


PROPOSED VIEW FROM WAKEHURST PARKWAY  
SCALE: 1:125 WHEN PRINTED AT A3

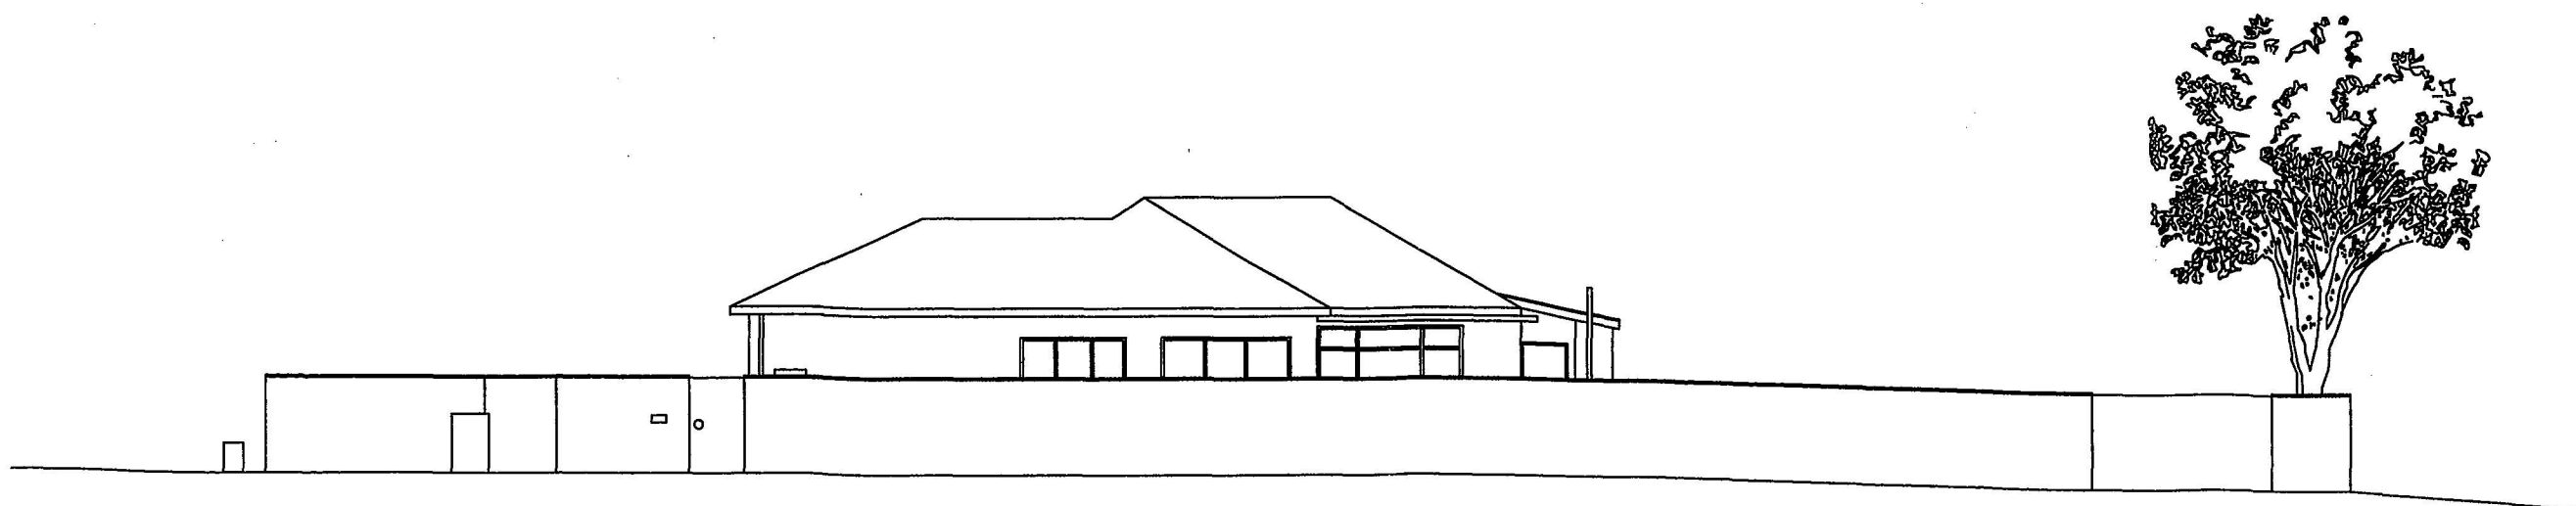

PROPOSED VIEW FROM CASTLE CIRCUIT  
SCALE 1:125 WHEN PRINTED AT A3

"WORK AS CONSTRUCTED"  
26/9/14

KARL DANENBERGSONS, CREG

5A CASTLE CIRCUIT  
(FORMERLY KNOWN AS 8 WAKEHURST PKWY)  
SEAFORTH, NSW, 2092  
(LOT 2 IN DEPOSITED PLAN 1112545)  
PROPOSED BOUNDARY FENCING  
MODIFICATIONS  
ELEVATIONS

K & J DANENBERGSONS  
REVISION A  
MAY 2013

DRAWING 004