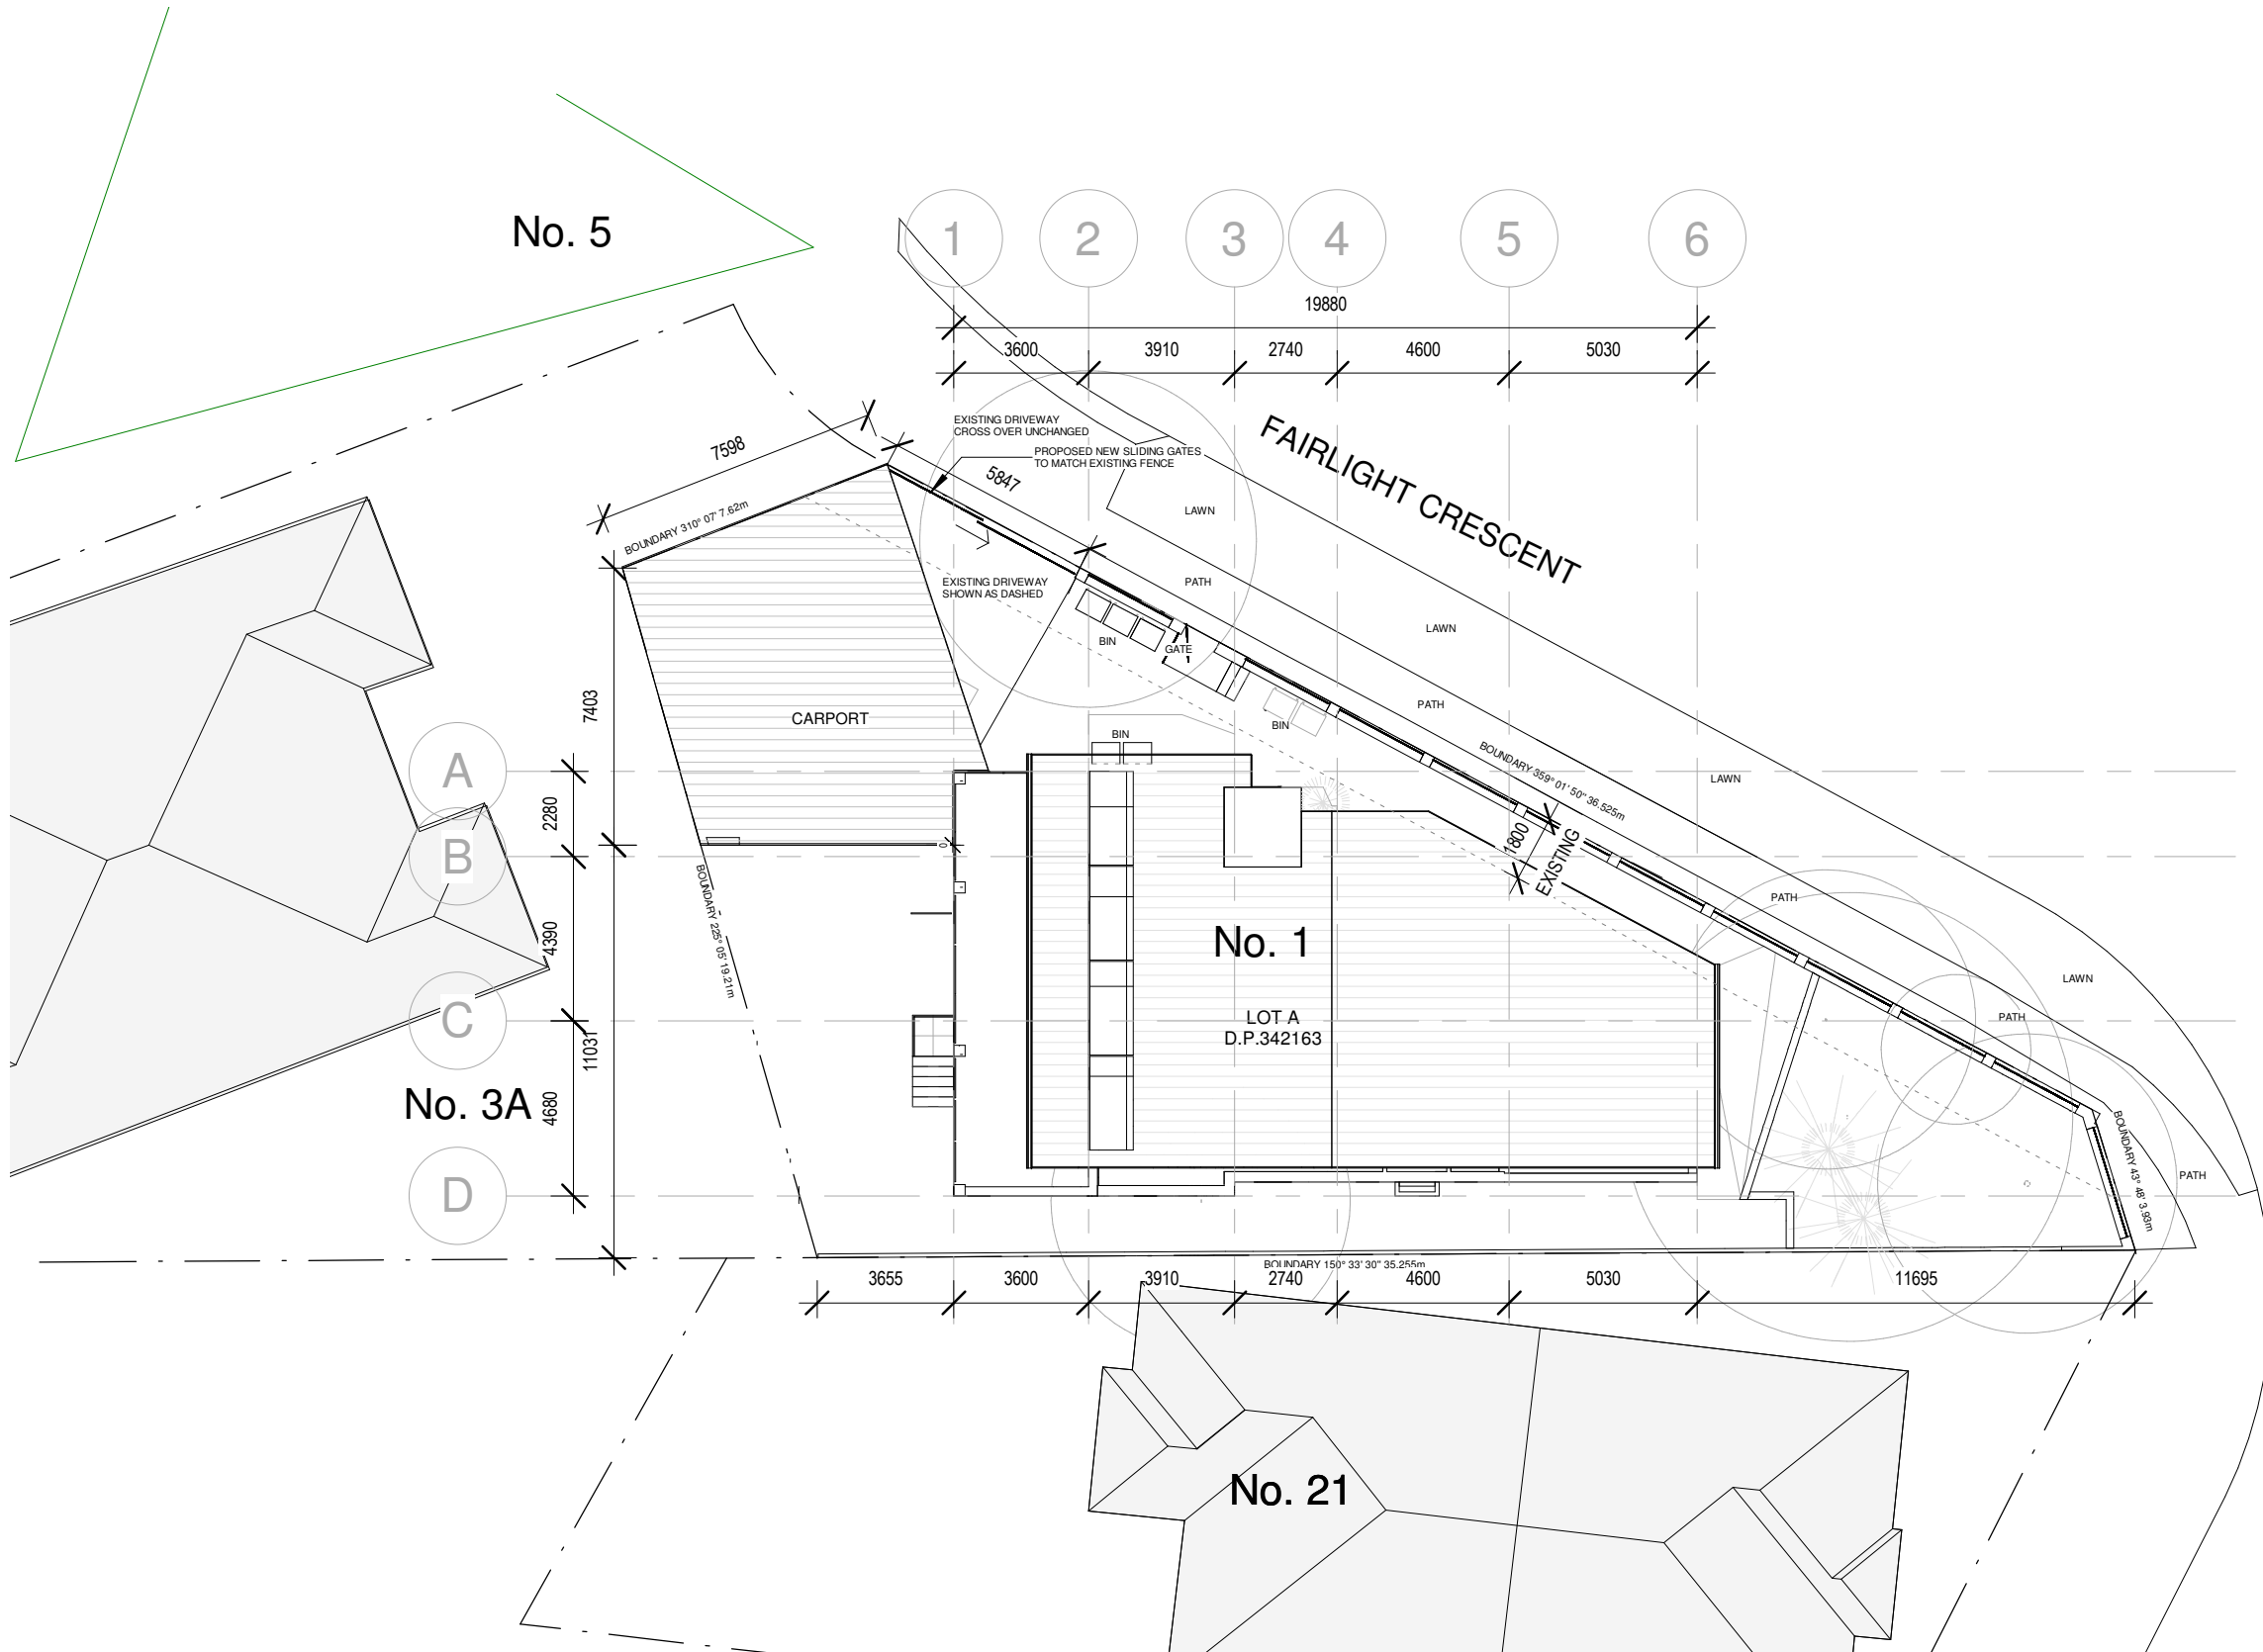



 **northern beaches council**


THIS PLAN IS TO BE READ IN CONJUNCTION WITH THE CONDITIONS OF DEVELOPMENT CONSENT

DA2023/0899

LAUDERDALE AVENUE

0102030405060708090100 GENERAL NOTES 1. CONTRACTORS MUST VERIFY ALL DIMENSIONS ON SITE PRIOR TO THE COMMENCEMENT OF ANY WORK OR THE PREPARATION OF SHOP DRAWINGS. 2. FIGURED DIMENSIONS TO BE USED IN PREFERENCE TO SCALED DIMENSIONS. USE OF THESE DRAWINGS The design and details shown on these drawings are applicable to this project only and may not be reproduced in whole or in part or be used for any other project or purpose without the written permission of Woodhouse & Danks Pty. Ltd. with whom copyright resides.															AS- BUILT DRAWINGS 1 FAIRLIGHT CRESCENT, FAIRLIGHT SITE PLAN															WOODHOUSE & DANKS ARCHITECTS Stephen R Fayle Suite 207 - Level 2, 20 Dale Street, Brookvale, NSW 2100 T: (02) 9939 8810 F: (02) 9939 8830 E: admin@woodhousedanks.com.au ABN: 26 064 690 106 ARN: 3274 SCALE 1 : 200@A3 DATE JUN 2023 PROJECT E:\STEPHEN FAYLE PROJ\111 Fairlight Crescent, Fairlight\Revit\1 Fairlight Crescent_2023.05.06\1 Fairlight Crescent_2023.06.06.rvt															JOB No. 15005 DWG. No. AS-01- REV DRAWN rjo														
No.	DATE	REVISION OR ISSUE	DWN.	CHK.	No.	DATE	REVISION OR ISSUE	DWN.	CHK.	No.	DATE	REVISION OR ISSUE	DWN.	CHK.																																													
						05.06.23	ISSUE																																																				
						17.04.23	AS-BUILT SUBMISSION																																																				

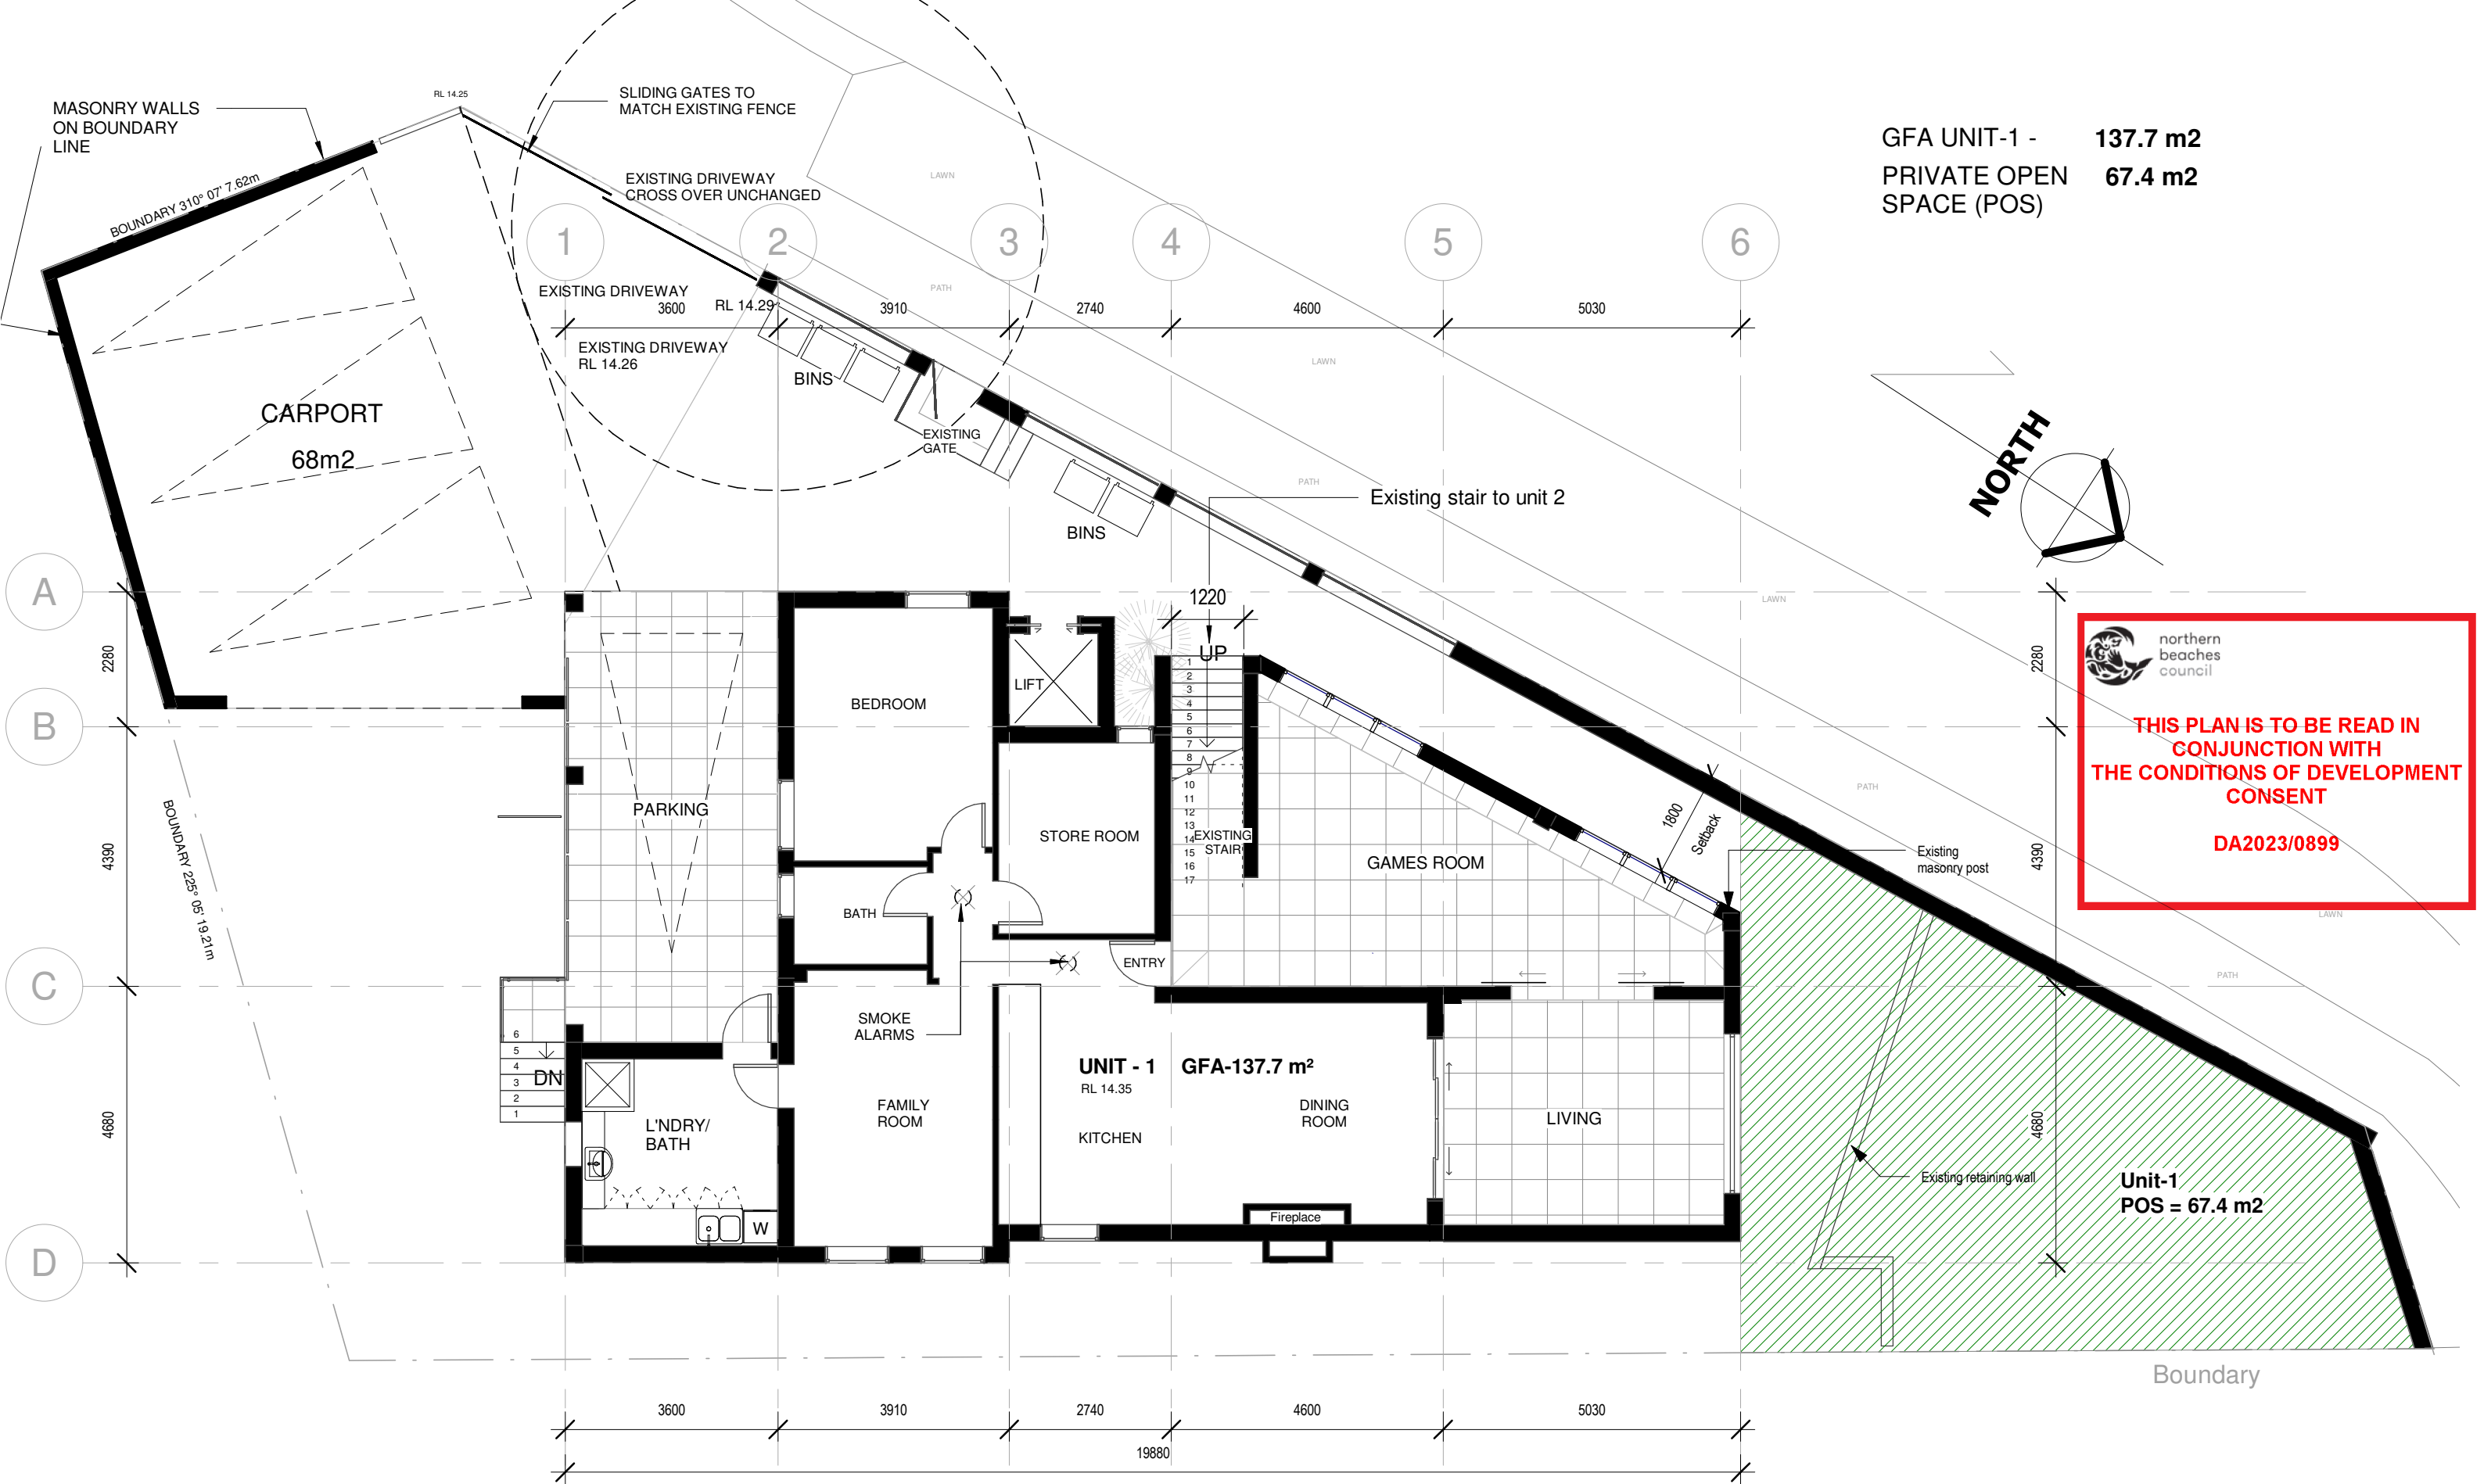

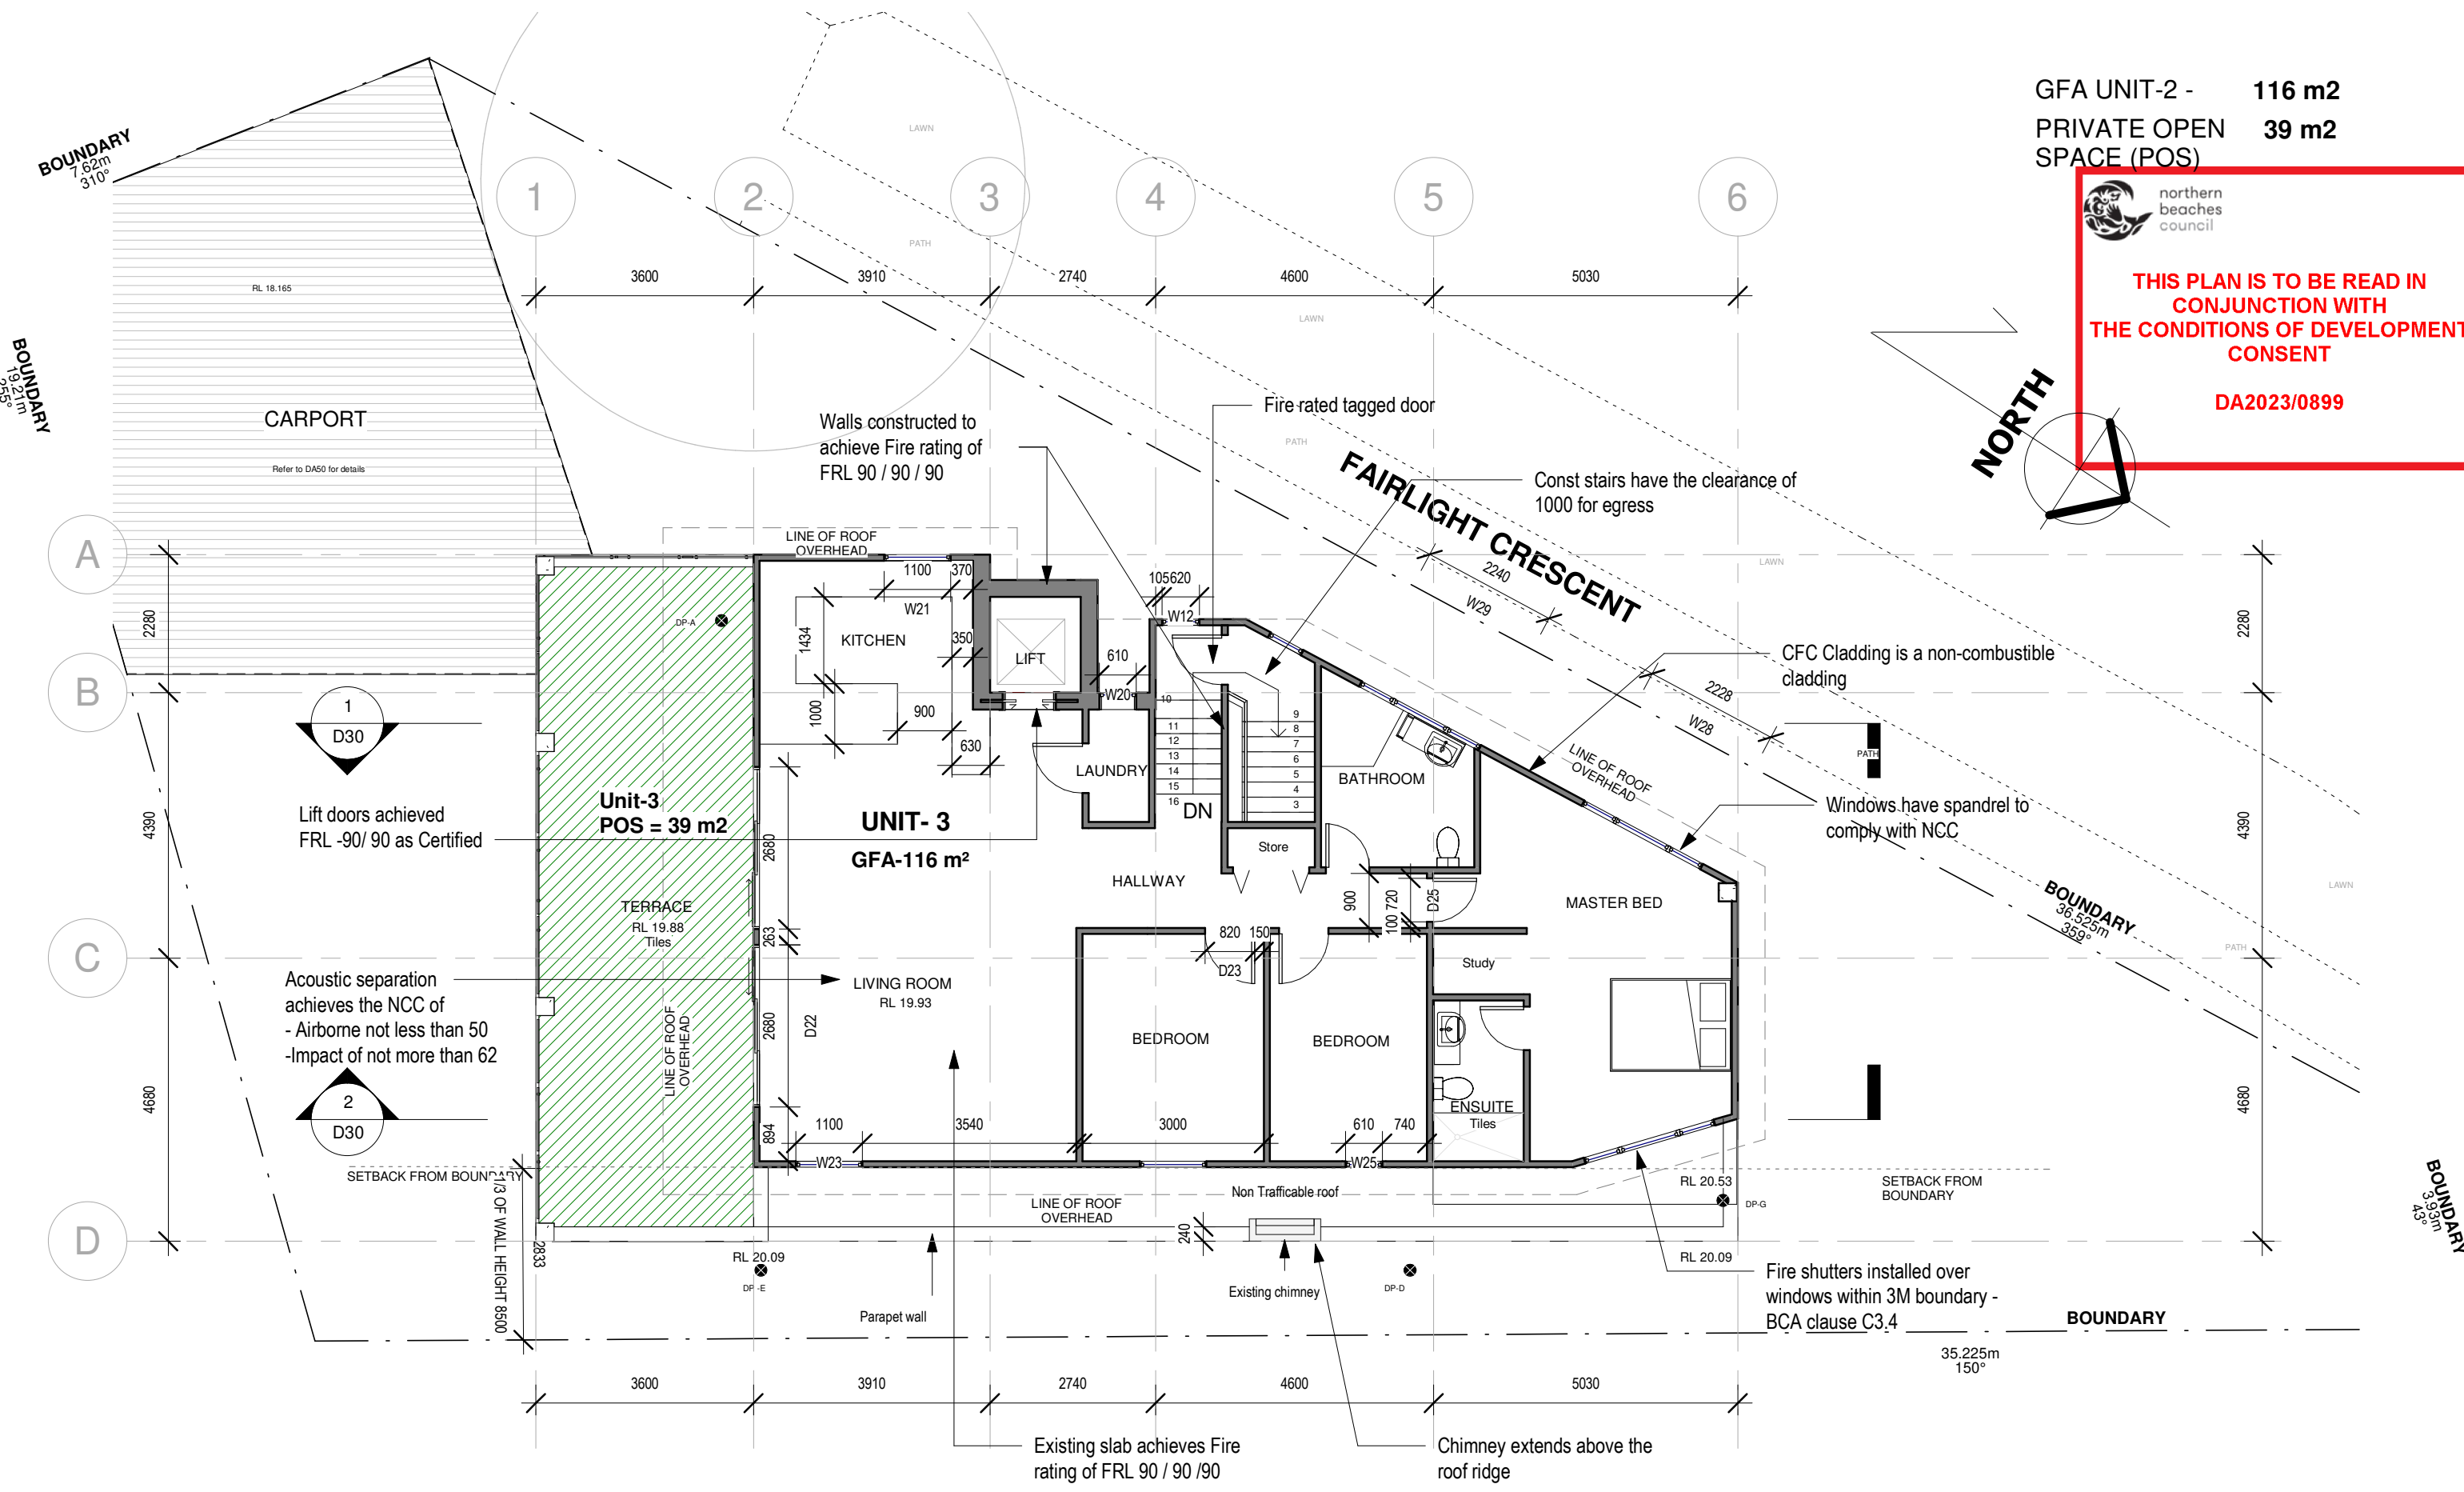

GFA UNIT-2 - 116 m²
PRIVATE OPEN SPACE (POS) 39 m²

THIS PLAN IS TO BE READ IN CONJUNCTION WITH THE CONDITIONS OF DEVELOPMENT CONSENT
DA2023/0899

0 5 1 2 3 4 5 6 7 8 9 10
GENERAL NOTES
1. CONTRACTORS MUST VERIFY ALL DIMENSIONS ON SITE PRIOR TO THE COMMENCEMENT OF ANY WORK OR THE PREPARATION OF SHOP DRAWINGS.
2. FIGURED DIMENSIONS TO BE USED IN PREFERENCE TO SCALED DIMENSIONS.
USE OF THESE DRAWINGS
The design and details shown on these drawings are applicable to this project only and may not be reproduced in whole or in part or be used for any other project or purpose without the written permission of Woodhouse & Danks Pty. Ltd. with whom copyright resides.

No.	DATE	REVISION OR ISSUE	DWN.	CHK.	No.	DATE	REVISION OR ISSUE	DWN.	CHK.	No.
						05.06.23	DA ISSUE			
						17.04.23	AS-BUILT SUBMISSION			

AS- BUILT DRAWINGS
1 FAIRLIGHT CRESCENT, FAIRLIGHT
SECOND FLOOR LEVEL

WOODHOUSE & DANKS ARCHITECTS
Suite 207 - Level 2, 20 Dale Street, Brookvale, NSW 2100
T: (02) 9939 8810 F: (02) 9939 8830
E: admin@woodhousedanks.com.au


15005
DWG. No. **AS-12-**
DATE **JUN 2023**
DRAWN **rjo**

SCALE: **1 : 100@A3**

JOB No. **15005**
REV **AS-12-**




NORTH

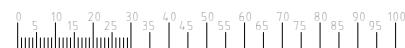[illegible]

DATE	JUN 2023	DRAWN	rjo
CAD FILE	C:\Users\joe\OneDrive\Documents\2023\06\20230620\20230620_115113_115113.dwg		

E:\STEPHEN FAYLE PROJS\1\1 Fairlight Crescent, Fairlight\Revit\1 Fairlight Crescent_2023.05.06\1 Fairlight Crescent_2023.06.06.rvt

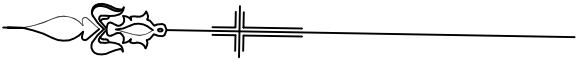

LAUDERDALE AVENUE

S.P.14560




northern
beaches
council

THIS PLAN IS TO BE READ IN
CONJUNCTION WITH
THE CONDITIONS OF DEVELOPMENT
CONSENT

DA2023/0899

B
D.P.190358

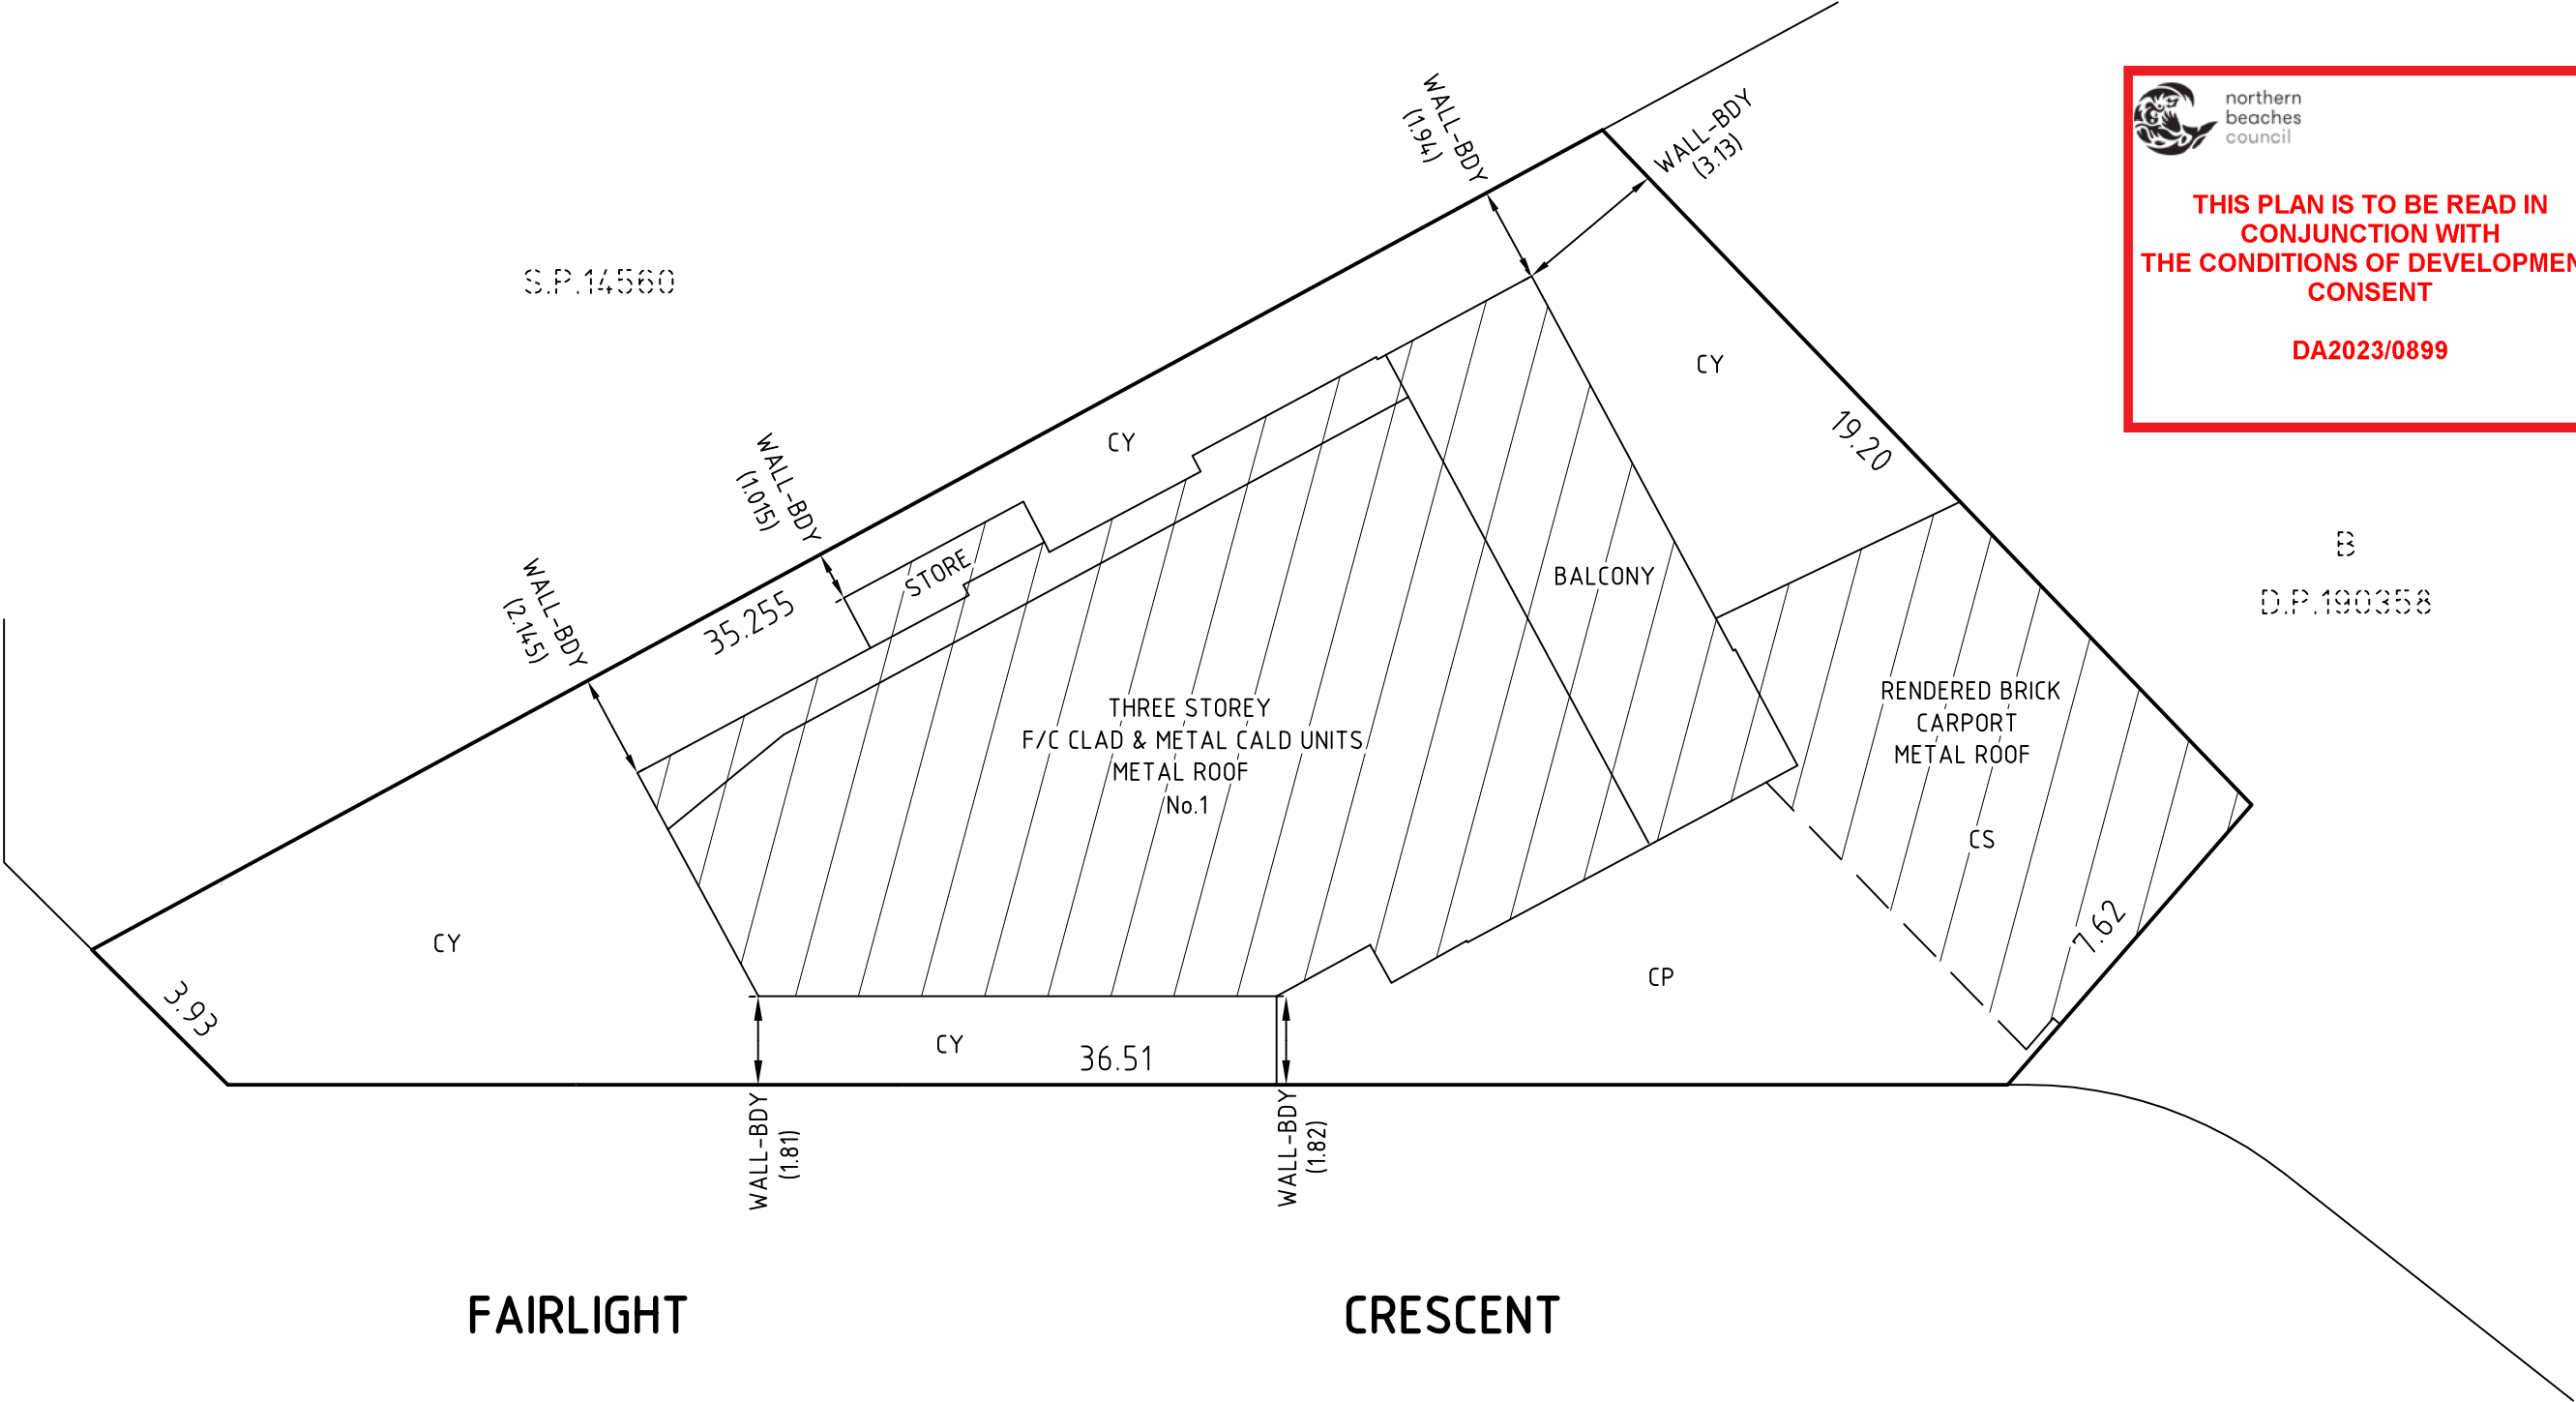

- CP DENOTES COMMON PROPERTY
- CS DENOTES CAR SPACE
- CY DENOTES COURTYARD

LOCATION PLAN

SURVEYOR
Name: David A. Stutchbury
Date: 19/09/2022
Reference: 8663/14

PLAN OF SUBDIVISION OF LOT A IN DP342163

L.G.A.: NORTHERN BEACHES
Locality: FAIRLIGHT
Reduction Ratio 1:150
Lengths are in metres.

Registered

SP DRAFT


	10	20	30	40	50	60	Table of mm	100	110	120	130	140	150
--	----	----	----	----	----	----	-------------	-----	-----	-----	-----	-----	-----



northern
beaches
council


THIS PLAN IS TO BE READ IN
CONJUNCTION WITH
THE CONDITIONS OF DEVELOPMENT
CONSENT

DA2023/0899

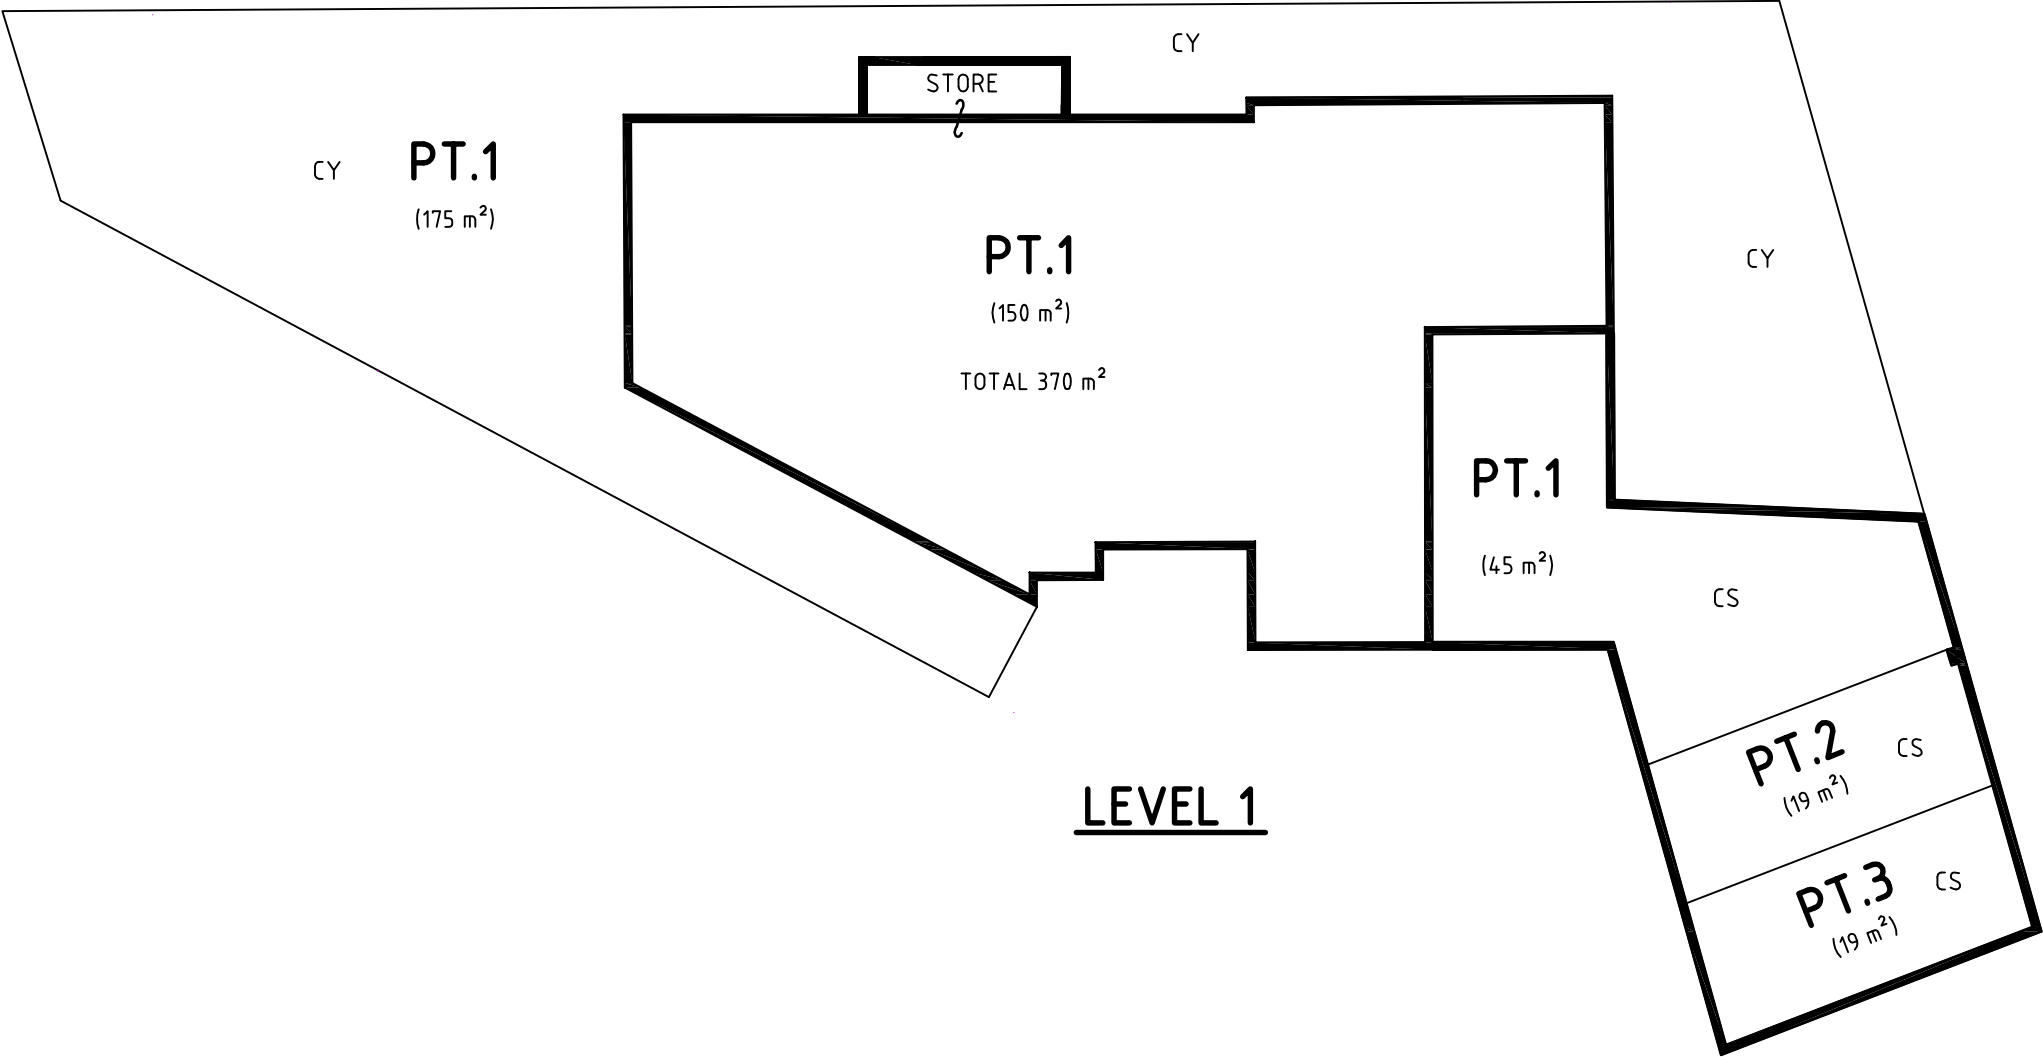


SURVEYOR	PLAN OF SUBDIVISION OF LOT A IN DP342163	L.G.A.: NORTHERN BEACHES	Registered	SP DRAFT
Name: David A. Stutchbury		Locality: FAIRLIGHT		
Date: 19/09/2022		Reduction Ratio 1:150		
Reference: 8663/14		Lengths are in metres.		

	10	20	30	40	50	60	Table of mm	100	110	120	130	140	150
--	----	----	----	----	----	----	-------------	-----	-----	-----	-----	-----	-----

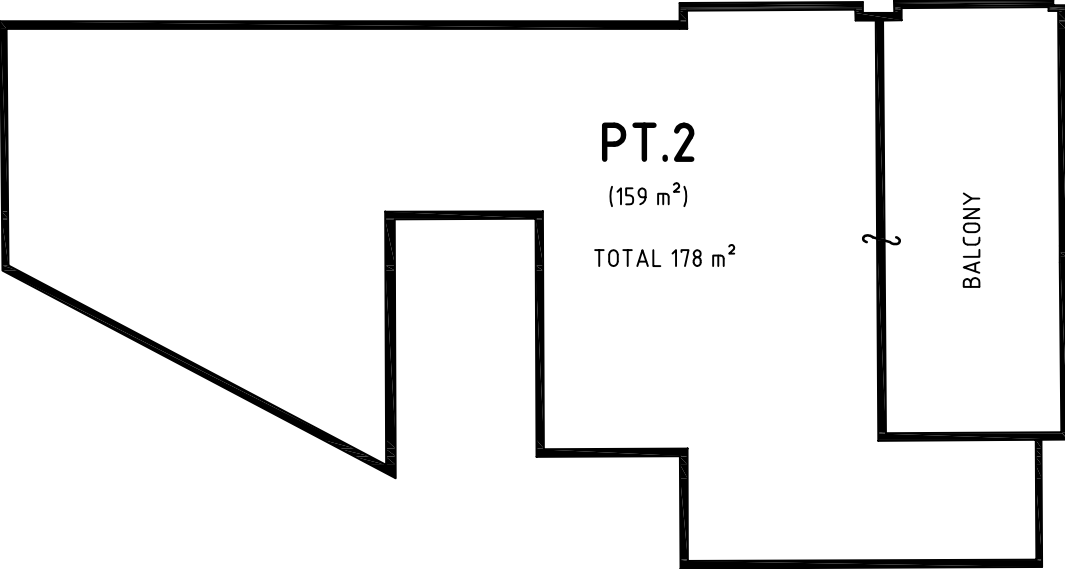

LEVEL 2

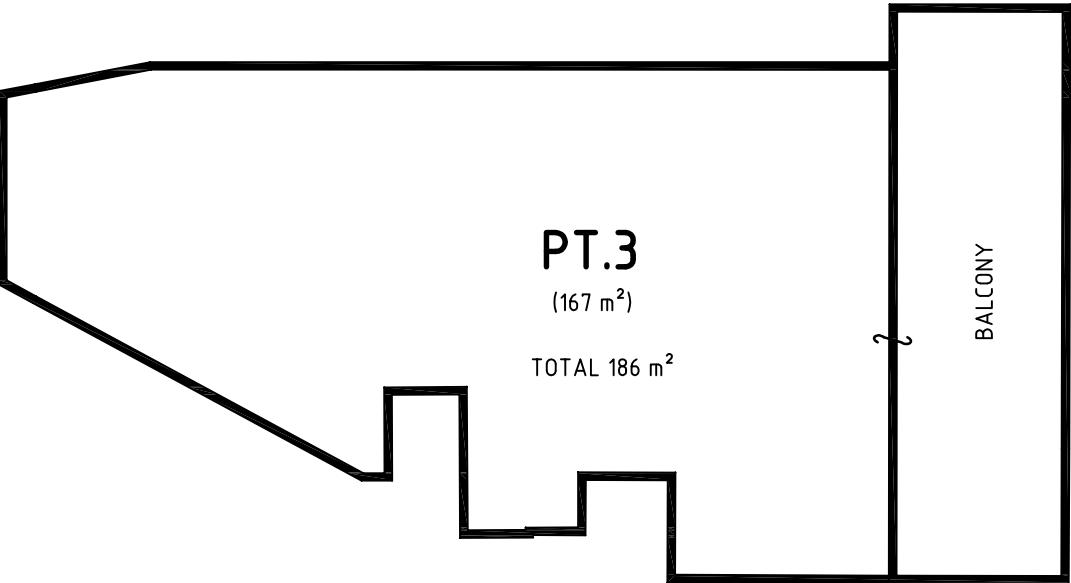

LEVEL 3



northern
beaches
council

THIS PLAN IS TO BE READ IN
CONJUNCTION WITH
THE CONDITIONS OF DEVELOPMENT
CONSENT

DA2023/0899



SURVEYOR

Name: David A. Stutchbury

Date: 19/09/2022

Reference: 8663/14

PLAN OF SUBDIVISION OF LOT A IN DP342163

L.G.A.: NORTHERN BEACHES

Locality: FAIRLIGHT

Reduction Ratio 1:150

Lengths are in metres.

Registered

SP DRAFT

	10	20	30	40	50	60	Table of mm	100	110	120	130	140	150
--	----	----	----	----	----	----	-------------	-----	-----	-----	-----	-----	-----