

DP 2
1161389

3
DP 1161389

DP 1161389

5
DP 1161389

 
24
SEC C
DP 5464

- 1) THE BOUNDARIES HAVE NOT BEEN MARKED
- 2) ALL AREAS AND DIMENSIONS HAVE BEEN COMPILED FROM PLANS MADE AVAILABLE BY THE OFFICE of LAND & PROPERTY INFORMATION (NSW) AND ARE SUBJECT TO FINAL SURVEY
- 3) ORIGIN OF LEVELS ON A.H.D. IS TAKEN FROM **PM15549** R.L. **9.38** (A.H.D.) IN MACPHERSON STREET
- 4) CONTOUR INTERVAL 0.5m
- 5) CONTOURS ARE INDICATIVE ONLY. ONLY SPOT LEVELS SHOULD BE USED FOR CALCULATIONS OF QUANTITIES WITH CAUTION
- 6) KERB LEVELS ARE TO THE TOP OF KERB UNLESS SHOWN OTHERWISE
- 7) FLOOR LEVELS SHOWN ARE THRESHOLD LEVELS. NO INVESTIGATION OF INTERNAL FLOOR LEVELS HAS BEEN UNDERTAKEN
- 8) NO INVESTIGATION OF UNDERGROUND SERVICES HAS BEEN MADE. SERVICES HAVE BEEN PLOTTED FROM RELEVANT AUTHORITIES INFORMATION AND HAVE NOT BEEN SURVEYED. ALL RELEVANT AUTHORITIES SHOULD BE NOTIFIED PRIOR TO ANY EXCAVATION ON OR NEAR THE SITE
- 9) NO INVESTIGATION OF UNDERGROUND SERVICES HAS BEEN MADE. ALL RELEVANT AUTHORITIES SHOULD BE NOTIFIED PRIOR TO ANY EXCAVATION ON OR NEAR THE SITE
- 10) 8/4/7 DENOTES TREE SPREAD OF 8m, TRUNK DIAMETER OF 0.4m & APPROX HEIGHT OF 7m
- 11) NO INVESTIGATION OF CERTIFICATE OF TITLE HAS BEEN MADE IN THIS AREA
- 12) SHOWS APPROXIMATE POSITION OF ROAD LINEMARKING AND IS INDICATIVE ONLY
- 13) BEARINGS SHOWN ARE MGA. ADD APPROX. 1° FOR TRUE NORTH BEARINGS

TREE SCHEDULE

TAG NUMBER	TREE SPREAD/DIAMETER/HEIGHT
21	8/0.6/12
22	4/0.4/12
23	8/0.6/12
24	4/0.4/10
25	8/0.6/12
26	4/0.3/10
27	8/0.6/12
28	8/0.6/12
29	4/0.3/10
30	8/0.6/12
31	4/0.2/10
32	8/0.6/12
33	4/0.4/10
34	4/0.4/10
35	4/0.4/10
36	6/0.4/10
37	6/0.4/10
38	6/0.4/10
39	10/0.6/12
40	4/0.4/12
41	6/0.6/12
42	4/0.3/10
43	6/0.4/10
44	6/0.4/10
45	10/0.6/12
46	6/0.4/10
47	8/0.6/10
48	6/0.6/10
49	4/0.4/8
50	6/0.6/10
51	10/0.6/12
52	6/0.6/12
53	10/0.6/12
54	10/0.8/10
55	10/0.6/12
56	10/0.6/10
57	8/0.4/10
58	10/0.6/12
59	8/0.4/10
60	8/0.4/10
61	8/0.4/10
62	0.6/2/8
63	10/0.6/10


LEGEND

BENCH MARK	
TELSTRA PIT	 TEL
ELECTRIC LIGHT POLE	 MLP
POWER POLE	 PP
PIT WITH CONCRETE LID	 CLID
KERB INLET PIT	 KIP
SEWER MANHOLE	 SMH
HYDRANT	 HYD
GAS	
TELSTRA	
WATER	
ELECTRICITY (U'GGROUND)	
SEWER	

EASEMENT NOTES

(B) EASEMENT FOR ELECTRICITY AND OTHER PURPOSES 2 WIDE AND VARIABLE WIDTH (VIDE DP1161389)
(C) RIGHT OF CARRIAGEWAY 4.5 WIDE, 7 WIDE & VARIABLE WIDTH (VIDE DP1161389)

▲ BENCH MARK
PM 15549
RI 9.38

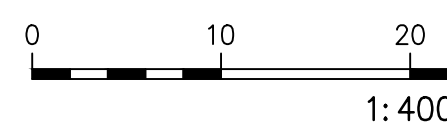

THIS IS THE PLAN
REFERRED TO IN
LETTER
DATED: -

.....
Registered
Surveyor NSW

DATE OF SURVEY:	21-08-2012
DATUM:	AHD
SITE AREA:	N/A




LOCKLEY
LAND TITLE
SOLUTIONS

Registered
Surveyors NSW
19 Massey Street
Gladesville NSW 2111
PO BOX 400
Gladesville NSW 1675
ph:(02) 9879 6077
fax:(02) 9879 7143

AMENDMENT: ADJOINING TREES & TREE DETAILS ADD: 35818 DATED 06/05/17	
CLIENT: ANGLICAN RETIREMENT VILLAGE	ORIGINAL PLAN SIZE: A1 1:400
PLAN OF LOT AND LEVEL OVER PART OF LOT 3, 4 AND 5 IN DP1161389 KNOWN AS NO 6-14 MACPHERSON STREET, WARRIEWOOD	PROJECT NO: - JOB REFERENCE: 35118DT
LGA: KU-RING-GAI	SHEET OF 1 SHEETS 1

THE FORMER CENTRE LINE OF NARRABEEN CREEK AS DETERMINED BY DP 5464 AND DP 400488 IS THE BOUNDARY. THE POSITION OF THE ORIGINAL CREEK HAS BEEN LOST. THE CREEK TRAVERSE BELOW HAS BEEN DETERMINED BY A COMBINATION OF FIELD SURVEY AND DEPOSITED PLANS WHICH HAVE BEEN TRACED IN ORDER TO DETERMINE THE ORIGINAL POSITION OF THE CENTRELINE OF CREEK.

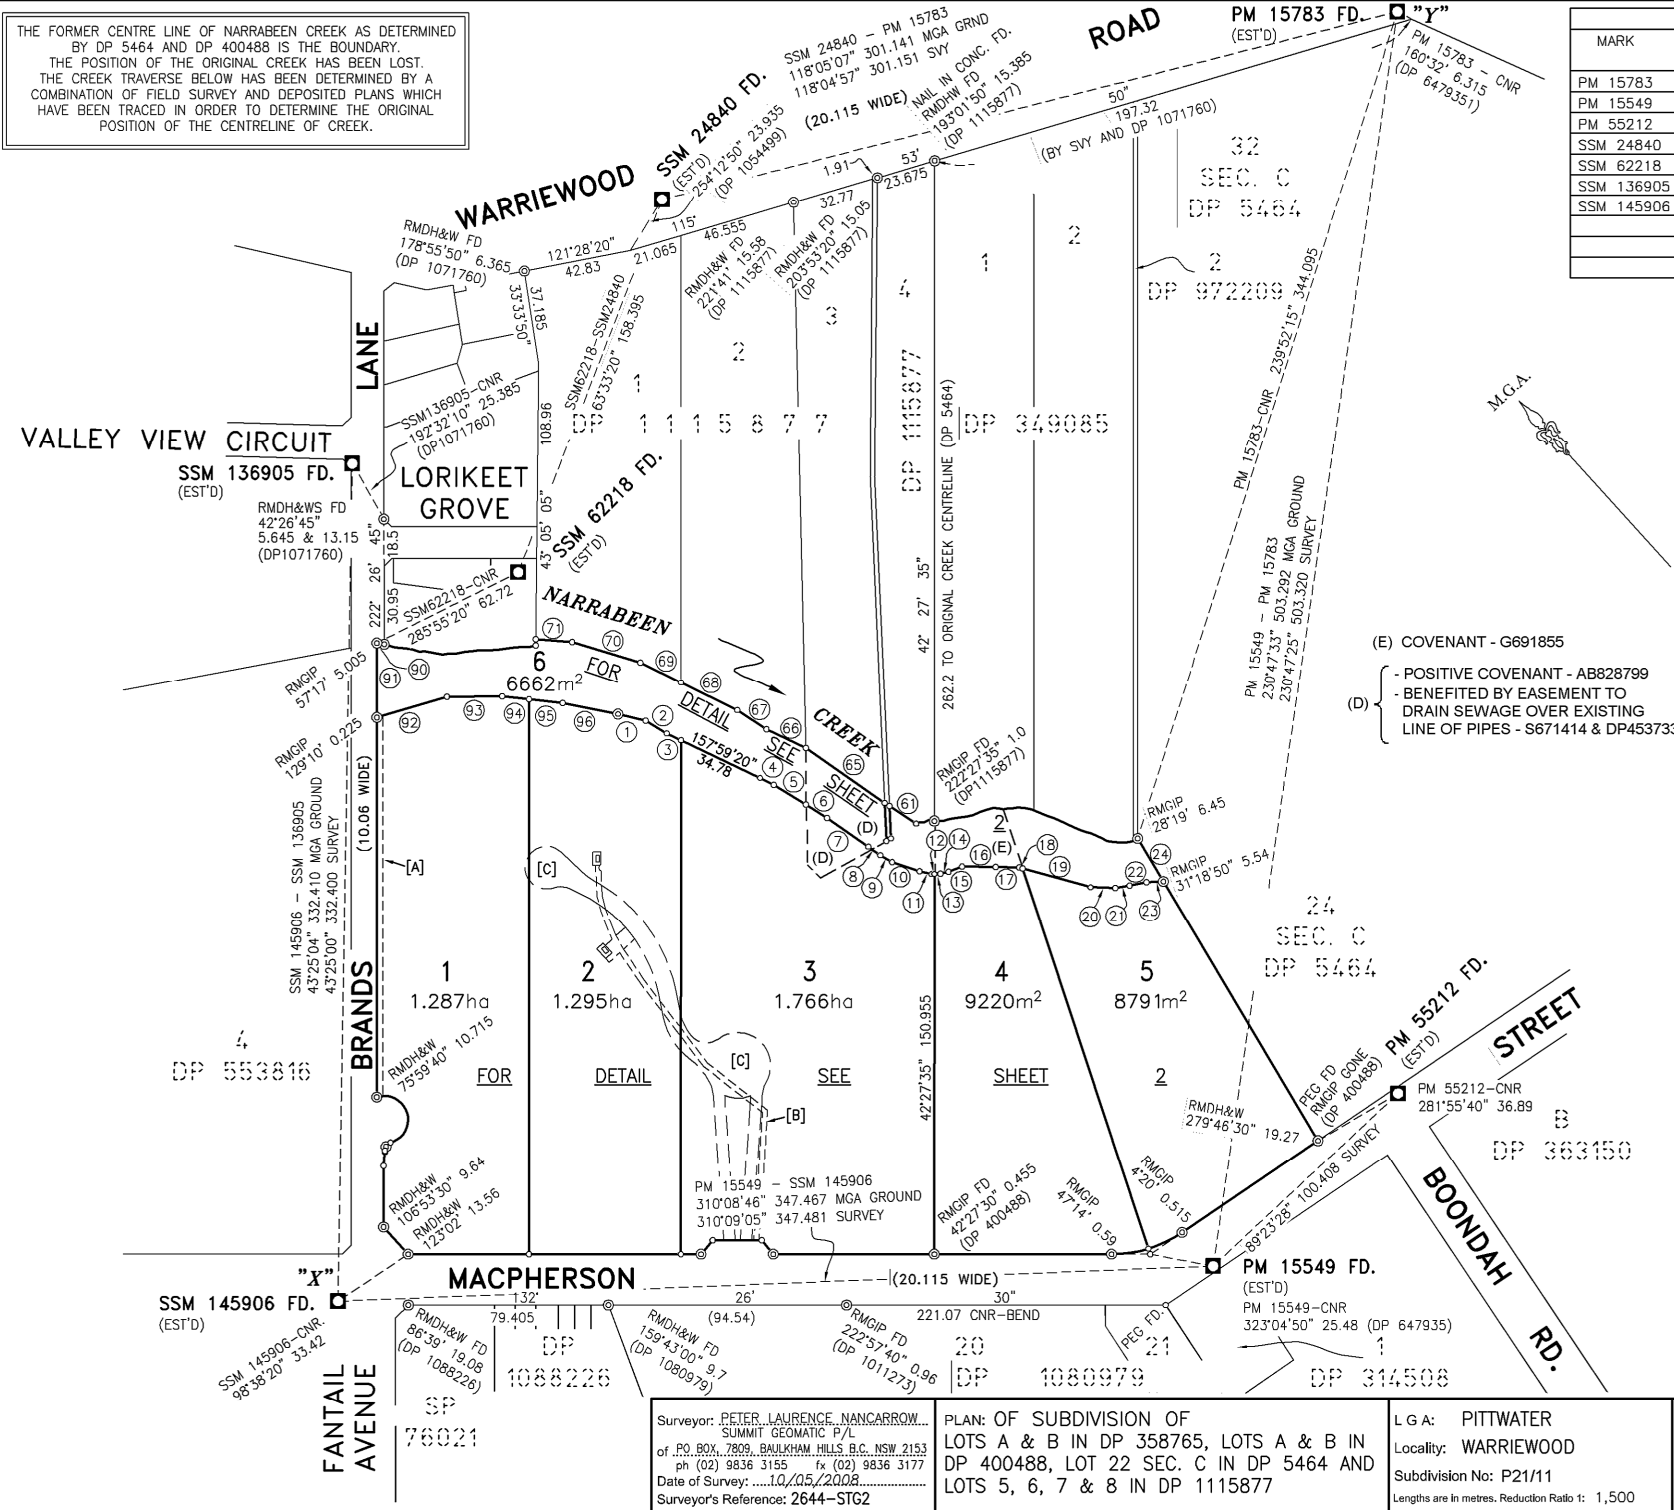

SURVEYING REGULATION 2006 CL 61(2)				
MARK	M.G.A. CO-ORDINATES		CLASS	ORDER
	EASTING	NORTHING		
PM 15783	342 457.485	6 271 268.028	B	2
PM 15549	342 067.540	6 270 949.911	B	2
PM 55212	342 167.927	6 270 950.978	B	2
SSM 24840	342 191.825	6 271 409.780	B	2
SSM 62218	342 050.017	6 271 339.253	C	4
SSM 136905	342 030.408	6 271 415.343	C	4
SSM 145906	341 801.960	6 271 173.915	C	3

COMBINED SCALE FACTOR 0.999906

SOURCE: M.G.A. CO-ORDINATES ADOPTED

FROM N.S.W. LPI 08/05/2008

"X" - "Y"
SSM 145906 - PM 15783
81°49'48" 662.308 MGA GROUND
81°49'48" 662.314 SURVEY

IT IS INTENDED TO CREATE LOT 6 AS PUBLIC RESERVE

- [A] EASEMENT FOR DRAINAGE 2.5 WIDE
- [B] EASEMENT FOR ELECTRICITY AND OTHER PURPOSES 2 WIDE AND VARIABLE WIDTH.
- [C] RIGHT OF CARRIAGEWAY 4.5 WIDE, 7 WIDE AND VARIABLE WIDTH.

SCHEDULE OF SHORT BOUNDARIES					
No.	BEARING	DISTANCE	No.	BEARING	DISTANCE
1	146°02'30"	11.34	49	293°39'50"	2.75
2	163°25'20"	9.77	50	285°20'50"	2.8
3	157°59'20"	6.245	51	301°51'50"	2.46
4	159°01'50"	6.13	52	305°15'00"	3.13
5	163°54'10"	14.93	53	301°04'00"	2.505
6	165°28'40"	9.945	54	306°13'50"	1.885
7	166°55'10"	19.98	55	294°13'10"	1.855
8	168°29'00"	5.805	56	309°55'00"	3.71
9	162°35'10"	5.395	57	322°20'30"	2.255
10	150°56'10"	11.47	58	289°25'40"	2.055
11	145°23'40"	4.91	59	288°42'10"	1.965
12	130°23'20"	1.115	60	288°42'10"	1.27
13	130°23'20"	2.43	61	345°46'00"	12.71
14	118°22'10"	3.23	62	219°53'30"	12.85
15	112°02'00"	5.745	63	282°41'30"	2.055
16	132°50'10"	13.36	64	39°53'30"	15.11
17	133°52'40"	9.355	65	347°20'20"	38.13
18	147°59'40"	1.355	66	337°56'30"	17.32
19	147°59'40"	27.98	67	346°03'40"	13.845
20	134°29'10"	9.835	68	338°45'00"	24.955
21	122°41'50"	5.695	69	338°45'00"	17.98
22	121°08'00"	6.89	70	329°12'30"	28.345
23	129°44'10"	6.685	71	317°00'50"	14.46
24	11°36'00"	19.88	72	223°05'10"	2.505
25	287°55'20"	2.71	73	300°11'30"	2.465
26	302°04'20"	2.37	74	311°05'40"	3.57
27	314°13'40"	2.19	75	308°17'20"	3.935
28	315°39'10"	2.475	76	302°56'30"	5.26
29	321°41'30"	2.65	77	310°27'20"	3.76
30	340°20'30"	2.45	78	313°23'40"	3.97
31	337°28'30"	2.29	79	301°48'30"	2.57
32	332°33'30"	2.305	80	307°16'20"	2.5
33	331°18'50"	1.635	81	302°36'20"	3.905
34	329°06'50"	2.015	82	312°02'40"	2.98
35	334°43'50"	3.485	83	304°12'50"	2.305
36	337°15'10"	3.99	84	323°09'40"	7.255
37	338°29'40"	4.915	85	305°35'20"	2.01
38	330°03'10"	3	86	328°03'10"	3.065
39	332°46'20"	3.475	87	320°08'30"	2.83
40	334°42'20"	3.04	88	318°36'00"	4.055
41	324°05'20"	3.005	89	328°20'10"	4.375
42	317°01'50"	2.59	90	322°35'30"	2.99
43	300°24'00"	2.155	91	42°26'45"	29.745
44	313°41'10"	1.635	92	115°50'10"	28.96
45	302°17'40"	2.005	93	132°08'50"	21.995
46	326°22'10"	1.765	94	138°41'20"	10.7
47	316°06'20"	2.215	95	138°41'20"	13.445
48	297°57'00"	2.885	96	143°49'50"	22.37

- (E) COVENANT - G691855
- (D) - POSITIVE COVENANT - AB828799
- BENEFITED BY EASEMENT TO DRAIN SEWAGE OVER EXISTING LINE OF PIPES - S671414 & DP453733

Surveyor: PETER LAURENCE NANCARROW
SUMMIT GEOMATIC P/L
of PO BOX 7809, BAULKHAM HILLS B.C. NSW 2153
ph (02) 9836 3155 fx (02) 9836 3177
Date of Survey: 11/05/2008
Surveyor's Reference: 2644-STG2

PLAN: OF SUBDIVISION OF
LOTS A & B IN DP 358765, LOTS A & B IN
DP 400488, LOT 22 SEC. C IN DP 5464 AND
LOTS 5, 6, 7 & 8 IN DP 1115877

LGA: PITTWATER
Locality: WARRIEWOOD
Subdivision No: P21/11
Lengths are in metres. Reduction Ratio 1: 1,500

Req:DP1161389 P /Rev:17-May-2012 /Prt:17-May-2012 23:04 /Pgs:ALL /Seq:1 of 5
Ref:lands:ict-eplan /For Surveyors Use Only /Src:W


PLAN FORM 2 (A2) DP1161389
Req:R906268 /Doc:DP 1161389 P /Rev:17-May-2012 23:04 /Pgs:ALL /Seq:2 of 5
Ref:lands:ict-eplan /For Surveyors Use Only /Src:W

DP1161389

WARNING: CREASING OR FOLDING WILL LEAD TO REJECTION

ePlan



Sheet 2 of 3 Sheets

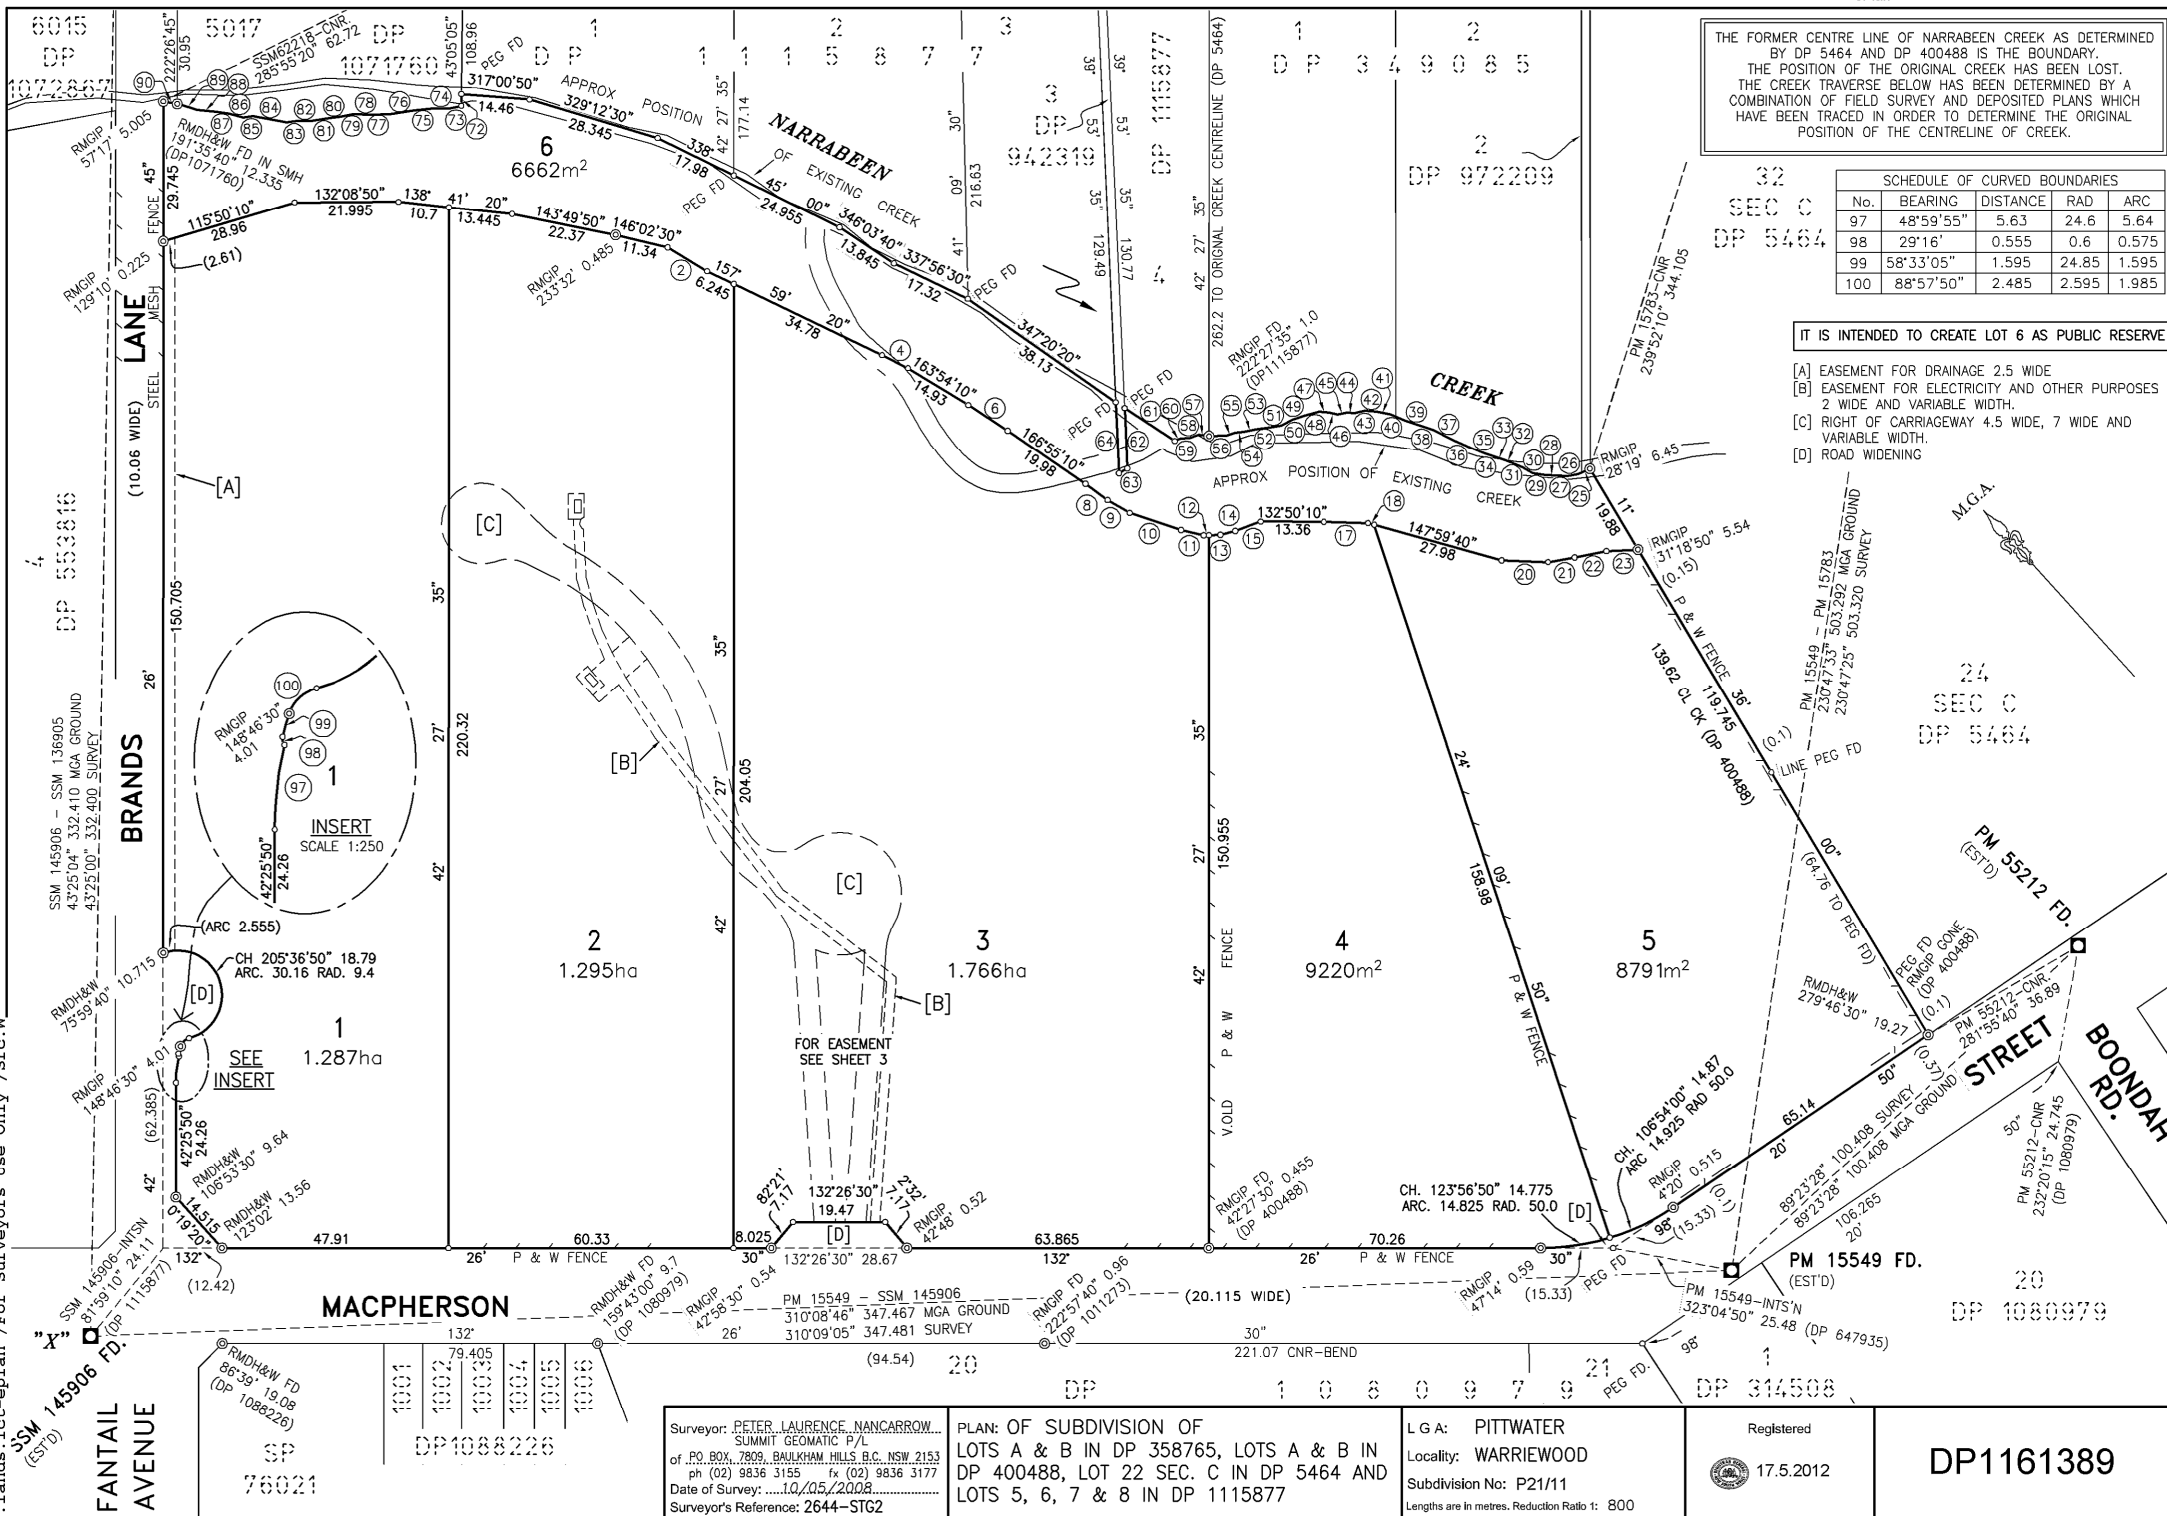

Number	Bearing	Distance	Number	Bearing	Distance
101	226°39'20"	0.62	126	39°17'45"	12.71
102	226°39'20"	2.405	127	312°14'00"	1.05
103	226°39'25"	54.667	128	42°14'00"	5.3
104	132°26'30"	4.51	129	132°14'00"	3.3
105	46°39'25"	51.326	130	222°14'00"	4.87
106	46°39'20"	2.405	131	219°17'45"	10.26
107	46°39'20"	4.18	132	207°25'40"	5.52
108	30°21'25"	10.5	133	203°01'10"	5.93
109	356°15'00"	10.53	134	199°30'40"	5.225
110	158°15'00"	4.725	135	193°19'20"	6.150
111	210°21'25"	10.5	136	188°40'25"	14.155
112	218°13'30"	57.914	137	184°55'30"	24.505
113	132°26'30"	4.51	138	185°07'10"	17.275
114	38°13'30"	57.693	139	170°25'45"	30.405
115	4°55'30"	24.565	140	226°18'50"	51.807
116	8°40'35"	13.915	141	312°26'50"	2.005
117	269°59'40"	5.655	142	46°18'50"	50.882
118	359°59'40"	2	143	350°25'45"	29.6
119	359°59'40"	5.3	144	5°07'10"	14.91
120	89°59'40"	3.3	145	5°07'10"	2.62
121	180°04'10"	1.315	146	89°59'40"	5.005
122	89°59'40"	3.675	147	89°59'40"	6.015
123	19°30'40"	5.995	148	179°58'20"	3.985
124	23°01'10"	6.07	149	269°59'40"	3.3
125	27°25'40"	5.805	150	132°14'00"	1.685

SCHEDULE OF SHORT & CURVED BOUNDARIES

Number	Radius	Arc Length	Chord Distance	Chord Bearing
162	13	7.68	7.57	139°13'50"
163	13	2.49	2.485	116°49'10"
164	13	0.595	0.595	110°01'50"
165	13	5.64	5.6	59°05'20"
166	13	35.275	25.405	353°47'20"
167	8	12.285	11.115	320°02'50"
168	20	9.185	9.105	17°12'00"
169	63.5	51.796	50.372	6°59'20"
170	63.5	2.39	2.39	342°32'40"
171	30	7.77	7.75	348°49'50"
172	8.5	36.08	14.48	234°44'35"
173	8.5	6.69	6.52	135°42'00"
174	56.5	8.475	8.47	162°32'50"
175	56.5	3.18	3.18	168°27'30"
176	56.5	10.62	10.605	175°27'25"
177	56.5	6	6	183°53'10"
178	56.5	23.1	22.94	198°38'35"
179	27	19.205	18.8	189°58'55"
180	30	12.25	12.165	181°18'10"
181	13	5.64	5.6	205°47'30"
182	63.5	0.06	0.06	161°26'10"
183	1.425	0.715	0.71	275°01'40"
184	1.425	2.48	2.18	210°52'00"

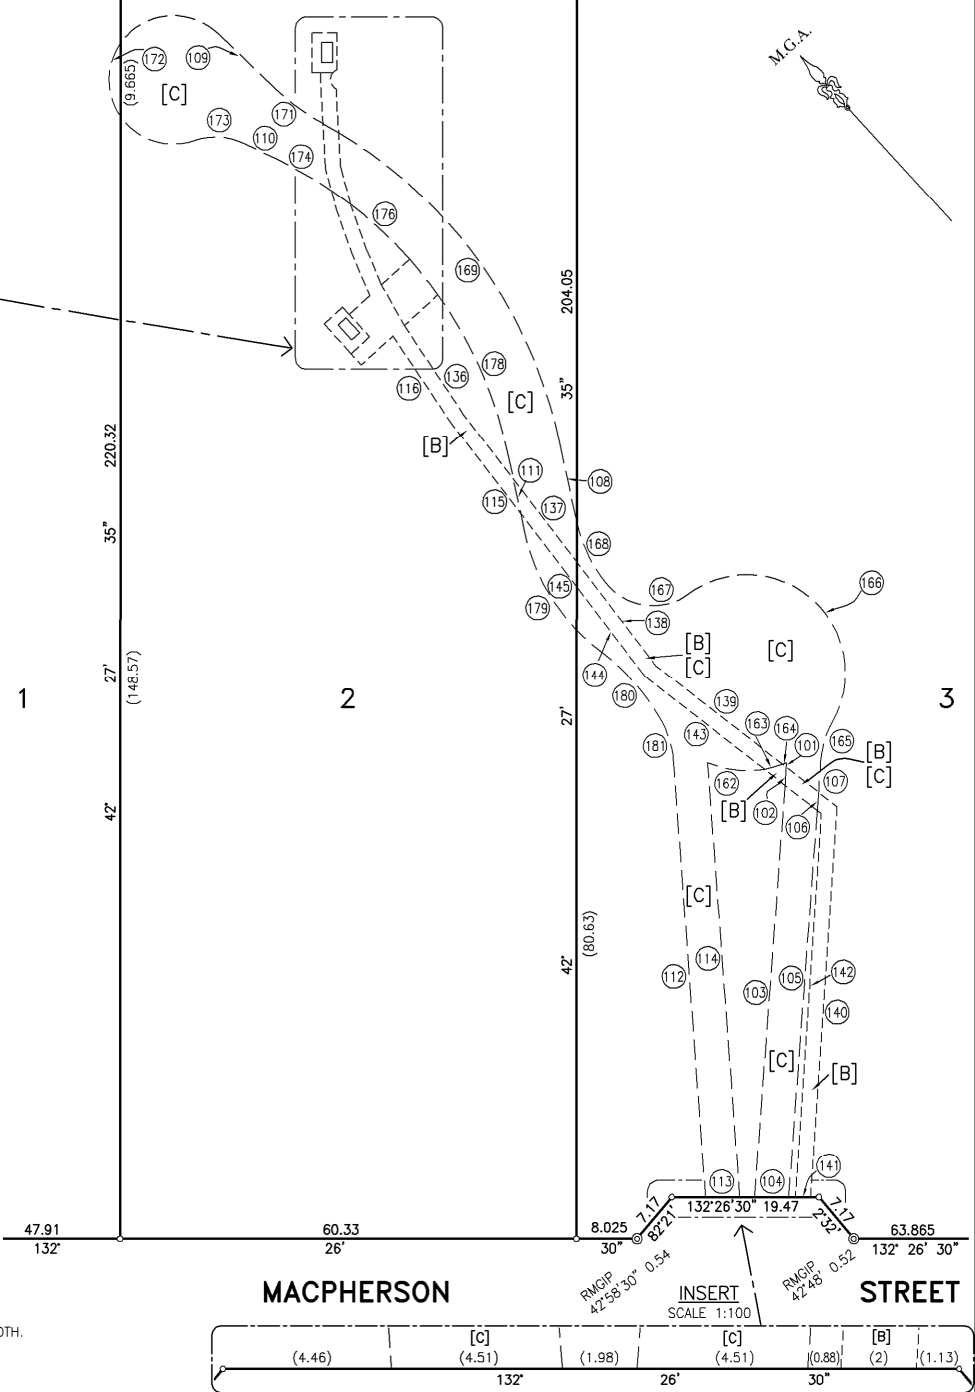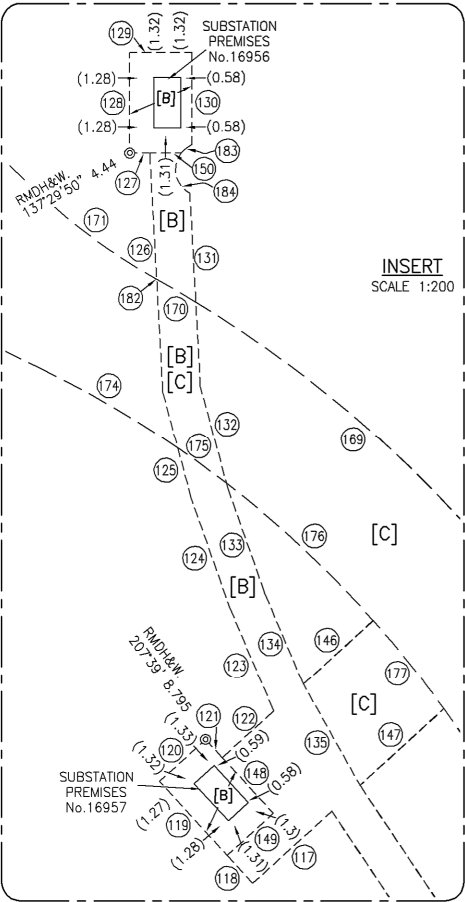

[B] EASEMENT FOR ELECTRICITY AND OTHER PURPOSES 2 WIDE AND VARIABLE WIDTH.

[C] RIGHT OF CARRIAGEWAY 4.5 WIDE, 7 WIDE AND VARIABLE WIDTH.

Surveyor: PETER LAURENCE NANCARROW...
SUMMIT GEOMATIC P/L
of .PO BOX 7809, BAULKHAM HILLS B.C. NSW 2153
ph (02) 9836 3155 fx (02) 9836 3177
Date of Survey:10/05/2008.....
Surveyor's Reference: 2644-STG2

PLAN: OF SUBDIVISION OF
LOTS A & B IN DP 358765, LOTS A & B IN
DP 400488, LOT 22 SEC. C IN DP 5464 AND
LOTS 5, 6, 7 & 8 IN DP 1115877

LGA: PITTWATER
Locality: WARRIEWOOD
Subdivision No: P21/11
Lengths are in metres. Reduction Ratio 1: 500

Registered
17.5.2012

DP1161389

Sheet 1 of 2 sheet(s)

DP1 161389

Registered:  17.5.2012

- Title System: TORRENS

Purpose: SUBDIVISION

- PLAN OF SUBDIVISION OF LOTS A & B DP358765,
LOTS A & B DP400488, LOT 22 SEC C DP5464
AND LOTS 5, 6, 7 & 8 IN DP 1115877**

LGA: PITTWATER

- Locality: WARRIEWOOD

Parish: NARRABEEN

County: CUMBERLAND

Surveying Regulation, 2006

I, PETER LAURENCE NANCARROW.....
of SUMMIT GEOMATIC PTY LTD.....
a surveyor registered under the *Surveying Act, 2002*, certify that the
survey represented in this plan is accurate, has been made in
accordance with the *Surveying Regulation, 2006* and was completed
on: 10/05/2008.....

The survey relates to LOTS 1 – 6 AND CONNECTIONS.....

(specify the land actually surveyed or specify any land shown in the plan that is not the subject of the survey)

Signature  Dated: 11/10/2011
Surveyor registered under the Surveying Act, 2002

Datum Line: "X" ~ "Y" _____

Type: Urban/Rural

Subdivision Certificate

Plans used in the preparation of survey/compilation

DP 581495	DP 972209	DP 579309
DP 553816	DP 537054	DP 228171
DP 208149	DP 400488	DP 1088226
DP 270426	DP 1071760	DP 1080979
DP 1011273	DP 647935	DP 5671414
DP 581495	DP 358765	DP 349085
DP 345528	DP 942319	DP 5464
DP 1115877		

(if insufficient space use Plan Form 6A annexure sheet)

SURVEYOR'S REFERENCE: 2644-STG2

Accreditation no: _____

Subdivision Certificate no: P21/11

File no: N0102/05

* Delete whichever is inapplicable.


DEPOSITED PLAN ADMINISTRATION SHEET Sheet 2 of 2 sheet(s)

PLAN OF SUBDIVISION OF LOTS A & B DP358765, LOTS A & B DP400488, LOT 22 SEC C DP5464 AND LOTS 5, 6, 7 & 8 IN DP 1115877	DP1161389 Registered:  17.5.2012
	*

Subdivision Certificate No: P21/11 Date of Endorsement: 14/12/11


Signed, Sealed and Delivered for Anglican Retirement Villages Diocese of Sydney
by its Attorneys ROB FREEMAN
And ROSS PENDLEBURY
pursuant to Power of Attorney Registered
Book 4616 No. 12 and we declare that
We have no notice of the revocation of the
said Power of Attorney in the presence of

Karen Ingram.
Witness

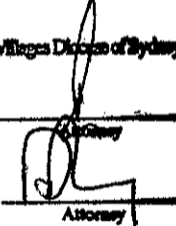
Attorney
12/3/2012
Date

SIGNED SEALED AND DELIVERED
for and on behalf of Ausgrid
by KATHERINE MARGARET GUNTON
its duly constituted Attorney pursuant
to Power of Attorney registered
Book 4528 No. 401


Attorney

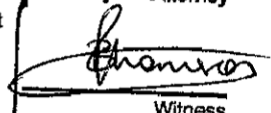
Witness

* OFFICE USE ONLY

21 April 2016

PBS Building
Unit 18, 11-21 Underwood Rd
HOMEBUSH NSW 2140

Dear Roi


Warriewood ARV Survey Set-out

Land Surveys are engaged on the Warriewood ARV project with PBS Building to carry out all survey related activities. All buildings were set out using the data from the Architectural Set-out Plan which was current at the time of survey.


Yours sincerely




Jarrod Renall
NSW Operations Manager

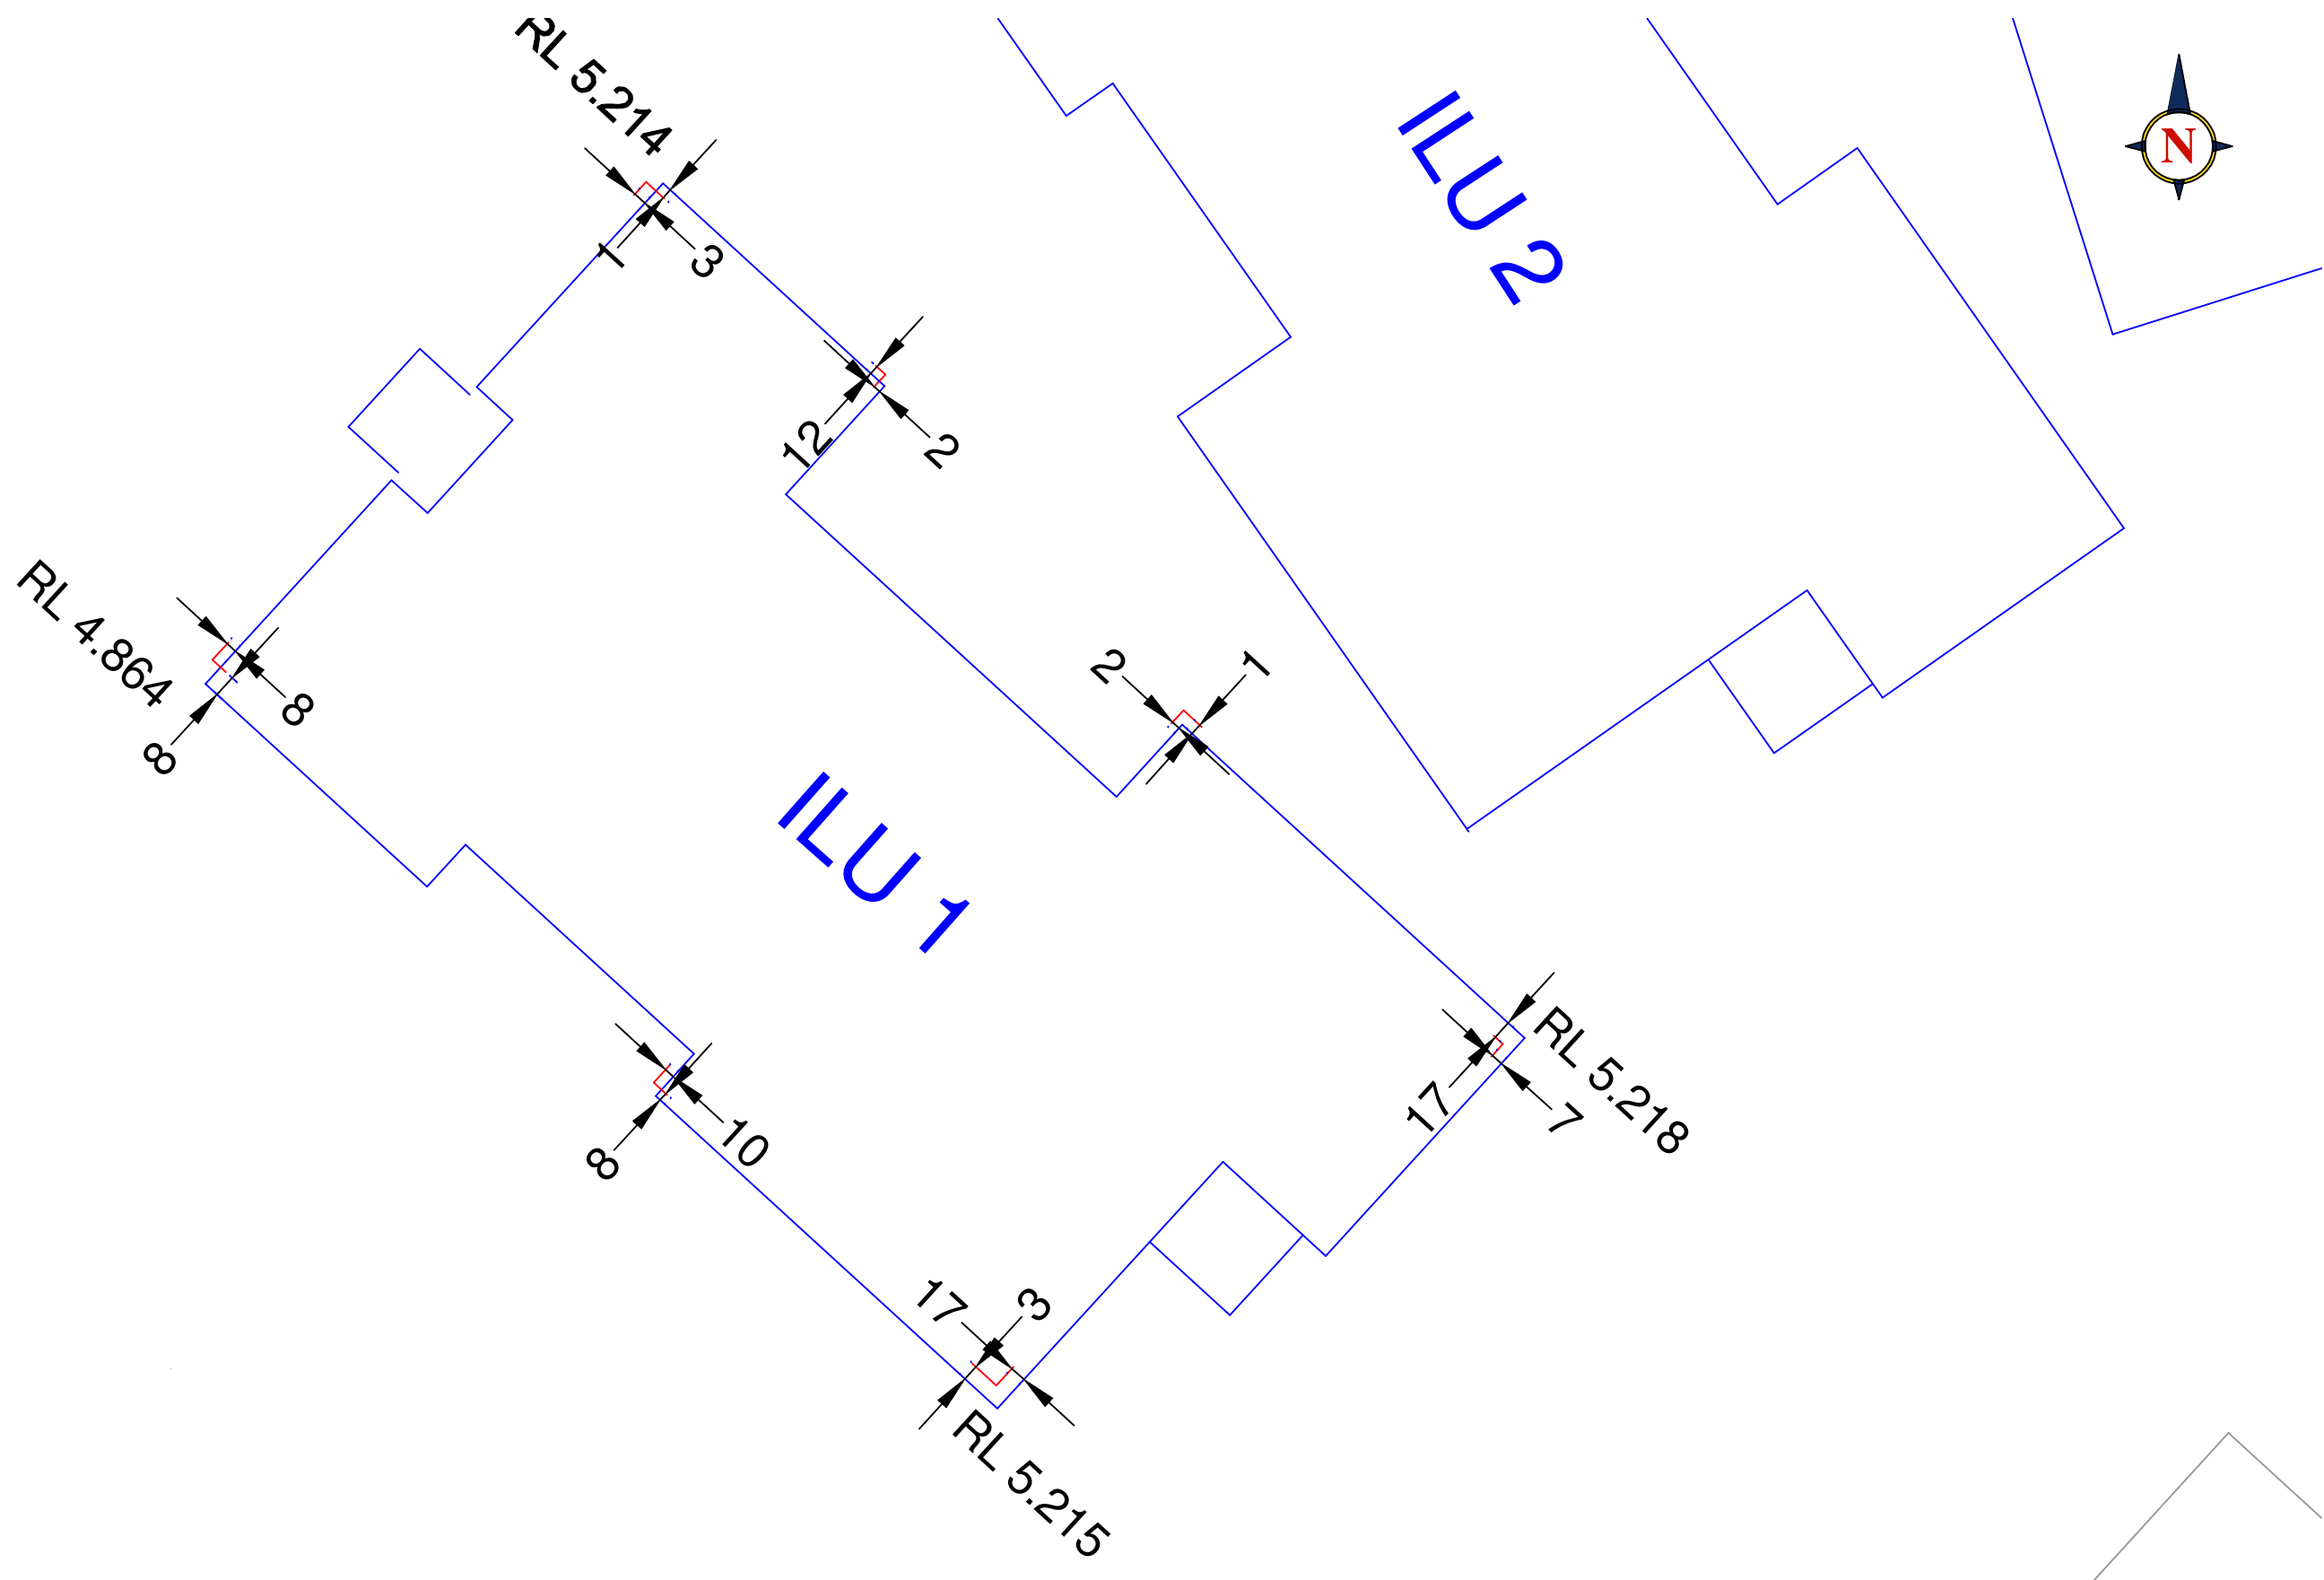



Land Surveys Sydney Office T (02) 8935 9451 F (02) 8935 9401 www.landsurveys.net.au E sydney@landsurveys.net.au SCALE : 1: 100 ORIGINAL SIZE : 100 012345	0	14/7/15	ISSUED TO CLIENT	SURVEYOR : DB	TITLE: SKETCH SHOWING FORMWORK CHECK OF ILU 1	CLIENT: PBS BUILDING	
				SURVEY DATE : 14/7/15		JOB No : 1500259	
				DRAWN : DB	PROJECT: WARRIEWOOD ARV	DWG No : 028	
				APPROVED : JR		REV 0	
				PBSBUILDING			
	REVISION	DATE	DESCRIPTION				

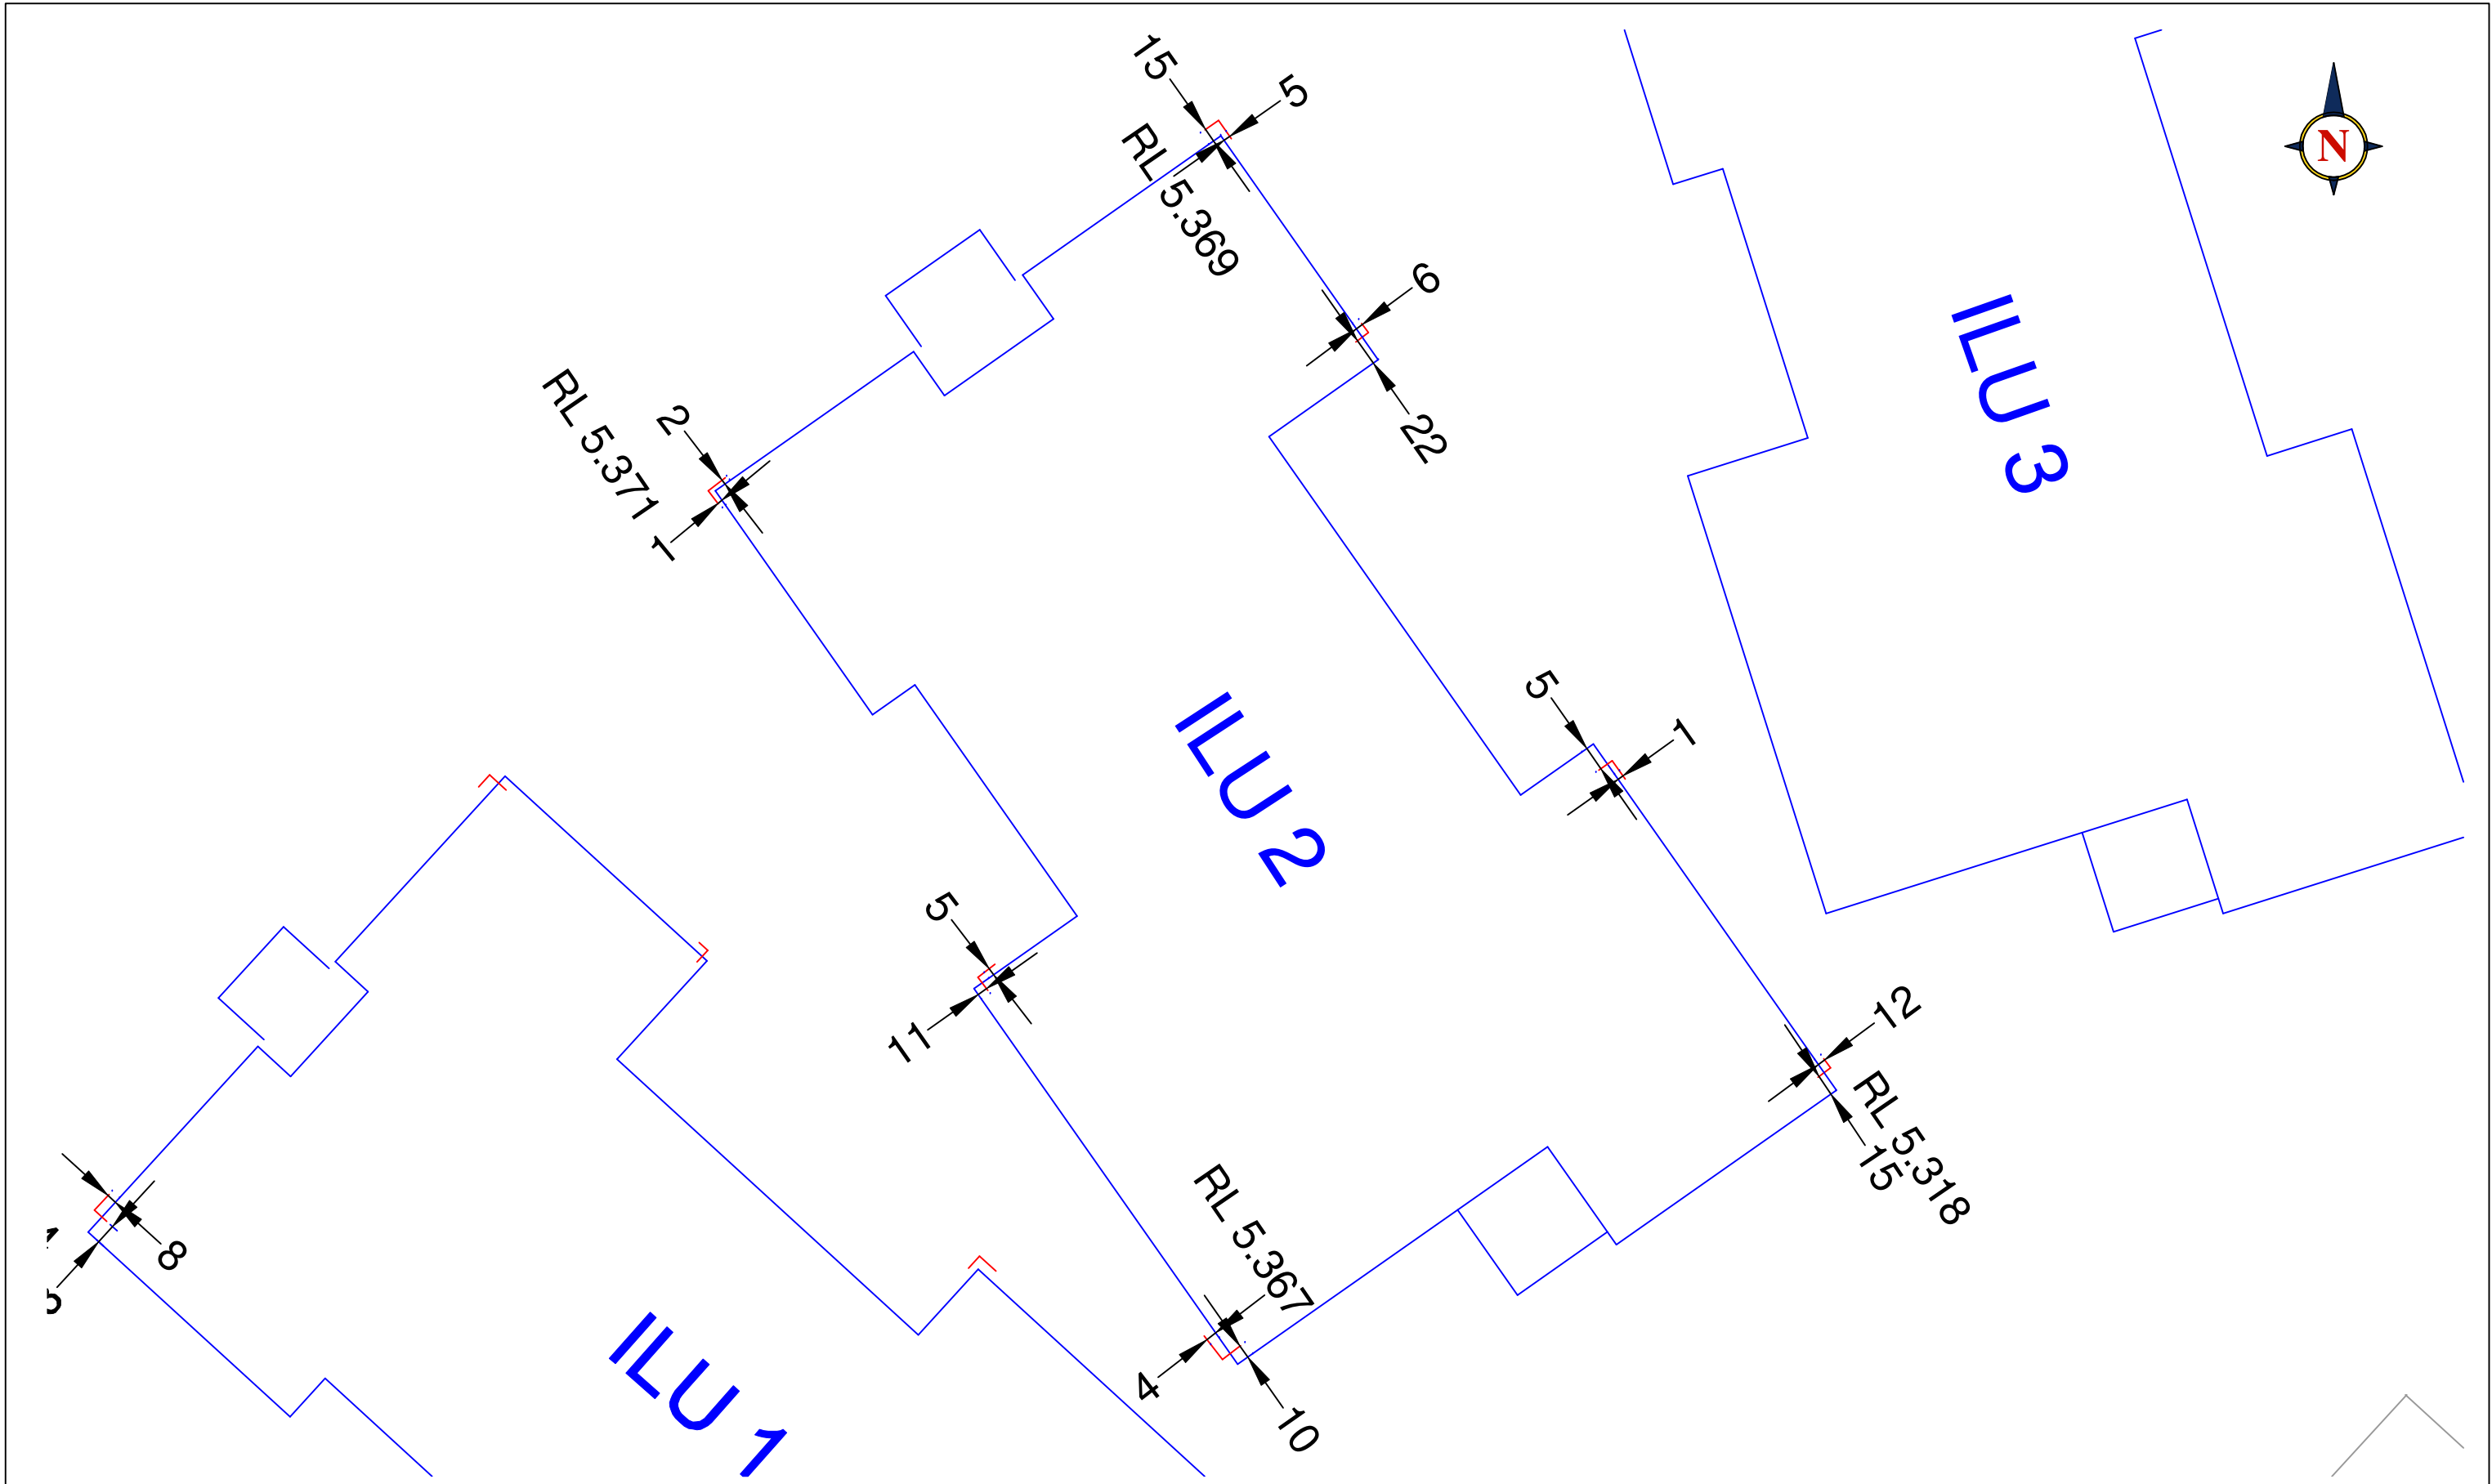

Land Surveys Sydney Office T (02) 8935 9451 F (02) 8935 9401 www.landsurveys.net.au E sydney@landsurveys.net.au Suite 3, 78 Reserve Road Artarmon NSW 2064 SCALE : 1: 100 ORIGINAL SIZE : 1 0 1 2 3 4 5	0	14/7/15	ISSUED TO CLIENT	SURVEYOR : DB	TITLE: SKETCH SHOWING FORMWORK CHECK OF ILU 2	CLIENT: PBS BUILDING		
				SURVEY DATE : 14/7/15		JOB No : 1500259		
				DRAWN : DB	PROJECT: WARRIEWOOD ARV	DWG No : 029 REV 0		
				APPROVED : JR				
				PBSBUILDING				
	REVISION	DATE	DESCRIPTION					

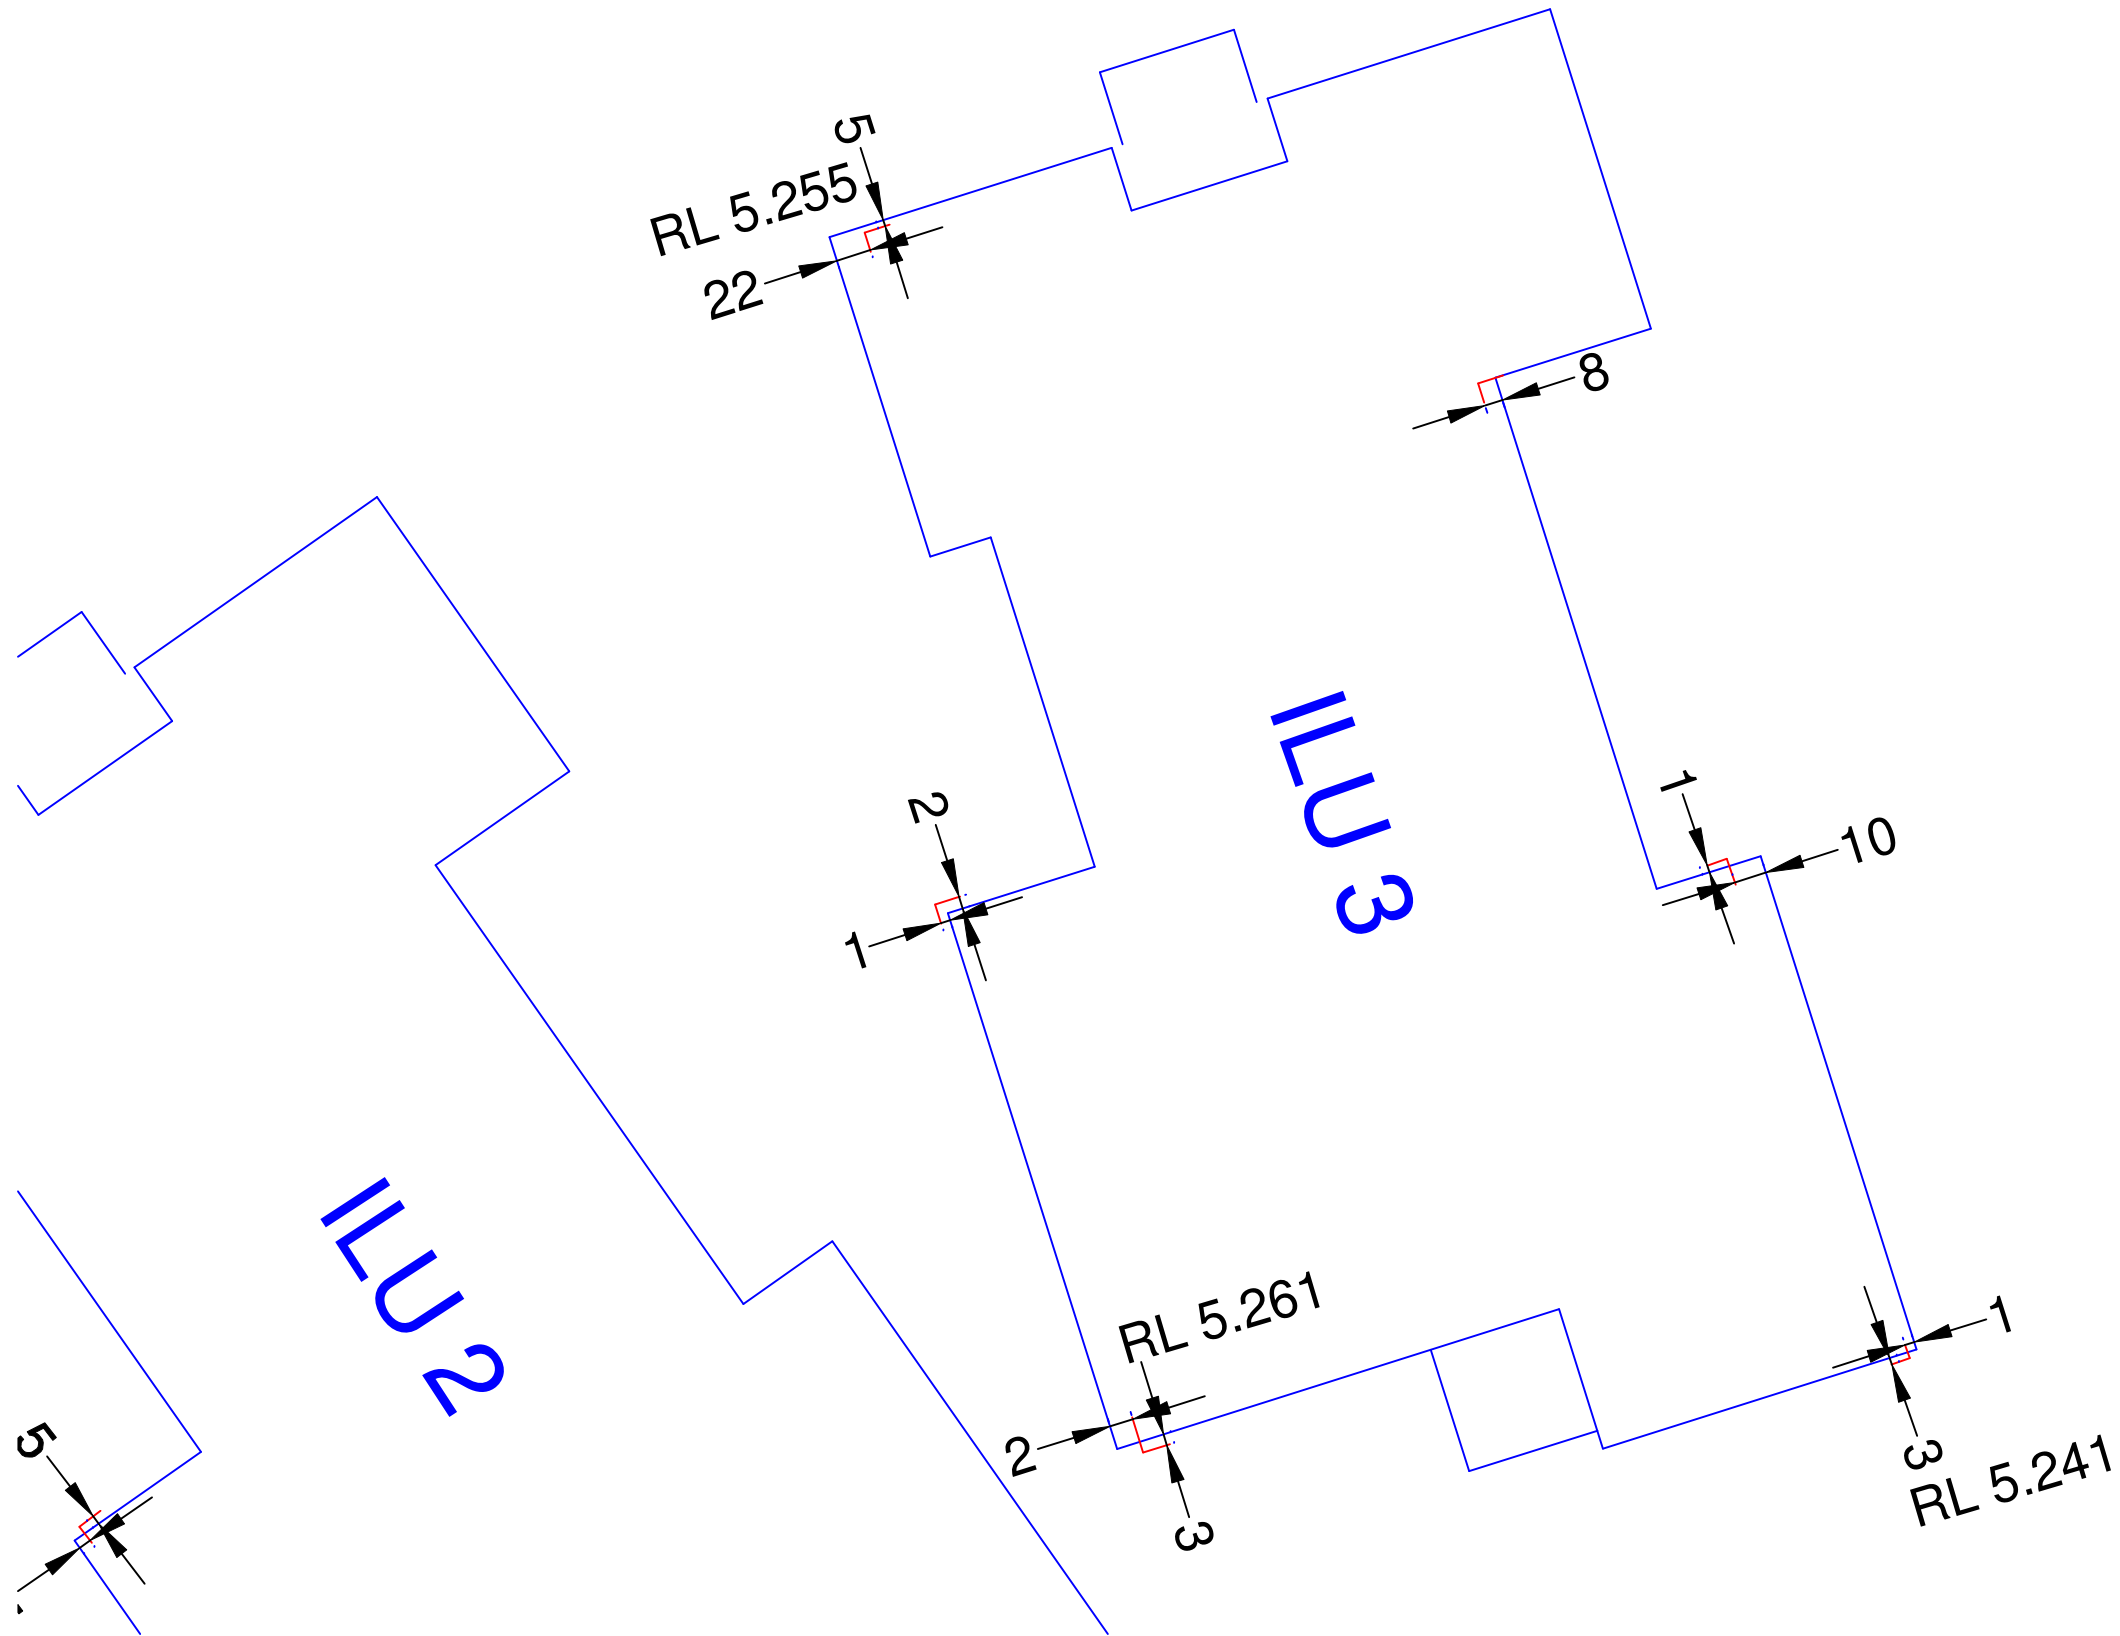


Land Surveys Sydney Office Suite 3, 78 Reserve Road Artarmon NSW 2064 T (02) 8935 9451 F (02) 8935 9401 www.landsurveys.net.au E sydney@landsurveys.net.au SCALE : 1: 100 ORIGINAL SIZE : 	0	14/7/15	ISSUED TO CLIENT	SURVEYOR : DB	TITLE: SKETCH SHOWING FORMWORK CHECK OF ILU 3	CLIENT: PBS BUILDING	
				SURVEY DATE : 14/7/15			
				DRAWN : DB	PROJECT: WARRIEWOOD ARV	JOB No : 1500259	
				APPROVED : JR			
						DWG No : 030	REV 0
	REVISION	DATE	DESCRIPTION				

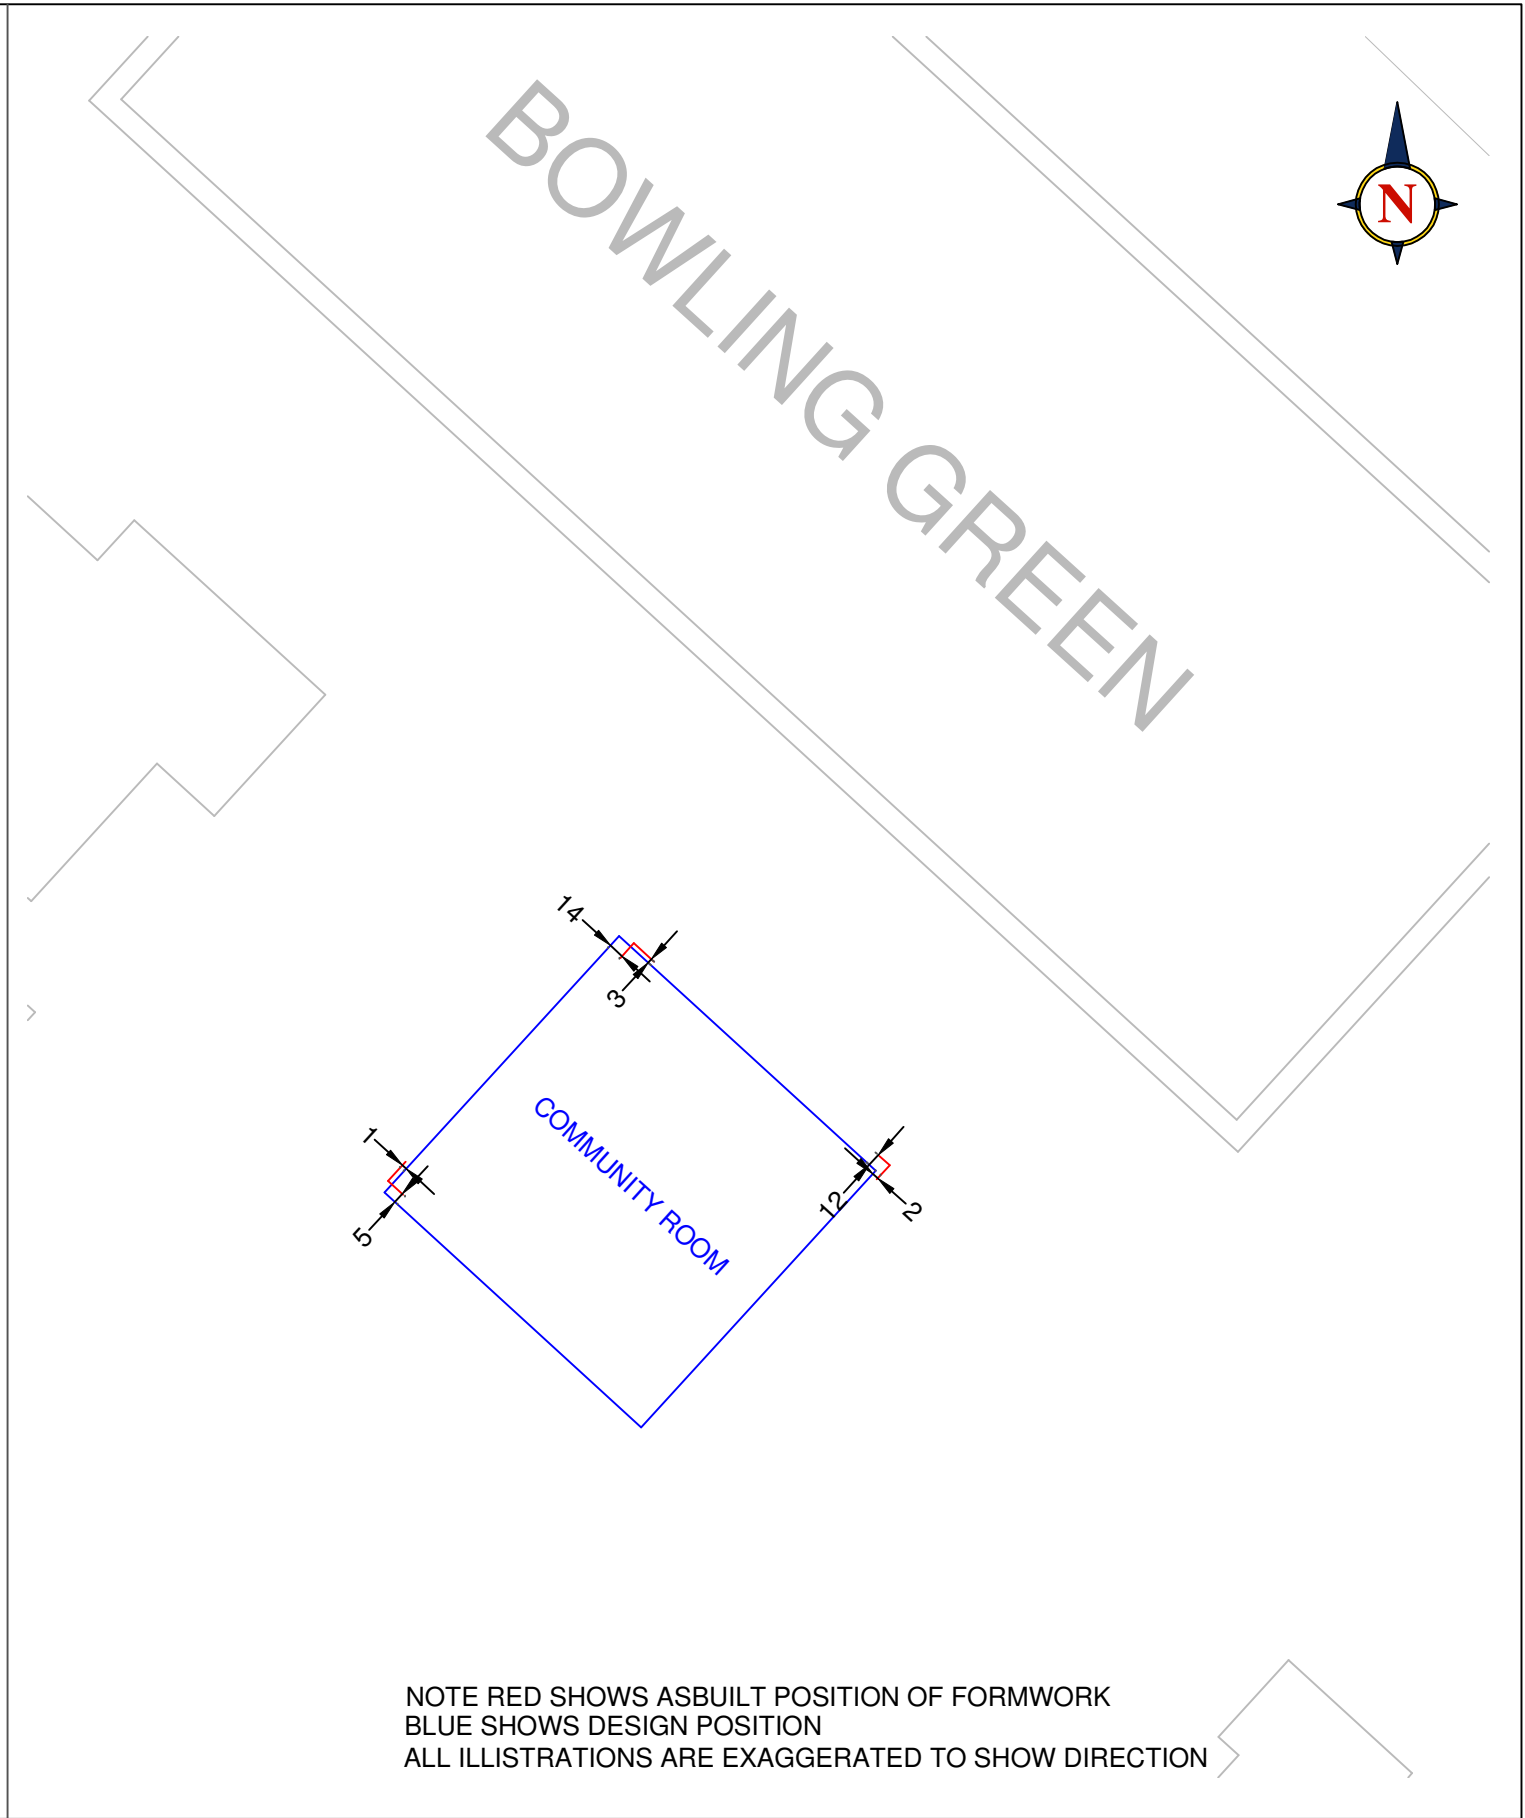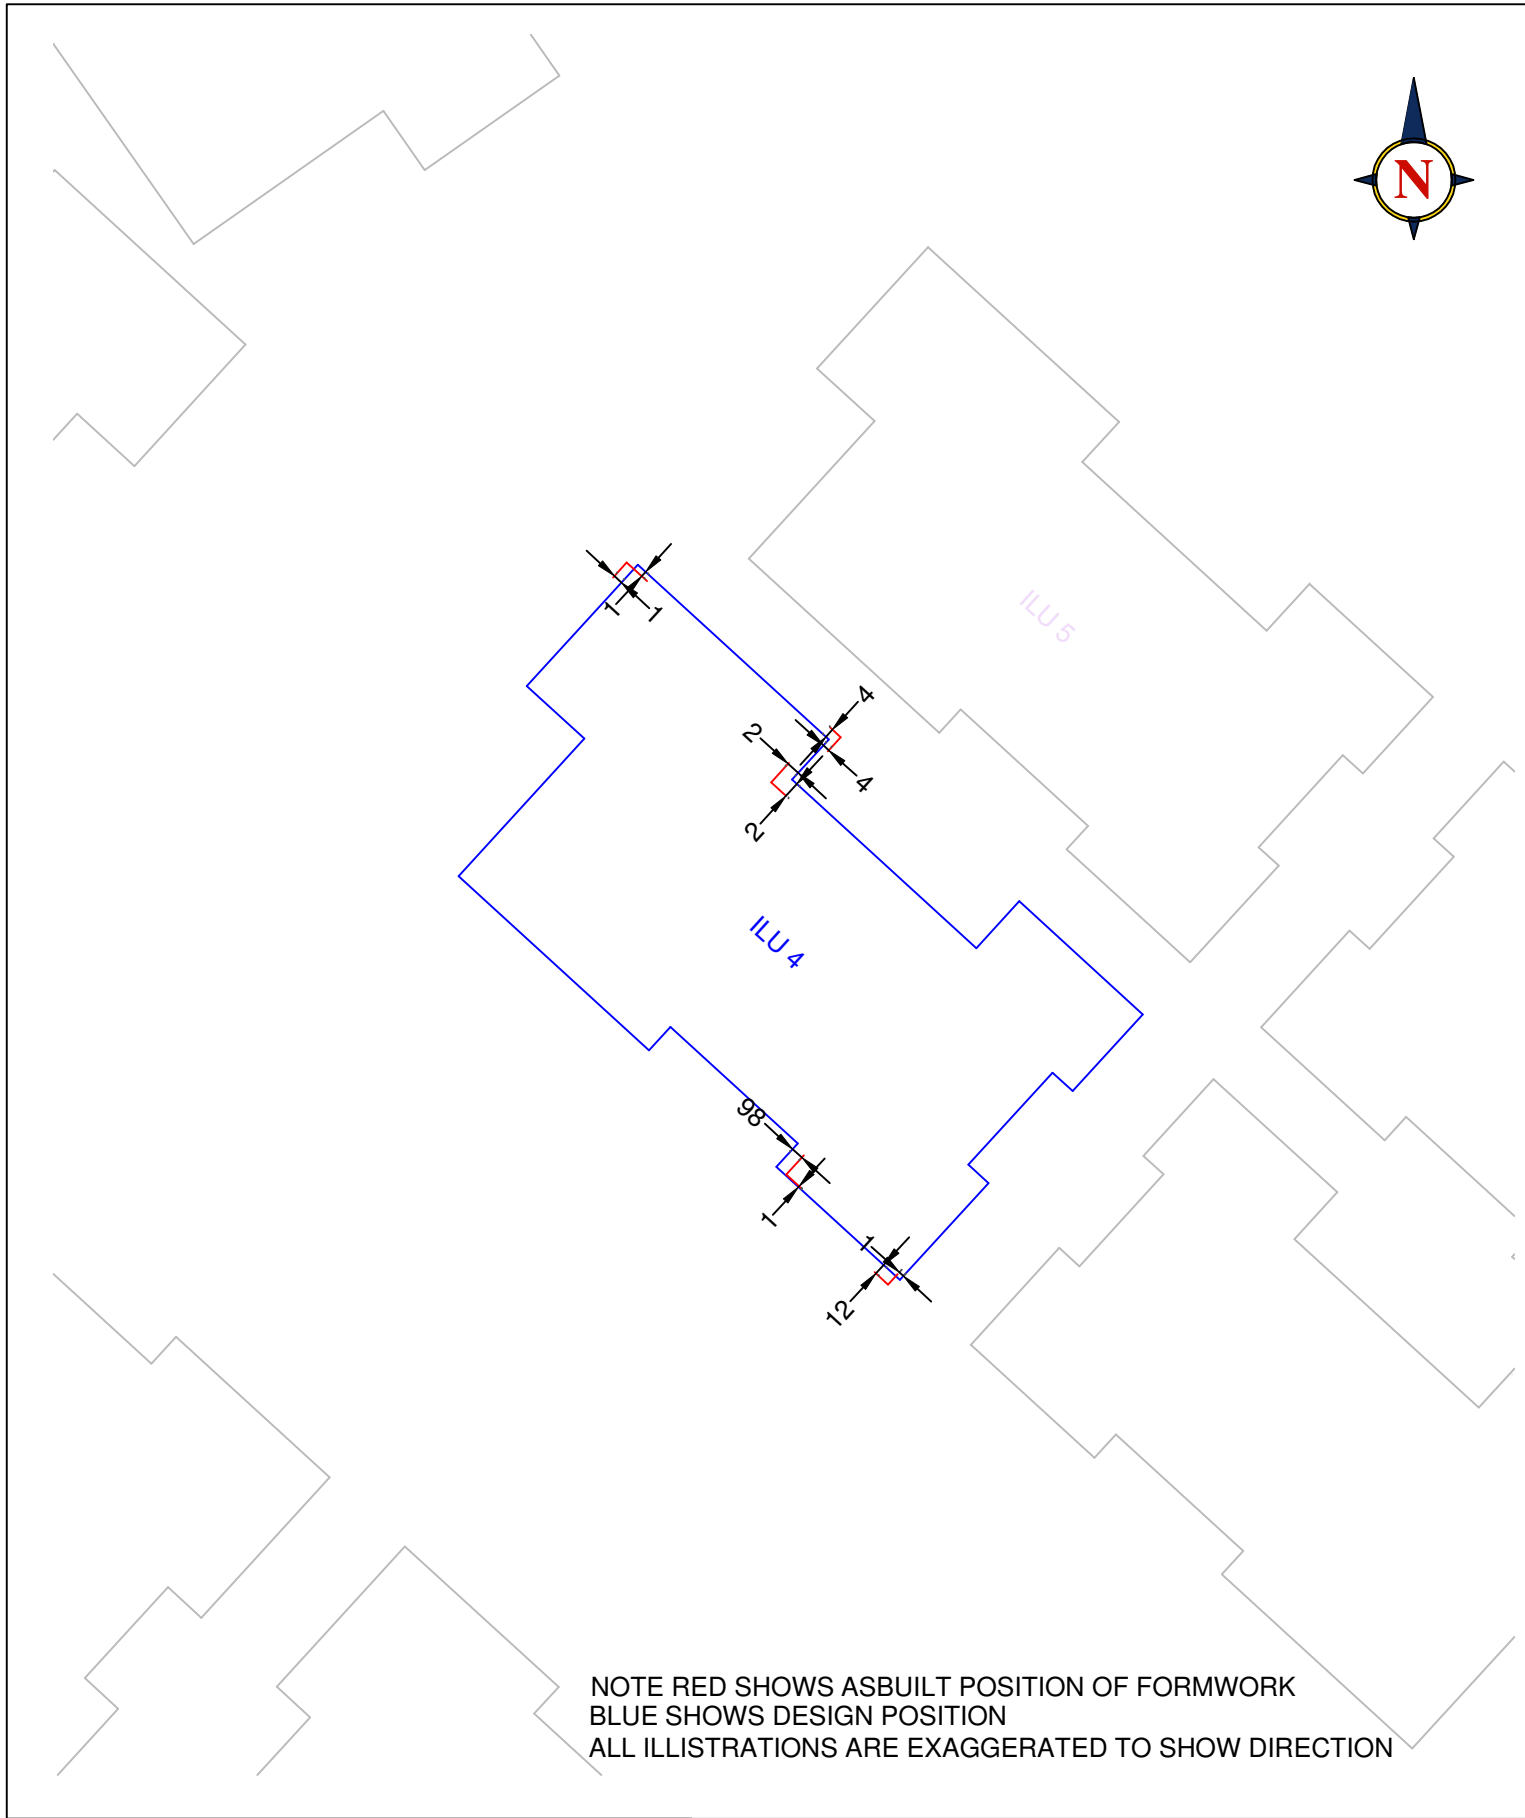

Land Surveys Level 5, 7 Eden Park Drive Macquarie NSW 2113 T (02) 8935 9451 F (02) 8935 9401 www.landsurveys.net.au E sydney@landsurveys.net.au	1	15/4/15	ISSUED TO CLIENT	SURVEYOR : DB	TITLE: SKETCH SHOWING FORMWORK CHECKS	CLIENT: PBS BUILDING	
				SURVEY DATE : 15/4/15			
				DRAWN : DB	PROJECT: WARRIEWOOD ARV	JOB No : 1500259	
				APPROVED : JR			
SCALE : 1: 200 ORIGINAL SIZE :	REVISION	DATE	DESCRIPTION	 PBS BUILDING		DWG No : 013	REV 1



BOWLING GREEN

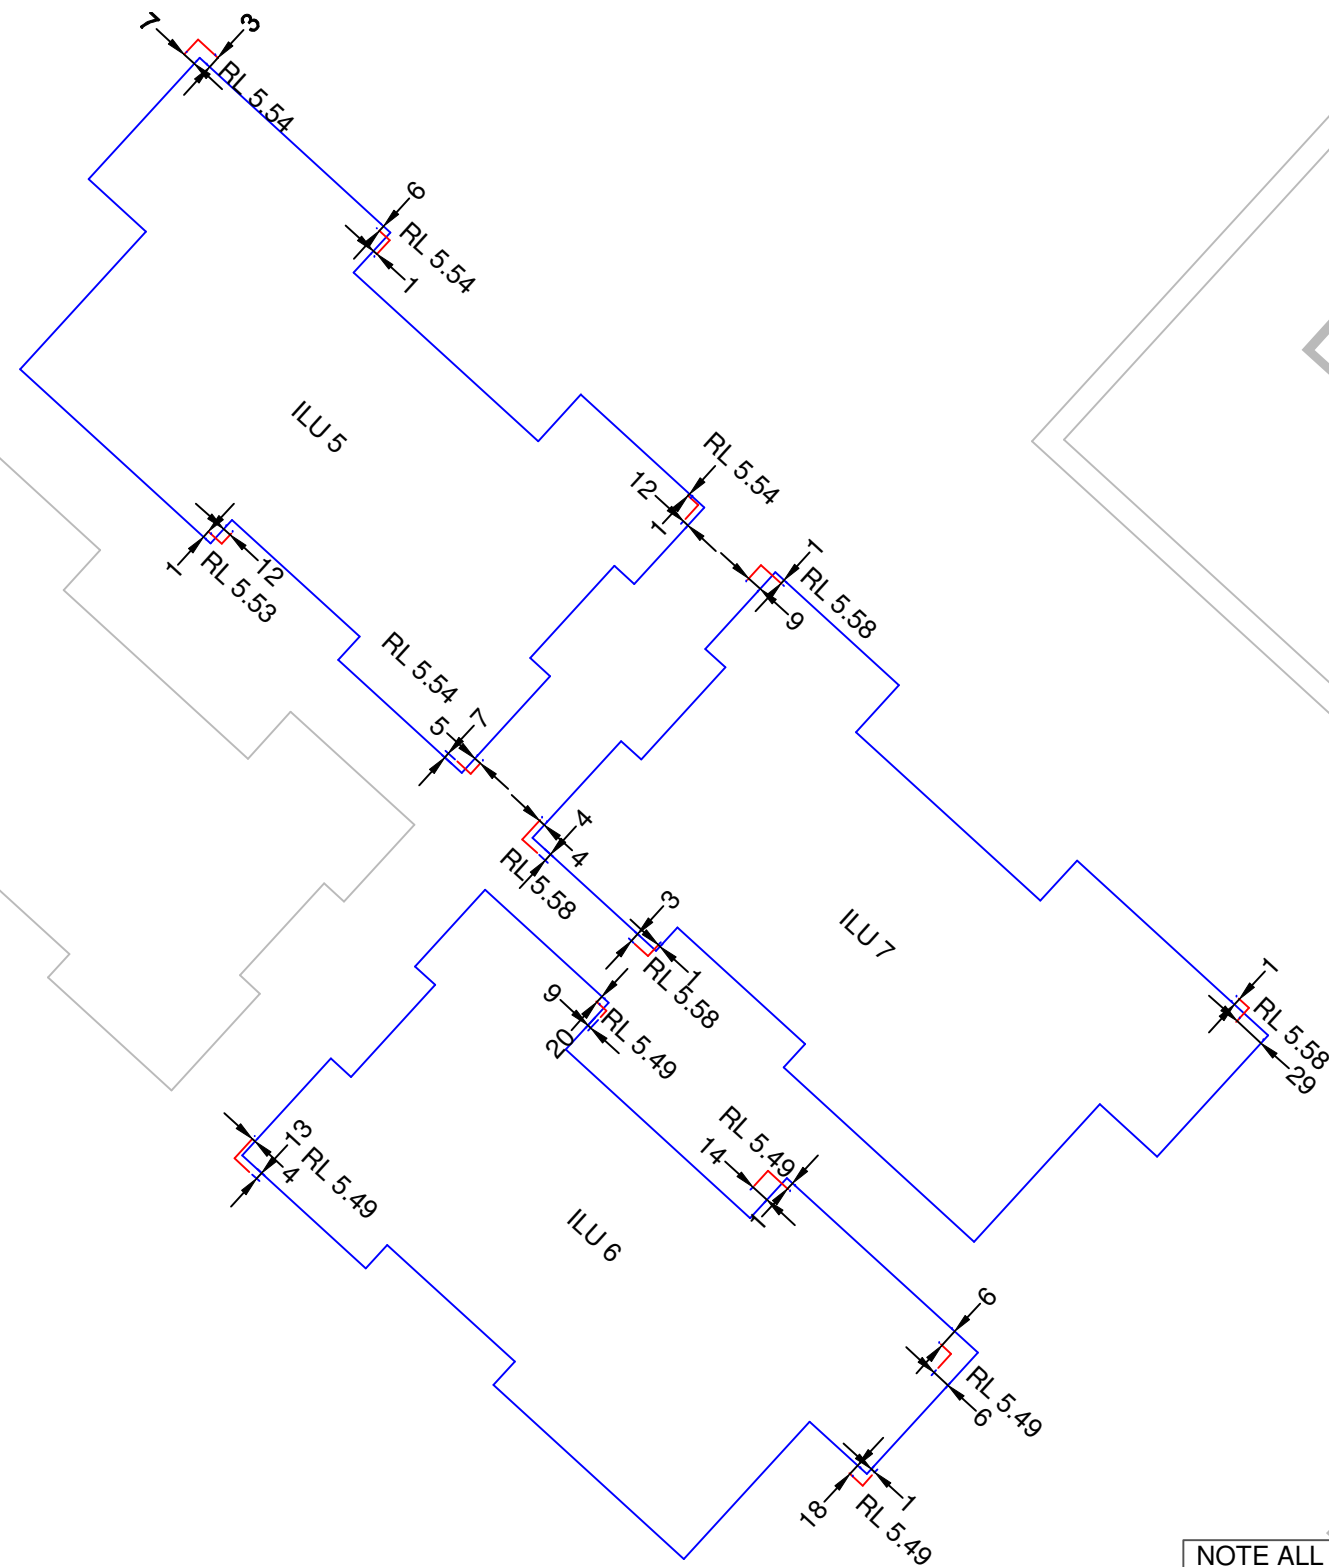

NOTE ALL ASBUILT POSITIONS ARE EXAGGERATED TO SHOW DIRECTION
RED SHOWS ASBUILT POSITION
BLUE SHOWS DESIGN POSITION
ALL DIMENSIONS ARE IN MM
RL AT SLAB HEIGHT

Land Surveys


Level 5, 7 Eden Park Drive
Macquarie NSW 2113
T (02) 8935 9451
F (02) 8935 9401
www.landsurveys.net.au
E sydney@landsurveys.net.au

SCALE :
1: 200
ORIGINAL SIZE :

0	9/4/15	ISSUED TO CLIENT
REVISION	DATE	DESCRIPTION


SURVEYOR : DB
SURVEY DATE : 9/4/15
DRAWN : DB
APPROVED : JR
 PBS BUILDING

TITLE: SKETCH SHOWING POSITION OF FORMWORK	CLIENT: PBS BUILDING
PROJECT: WARRIEWOOD ARV	JOB No : 1500259
	DWG No : 010
	REV 0

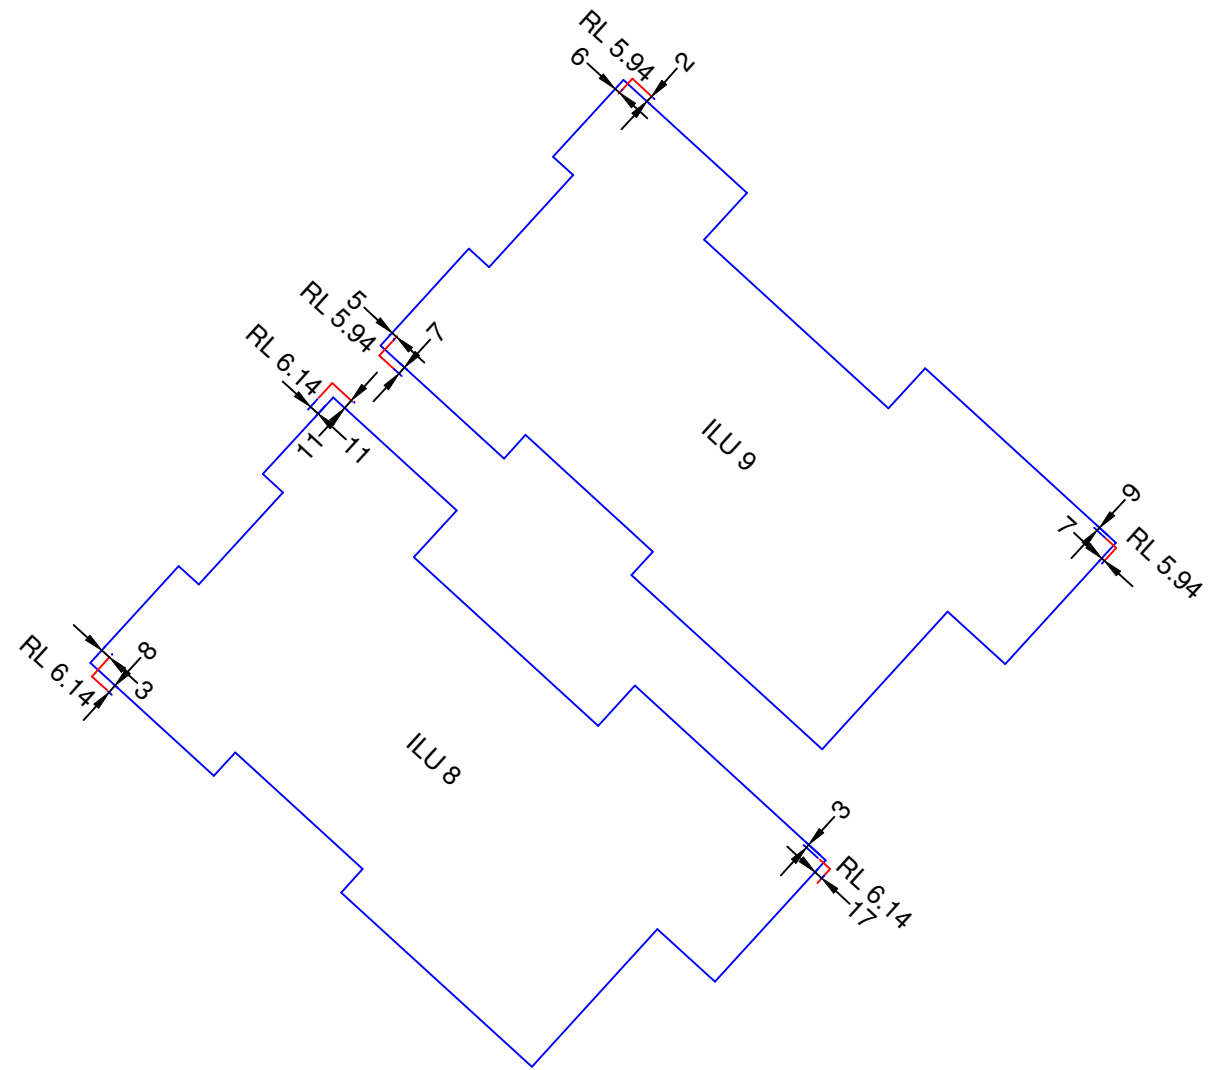


NOTE ALL ASBUILT POSITIONS ARE EXAGGERATED TO SHOW DIRECTION
RED SHOWS ASBUILT POSITION
BLUE SHOWS DESIGN POSITION
ALL DIMENSIONS ARE IN MM
RL AT SLAB HEIGHT


Land Surveys Level 5, 7 Eden Park Drive Macquarie NSW 2113 T (02) 8935 9451 F (02) 8935 9401 www.landsurveys.net.au E sydney@landsurveys.net.au	0	9/4/15	ISSUED TO CLIENT	SURVEYOR : DB	TITLE: SKETCH SHOWING POSITION OF FORMWORK	CLIENT: PBS BUILDING		
				SURVEY DATE : 9/4/15				
					DRAWN : DB	PROJECT: WARRIEWOOD ARV	JOB No : 1500259	
					APPROVED : JR			
SCALE : 1: 200 ORIGINAL SIZE :				PBSBUILDING		DWG No : 011	REV 0	
	REVISION	DATE	DESCRIPTION					

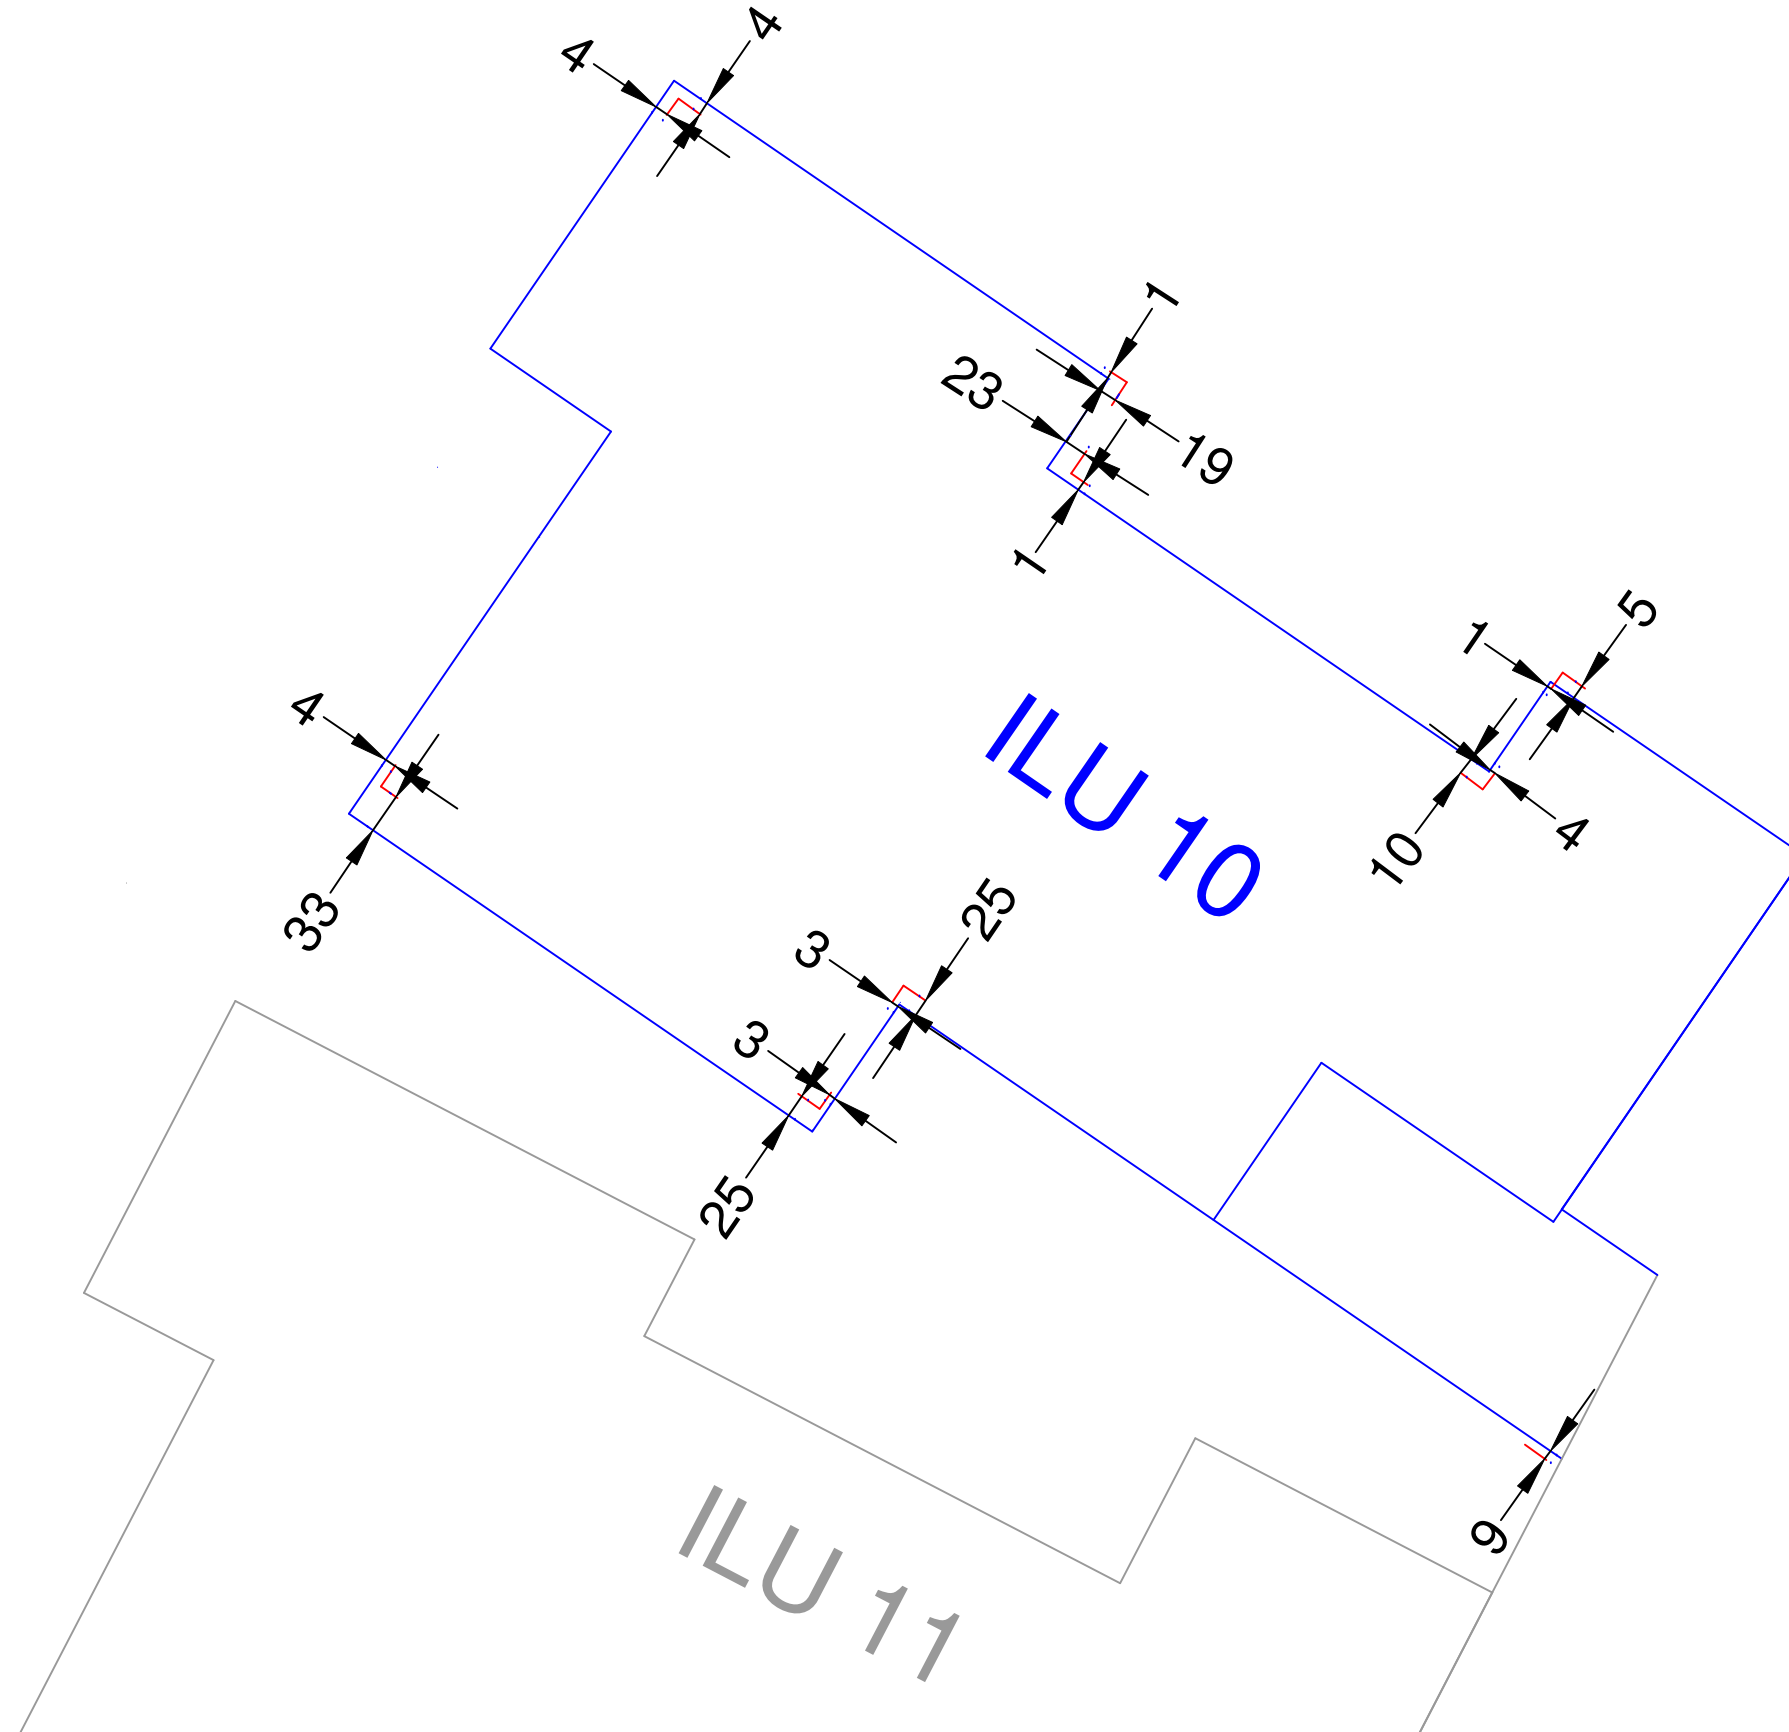


Land Surveys Sydney Office Suite 3, 78 Reserve Road Artarmon NSW 2064 T (02) 8935 9451 F (02) 8935 9401 www.landsurveys.net.au E sydney@landsurveys.net.au SCALE : 1: 100 ORIGINAL SIZE :	0	31/7/15	ISSUED TO CLIENT	SURVEYOR : DB	TITLE: SKETCH SHOWING FORMWORK CHECK OF ILU 10	CLIENT: PBS BUILDING	
				SURVEY DATE : 31/7/15			
				DRAWN : DB	PROJECT: WARRIEWOOD ARV	JOB No : 1500259	
				APPROVED : JR			
						DWG No : 034	REV 0
	REVISION	DATE	DESCRIPTION				

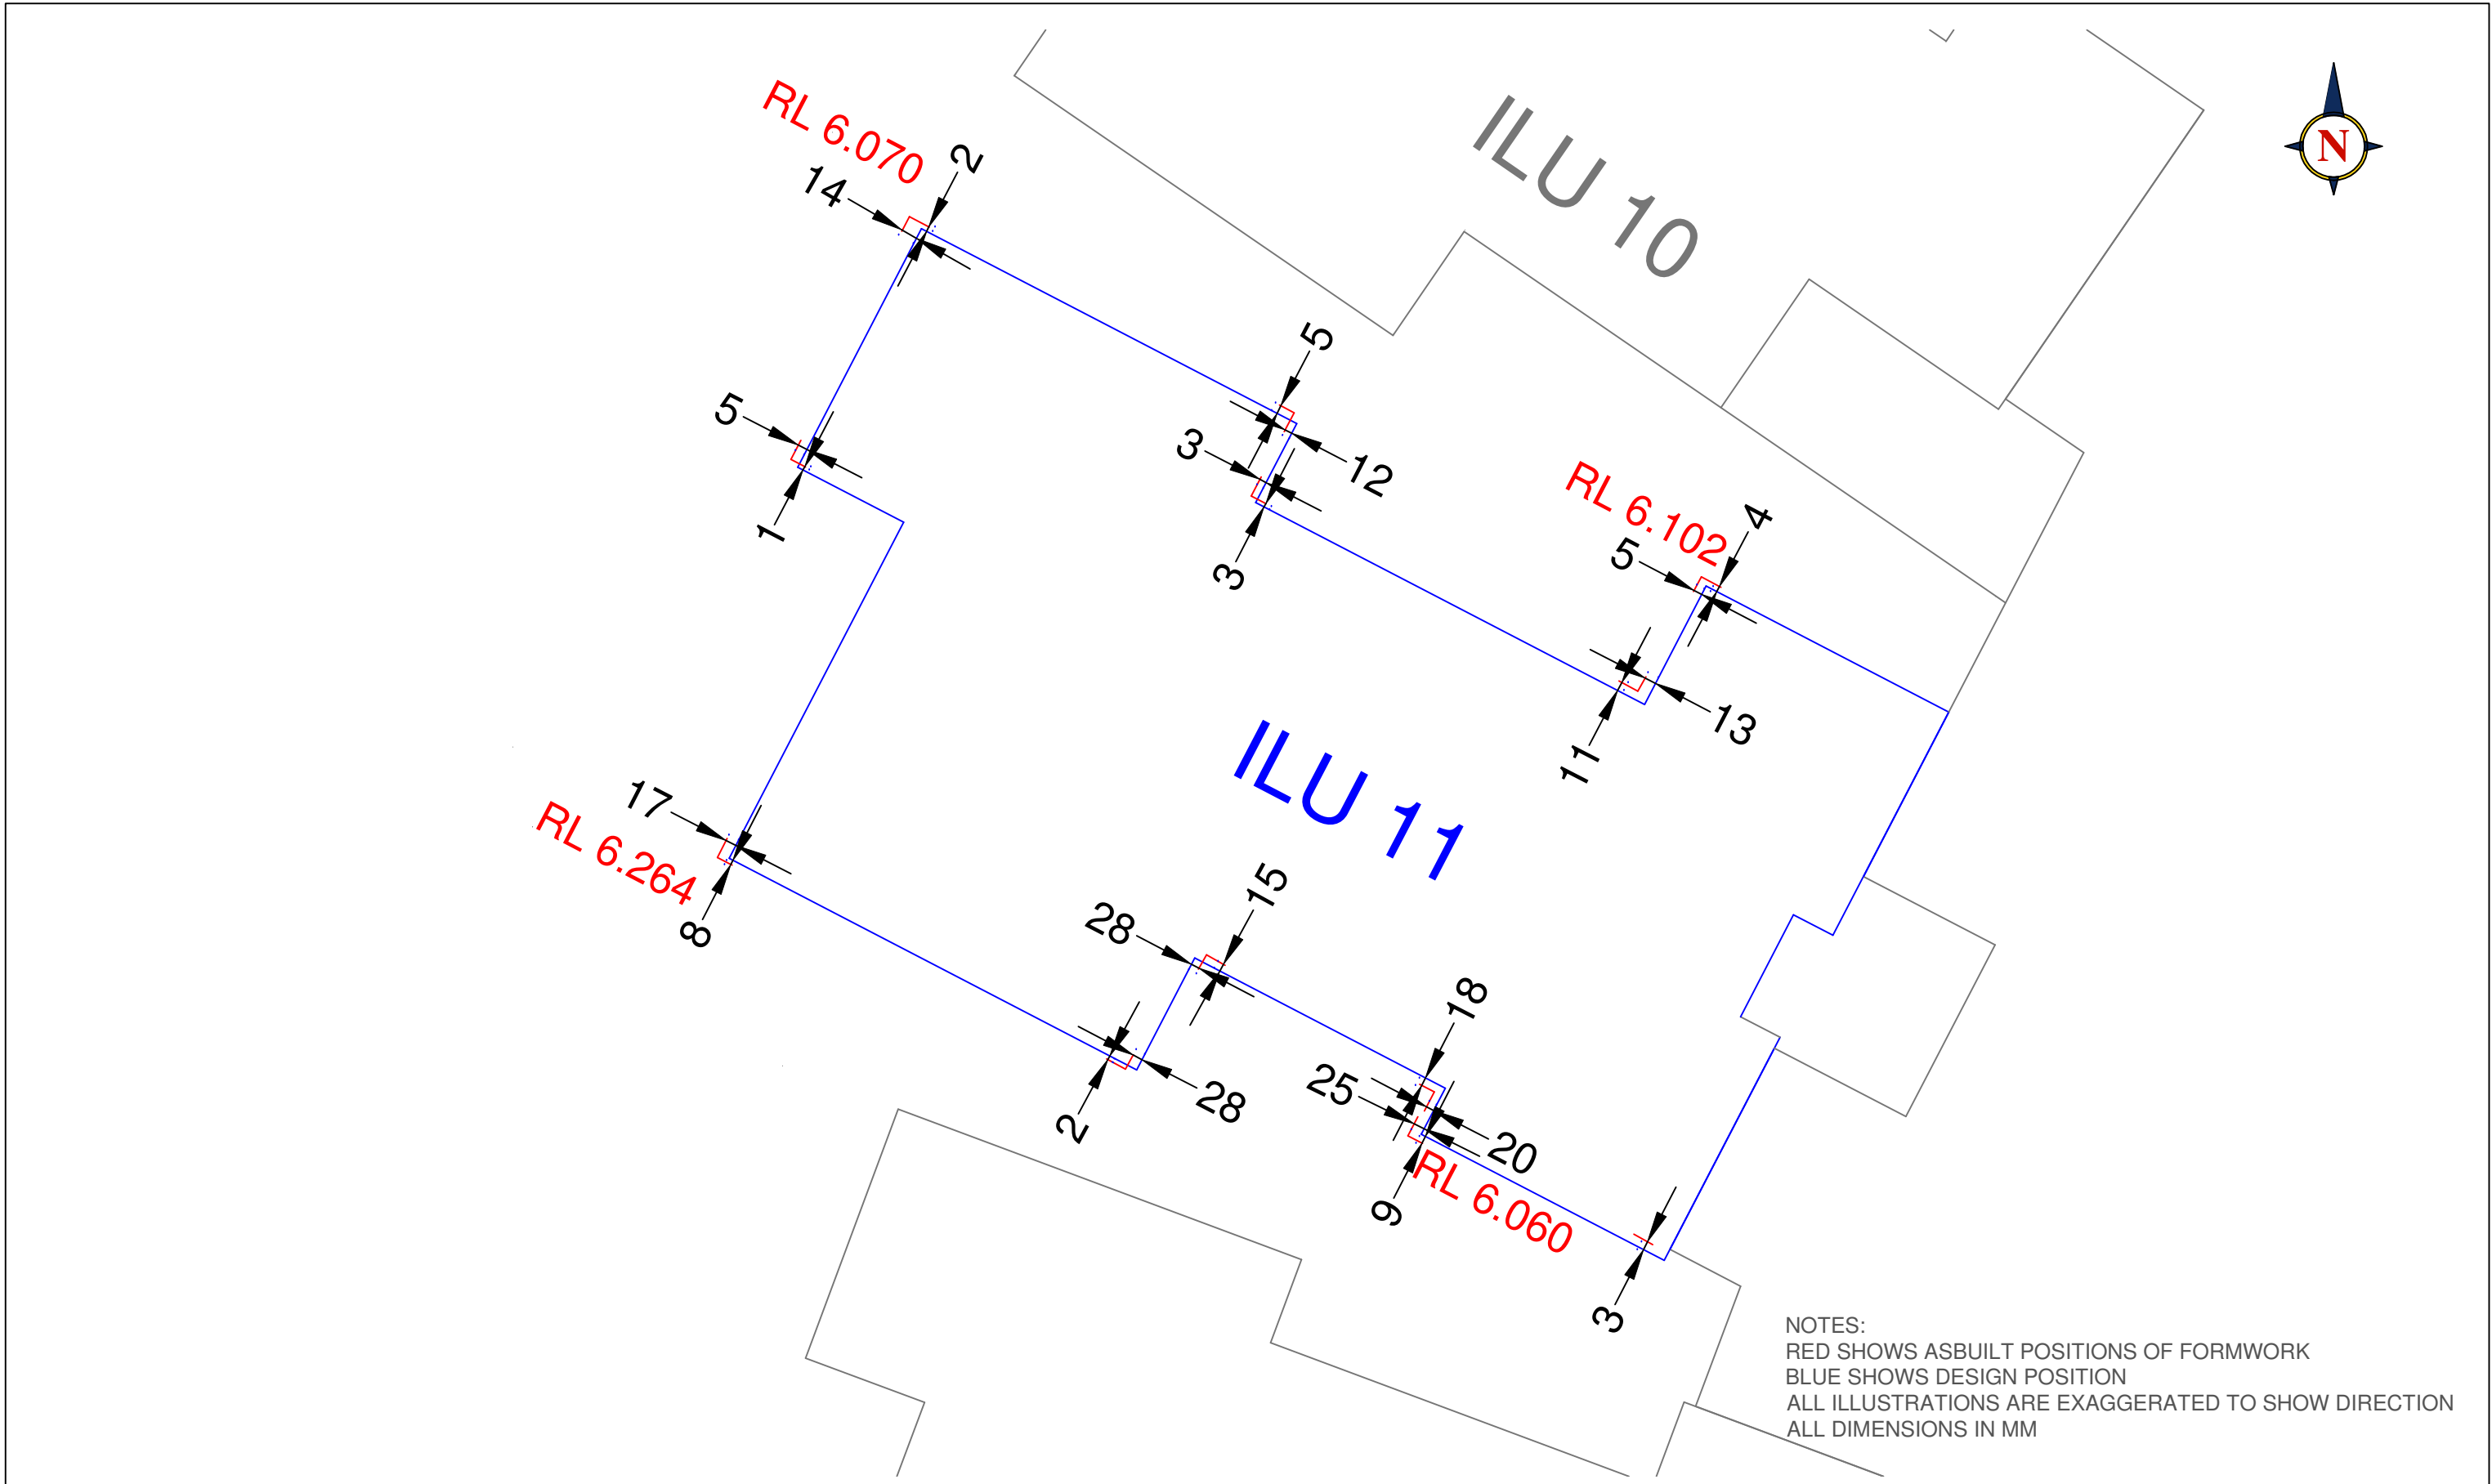


Land Surveys Sydney Office Suite 3, 78 Reserve Road Artarmon NSW 2064 T (02) 8935 9451 F (02) 8935 9401 www.landsurveys.net.au E sydney@landsurveys.net.au SCALE : 1: 100 ORIGINAL SIZE :	0	5/8/15	ISSUED TO CLIENT	SURVEYOR : DB	TITLE: SKETCH SHOWING FORMWORK CHECK OF ILU 11	CLIENT: PBS BUILDING	
				SURVEY DATE : 5/8/15			
				DRAWN : DB	PROJECT: WARRIEWOOD ARV	JOB No : 1500259	
				APPROVED : JR			
					DWG No : 035		REV 0
	REVISION	DATE	DESCRIPTION				

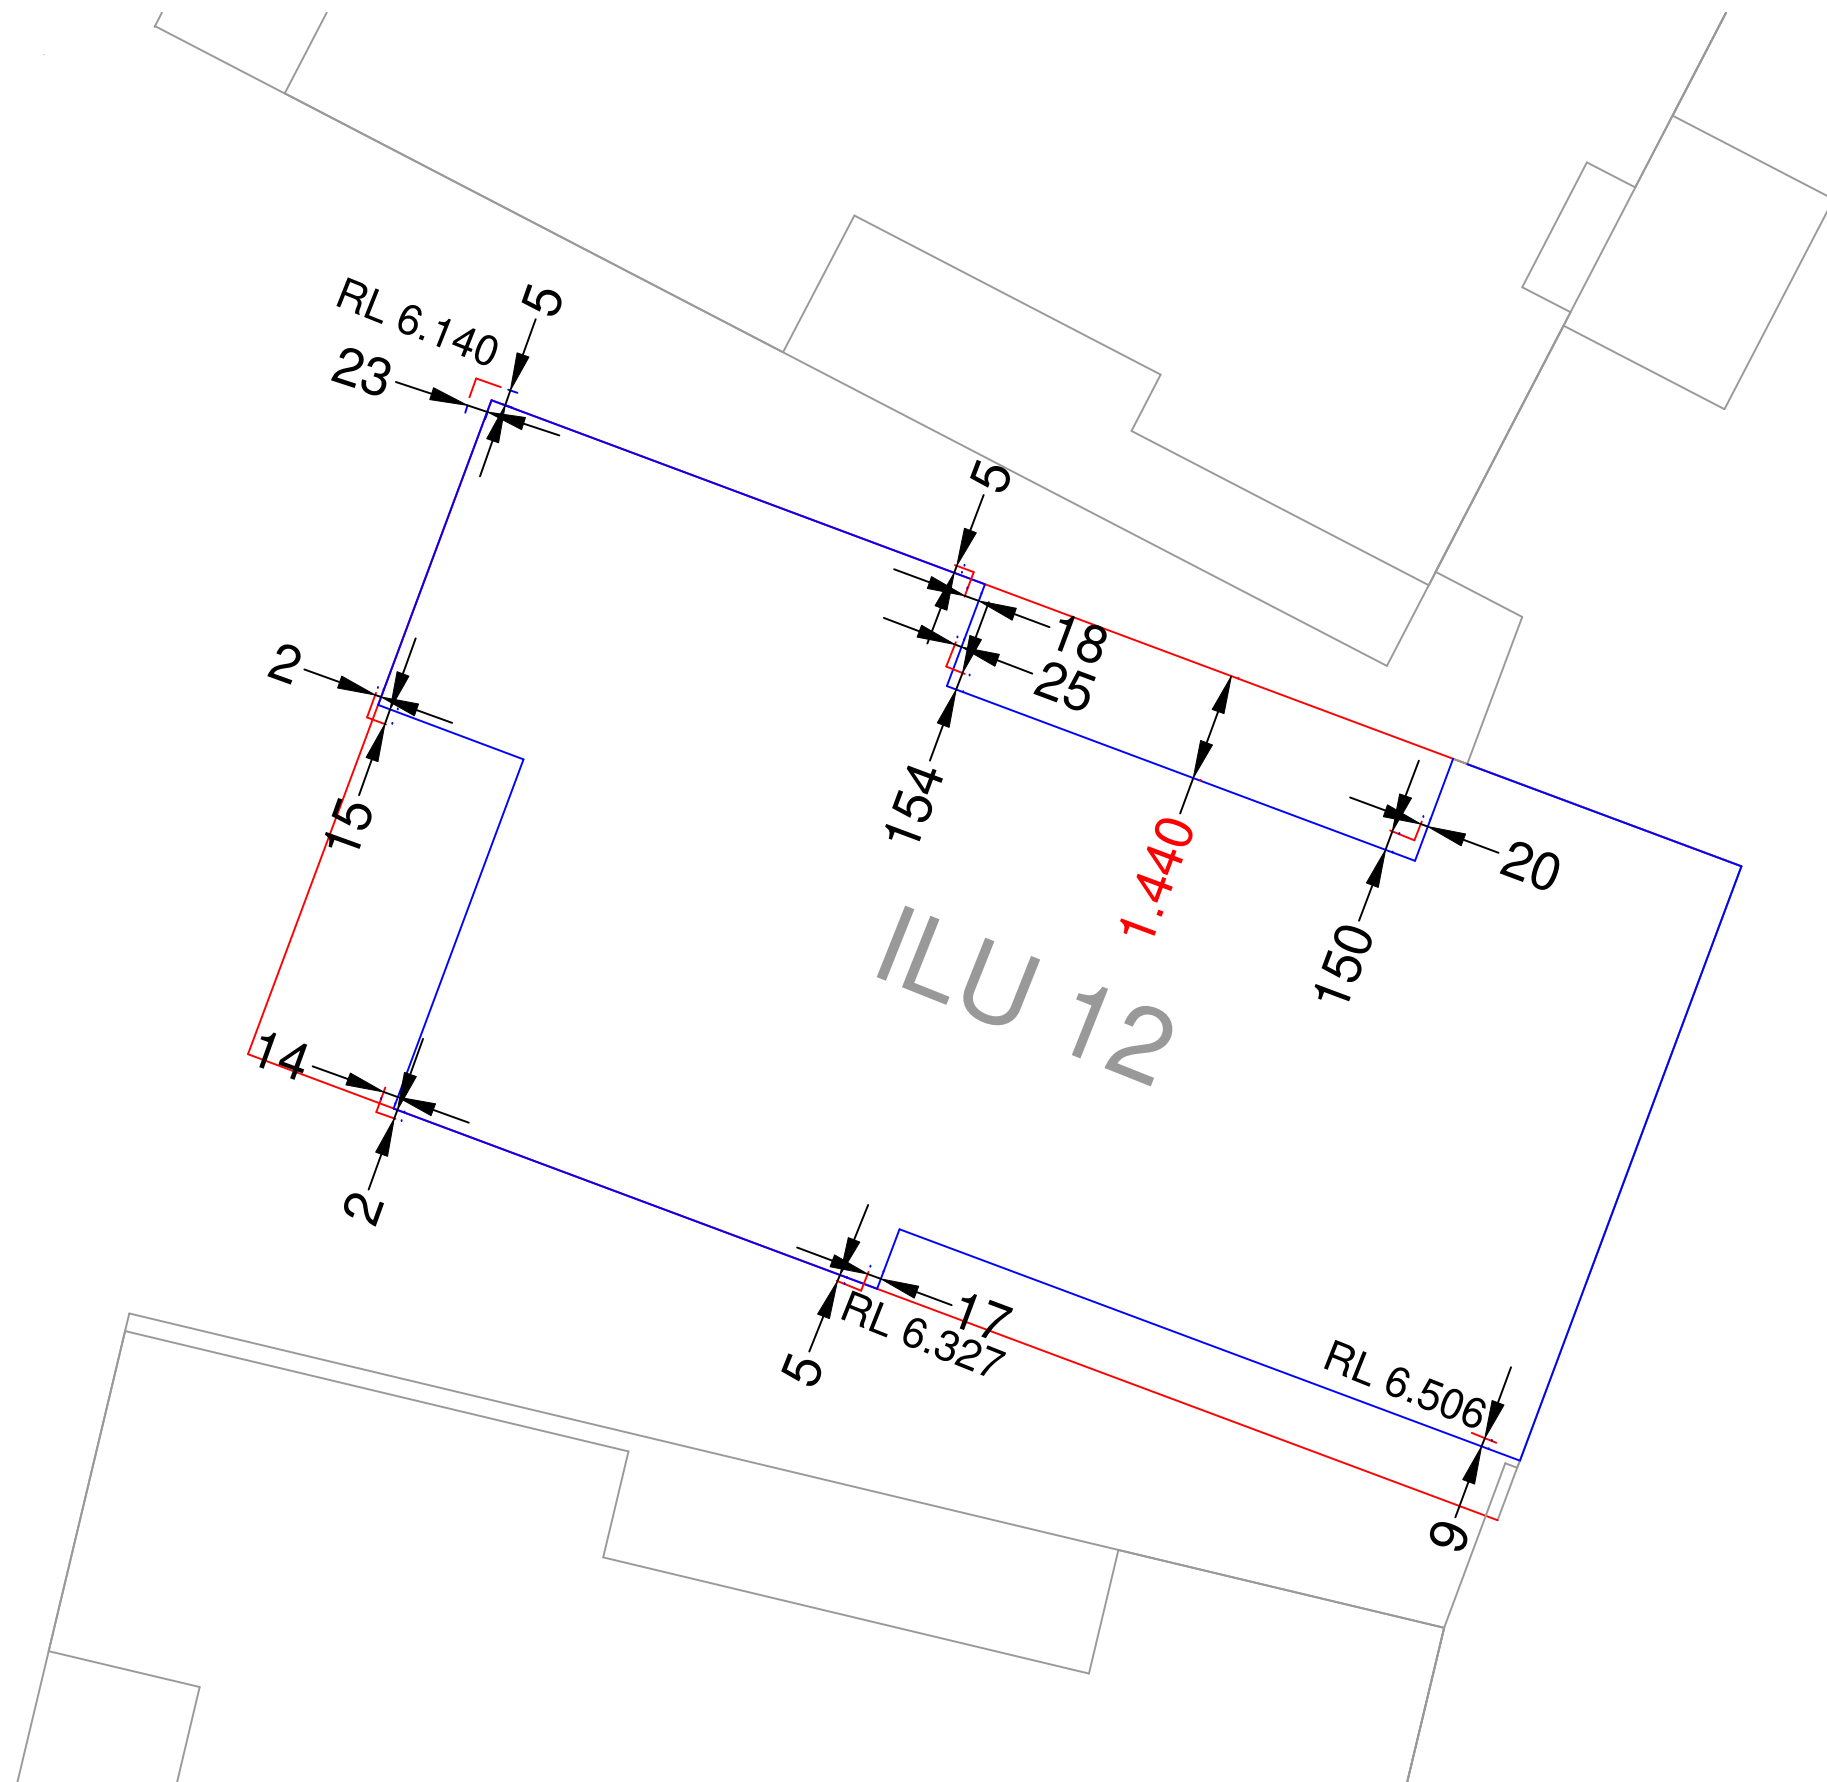


Land Surveys Sydney Office T (02) 8935 9451 F (02) 8935 9401 www.landsurveys.net.au E sydney@landsurveys.net.au Suite 3, 78 Reserve Road Artarmon NSW 2064 SCALE : 1: 100 ORIGINAL SIZE : 1 0 1 2 3 4 5	0	20/8/15	ISSUED TO CLIENT	SURVEYOR : DB	TITLE: FORMWORK CHECK OF ILU 12		CLIENT: PBS BUILDING	
				SURVEY DATE : 20/8/15				
				DRAWN : DB	PROJECT: WARRIEWOOD ARV		JOB No : 1500259	
				APPROVED : JR				
				PBSBUILDING			DWG No : 038	REV 0
	REVISION	DATE	DESCRIPTION					

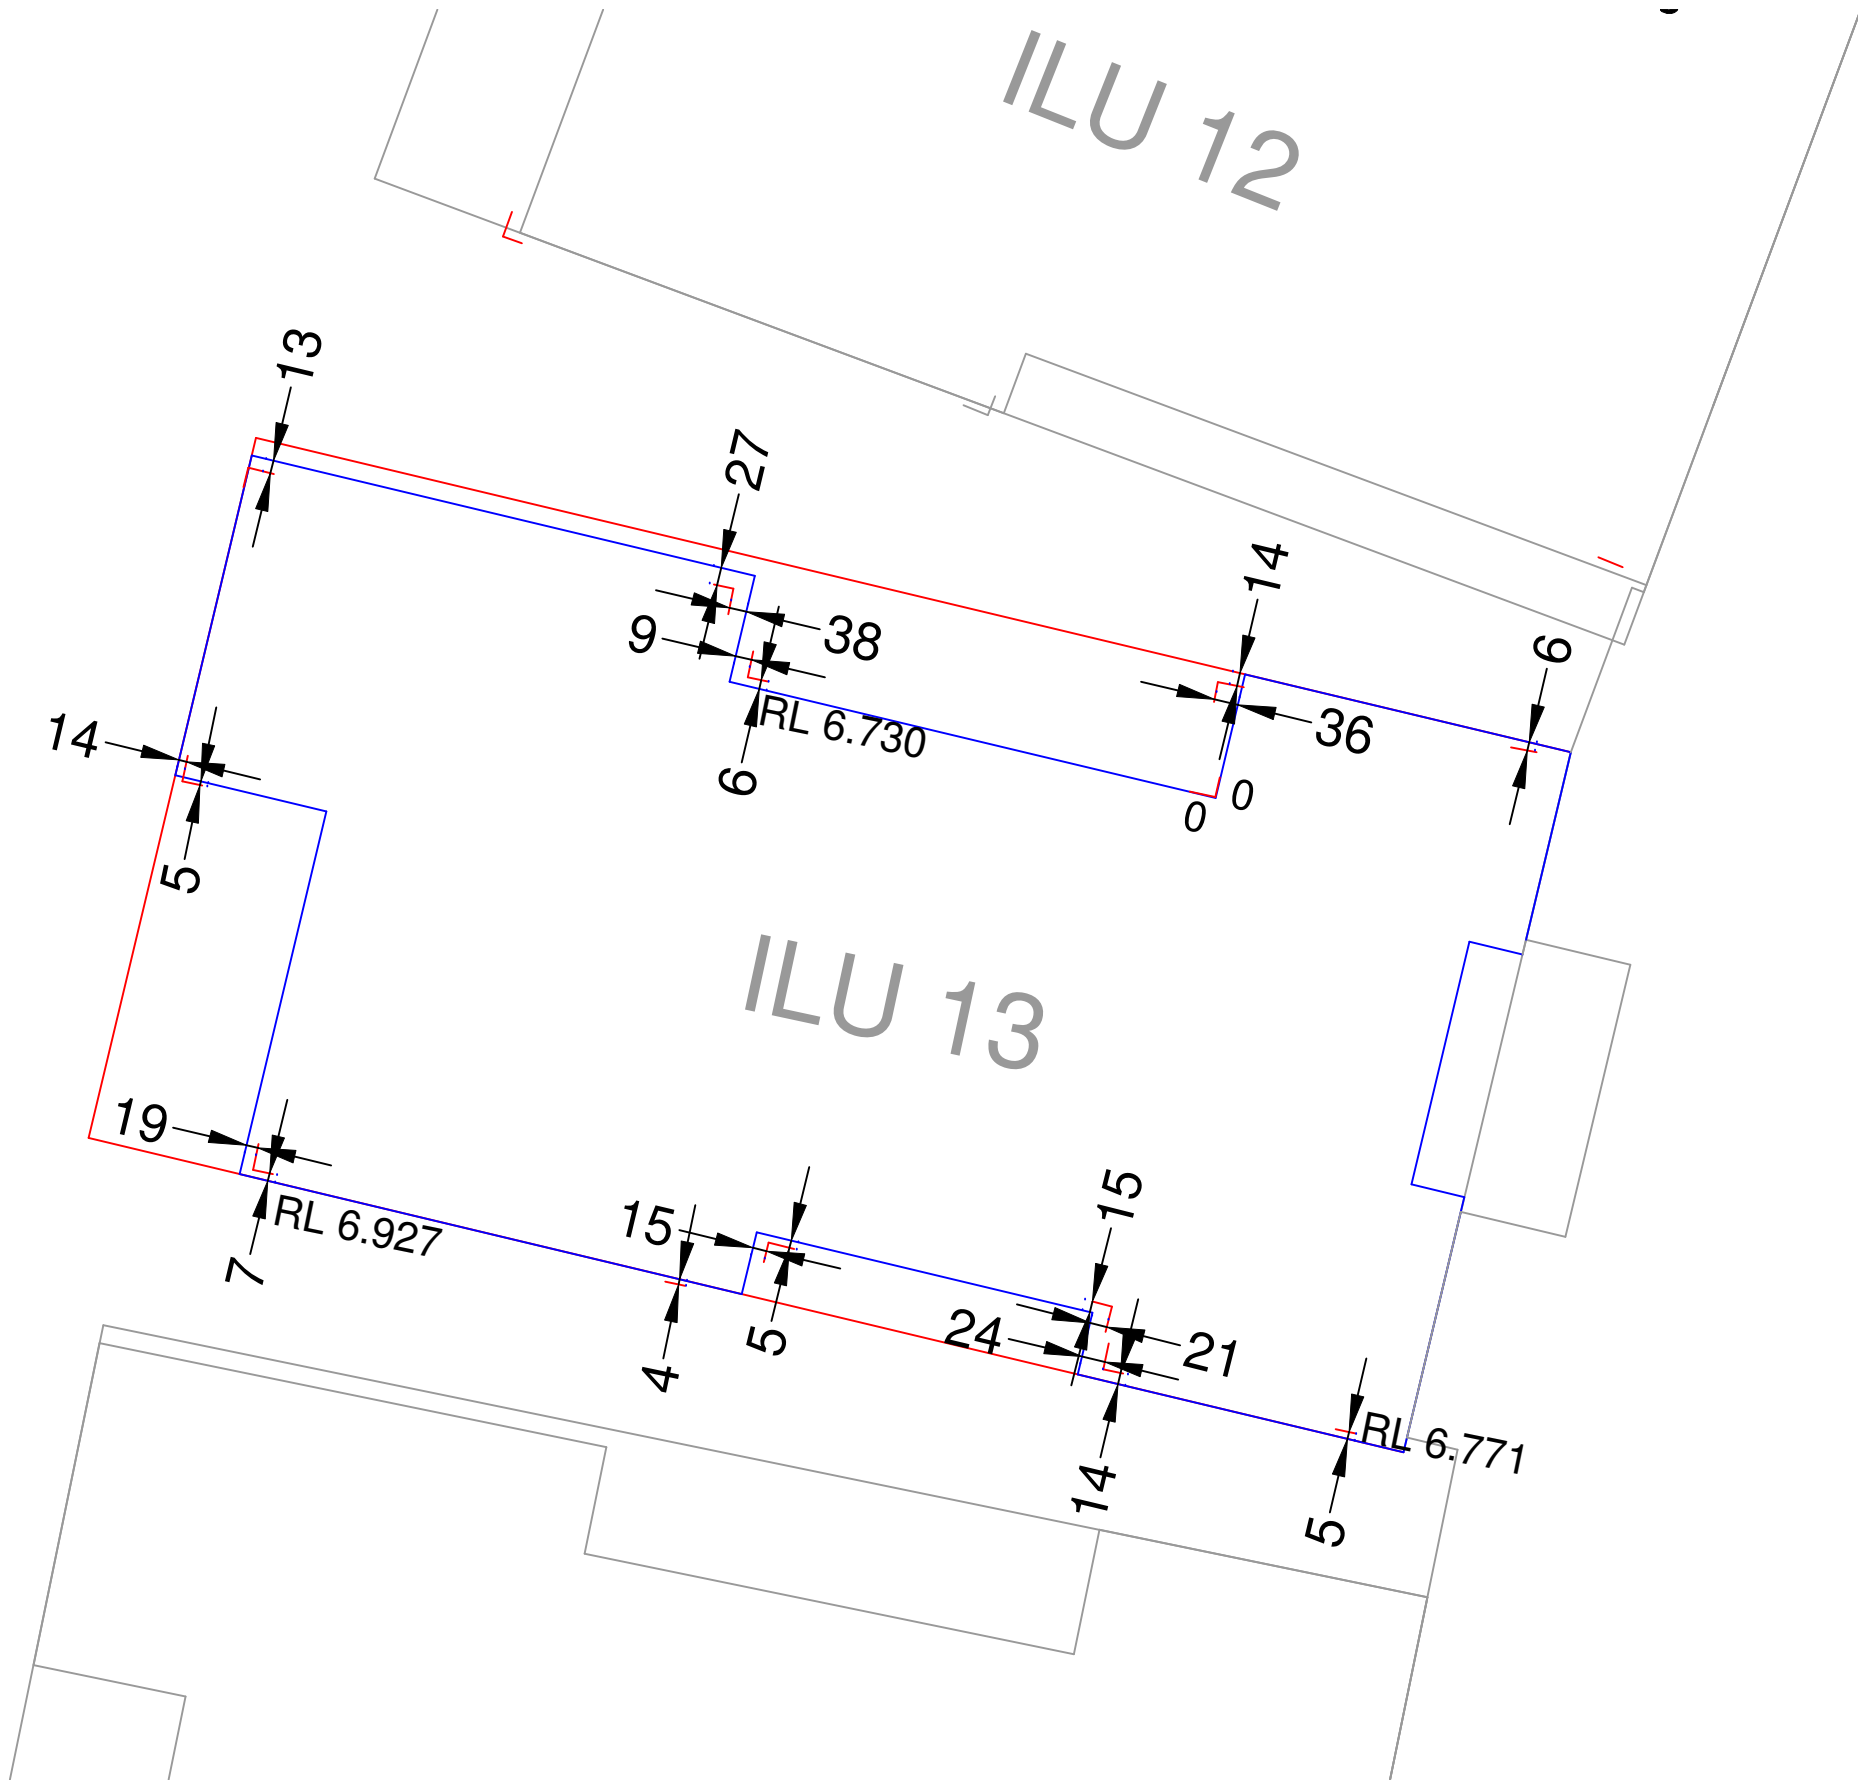


Land Surveys Sydney Office T (02) 8935 9451 F (02) 8935 9401 www.landsurveys.net.au E sydney@landsurveys.net.au SCALE : 1: 100 ORIGINAL SIZE : 1 0 1 2 3 4 5	0	20/8/15	ISSUED TO CLIENT	SURVEYOR : DB	TITLE: FORMWORK CHECK OF ILU 13	CLIENT: PBS BUILDING	
				SURVEY DATE : 20/8/15		JOB No : 1500259	
				DRAWN : DB	PROJECT: WARRIEWOOD ARV	DWG No : 039REV0	
				APPROVED : JR			
				PBSBUILDING			
REVISION	DATE	DESCRIPTION					

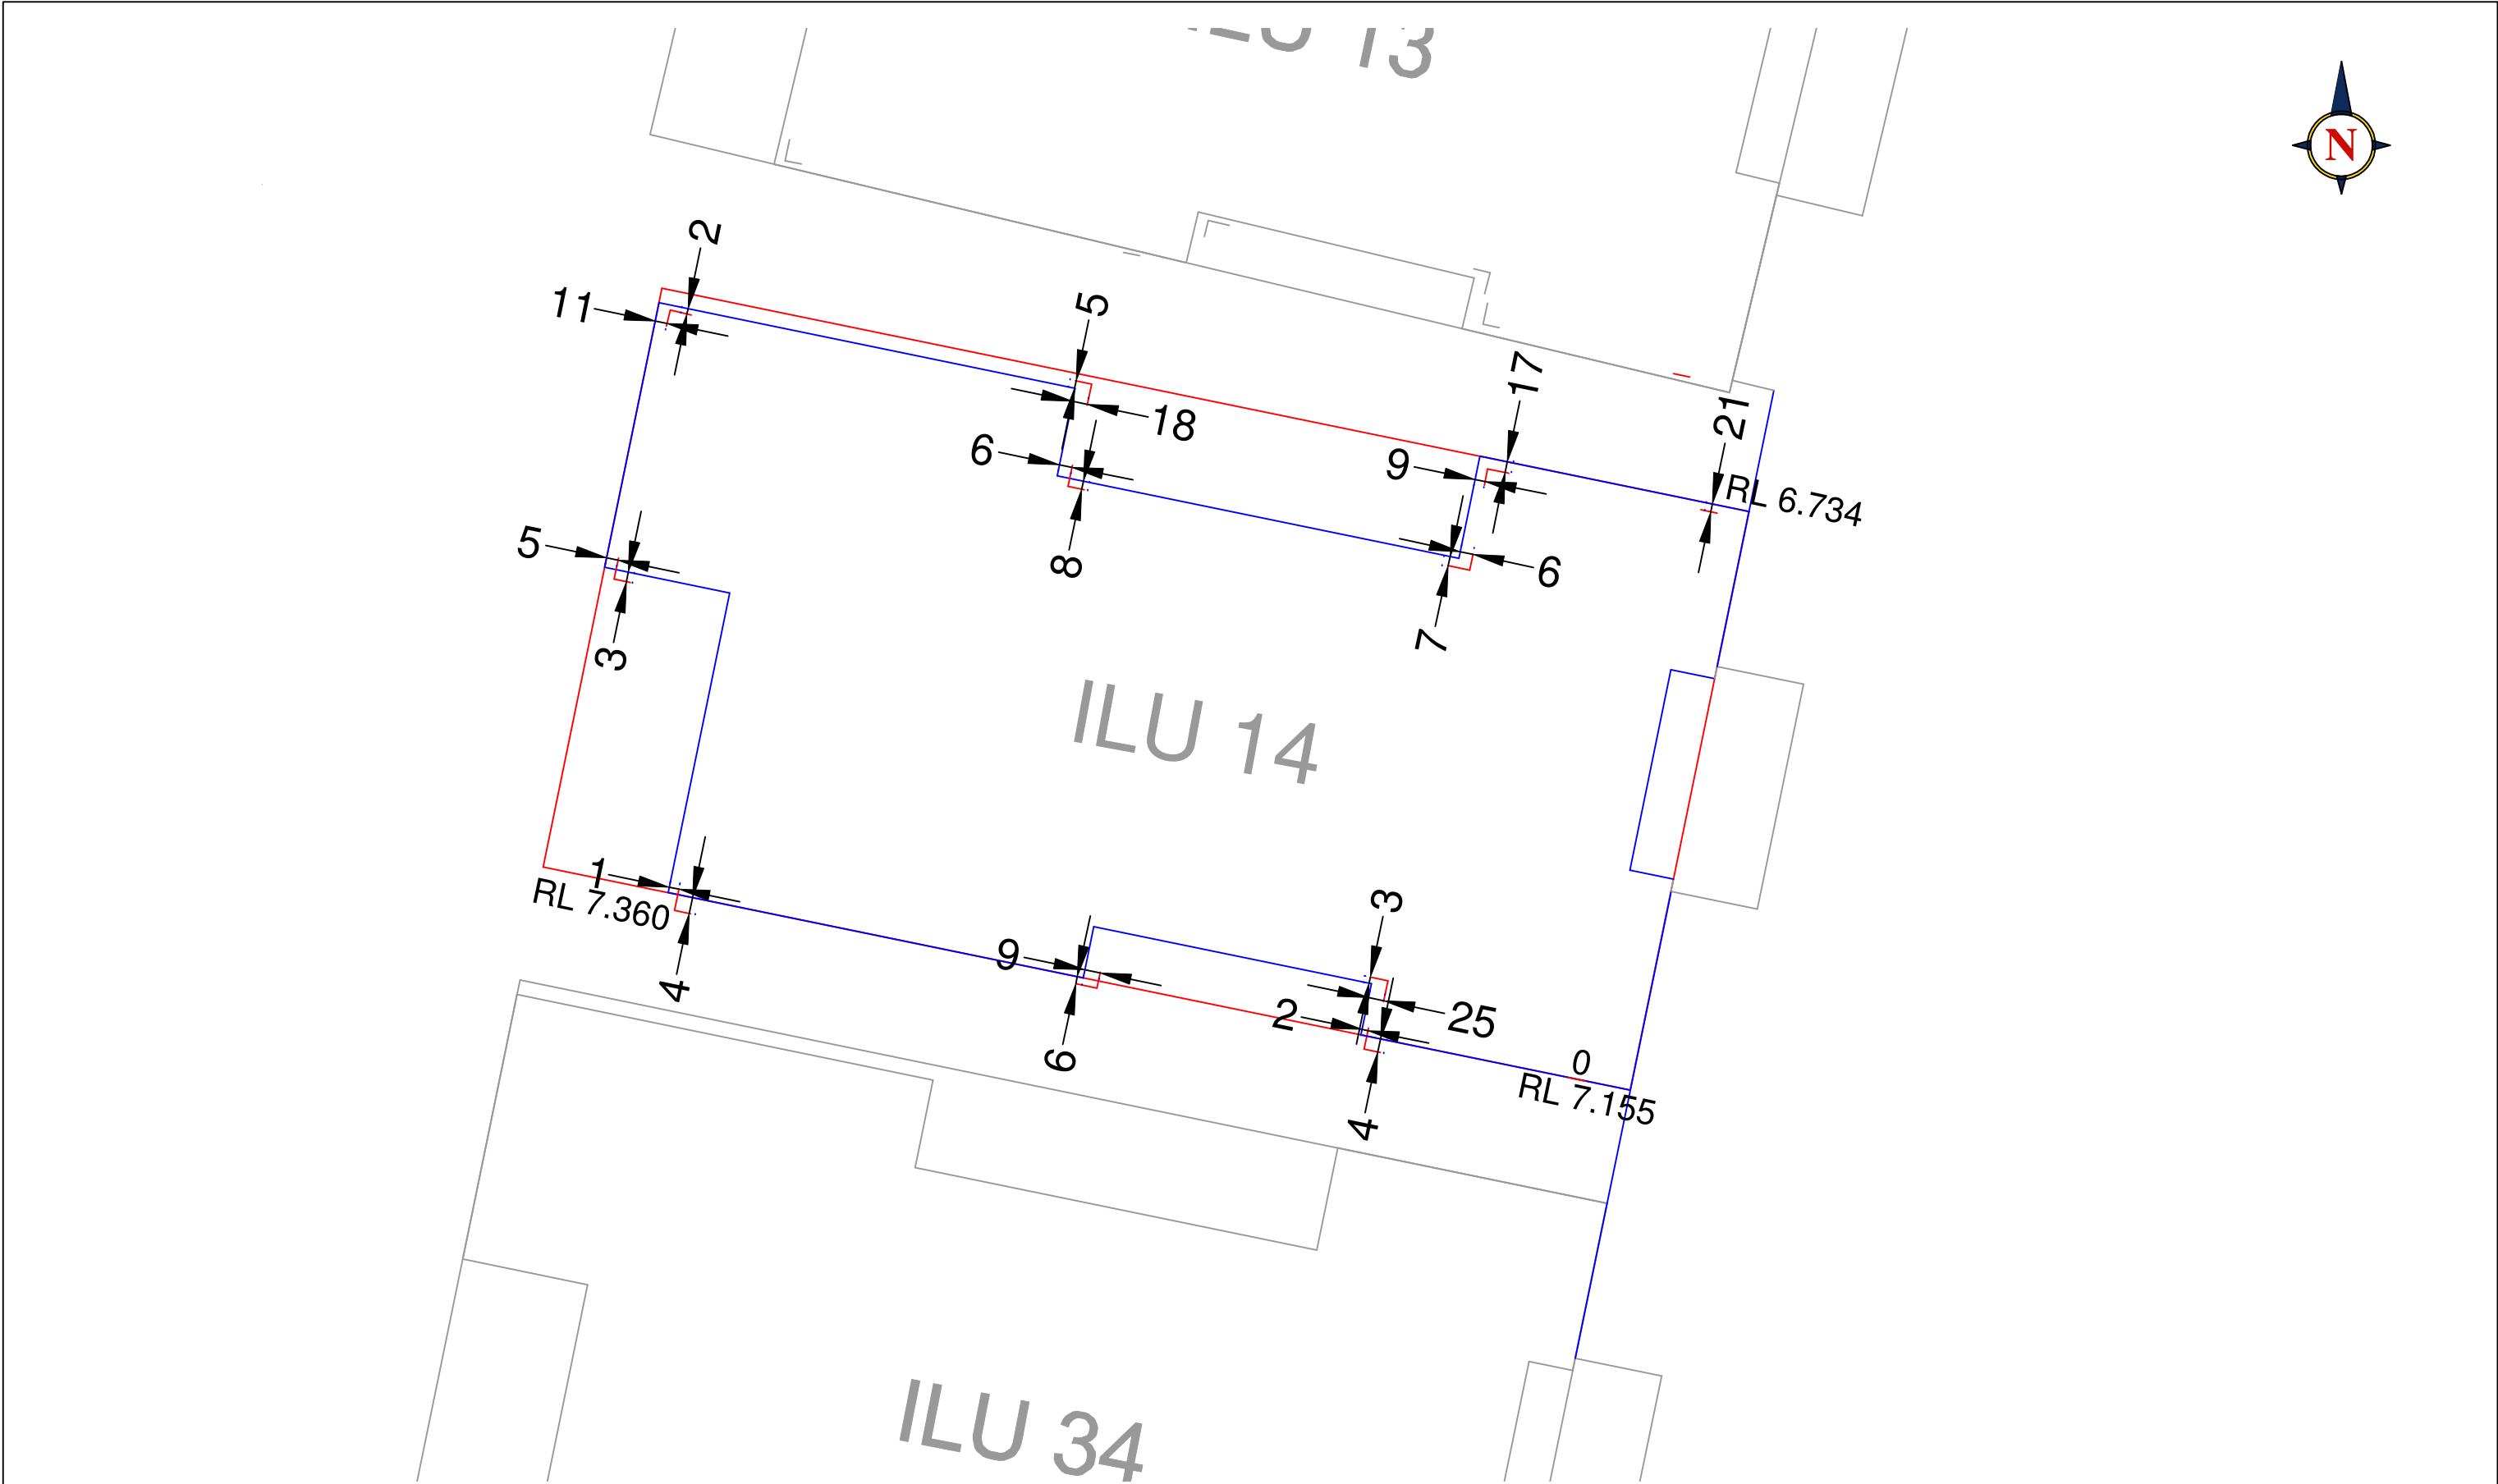

Land Surveys Sydney Office Suite 3, 78 Reserve Road Artarmon NSW 2064 T (02) 8935 9451 F (02) 8935 9401 www.landsurveys.net.au E sydney@landsurveys.net.au SCALE : 1: 100 ORIGINAL SIZE :	0	20/8/15	ISSUED TO CLIENT	SURVEYOR : DB	TITLE: FORMWORK CHECK OF ILU 14	CLIENT: PBS BUILDING	
				SURVEY DATE : 20/8/15		JOB No : 1500259	
				DRAWN : DB			
				APPROVED : JR	PROJECT: WARRIEWOOD ARV	DWG No : 040	
	REVISION	DATE	DESCRIPTION				REV 0

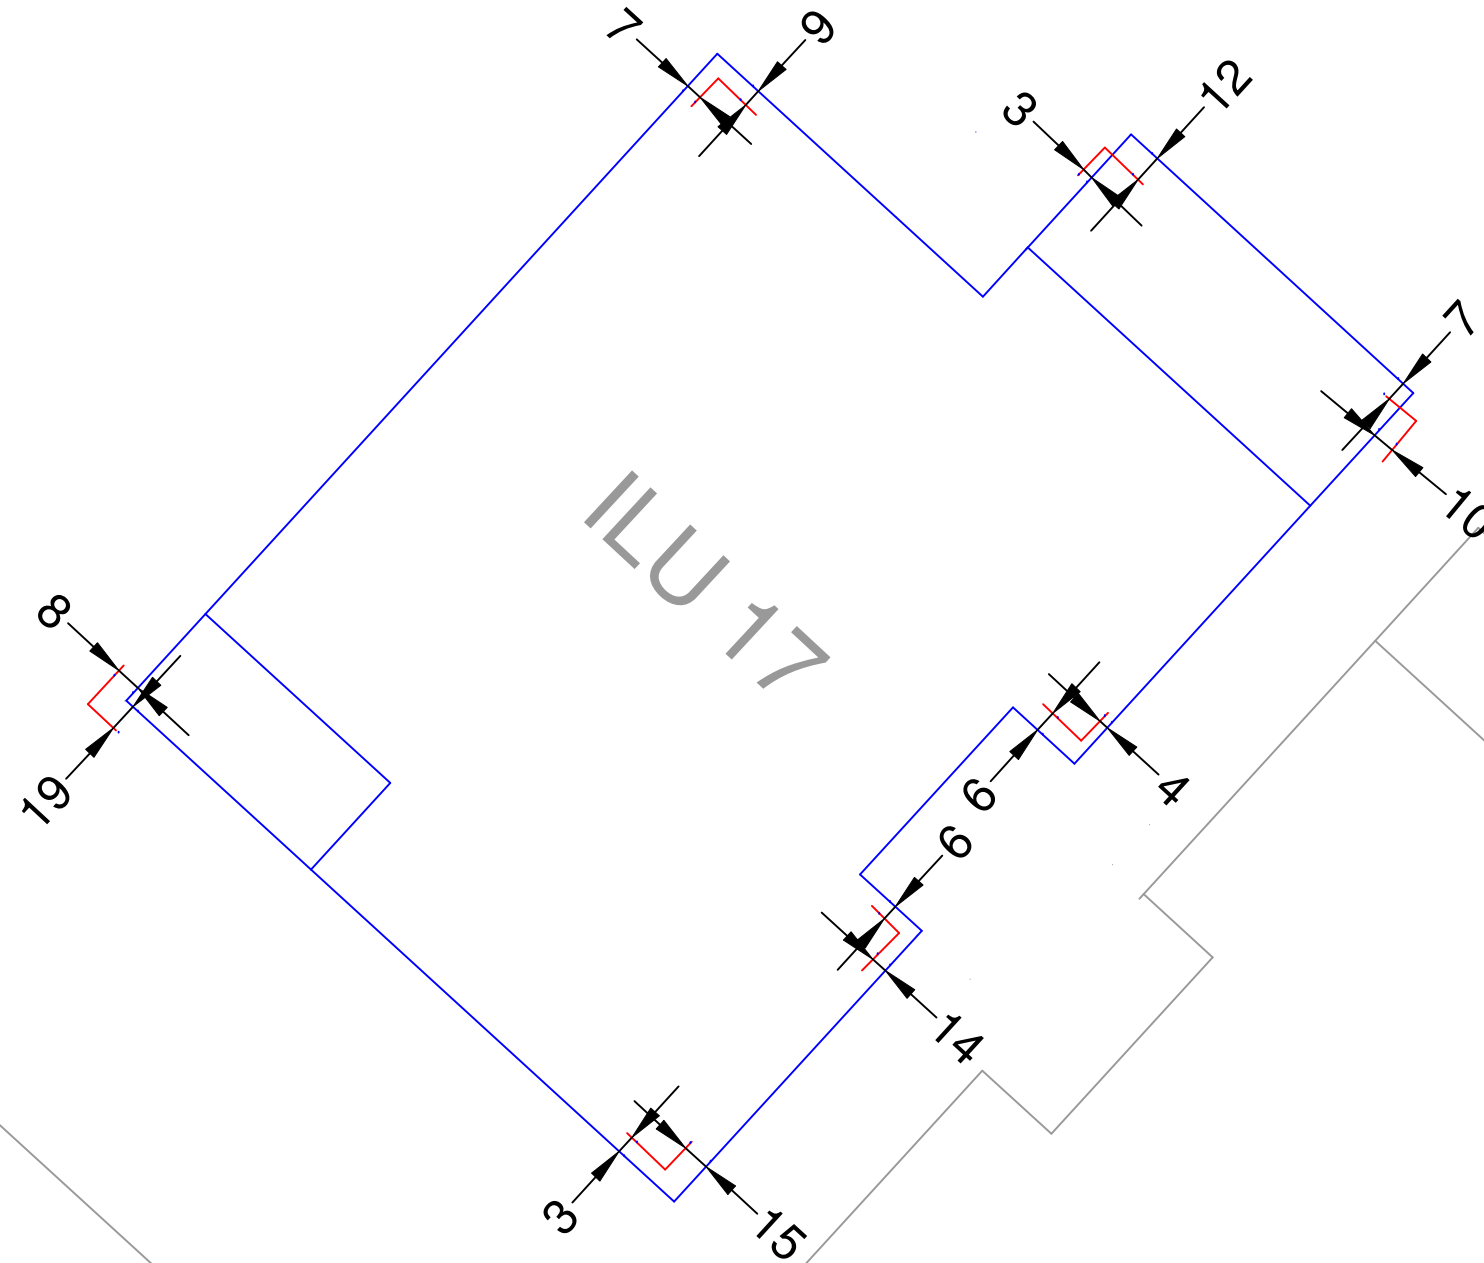


Land Surveys Sydney Office T (02) 8935 9451 F (02) 8935 9401 www.landsurveys.net.au E sydney@landsurveys.net.au Suite 3, 78 Reserve Road Artarmon NSW 2064	0	29/9/15	ISSUED TO CLIENT	SURVEYOR : DB	TITLE: SKETCH SHOWING FORM WORK CHECK OF ILU 17	CLIENT: PBS BUILDING		
				SURVEY DATE : 29/9/15				
					DRAWN : DB	PROJECT: WARRIEWOOD ARV	JOB No : 1500259	
					APPROVED : JR			
					 PBSBUILDING			
SCALE : 1: XXX ORIGINAL SIZE :	REVISION	DATE	DESCRIPTION	DWG No : 051		REV 0		

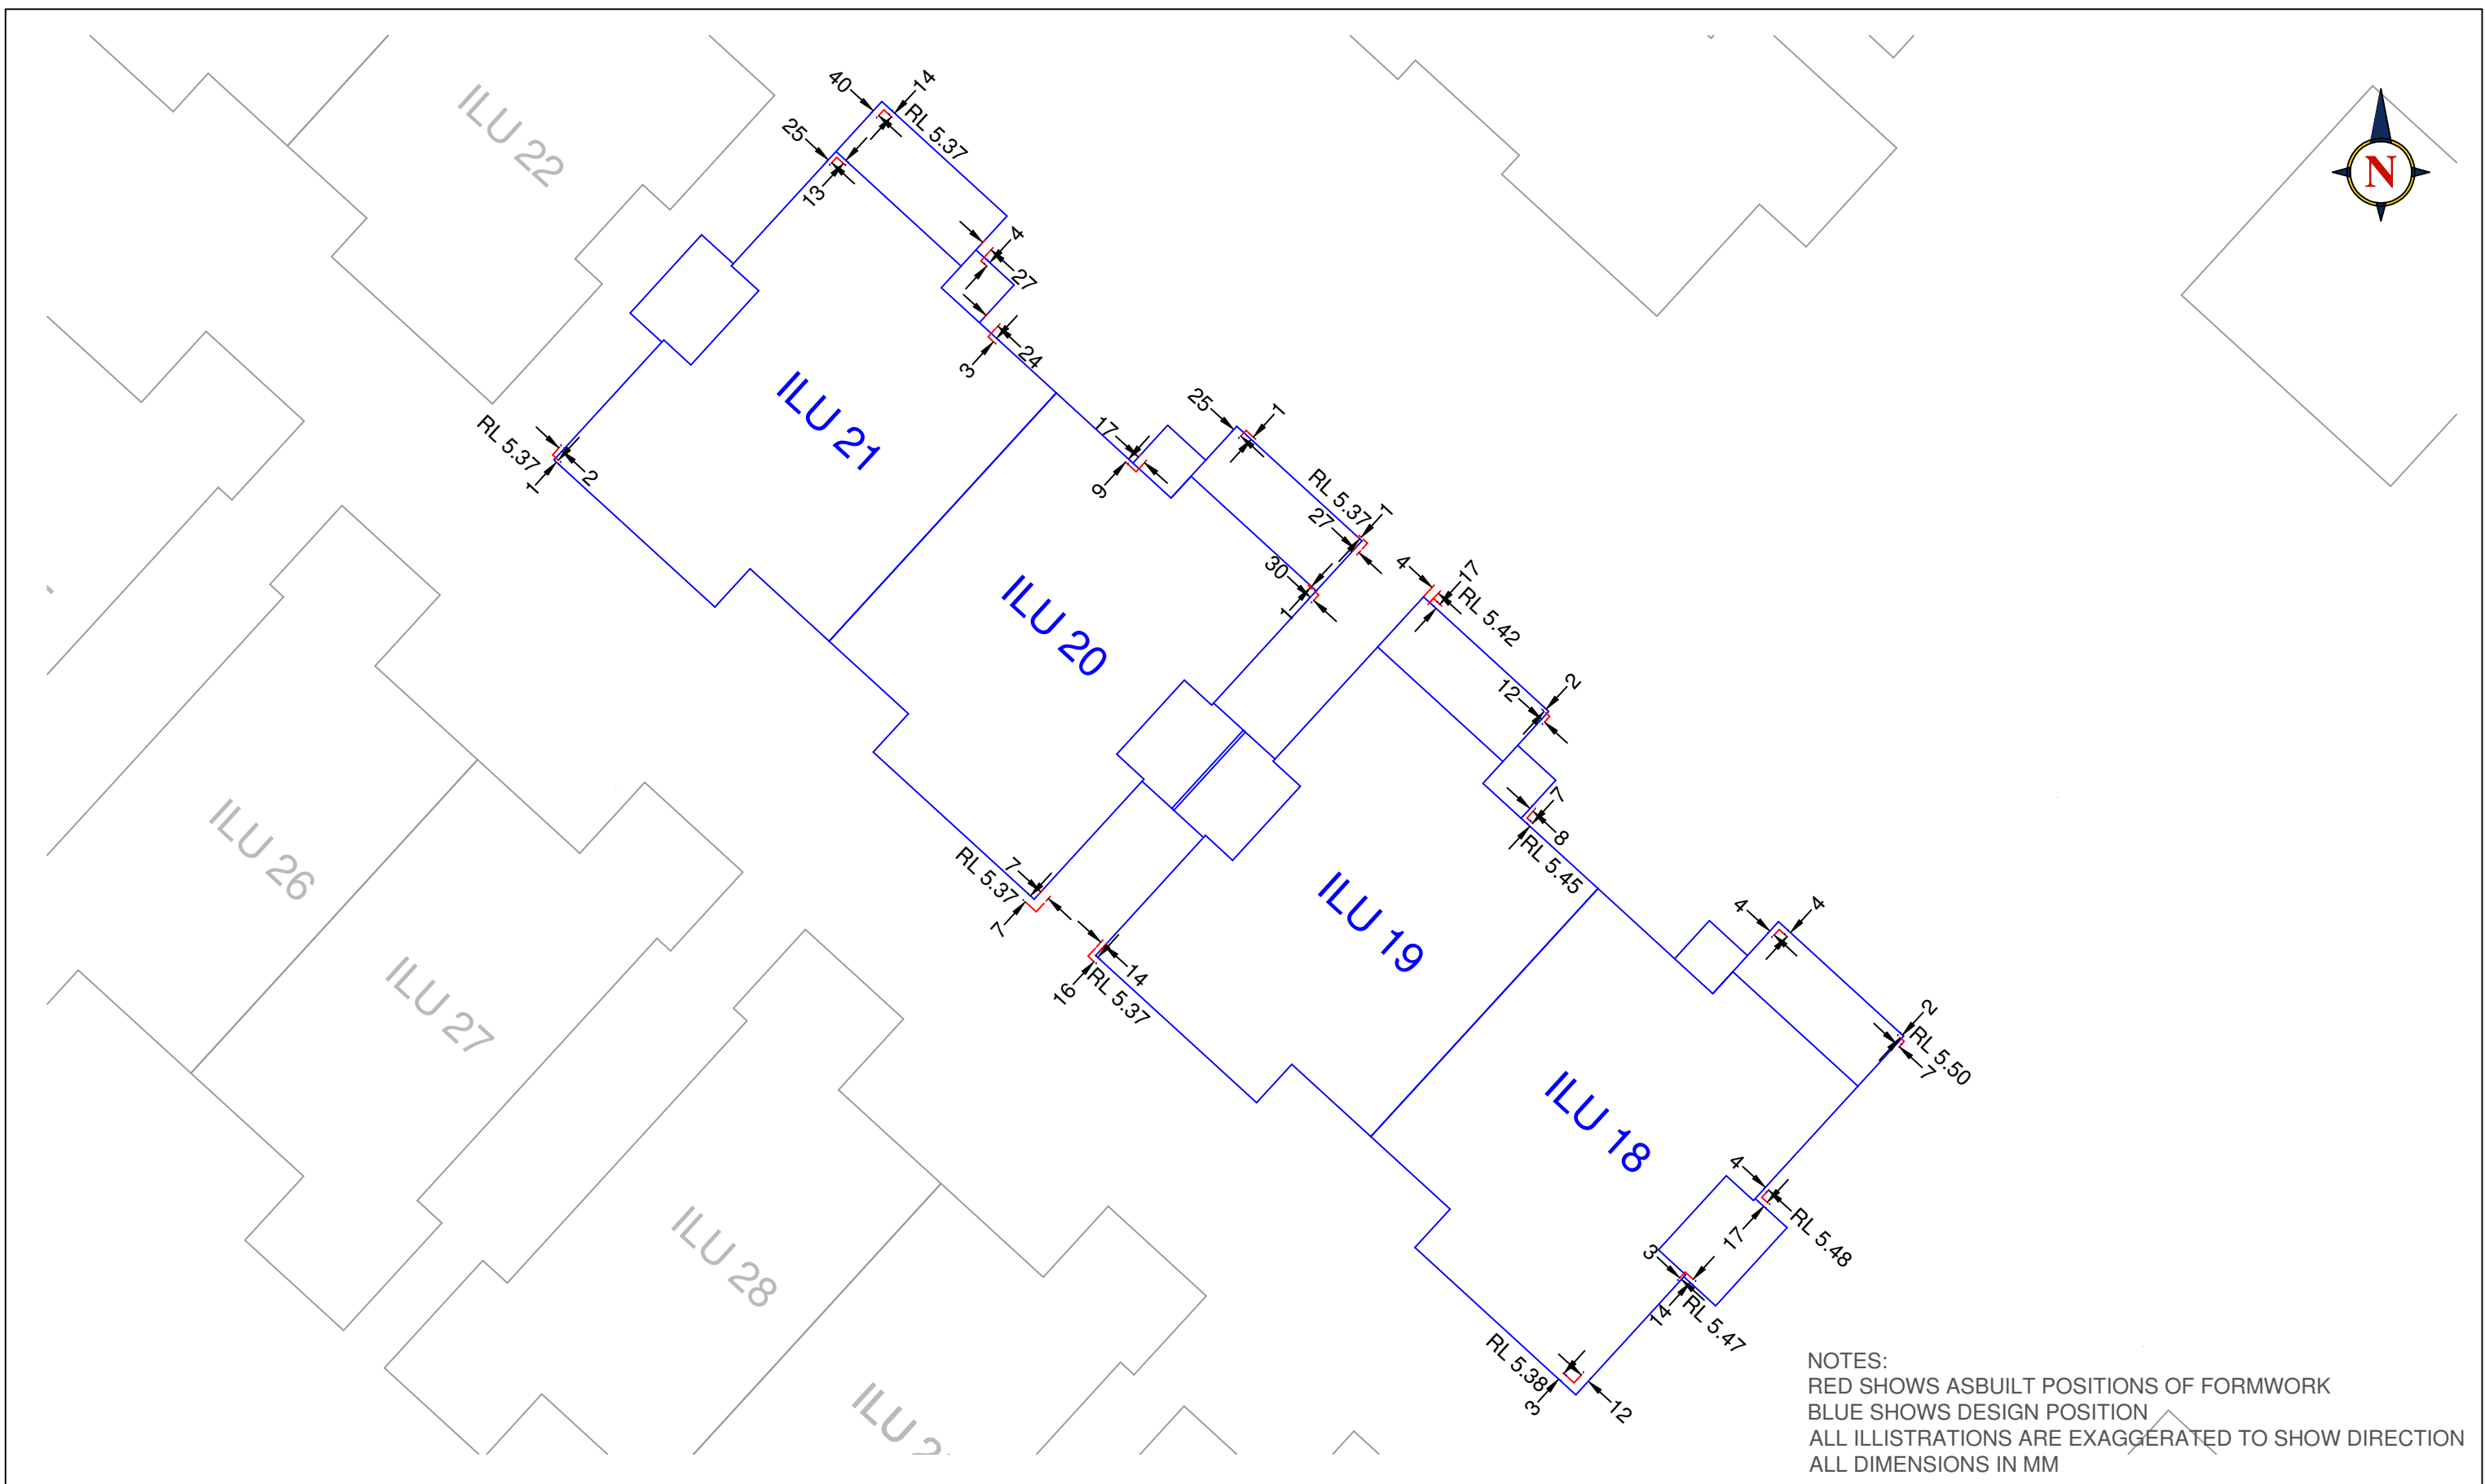

NOTES:
RED SHOWS ASBUILT POSITIONS OF FORMWORK
BLUE SHOWS DESIGN POSITION
ALL ILLUSTRATIONS ARE EXAGGERATED TO SHOW DIRECTION
ALL DIMENSIONS IN MM

Land Surveys Level 5, 7 Eden Park Drive Macquarie NSW 2113 T (02) 8935 9451 F (02) 8935 9401 www.landsurveys.net.au E sydney@landsurveys.net.au	0	15/6/15	ISSUED TO CLIENT	SURVEYOR : DB	TITLE: SKETCH SHOWING FORMWORK CHECKS ILU 18,19,20 AND 21	CLIENT: PBS BUILDING		
				SURVEY DATE : 12/6/15				
					DRAWN : DB	PROJECT: WARRIEWOOD ARV	JOB No : 1500259	
					APPROVED : JR			
					PBSBUILDING			
SCALE : 1: 200 ORIGINAL SIZE :						DWG No : 025	REV 0	
	REVISION	DATE	DESCRIPTION					

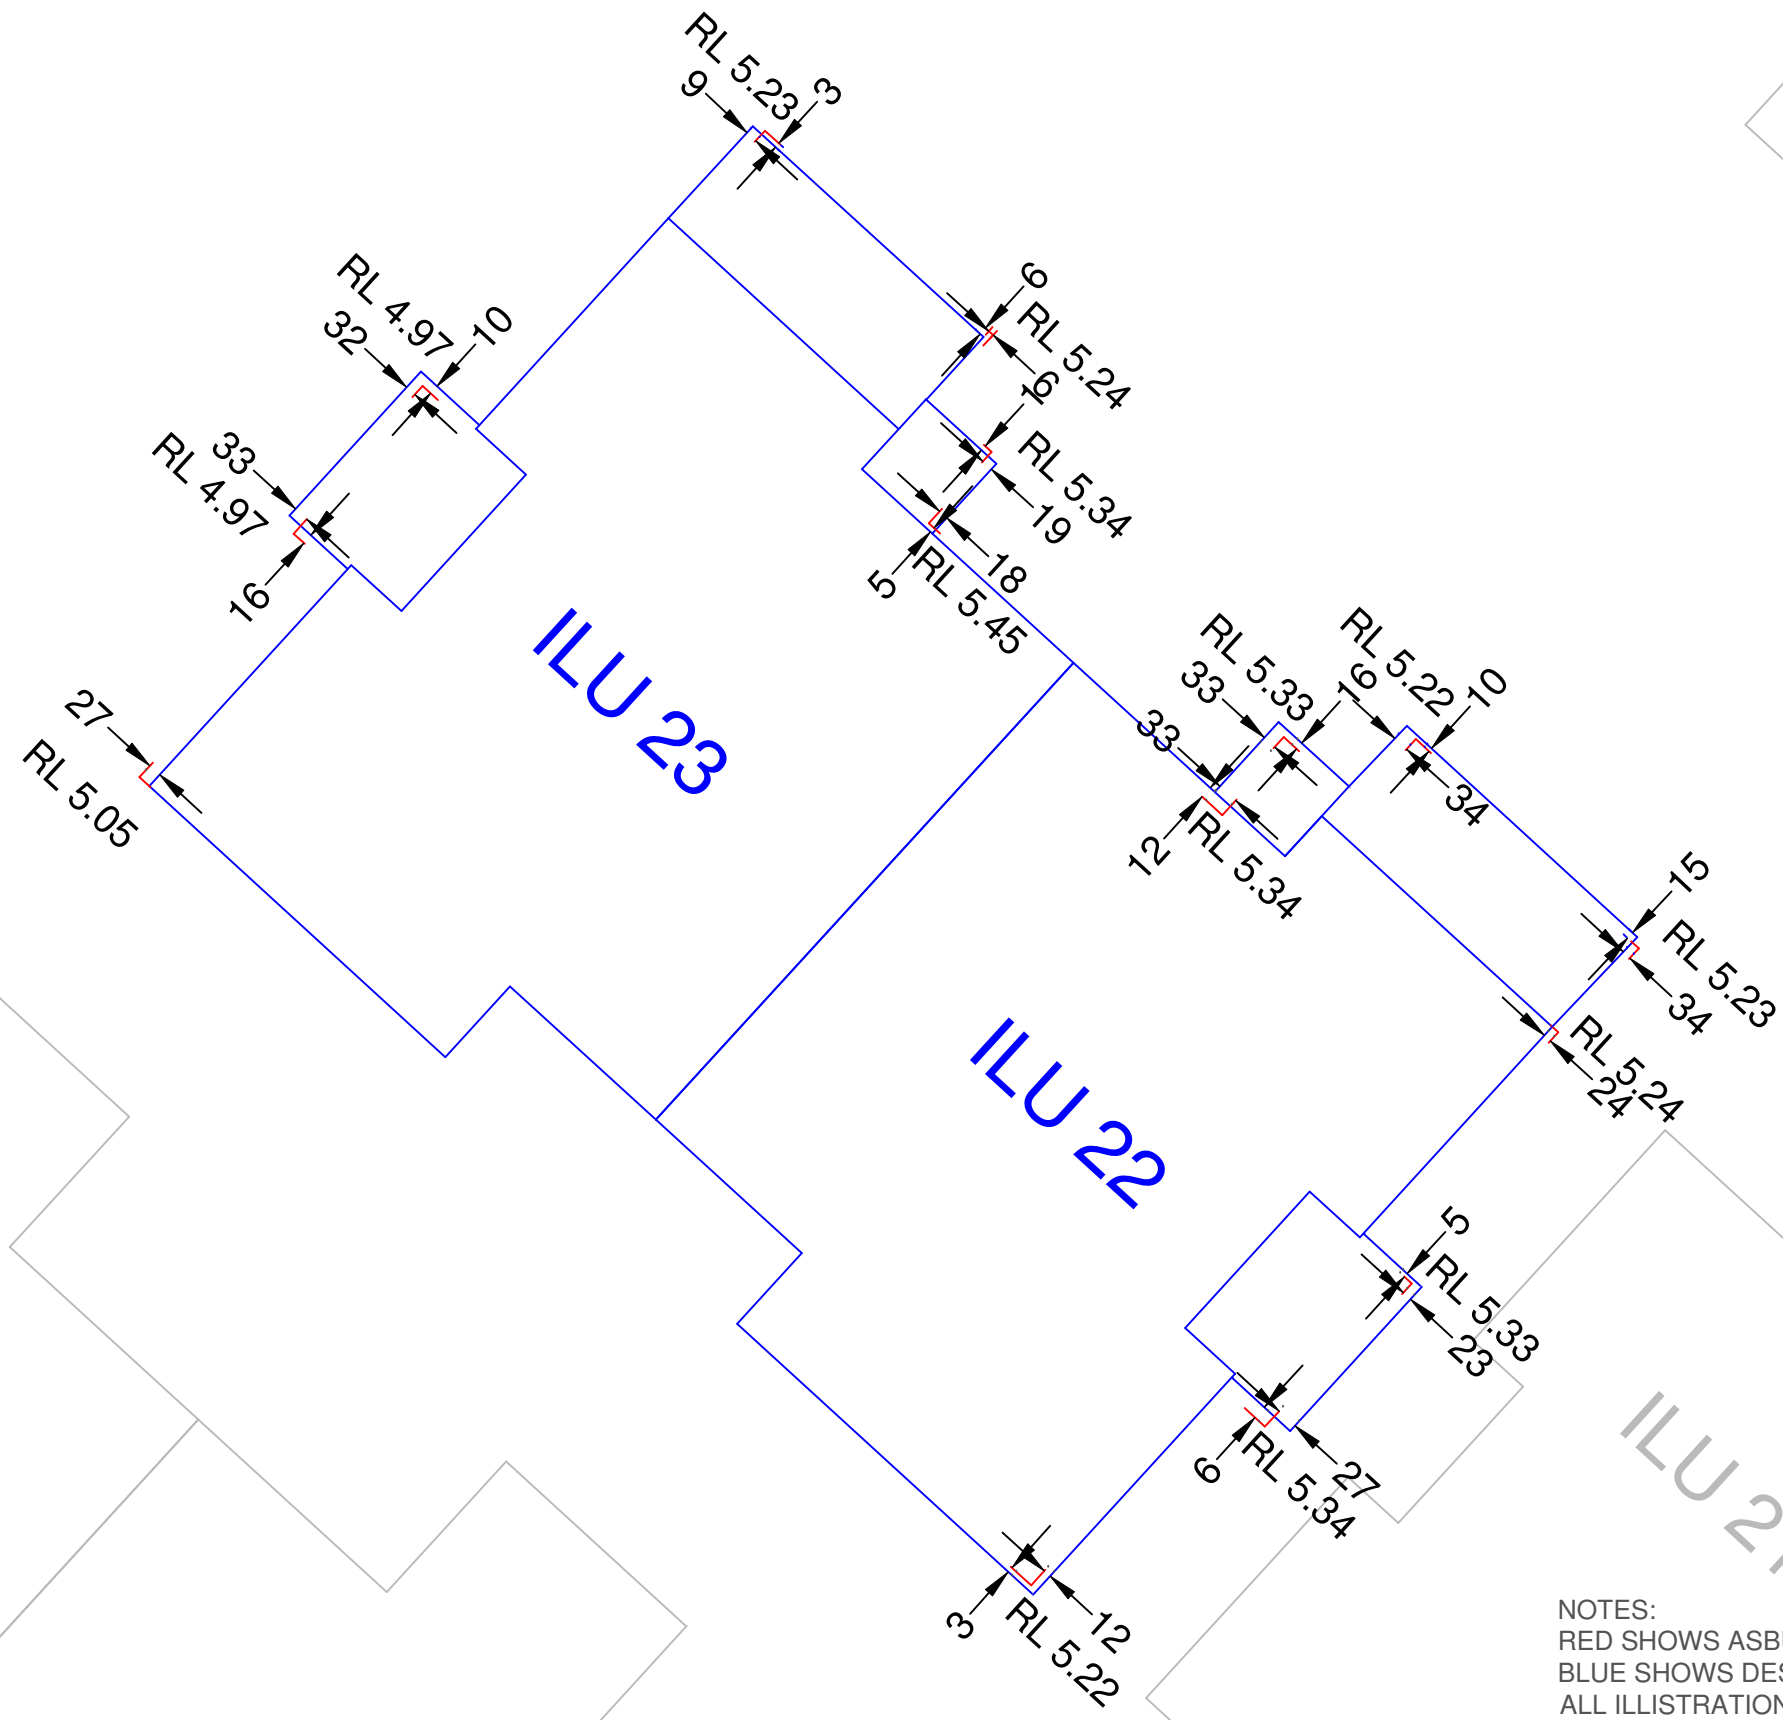

NOTES:
RED SHOWS ASBUILT POSITIONS OF FORMWORK
BLUE SHOWS DESIGN POSITION
ALL ILLUSTRATIONS ARE EXAGGERATED TO SHOW DIRECTION
ALL DIMENSIONS IN MM

Land Surveys


Level 5, 7 Eden Park Drive
Macquarie NSW 2113
T (02) 8935 9451
F (02) 8935 9401
www.landsurveys.net.au
E sydney@landsurveys.net.au

SCALE :
1: xxx
ORIGINAL SIZE :

0	8/6/15	ISSUED TO CLIENT
1	9/6/15	REVISED
REVISION	DATE	DESCRIPTION


SURVEYOR : DB
SURVEY DATE : 5/6/15
DRAWN : DB
APPROVED : JR


TITLE: SKETCH SHOWING FORMWORK CHECKS ILU 22 AND 23	CLIENT: PBS BUILDING
PROJECT: WARRIEWOOD ARV	JOB No : 1500259
	DWG No : 024
	REV 1

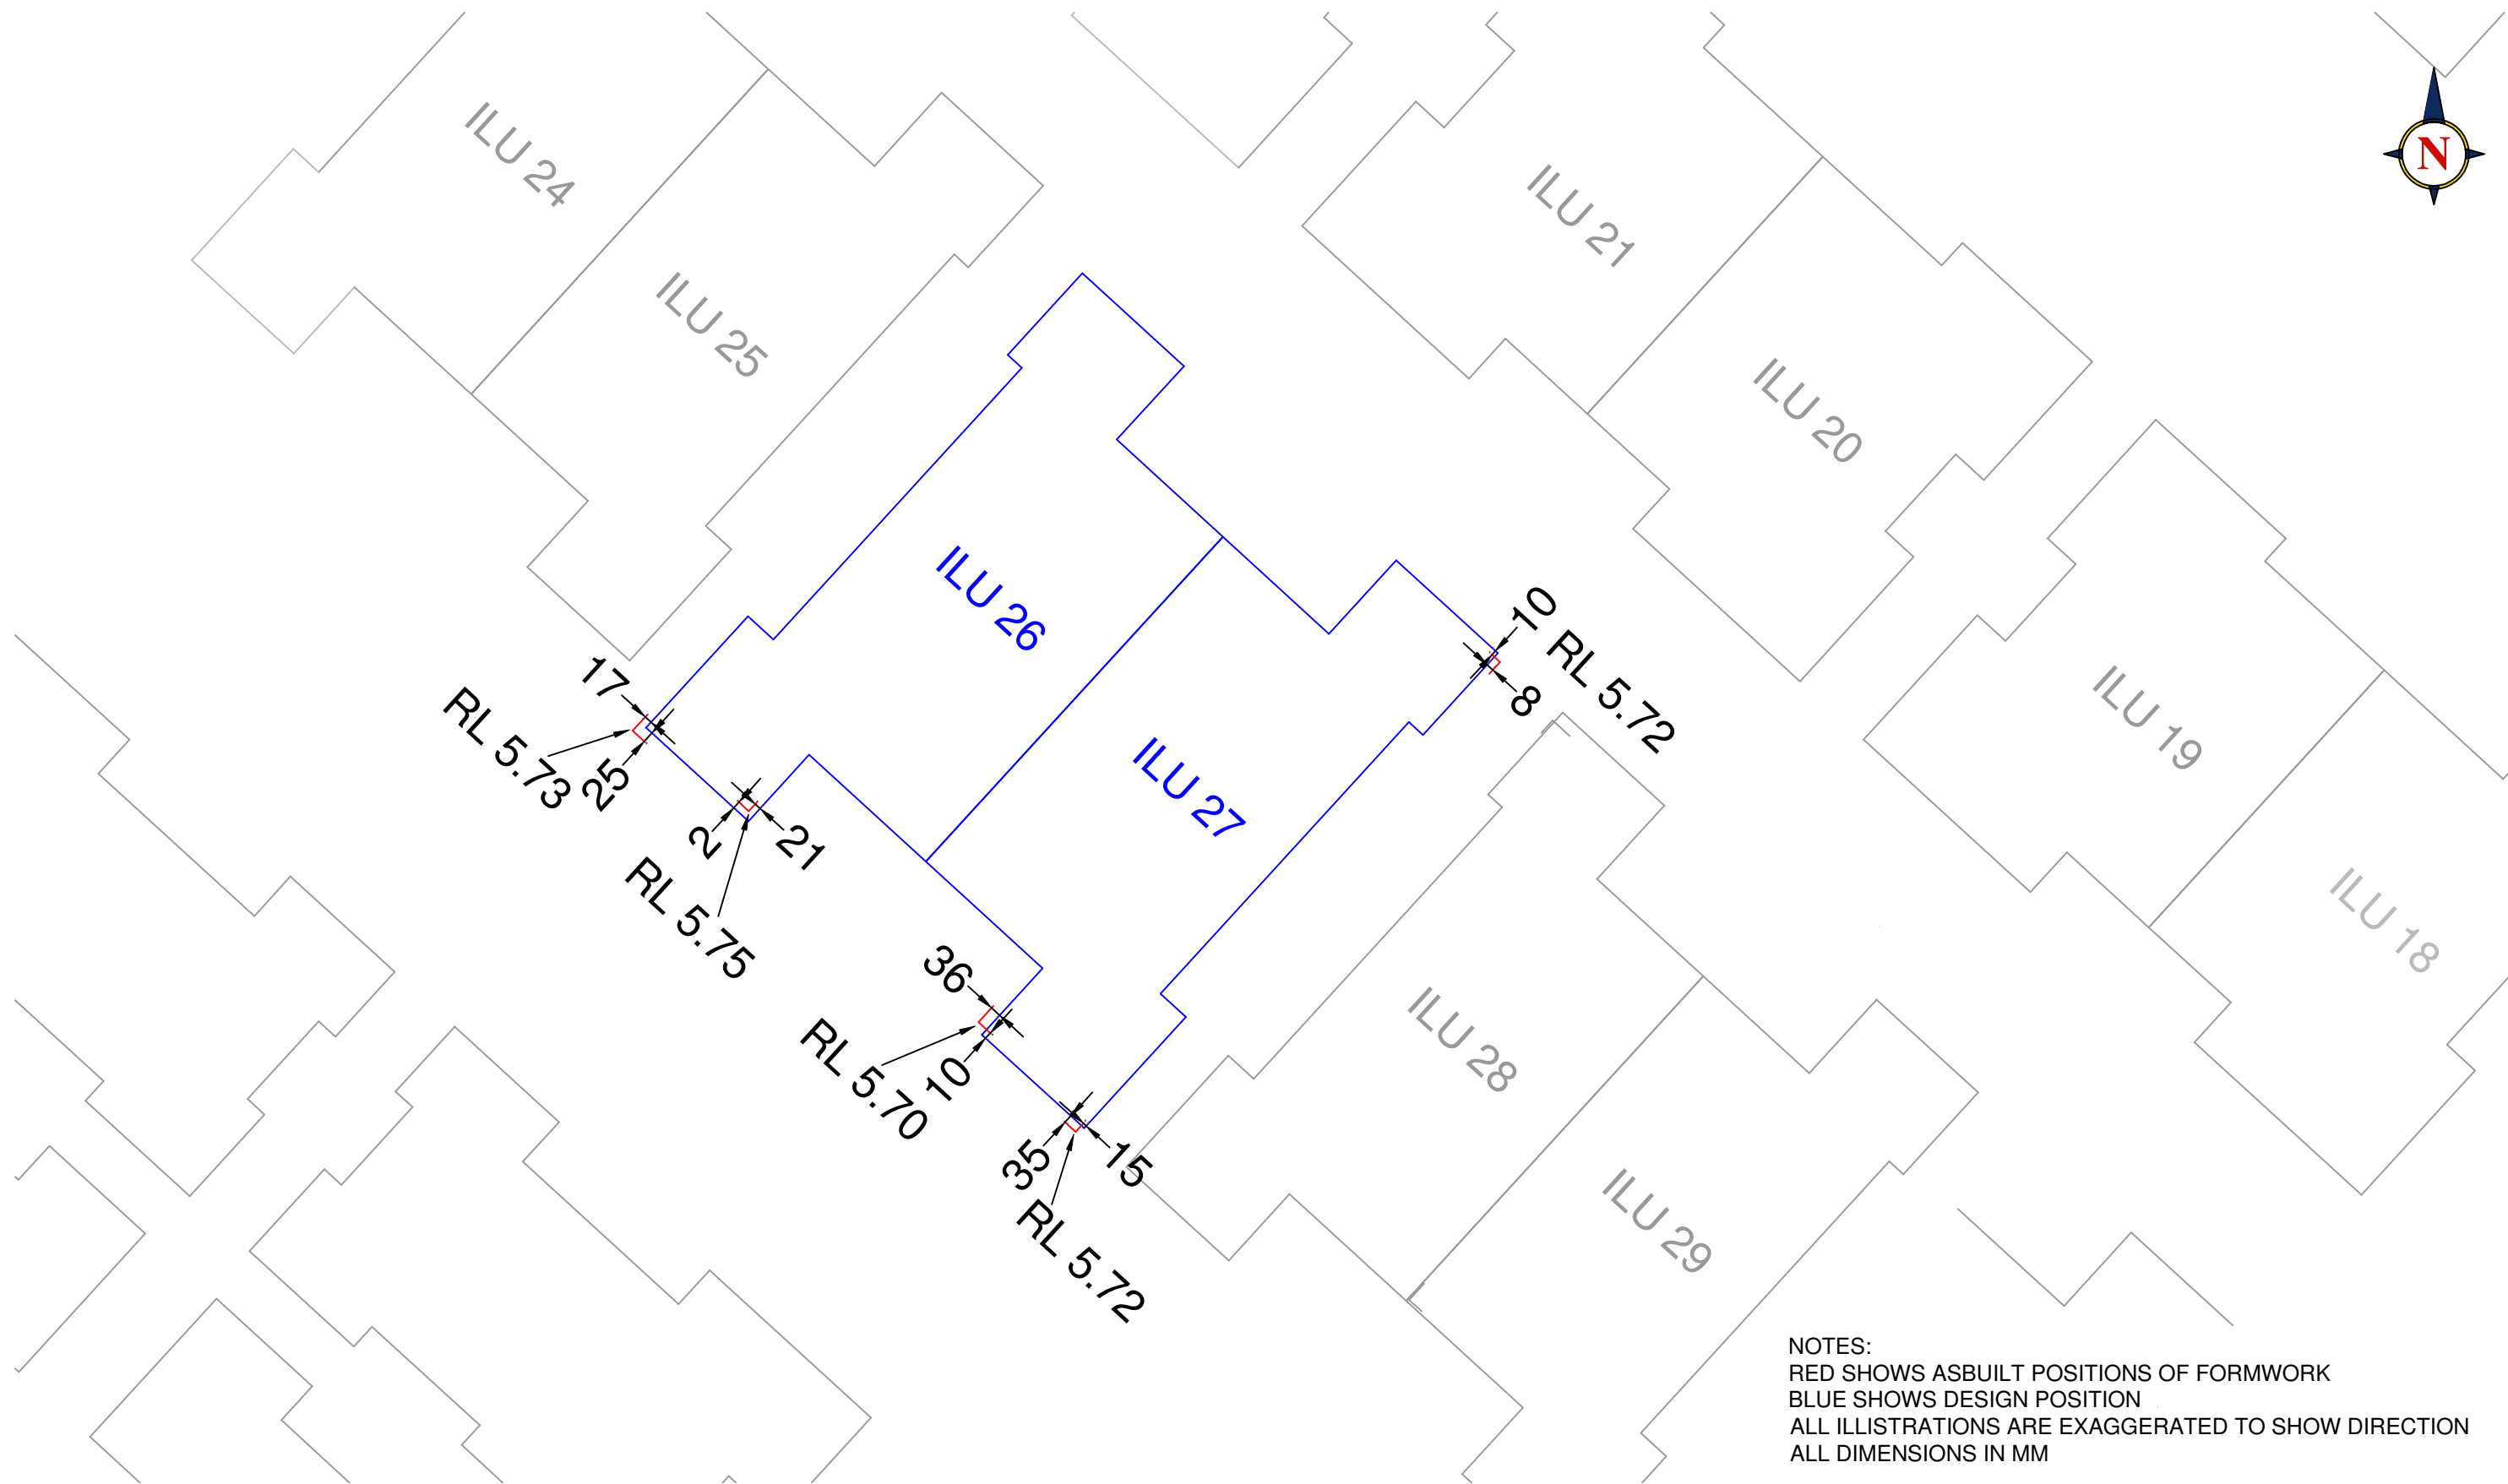


NOTES:
RED SHOWS ASBUILT POSITIONS OF FORMWORK
BLUE SHOWS DESIGN POSITION
ALL ILLUSTRATIONS ARE EXAGGERATED TO SHOW DIRECTION
ALL DIMENSIONS IN MM

Land Surveys Level 5, 7 Eden Park Drive Macquarie NSW 2113 T (02) 8935 9451 F (02) 8935 9401 www.landsurveys.net.au E sydney@landsurveys.net.au SCALE : 1: 200 ORIGINAL SIZE :	0	13/5/15	ISSUED TO CLIENT	SURVEYOR : DB	TITLE: SKETCH SHOWING FORMWORK CHECKS ILU 26 AND 27	CLIENT: PBS BUILDING	
				SURVEY DATE : 6/5/15			
				DRAWN : DB	PROJECT: WARRIEWOOD ARV	JOB No : 1500259	
				APPROVED : JR			
	REVISION	DATE	DESCRIPTION			DWG No : 019	REV 0

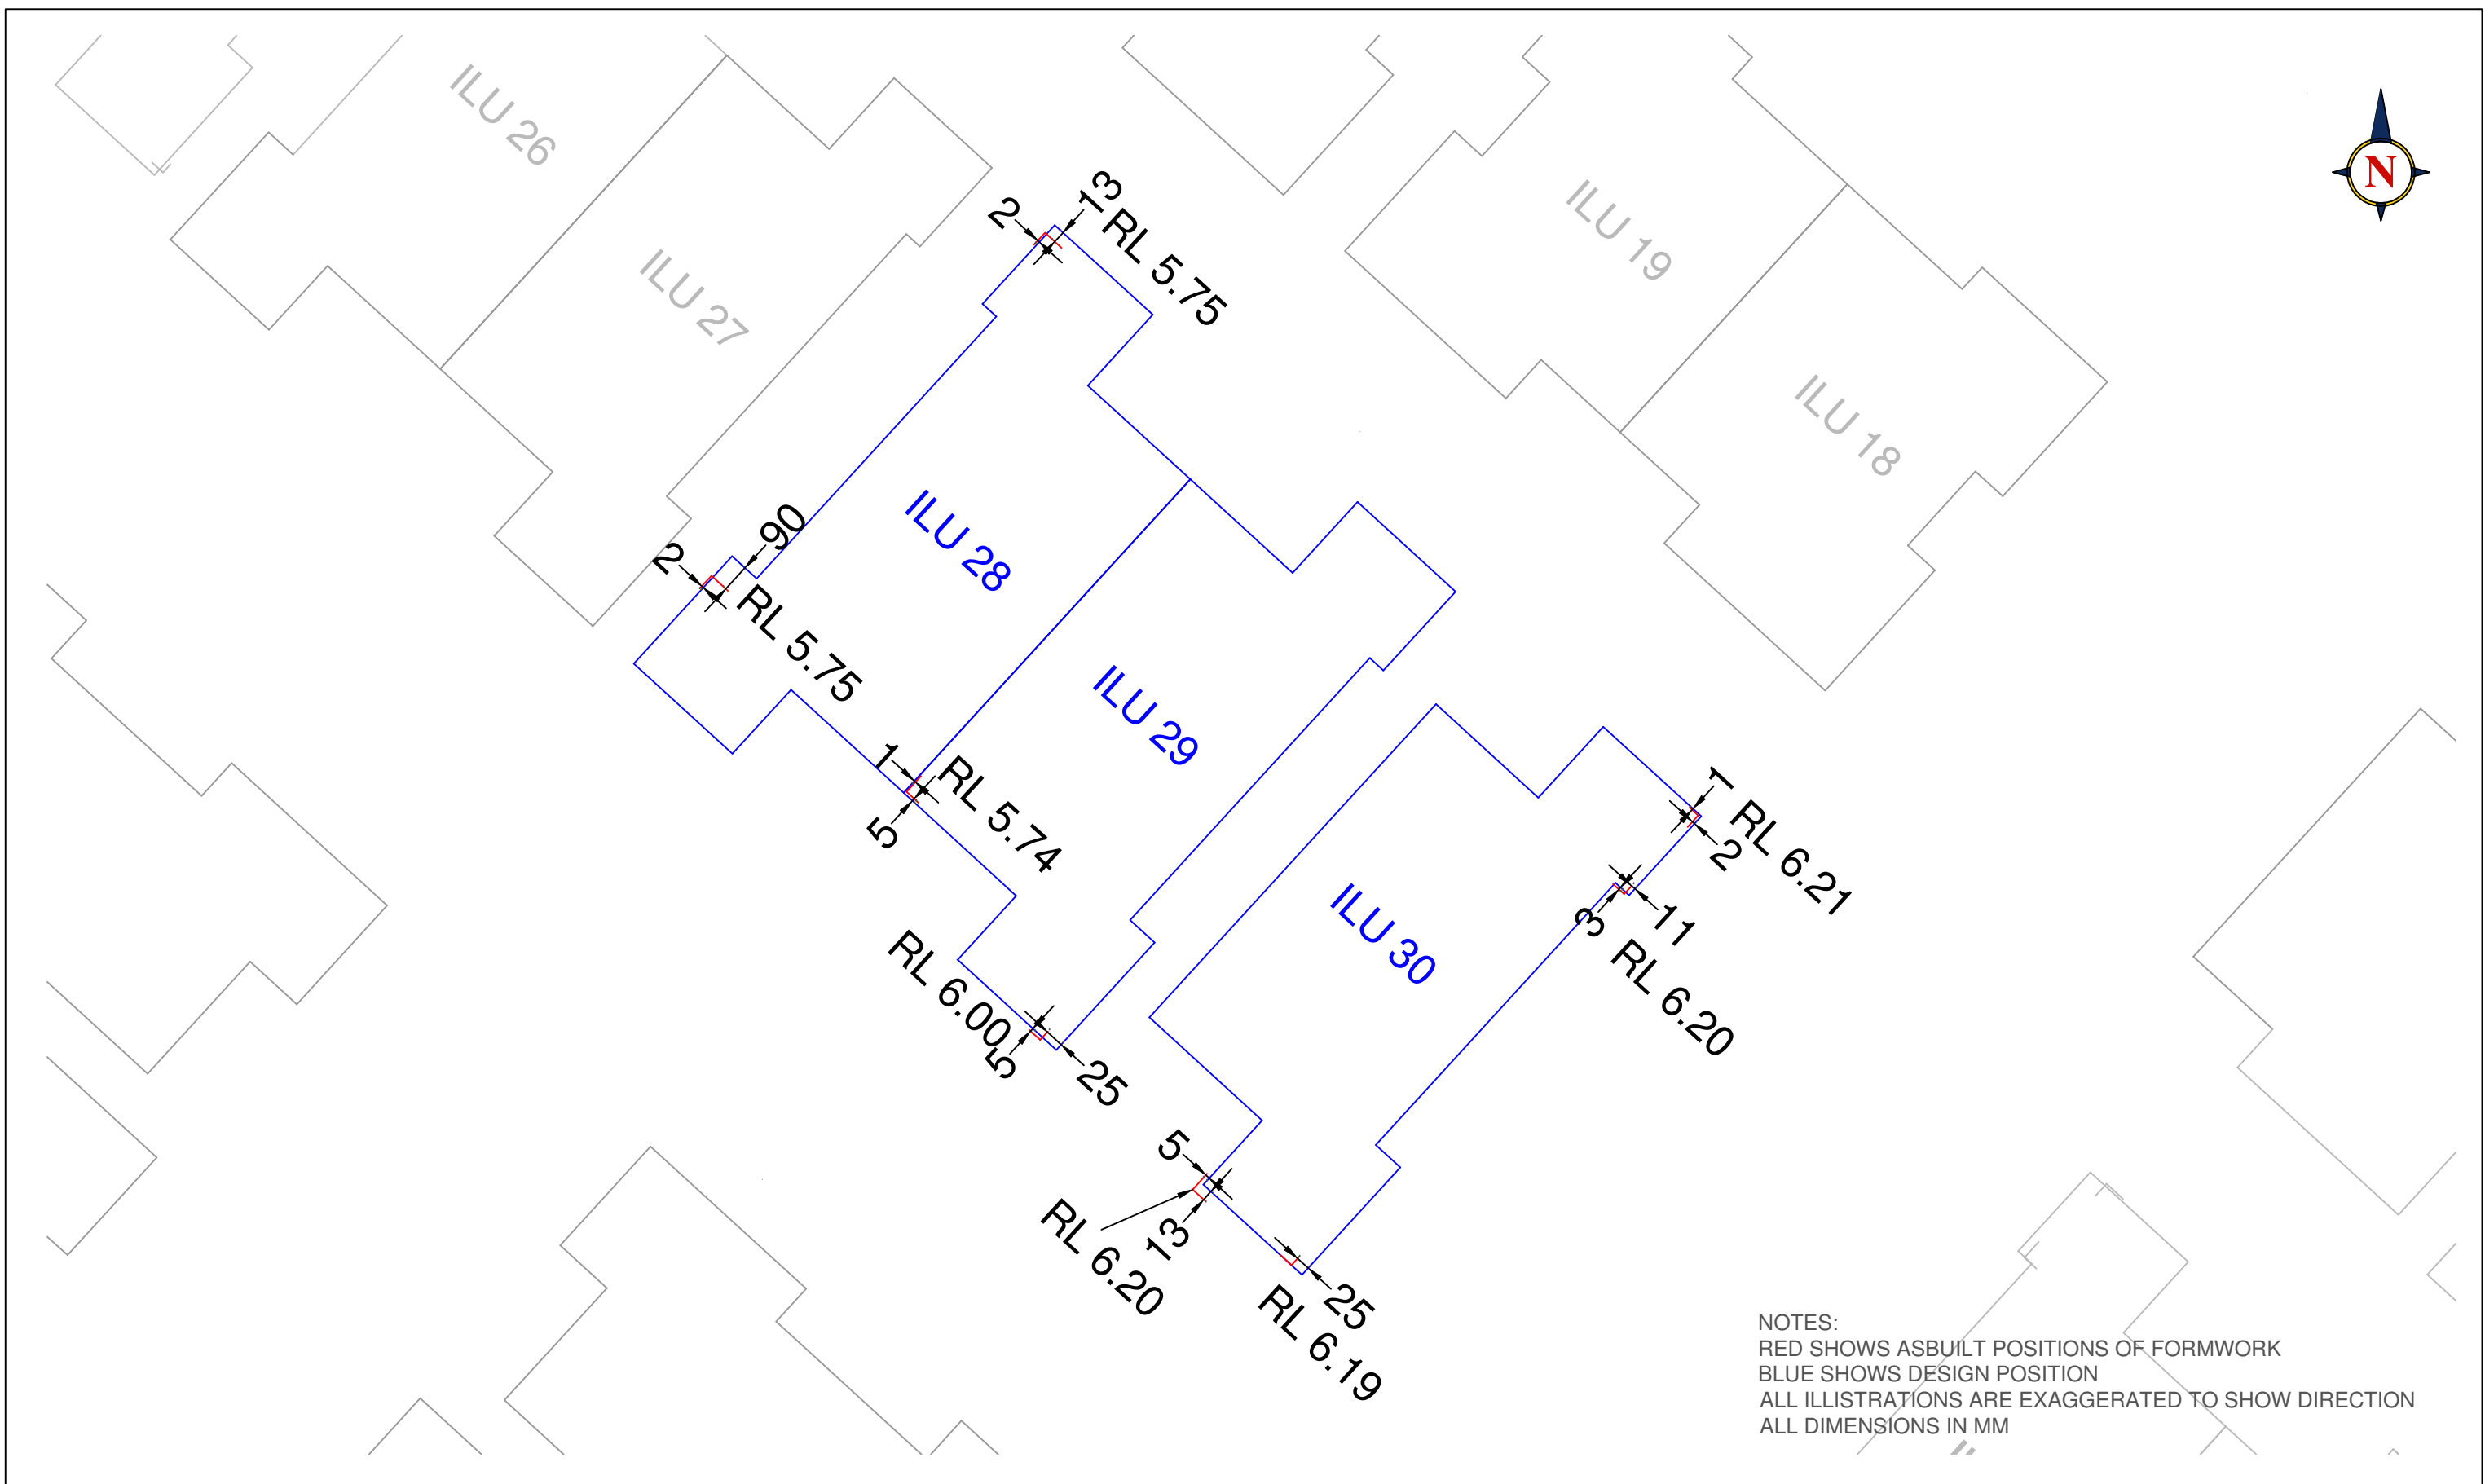

NOTES:
RED SHOWS ASBUILT POSITIONS OF FORMWORK
BLUE SHOWS DESIGN POSITION
ALL ILLUSTRATIONS ARE EXAGGERATED TO SHOW DIRECTION
ALL DIMENSIONS IN MM

Land Surveys Level 5, 7 Eden Park Drive Macquarie NSW 2113 T (02) 8935 9451 F (02) 8935 9401 www.landsurveys.net.au E sydney@landsurveys.net.au SCALE : 1: 200 ORIGINAL SIZE :	0	7/5/15	ISSUED TO CLIENT	SURVEYOR : DB	TITLE: SKETCH SHOWING FORMWORK CHECKS ILU 28, 29 and 30	CLIENT: PBS BUILDING	
	1	13/5/15	REVISED	SURVEY DATE : 6/5/15		JOB No : 1500259	
				DRAWN : DB	PROJECT: WARRIEWOOD ARV	DWG No : 017	
				APPROVED : JR		REV 1	
	REVISION	DATE	DESCRIPTION				

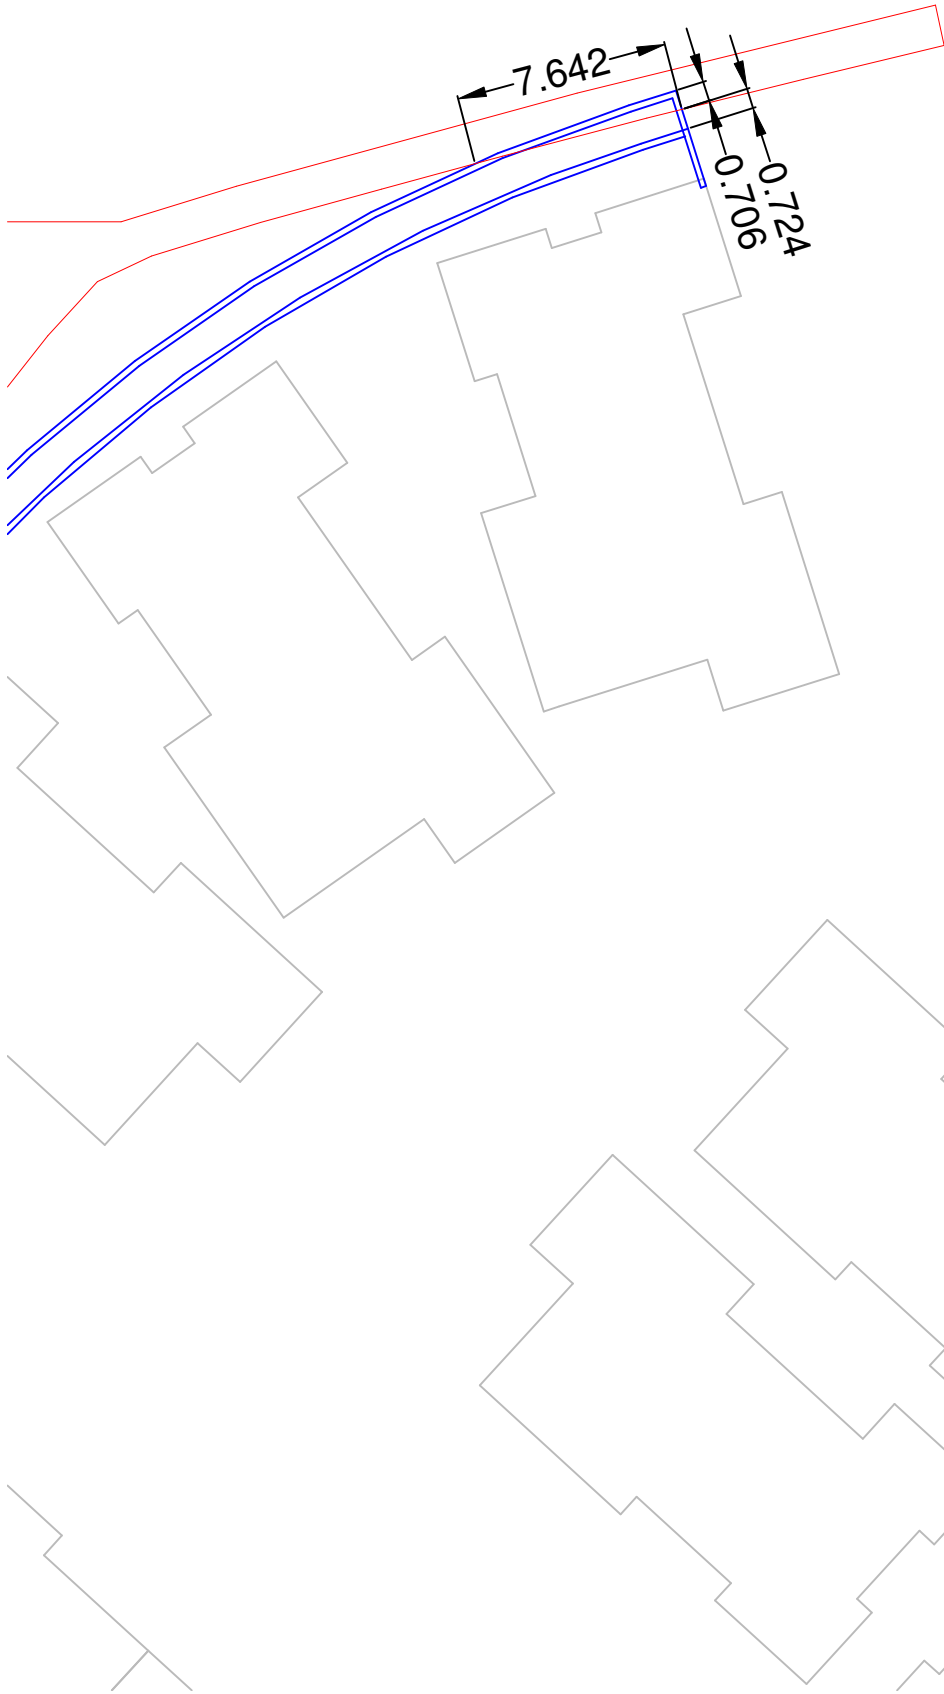

Land Surveys

Level 5, 7 Eden Park Drive
Macquarie NSW 2113
T (02) 8935 9451
F (02) 8935 9401
www.landsurveys.net.au
E sydney@landsurveys.net.au


SCALE :
1: XXX
ORIGINAL SIZE :

0	27/3/15	ISSUED TO CLIENT
REVISION	DATE	DESCRIPTION


SURVEYOR : DB
SURVEY DATE : 25/3/15
DRAWN : DB
APPROVED : JR


TITLE: SKETCH SHOWING OFFSETS FROM EXISTING PATH TO NORTH WEST RETAINING WALL
PROJECT: WARRIEWOOD ARV


CLIENT: PBS BUILDING	
JOB No : 1500259	
DWG No : 007	REV 0

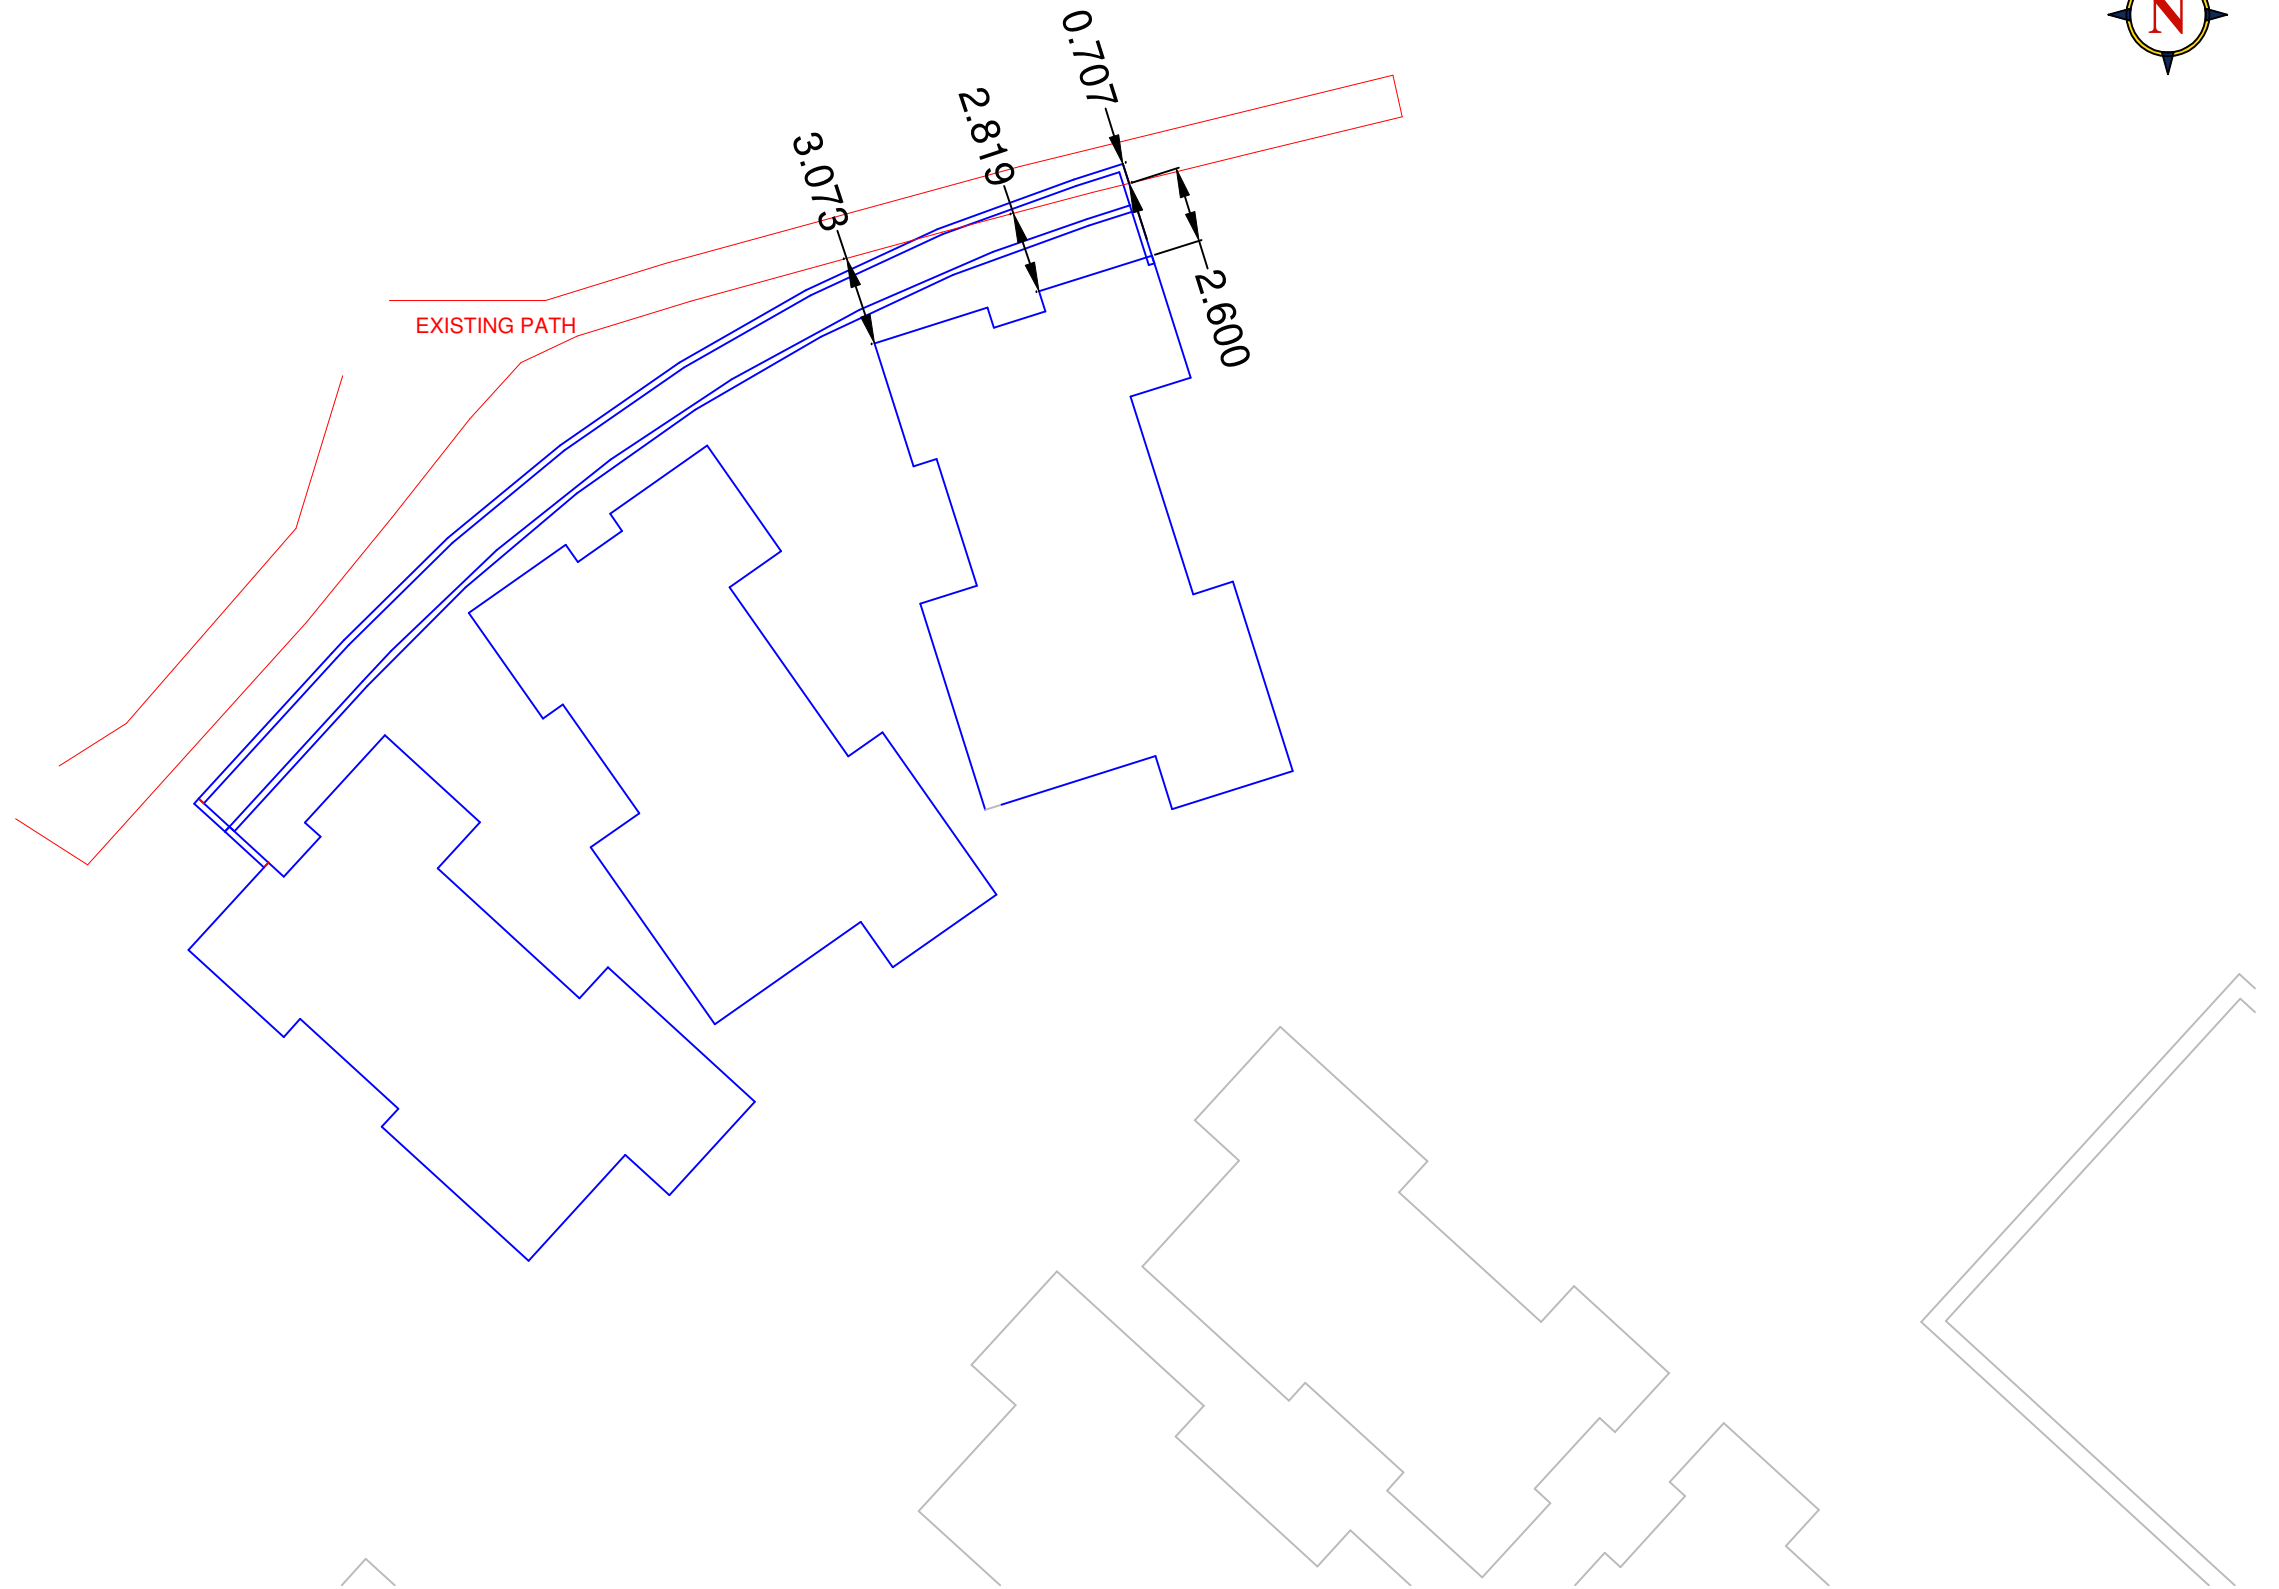


Land Surveys Sydney Office T (02) 8935 9451 F (02) 8935 9401 Level 5, 7 Eden Park DriveMacquarie NSW 2113www.landsurveys.net.au E sydney@landsurveys.net.au SCALE : 1: XXX ORIGINAL SIZE :	0	26/3/15	ISSUED TO CLIENT	SURVEYOR : DB	TITLE: SKETCH SHOWING OFFSETS FROM EXISTING PATH TO PROPOSED RETAINING WALL AND HOUSE	CLIENT: PBS BUILDING	
				SURVEY DATE : 25/3/15		JOB No : 1500259	
				DRAWN : DB	PROJECT: WARRIEWOOD ARV	DWG No : 005	
				APPROVED : JR		REV 0	
							
	REVISION	DATE	DESCRIPTION				

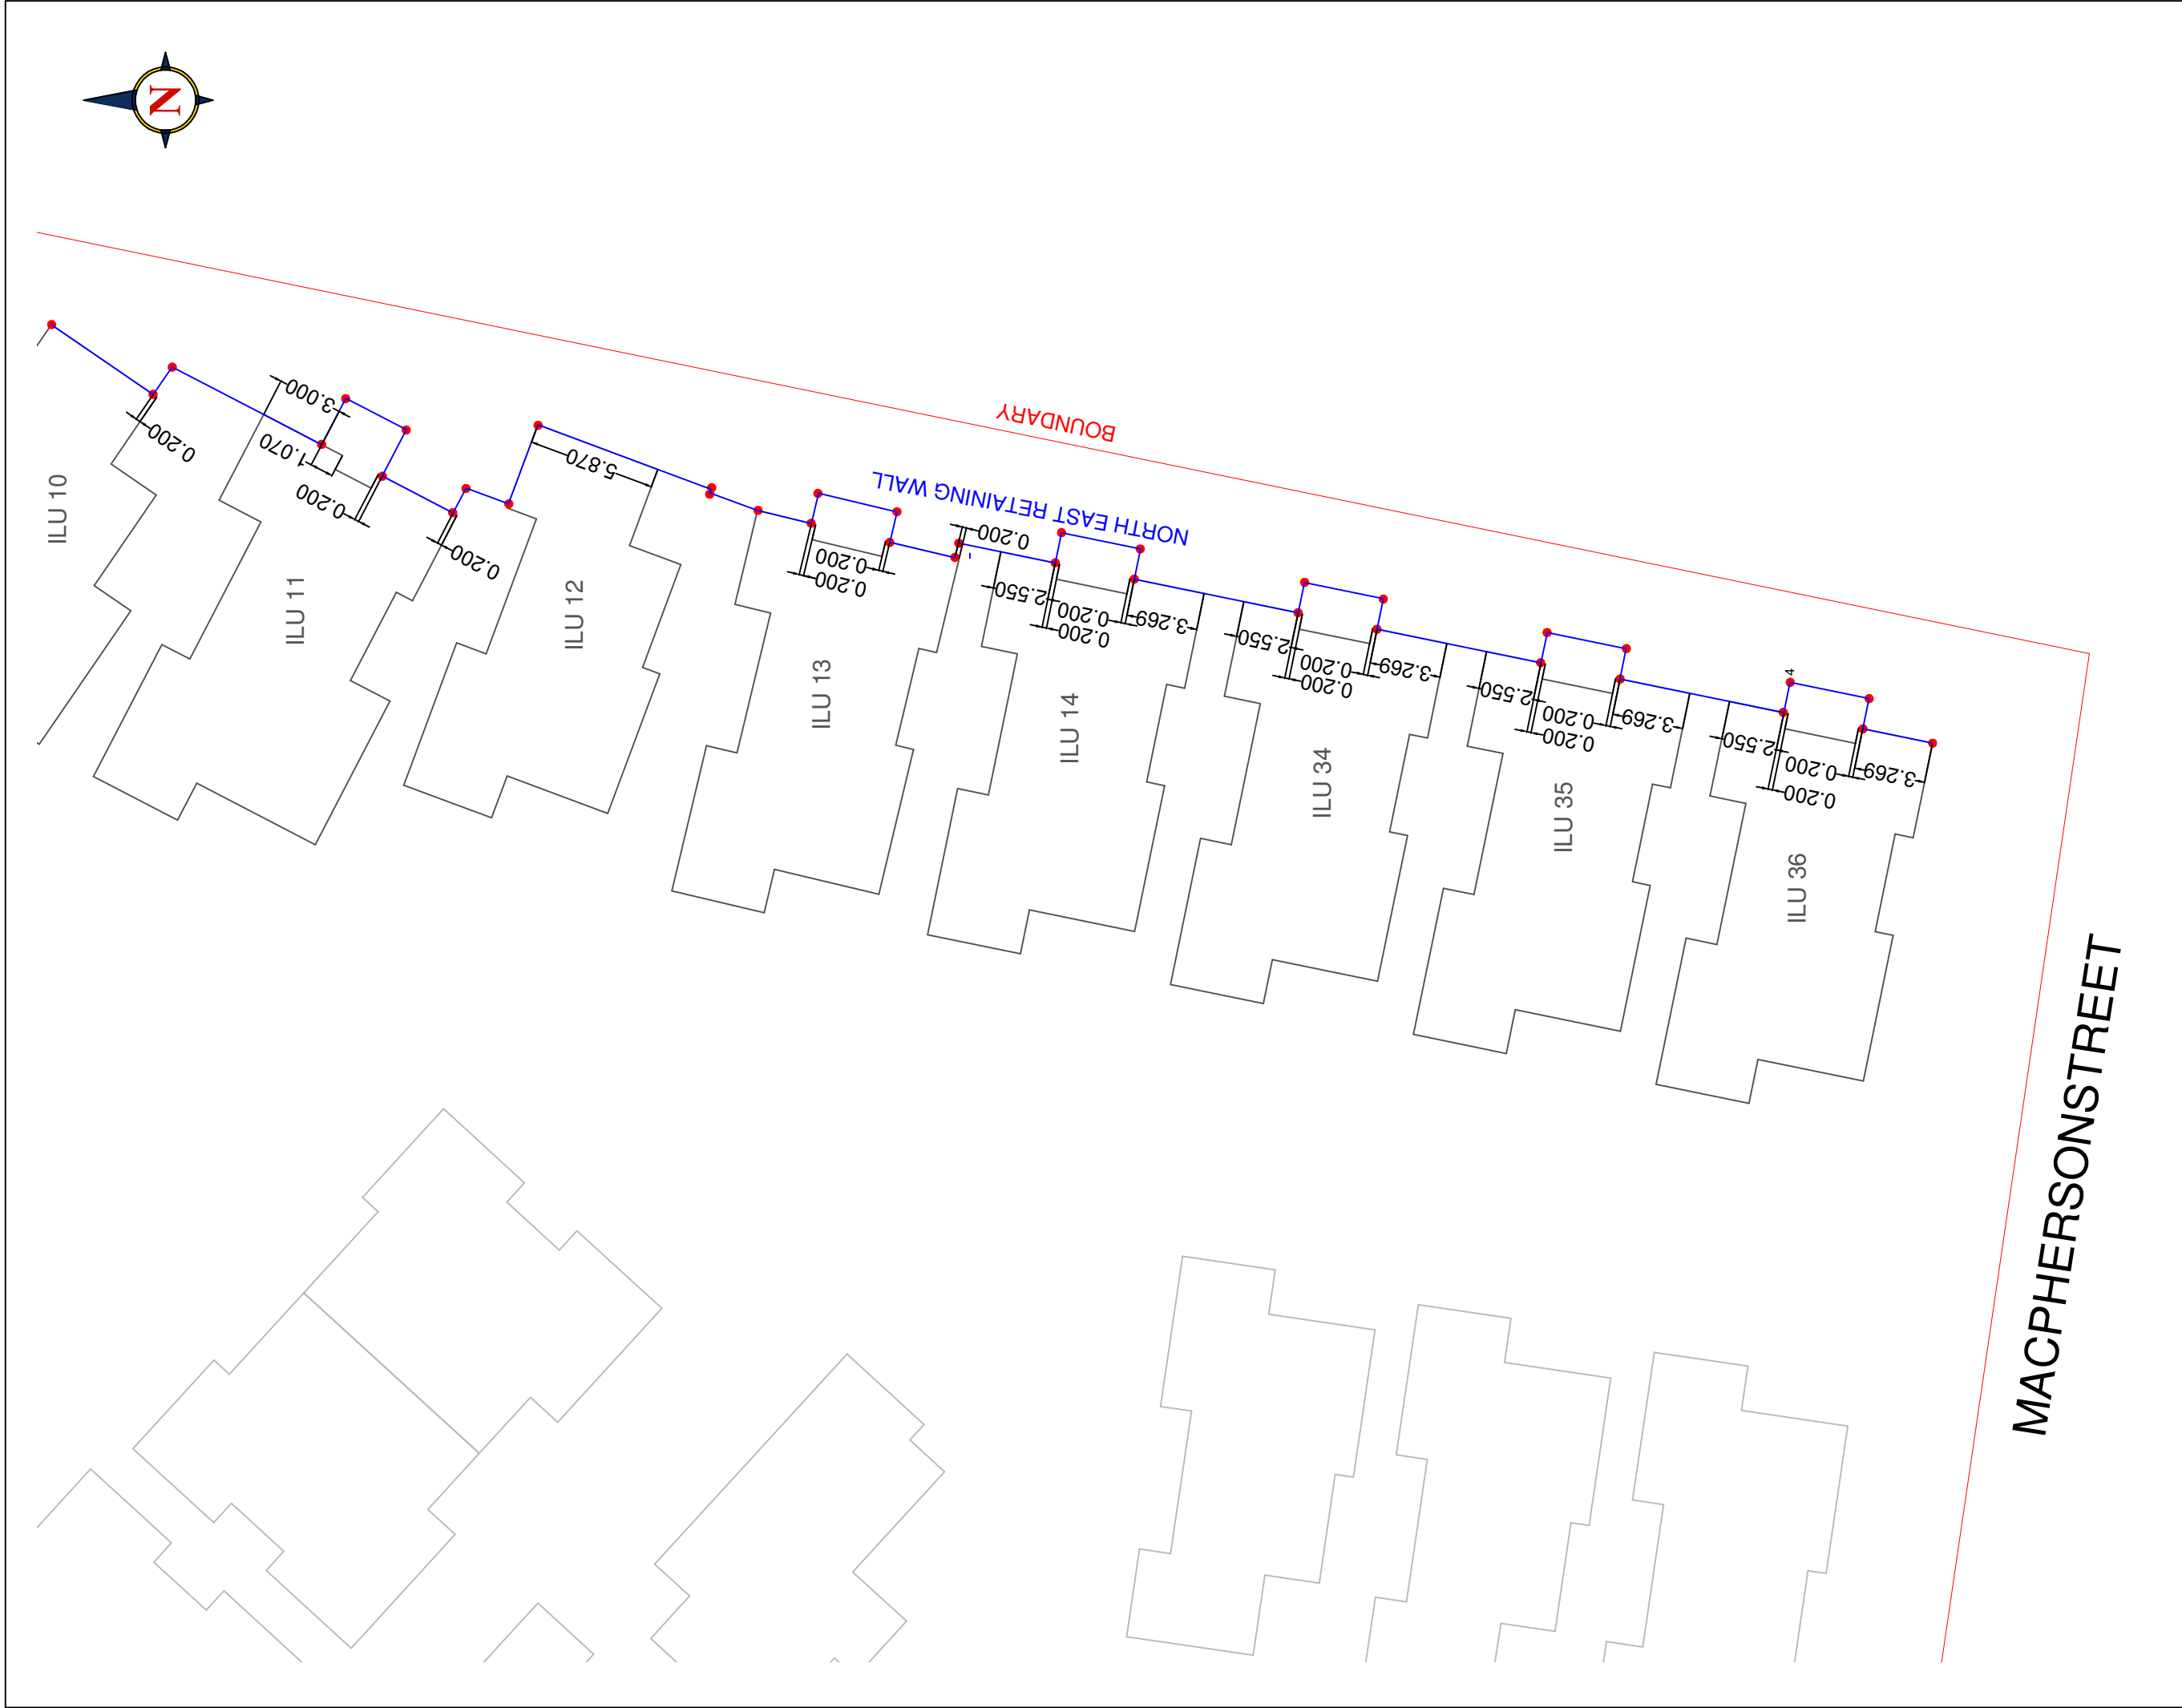


Land Surveys Level 5, 7 Eden Park Drive Macquarie NSW 2113 T (02) 8935 9451 F (02) 8935 9401 www.land-surveys.net.au E sydney@land-surveys.net.au	SURVEYOR : DB		TITLE: SKETCH SHOWING OFFSETS FROM RETAINING WALL TO HOUSE CORNERS	CLIENT: PBS BUILDING	
	SURVEY DATE : 16/4/15				
	DRAWN : DB				
	APPROVED : JR				
	 PBSBUILDING				
SCALE : 1:XXX ORIGINAL SIZE :		PROJECT: WARRIEWOOD ARV		JOB No : 1500259	
				DWG No : 015	REV 0

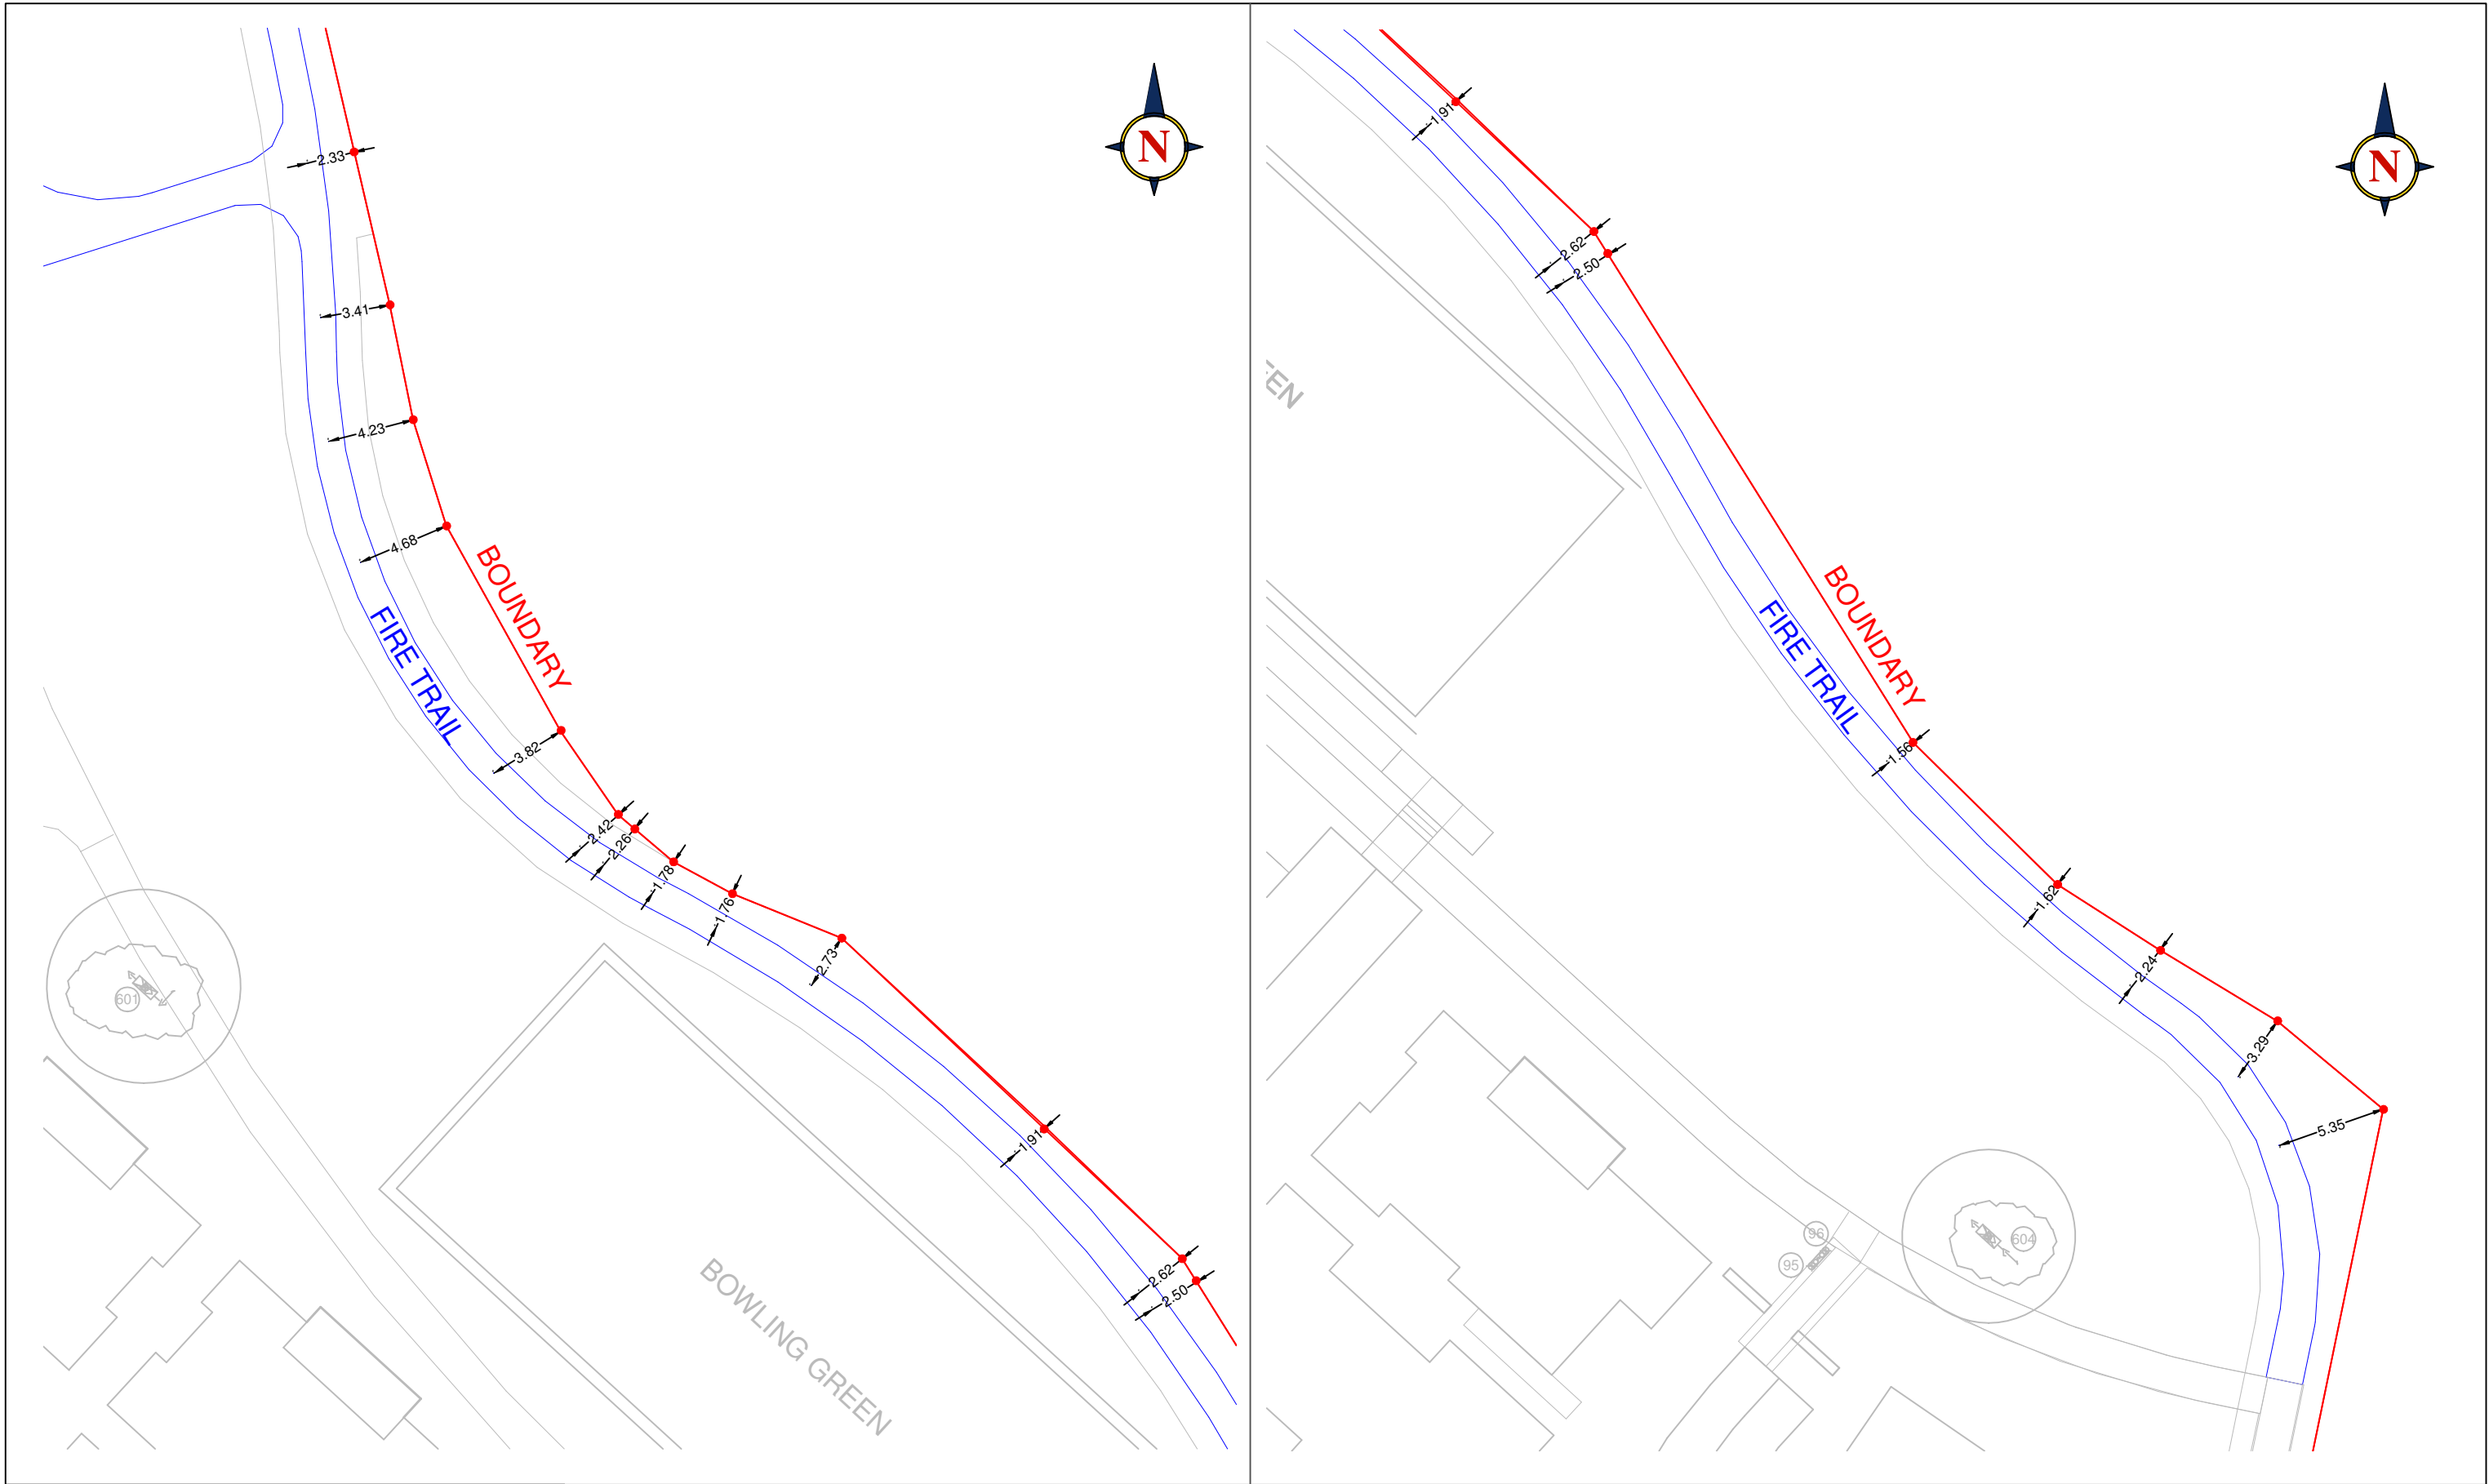

Land Surveys Level 5, 7 Eden Park Drive Macquarie NSW 2113 T (02) 8935 9451 F (02) 8935 9401 www.landsurveys.net.au E sydney@landsurveys.net.au	0	11/4/15	ISSUED TO CLIENT	SURVEYOR : DB	TITLE:SKETCH SHOWING PEGED BOUNDARY POSITIONS AND OFFSETS TO CENTRE OF FIRE TRAIL	CLIENT: PBS BUILDING	
				SURVEY DATE : 10/4/15			
				DRAWN : DB	PROJECT: WARRIEWOOD ARV	JOB No : 1500259	
				APPROVED : JR			
				PBSBUILDING			
SCALE : 1: 300 ORIGINAL SIZE :	REVISION	DATE	DESCRIPTION		DWG No : 012	REV 0	

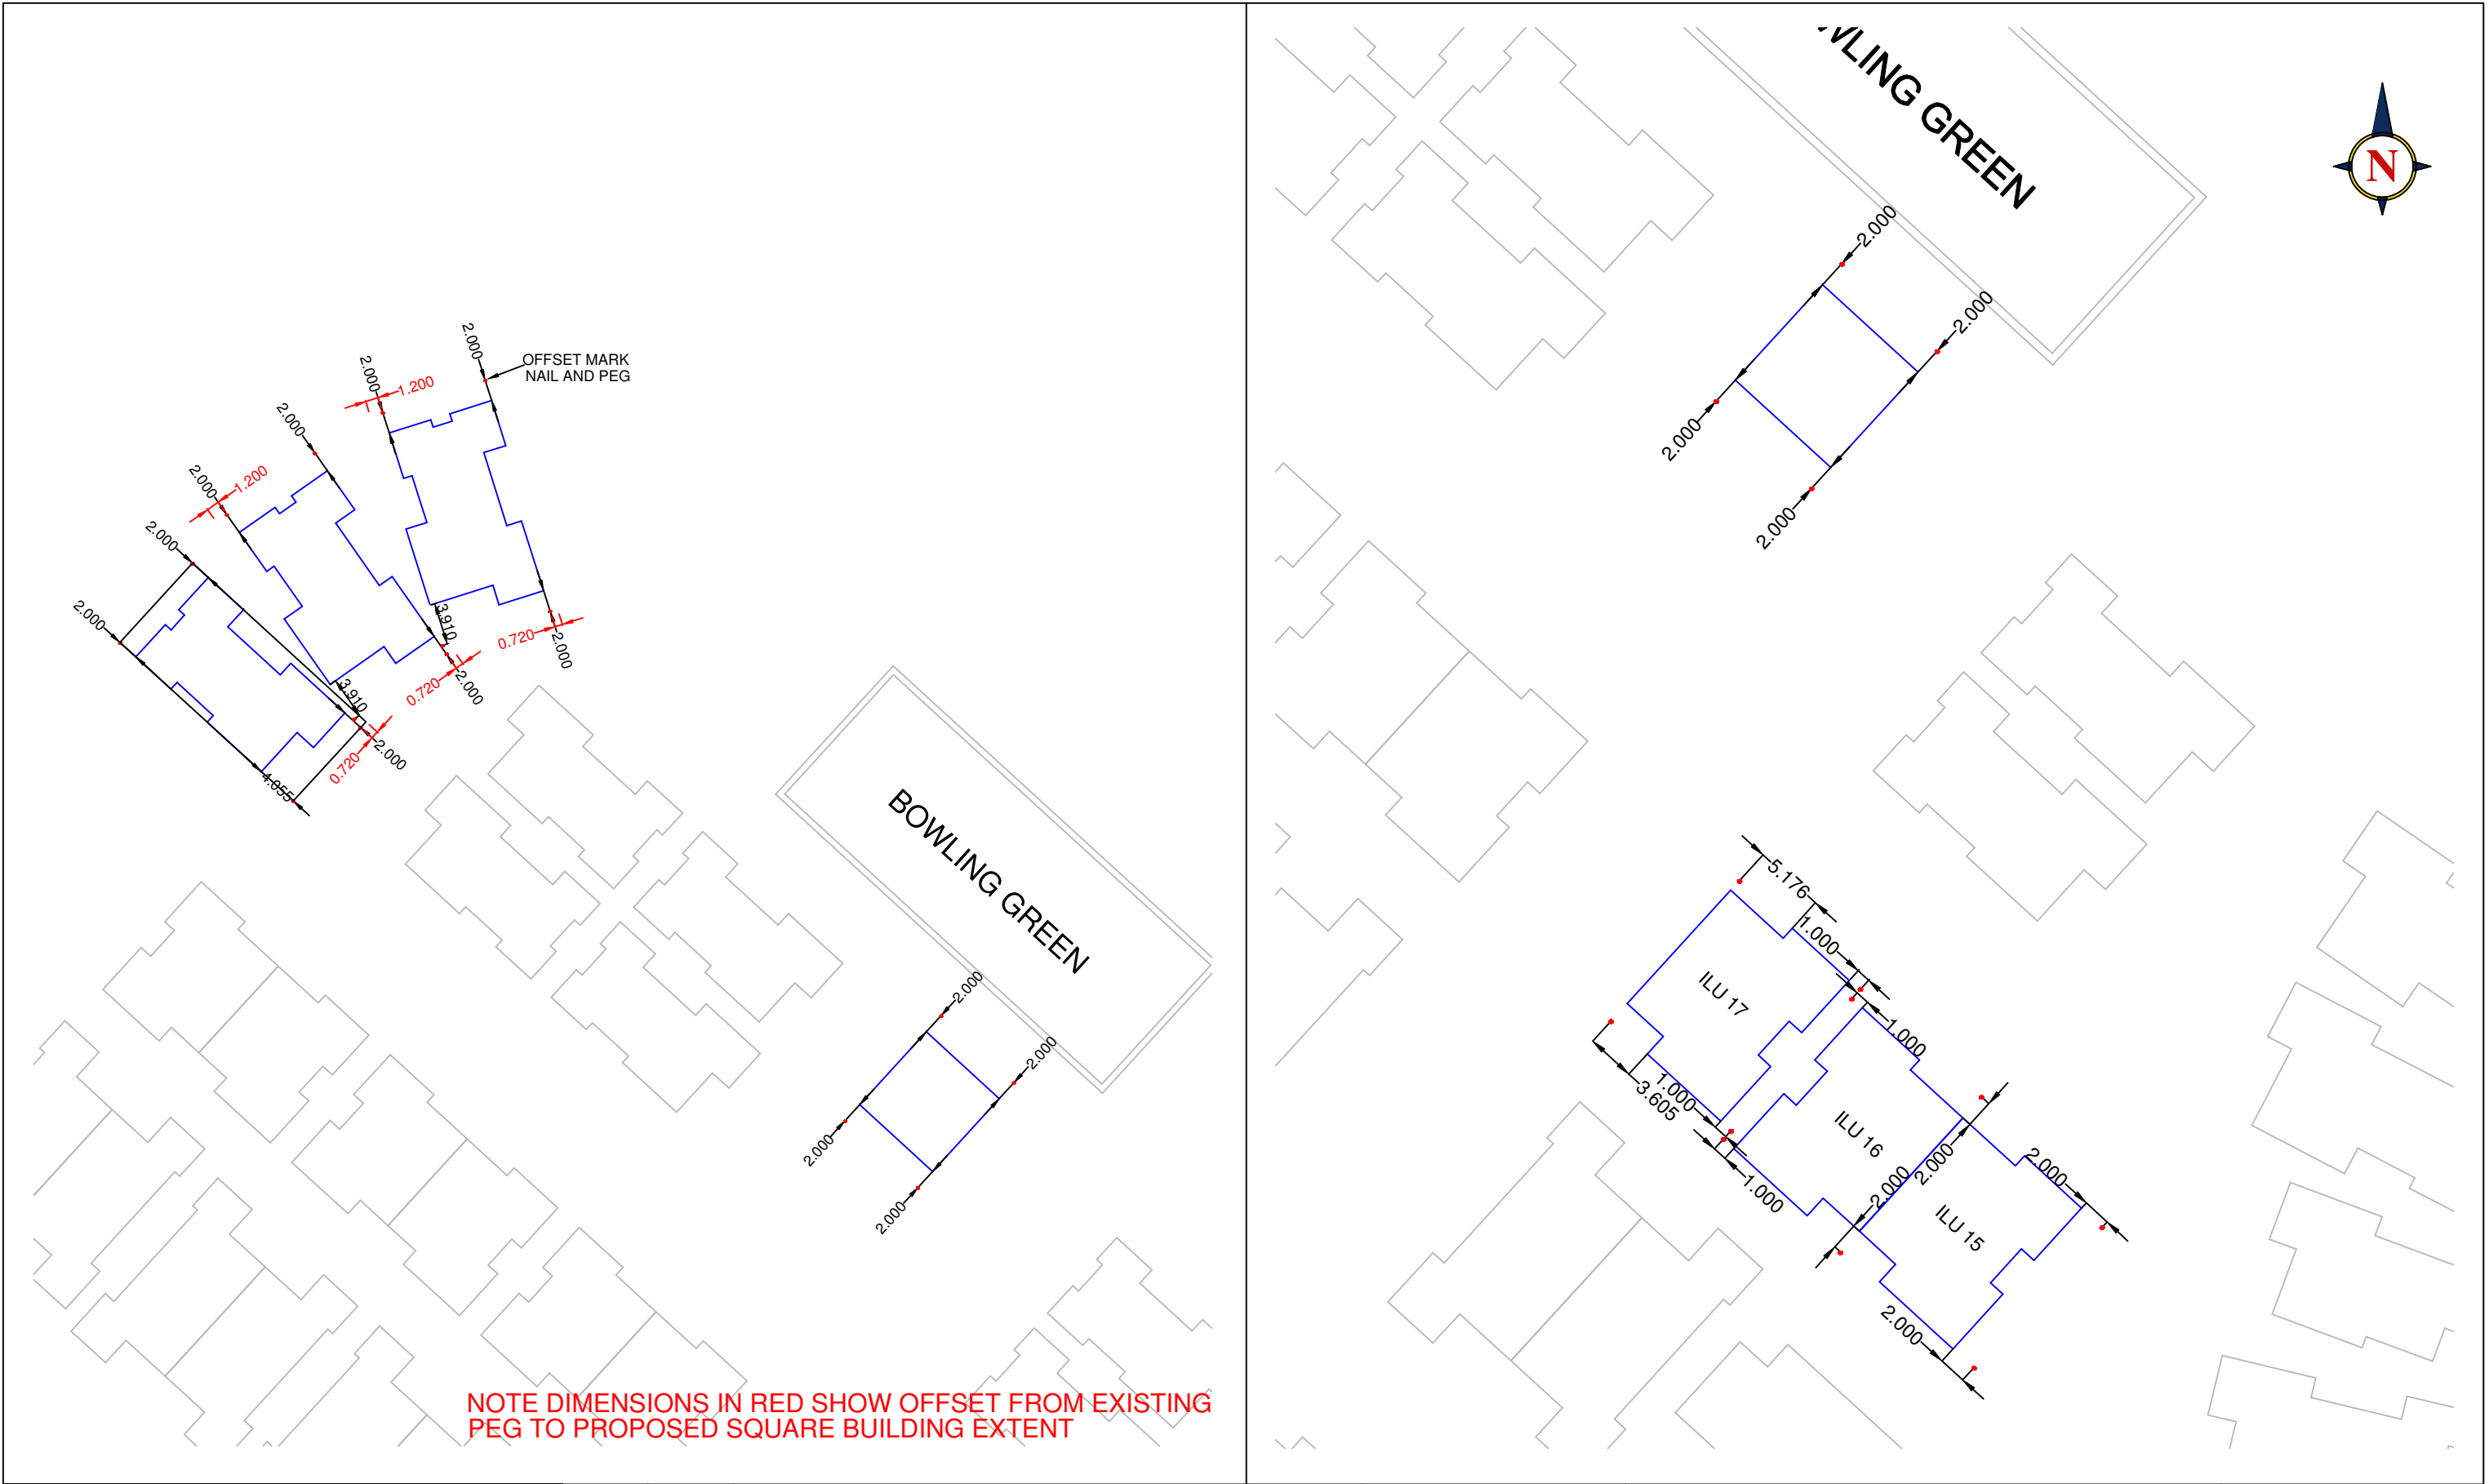

Land Surveys Sydney Office T (02) 8935 9451 F (02) 8935 9401 Level 5, 7 Eden Park DriveMacquarie NSW 2113 www.landsurveys.net.au E sydney@landsurveys.net.au SCALE : 1: XXX ORIGINAL SIZE :	0	26/3/15	ISSUED TO CLIENT	SURVEYOR : DB	TITLE: SKETCH SHOWING SETOUT OF HOUSES	CLIENT: PBS BUILDING	
	1	7/4/15	ISSUED TO CLIENT	SURVEY DATE : 25/3/15			
	2	31/8/15	ISSUED TO CLIENT	DRAWN : DB	PROJECT: WARRIEWOOD ARV	JOB No : 1500259	
				APPROVED : JR			
				PBSBUILDING		DWG No : 004	REV 2
	REVISION	DATE	DESCRIPTION				

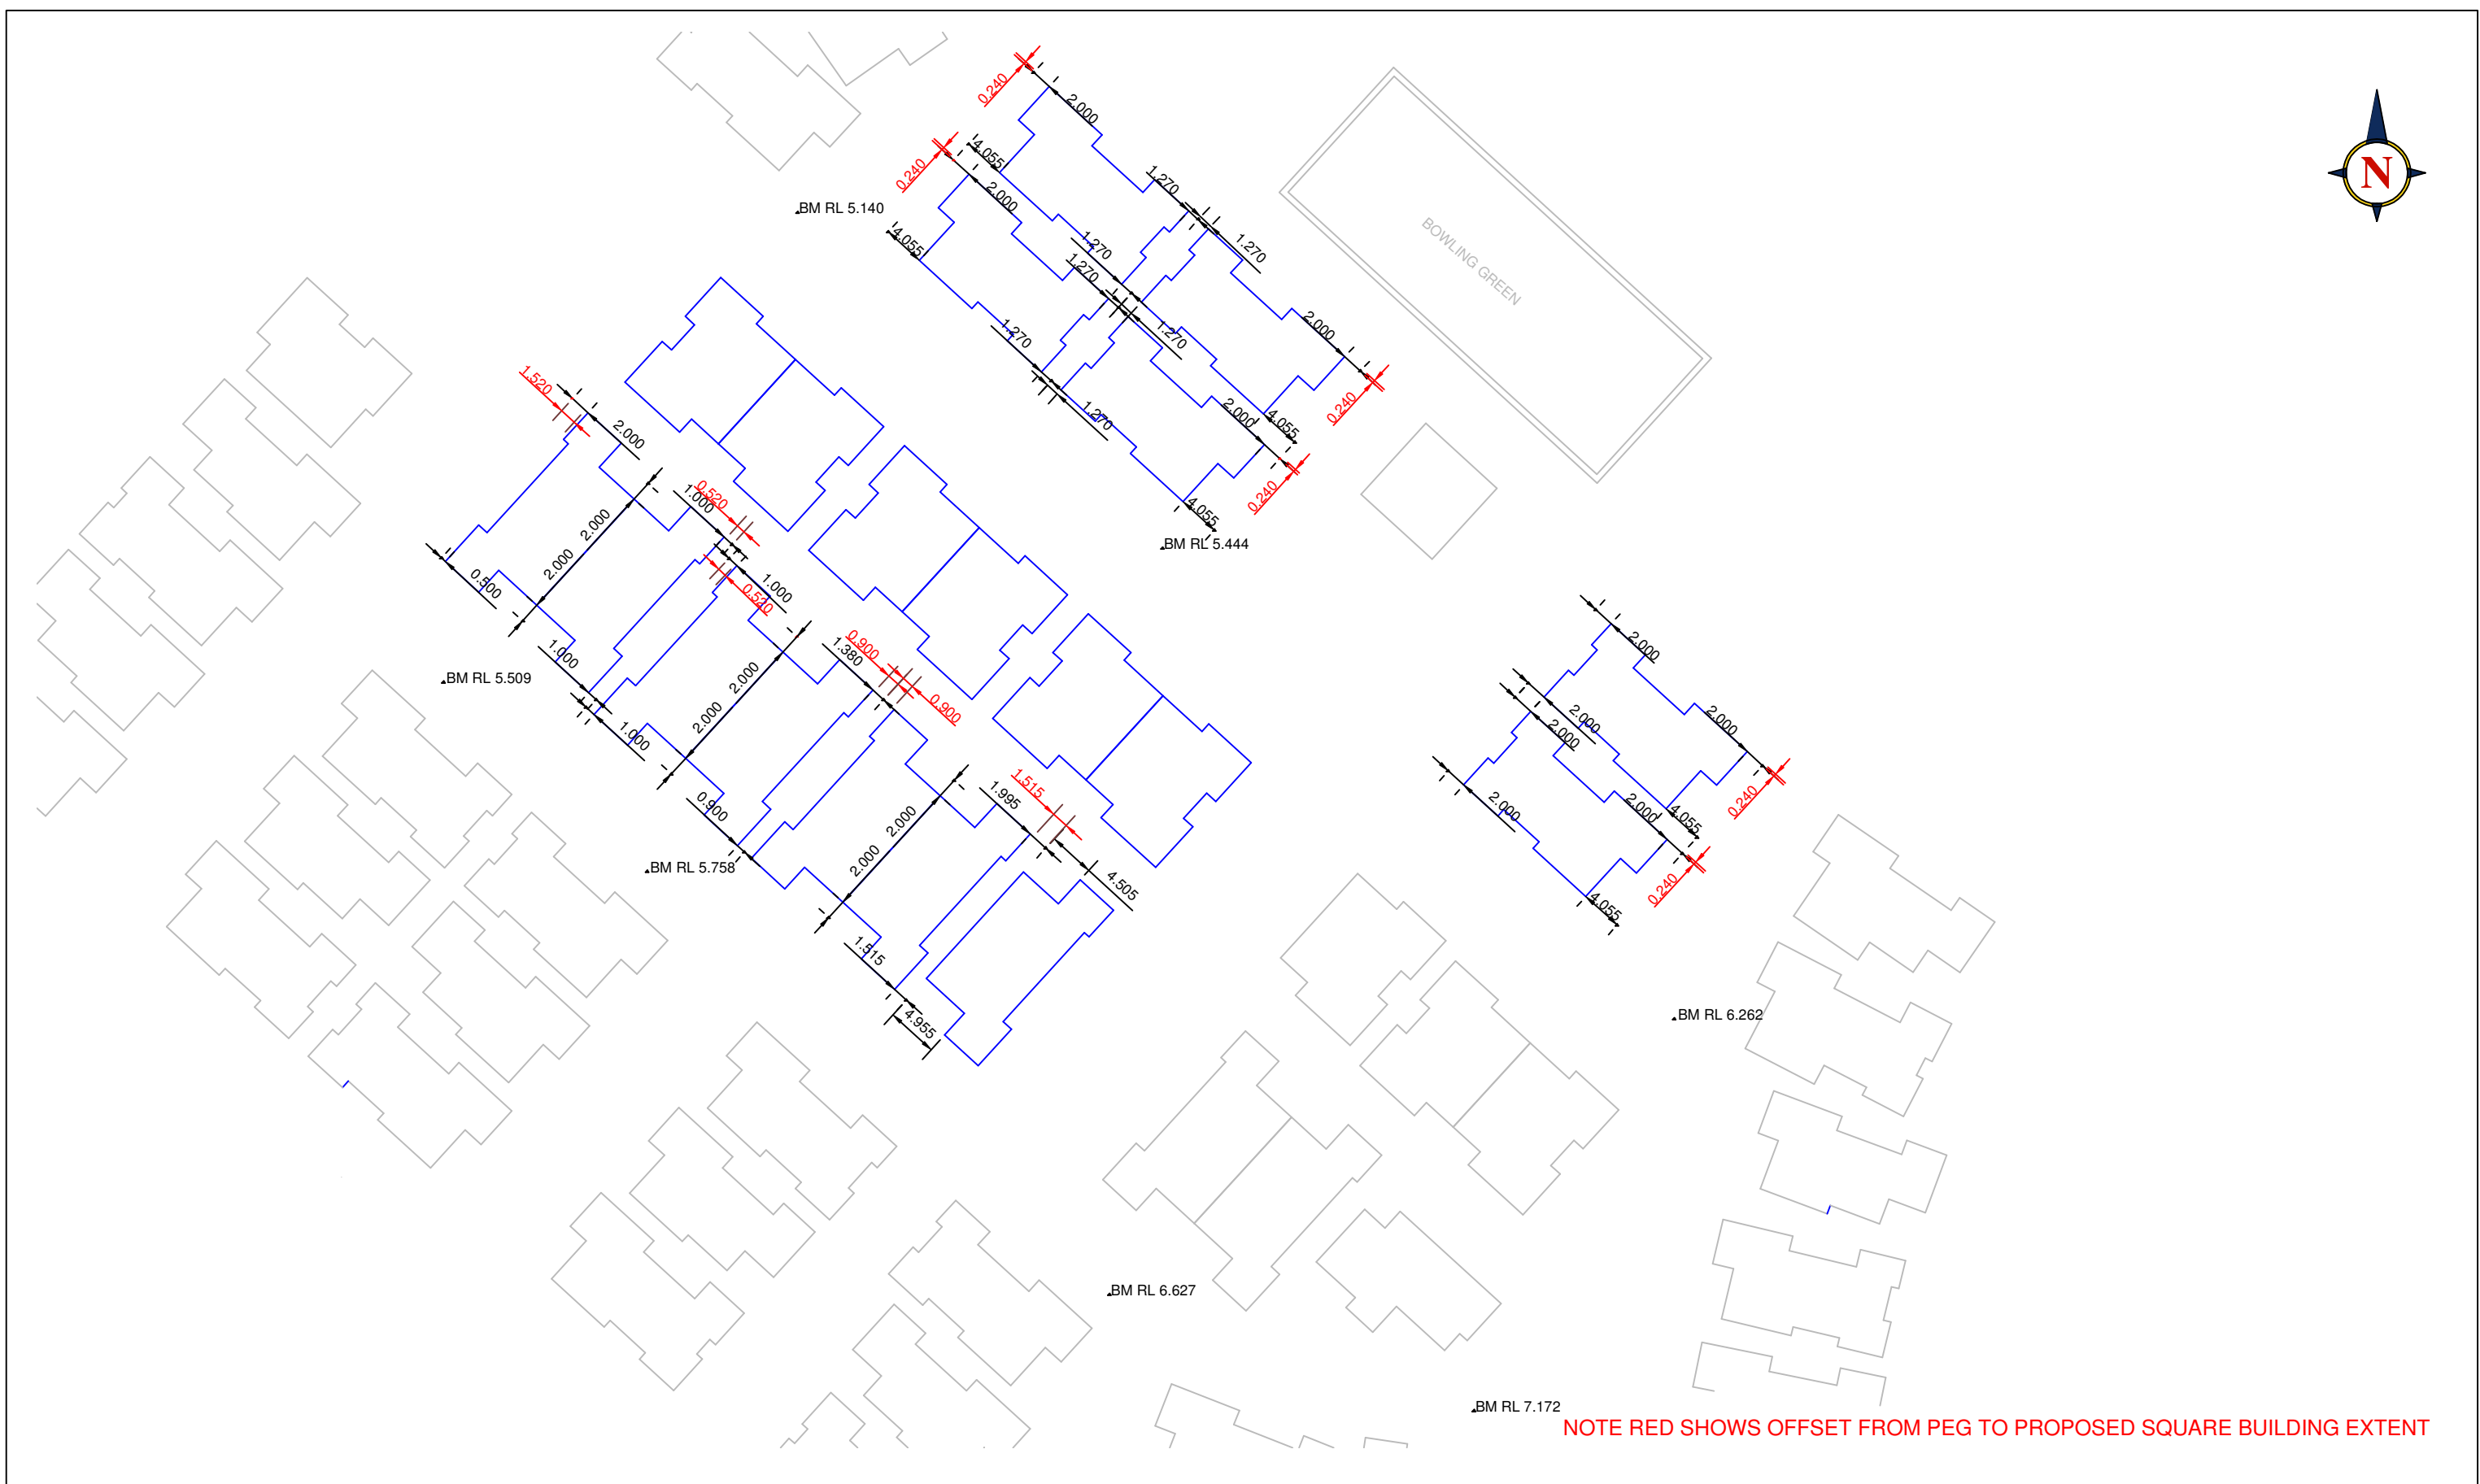


NOTE RED SHOWS OFFSET FROM PEG TO PROPOSED SQUARE BUILDING EXTENT


Land Surveys Level 5, 7 Eden Park Drive Macquarie NSW 2113 T (02) 8935 9451 F (02) 8935 9401 www.landsurveys.net.au E sydney@landsurveys.net.au	3	16/4/15	ISSUED TO CLIENT	SURVEYOR : DANIEL BENN	TITLE: SKETCH SHOWING HOUSE SETOUT POINTS AND BENCH MARKS	CLIENT: ARV	
				SURVEY DATE : 15/4/15			
				DRAWN : DANIEL BENN	PROJECT: WARRIEWOOD ARV	JOB No : 1500259	
				APPROVED : JR			
SCALE : XXX 1: ORIGINAL SIZE :	REVISION	DATE	DESCRIPTION			DWG No : 002	REV 3




Land Surveys Sydney Office T (02) 8935 9451 F (02) 8935 9401 www.landsurveys.net.au E sydney@landsurveys.net.au SCALE : 1: 500 ORIGINAL SIZE :	0	26/3/15	ISSUED TO CLIENT	SURVEYOR : DB	TITLE: SKETCH SHOWING SETOUT OF HOUSES	CLIENT: PBS BUILDING	
	1	11/4/15	REVISED	SURVEY DATE : 15/5/15			
	2	15/5/15	REVISED ILU 23 AND 33 RESETOUT	DRAWN : DB	PROJECT: WARRIEWOOD ARV	JOB No : 1500259	
				APPROVED : JR			
				PBSBUILDING		DWG No : 003	REV 2
	REVISION	DATE	DESCRIPTION				

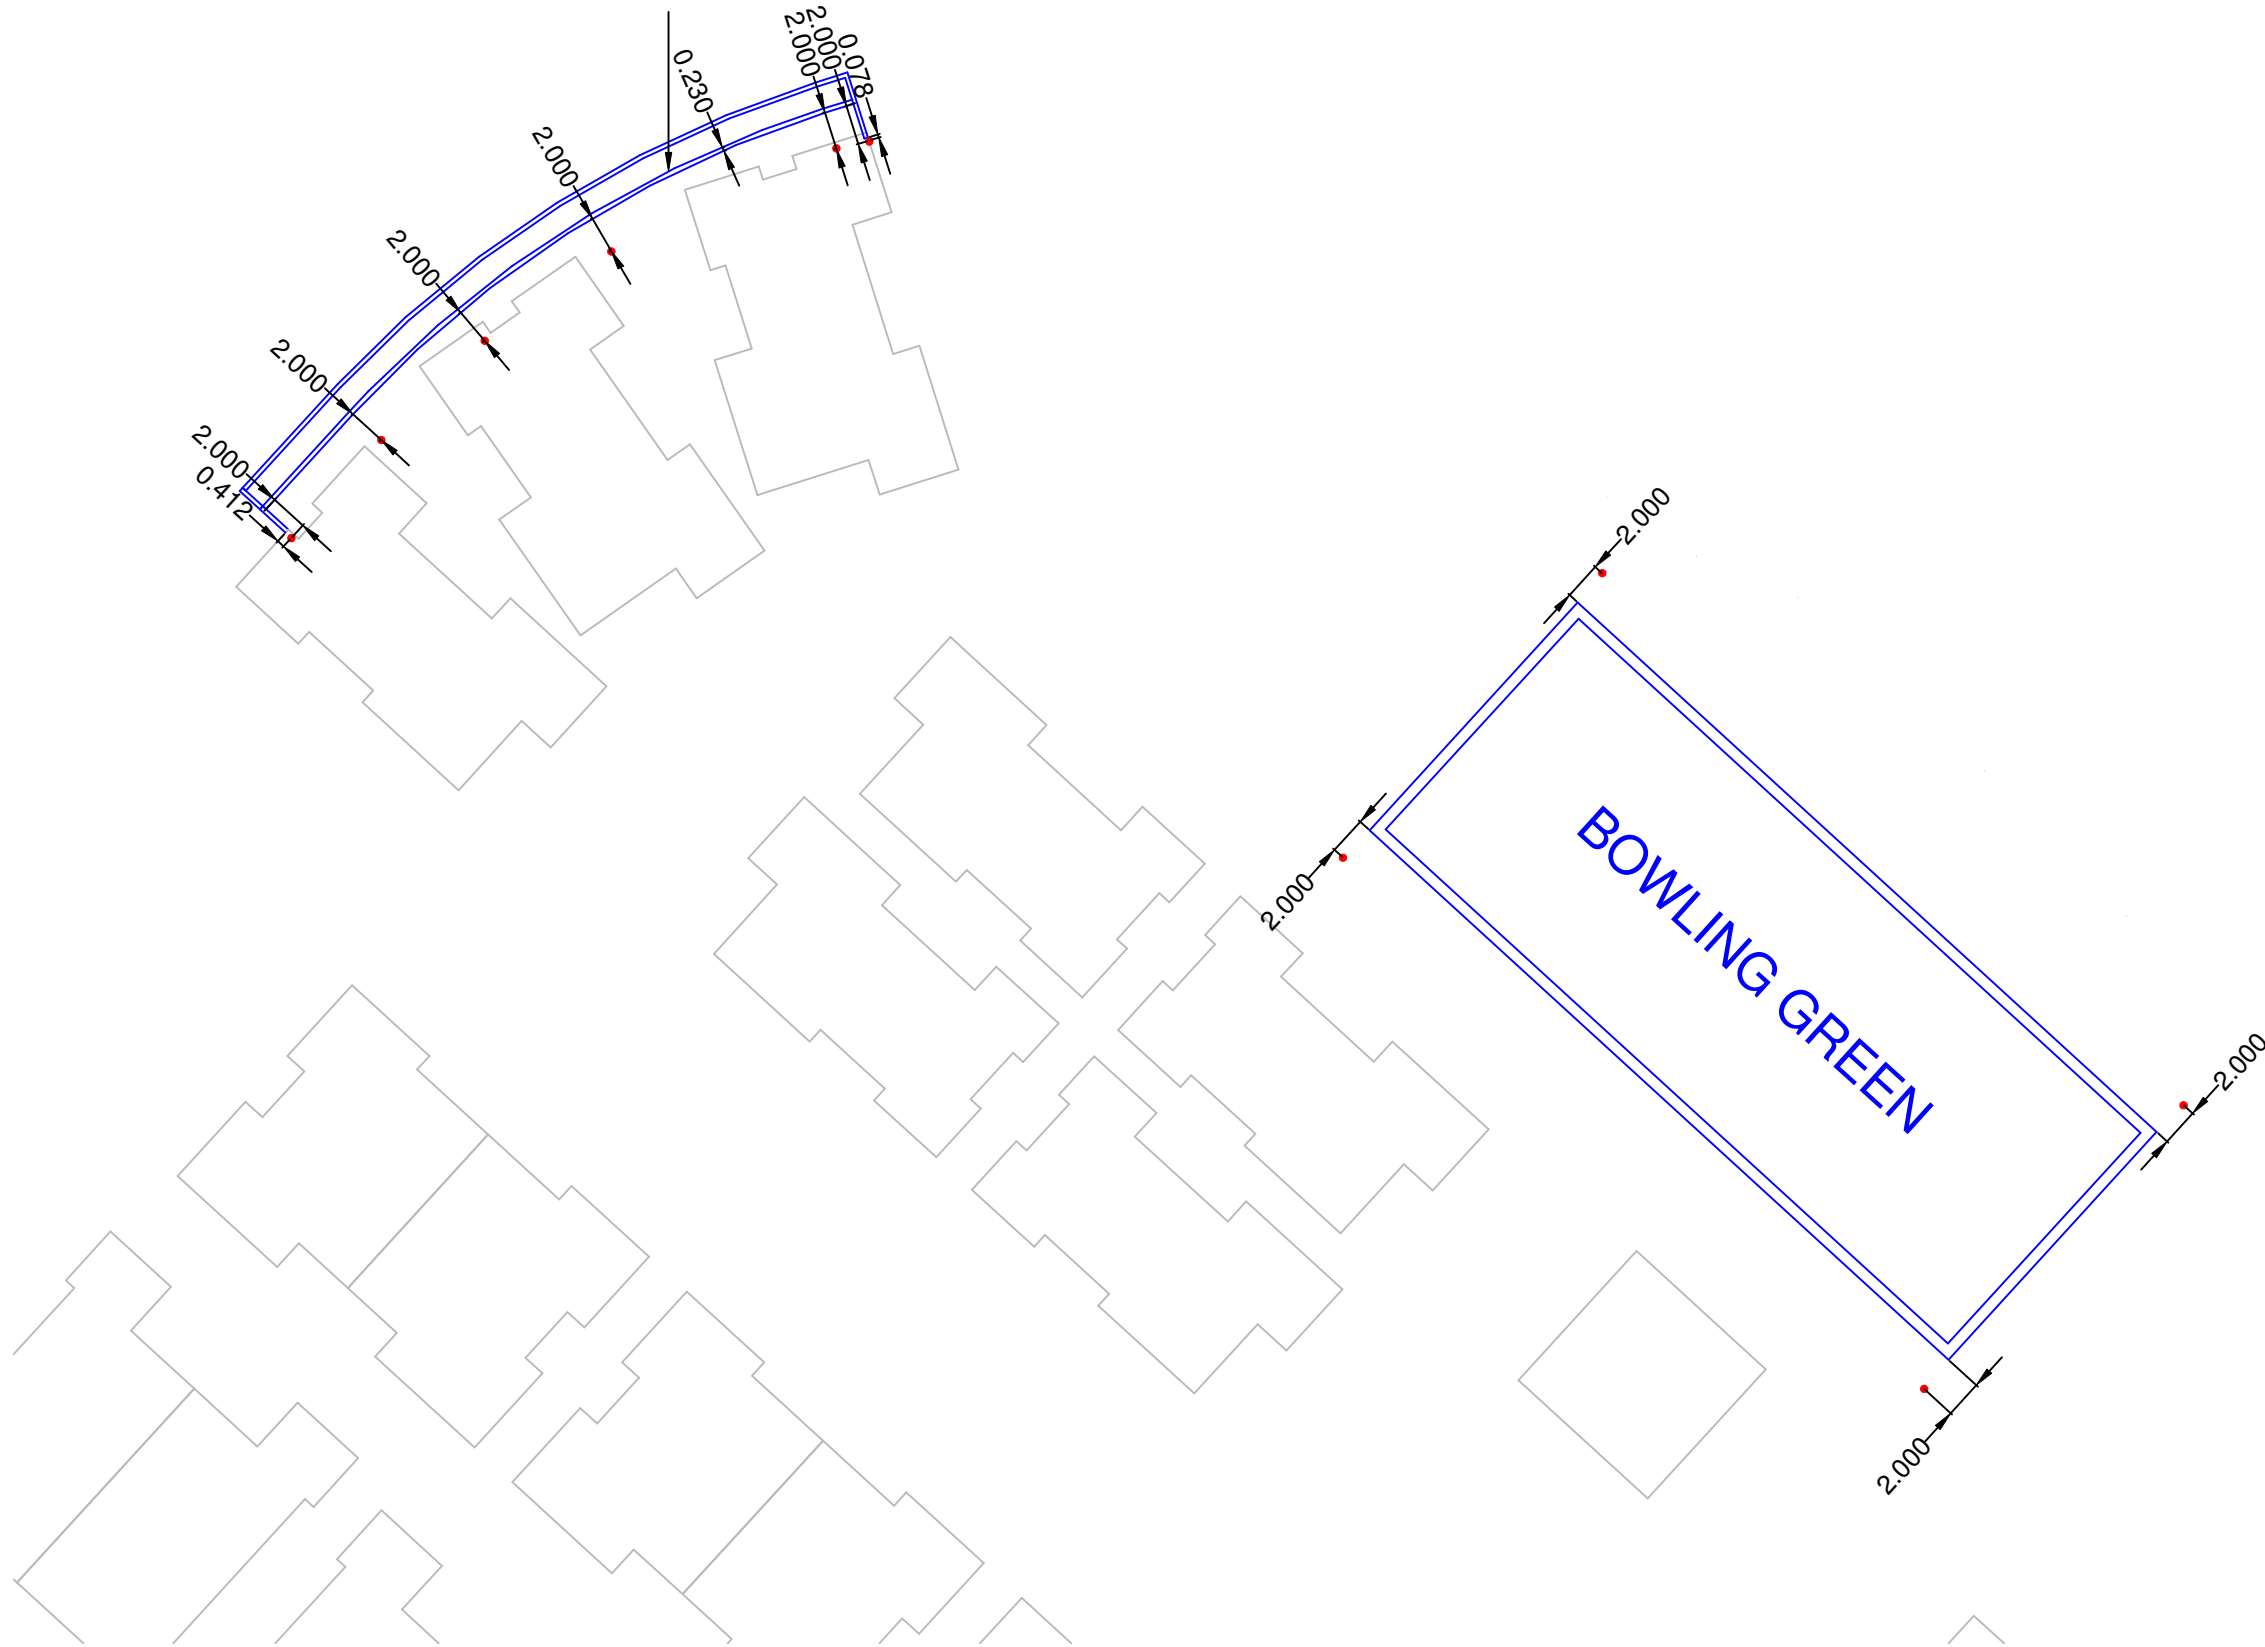


 Level 5, 7 Eden Park Drive Macquarie NSW 2113 T (02) 8935 9451 F (02) 8935 9401 www.landsurveys.net.au E sydney@landsurveys.net.au	0	31/3/15	ISSUED TO CLIENT	SURVEYOR : DB	TITLE: SKETCH SHOWING SETOUT OF BOWLING GREEN AND NORTH WEST RETAINING WALL PROJECT: WARRIEWOOD ARV	CLIENT: PBS BUILDING		
				SURVEY DATE : 31/3/15				
				DRAWN : DB				
				APPROVED : JR				
								
SCALE : 1: XXX ORIGINAL SIZE :	REVISION	DATE	DESCRIPTION				DWG No : 008 REV 0	

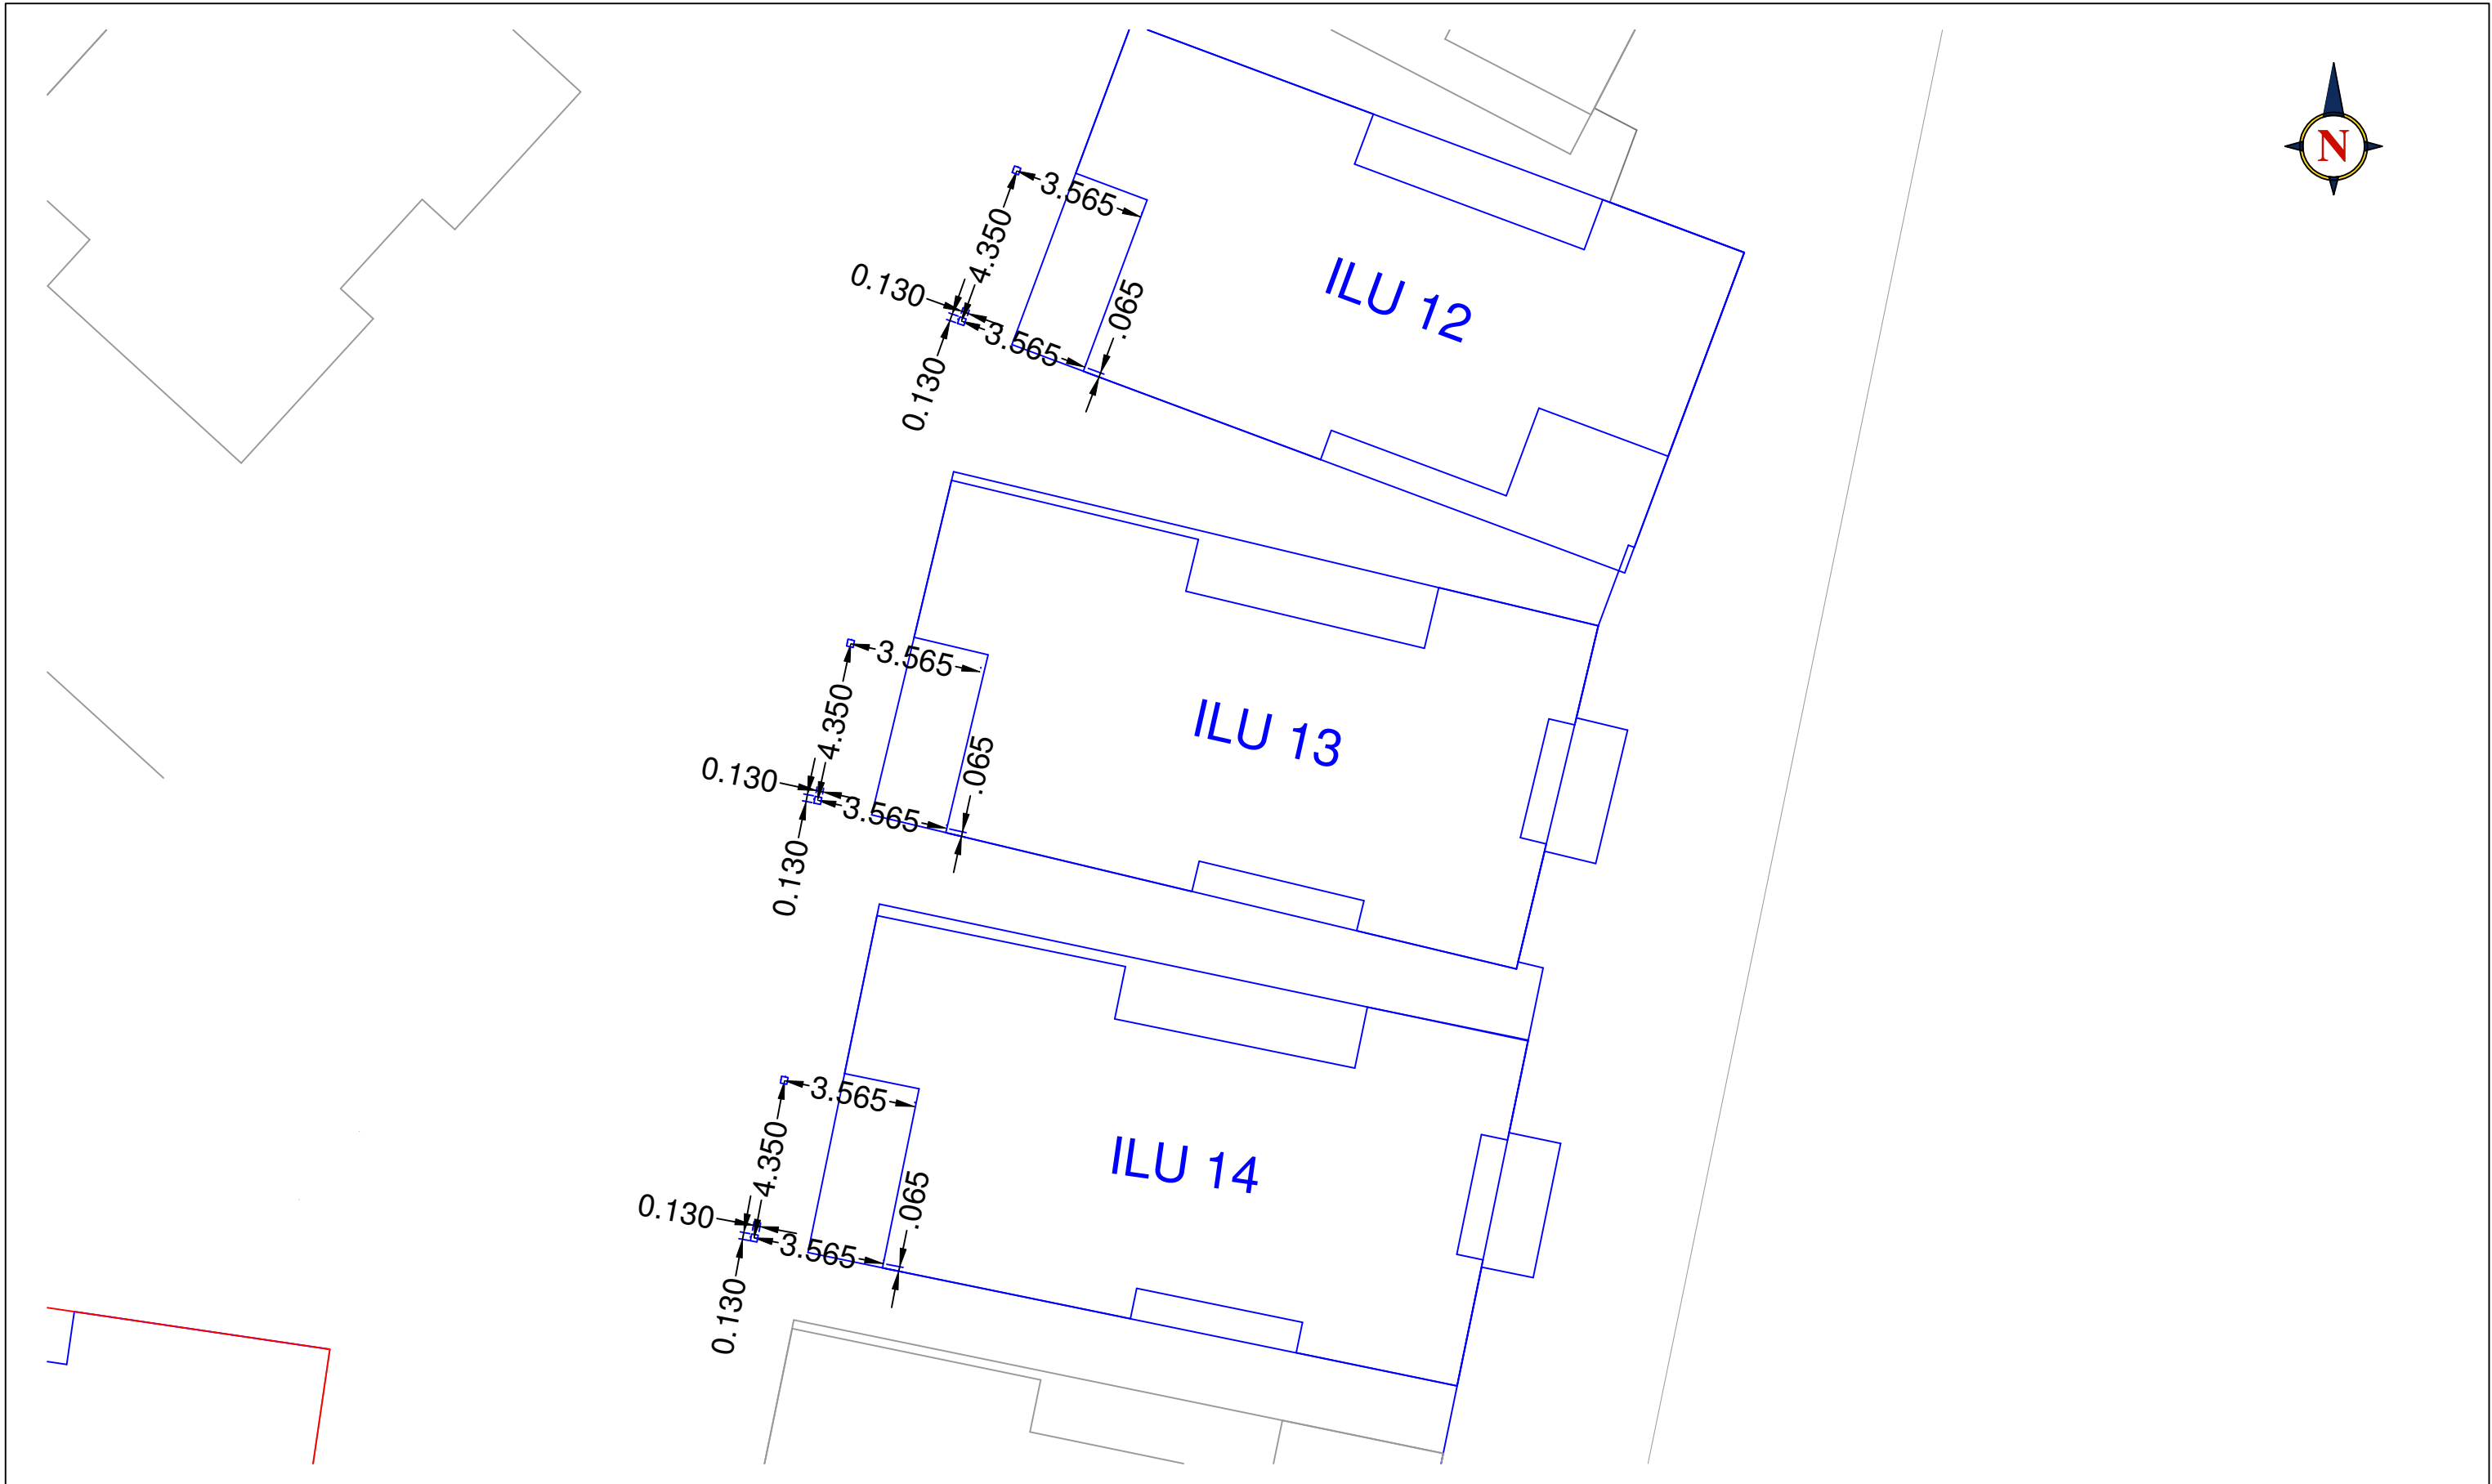

Land Surveys Sydney Office Suite 3, 78 Reserve Road Artarmon NSW 2064 T (02) 8935 9451 F (02) 8935 9401 www.landsurveys.net.au E sydney@landsurveys.net.au SCALE : 1: 200 ORIGINAL SIZE : 	0	14/7/15	ISSUED TO CLIENT	SURVEYOR : DB	TITLE: SKETCH SHOWING SETOUT OF DRIVE WAY PILLARS ILU 12,13 AND 14	CLIENT: PBS BUILDING	
				SURVEY DATE : 14/7/15		JOB No : 1500259	
				DRAWN : DB	PROJECT: WARRIEWOOD ARV	DWG No : 031	
				APPROVED : JR		REV 0	
							
	REVISION	DATE	DESCRIPTION				

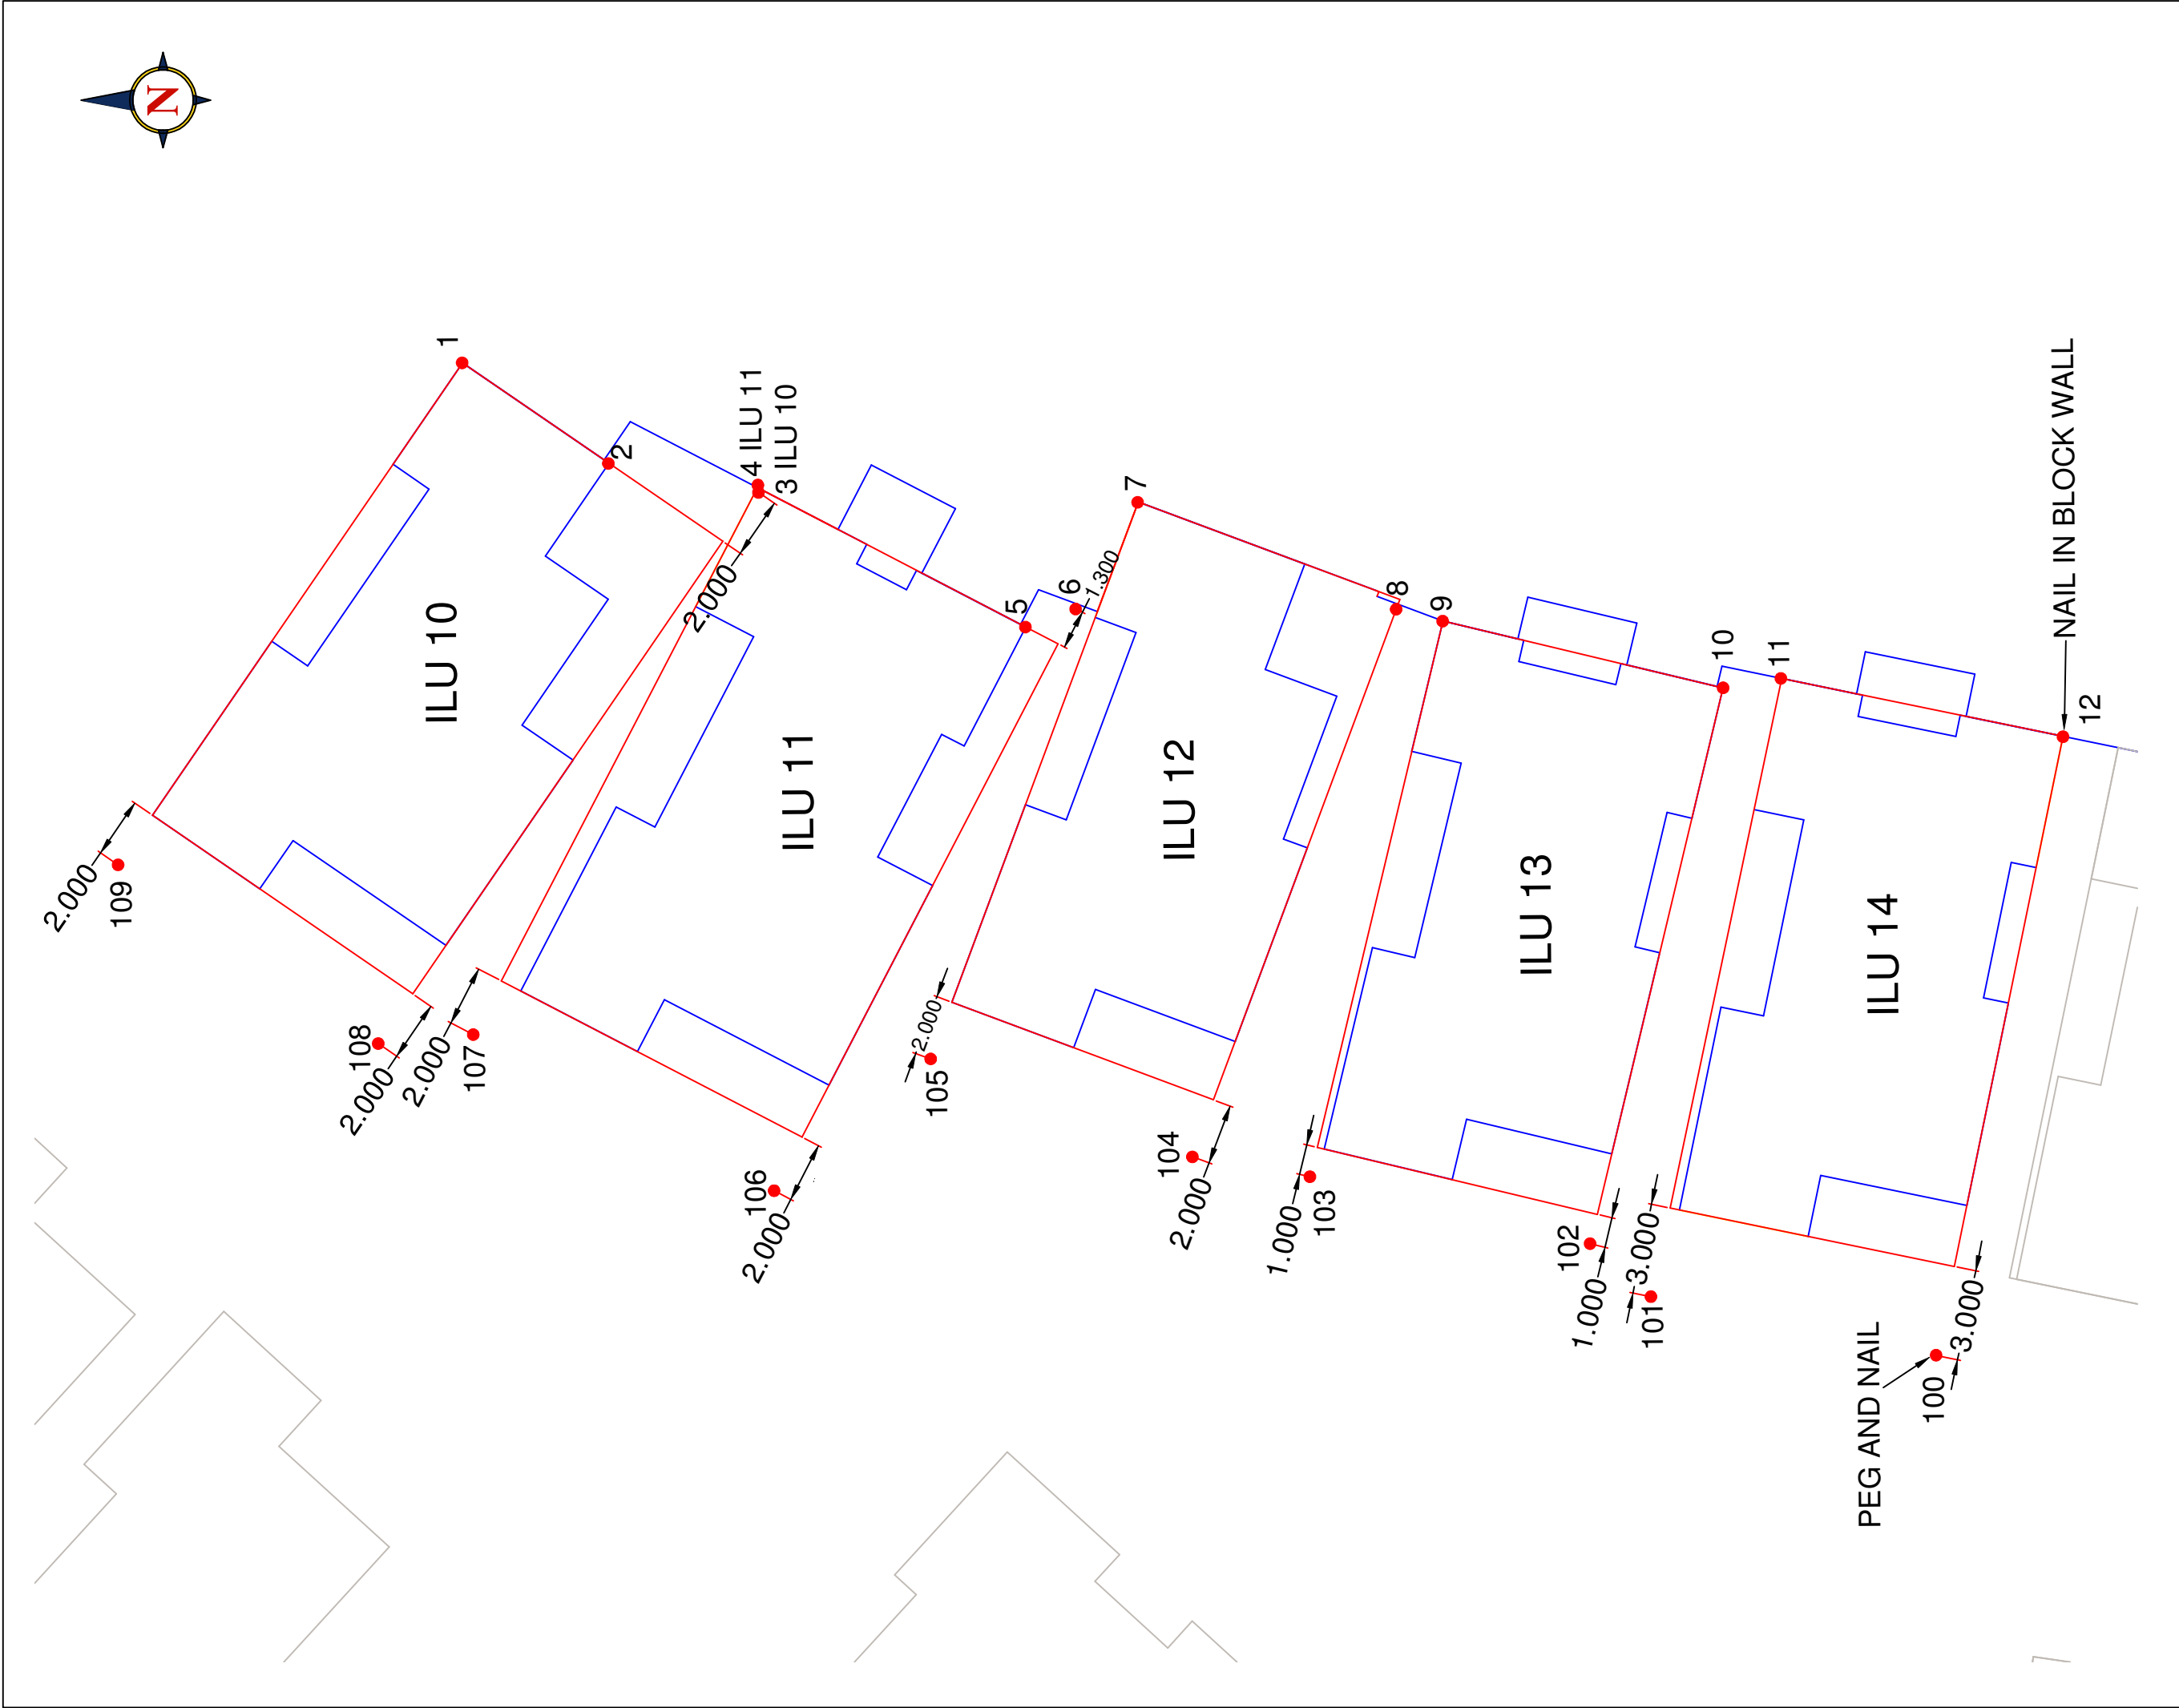

Land Surveys Level 5, 7 Eden Park Drive Macquarie NSW 2113 T (02) 8935 9451 F (02) 8935 9401 www.land surveys.net.au E sydney@land surveys.net.au	SURVEYOR :	DB	TITLE: SKETCH SHOWING SETOUT OF HOUSES ILU 10, 11, 12, 13 AND 14	CLIENT: PBS BUILDING
	SURVEY DATE :	28/5/15		
	DRAWN :	DB	PROJECT: WARRIWOOD ARV	JOB No : 1500259
SCALE : 1:200 ORIGINAL SIZE :	APPROVED :	JR		
	 PBSBUILDING		DWG No : 022	REV 0

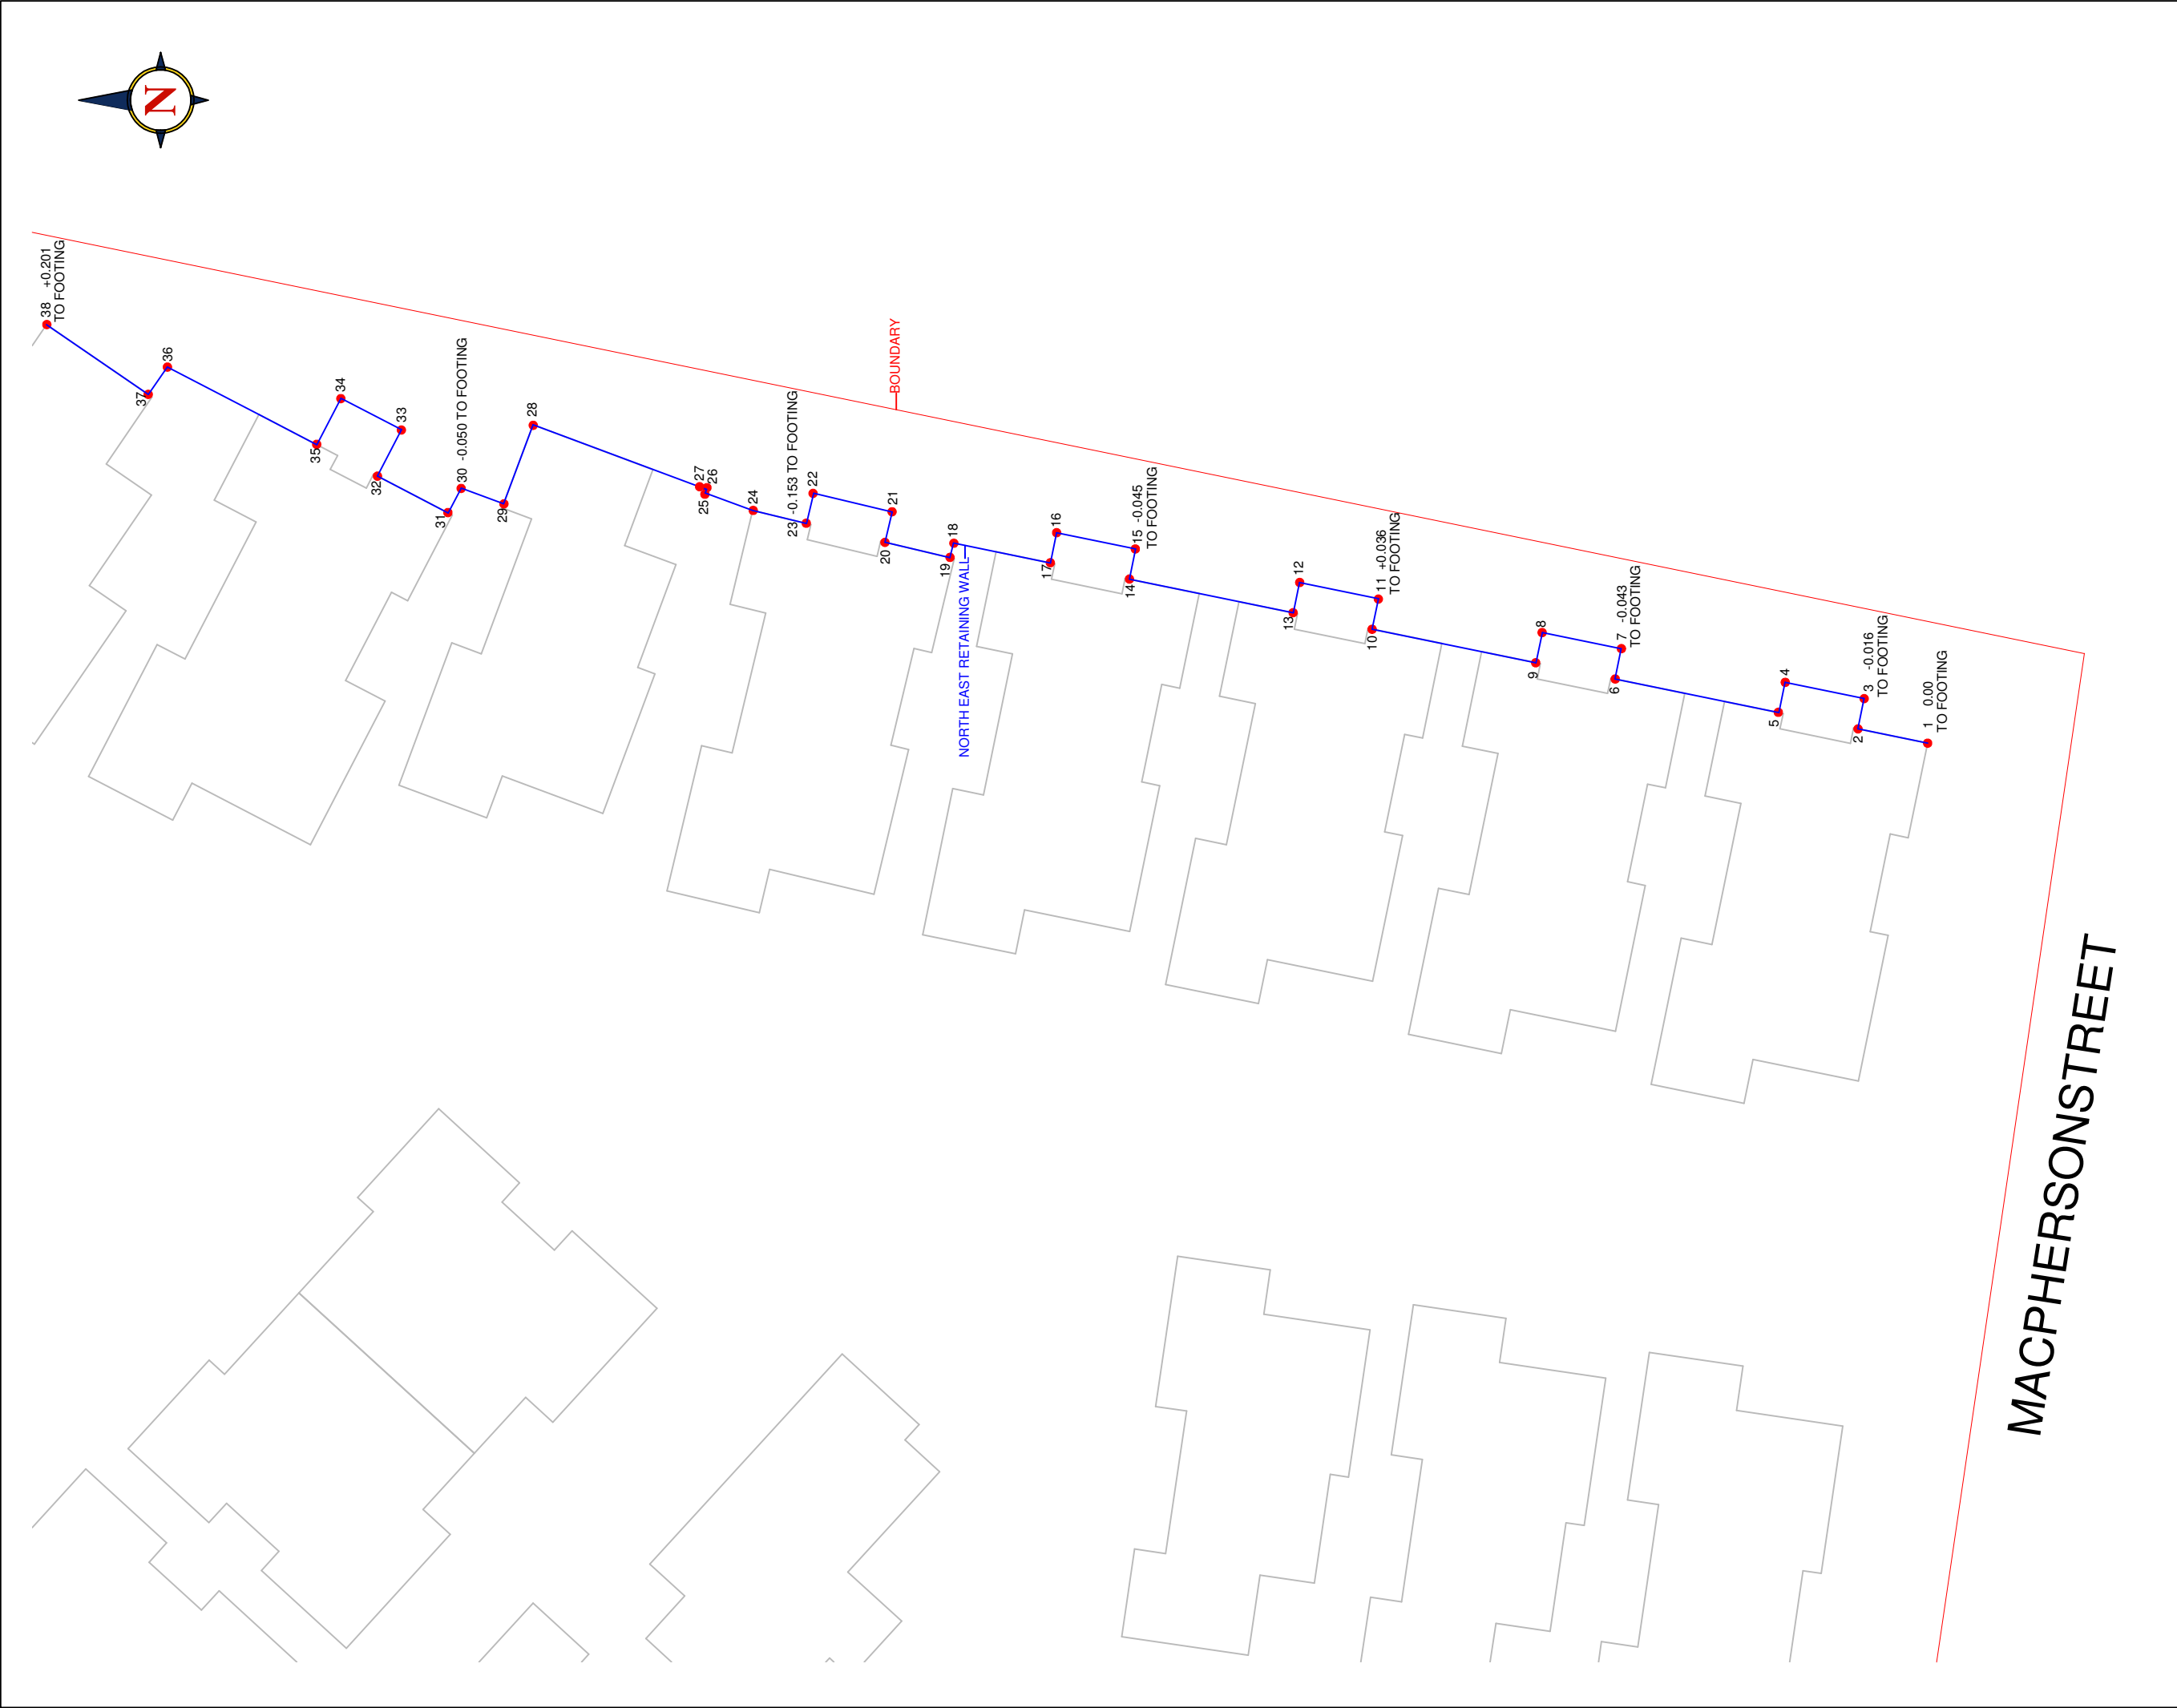


Land Surveys Level 5, 7 Eden Park Drive Macquarie NSW 2113 T (02) 8935 9451 F (02) 8935 9401 www.land surveys.net.au E sydney@land surveys.net.au	SURVEYOR : DB		CLIENT: PBS BUILDING	
	SURVEY DATE : 27/3/15		TITLE: SKETCH SHOWING SETOUT OF NORTH EAST RETAINING WALL AND HEIGHTS TO FOOTING	
	DRAWN : DB		PROJECT: WARRIEWOOD ARV	
	APPROVED : JR		JOB No : 1500259	
SCALE : 1: XXX ORIGINAL SIZE :	PBSBUILDING		DWG No : 006	
			REV 0	




Land Surveys Sydney Office Suite 3, 78 Reserve Road Artarmon NSW 2064 T (02) 8935 9451 F (02) 8935 9401 www.landsurveys.net.au E sydney@landsurveys.net.au SCALE : 1: 200 ORIGINAL SIZE :	0	10/8/15	ISSUED TO CLIENT	SURVEYOR : DB	TITLE: SKETCH SHOWING SETOUT OF OF ILU 34, 35 AND 36	CLIENT: PBS BUILDING	
				SURVEY DATE : 10/8/15			
				DRAWN : DB	PROJECT: WARRIEWOOD ARV	JOB No : 1500259	
				APPROVED : JR			
	REVISION	DATE	DESCRIPTION			DWG No : 036	REV 0



Land Surveys Sydney Office T (02) 8935 9451 F (02) 8935 9401 www.landsurveys.net.au E sydney@landsurveys.net.au Suite 3, 78 Reserve Road Artarmon NSW 2064 SCALE : 1: 200 ORIGINAL SIZE : 2 0 2 4 6 8 10	0	15/6/15	ISSUED TO CLIENT	SURVEYOR : DB	TITLE: SKETCH SHOWING SETOUT OF ILU 37,38 AND 39	CLIENT: PBS BUILDING	
				SURVEY DATE : 3/7/15		JOB No : 1500259	
				DRAWN : DB	PROJECT: WARRIEWOOD ARV	DWG No : 026	
				APPROVED : JR			
REVISION	DATE	DESCRIPTION					

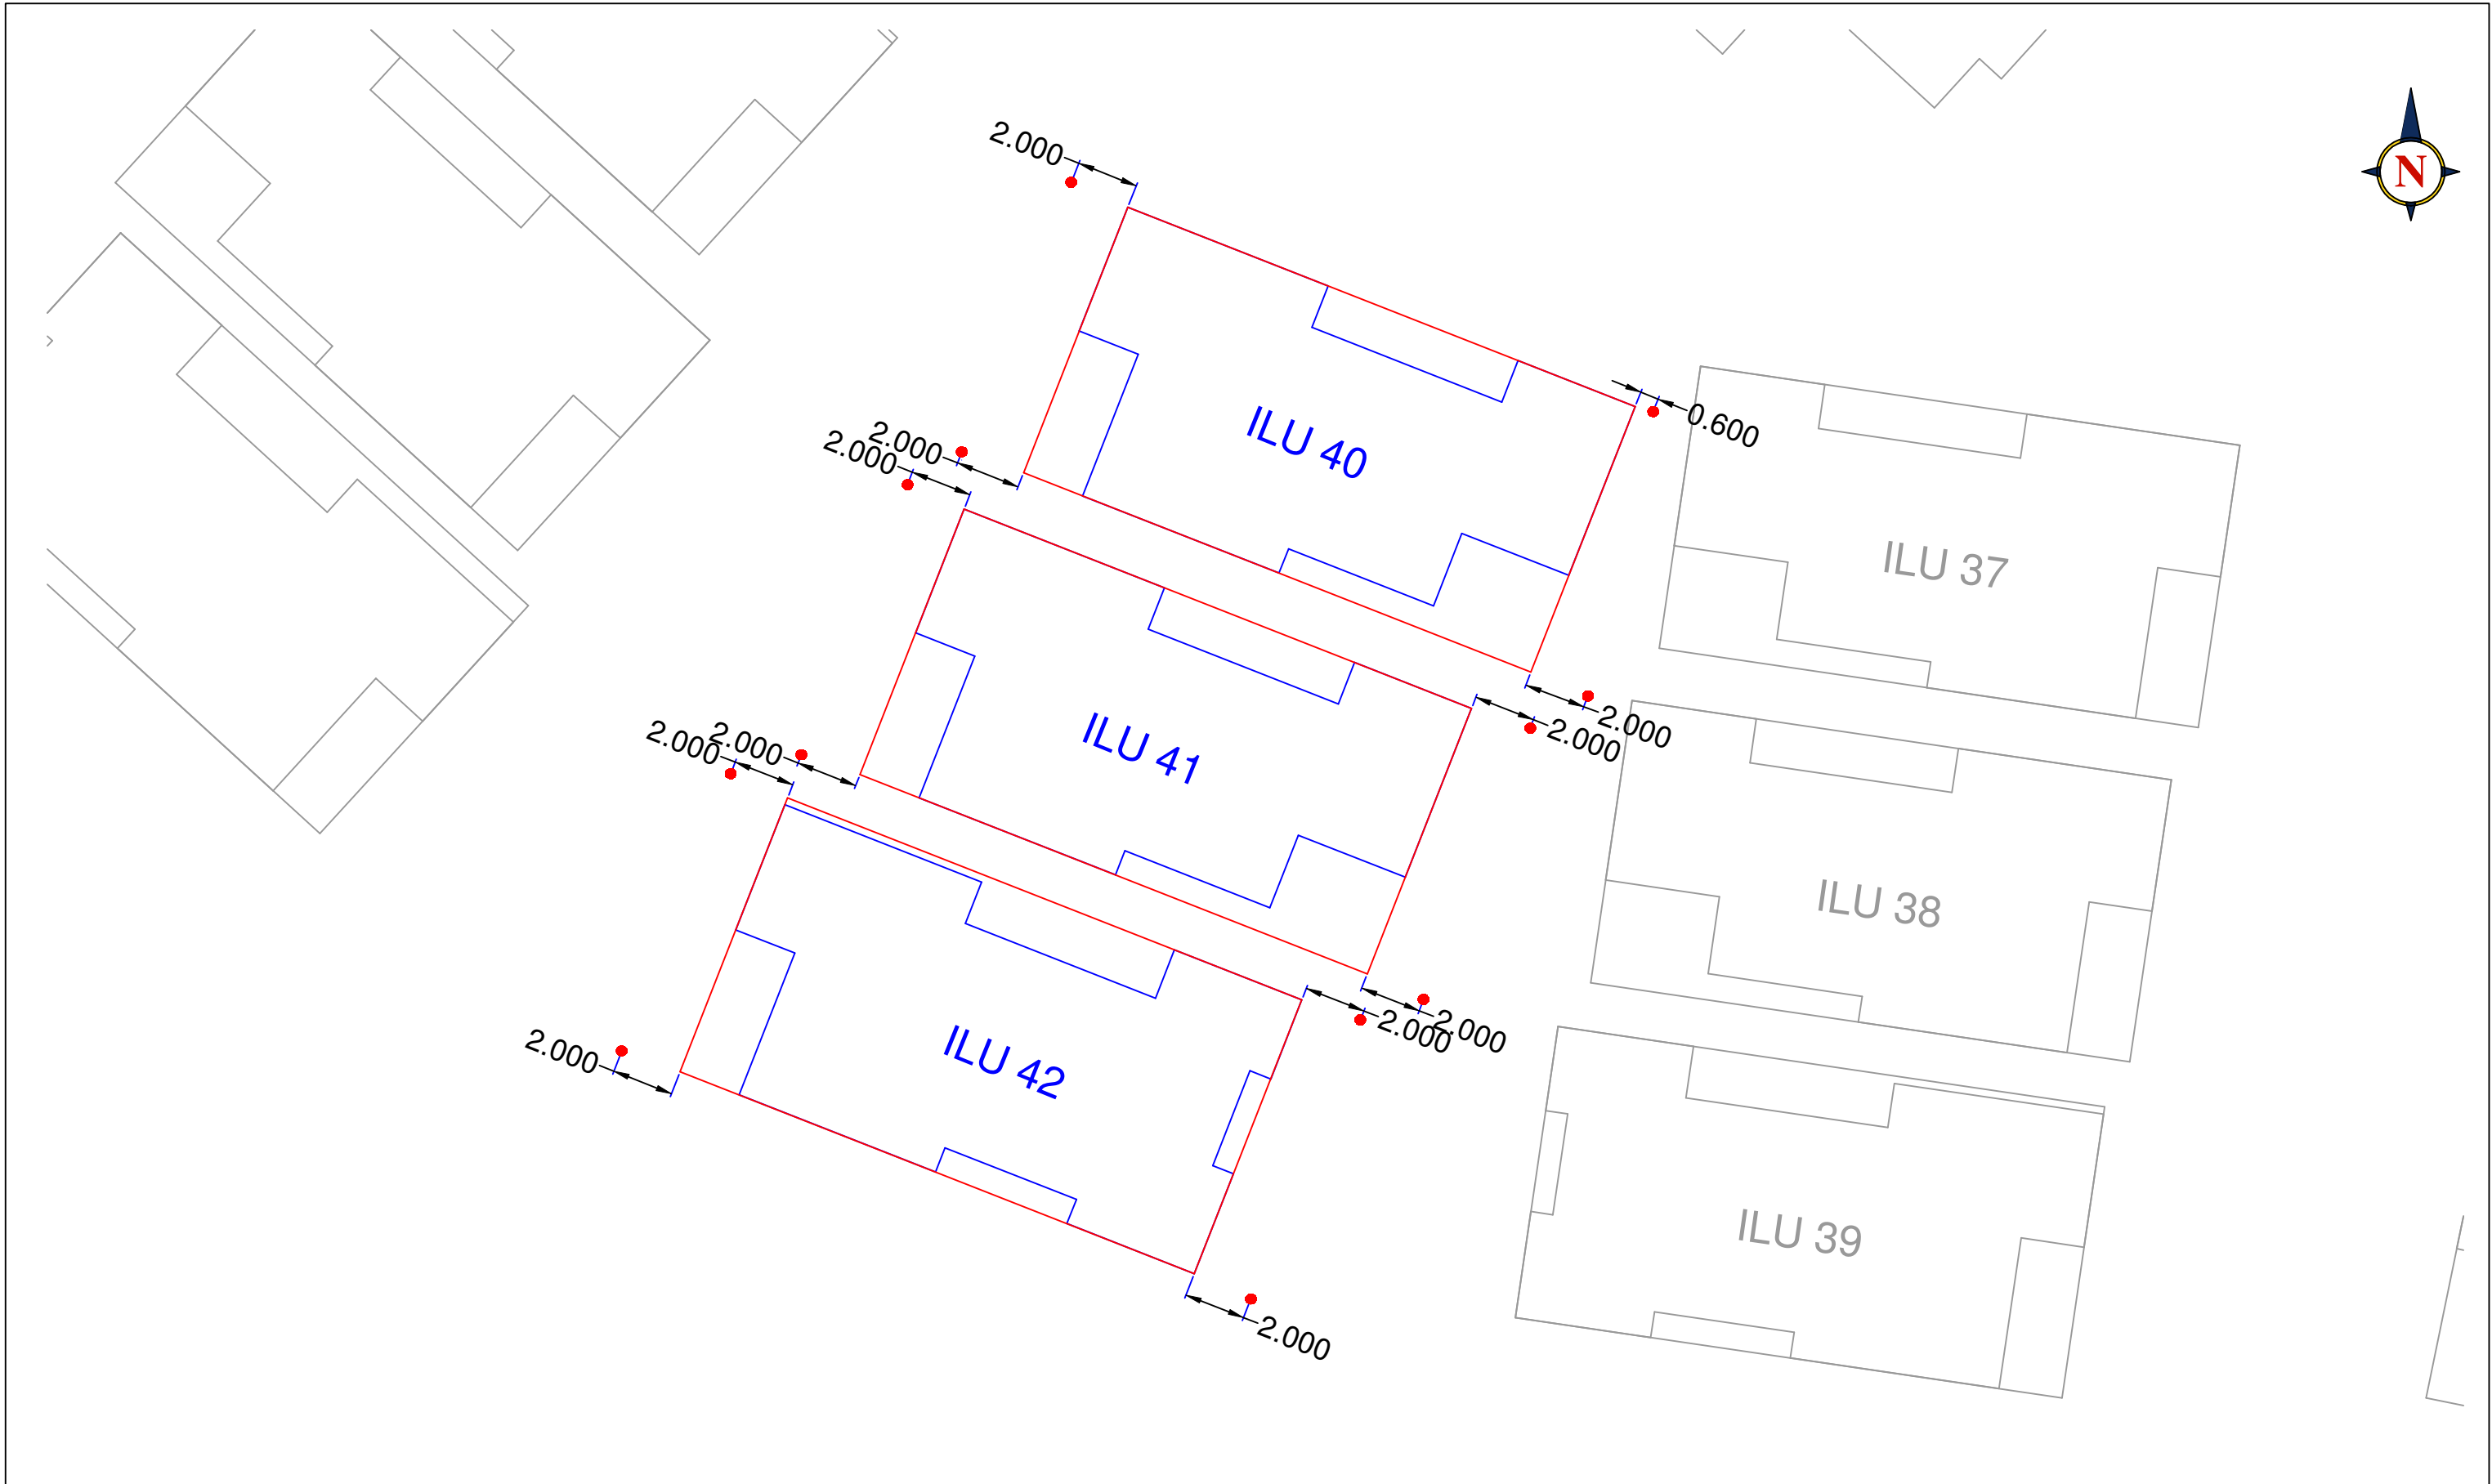


Land Surveys Sydney Office Suite 3, 78 Reserve Road Artarmon NSW 2064 T (02) 8935 9451 F (02) 8935 9401 www.landsurveys.net.au E sydney@landsurveys.net.au SCALE : 1: 200 ORIGINAL SIZE : 	0	16/7/15	ISSUED TO CLIENT	SURVEYOR : DB	TITLE: SKETCH SHOWING SETOUT OF ILU 40,41 AND 42	CLIENT: PBS BUILDING	
				SURVEY DATE : 16/7/15			
				DRAWN : DB	PROJECT: WARRIEWOOD ARV	JOB No : 1500259	
				APPROVED : JR			
	REVISION	DATE	DESCRIPTION			DWG No : 032	REV 0

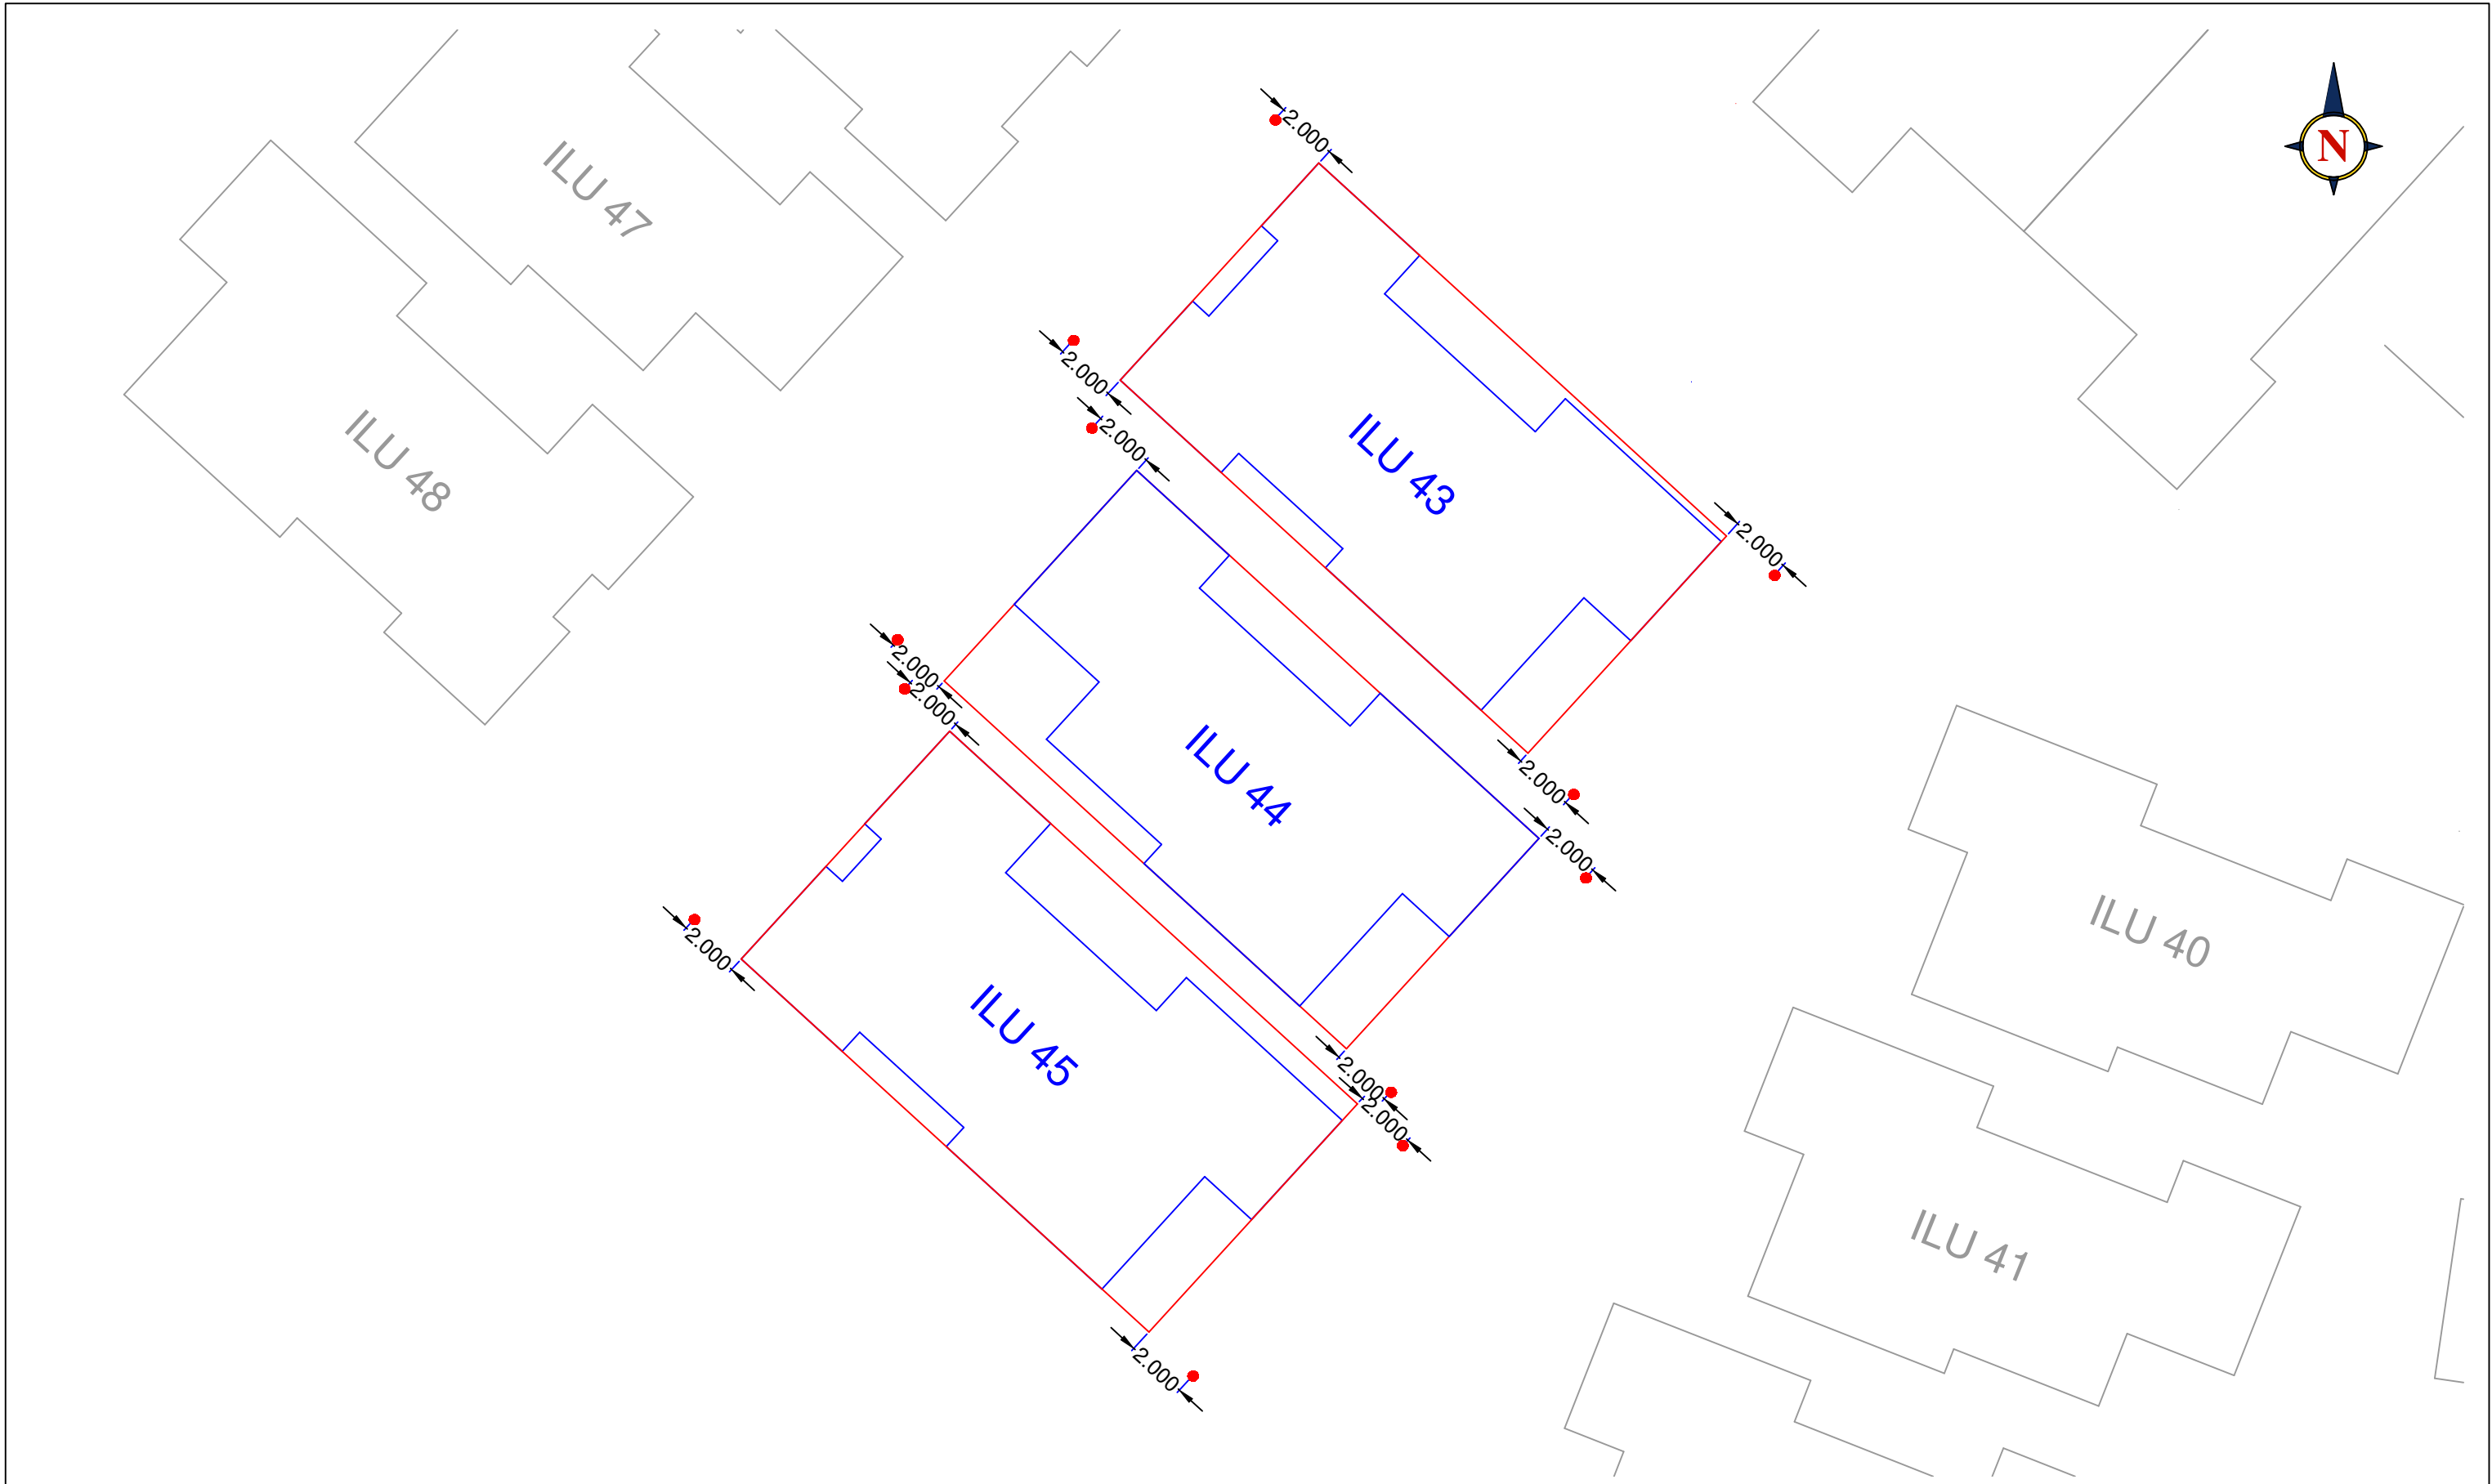


Land Surveys Sydney Office Suite 3, 78 Reserve Road Artarmon NSW 2064 T (02) 8935 9451 F (02) 8935 9401 www.landsurveys.net.au E sydney@landsurveys.net.au SCALE : 1: 200 ORIGINAL SIZE :	0	31/7/15	ISSUED TO CLIENT	SURVEYOR : DB	TITLE: SKETCH SHOWING SETOUT OF ILU 43, 44 AND 45	CLIENT: PBS BUILDING	
				SURVEY DATE : 31/7/15			
				DRAWN : DB	PROJECT: WARRIEWOOD ARV	JOB No : 1500259	
				APPROVED : JR			
					DWG No : 033		REV 0
	REVISION	DATE	DESCRIPTION				




Land Surveys Sydney Office T (02) 8935 9451 F (02) 8935 9401 www.landsurveys.net.au E sydney@landsurveys.net.au SCALE : 1: 300 ORIGINAL SIZE :	0	10/8/15	ISSUED TO CLIENT	SURVEYOR : DB	TITLE: SKETCH SHOWING SETOUT OF ILU 46, 49 AND 52	CLIENT: PBS BUILDING	
				SURVEY DATE : 10/8/15			
				DRAWN : DB	PROJECT: WARRIEWOOD ARV	JOB No : 1500259	
				APPROVED : JR			
	REVISION	DATE	DESCRIPTION			DWG No : 037	REV 0

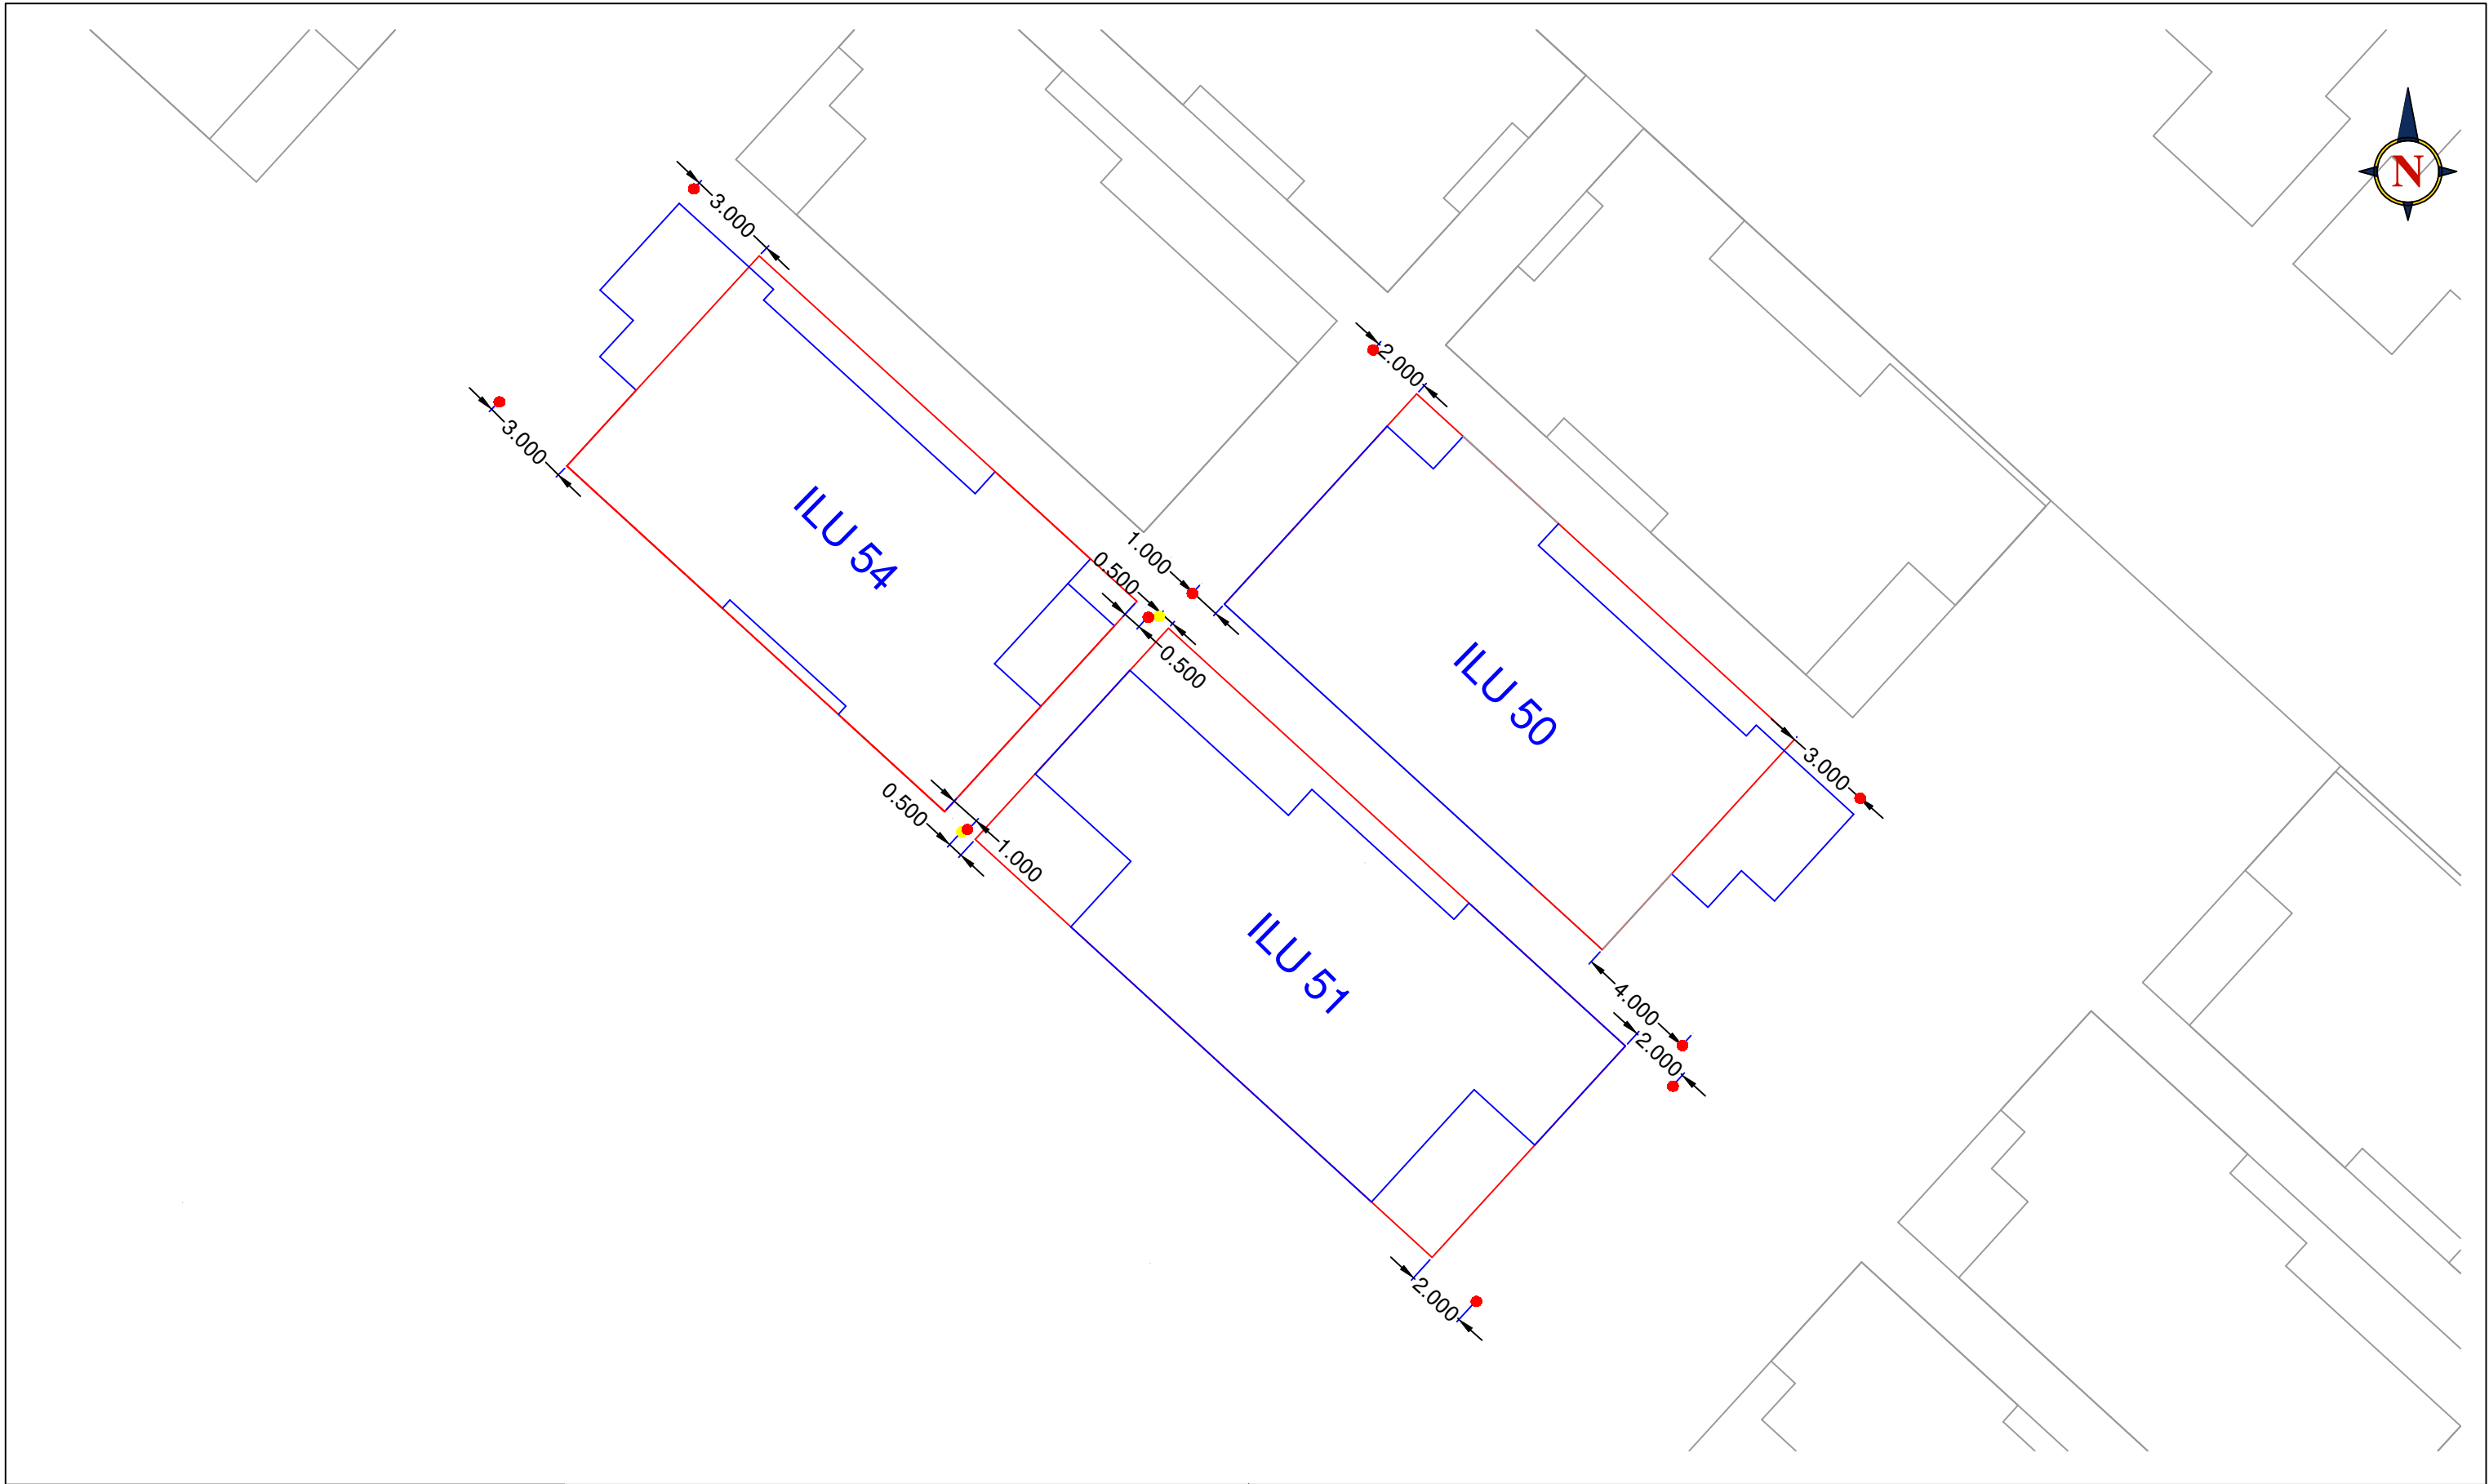


Land Surveys Sydney Office Suite 3, 78 Reserve Road Artarmon NSW 2064 T (02) 8935 9451 F (02) 8935 9401 www.landsurveys.net.au E sydney@landsurveys.net.au SCALE : 1: 200 ORIGINAL SIZE :	0	10/11/15	ISSUED TO CLIENT	SURVEYOR : DB	TITLE: SETOUT OF ILU 50, 51 AND 54	CLIENT: PBS BUILDING	
				SURVEY DATE : 10/11/15			
				DRAWN : DB	PROJECT: WARRIEWOOD ARV	JOB No : 1500259	
				APPROVED : DB			
						DWG No : 064	REV 0
	REVISION	DATE	DESCRIPTION				

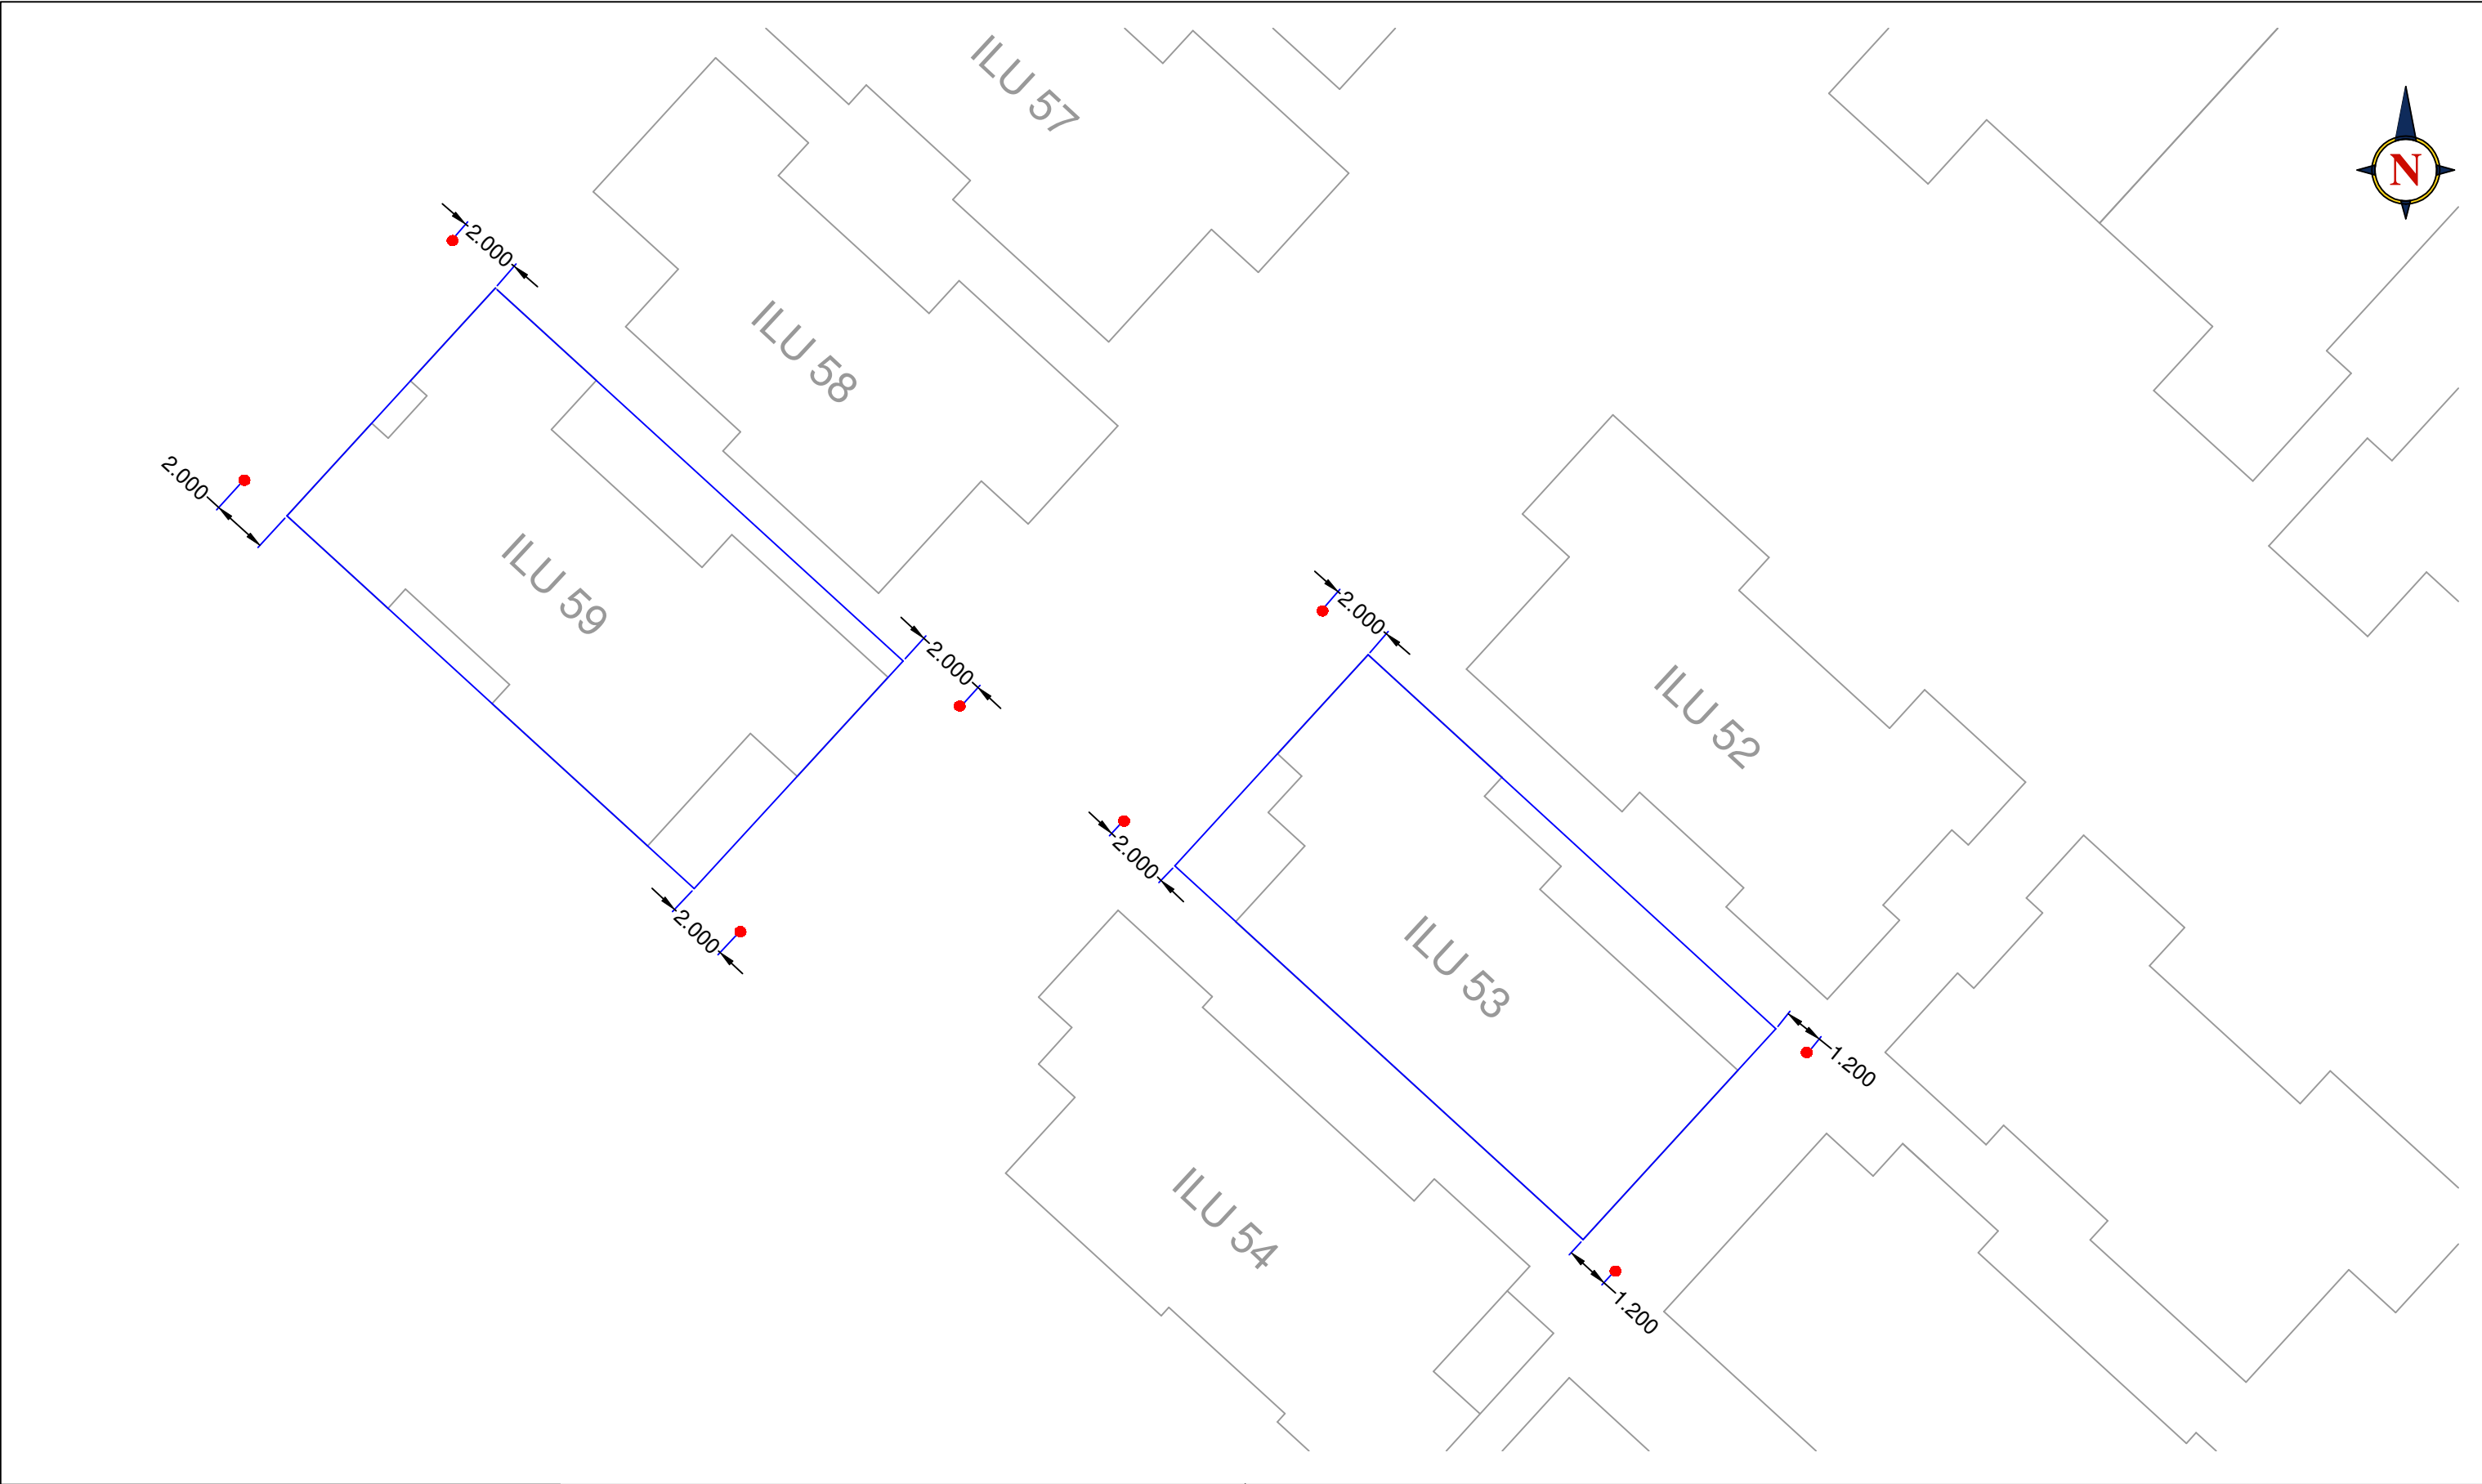


Land Surveys Sydney Office Suite 3, 78 Reserve Road Artarmon NSW 2064 T (02) 8935 9451 F (02) 8935 9401 www.landsurveys.net.au E sydney@landsurveys.net.au SCALE : 1: 200 ORIGINAL SIZE :	0	2/10/15	ISSUED TO CLIENT	SURVEYOR : DB	TITLE: SKETCH SHOWING SETOUT OF ILU 53 AND 59	CLIENT: PBS BUILDING		
				SURVEY DATE : 2/10/15				
					DRAWN : DB	PROJECT: WARRIEWOOD ARV	JOB No : 1500259	
					APPROVED : DB			
	REVISION	DATE	DESCRIPTION			DWG No : 053	REV 0	

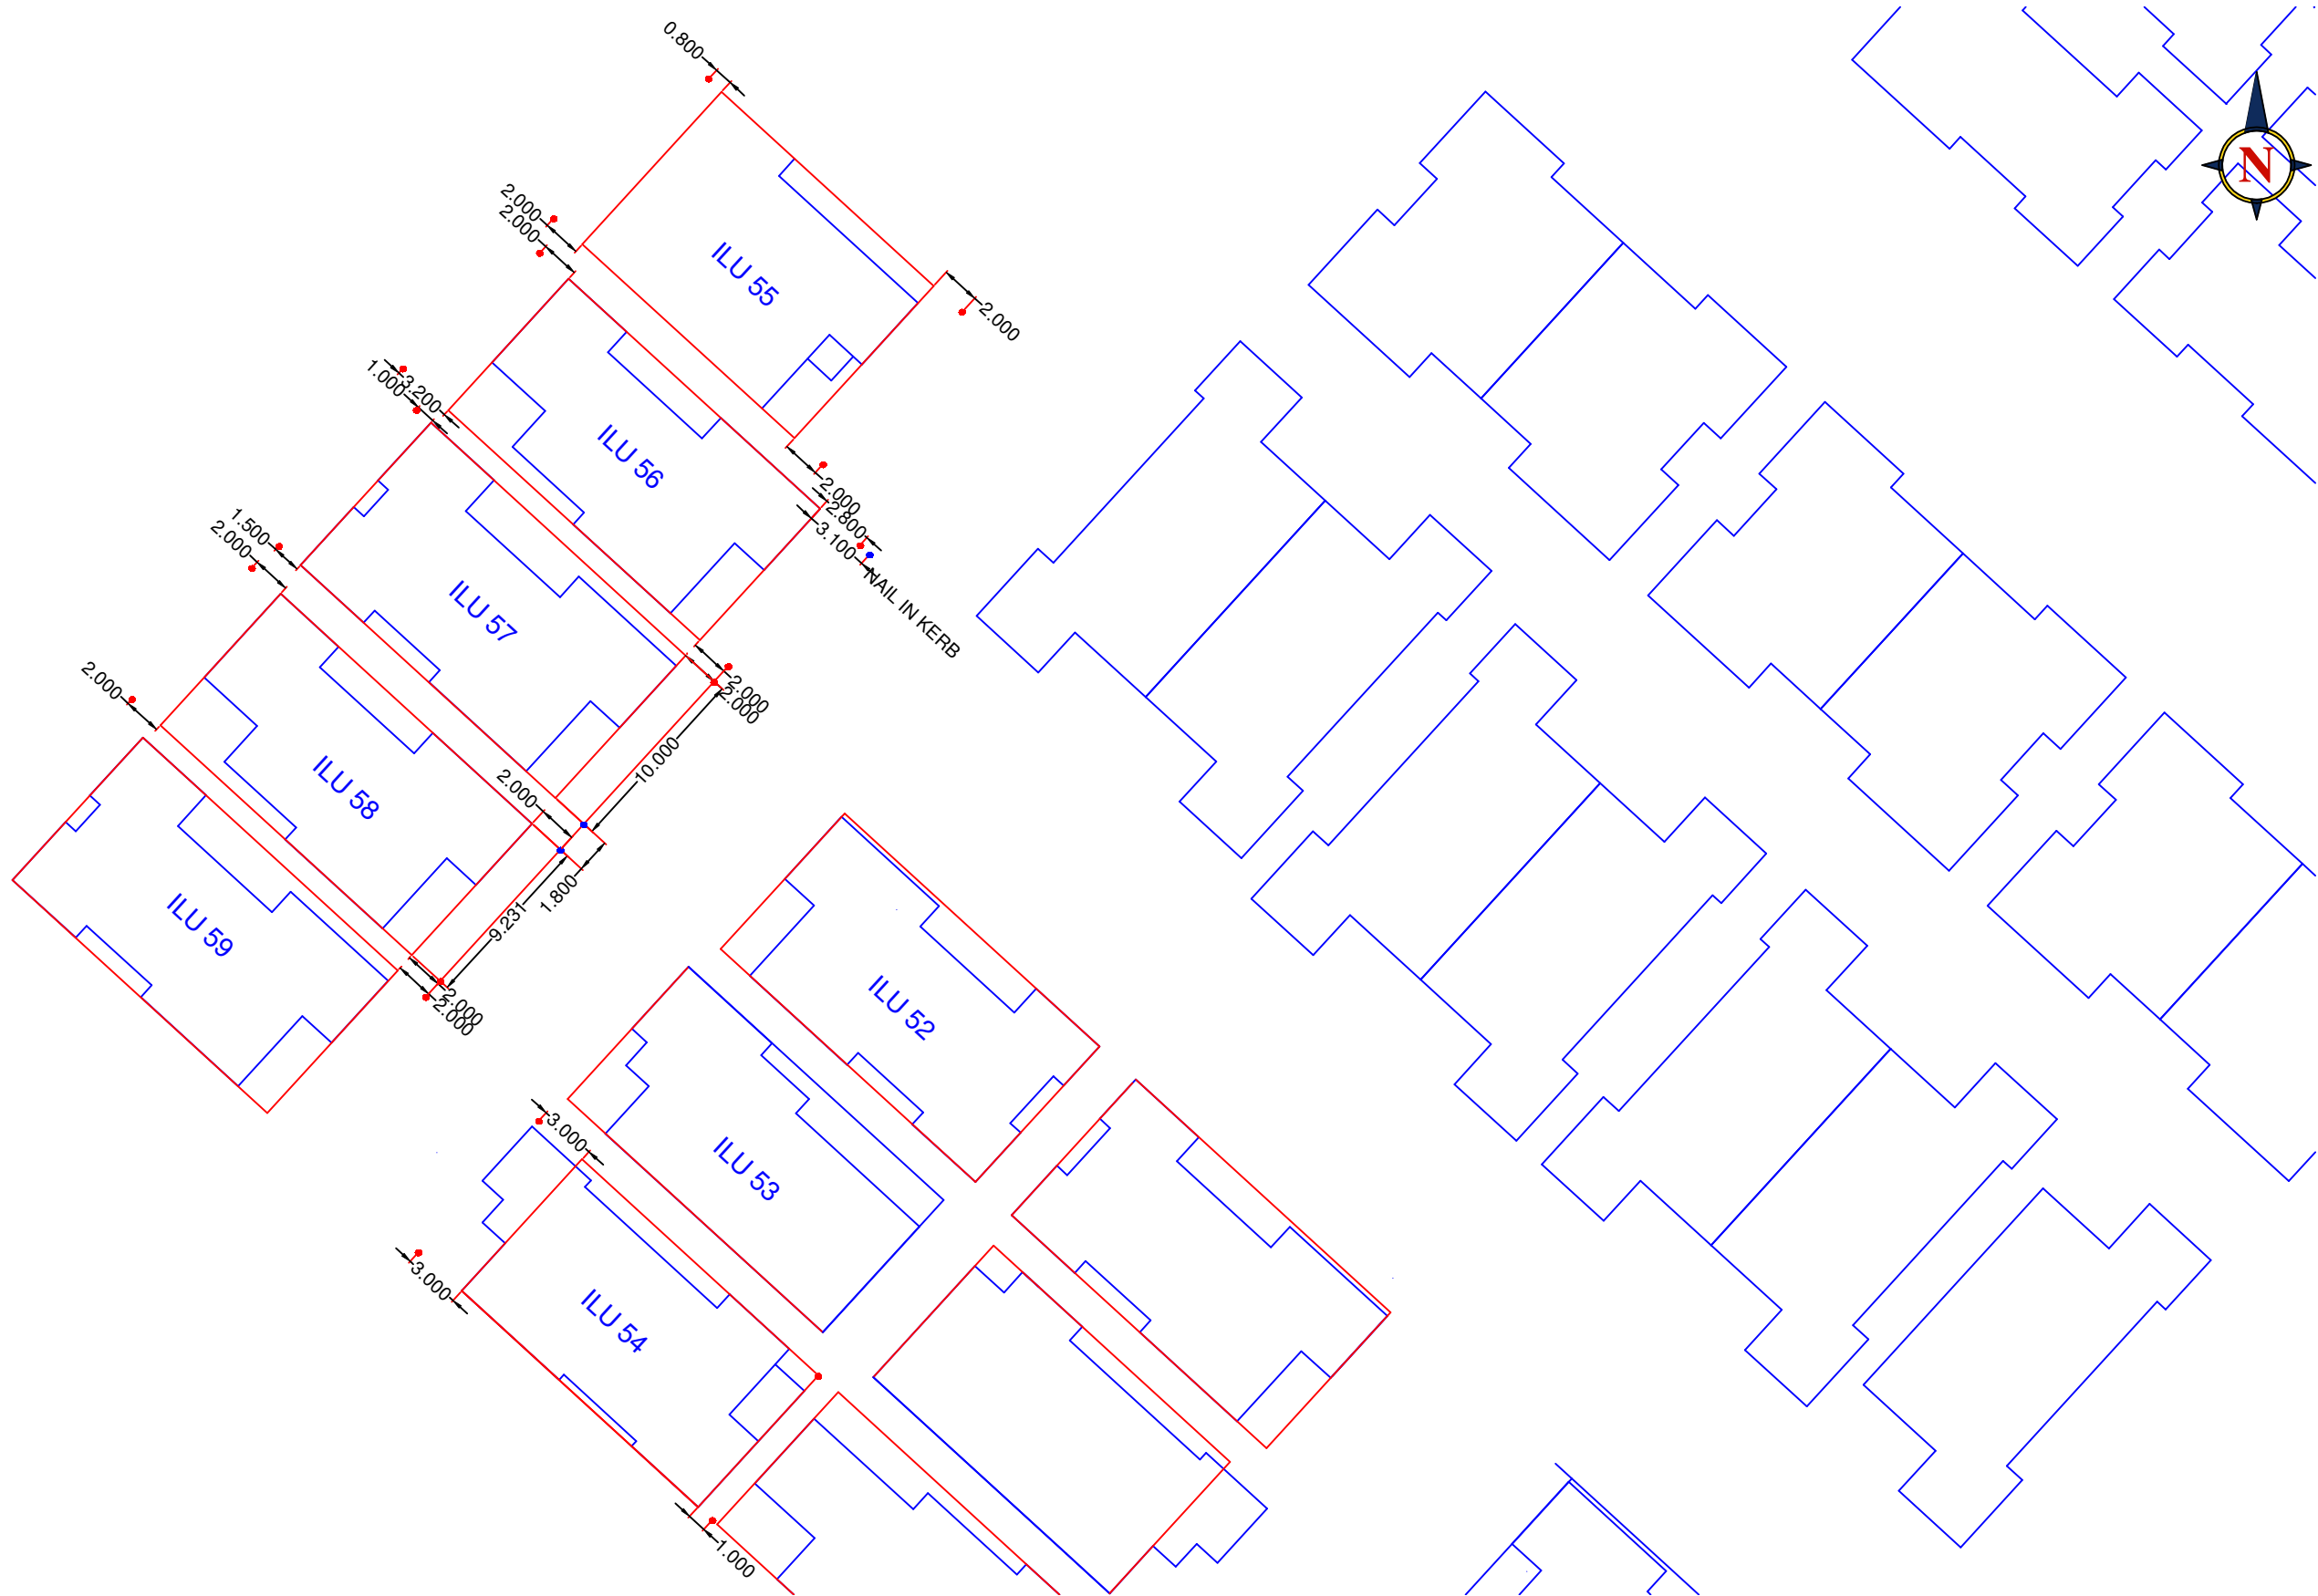


Land Surveys Sydney Office Suite 3, 78 Reserve Road Artarmon NSW 2064 T (02) 8935 9451 F (02) 8935 9401 www.landsurveys.net.au E sydney@landsurveys.net.au SCALE : 1: XXX ORIGINAL SIZE : _____	0	22/10/15	ISSUED TO CLIENT	SURVEYOR : DB	TITLE: SETOUT SKETCH	CLIENT: PBS BUILDING	
	1	02/11/15	PEGS ADDED	SURVEY DATE : 22/10/15			
				DRAWN : DB	PROJECT: WARRIEWOOD ARV	JOB No : 1500259	
				APPROVED : DB			
				PBSBUILDING			
	REVISION	DATE	DESCRIPTION		DWG No : 061	REV 1	

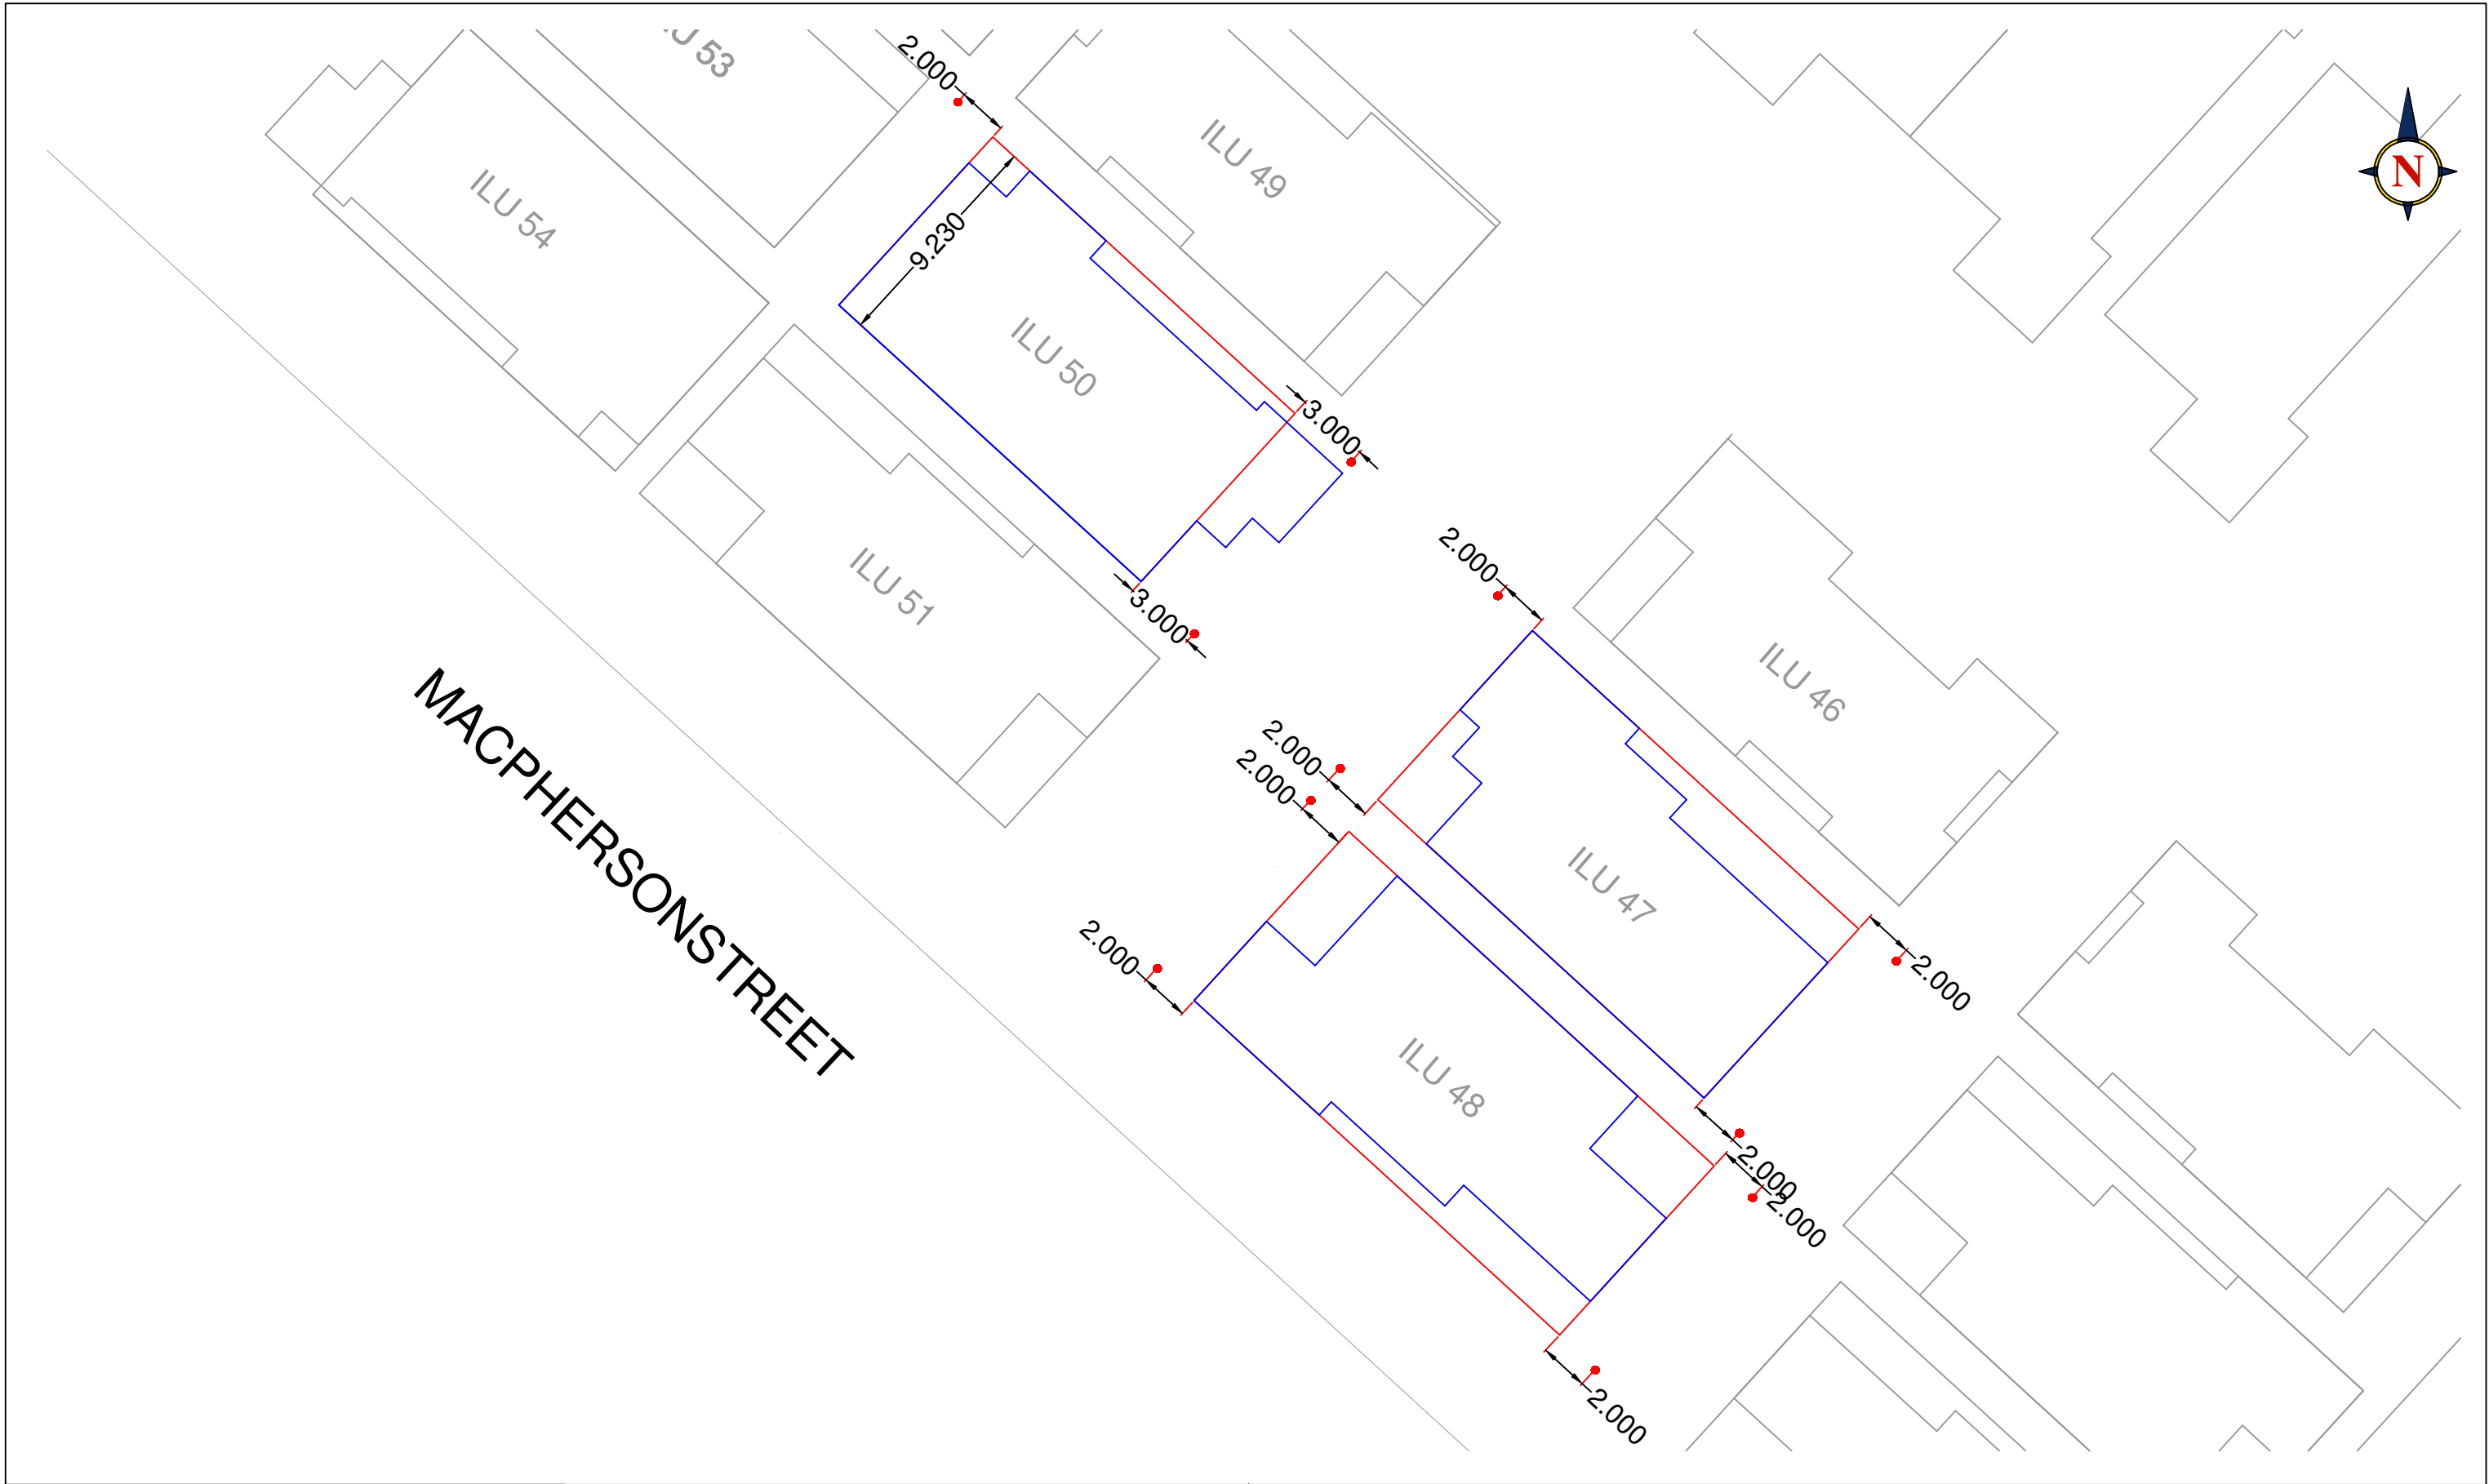


Land Surveys Sydney Office Suite 3, 78 Reserve Road Artarmon NSW 2064 T (02) 8935 9451 F (02) 8935 9401 www.landsurveys.net.au E sydney@landsurveys.net.au	0	14/9/15	ISSUED TO CLIENT	SURVEYOR : DB	TITLE: SKETCH SHOWING SETOUT OF ILU 47, 48 AND 50	CLIENT: PBS BUILDING	
				SURVEY DATE : 11/9/15			
				DRAWN : DB	PROJECT: WARRIEWOOD ARV	JOB No : 1500259	
				APPROVED : JR			
				PBSBUILDING			
SCALE : 1: XXX ORIGINAL SIZE :	REVISION	DATE	DESCRIPTION		DWG No : 048	REV 0	

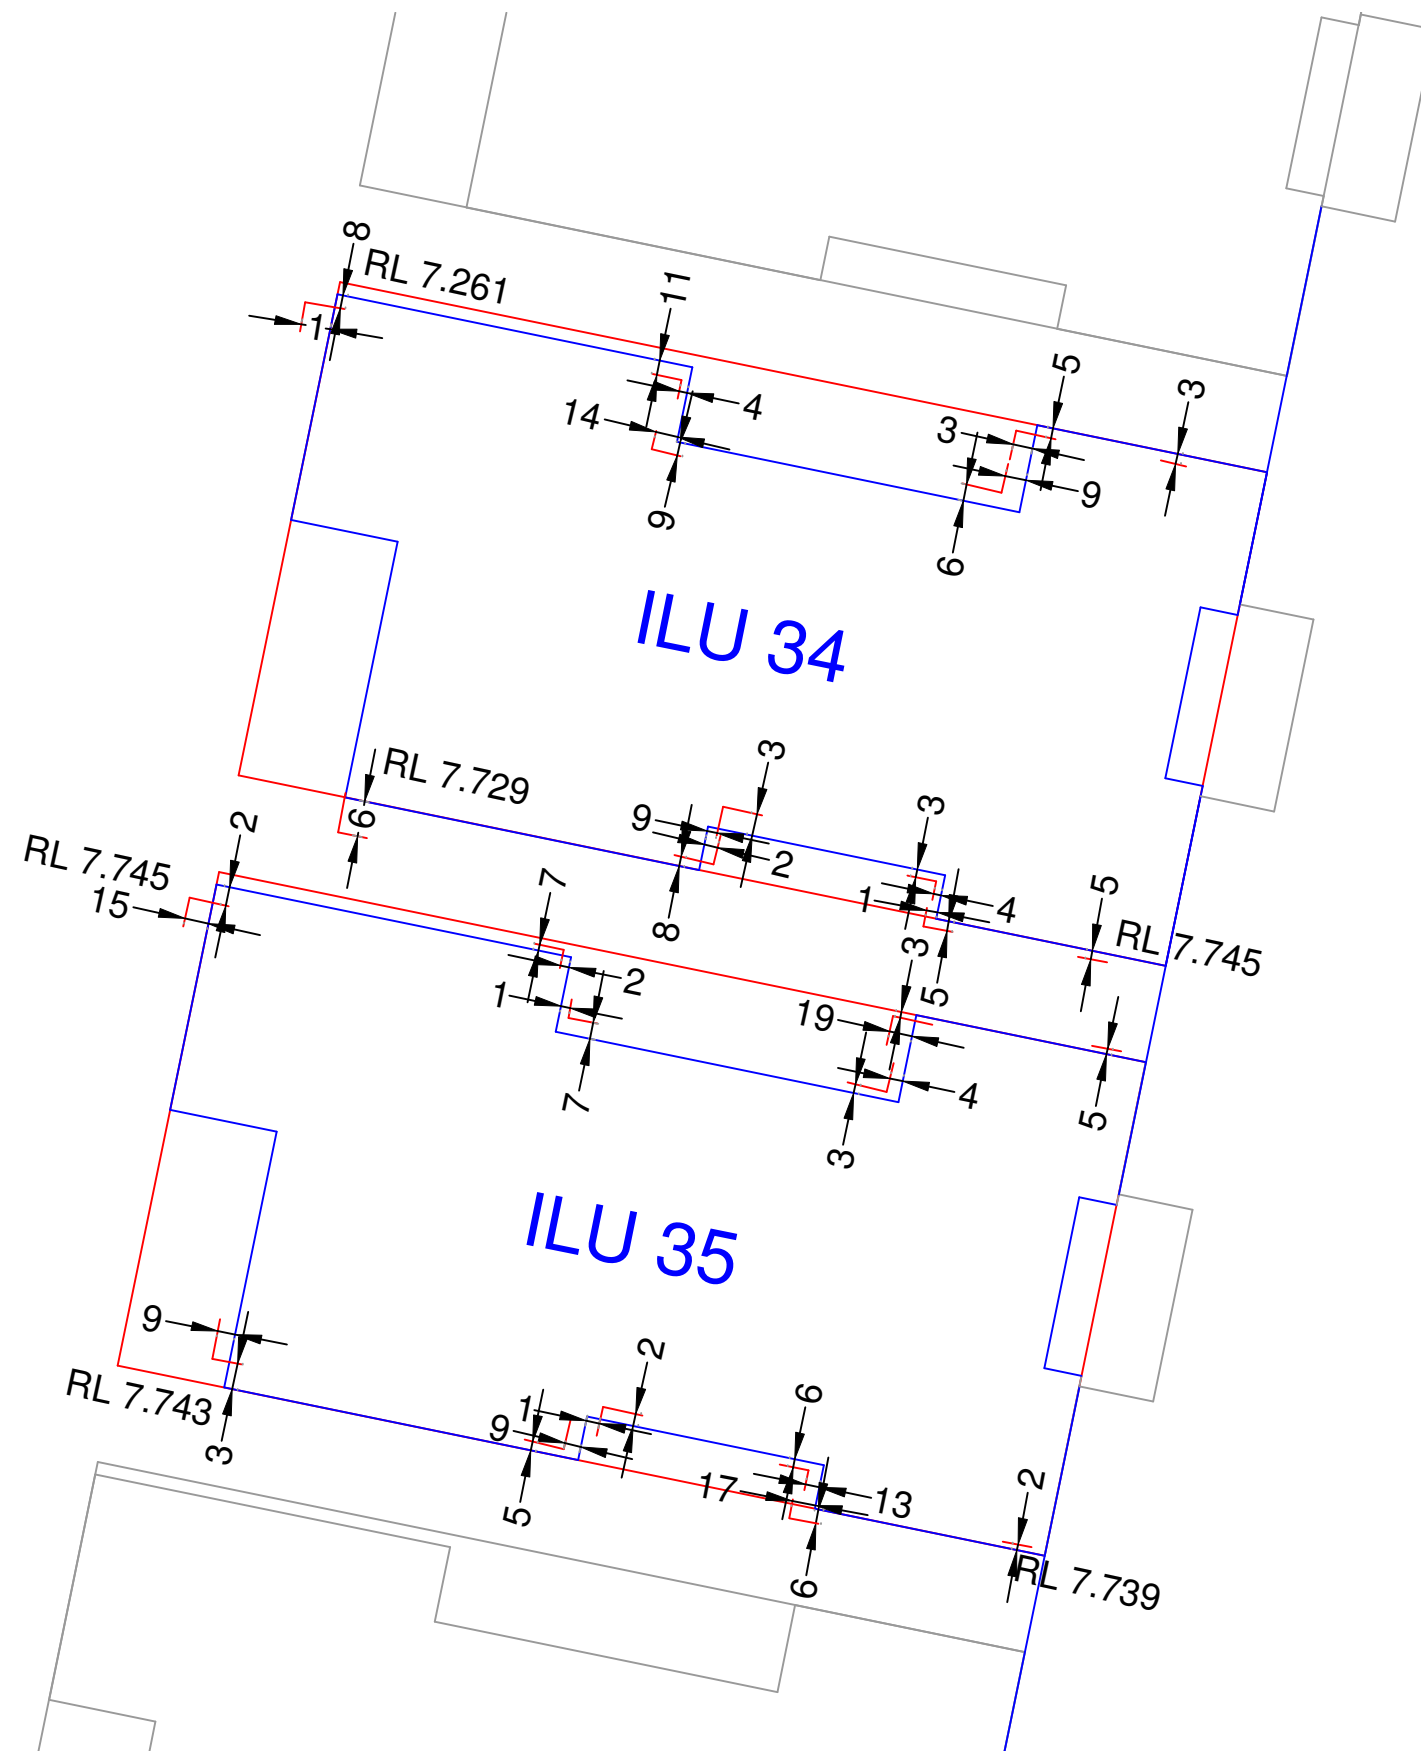


Land Surveys Sydney Office Suite 3, 78 Reserve Road Artarmon NSW 2064 T (02) 8935 9451 F (02) 8935 9401 www.landsurveys.net.au E sydney@landsurveys.net.au	0	11/9/15	ISSUED TO CLIENT	SURVEYOR : DB	TITLE: FORMWORK CHECK ILU 34 & 35	CLIENT: PBS BUILDING	
				SURVEY DATE : 10/9/15			
				DRAWN : DB	PROJECT: WARRIEWOOD ARV	JOB No : 1500259	
				APPROVED : JR			
SCALE : 1: xxx ORIGINAL SIZE :				 PBSBUILDING	DWG No : 045		REV 0
	REVISION	DATE	DESCRIPTION				

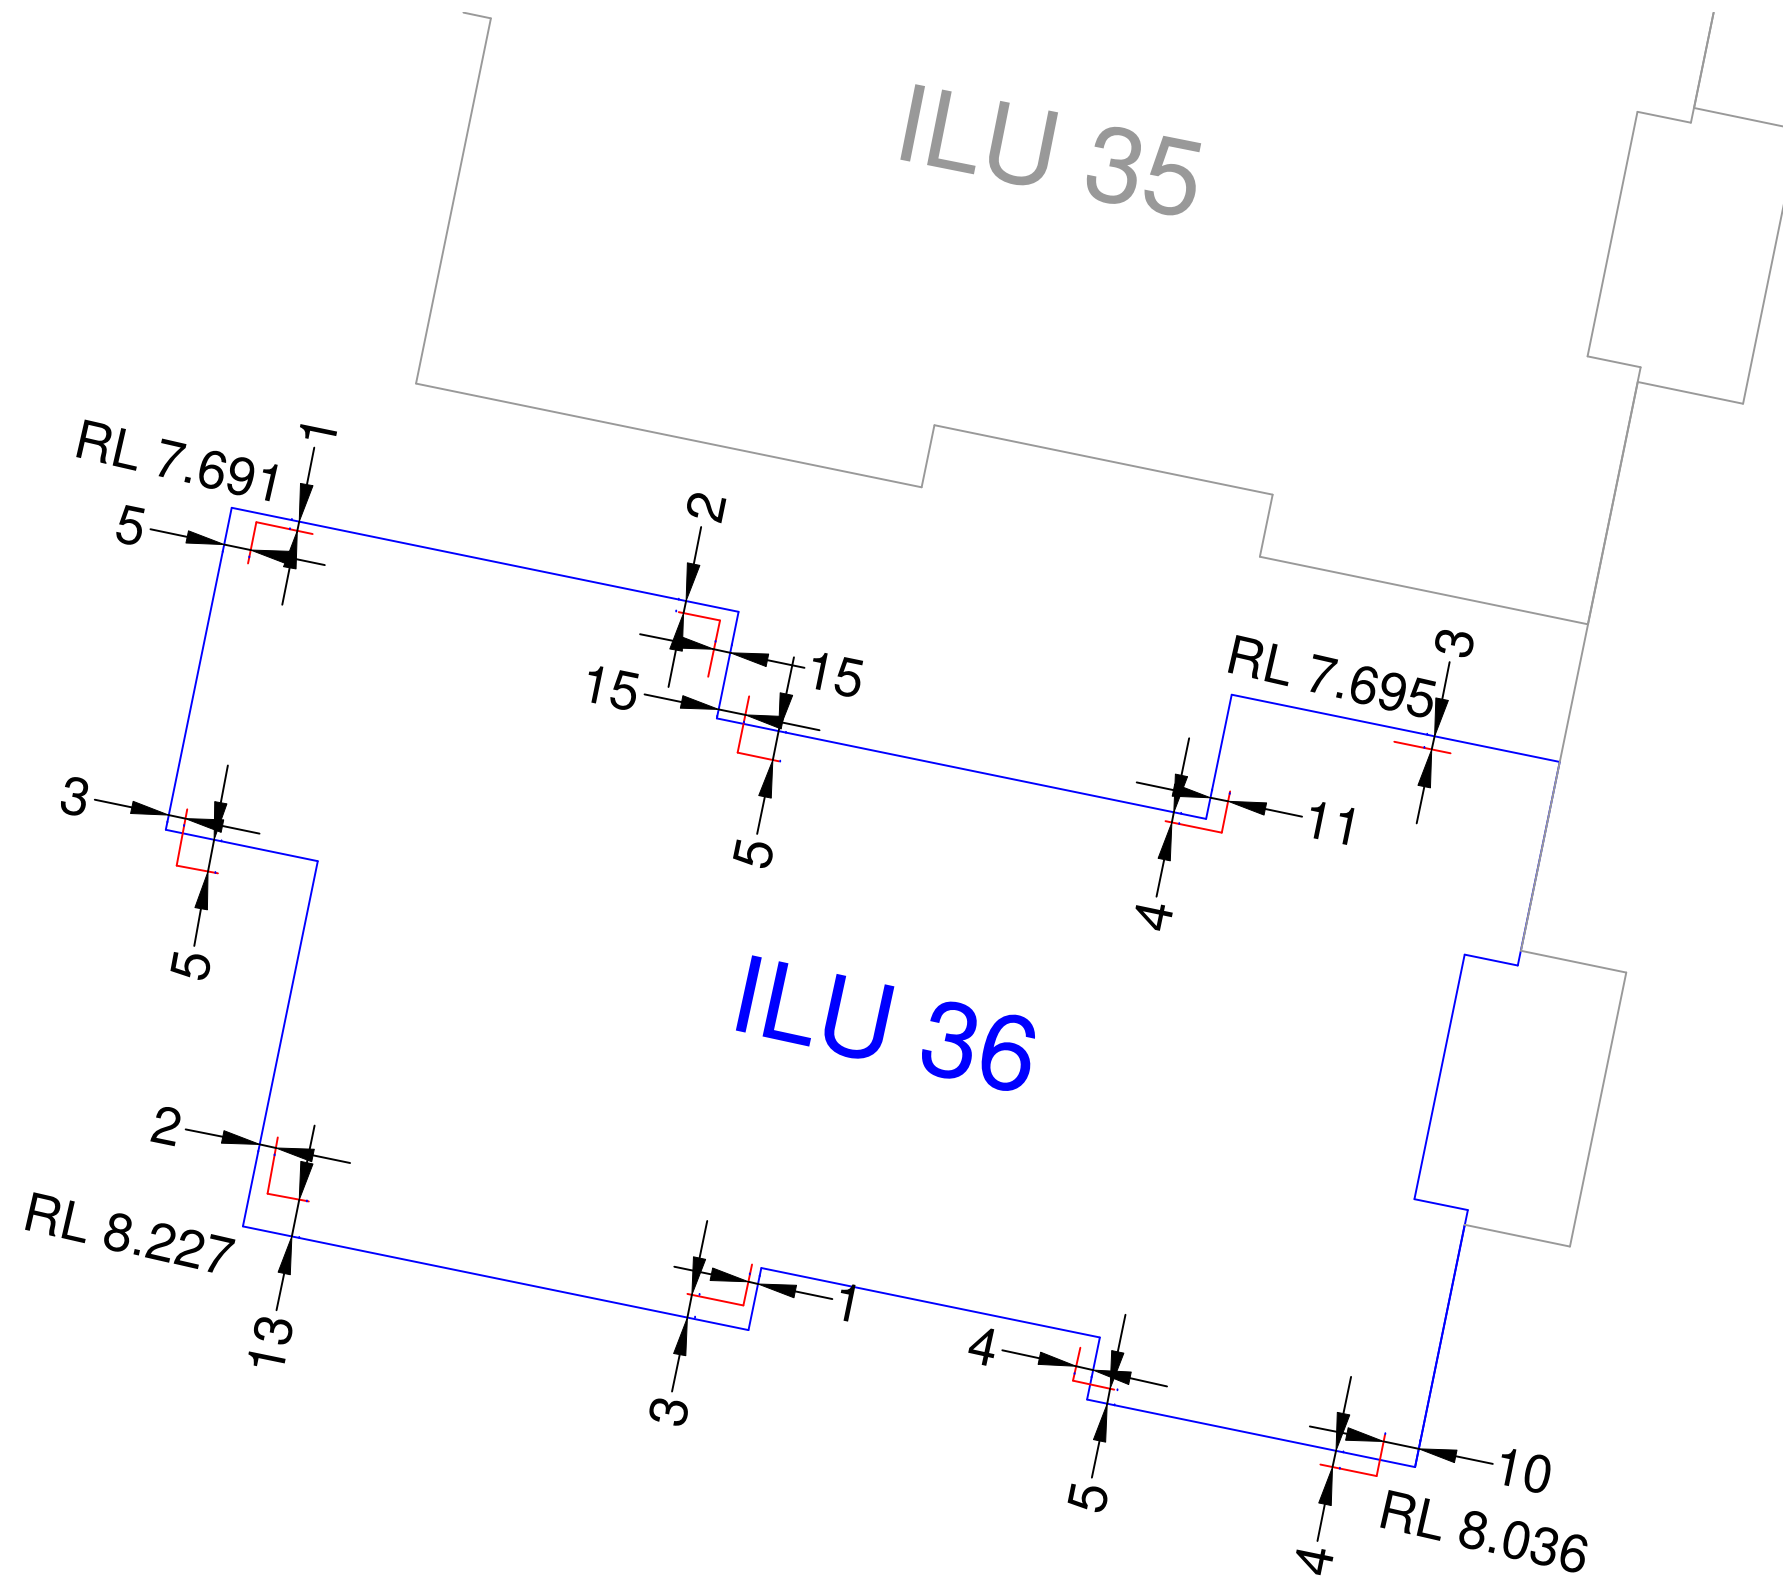


Land Surveys Sydney Office Suite 3, 78 Reserve Road Artarmon NSW 2064 T (02) 8935 9451 F (02) 8935 9401 www.landsurveys.net.au E sydney@landsurveys.net.au	0	8/10/15	ISSUED TO CLIENT	SURVEYOR : DB	TITLE: SKETCH SHOWING FORM WORK CHECK OF ILU 36	CLIENT: PBS BUILDING	
				SURVEY DATE : 8/10/15			
				DRAWN : DB	PROJECT: WARRIEWOOD ARV	JOB No : 1500259	
				APPROVED : JR			
				PBSBUILDING			
SCALE : 1: 100 ORIGINAL SIZE : 10 0 1 2 3 4 5	REVISION	DATE	DESCRIPTION				

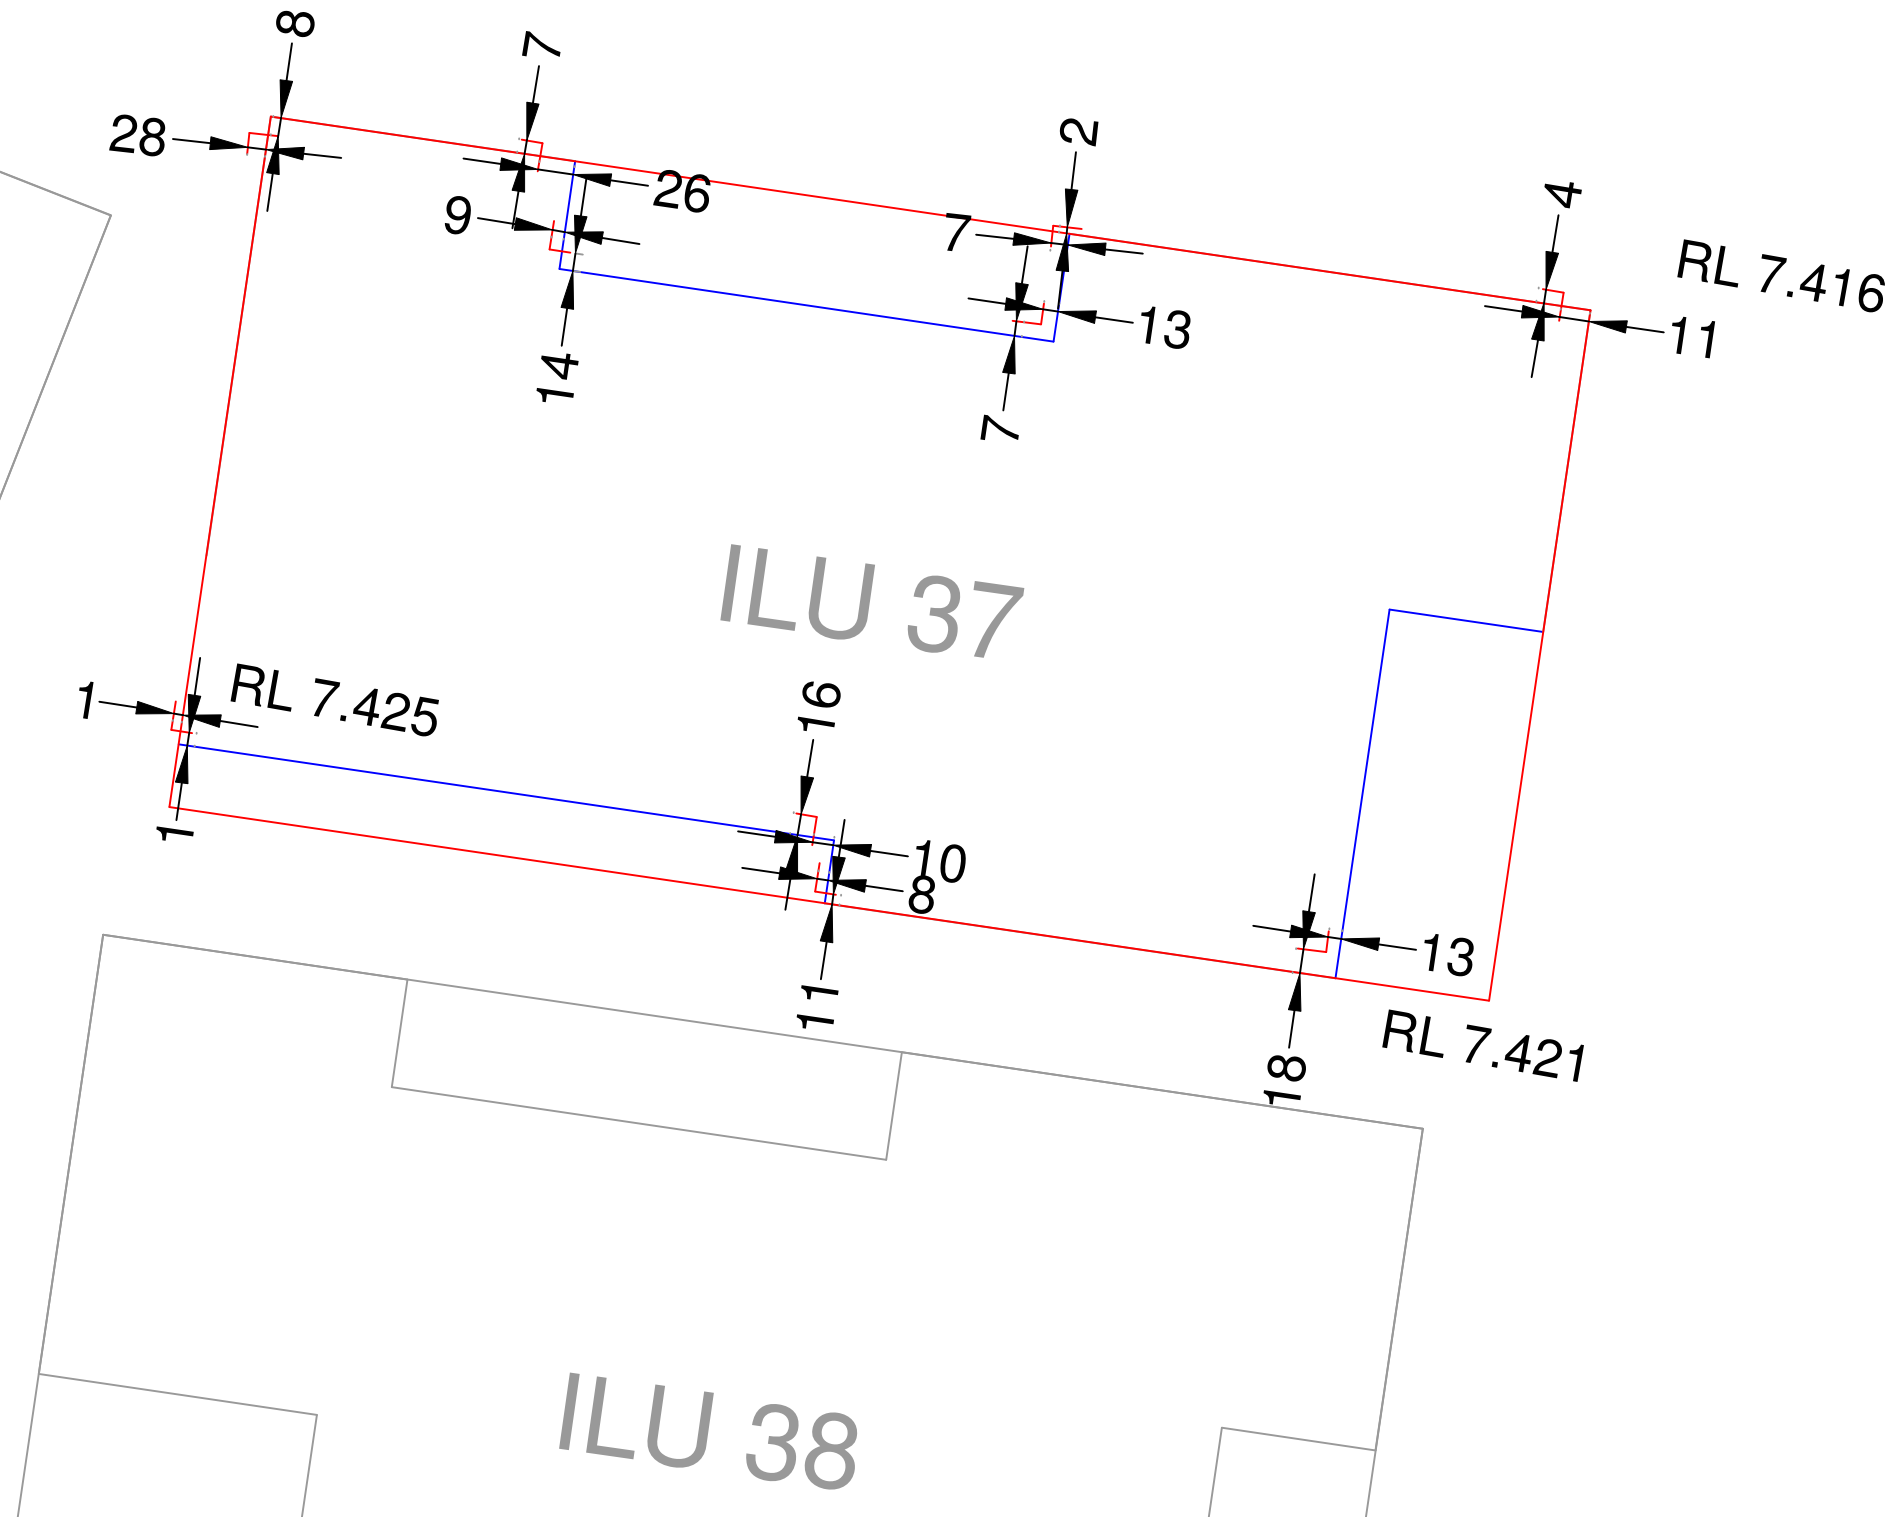


Land Surveys Sydney Office Suite 3, 78 Reserve Road Artarmon NSW 2064 T (02) 8935 9451 F (02) 8935 9401 www.landsurveys.net.au E sydney@landsurveys.net.au SCALE : 1: 100 ORIGINAL SIZE :	0	7/9/15	ISSUED TO CLIENT	SURVEYOR : DB	TITLE: FORMWORK CHECK ILU 37	CLIENT: PBS BUILDING
				SURVEY DATE : 7/9/15		
				DRAWN : DB	PROJECT: WARRIEWOOD ARV	JOB No : 1500259
				APPROVED : JR		
	REVISION	DATE	DESCRIPTION		DWG No : 042	REV 0

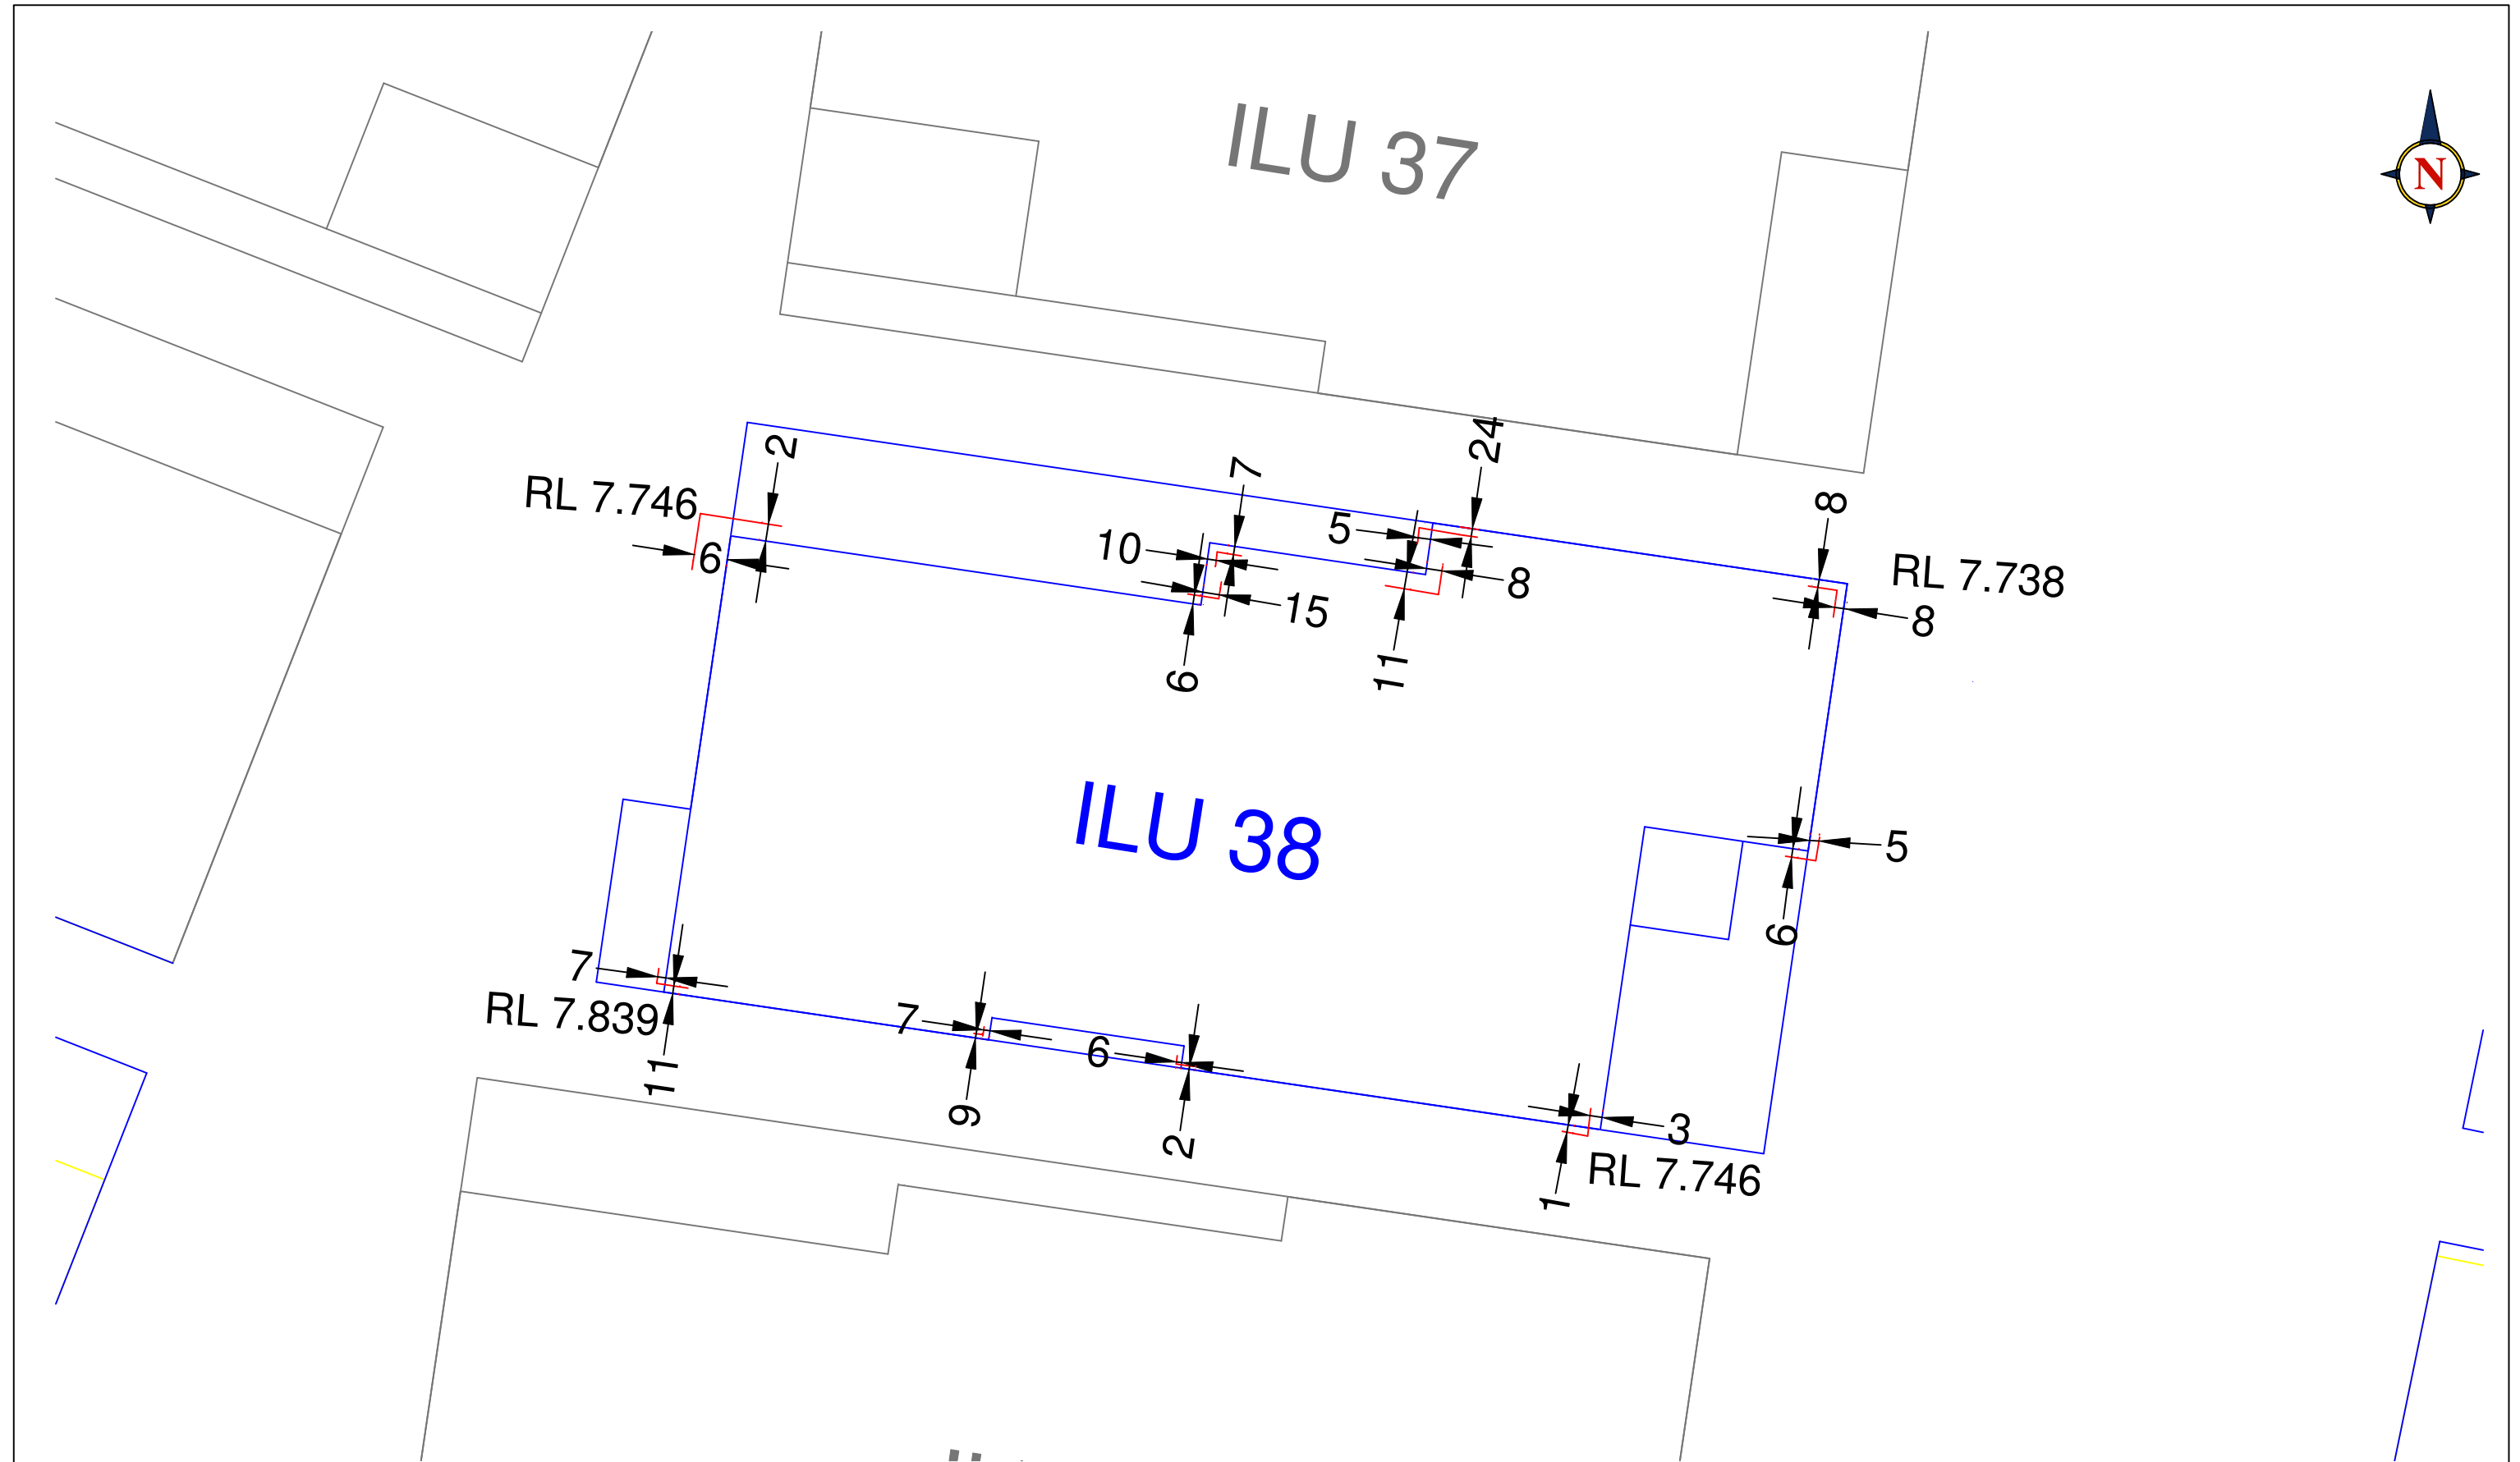

Land Surveys Sydney Office T (02) 8935 9451 F (02) 8935 9401 www.landsurveys.net.au E sydney@landsurveys.net.au Suite 3, 78 Reserve Road Artarmon NSW 2064 SCALE : 1: 100 ORIGINAL SIZE :	0	22/10/15	ISSUED TO CLIENT	SURVEYOR : DB	TITLE: FORM WORK CHECK ILU 38	CLIENT: PBS BUILDING	
				SURVEY DATE : 22/10/15			
				DRAWN : DB	PROJECT: WARRIEWOOD ARV	JOB No : 1500259	
				APPROVED : DB			
					DWG No : 059		REV
					0		

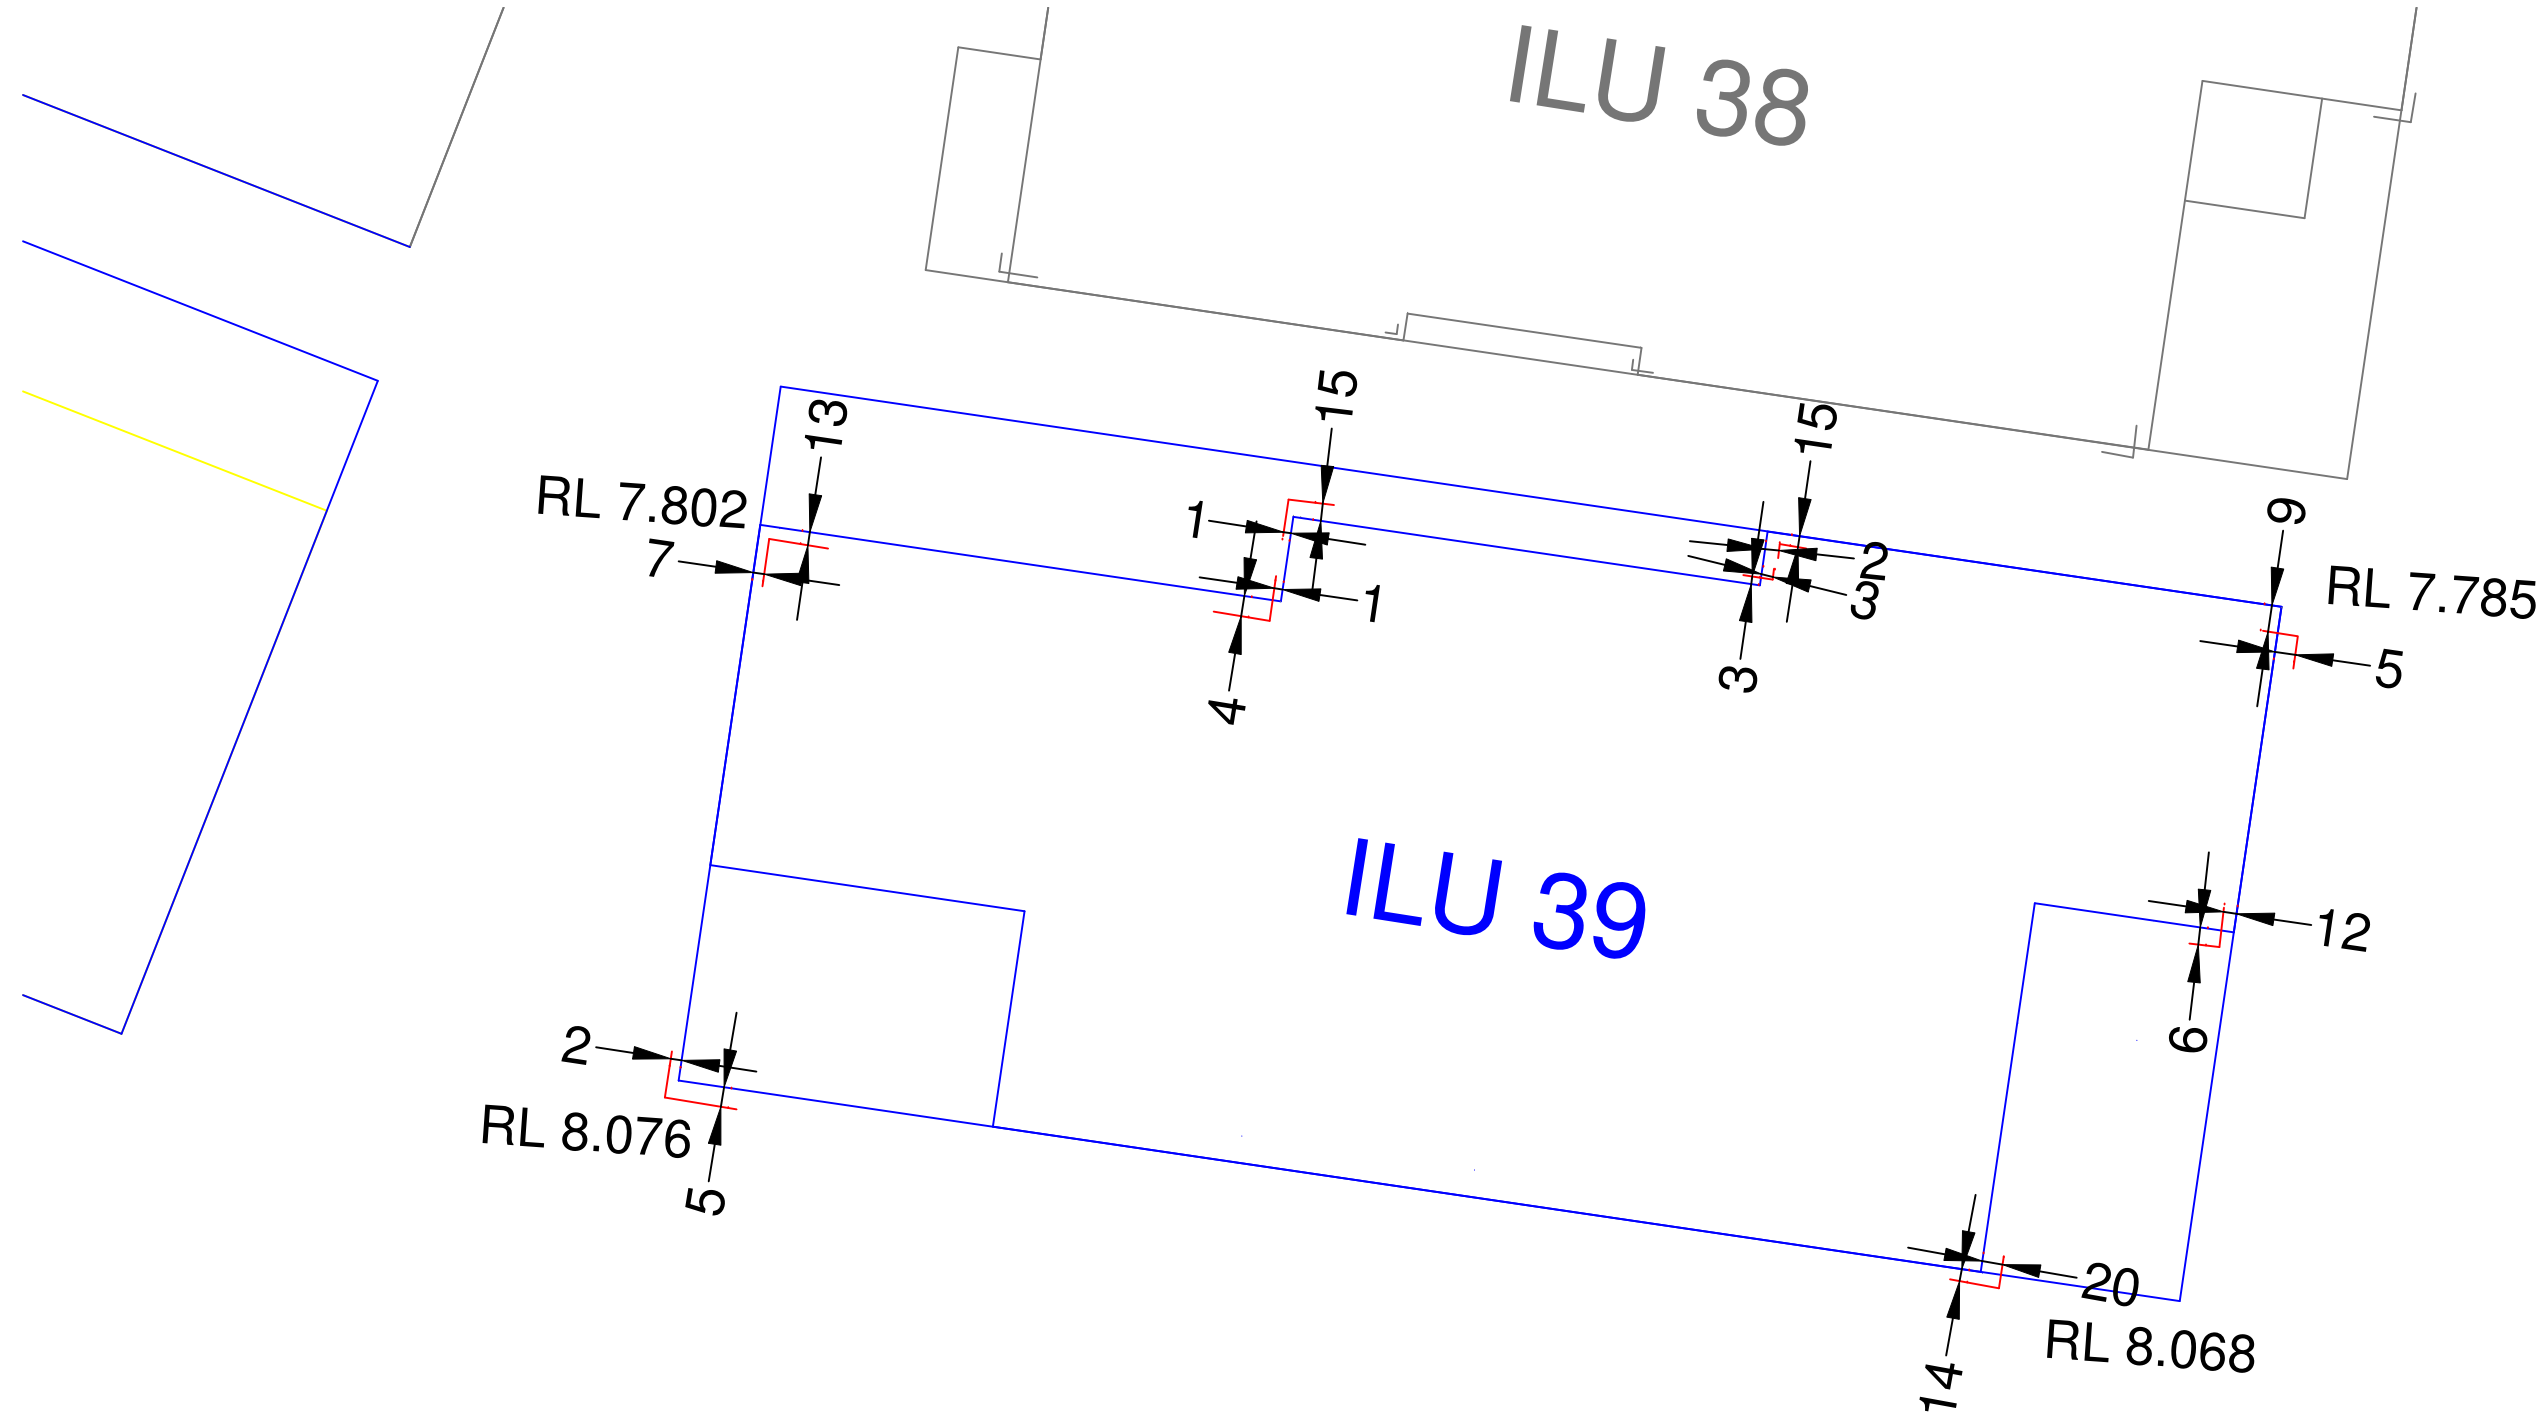

Land Surveys Sydney Office Suite 3, 78 Reserve Road Artarmon NSW 2064 T (02) 8935 9451 F (02) 8935 9401 www.landsurveys.net.au E sydney@landsurveys.net.au SCALE : 1: 100 ORIGINAL SIZE :	0	22/10/15	ISSUED TO CLIENT	SURVEYOR : DB	TITLE: FORM WORK CHECK ILU 39	CLIENT: PBS BUILDING	
				SURVEY DATE : 22/10/15			
				DRAWN : DB	PROJECT: WARRIEWOOD ARV	JOB No : 1500259	
				APPROVED : DB			
						DWG No : 060	REV 0
	REVISION	DATE	DESCRIPTION				

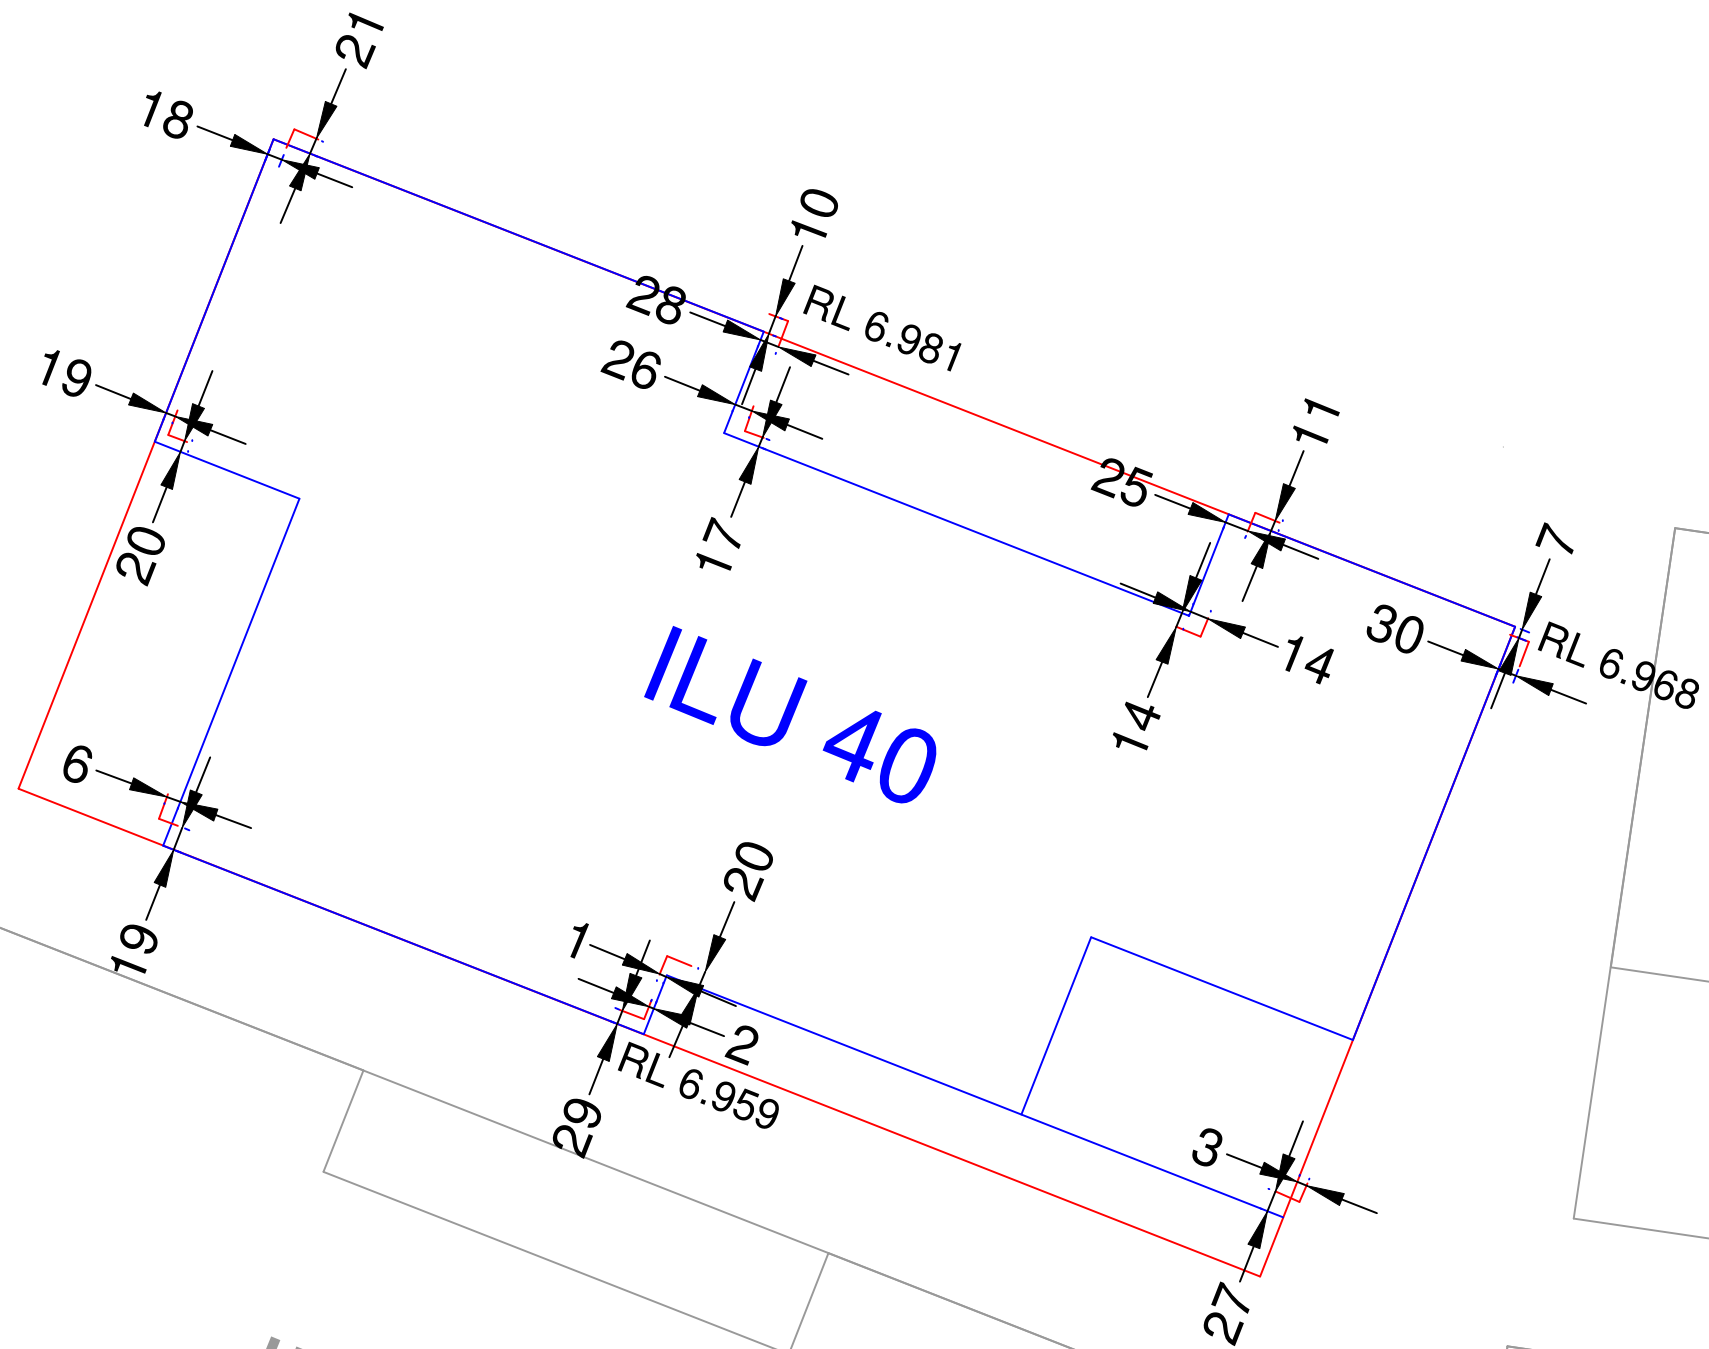


Land Surveys


Sydney Office
Suite 3, 78 Reserve Road
Artarmon NSW 2064
T (02) 8935 9451
F (02) 8935 9401
www.landsurveys.net.au
E sydney@landsurveys.net.au

SCALE :
1: 100
ORIGINAL SIZE :

0	31/8/15	ISSUED TO CLIENT	SURVEYOR : DB	TITLE: FORMWORK CHECK OF ILU 40	CLIENT: PBS BUILDING
			SURVEY DATE : 31/8/15		
			DRAWN : DB	PROJECT: WARRIEWOOD ARV	JOB No : 1500259
			APPROVED : JR		
REVISION	DATE	DESCRIPTION		DWG No : 041	REV 0

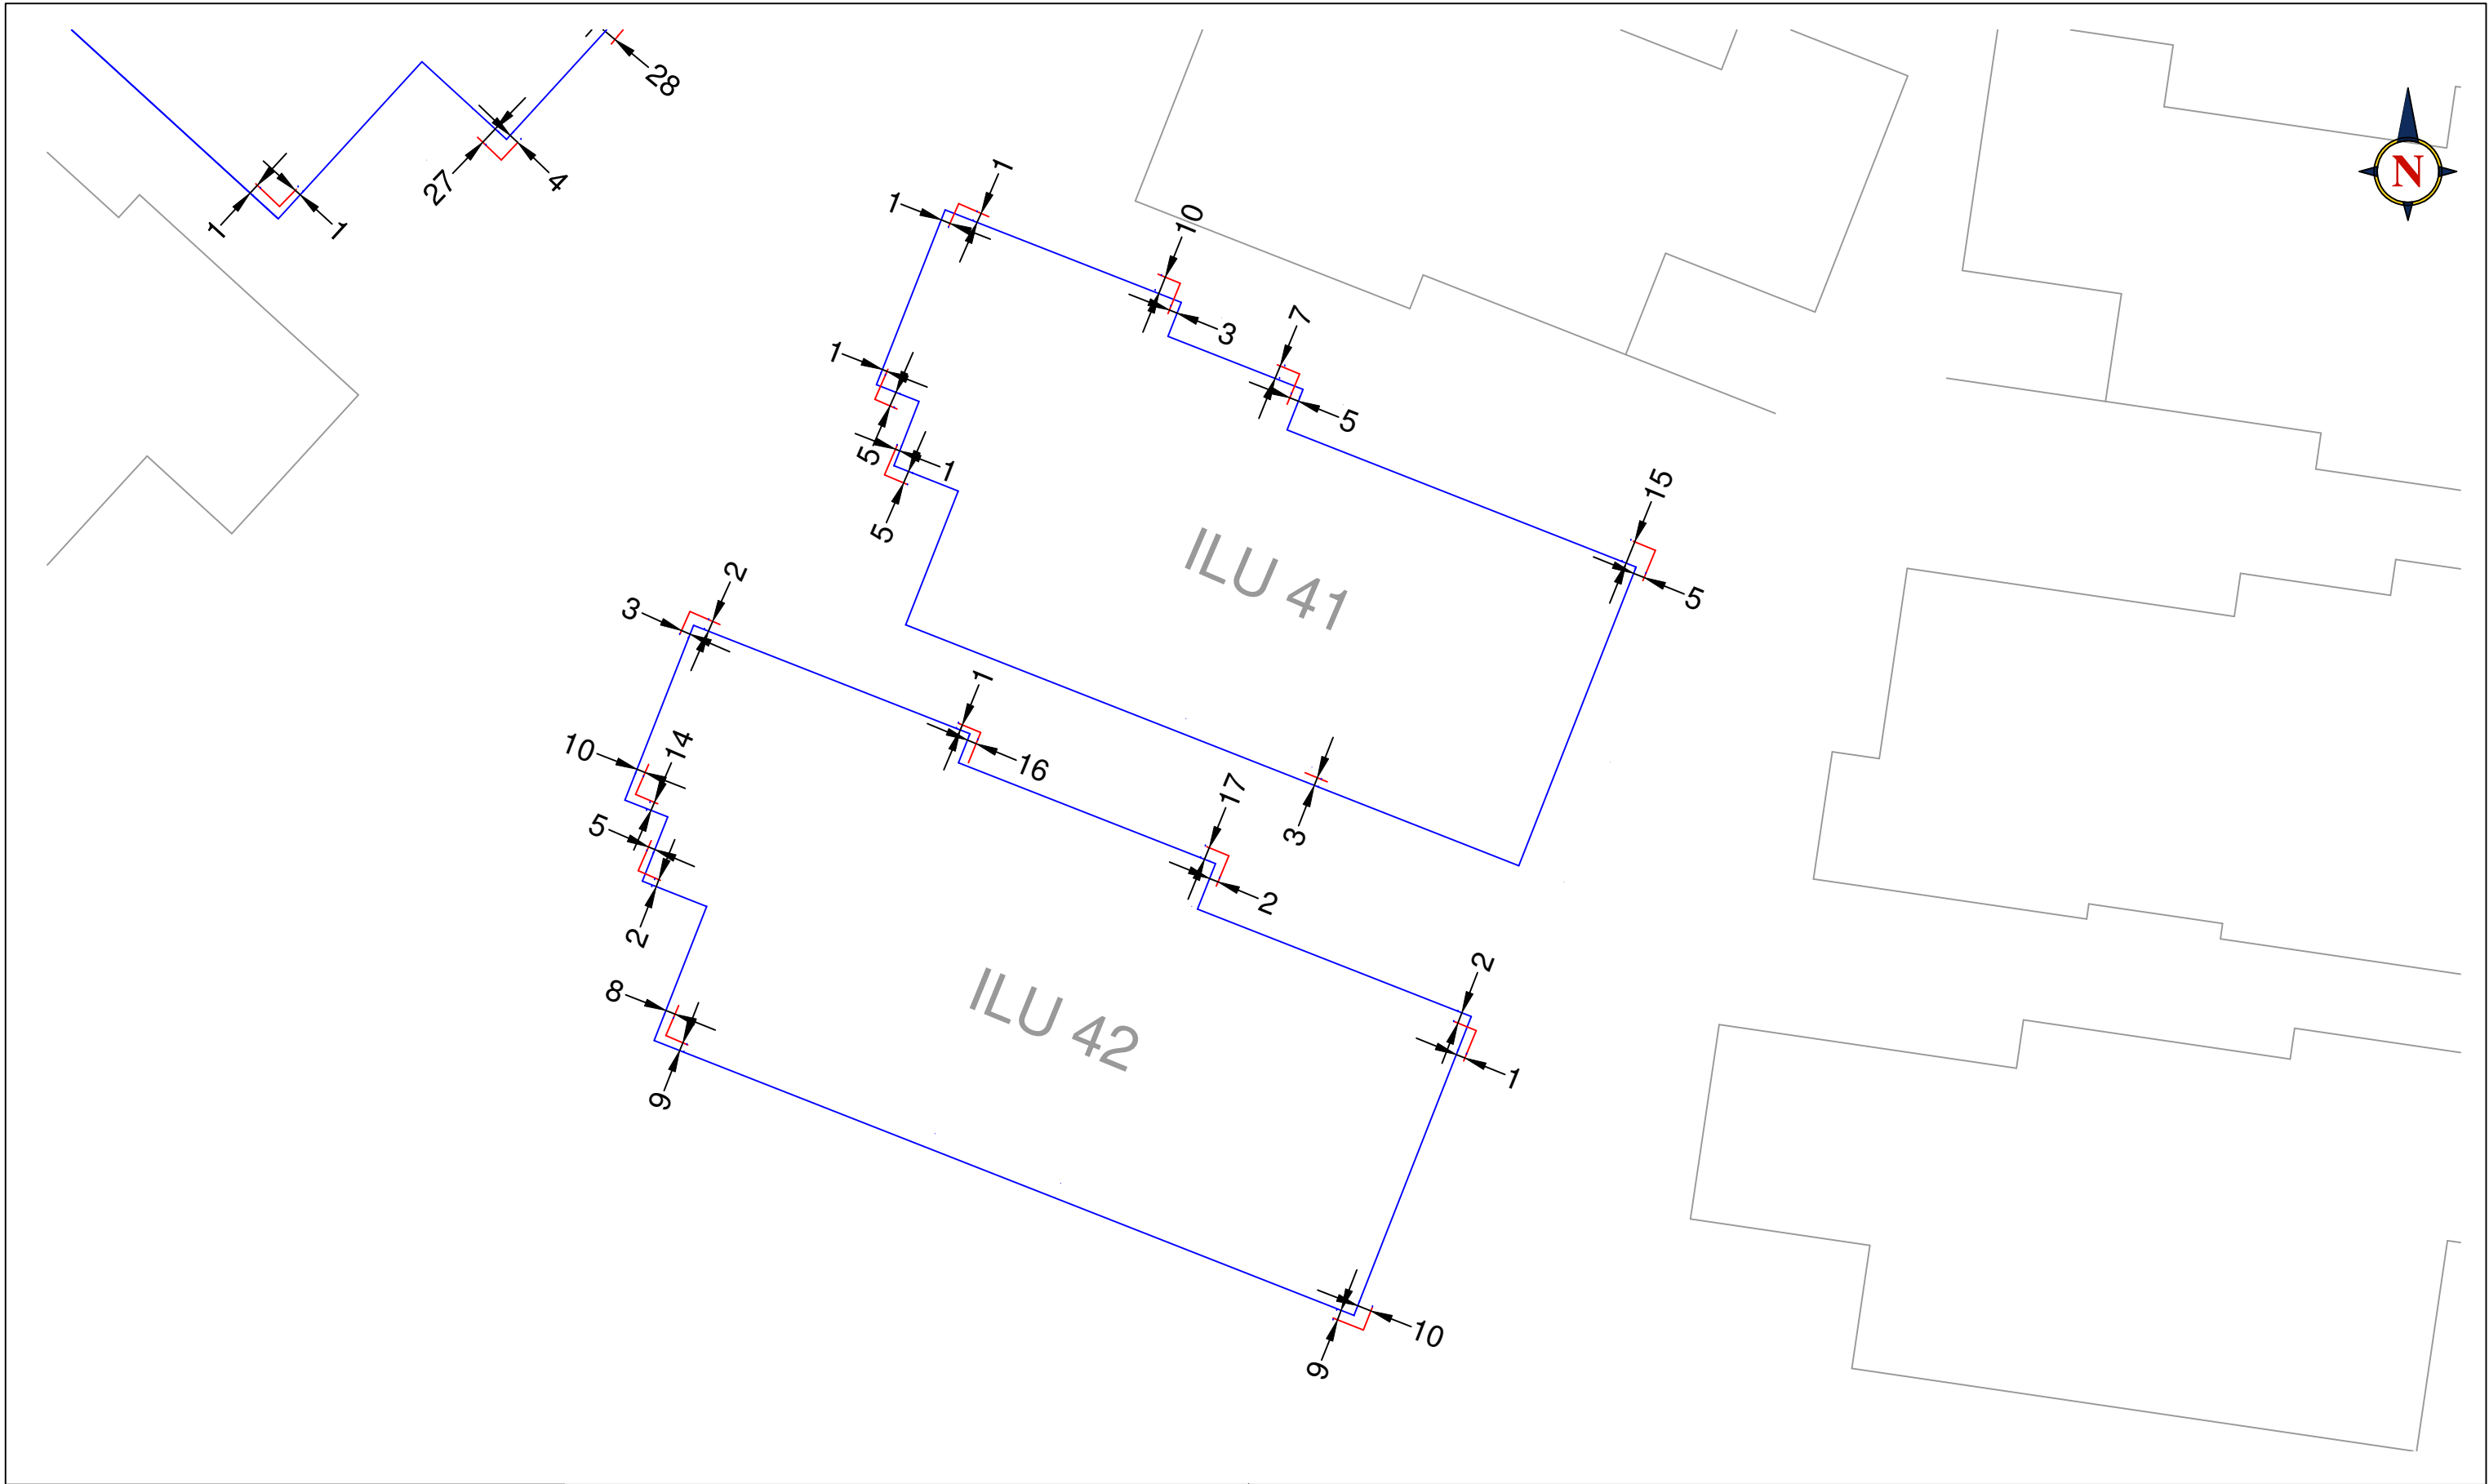

Land Surveys Sydney Office Suite 3, 78 Reserve Road Artarmon NSW 2064 T (02) 8935 9451 F (02) 8935 9401 www.landsurveys.net.au E sydney@landsurveys.net.au SCALE : 1: XXX ORIGINAL SIZE :	0	29/9/15	ISSUED TO CLIENT	SURVEYOR : DB	TITLE: SKETCH SHOWING FORM WORK CHECK OF ILU 41 AND 42	CLIENT: PBS BUILDING	
				SURVEY DATE : 29/9/15			
				DRAWN : DB	PROJECT: WARRIEWOOD ARV	JOB No : 1500259	
				APPROVED : JR			
				PBSBUILDING			
	REVISION	DATE	DESCRIPTION			DWG No : 050	REV 0

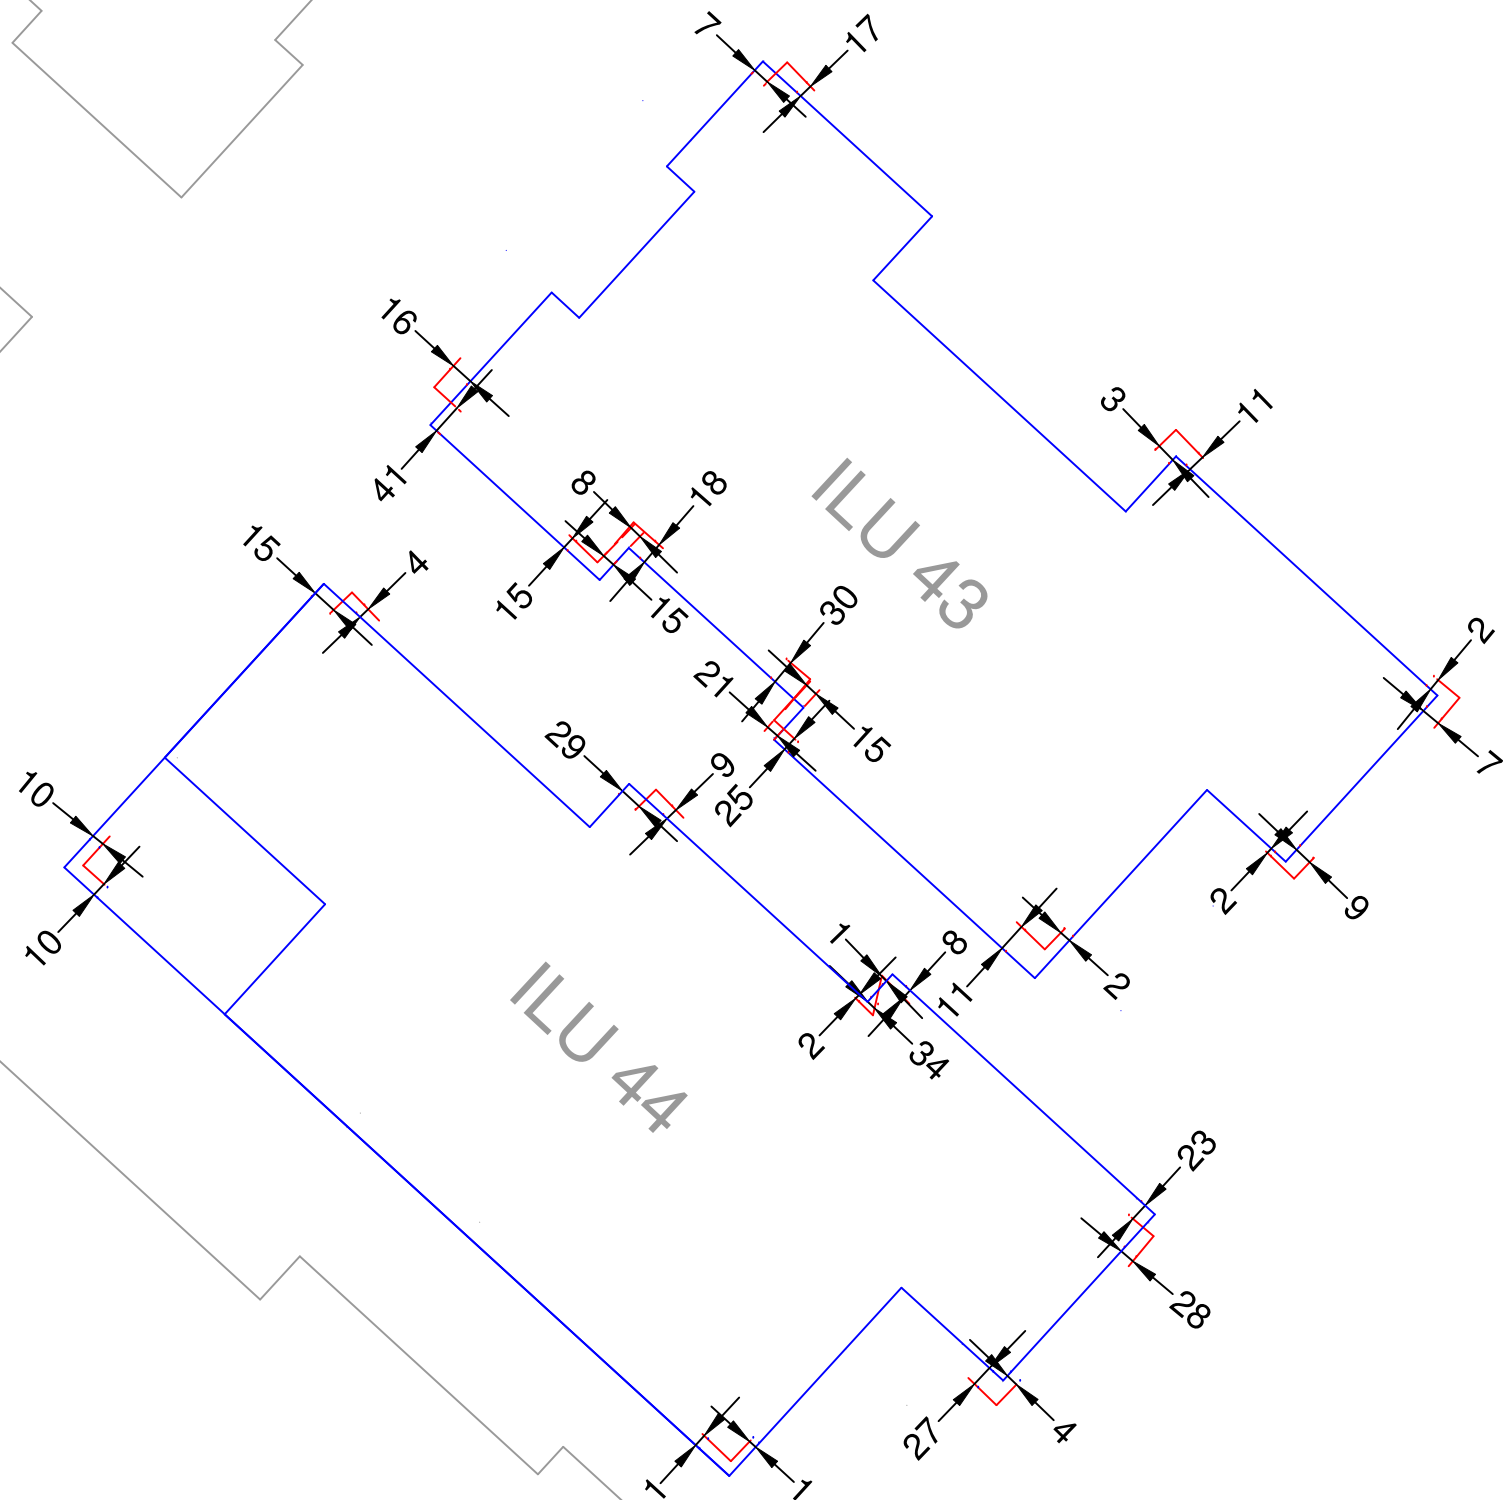

Land Surveys

Sydney Office
Suite 3, 78 Reserve Road
Artarmon NSW 2064
T (02) 8935 9451
F (02) 8935 9401
www.landsurveys.net.au
E sydney@landsurveys.net.au


SCALE :
1: xxx
ORIGINAL SIZE :

0	29/9/15	ISSUED TO CLIENT
REVISION	DATE	DESCRIPTION


SURVEYOR : DB
SURVEY DATE : 29/9/15
DRAWN : DB
APPROVED : JR
 PBSBUILDING

TITLE:	SKETCH SHOWING FORM WORK CHECK OF ILU 43 AND 44
PROJECT:	WARRIEWOOD ARV
DWG No : 049	REV 0


CLIENT: PBS BUILDING
JOB No : 1500259

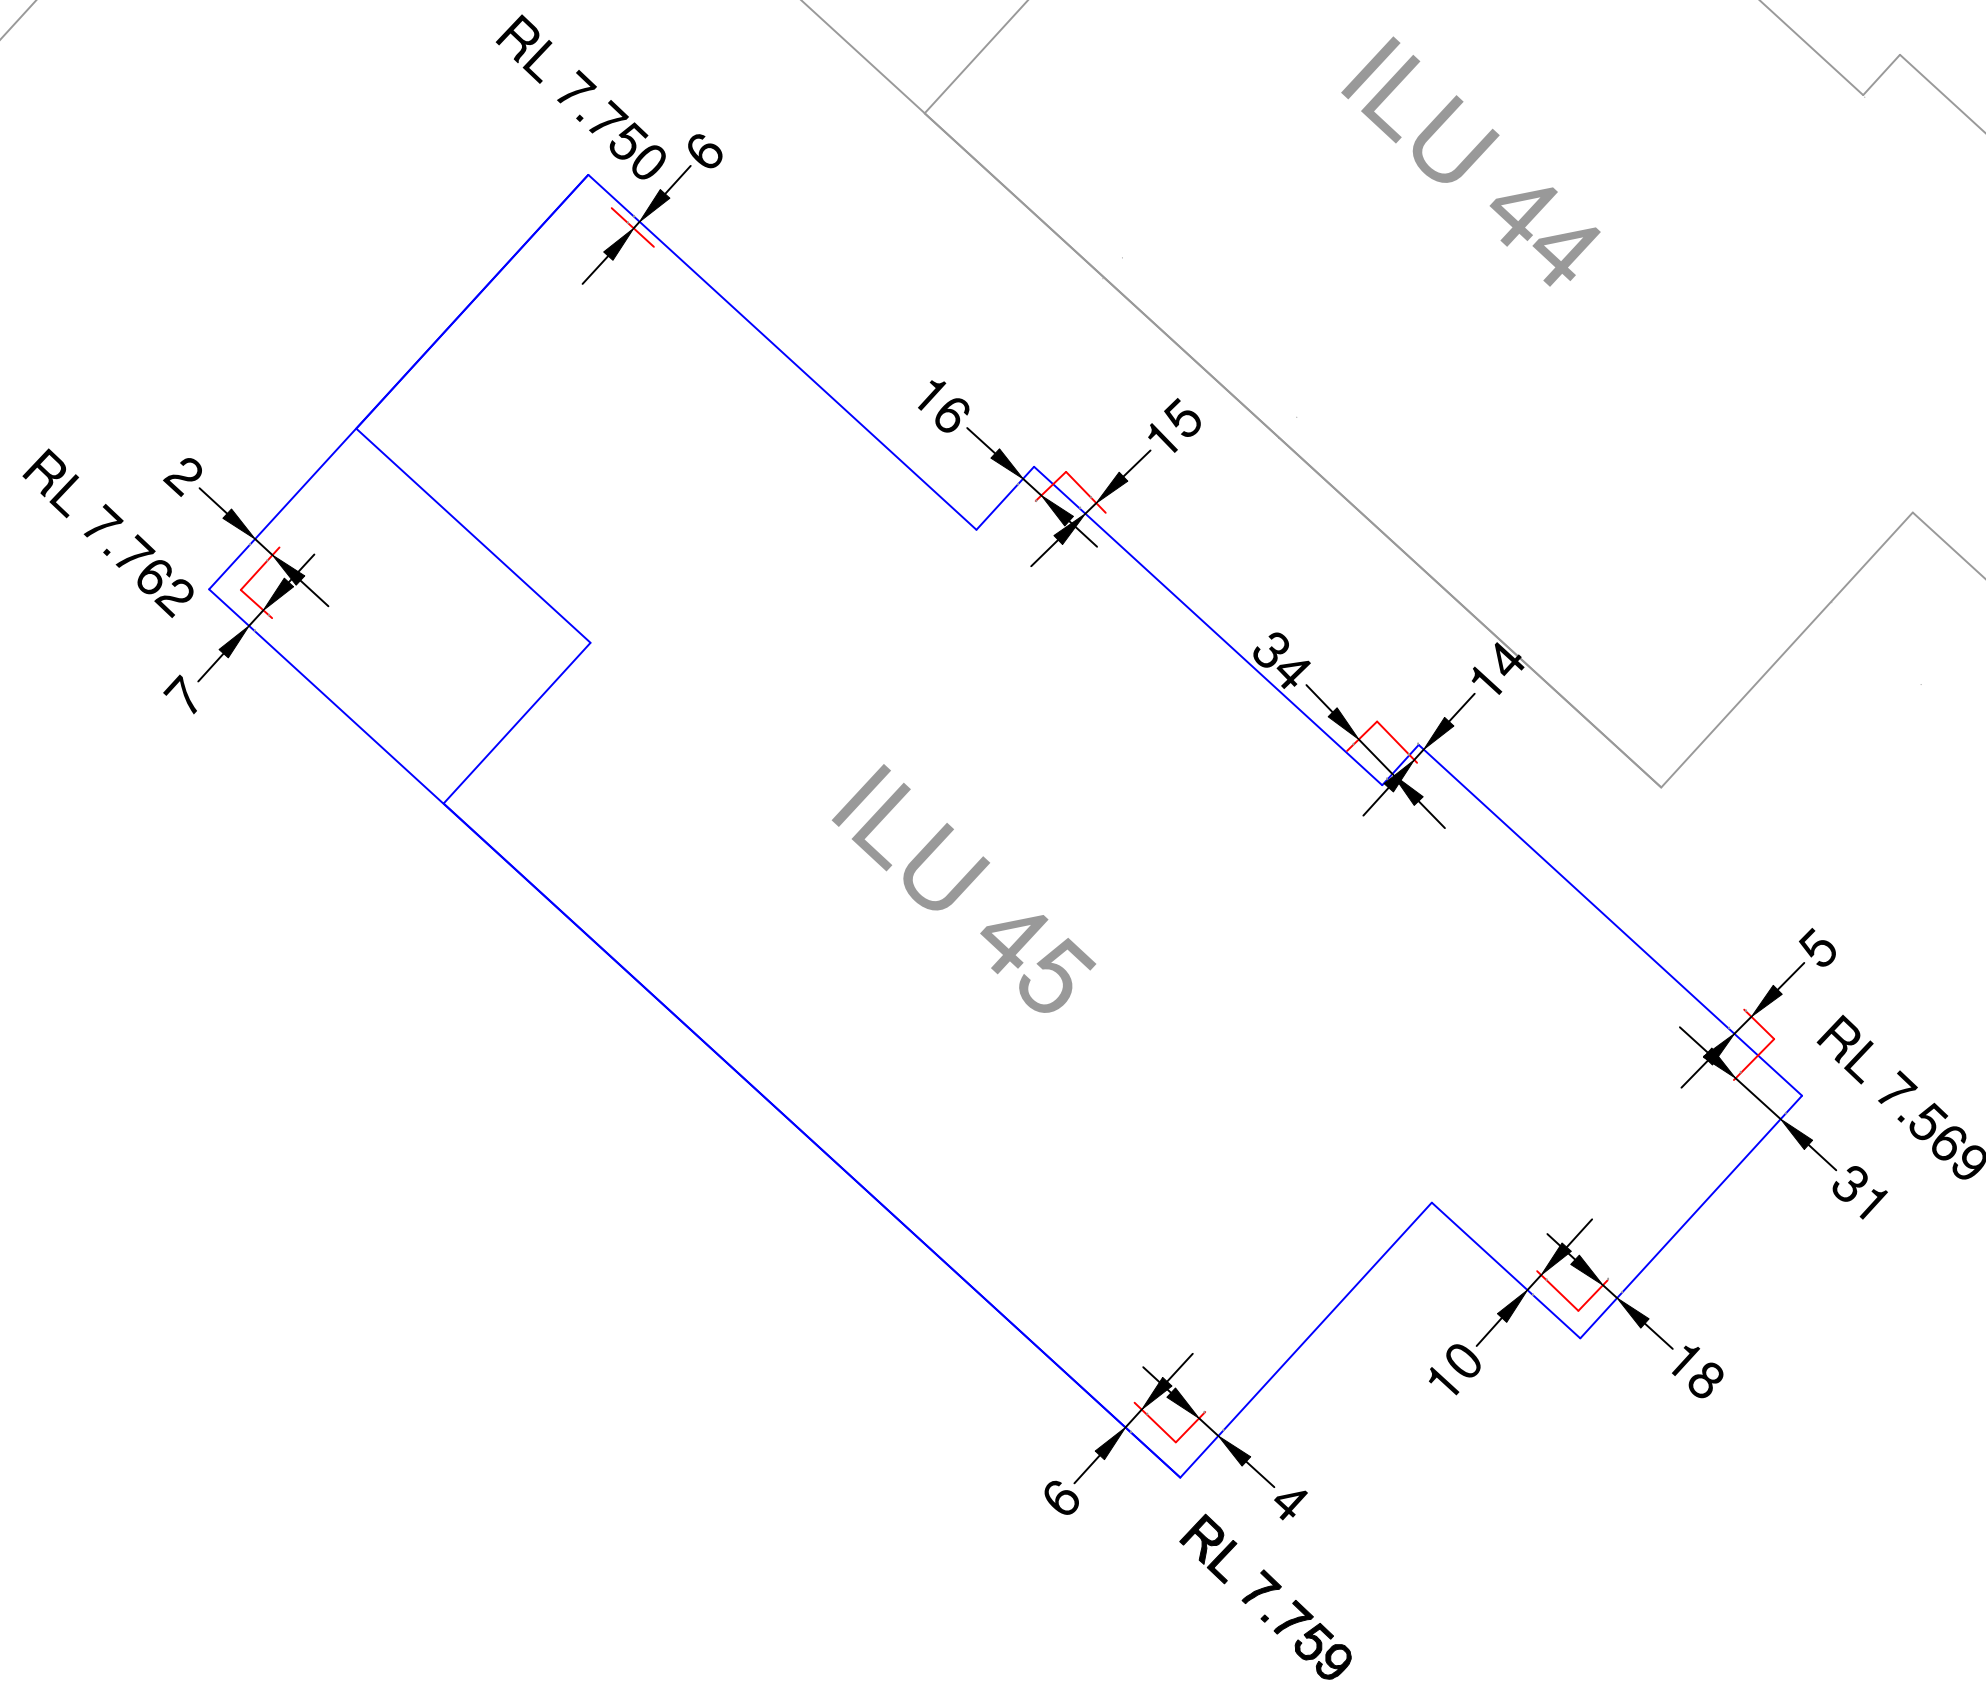


Land Surveys Sydney Office Suite 3, 78 Reserve Road Artarmon NSW 2064 SCALE : 1: 100 ORIGINAL SIZE :	0	2/10/15	ISSUED TO CLIENT	SURVEYOR : DB	TITLE: SKETCH SHOWING FORM WORK CHECK OF ILU 45	CLIENT: PBS BUILDING	
				SURVEY DATE : 2/10/15			
				DRAWN : DB	PROJECT: WARRIEWOOD ARV	JOB No : 1500259	
				APPROVED : DB			
						DWG No : 052	REV 0
	REVISION	DATE	DESCRIPTION				

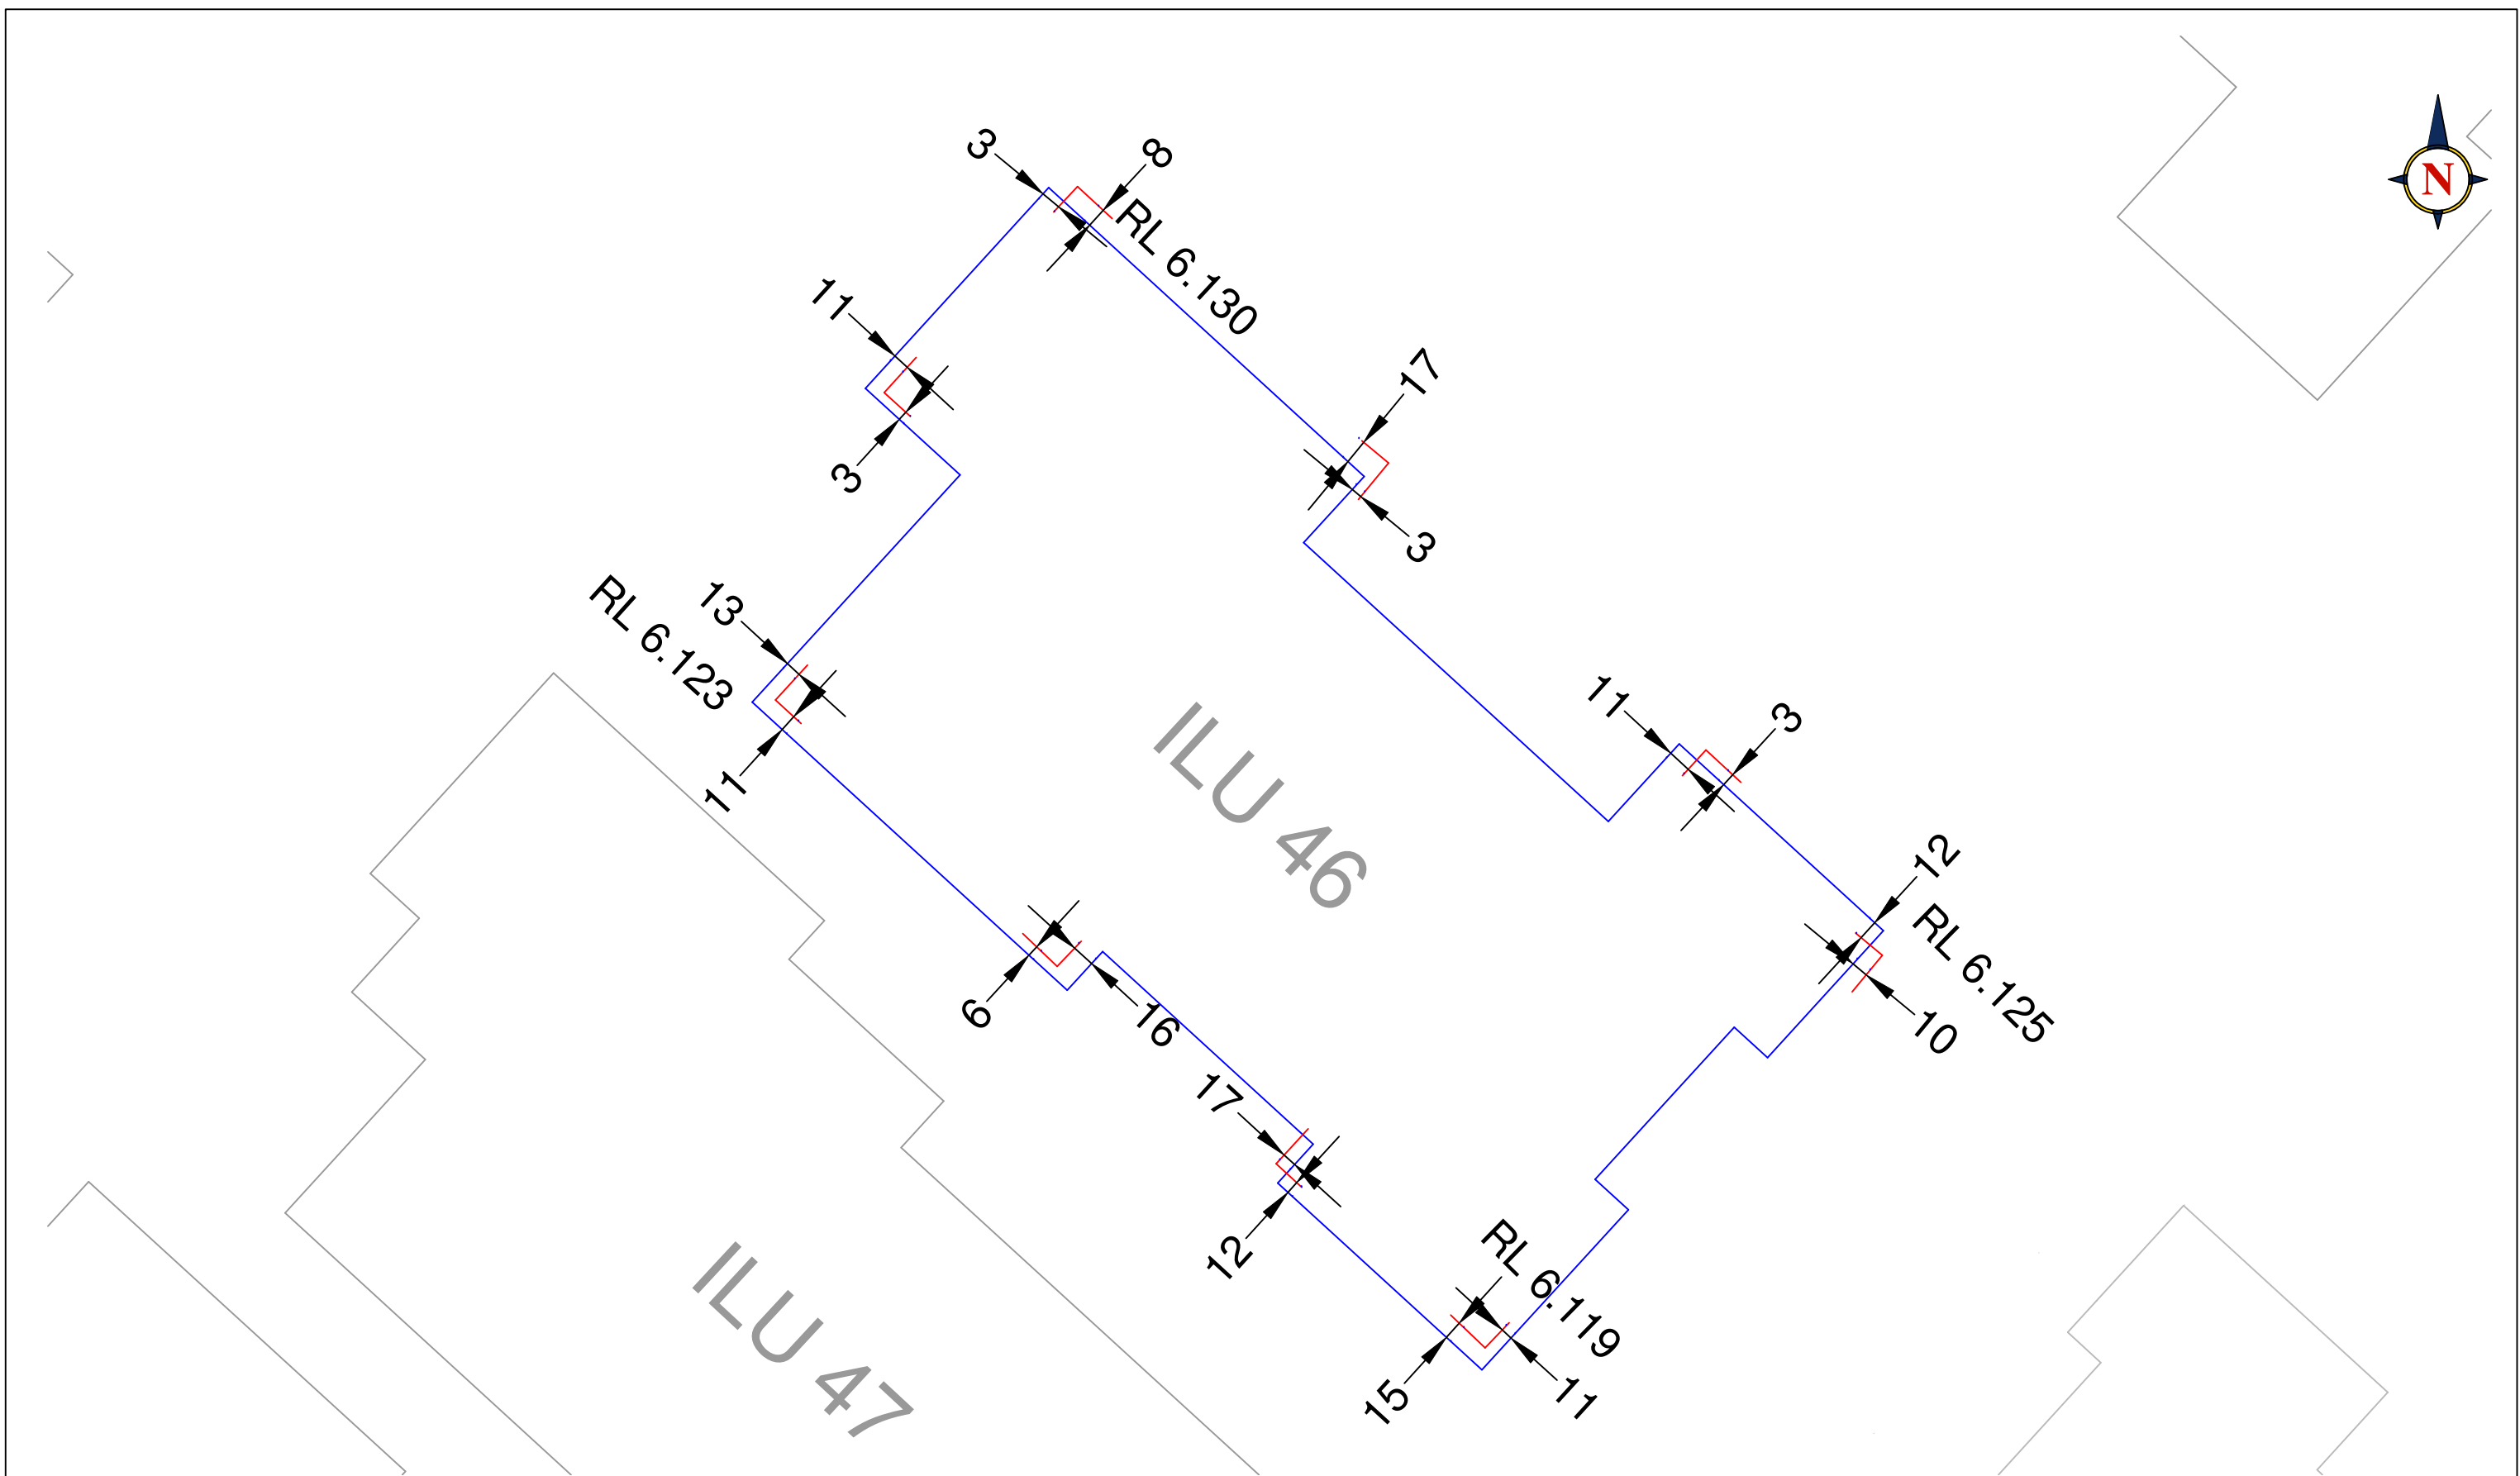


Land Surveys Sydney Office Suite 3, 78 Reserve Road Artarmon NSW 2064 T (02) 8935 9451 F (02) 8935 9401 www.landsurveys.net.au E sydney@landsurveys.net.au SCALE : 1: 100 ORIGINAL SIZE :	0	8/10/15	ISSUED TO CLIENT	SURVEYOR : DB	TITLE: SKETCH SHOWING FORM WORK CHECK OF ILU 46	CLIENT: PBS BUILDING	
				SURVEY DATE : 8/10/15			
				DRAWN : DB	PROJECT: WARRIEWOOD ARV	JOB No : 1500259	
				APPROVED : JR			
						DWG No : 055	REV 0
	REVISION	DATE	DESCRIPTION				

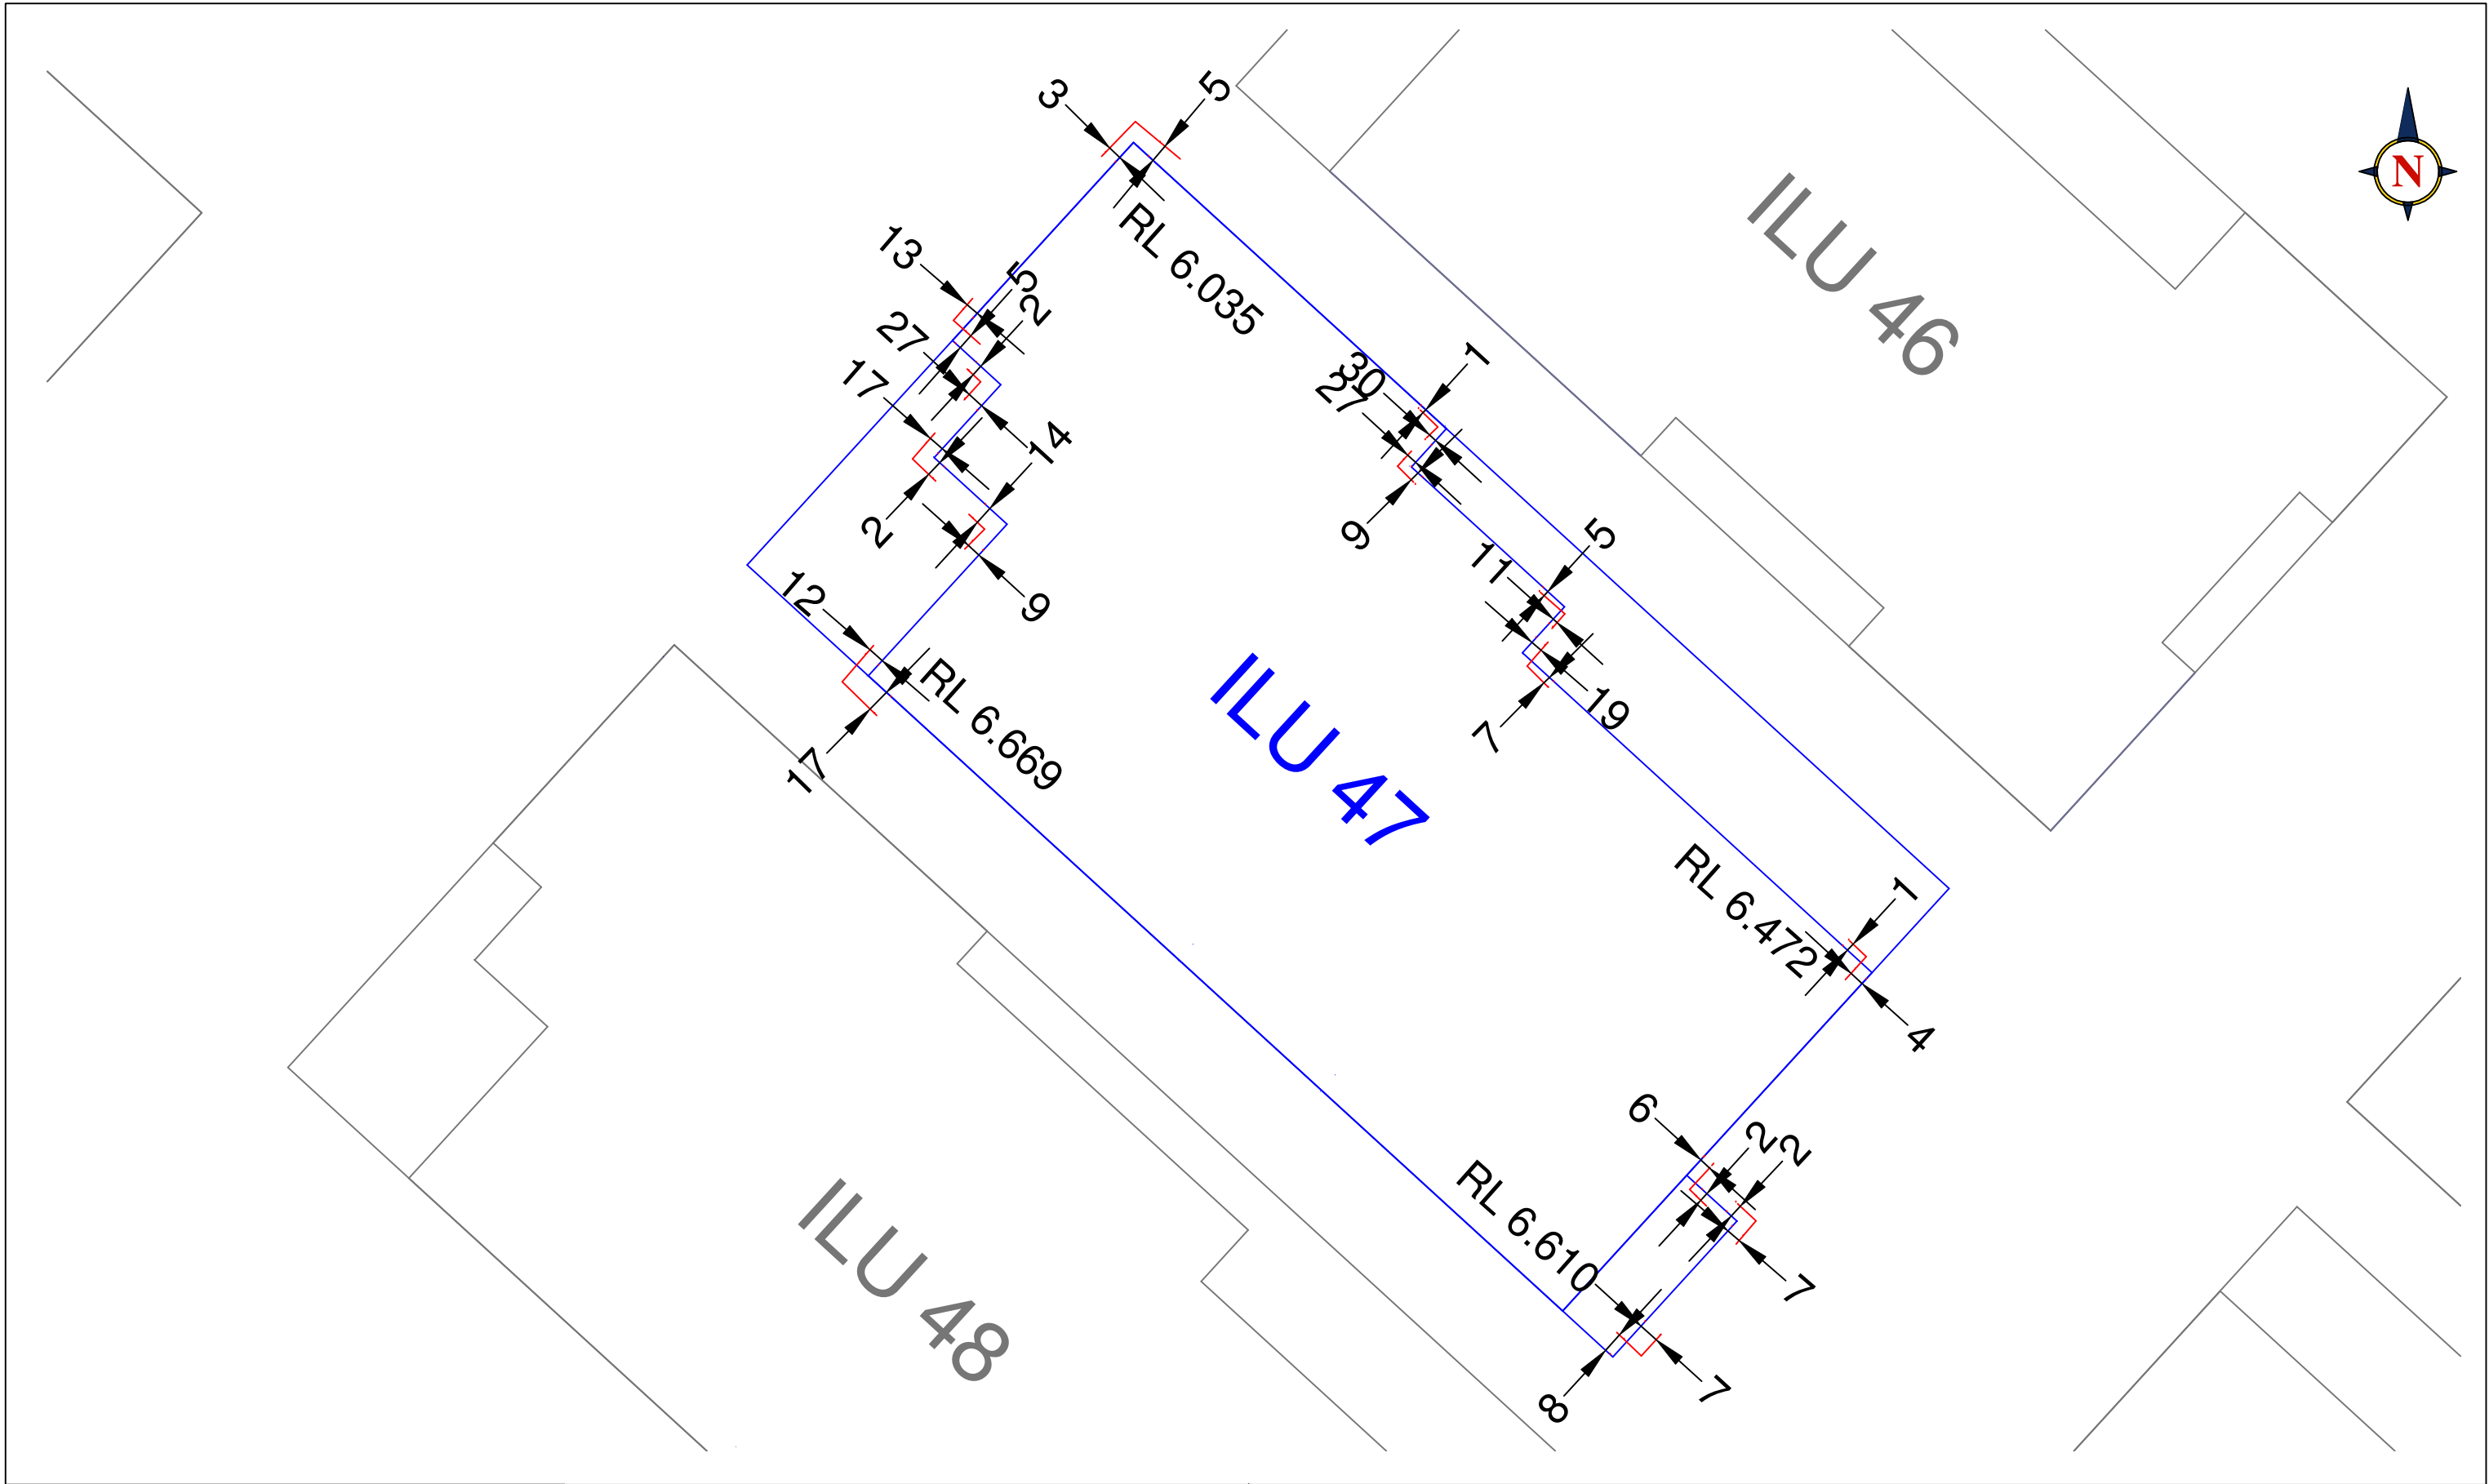


Land Surveys Sydney Office Suite 3, 78 Reserve Road Artarmon NSW 2064 T (02) 8935 9451 F (02) 8935 9401 www.landsurveys.net.au E sydney@landsurveys.net.au SCALE : 1: 100 ORIGINAL SIZE :	0	22/10/15	ISSUED TO CLIENT	SURVEYOR : DB	TITLE: FORMWORK CHECK OF ILU 47	CLIENT: PBS BUILDING	
				SURVEY DATE : 22/10/15			
				DRAWN : DB	PROJECT: WARRIEWOOD ARV	JOB No : 1500259	
				APPROVED : DB			
						DWG No : 062	REV 0
	REVISION	DATE	DESCRIPTION				

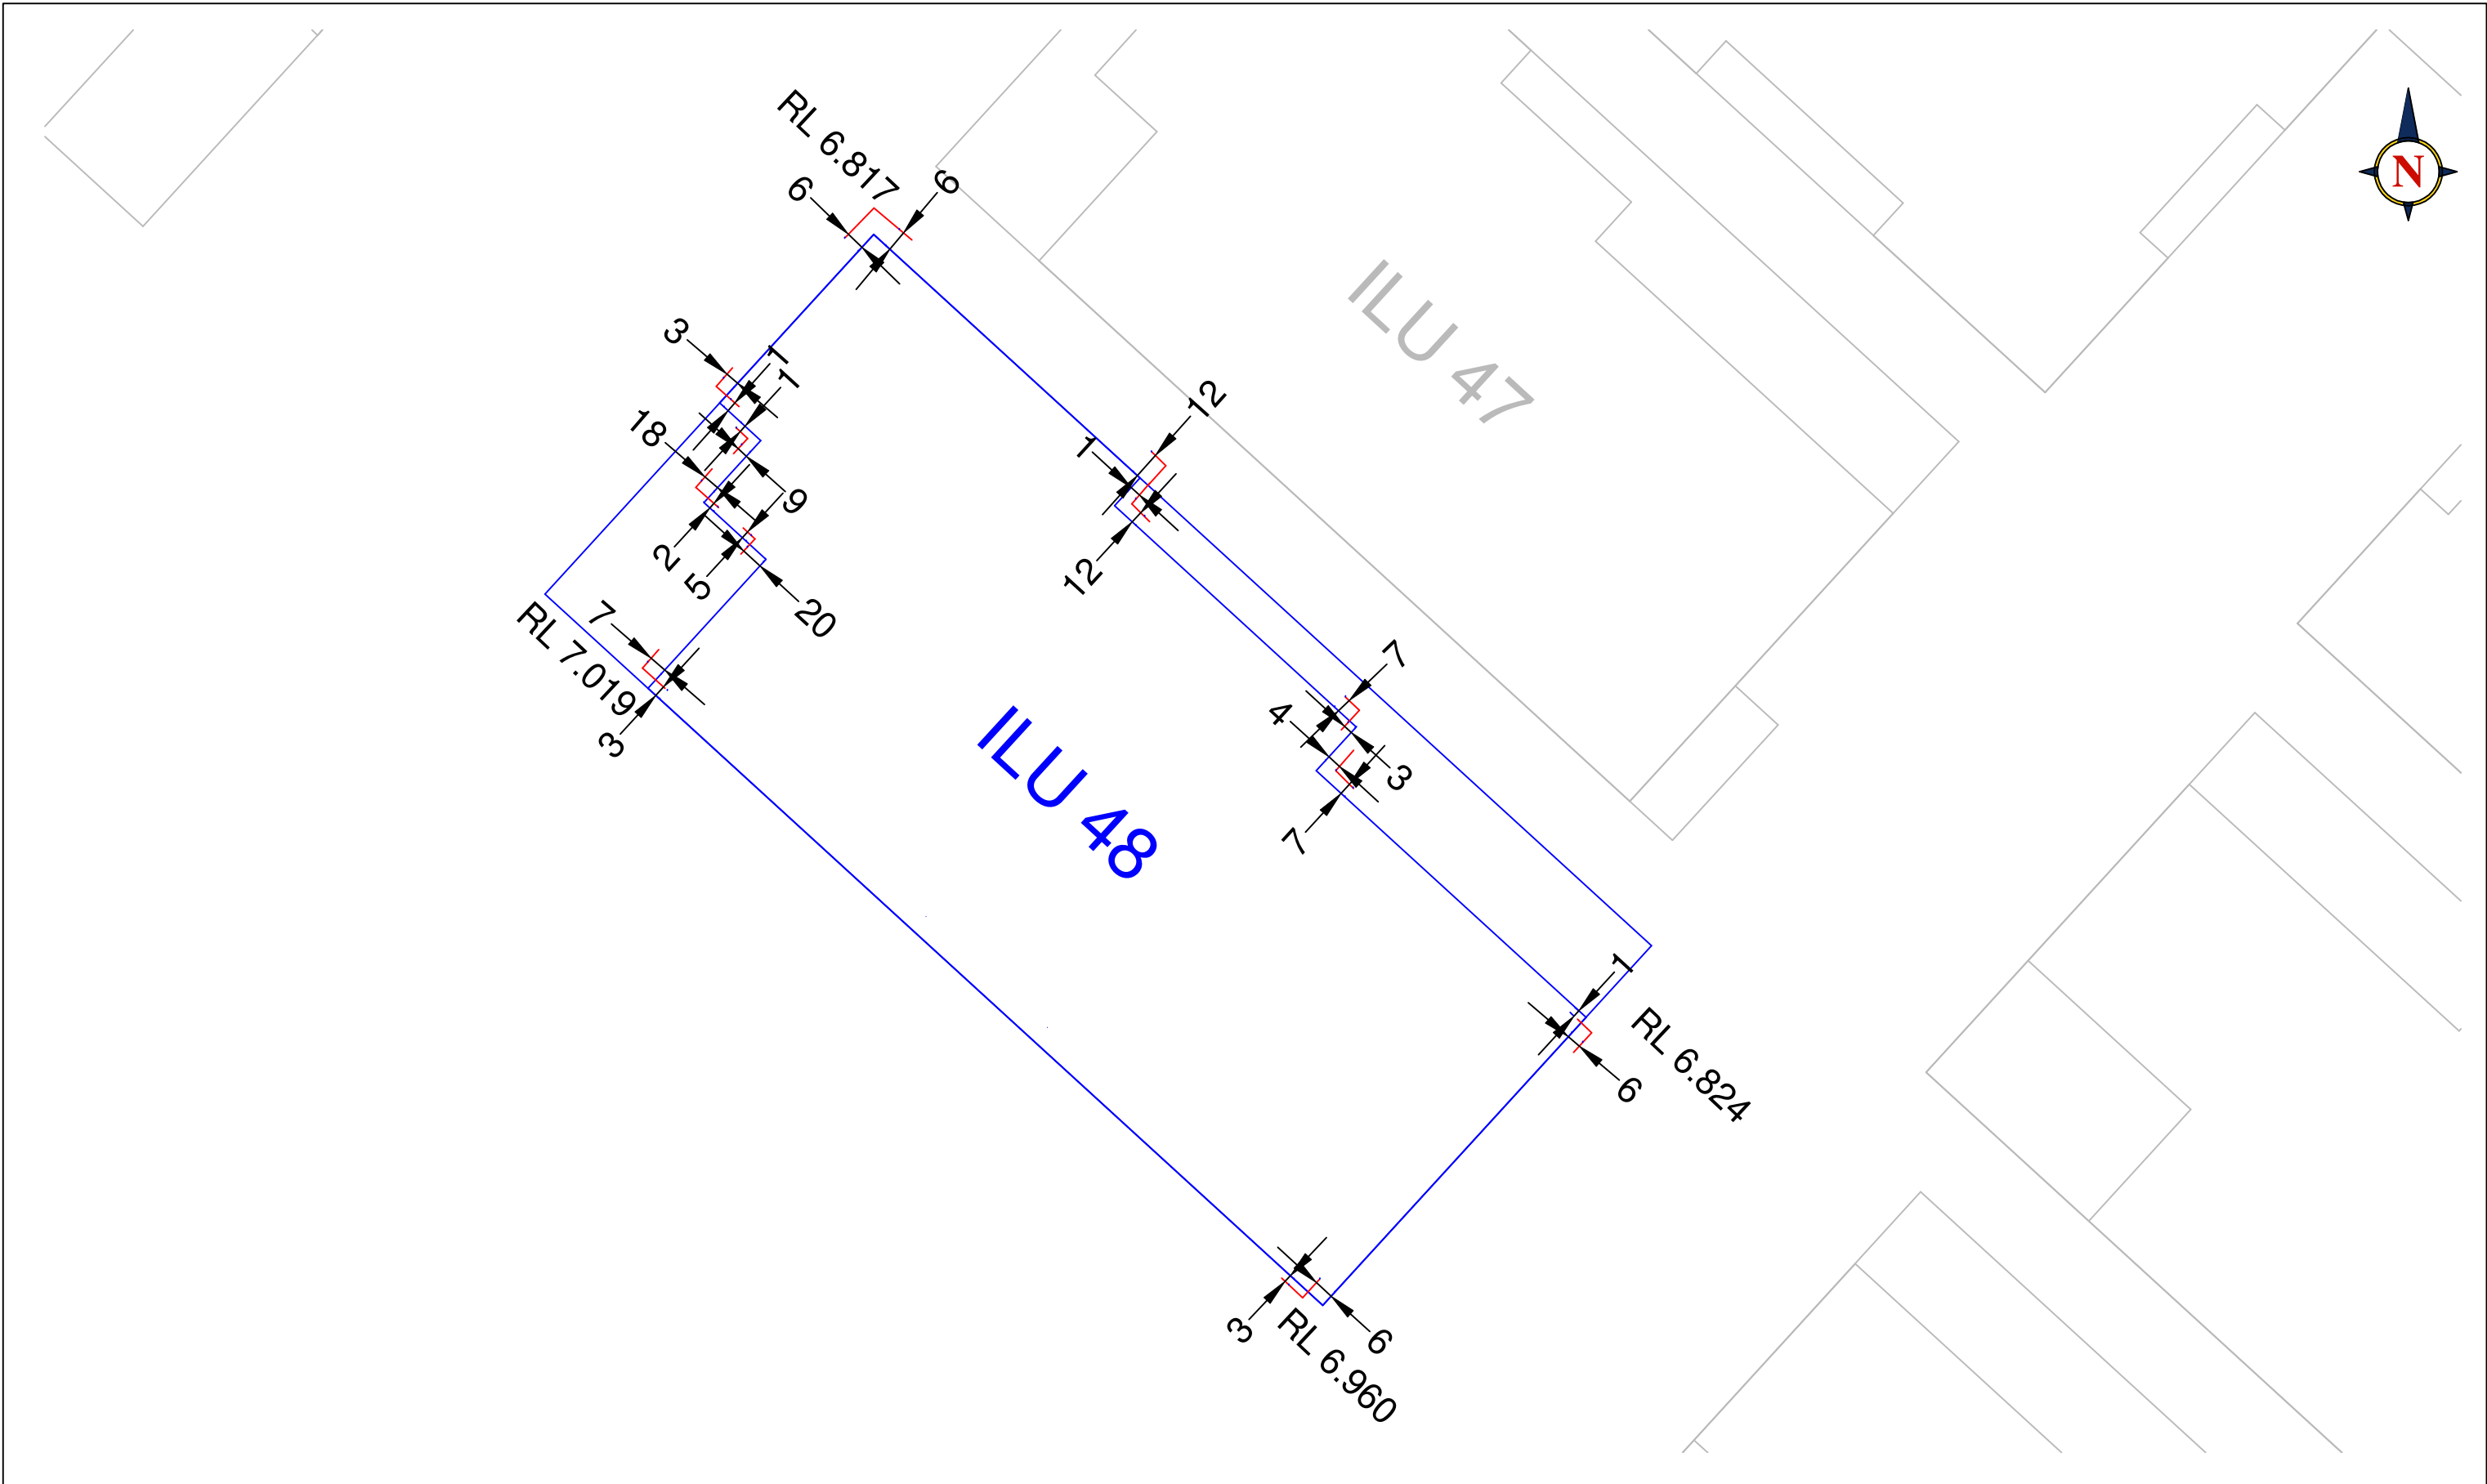


Land Surveys Sydney Office Suite 3, 78 Reserve Road Artarmon NSW 2064 T (02) 8935 9451 F (02) 8935 9401 www.landsurveys.net.au E sydney@landsurveys.net.au	0	02/11/15	ISSUED TO CLIENT	SURVEYOR : DB	TITLE: FORM WORK CHECK OF ILU 48	CLIENT: PBS BUILDING		
				SURVEY DATE : 02/11/15		PROJECT: WARRIEWOOD ARV	JOB No : 1500259	
				DRAWN : DB	PBSBUILDING			
				APPROVED : DB			DWG No : 063	REV 0
SCALE : 1: xxx ORIGINAL SIZE :	REVISION	DATE	DESCRIPTION					

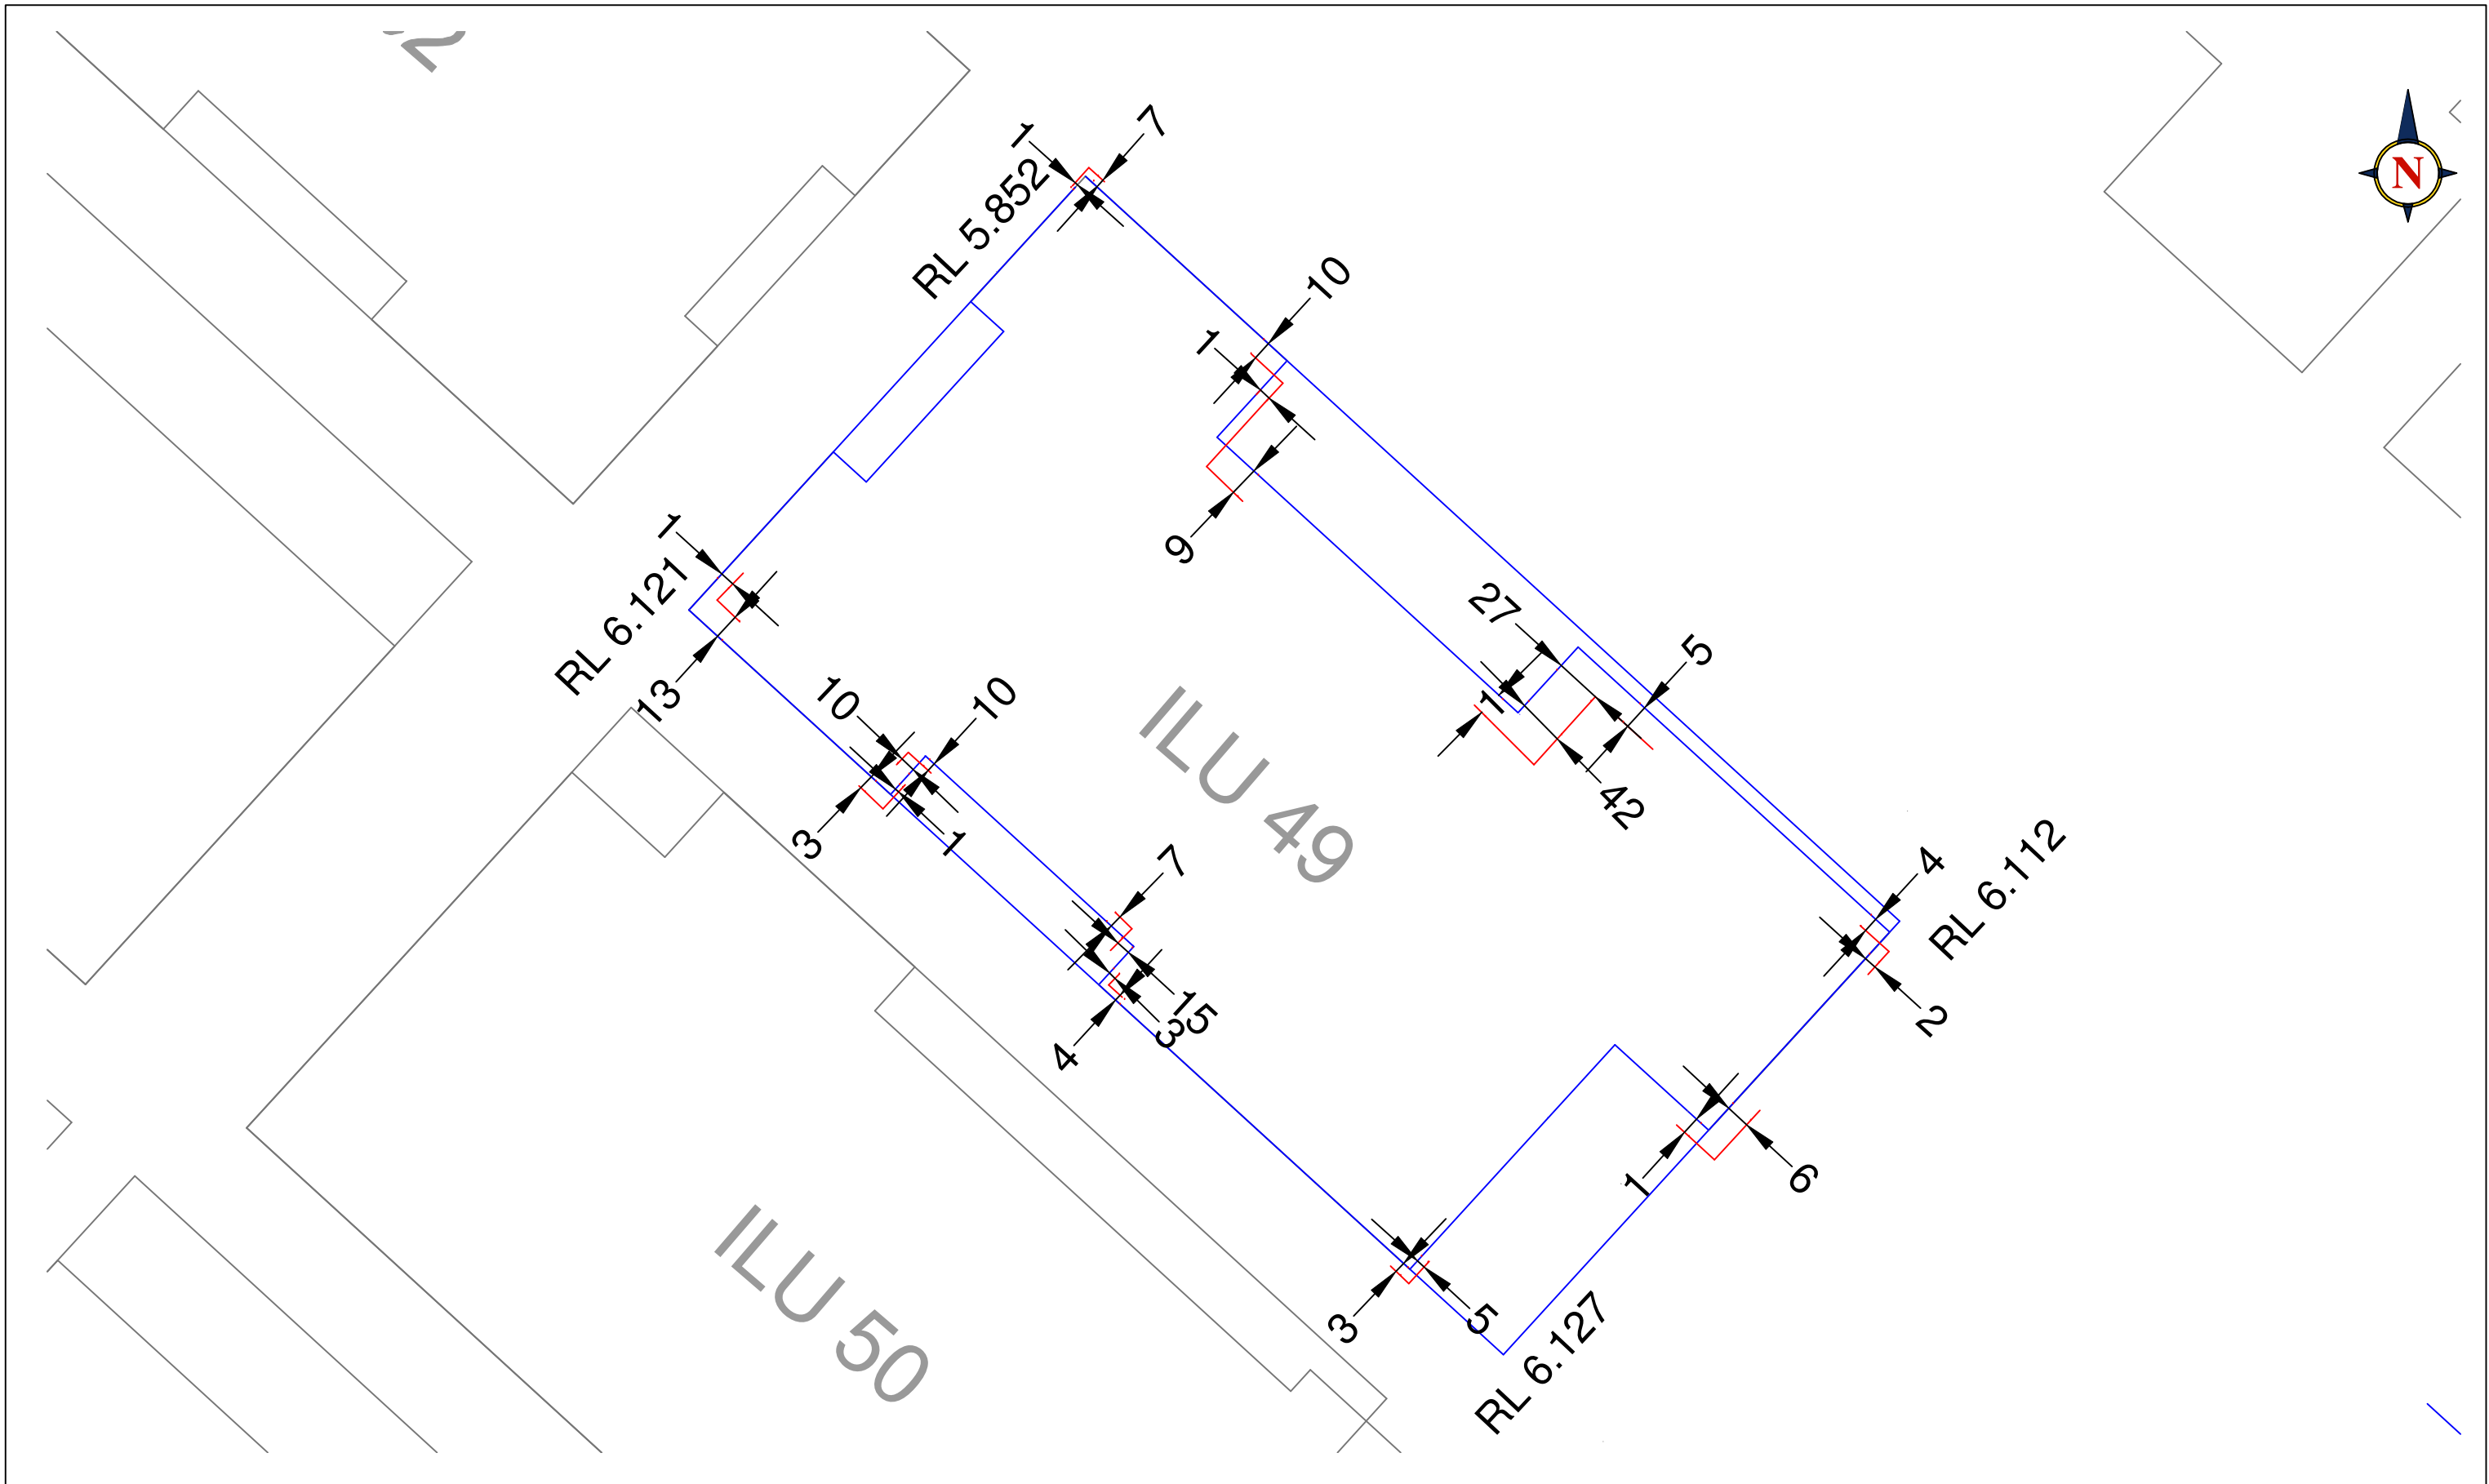


Land Surveys Sydney Office Suite 3, 78 Reserve Road Artarmon NSW 2064 T (02) 8935 9451 F (02) 8935 9401 www.landsurveys.net.au E sydney@landsurveys.net.au SCALE : 1: 100 ORIGINAL SIZE :	0	15/10/15	ISSUED TO CLIENT	SURVEYOR : DB	TITLE: FORM WORK CHECK ILU 49	CLIENT: PBS BUILDING	
				SURVEY DATE : 15/10/15			
				DRAWN : DB	PROJECT: WARRIEWOOD ARV	JOB No : 1500259	
				APPROVED : DB			
	REVISION	DATE	DESCRIPTION		DWG No : 057	REV 0	

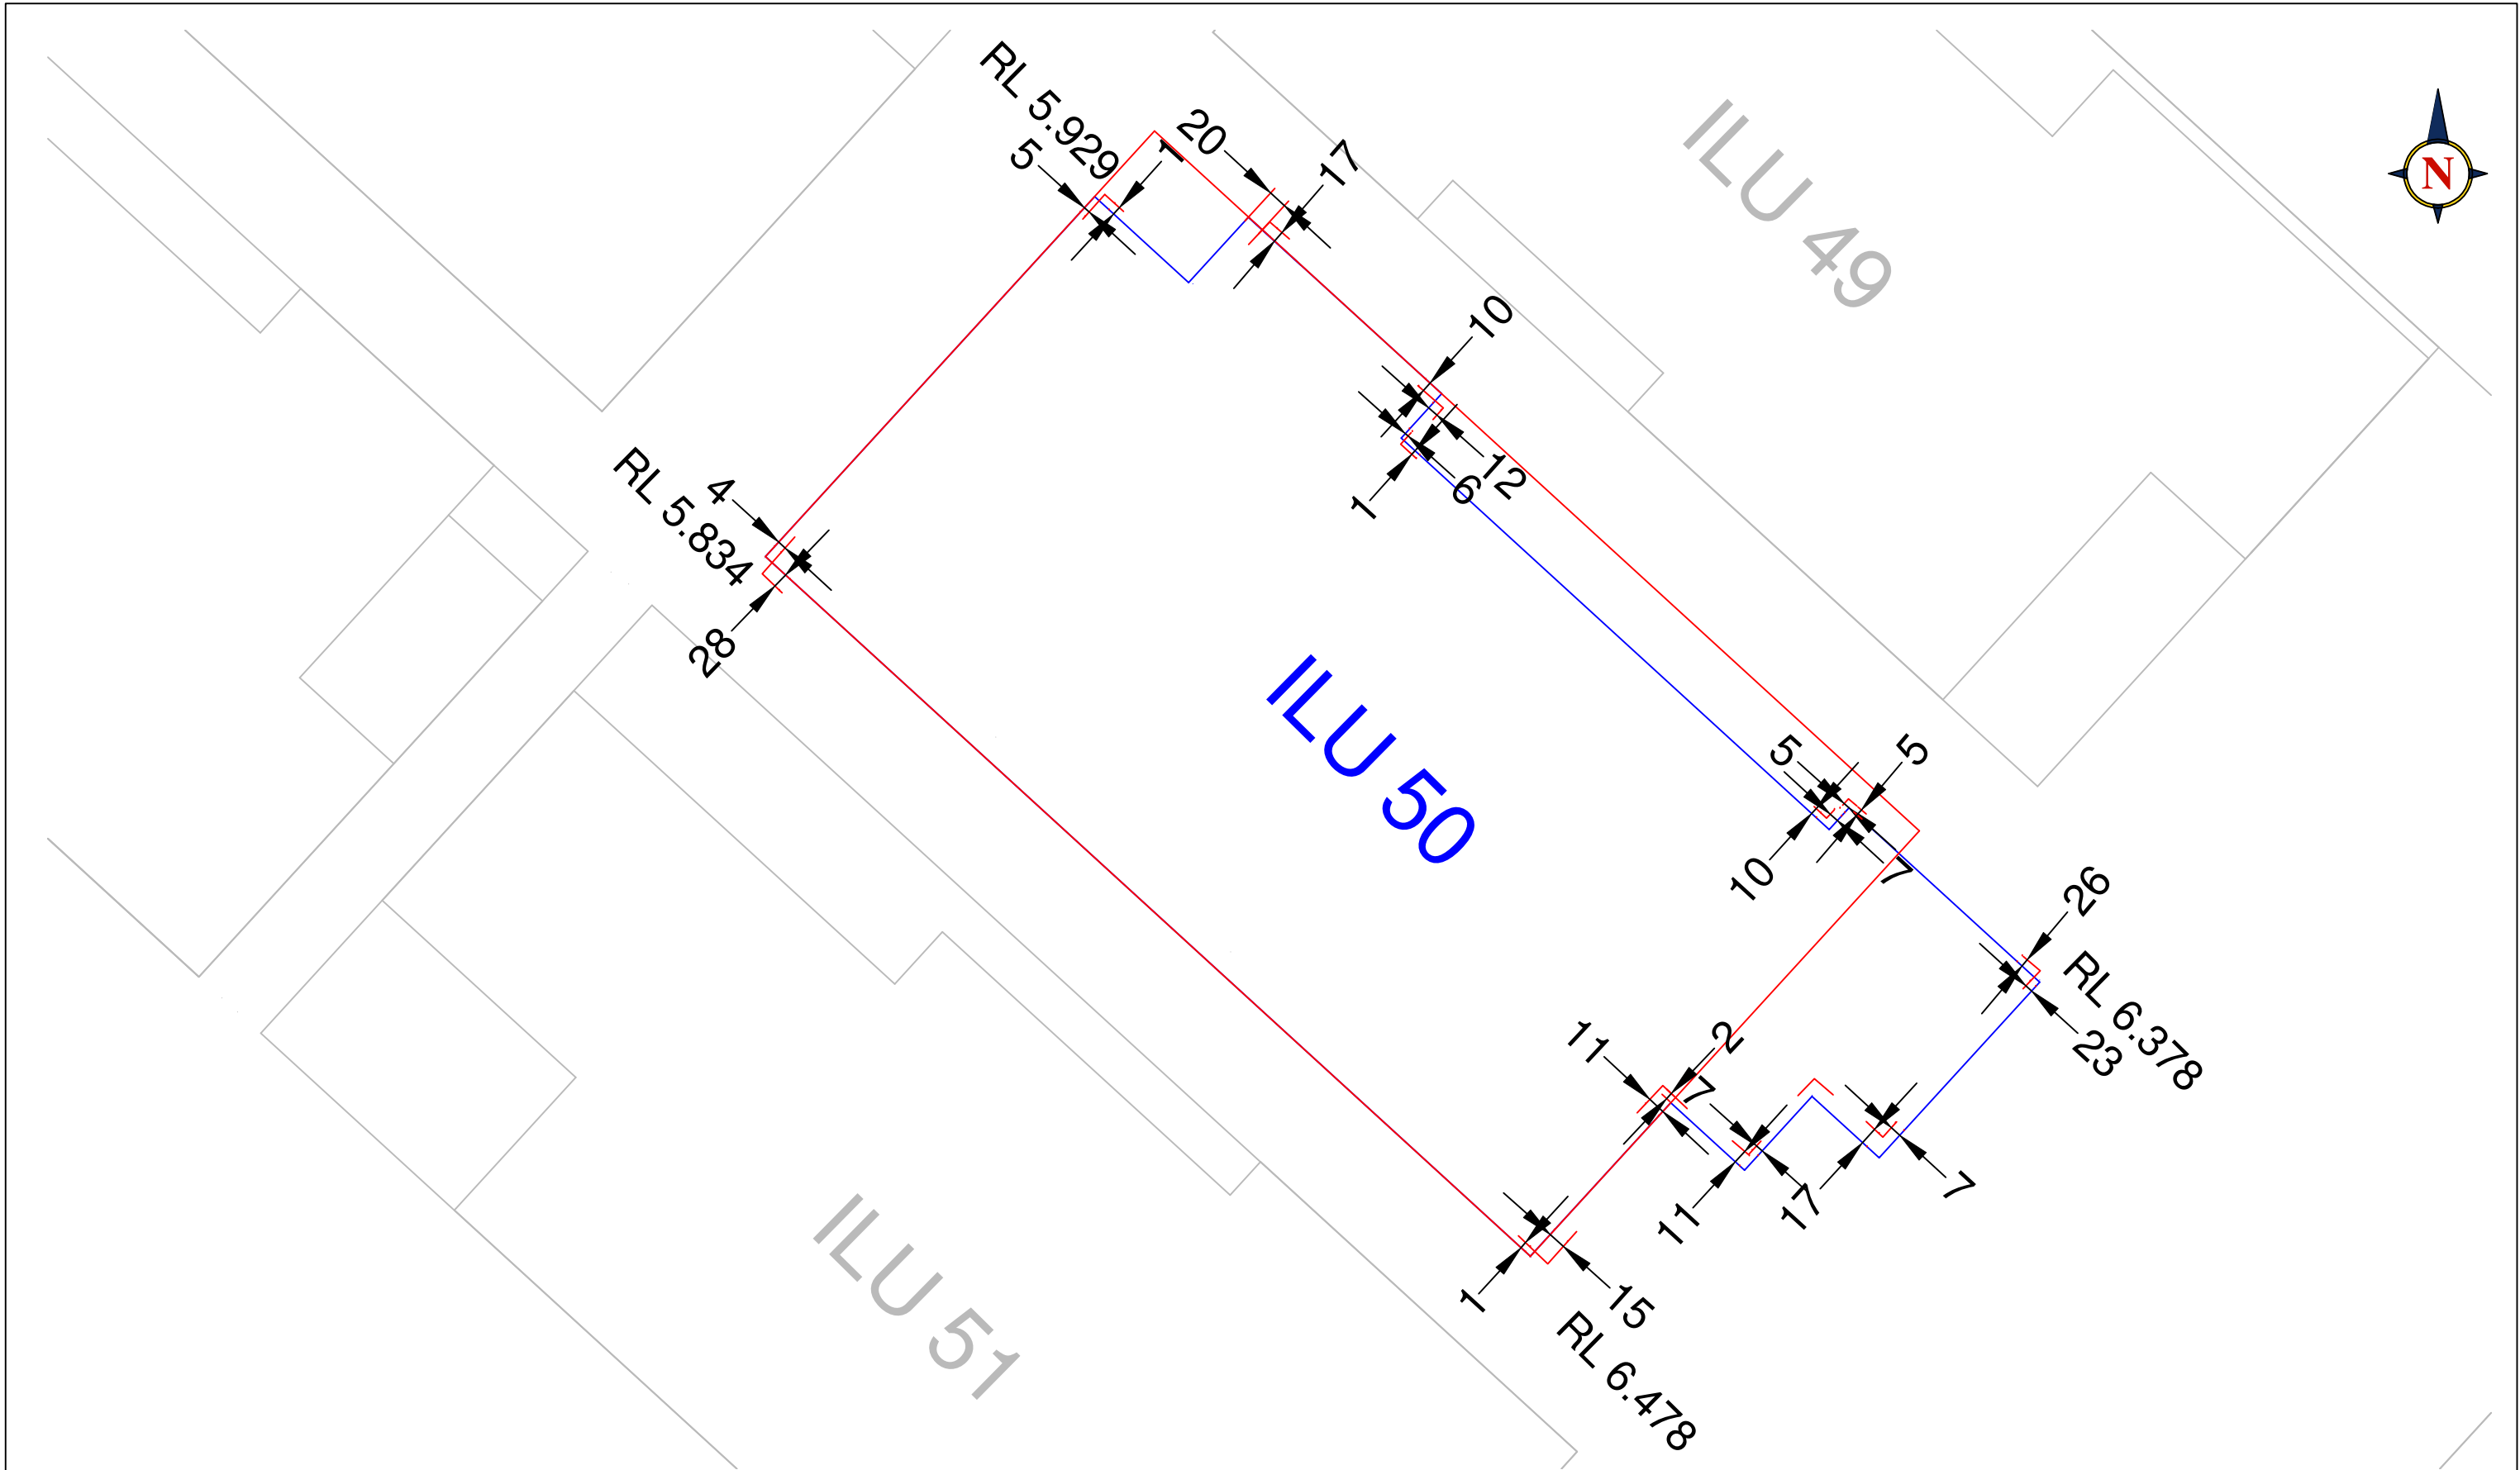


Land Surveys Sydney Office Suite 3, 78 Reserve Road Artarmon NSW 2064 T (02) 8935 9451 F (02) 8935 9401 www.landsurveys.net.au E sydney@landsurveys.net.au SCALE : 1: 100 ORIGINAL SIZE :	0	02/12/15	ISSUED TO CLIENT	SURVEYOR : DB	TITLE: FORM WORK CHECK ILU50	CLIENT: PBS BUILDING	
				SURVEY DATE : 02/12/15			
				DRAWN : DB	PROJECT: WARRIEWOOD ARV	JOB No : 1500259	
				APPROVED : DB			
						DWG No : 065	REV 0
	REVISION	DATE	DESCRIPTION				

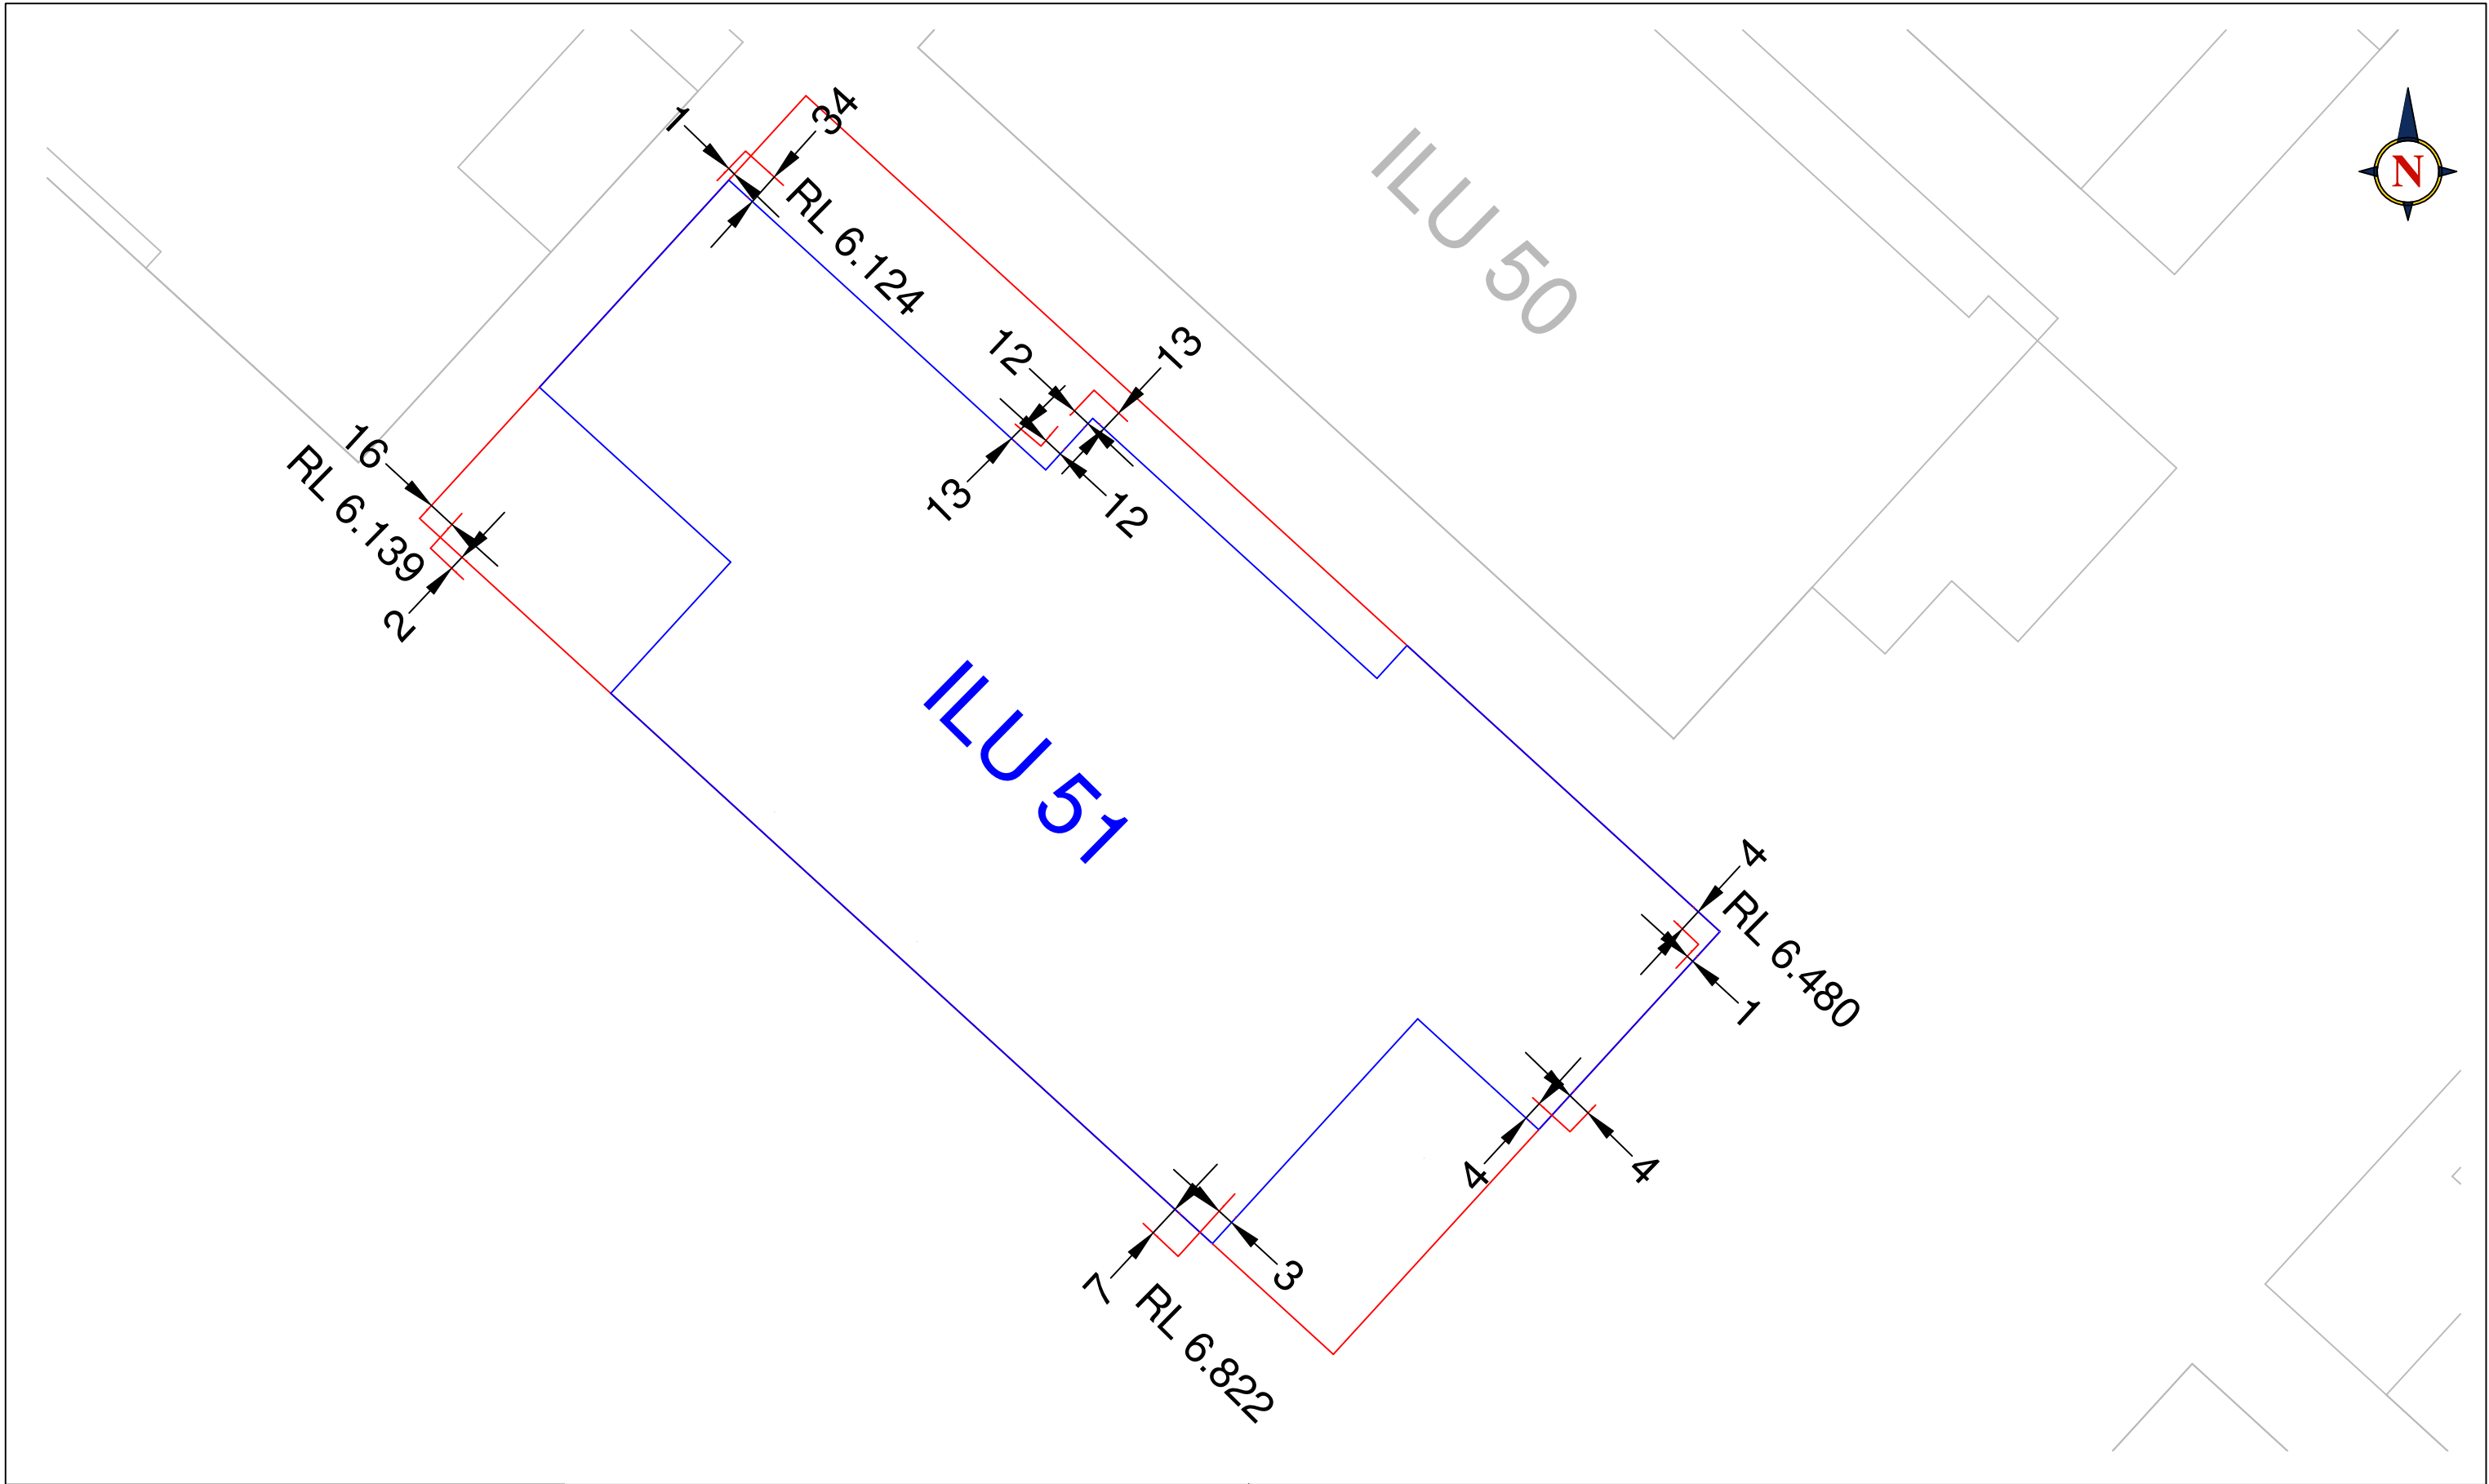


Land Surveys Sydney Office Suite 3, 78 Reserve Road Artarmon NSW 2064 T (02) 8935 9451 F (02) 8935 9401 www.landsurveys.net.au E sydney@landsurveys.net.au SCALE : 1: 100 ORIGINAL SIZE :	0	03/12/15	ISSUED TO CLIENT	SURVEYOR : DB	TITLE: FORM WORK CHECK ILU51	CLIENT: PBS BUILDING	
				SURVEY DATE : 03/12/15			
				DRAWN : DB	PROJECT: WARRIEWOOD ARV	JOB No : 1500259	
				APPROVED : DB			
	REVISION	DATE	DESCRIPTION			DWG No : 066	REV 0

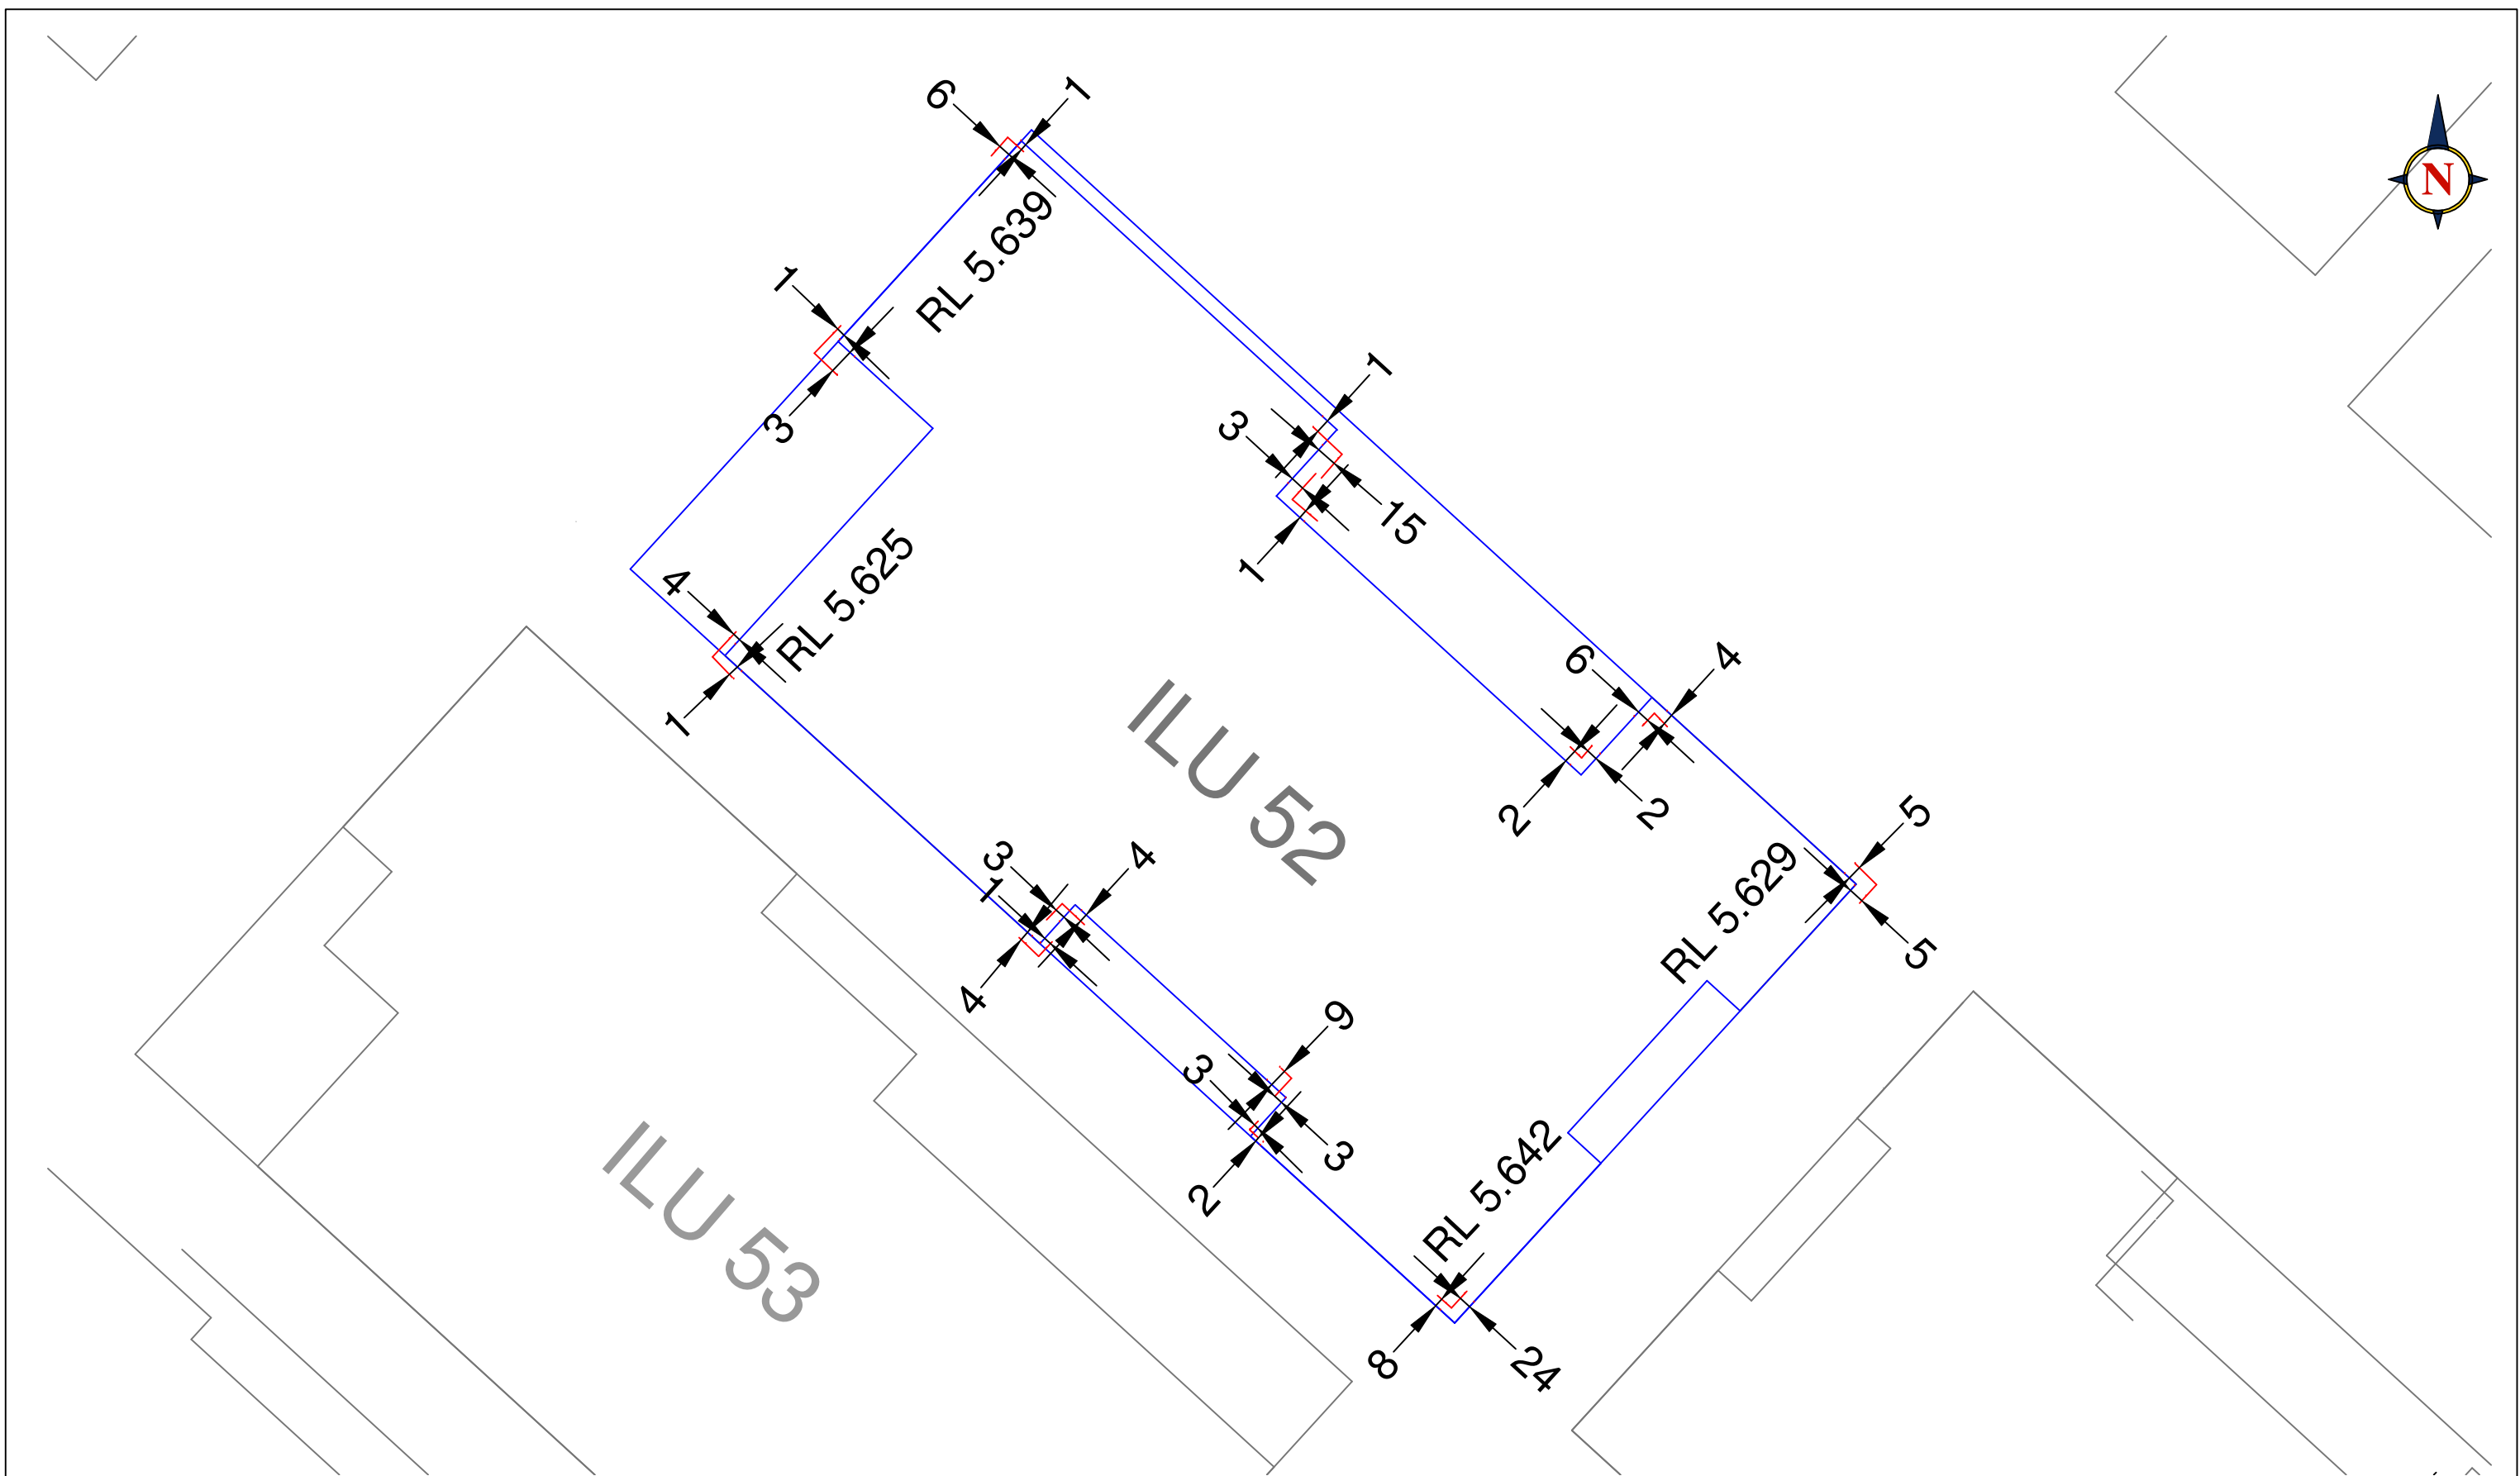

Land Surveys Sydney Office T (02) 8935 9451 F (02) 8935 9401 www.landsurveys.net.au E sydney@landsurveys.net.au Suite 3, 78 Reserve Road Artarmon NSW 2064 SCALE : 1: 100 ORIGINAL SIZE :	0	15/10/15	ISSUED TO CLIENT	SURVEYOR : DB	TITLE: FORM WORK CHECK ILU 52		CLIENT: PBS BUILDING	
				SURVEY DATE : 15/10/15				
				DRAWN : DB	PROJECT: WARRIEWOOD ARV		JOB No : 1500259	
				APPROVED : DB				
						DWG No : 058	REV 0	
	REVISION	DATE	DESCRIPTION					

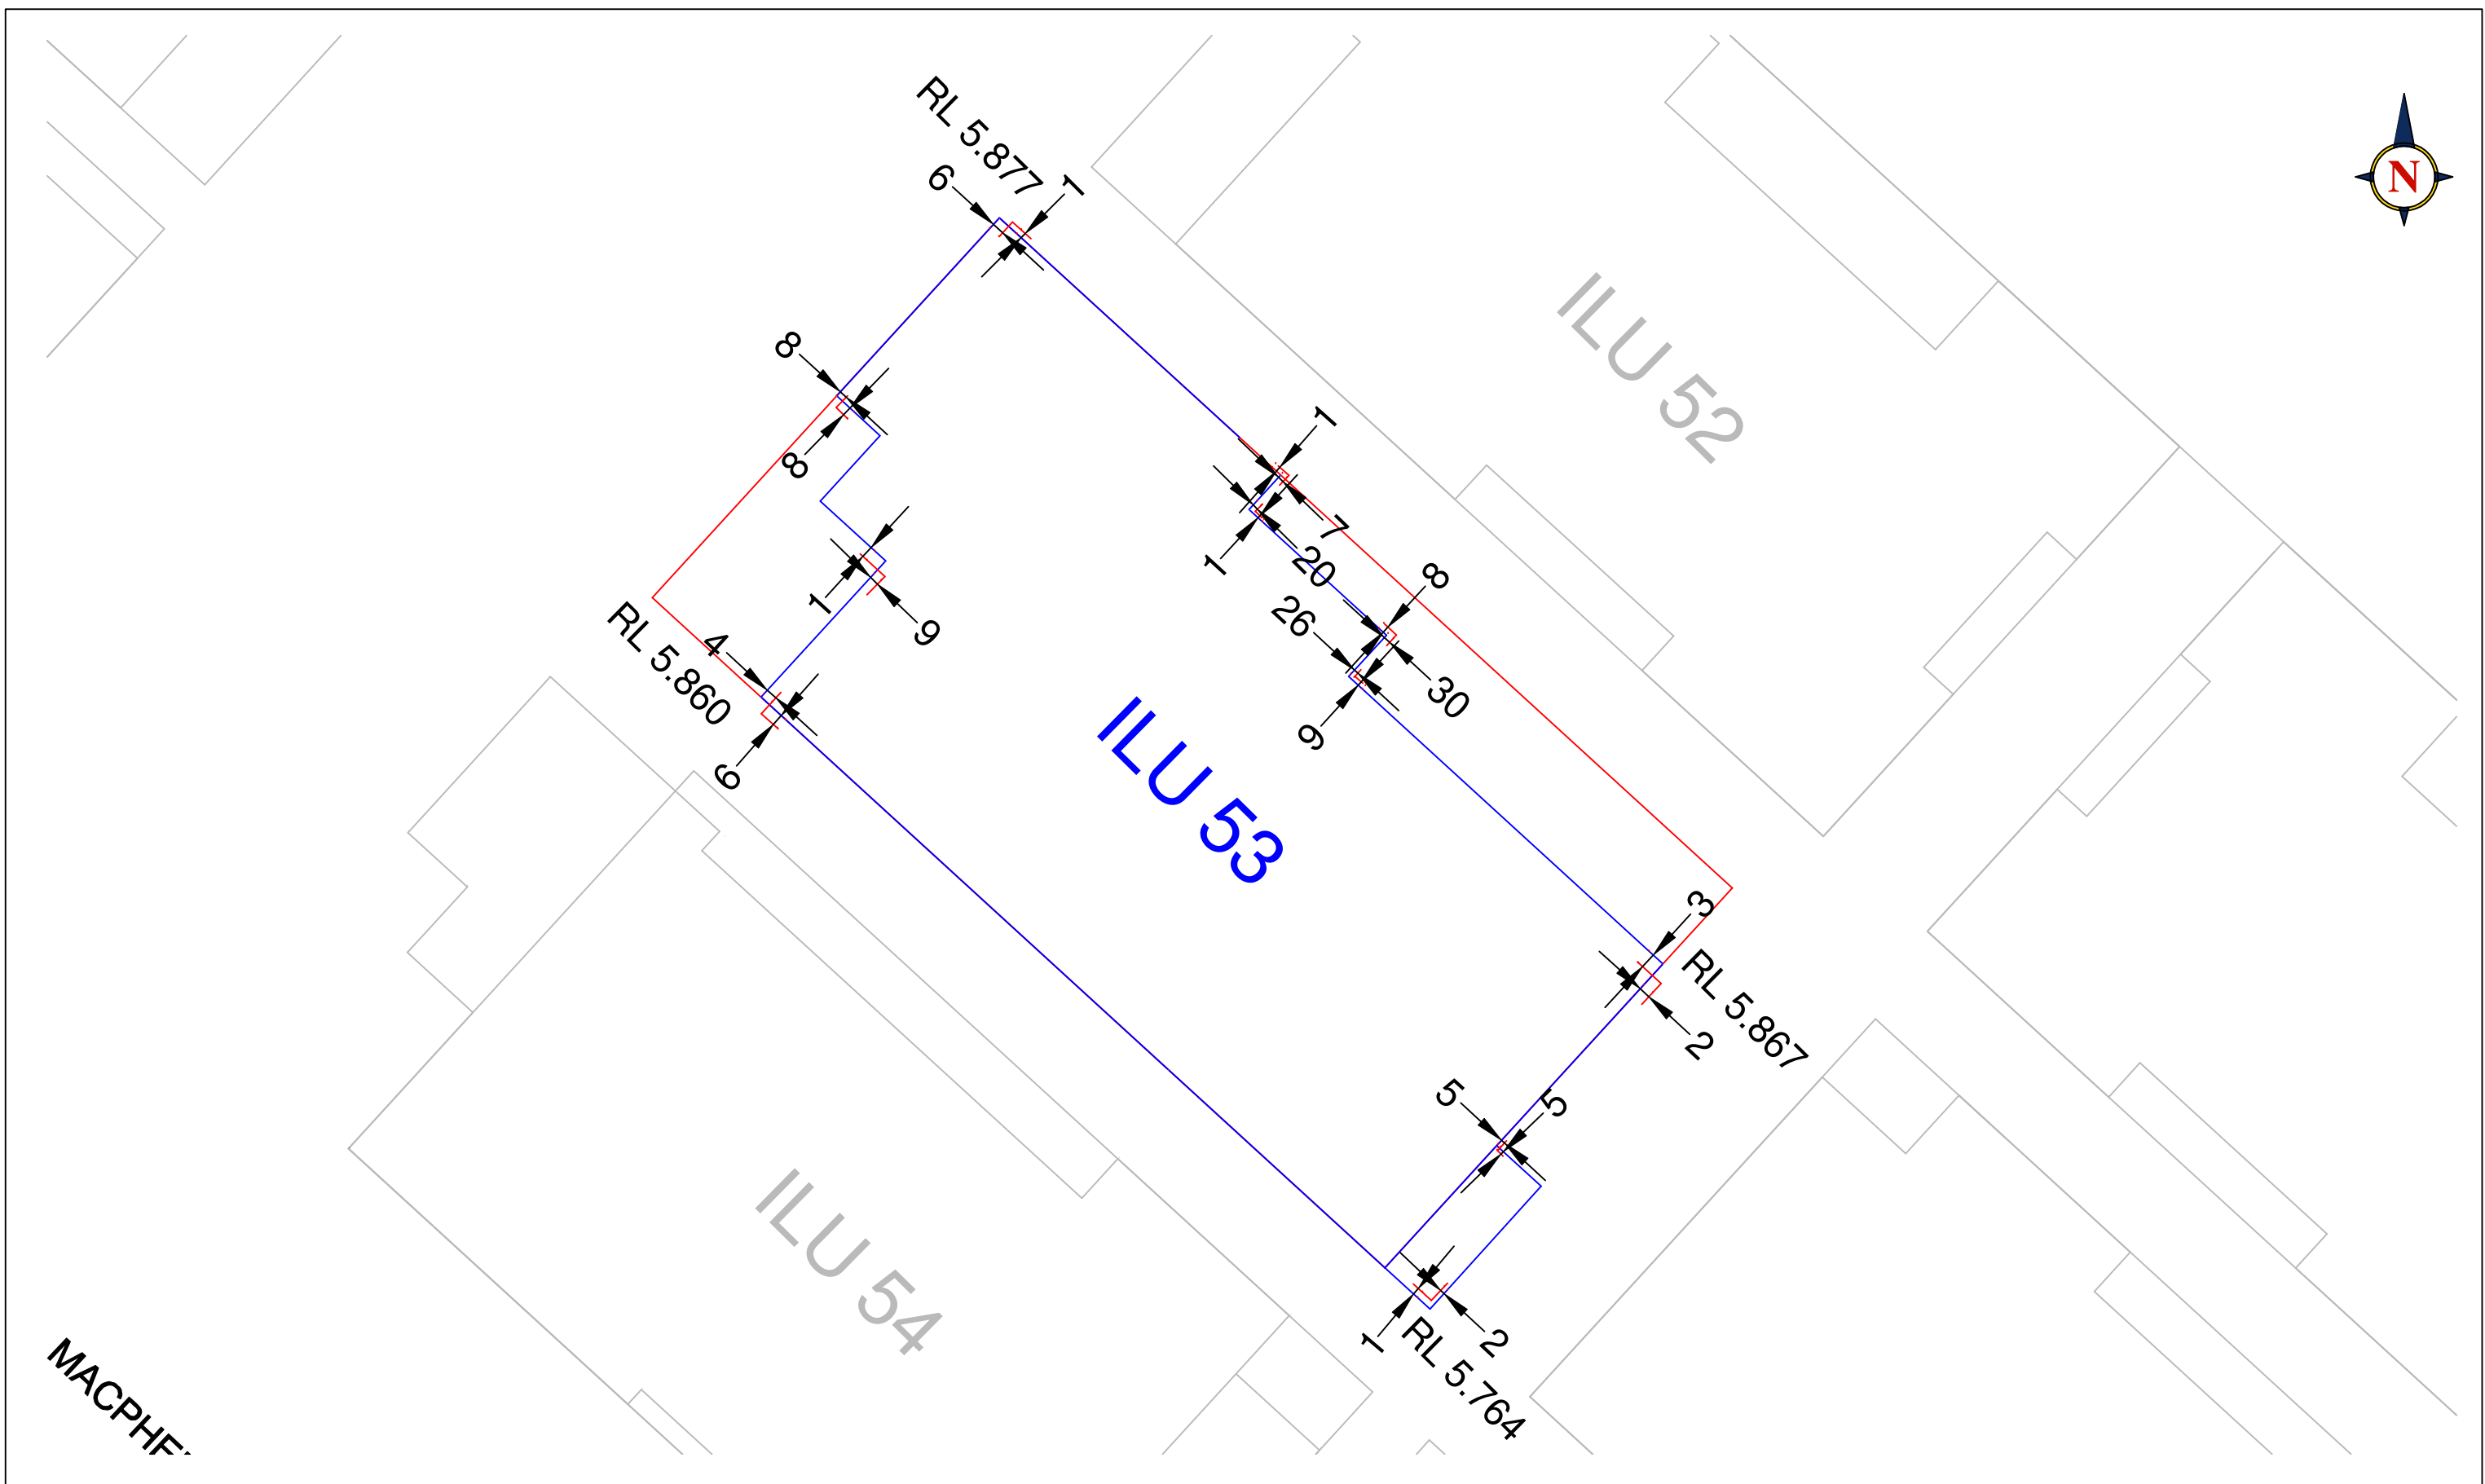

Land Surveys Sydney Office Suite 3, 78 Reserve Road Artarmon NSW 2064 T (02) 8935 9451 F (02) 8935 9401 www.landsurveys.net.au E sydney@landsurveys.net.au SCALE : 1: XXX ORIGINAL SIZE :	0	16/12/15	ISSUED TO CLIENT	SURVEYOR : DB	TITLE: FORM WORK CHECK ILU53	CLIENT: PBS BUILDING		
				SURVEY DATE : 16/12/15				
					DRAWN : DB	PROJECT: WARRIEWOOD ARV	JOB No : 1500259	
					APPROVED : DB			
					PBSBUILDING			
	REVISION	DATE	DESCRIPTION	DWG No : 068 REV 0				

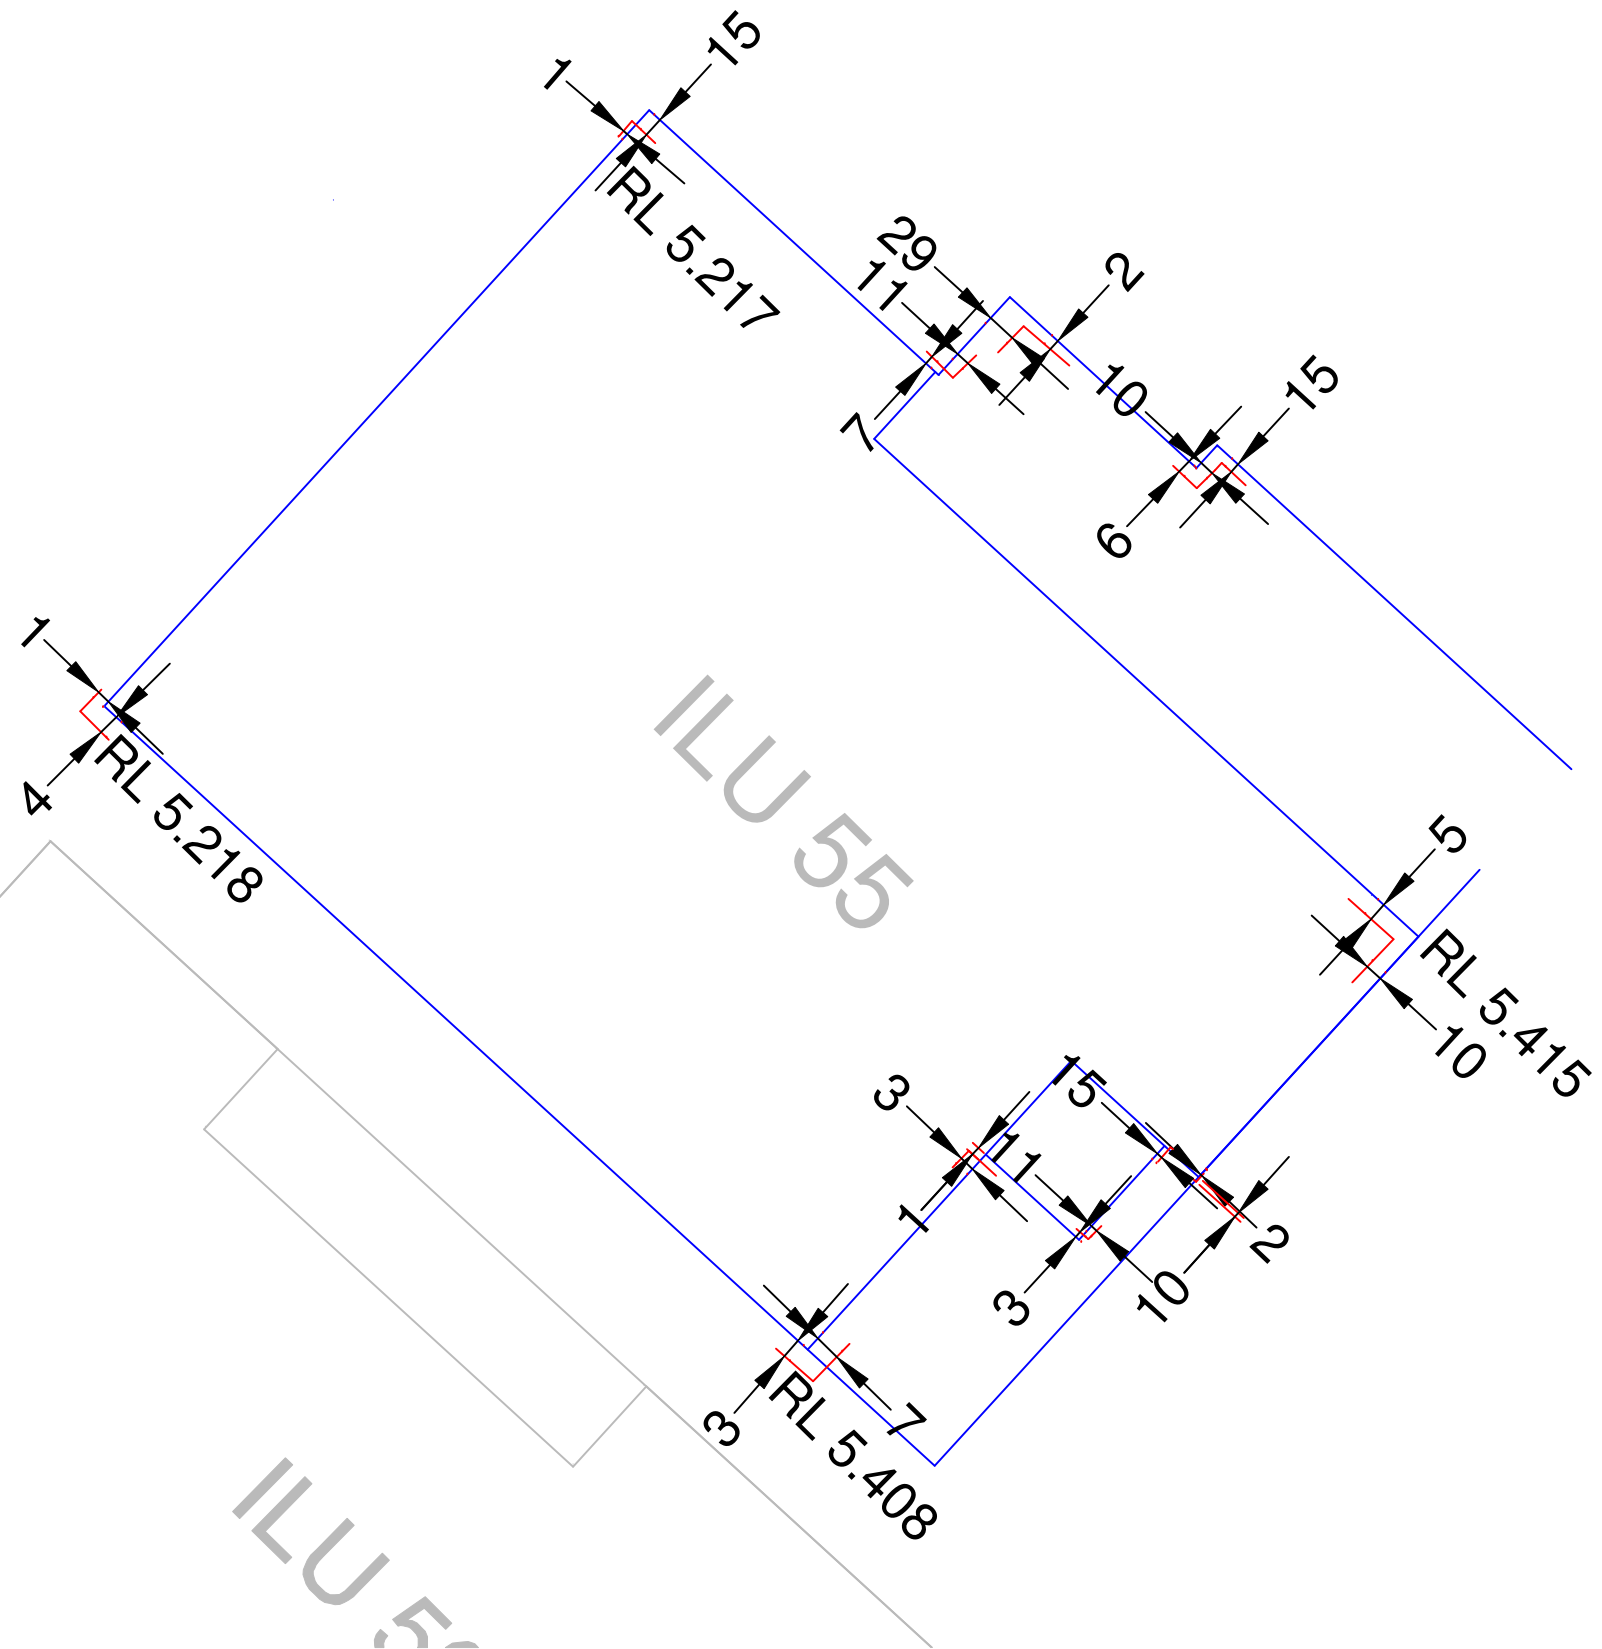


Land Surveys


Sydney Office
Suite 3, 78 Reserve Road
Artarmon NSW 2064
T (02) 8935 9451
F (02) 8935 9401
www.landsurveys.net.au
E sydney@landsurveys.net.au

SCALE :
1: 100
ORIGINAL SIZE :


0	2/2/16	ISSUED TO CLIENT	SURVEYOR : DB	TITLE: FORM WORK CHECK ILU55	CLIENT: PBS BUILDING
			SURVEY DATE : 2/2/16		
			DRAWN : DB	PROJECT: WARRIEWOOD ARV	JOB No : 1500259
			APPROVED : DB		
REVISION	DATE	DESCRIPTION		DWG No : 073	REV 0

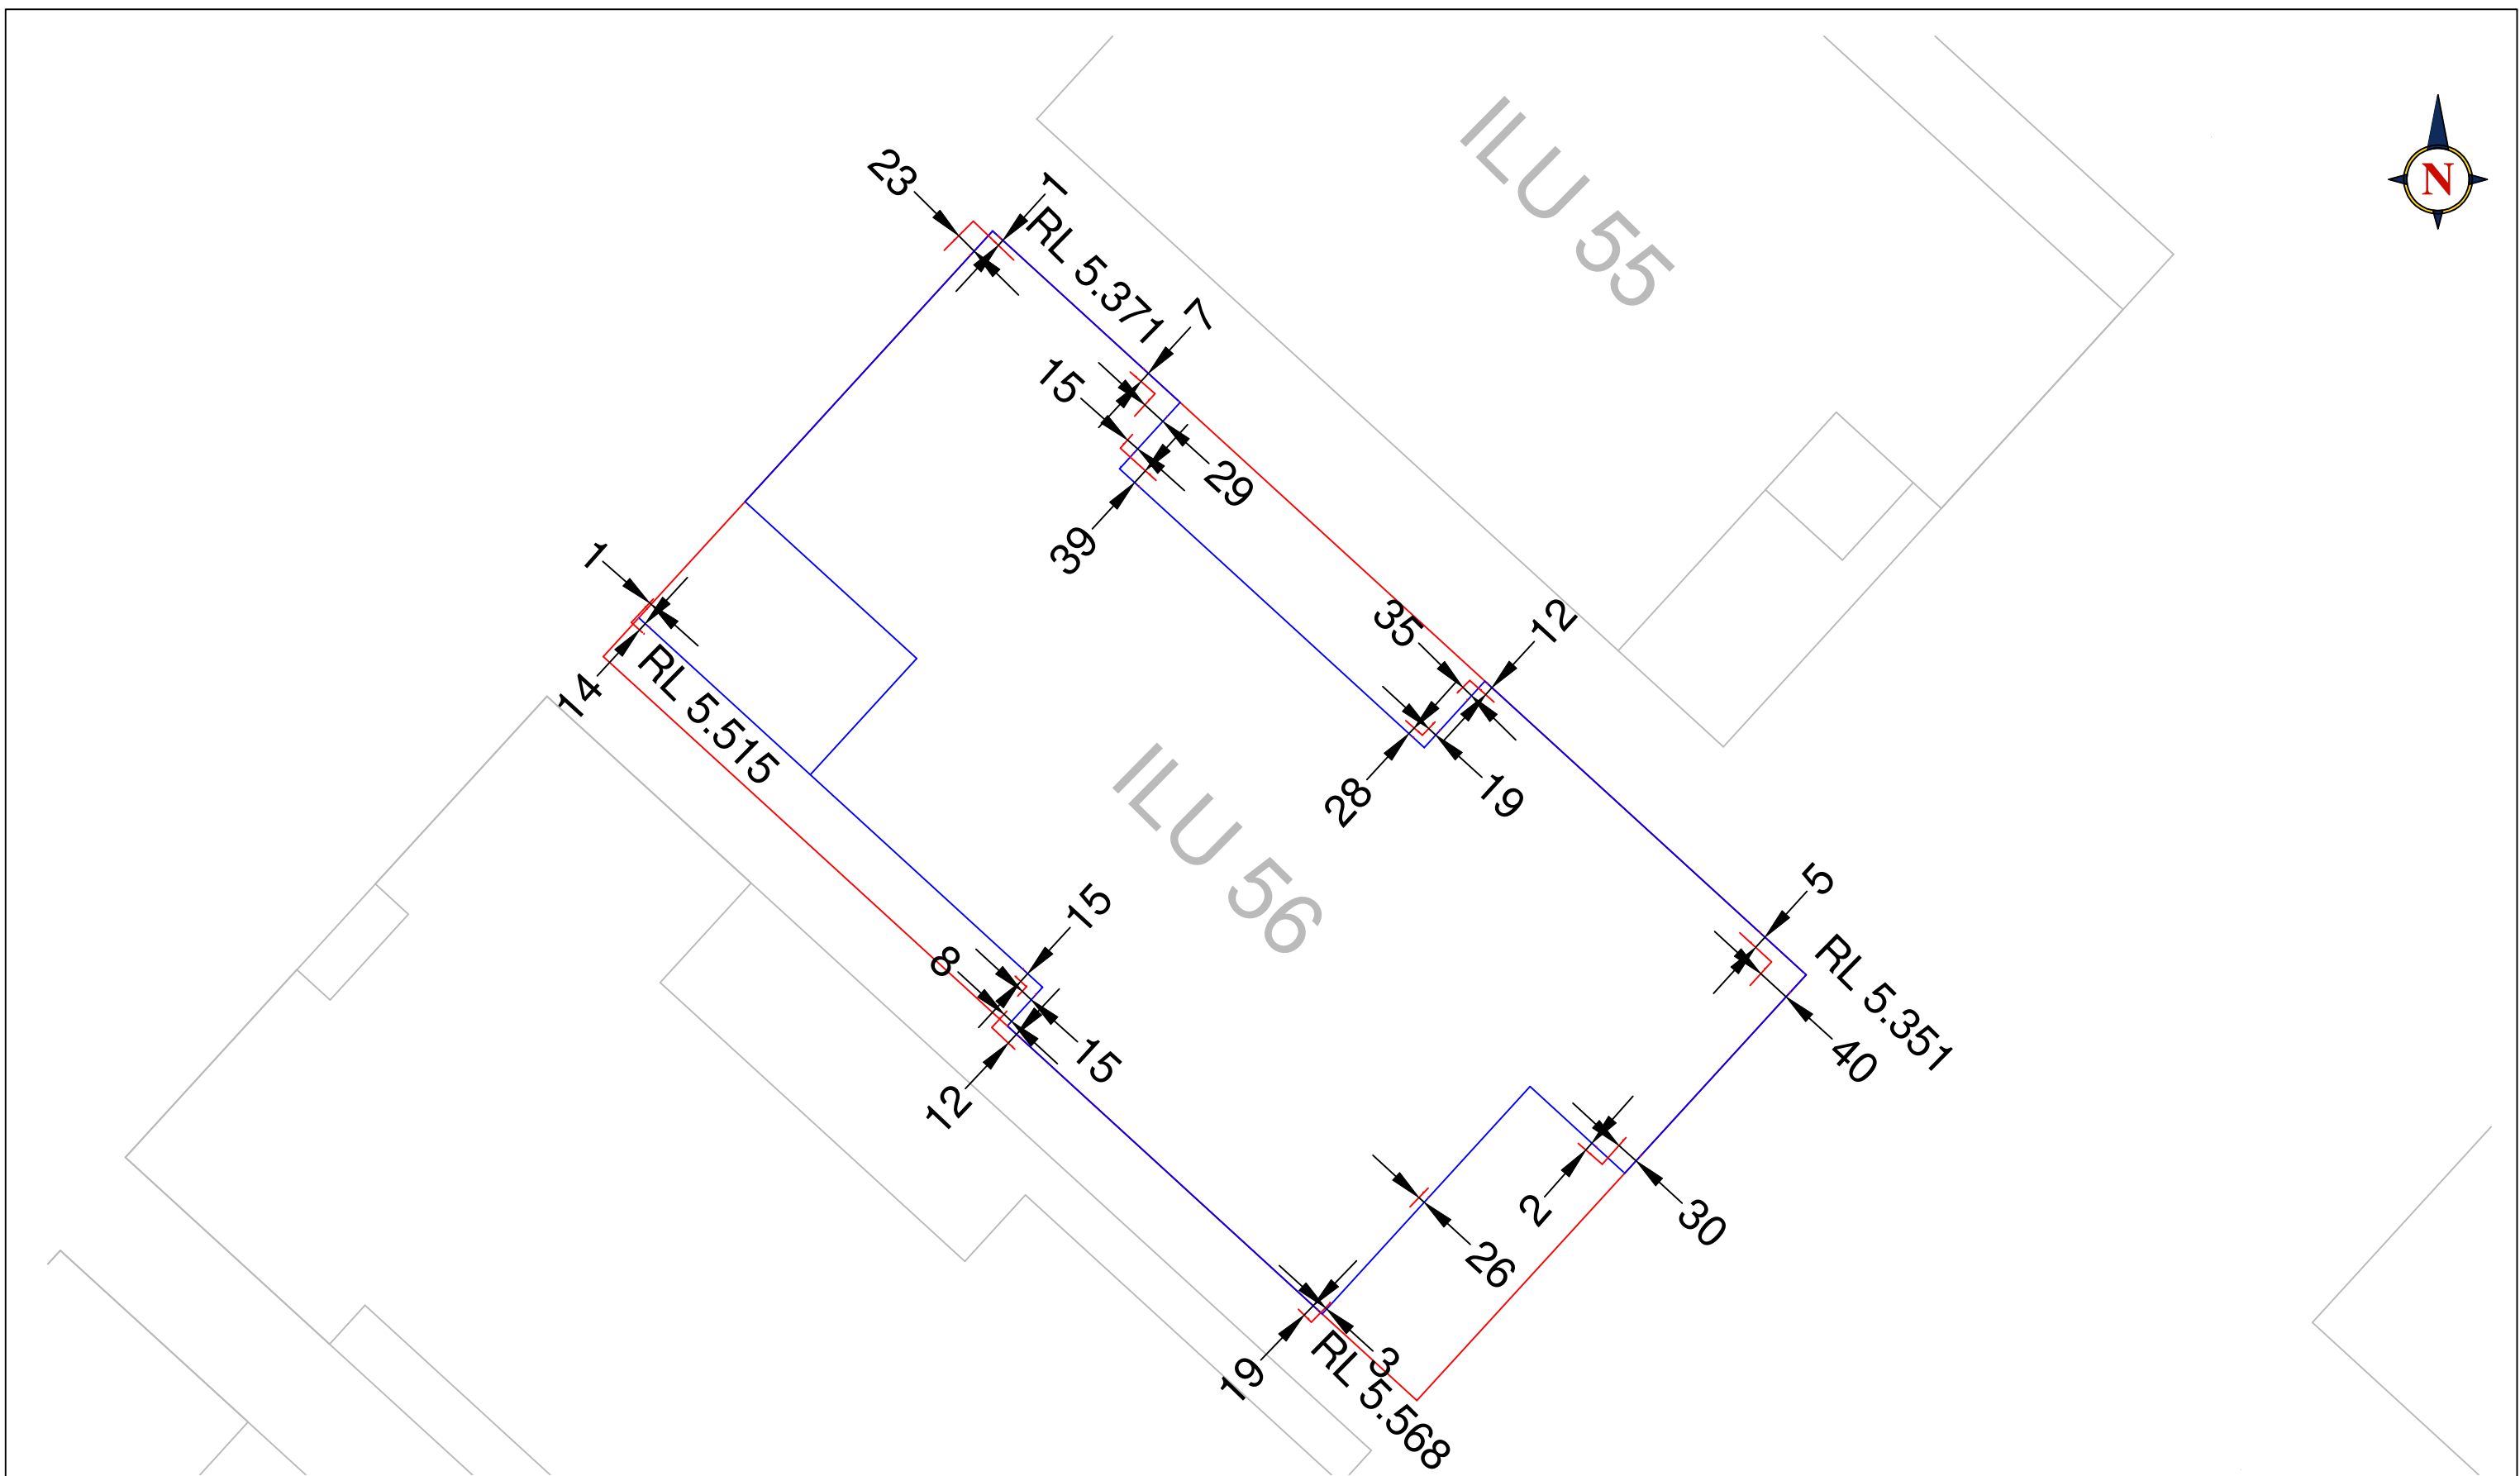


Land Surveys Sydney Office Suite 3, 78 Reserve Road Artarmon NSW 2064 T (02) 8935 9451 F (02) 8935 9401 www.landsurveys.net.au E sydney@landsurveys.net.au SCALE : 1: 100 ORIGINAL SIZE :	0	2/2/16	ISSUED TO CLIENT	SURVEYOR : DB	TITLE: FORM WORK CHECK ILU56	CLIENT: PBS BUILDING	
				SURVEY DATE : 2/2/16			
				DRAWN : DB	PROJECT: WARRIEWOOD ARV	JOB No : 1500259	
				APPROVED : DB			
					DWG No : 072		REV
	REVISION	DATE	DESCRIPTION				0

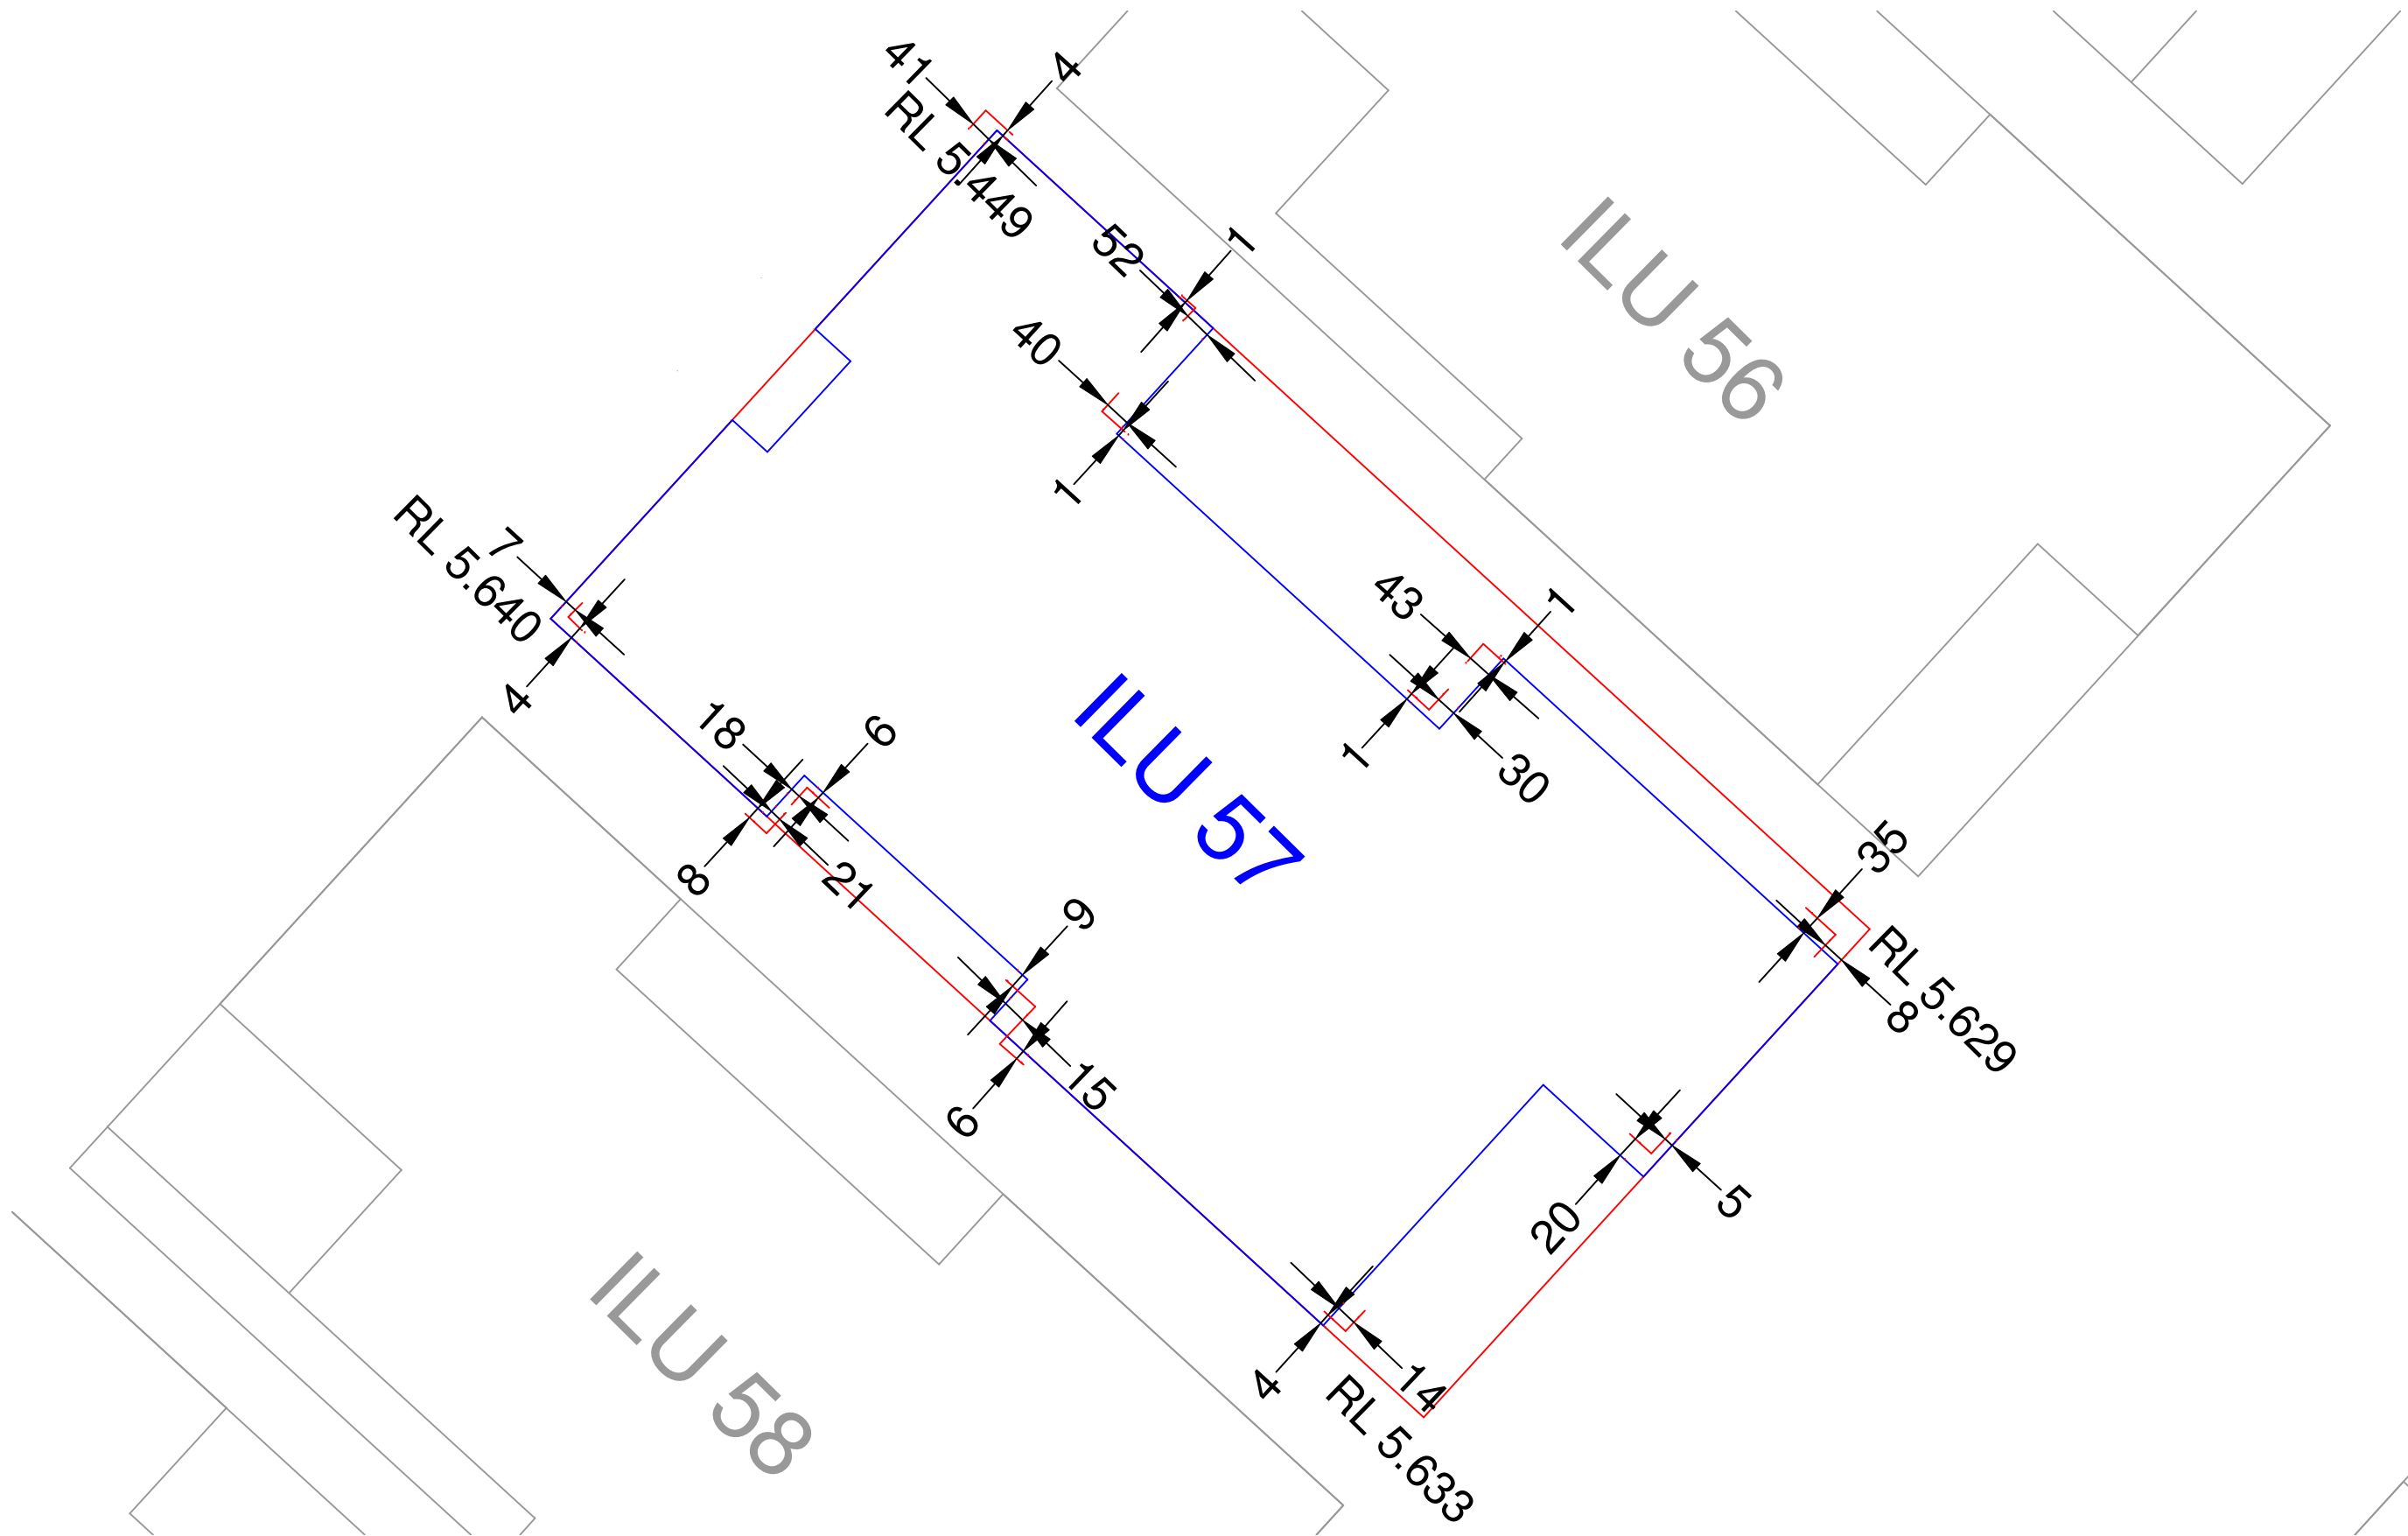

Land Surveys Sydney Office Suite 3, 78 Reserve Road Artarmon NSW 2064 T (02) 8935 9451 F (02) 8935 9401 www.landsurveys.net.au E sydney@landsurveys.net.au SCALE : 1: 100 ORIGINAL SIZE :	0	4/1/16	ISSUED TO CLIENT	SURVEYOR : DB	TITLE: FORM WORK CHECK ILU57	CLIENT: PBS BUILDING	
				SURVEY DATE : 4/1/16			
				DRAWN : DB	PROJECT: WARRIEWOOD ARV	JOB No : 1500259	
				APPROVED : DB			
						DWG No : 069	REV 0
	REVISION	DATE	DESCRIPTION				

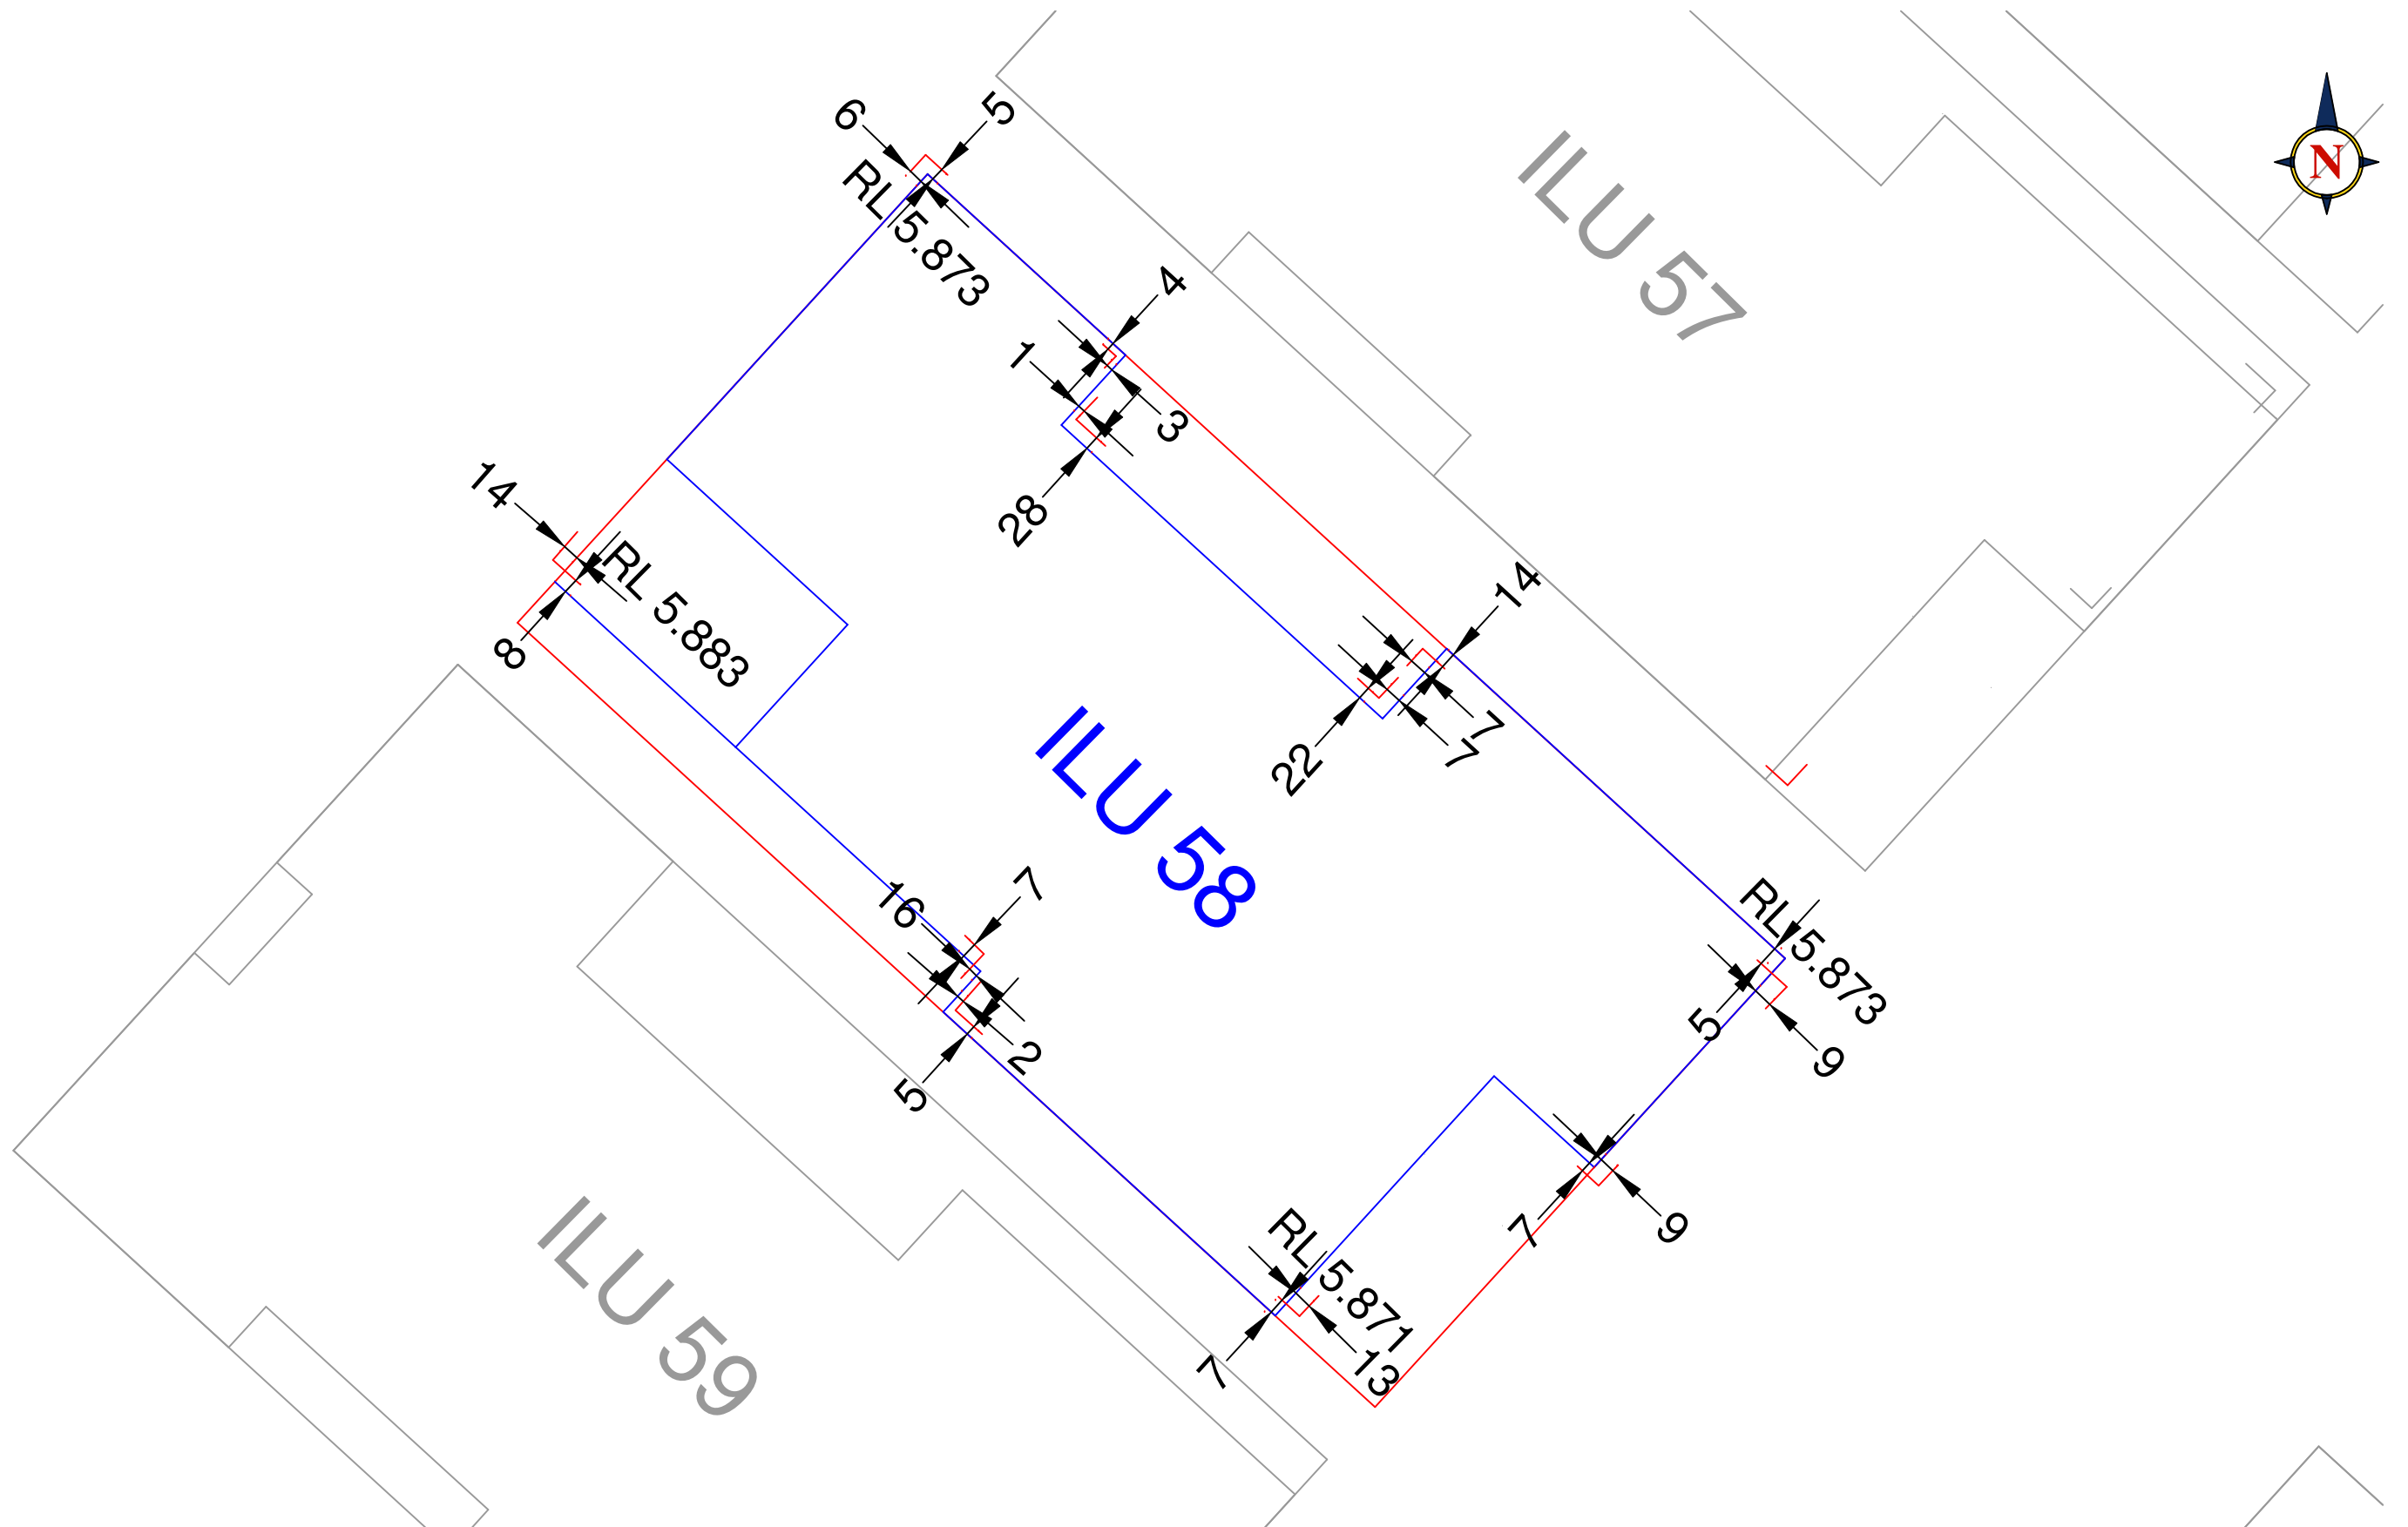

Land Surveys Sydney Office Suite 3, 78 Reserve Road Artarmon NSW 2064 T (02) 8935 9451 F (02) 8935 9401 www.landsurveys.net.au E sydney@landsurveys.net.au SCALE : 1: 100 ORIGINAL SIZE :	0	4/1/16	ISSUED TO CLIENT	SURVEYOR : DB	TITLE: FORM WORK CHECK ILU58	CLIENT: PBS BUILDING	
				SURVEY DATE : 4/1/16			
				DRAWN : DB	PROJECT: WARRIEWOOD ARV	JOB No : 1500259	
				APPROVED : DB			
						DWG No : 070	REV 0
	REVISION	DATE	DESCRIPTION				

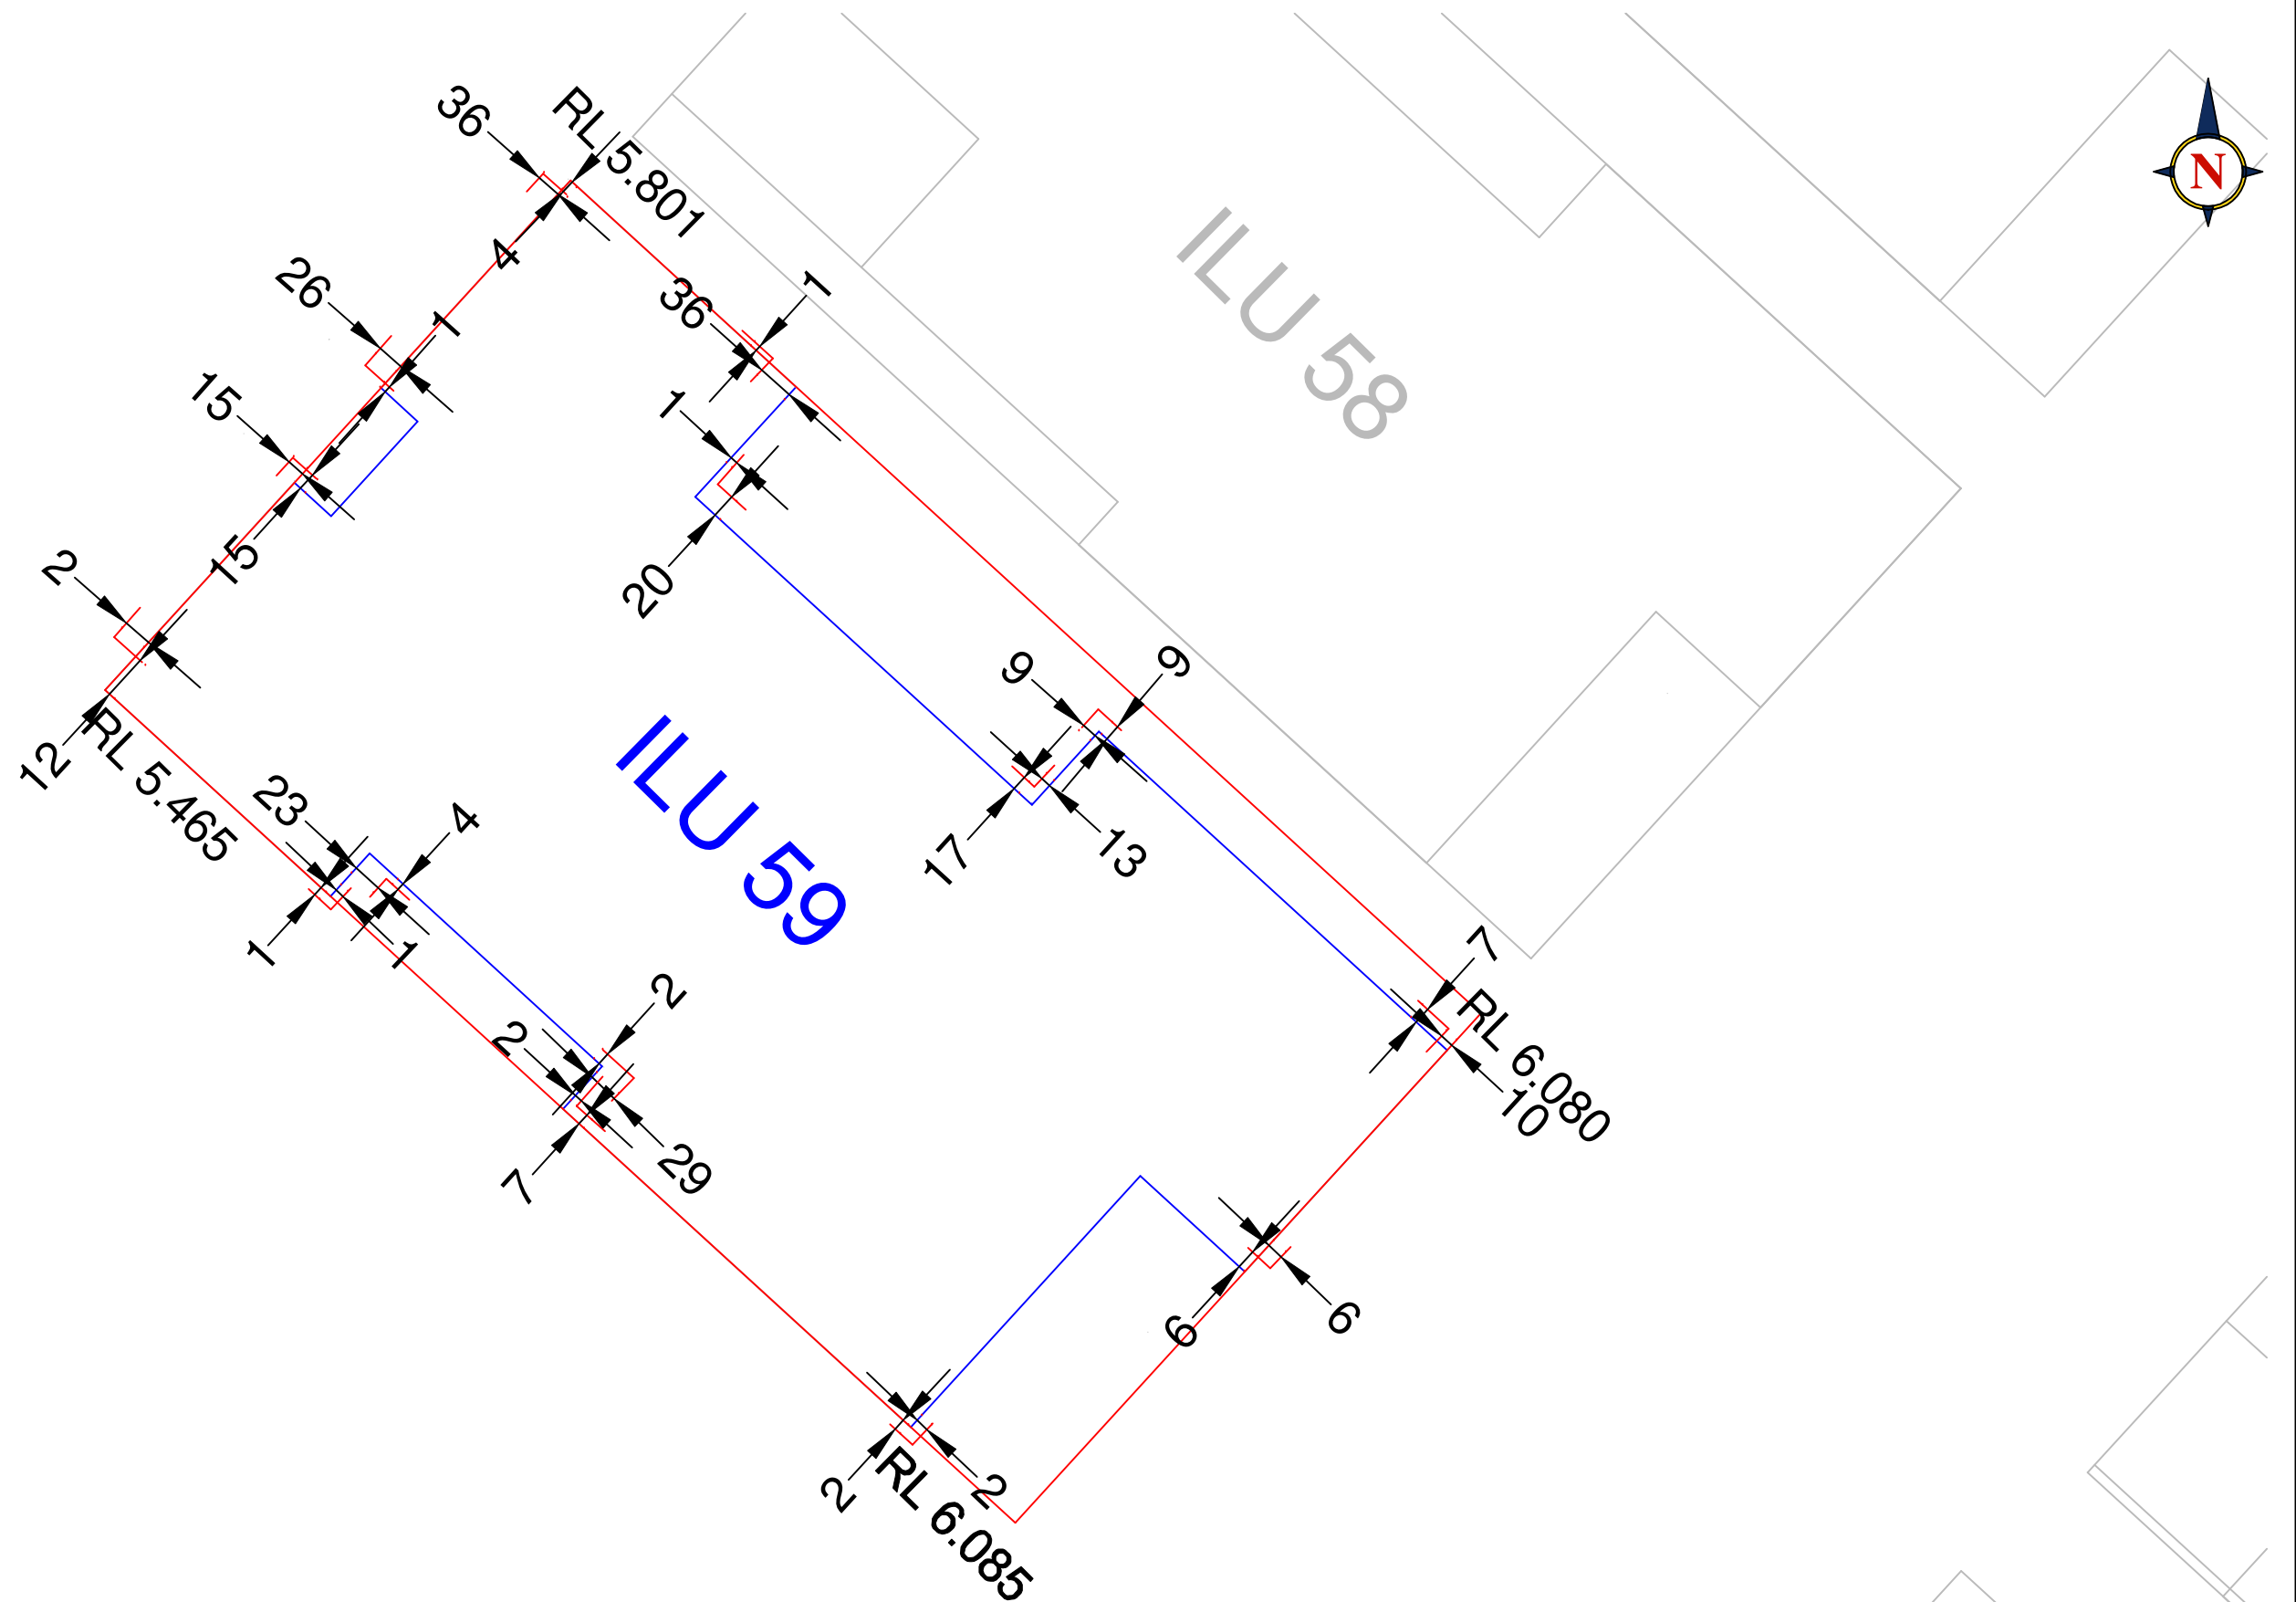

Land Surveys Sydney Office Suite 3, 78 Reserve Road Artarmon NSW 2064 T (02) 8935 9451 F (02) 8935 9401 www.landsurveys.net.au E sydney@landsurveys.net.au	0	25/1/16	ISSUED TO CLIENT	SURVEYOR : DB	TITLE: FORM WORK CHECK ILU59	CLIENT: PBS BUILDING
				SURVEY DATE : 25/1/16		
				DRAWN : DB	PROJECT: WARRIEWOOD ARV	JOB No : 1500259
				APPROVED : DB		
				 PBS BUILDING		
SCALE : 1: 100 ORIGINAL SIZE : 	REVISION	DATE	DESCRIPTION		DWG No : 071	REV 0