

ALTERATIONS and ADDITIONS: to EXISTING DETACHED STYLE SINGLE STOREY RENDERED HOUSE at No.2 NEW STREET EAST BALGOWLAH NSW 2093

SYMBOLS + COLOURS:

OUTLINE OF DEMOLITION.

BOUNDARY LINE - AS SURVEYED

METAL TILE NEW ROOF EXISTING TO REMAIN

DIRECTION OF ROOF FALL

DIRECTION OF STORMWATER

DIRECTION OF SURFACE FALL

ACHIEVED SETBACK DIMENSION

900

YELLOW - TIMBER BASED GREEN - CONCRETE BASED

RED - MASONRY BASED BLUE - METAL BASED

ORANGE - DEMOLITION PINK - GENERAL PAVEMENT

EARTHWORK LIGHT GREEN - PERM. LANDS

THE INFORMATION PROVIDED ON THESE PLANS HAVE BEEN PRODUCED BASED ON THE INFORMATION PROVIDED TO US BY THE CLIENT, and THE CLIENT'S CONSULTANTS.

IT IS THE RESPONSIBILITY OF THE CONTRACTOR TO ADHERE TO AND COMPLY WITH THE BCA, HAVE ALL DIMENSIONS, LEVELS, SEWER AND STORMWATER INVERT LEVELS, UNDERGROUND and OVERHEAD SERVICES, and FLOOR AREAS CHECKED AND VERIFIED. ANY DISCREPANCIES ARE TO BE BROUGHT TO THE ATTENTION OF THE PROJECT SUPERINTENDENT PRIOR TO THE COMMENCEMENT OF ANY BUILDING WORK or FABRICATION OF ITEMS.


LEGEND:	ABOVE FINISHED FLOOR LEVEL	H	HIGH HANDRAIL
AFFL	FLOOR LEVEL	MDR	METAL DECK ROOF
BAL	BOX GUTTER - TO ENGINEER'S DETAILS	MTL	METAL SHEET
BO	BUILDING	OH	OVERHEAD
BSN	BASIN	PAR	PARAPET
BWKF	BRICKWORK - COLOUR/FINISH	PAV	PAVEMENT
		PP	PAINT FINISH
COL	COLUMN	R	POWER POLE
COMC	CONCRETE	RR	ROOF RIDGE
COS	CONFIRM ON SITE	RL	RELATIVE LEVEL
CPT	CARPET	RT	ROOF TILE
CP	DOWNPIPE	RVO	RAINWATER OUTLET
DR	DRYER	SHR	SHOWER
EX	EXISTING	TD	TIMBER DECK
FB	FACE BRICK	TF	TIMBER FLOOR
FCB	FIBRE CEMENT SHEETING TYPE	TFAS	TOP OF FASCIA
FCL	FINISHED CEILING	TG	TOP OF GUTTER
FFL	FINISHED FLOOR	TILE	TILED FLOORING
FLUE	FIRE PLACE FLUE	TYP	TYPICAL
FP	INTERNAL GLASS-TO-BASIX REQUIREMENTS	WC	WATER CLOSET
QL		WIN	WINDOW
		WM	WASHING MACHINE
		VNTY	VANITY

2 NEW STREET EAST, BALGOWLAH 2093

ALTERATIONS and ADDITIONS:

Works Include:

- Ground Floor Addition; New First Floor Addition; Internal and External Modifications; Rectifications and Improvements; and Landscape Concept

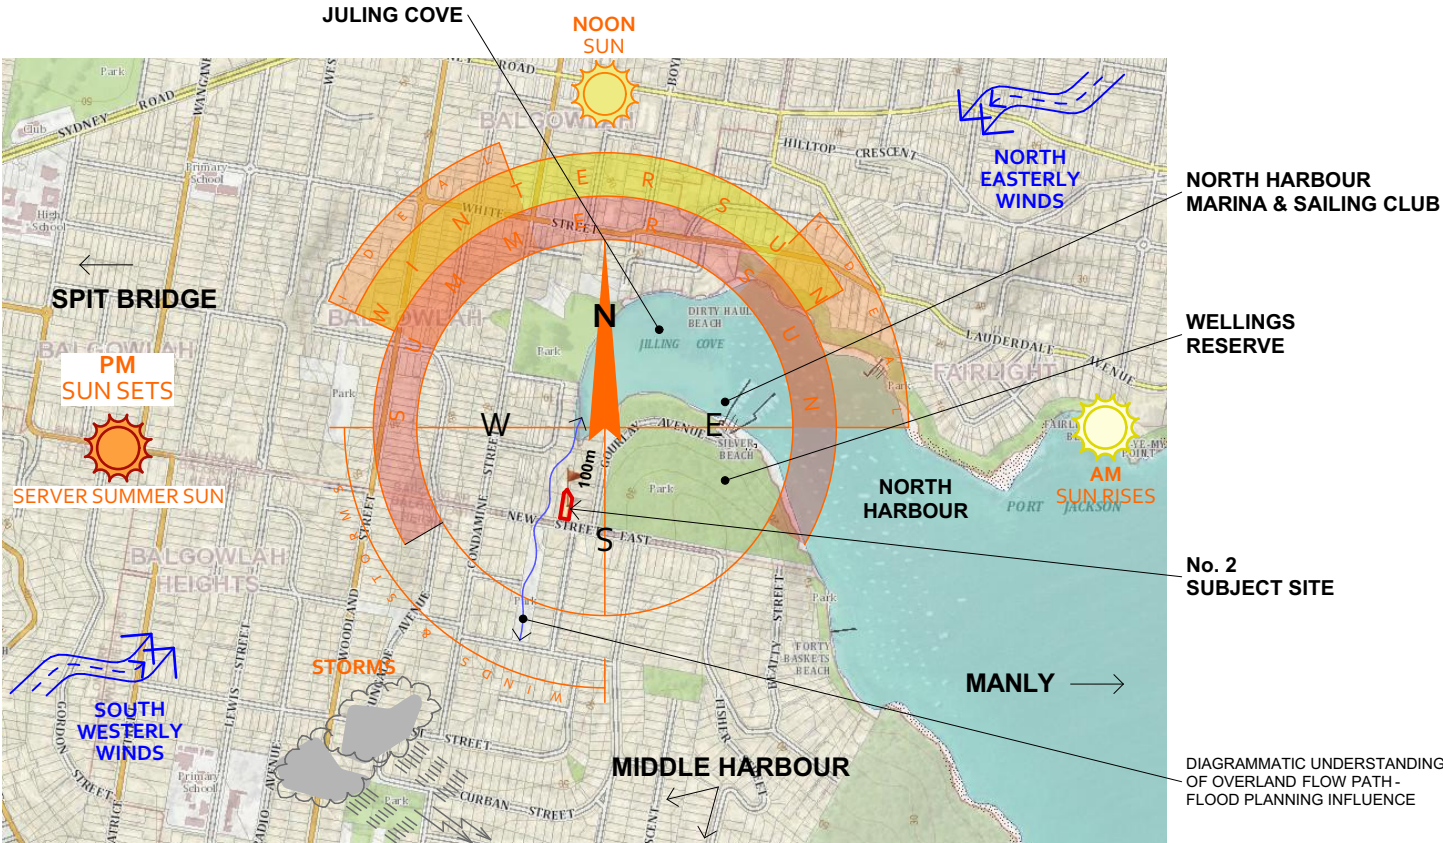

1. LOCATION & ANALYSIS PLAN (North Point ORIENTATED TO SIX MAPS)

SITE AREA: 550.1m²
SITE WIDTH: 12.19m

PLANNING: MANLY LEP & DCP 2013

- Land Zoning: R2 - Low Density Residential
- FSR: 0.45:1 (247.5m²)
- Site Coverage: Open Space requirement. Max SC. 247.55m²
- Height of Building: 8.5m
- Heritage: Not an Item; Not within a Heritage Conservation Area, and is not a Contributory Item.
- Bushfire Prone Land: Yes is within Bushfire Prone Land
- Flood Risk: Low and Medium Risk
- No. of storeys: Max. 2
- Building Envelope: no less than 1/3 of proposed height
- Landscape ratio: Open Space Area 3 (OS3): 55% = 302.55m², 35% of that to be Landscaped (with 25% max. above ground-balcony or the like). 3m min. dimension, 1m spoil depth and at least a 12sqm clear space.
- Front setback: Prevailing Setback - neighbouring carport
- Side setback: 1/3 of wall height
- Rear setback: 8m
- Private Open Space: 18m², rear and level to building.
- Foreshore Building Line / Scenic Protection: Yes
- Acid Sulfate Soils: Class 5
- Geotechnical Hazard: Not in Landslip Risk
- Biodiversity: N/A
- Pool: N/A - Existing Pool - no new work
- Secondary Dwelling: N/A




4. REAR VIEW OF EXISTING BUILDING




3. AERIAL VIEW - sourced from SIX MAPS



2. STREETVIEW - BUILDING TO BE RETAINED

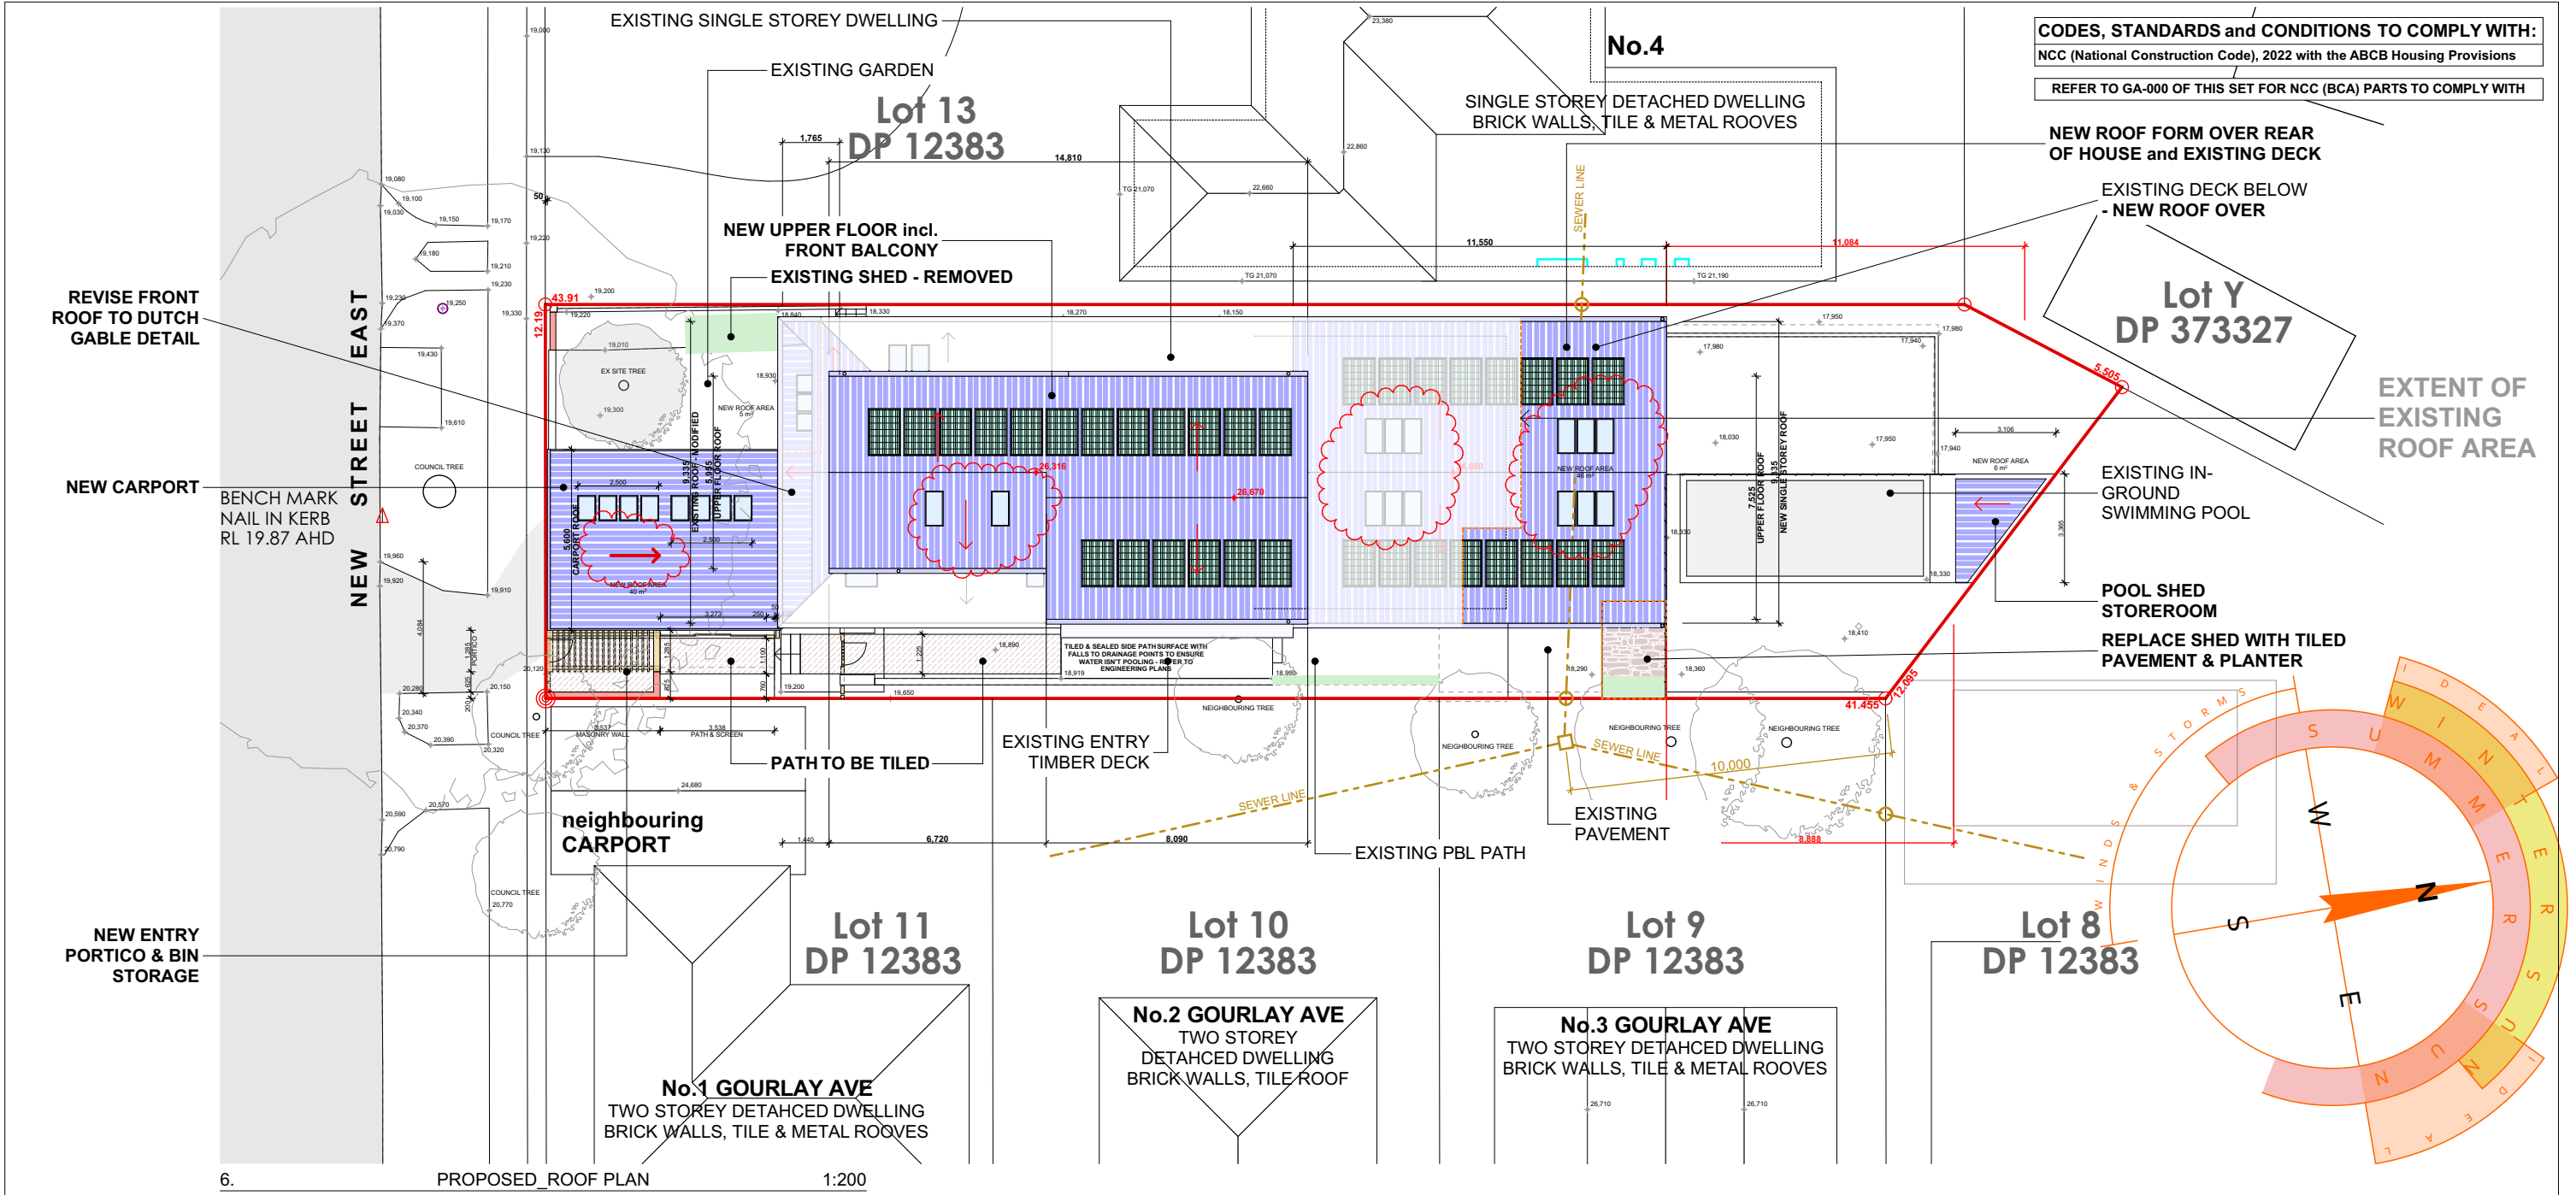

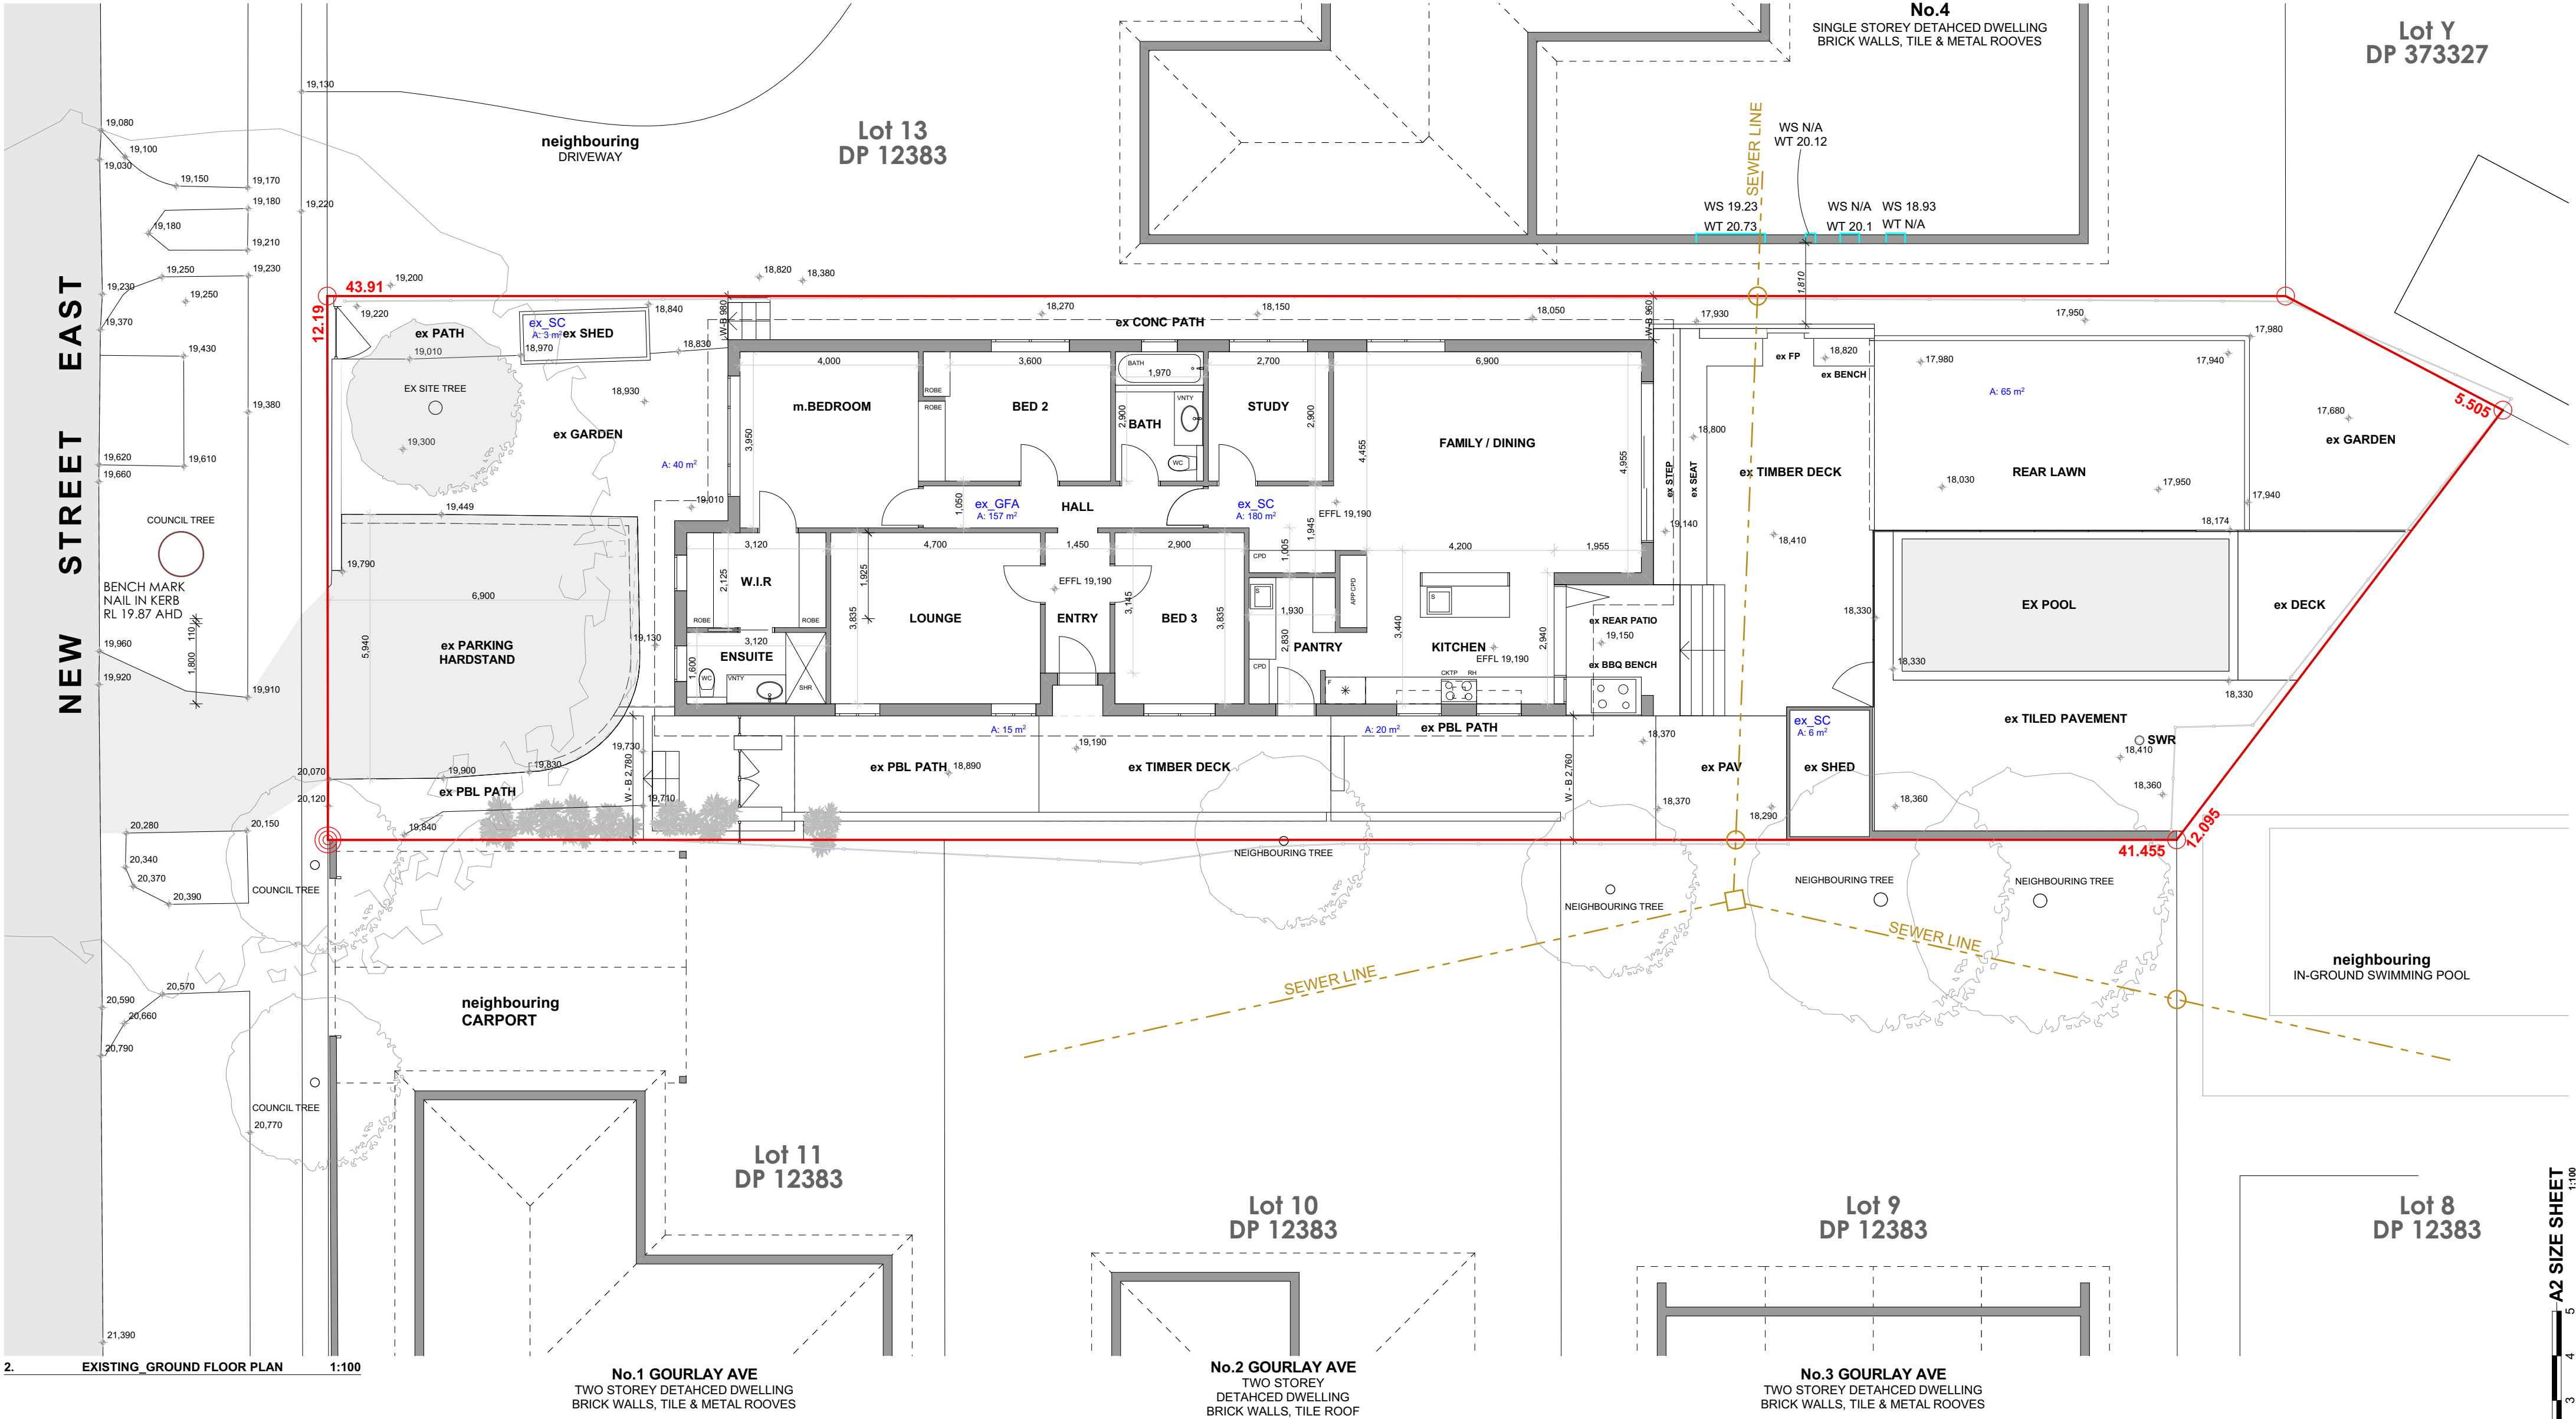

2. EXISTING_GROUND FLOOR PLAN 1:100

No.1 GOURLAY AVE
TWO STOREY DETACHED DWELLING
BRICK WALLS, TILE & METAL ROOVES

No.2 GOURLAY AVE
TWO STOREY
DETACHED DWELLING
BRICK WALLS, TILE ROOF

No.3 GOURLAY AVE
TWO STOREY DETACHED DWELLING
BRICK WALLS, TILE & METAL ROOVES

Lot 8
DP 12383

Lot 9
DP 12383


Lot 10
DP 12383

Lot 11
DP 12383

Lot 13
DP 12383

Lot Y
DP 373327

INTERNAL MEASUREMENTS HAVE NOT HAD A FINAL CHECK. ALL DIMENSIONS TO BE CONFIRMED ON SITE. ANY MAJOR DISCREPANCY IS TO BE ADVISED BEFORE ANY CONSTRUCTION WORK / FABRICATION IS UNDERTAKEN

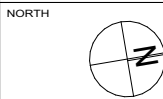

LOT & DP
LOT 12; DP 12383
COUNCIL
NORTHERN BEACHES COUNCIL
MANLY

PROJECT
ALTERATIONS and ADDITIONS:
- Ground Floor Addition; New First Floor Addition; Internal and External Modifications;
Rectifications and Improvements; and Landscape Concept
2 NEW STREET EAST, BALGOWLAH NSW, 2093

CLIENT
M & N DeGARIS

A2 SIZE SHEET 1:100


HARGROVES DESIGN CONSULTANTS				M: 0410 669 148 E: jacqui@hargroves.com.au	
DATE	DEC 2021	TITLE	EXISTING GROUND FLOOR PLAN	Sheet No	GA-101
SCALE	AS NOTED	BY	R.P.	Issue	S
DRAWN	R.P.				

GENERAL NOTES
1. ALL DIMENSIONS, LEVELS, SEWER AND STORMWATER INVERT LEVELS AND FLOOR AREAS ARE TO BE CHECKED AND VERIFIED. ANY DISCREPANCIES ARE TO BE BROUGHT TO THE ATTENTION OF THE DESIGNER PRIOR TO THE COMMENCEMENT OF ANY BUILDING WORK.
2. DO NOT SCALE OFF DRAWINGS.

GENERAL ARRANGEMENT
- FOR CONSTRUCTION

3. ALL BUILDING WORK IS TO BE DONE IN ACCORDANCE WITH THE MOST CURRENT EDITION or AS APPROVED EDITION OF THE BCA (NATIONAL CONSTRUCTION CODE), THE AUSTRALIAN STANDARDS and CONDITIONS OF CONSENT.
4. THE INFORMATION PROVIDED ON THESE PLANS HAVE BEEN PRODUCED BASED ON THE INFORMATION PROVIDED TO US BY THE CLIENT, and THE CLIENT'S CONSULTANTS.
5. IT IS THE RESPONSIBILITY OF THE CONTRACTOR TO HAVE ALL DIMENSIONS, LEVELS, SEWER AND STORMWATER INVERT LEVELS, UNDERGROUND and OVERHEAD SERVICES, and FLOOR AREAS CHECKED AND VERIFIED.
6. ANY DISCREPANCIES ARE TO BE BROUGHT TO THE ATTENTION OF THE PROJECT SUPERINTENDENT PRIOR TO THE COMMENCEMENT OF ANY BUILDING WORK or FABRICATION OF ITEMS.

Q	RP	CLIENT REQUESTED CHANGES BED 1 & 2 ROBE CHANGES, WIPFL EXISTING BED 3 & 4 ROBE CHANGES LANDSCAPE CHANGES BATH REMOVED KITCHEN CHANGE AND NO BBQ ALLOWED RETRACTED BRIGGS (BALCONY BRILLIANT) ADDITIONAL SKYLIGHTS COURTNEY ROOF PITCH MADE TO FALL TOWARDS HOUSE FOR SKYLIGHTS BY REQUEST	26.09.2025						
P	RP	GENERAL ARRANGEMENT FOR CONSTRUCTION - CC SUBMISSION	14.07.2025	S	RP	UPDATED WINDOW SCHEDULE	01.10.2025		
O	RP	GENERAL ARRANGEMENT FOR CONSTRUCTION - CC SUBMISSION	30.06.2025	R	RP	UPDATED DOOR and WINDOW SCHEDULES	30.09.2025		
ISSUE	BY	DESCRIPTION	DATE	ISSUE	BY	DESCRIPTION	DATE		

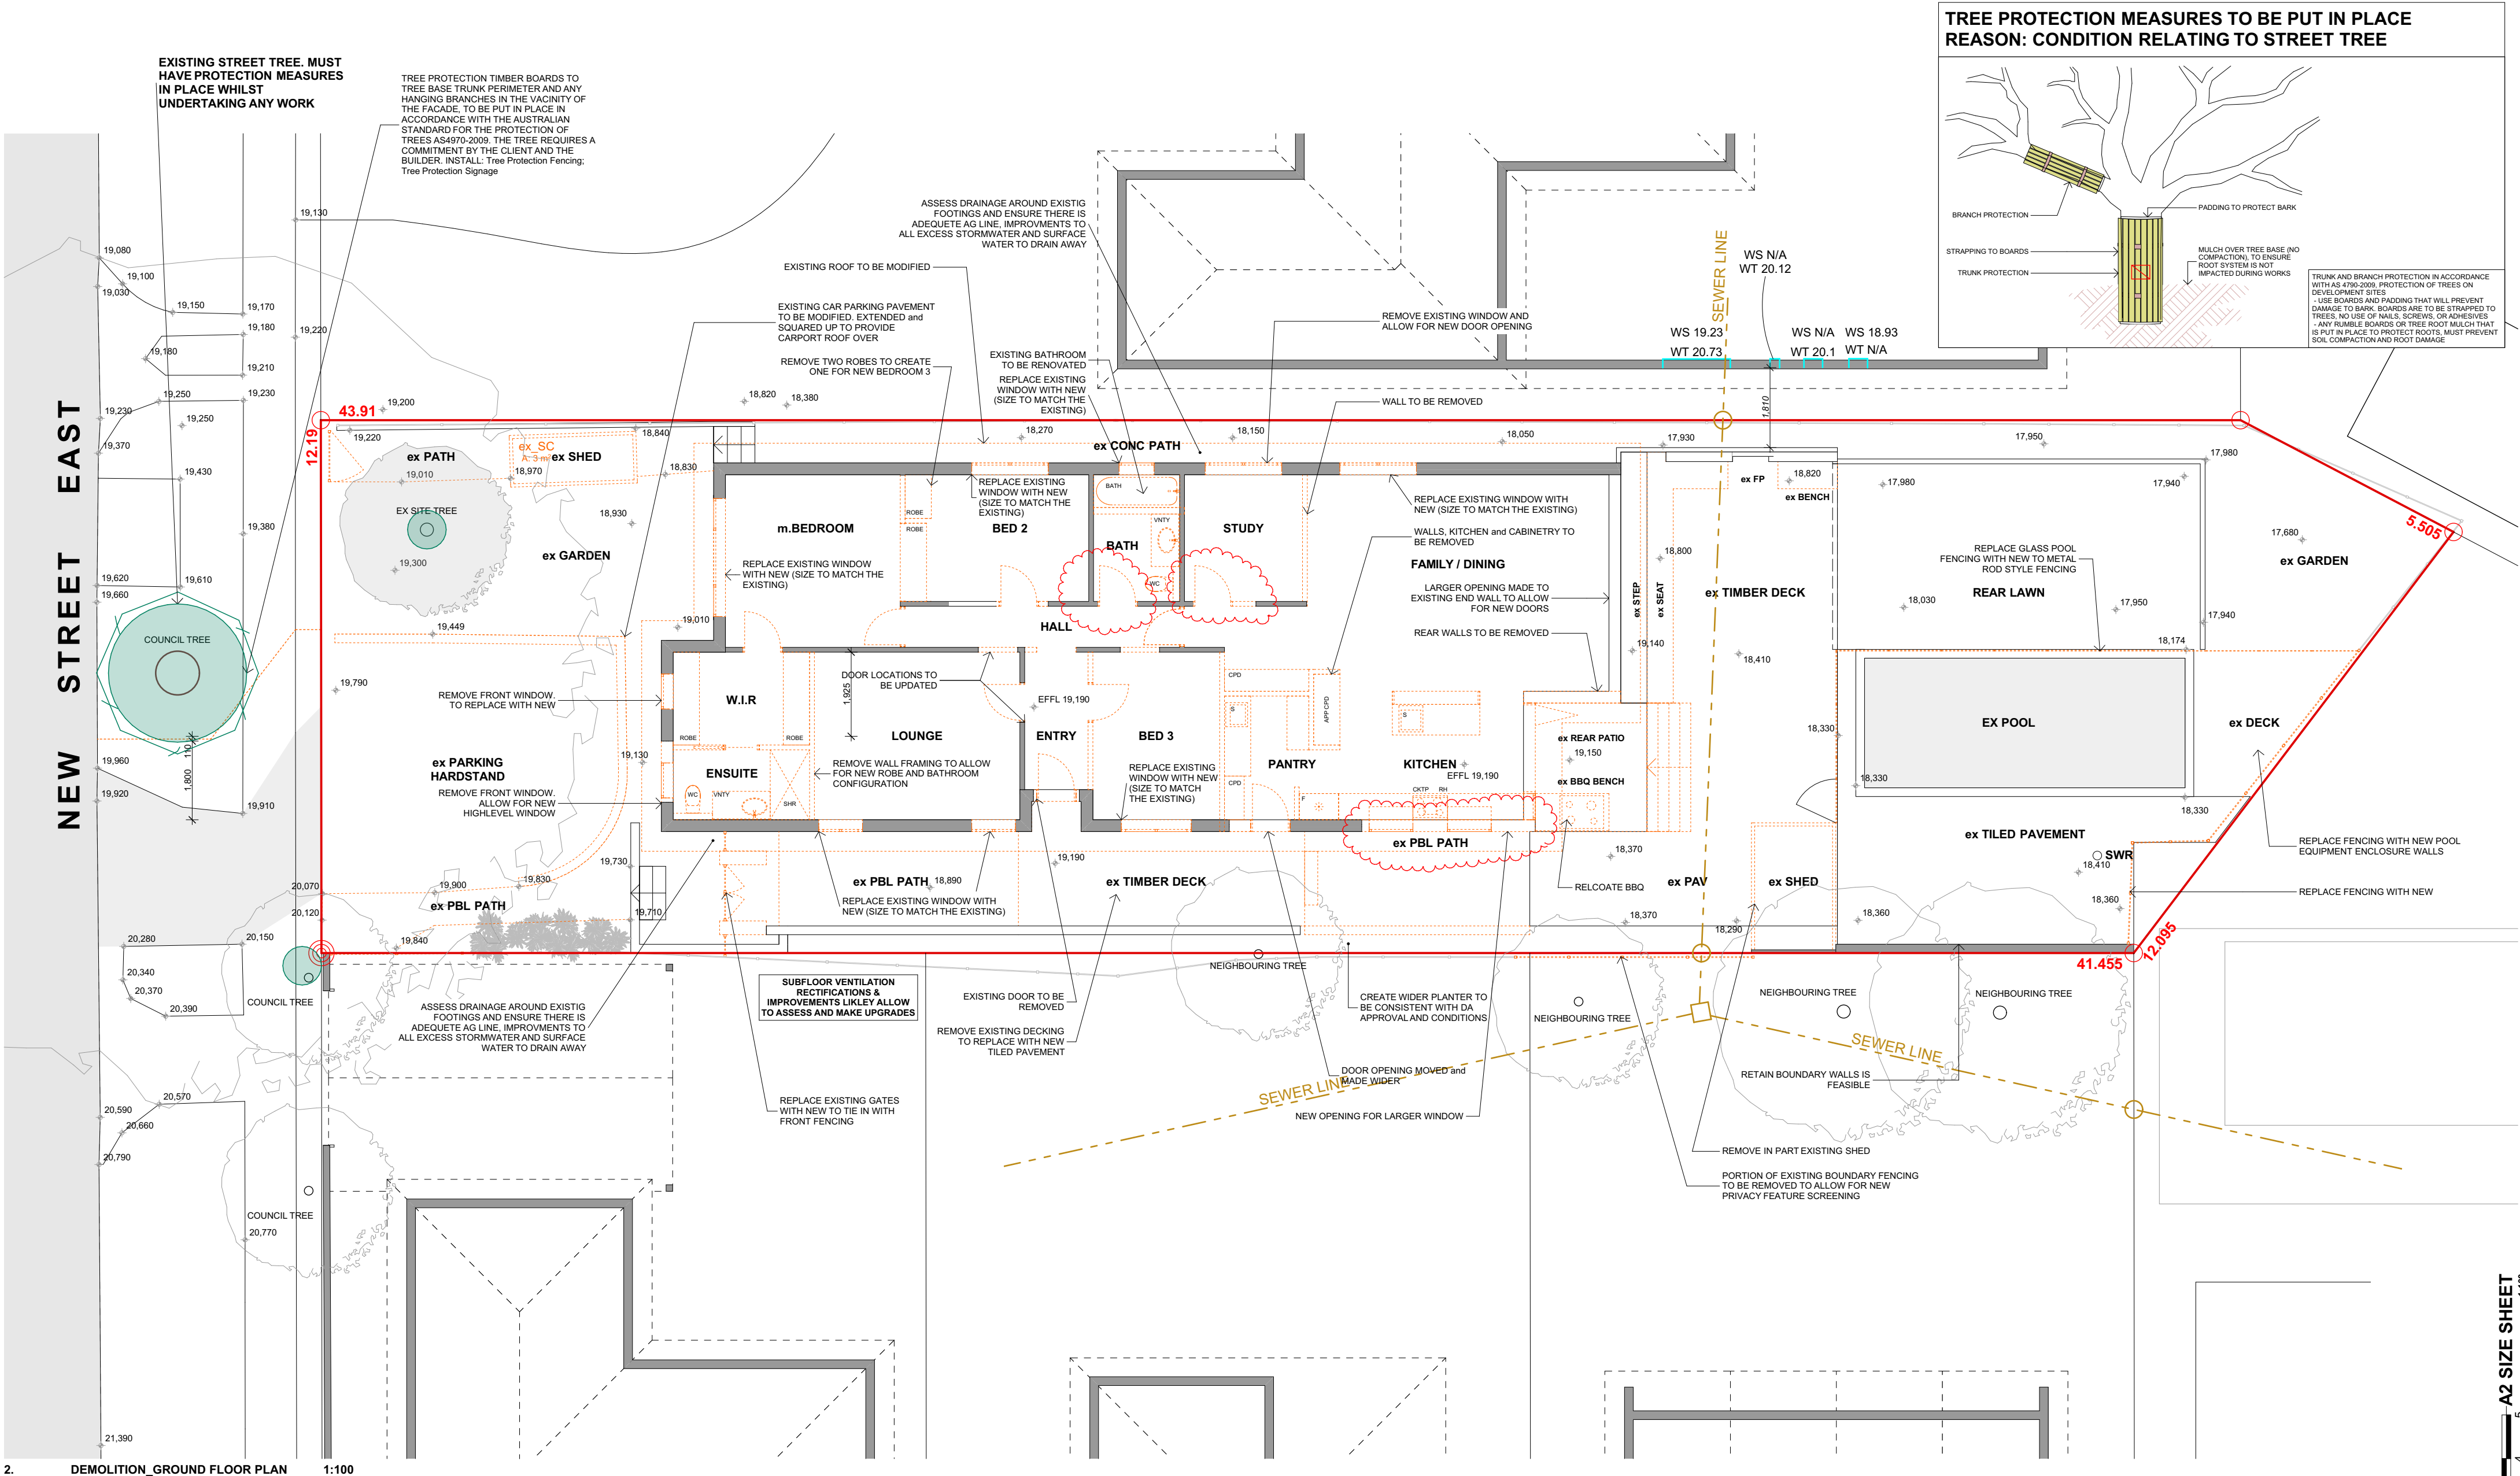

2. DEMOLITION_GROUND FLOOR PLAN 1:100

DEMOLITION NOTE:
ALL DEMOLITION WORKS TO BE DONE IN ACCORDANCE WITH AS2601 and CONSENT AUTHORITY CONDITIONS.

GENERAL NOTES
1. ALL DIMENSIONS, LEVELS, SEWER AND STORMWATER INVERT LEVELS AND FLOOR AREAS ARE TO BE CHECKED AND VERIFIED. ANY DISCREPANCIES ARE TO BE BROUGHT TO THE ATTENTION OF THE DESIGNER PRIOR TO THE COMMENCEMENT OF ANY BUILDING WORK.
2. DO NOT SCALE OFF DRAWINGS.

GENERAL ARRANGEMENT
- FOR CONSTRUCTION

3. ALL BUILDING WORK IS TO BE DONE IN ACCORDANCE WITH THE MOST CURRENT EDITION or AS APPROVED EDITION OF THE BCA (NATIONAL CONSTRUCTION CODE), THE AUSTRALIAN STANDARDS and CONDITIONS OF CONSENT.
4. THE INFORMATION PROVIDED ON THESE PLANS HAVE BEEN PRODUCED BASED ON THE INFORMATION PROVIDED TO US BY THE CLIENT, and the CLIENT'S CONSULTANTS.
5. IT IS THE RESPONSIBILITY OF THE CONTRACTOR TO HAVE ALL DIMENSIONS, LEVELS, SEWER AND STORMWATER INVERT LEVELS, UNDERGROUND and OVERHEAD SERVICES, and FLOOR AREAS CHECKED AND VERIFIED.
6. ANY DISCREPANCIES ARE TO BE BROUGHT TO THE ATTENTION OF THE PROJECT SUPERINTENDENT PRIOR TO THE COMMENCEMENT OF ANY BUILDING WORK or FABRICATION OF ITEMS.



ALL DIMENSIONS TO BE CONFIRMED AND SURVEY PEG OUT TO BE UNDERTAKEN IN ACCORDANCE WITH THE CONDITIONS OF THE CONSENT

LOT 12; DP 12383
COUNCIL: NORTHERN BEACHES COUNCIL
MANLY
PROJECT: ALTERATIONS and ADDITIONS:
- Ground Floor Addition; New First Floor Addition; Internal and External Modifications; Rectifications and Improvements; and Landscape Concept
2 NEW STREET EAST, BALGOWLAH NSW, 2093
CLIENT: M & N DeGARIS

CODES, STANDARDS and CONDITIONS TO COMPLY WITH:
NCC (National Construction Code), 2022 with the ABCB Housing Provisions
REFER TO GA-000 OF THIS SET FOR NCC (BCA) PARTS TO COMPLY WITH

A2 SIZE SHEET
1:100

HARGROVES DESIGN CONSULTANTS
M: 0410 669 148
E: jacqui@hargroves.com.au
DATE: DEC 2021
SCALE: AS NOTED
DRAWN: R.P.
TITLE: DEMOLITION GROUND FLOOR PLAN
Sheet No: GA-102
Issue: S

BUSHFIRE ASSESSMENT
BAL-12.5

Required construction level

The highest Bushfire Attack Level to the proposed new works was determined to be BAL 12.5 from the eastern aspect. The proposed new works are required to comply with section 9 and 8 BAL 12.5 of AS 3959 – 2018 Construction of buildings in bushfire prone areas or the NASH Standard National Standard Steel Framed Construction in Bushfire Areas 2021 as appropriate for BAL 12.5 construction.

Note: Certain provisions of AS 3959 are varied in NSW based on the findings of the Victorian Bush Fires Royal Commission and bush fire industry research. PBP 2019 section 7.5.2 provides a NSW State Variation that BAL 12.5 decks and outdoor areas are constructed to section 7.5.2.29 requirements except that any wall enclosing the outdoor space need only comply with the wall requirements for BAL 12.5.

BASIX™ Certificate

Building Sustainability Index
www.planningportal.nsw.gov.au/development-and-assessment/basix

Alterations and Additions

Certificate number: A1779439_03

This certificate confirms that the proposed development will meet the NSW government's requirements for sustainability. It is built in accordance with the commitments set out below. Terms used in this certificate, or in the commitments, have the meaning given by the document entitled 'BASIX Definitions' dated 10/06/2020 published by the Department. This document is available at: www.planningportal.nsw.gov.au/definitions

This certificate is a revision of certificate number A1779439 lodged with the consent authority or certifier on 12 February 2025 with application PAN-506484.

It is the responsibility of the applicant to verify with the consent authority that the original, or any revised certificate, complies with the requirements of Schedule 1 Clause 2A, 4A or 6A of the Environment Planning and Assessment Regulation 2000


Secretary
Date of issue: Wednesday, 01 October 2025

To be valid, this certificate must be lodged within 3 months of the date of issue.


NEW AND EXISTING SMOKE ALARM REQUIREMENTS:

- ANY STOREY CONTAINING BEDROOMS, EVERY CORRIDOR or HALLWAY ASSOCIATED WITH A BEDROOM, OR IF THERE IS NO CORRIDOR or HALLWAY, IN AN AREA BETWEEN THE BEDROOMS and THE REMAINDER OF THE BUILDING; and
- EACH OTHER STOREY NOT CONTAINING BEDROOMS.

- WHERE A SMOKE ALARM IS LOCATED ON THE CEILING IT MUST BE - A MINIMUM OF 300mm AWAY FROM THE CORNER JUNCTION OF THE WALL and CEILING; and BETWEEN 500mm and 1500mm AWAY FROM THE HIGH POINT and APEXES OF THE CEILING, IF THE ROOM HAS A SLOPING CEILING.

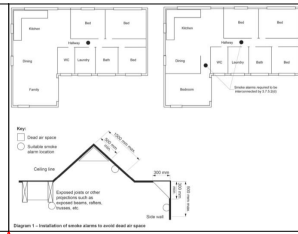

Lot 13
DP 12383

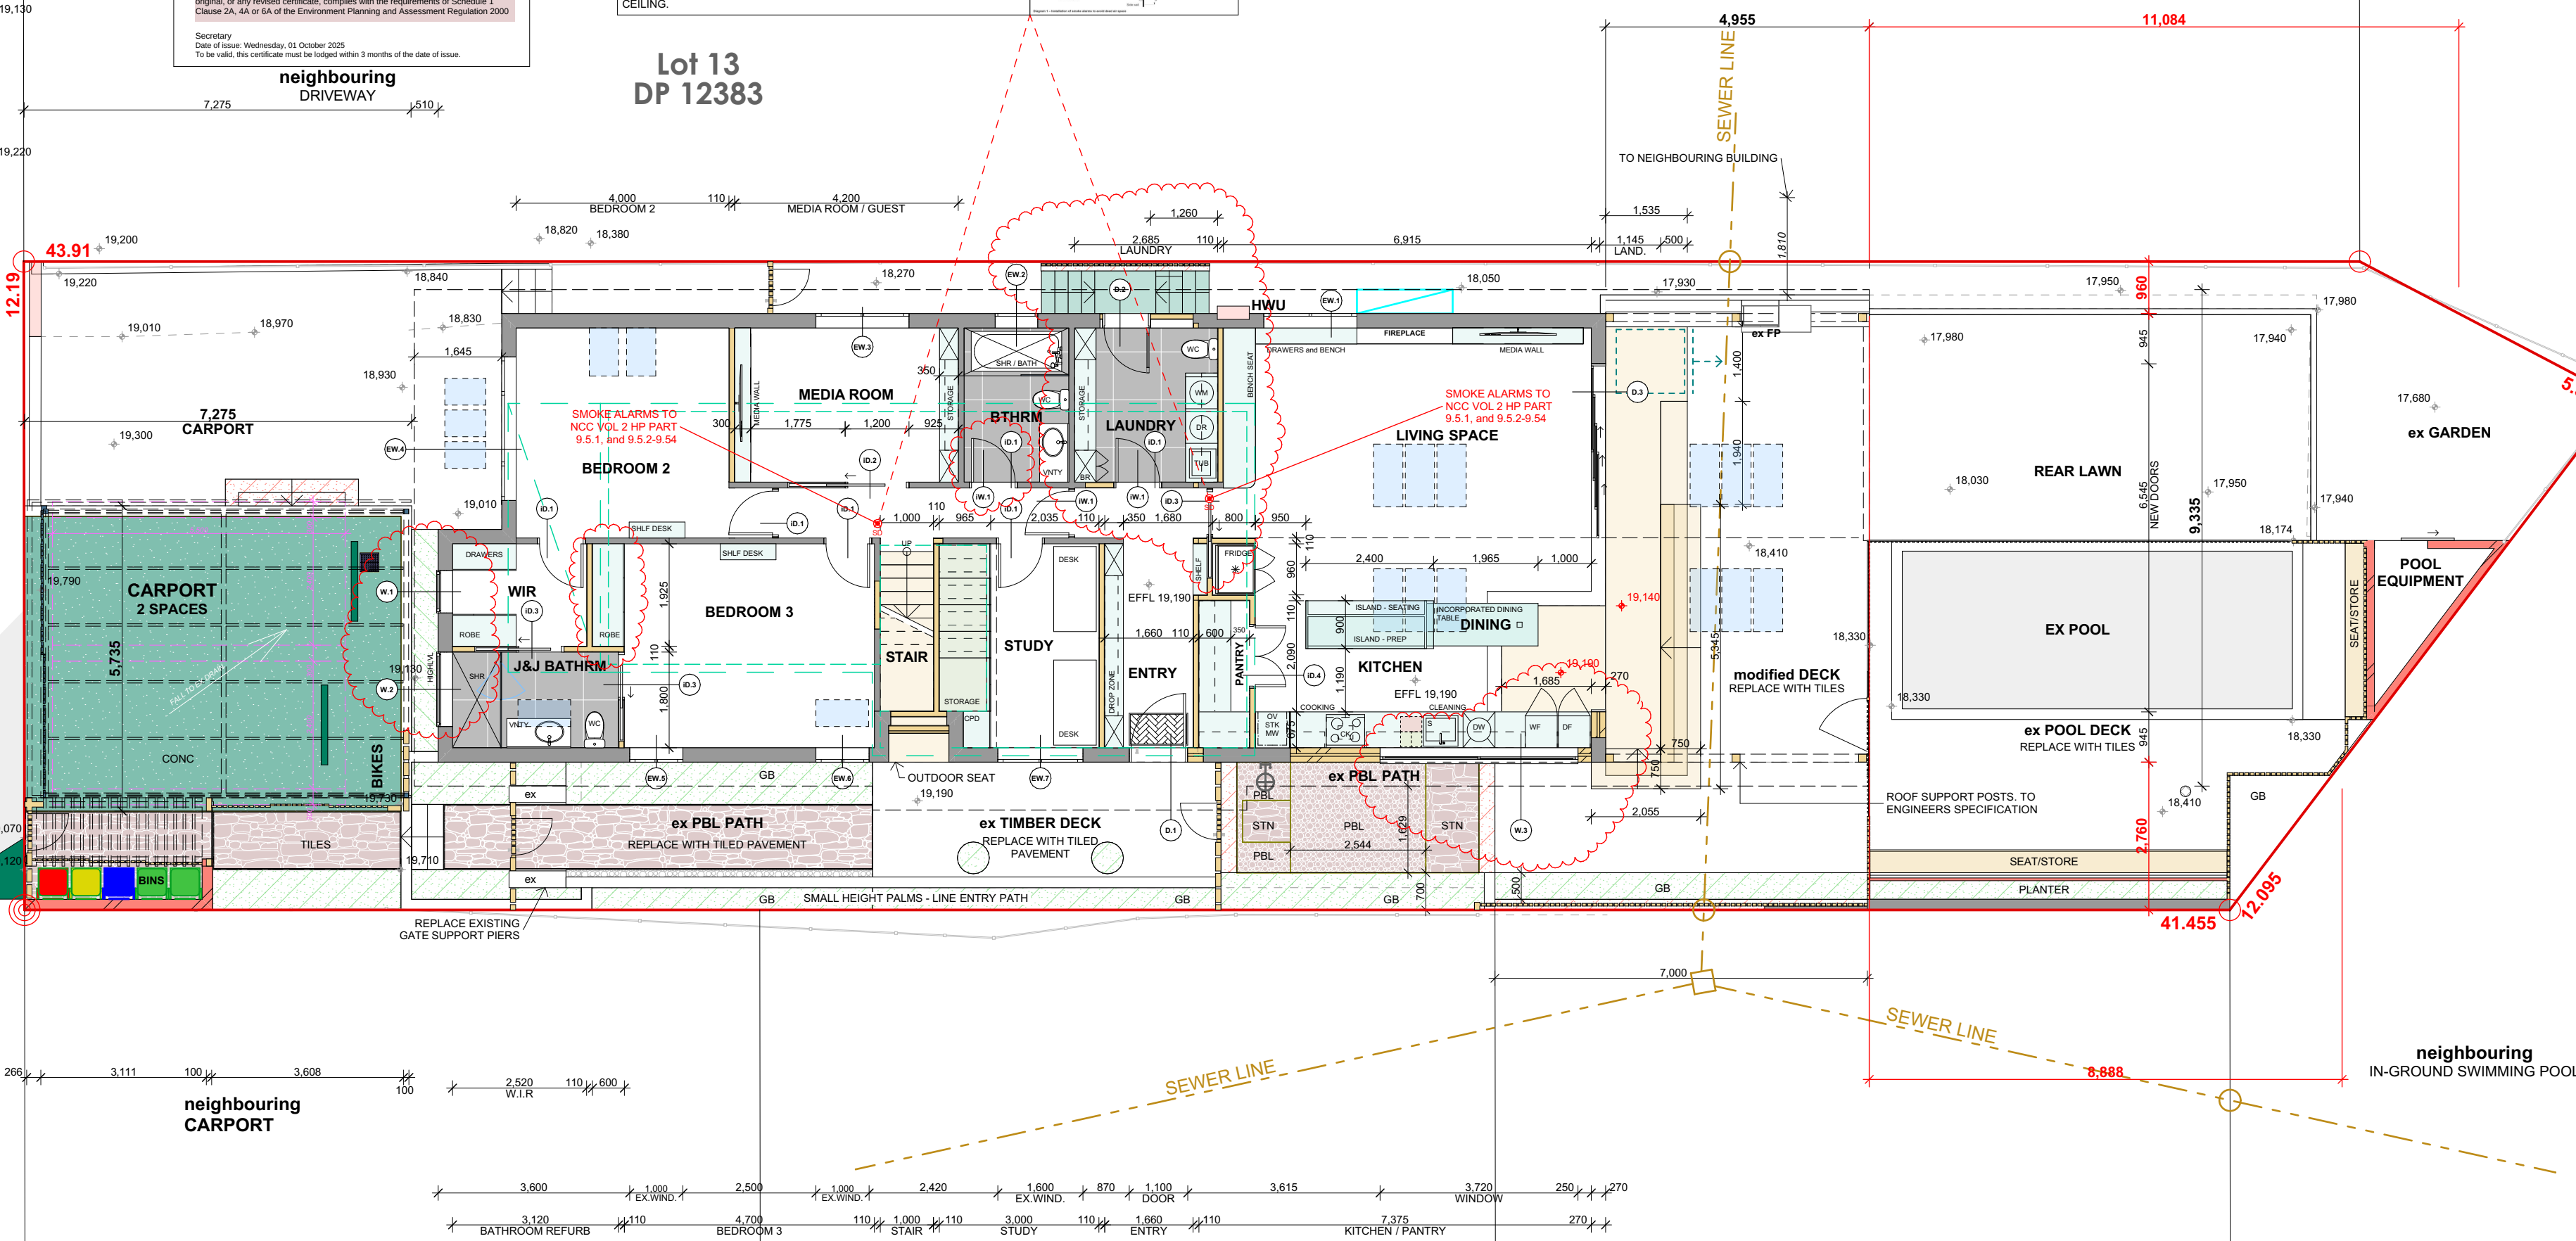

CODES, STANDARDS AND CONDITIONS TO COMPLY WITH:
NCC (National Construction Code), 2022 with the ABCB Housing Provisions

REFER ALSO TO GA-000 OF THIS SET FOR NCC (BCA) PARTS

PART 3.3 – SURFACE WATER DRAINAGE/EXTERNAL STEP DOWN
Provide minimum 50mm step-down to external areas

PART 3.4 – TERMITE RISK MANAGEMENT
Provide physical or chemical system (as appropriate) to AS3660.1 & BCA Part 3.4

PART 6.2 – SUBFLOOR VENTILATION
Provide subfloor openings & ground clearance (climatic zone C):
- min clearance 150mm increasing to 400mm over 2m (ground clearance)
- min 77.5mm x 77.5mm nett opening/metre (subfloor ventilation openings)

PART 7 – WALL & ROOF CLADDING
Must be compliant with BCA Part 7 & DTS provisions (BCA Vol 2 A5G3)
NOTE: Off-form concrete walls only permissible to non-habitable rooms or when used in conjunction with additional cavity construction.

PART 9 – FIRE SEPARATION
External Wall (and any openings in that wall) within 900mm of boundary – provide min 60/60/60 FRL
Separating Wall (eg duplex, terrace etc) – provide min 60/60/60 FRL & Rtr +Ctr 50+ Sound Separation system).

PART 10.2 – WET AREA WATERPROOFING
Provide floor wastes (FW) both inside and outside the shower area (unenclosed) (10.2.18).
Provide min 1:80 fall to floor wastes inside and outside shower area (10.2.12).
Detail water resistant surface materials ie, tiles (10.2.10).
Waterproofing to AS3740 or BCA Part 10.2 (choice to be made by applicant)

VOL 2 H2D8 - EXTERNAL BALCONIES
Provide min 50mm/100mm step-down to external areas (dependent on property's wind classification to be determined by project engineer) - finished internal surface to finished external surface.
Provide min 1:100 fall away from dwelling to drain (provide overflow if enclosed).
Waterproof to AS4654.1 & AS4654.2
NOTE: please provide details/technical specification of pedestal tile system or threshold strip/channel drain if proposed.

PART 10.3 - ROOM HEIGHTS
HABITABLE ROOM - minimum 2.4m
OTHER SPACES - minimum 2.1m (including kitchen, corridor, passageway etc, bathroom, shower room, laundry, sanitary compartment, airlock, pantry, storeroom, garage, car parking area or the like).
Stairway, ramp, landing or the like - minimum 2.0m measured vertically above stairway treads nosing line or floor surface of ramp, landing or the like.
ATTIC - minimum 2.2m for at least two thirds of floor area.
NOTE: For rooms with sloping ceilings the minimum heights must be achieved for at least two thirds of the floor area (for the purposes of calculating the floor areas of a room or space, any part of that has a ceiling height of <1.5m is not included).

PART 10.4 - LAUNDRIES (incl those in cabinets & kitchens)
A dedicated laundry space comprising of at least one washbasin & space for a washing machine must be provided. Laundries shall be waterproofed to AS3740 and provided with water resistant floors (tiled), graded and drained to a floor waste.
NOTE 1: Timber is not deemed water resistant by definition under NCC/BCA provisions.
NOTE 2: A kitchen sink or washbasin must not be counted as a laundry washbasin.
NOTE 3: Mechanical ventilation is to be provided to laundries in cabinets or in rooms with no direct openings to outdoor air.
NOTE 4: No joinery will impede any water overflow path to floor waste

PART 10.6 & 10.8.2 - VENTILATION & EXHAUST SYSTEMS
For rooms with no opening to outdoor air, provide mechanical ventilation ducted to outdoor air:
- 25L/s - bathrooms and WCs
- 40L/s - kitchens and laundries

PART 11.3.7 & 11.3.8 - PROTECTION OF OPENABLE WINDOWS
BEDROOMS - where floor to surface below is >2m provide 1.7m sill height or child-safe restrictor/screen (no openings >125mm).
OTHER ROOMS - where floor to surface below is >4m openable part must be protected by a sill/barrier min 865mm above FFL with no horizontal elements between 150-760mm and permanently fixed with no openings >125mm.

PART 11 - STAIRS & HANDRAILS
Provide a slip-resistant treatment to treads/nosing strip/landings to AS4586 (Dry - P3, Wet - P4) and a continuous handrail for the full length of the flight.
Riser: min 115mm - max 190mm
Going/tread: min 240mm - max 355mm
Slope Relationship (2R+G): min 550mm - max 700mm
Riser/tread dimensions to be constant for each flight

PART 11.3 - BALUSTRADES
A continuous barrier must be provided along the side of a trafficable surface where it is possible to fall 1m or more to the surface beneath.
The height of the barrier must be not less than 1m above FFL (or not less than 865mm above the nosing line for stairs).
No horizontal elements to facilitate climbing between 150mm to 760mm where floor to ground level below is >4m (solid or vertically configured only).
Openings must be constructed so that they do not permit a 125mm sphere to pass through.

ALL DIMENSIONS TO BE CONFIRMED AND SURVEY PEG OUT TO BE UNDERTAKEN IN ACCORDANCE WITH THE CONDITIONS OF THE CONSENT

INTERNAL MEASUREMENTS HAVE NOT HAD A FINAL CHECK. ALL DIMENSIONS TO BE CONFIRMED ON SITE. ANY MAJOR DISCREPANCY IS TO BE ADVISED BEFORE ANY CONSTRUCTION WORK / FABRICATION IS UNDERTAKEN

SYMBOLS + COLOURS:

- OUTLINE OF DEMOLITION.
- BOUNDARY LINE - AS SURVEYED
- NEW ROOF
- EXISTING TO REMAIN
- DIRECTION OF ROOF FALL
- DIRECTION OF STORMWATER
- DIRECTION OF SURFACE FALL
- ACHIEVED SETBACK DIMENSION
- YELLOW - TIMBER BASED
- RED - MASONRY BASED
- ORANGE - DEMOLITION
- EARTHWORK

CODES, STANDARDS AND CONDITIONS TO COMPLY WITH:
NCC (National Construction Code), 2022 with the ABCB Housing Provisions

REFER TO GA-000 OF THIS SET FOR NCC (BCA) PARTS TO COMPLY WITH

A2 SIZE SHEET
1:100

2. UPDATED GROUND FLOOR PLAN
1:100

Q	RP	CLIENT REQUESTED CHANGES	26.09.2025		
		1. AS 1500 HORIZONTAL, 1500 VERTICAL			
		2. AS 1500 HORIZONTAL, 1500 VERTICAL			
		3. AS 1500 HORIZONTAL, 1500 VERTICAL			
GENERAL NOTES

1. ALL DIMENSIONS, LEVELS, SEWER AND STORMWATER INVERT LEVELS AND FLOOR AREAS ARE TO BE CHECKED AND VERIFIED. ANY DISCREPANCIES ARE TO BE BROUGHT TO THE ATTENTION OF THE DESIGNER PRIOR TO THE COMMENCEMENT OF ANY BUILDING WORK.

2. DO NOT SCALE OFF DRAWINGS.

GENERAL ARRANGEMENT
- FOR CONSTRUCTION

3. ALL BUILDING WORK IS TO BE DONE IN ACCORDANCE WITH THE MOST CURRENT EDITION or AS APPROVED EDITION OF THE BCA (NATIONAL CONSTRUCTION CODE), THE AUSTRALIAN STANDARDS AND CONDITIONS OF CONSENT.

4. THE INFORMATION PROVIDED ON THESE PLANS HAVE BEEN PRODUCED BASED ON THE INFORMATION PROVIDED TO US BY THE CLIENT, AND THE CLIENT'S CONSULTANTS.

5. IT IS THE RESPONSIBILITY OF THE CONTRACTOR TO HAVE ALL DIMENSIONS, LEVELS, SEWER AND STORMWATER INVERT LEVELS, UNDERGROUND AND OVERHEAD SERVICES, AND FLOOR AREAS CHECKED AND VERIFIED.

6. ANY DISCREPANCIES ARE TO BE BROUGHT TO THE ATTENTION OF THE PROJECT SUPERINTENDENT PRIOR TO THE COMMENCEMENT OF ANY BUILDING WORK or FABRICATION OF ITEMS.



LOT & DP
LOT 12; DP 12383

COUNCIL
NORTHERN BEACHES COUNCIL

MANLY

COPYRIGHT
THIS DESIGN AND THE ASSOCIATED DOCUMENTS ARE SUBJECT TO COPYRIGHT LAWS AND MAY NOT BE REPRODUCED IN ANY FORM WITHOUT WRITTEN CONSENT FROM HARGROVES DESIGN CONSULTANTS

PROJECT
ALTERATIONS AND ADDITIONS:
- Ground Floor Addition; New First Floor Addition; Internal and External Modifications; Rectifications and Improvements; and Landscape Concept

CLIENT
M & N DeGARIS

DATE	DEC 2021	TITLE	PROPOSED GROUND FLOOR PLAN	Sheet No	GA-103	Issue	S
SCALE	AS NOTED						
DRAWN	R.P.						

BUSHFIRE ASSESSMENT
BAL-12.5

Required construction level

The highest Bushfire Attack Level to the proposed new works was determined to be BAL 12.5 from the eastern aspect. The proposed new works are required to comply with section 9 and 8 BAL 12.5 of AS 3999 – 2018 Construction of buildings in bushfire prone areas or the NASH Standard National Standard Steel Framed Construction in Bushfire Areas 2021 as appropriate for BAL 12.5 construction.

Note: Certain provisions of AS 3999 are varied in NSW based on the findings of the Victorian Bush Fires Royal Commission and bush fire industry research. PBP 2019 section 7.5.2 provides a NSW State Variation that BAL 12.5 decks and outdoor areas are constructed to section 7.7 BAL 29 requirements except that any wall enclosing the outdoor space need only comply with the wall requirements for BAL 12.5.

BASIX™Certificate

Building Sustainability Index
www.planningportal.nsw.gov.au/development-and-assessment/basix

Alterations and Additions

Certificate number: A1779439_03

This certificate confirms that the proposed development will meet the NSW government's requirements for sustainability. If it is built in accordance with the commitments set out below. Terms used in this certificate, or in the commitments, have the meaning given by the document entitled 'BASIX Definitions' dated 10/06/2020 published by the Department. This document is available at www.planningportal.nsw.gov.au/definitions


This certificate is a revision of certificate number A1779439 lodged with the consent authority or certifier on 12 February 2025 with application PAN-506484.

It is the responsibility of the applicant to verify with the consent authority that the original, or any revised certificate, complies with the requirements of Schedule 1 Clause 2A, 4A or 6A of the Environment Planning and Assessment Regulation 2000


Secretary
Date of issue: Wednesday, 01 October 2025
To be valid, this certificate must be lodged within 3 months of the date of issue.

NEW and EXISTING SMOKE ALARM REQUIREMENTS:
- ANY STOREY CONTAINING BEDROOMS, EVERY CORRIDOR or HALLWAY ASSOCIATED WITH A BEDROOM, OR IF THERE IS NO CORRIDOR or HALLWAY, IN AN AREA BETWEEN THE BEDROOMS and the REMAINDER OF THE BUILDING; and
- EACH OTHER STOREY NOT CONTAINING BEDROOMS.

- WHERE A SMOKE ALARM IS LOCATED ON THE CEILING IT MUST BE - A MINIMUM OF 300mm AWAY FROM THE CORNER JUNCTION OF THE WALL and CEILING; and BETWEEN 500mm and 1500mm AWAY FROM THE HIGH POINT and APEXES OF THE CEILING, IF THE ROOM HAS A SLOPING CEILING.

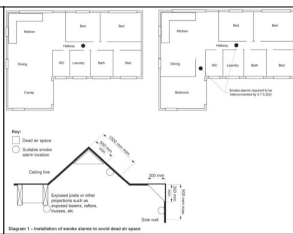

Lot 13
DP 12383

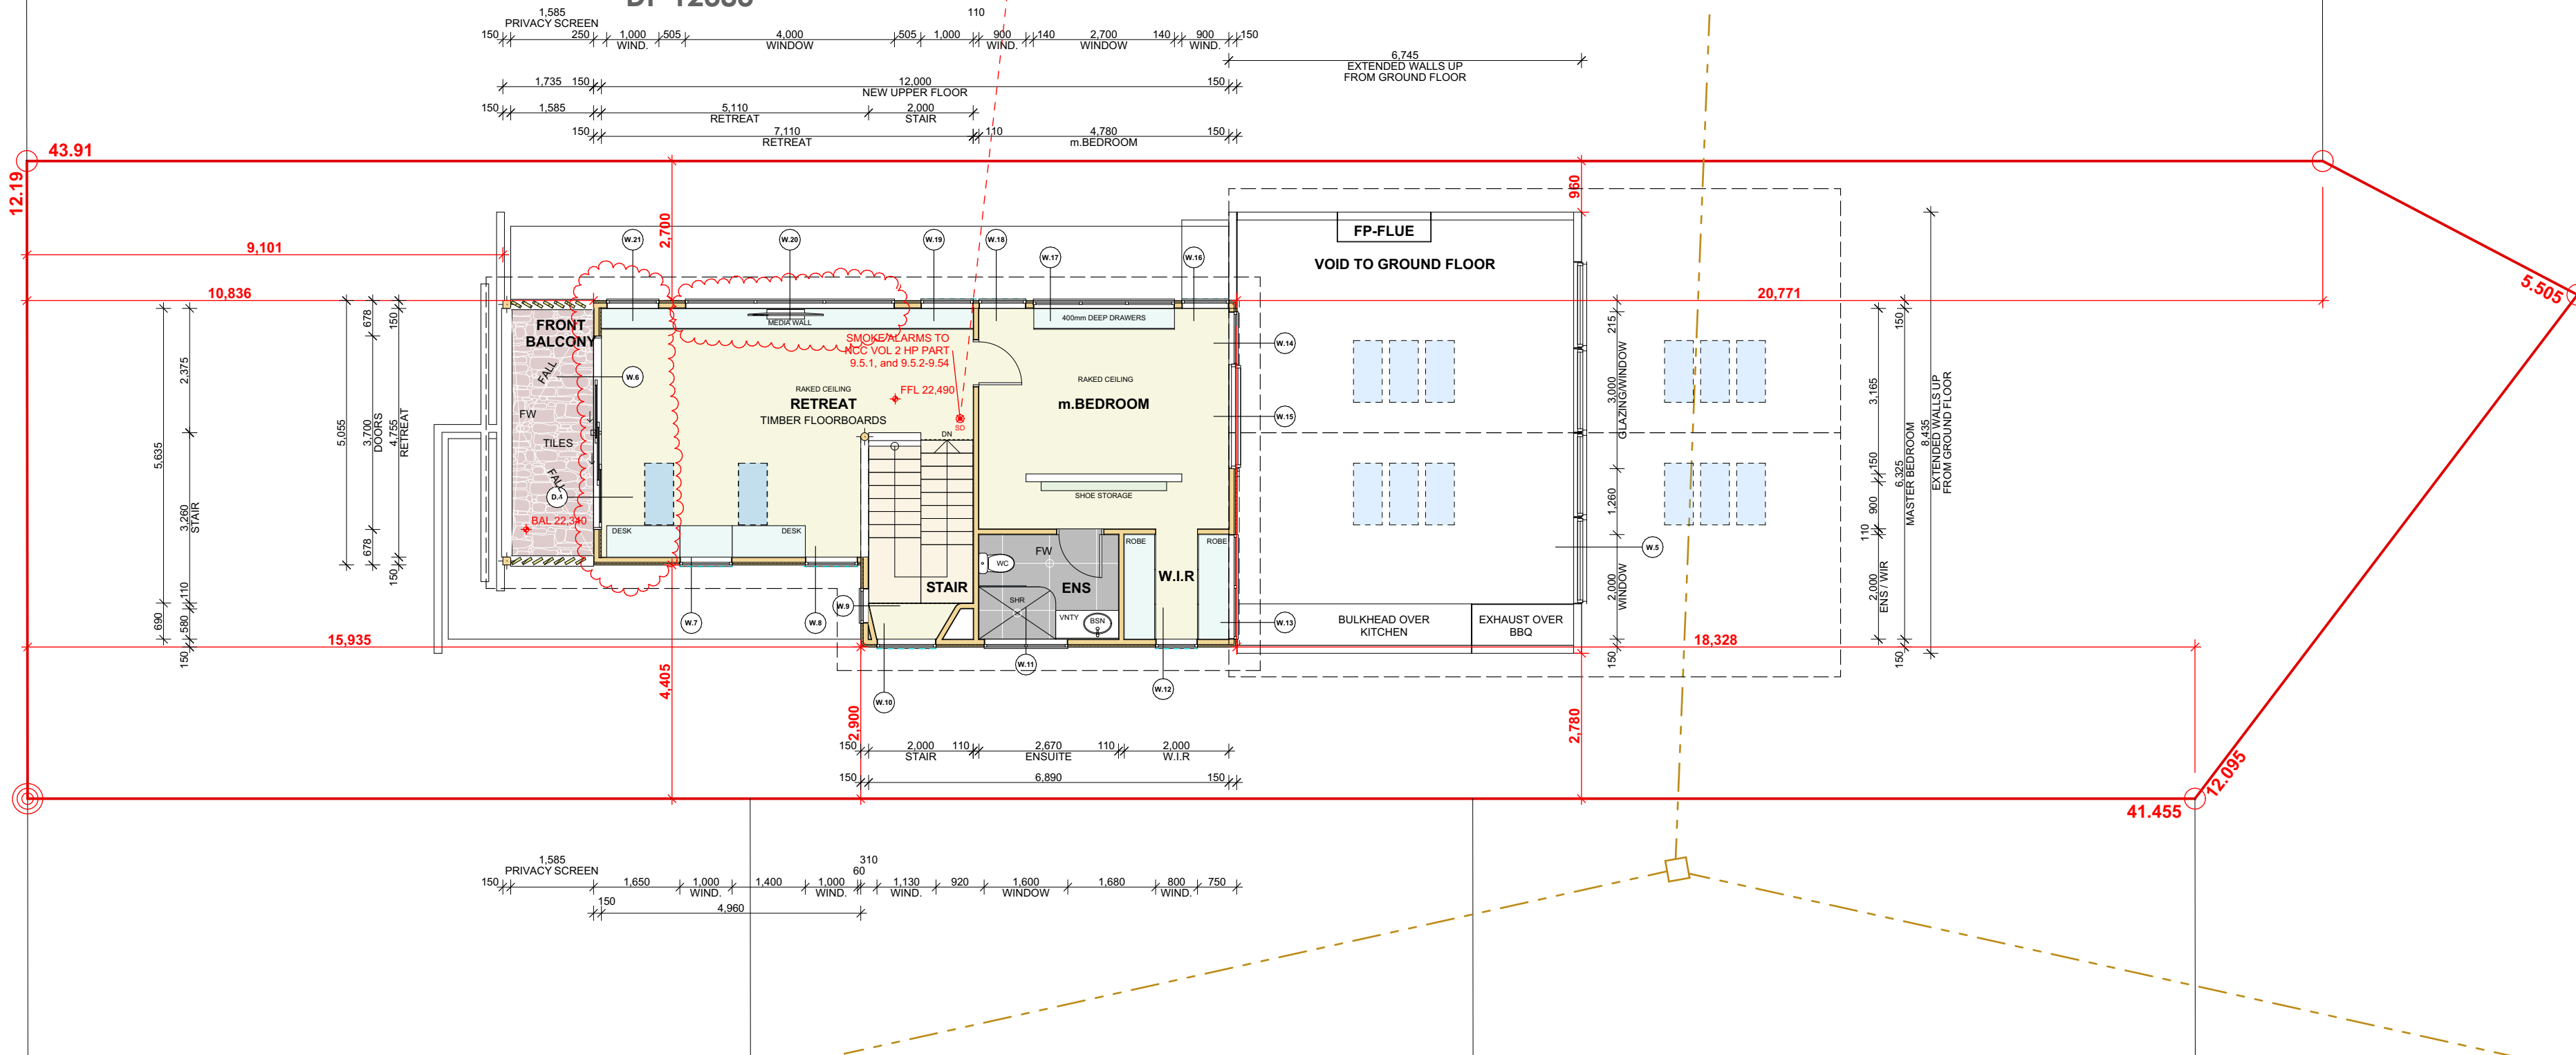

CODES, STANDARDS and CONDITIONS TO COMPLY WITH:
NCC (National Construction Code), 2022 with the ABCB Housing Provisions

REFER ALSO TO GA-000 OF THIS SET FOR NCC (BCA) PARTS

PART 3.3 – SURFACE WATER DRAINAGE/EXTERNAL STEP DOWN
Provide minimum 50mm step-down to external areas

PART 3.4 – TERMITE RISK MANAGEMENT
Provide physical or chemical system (as appropriate) to AS3660.1 & BCA Part 3.4

PART 6.2 – SUBFLOOR VENTILATION
Provide subfloor openings & ground clearance (climatic zone C):
- min clearance 150mm increasing to 400mm over 2m (ground clearance)
- min 77.5mm x 77.5mm nett opening/metre (subfloor ventilation openings)

PART 7 – WALL & ROOF CLADDING
Must be compliant with BCA Part 7 & DTS provisions (BCA Vol 2 A5G3)
NOTE: Off-form concrete walls only permissible to non-habitable rooms or when used in conjunction with additional cavity construction.

PART 9 – FIRE SEPARATION
External Wall (and any openings in that wall) within 900mm of boundary – provide min 60/60/60 FRL
Separating Wall (eg duplex, terrace etc) – provide min 60/60/60 FRL (& Rw +Ctr 50+ Sound Separation system).
Separating Floor (eg secondary dwelling on top of non-ancillary garage) – provide min 30/30/30 FRL in accordance with DTS solution/approved system

PART 9.5 – SMOKE ALARMS
Provide hardwired, interconnected smoke alarms to every storey.
Predominantly located outside bedrooms protecting them from remainder of building

PART 10.2 – WET AREA WATERPROOFING
Provide floor wastes (FW) both inside and outside the shower area (unenclosed) (10.2.18).
Provide min 1:80 fall to floor wastes inside and outside shower area (10.2.12).
Detail water resistant surface materials ie, tiles (10.2.10).
Waterproofing to AS3740 or BCA Part 10.2 (choice to be made by applicant)

VOL 2 H2D8 - EXTERNAL BALCONIES
Provide min 50mm-100mm step-down to external areas (dependent on property's wind classification to be determined by project engineer) - finished internal surface to finished external surface.
Provide min 1:100 fall away from dwelling (provide overflow if enclosed).
Waterproof to AS4654.1 & AS4654.2
NOTE: please provide details/technical specification of pedestal tile system or threshold strip/channel drain if proposed.

PART 10.3 - ROOM HEIGHTS
HABITABLE ROOM - minimum 2.4m
OTHER SPACES - minimum 2.1m (including kitchen, corridor, passageway etc, bathroom, shower room, laundry, sanitary compartment, airlock, pantry, storeroom, garage, car parking area or the like).
Stairway, ramp, landing or the like - minimum 2.0m measured vertically above stairway treads nosing line or floor surface of ramp, landing or the like.
ATTIC - minimum 2.2m for at least two thirds of floor area.
NOTE: For rooms with sloping ceilings the minimum heights must be achieved for at least two thirds of the floor area (for the purposes of calculating the floor areas of a room or space, any part of that has a ceiling height of <1.5m is not included)

PART 10.4 - LAUNDRIES (incl those in cabinets & kitchens)
A dedicated laundry space comprising of at least one washub & space for a washing machine must be provided. Laundries shall be waterproofed to AS3740 and provided with water resistant floors (tiled), graded and drained to a floor waste.
NOTE 1: Timber is not deemed water resistant by definition under NCC/BCA provisions.
NOTE 2: A kitchen sink or washbasin must not be counted as a laundry washub.
NOTE 3: Mechanical ventilation is to be provided to laundries in cabinets or in rooms with no direct openings to outdoor air.
NOTE 4: No joinery will impede any water overflow path to floor waste

PART 10.6 & 10.8.2 - VENTILATION & EXHAUST SYSTEMS
For rooms with no opening to outdoor air, provide mechanical ventilation ducted to outdoor air:
- 25L/s - bathrooms and WCs
- 40L/s - kitchens and laundries

PART 11.3.7 & 11.3.8 - PROTECTION OF OPENABLE WINDOWS
BEDROOMS - where floor to surface below is >2m provide 1.7m sill height or child-safe restrictor/screen (no openings >125mm).
OTHER ROOMS - where floor to surface below is >4m openable part must be protected by a sill/barrier min 865mm above FFL with no horizontal elements between 150-760mm and permanently fixed with no openings >125mm.

PART 11 - STAIRS & HANDRAILS
Provide a slip-resistant treatment to treads/nosing strip/landings to AS4586 (Dry - P3, Wet - P4) and a continuous handrail for the full length of the flight.
Riser: min 115mm - max 190mm
Going/tread: min 240mm - max 355mm
Slope Relationship (2R+G): min 550mm - max 700mm
Riser/tread dimensions to be constant for each flight

PART 11.3 - BALUSTRADES
A continuous barrier must be provided along the side of a trafficable surface where it is possible to fall 1m or more to the surface beneath.
The height of the barrier must be not less than 1m above FFL (or not less than 865mm above the nosing line for stairs).
No horizontal elements to facilitate climbing between 150mm to 760mm where floor to ground level below is >4m (solid or vertically configured only).
Openings must be constructed so that they do not permit a 125mm sphere to pass through.


ALL DIMENSIONS TO BE CONFIRMED AND SURVEY PEG OUT TO BE UNDERTAKEN IN ACCORDANCE WITH THE CONDITIONS OF THE CONSENT

INTERNAL MEASUREMENTS HAVE NOT HAD A FINAL CHECK. ALL DIMENSIONS TO BE CONFIRMED ON SITE. ANY MAJOR DISCREPANCY IS TO BE ADVISED BEFORE ANY CONSTRUCTION WORK / FABRICATION IS UNDERTAKEN

LOT 12; DP 12383
NORTHERN BEACHES COUNCIL
MANLY

PROJECT
ALTERATIONS AND ADDITIONS:
- Ground Floor Addition; New First Floor Addition; Internal and External Modifications; Rectifications and Improvements; and Landscape Concept
2 NEW STREET EAST, BALGOWLAH NSW, 2093

CLIENT
M & N DeGARIS

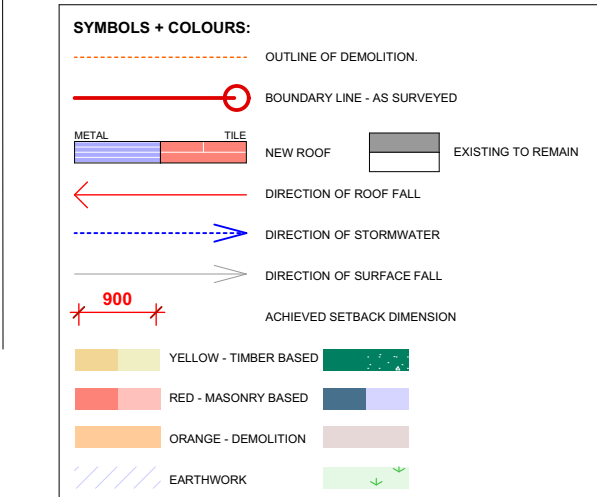

CODES, STANDARDS and CONDITIONS TO COMPLY WITH:
NCC (National Construction Code), 2022 with the ABCB Housing Provisions
REFER TO GA-000 OF THIS SET FOR NCC (BCA) PARTS TO COMPLY WITH

A2 SIZE SHEET
1:100


DATE	DEC 2021	TITLE	PROPOSED NEW FIRST FLOOR	Sheet No	Issue
SCALE	AS NOTED	PLAN		GA-104	S
DRAWN	R.P.				

A2 SIZE SHEET
1:100

GENERAL NOTES
1. ALL DIMENSIONS, LEVELS, SEWER AND STORMWATER INVERT LEVELS AND FLOOR AREAS ARE TO BE CHECKED AND VERIFIED. ANY DISCREPANCIES ARE TO BE BROUGHT TO THE ATTENTION OF THE DESIGNER PRIOR TO THE COMMENCEMENT OF ANY BUILDING WORK.
2. DO NOT SCALE OFF DRAWINGS.

GENERAL ARRANGEMENT
- FOR CONSTRUCTION

3. ALL BUILDING WORK IS TO BE DONE IN ACCORDANCE WITH THE MOST CURRENT EDITION or AS APPROVED EDITION OF THE BCA (NATIONAL CONSTRUCTION CODE), THE AUSTRALIAN STANDARDS and CONDITIONS OF CONSENT.
4. THE INFORMATION PROVIDED ON THESE PLANS HAVE BEEN PRODUCED BASED ON THE INFORMATION PROVIDED TO US BY THE CLIENT, AND THE CLIENT'S CONSULTANTS.
5. IT IS THE RESPONSIBILITY OF THE CONTRACTOR TO HAVE ALL DIMENSIONS, LEVELS, SEWER AND STORMWATER INVERT LEVELS, UNDERGROUND AND OVERHEAD SERVICES, and FLOOR AREAS CHECKED AND VERIFIED.
6. ANY DISCREPANCIES ARE TO BE BROUGHT TO THE ATTENTION OF THE PROJECT SUPERINTENDENT PRIOR TO THE COMMENCEMENT OF ANY BUILDING WORK or FABRICATION OF ITEMS.

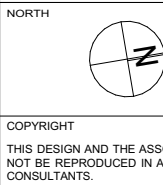

COPYRIGHT
THIS DESIGN AND THE ASSOCIATED DOCUMENTS ARE SUBJECT TO COPYRIGHT LAWS AND MAY NOT BE REPRODUCED IN ANY FORM WITHOUT WRITTEN CONSENT FROM HARGROVES DESIGN CONSULTANTS

LOT 12; DP 12383
NORTHERN BEACHES COUNCIL
MANLY

PROJECT
ALTERATIONS AND ADDITIONS:
- Ground Floor Addition; New First Floor Addition; Internal and External Modifications; Rectifications and Improvements; and Landscape Concept
2 NEW STREET EAST, BALGOWLAH NSW, 2093

CLIENT
M & N DeGARIS

DATE	DEC 2021	TITLE	PROPOSED NEW FIRST FLOOR	Sheet No	Issue
SCALE	AS NOTED	PLAN		GA-104	S
DRAWN	R.P.				

Issue

NEW STREET EAST

BENCH MARK
NAIL IN KERB
RL 19.87 AHD

Lot Y
DP 373327

No.4
SINGLE STOREY DETACHED DWELLING
BRICK WALLS, TILE & METAL ROOVES

5.505

41.455

12.085

43.91

12.19

9.101

10.836

15.935

3.

UPDATED FIRST FLOOR PLAN

1:100

91.35m² OF NEW ROOF AREA

112.15m² (20.3%) OF DEEP SOIL LANDSCAPING AREA

REFER TO ENGINEERS STORMWATER DESIGN TO DRAINAGE AND DISCHARGE LAYOUT

ALL NEW ROOF AREAS TO HAVE METAL GUTTERS TO COLLECT WATER RUNOFF TO UNDERGROUND UPVC PIPE (min. 100dia). ENSURE APPROPRIATELY DIVERTED TO NEW RAINWATER TANK and OVERFLOW TO APPROVED DISCHARGE POINT.
ALL TO ENGINEER'S SPECIFICATION AND IN ACCORDANCE WITH THE MOST CURRENT EDITION OF AS3500

STORMWATER FROM RAINWATER TANK OVERFLOW TO CONNECT TO EXISTING SITE STORMWATER SYSTEM.
DIVERTED TO EXISTING STREET DISCHARGE POINT, WHERE LOCATED ADJACENT TO SITE - ALL TO ENGINEER'S SPECIFICATION AND DETAILED DESIGN, AND COUNCIL'S CONDITIONS OF CONSENT.

NORTHERN and REAR LOW CORNER OF SITE TO BE FITTED WITH ABSORPTION TRENCH THAT COLLECTS AND SLOW RELEASES WATER INTO GARDENS and ANY EXCESS INTO THE SITE STORMWATER SYSTEM TO MITIGATE SURFACE WATER AND PREVENT NEIGHBOURING SITES BEING INUNDATED

BUSHFIRE ASSESSMENT BAL-12.5

Required construction level

The highest Bushfire Attack Level to the proposed new works was determined to be 'BAL 12.5' from the eastern aspect. The proposed new works are required to comply with section 3 and 5 BAL 12.5 of AS 3099 - 2018 Construction of buildings in bushfire prone areas or the NSW Standard National Standard Steel Framed Construction in Bushfire Areas 2021 as appropriate for BAL 12.5 construction.

The additional construction requirements detailed within section 7.5.2 of PBP 2019 are also applicable.

Notes: Certain provisions of AS 3099 are waived in NSW based on the findings of the Victorian Bush Fire Royal Commission and bush fire industry research. PBP 2019 section 7.5.2 provides a NSW State Variation that BAL 12.5 decks and outdoor areas are constructed to section 7.7 BAL 29 requirements except that any wall enclosing the outdoor space need only comply with the wall requirements for BAL 12.5.


BASIX™Certificate

Building Sustainability Index
www.planningportal.nsw.gov.au/development-and-assessment/basix


Alterations and Additions
Certificate number: A1379439_03

No.4
SINGLE STOREY DETACHED DWELLING
BRICK WALLS, TILE & METAL ROOVES

Lot 13
DP 12383

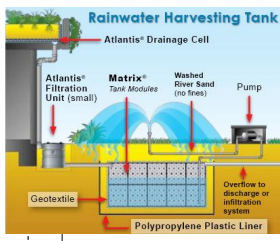


PROPOSED SUBDECK
RAINWATER HARVESTING TO
MEET 2,000L REQUIREMENTS

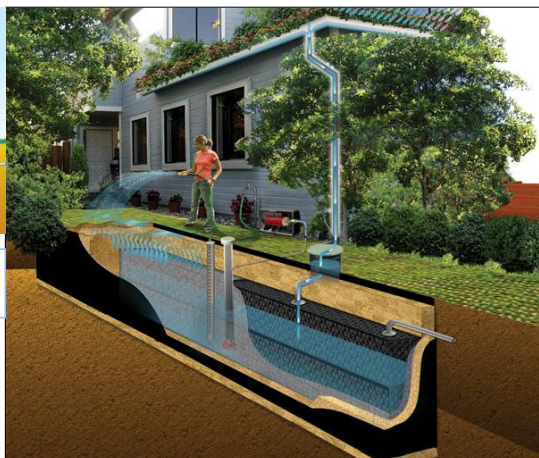

Lot Y
DP 373327

NEW STREET EAST

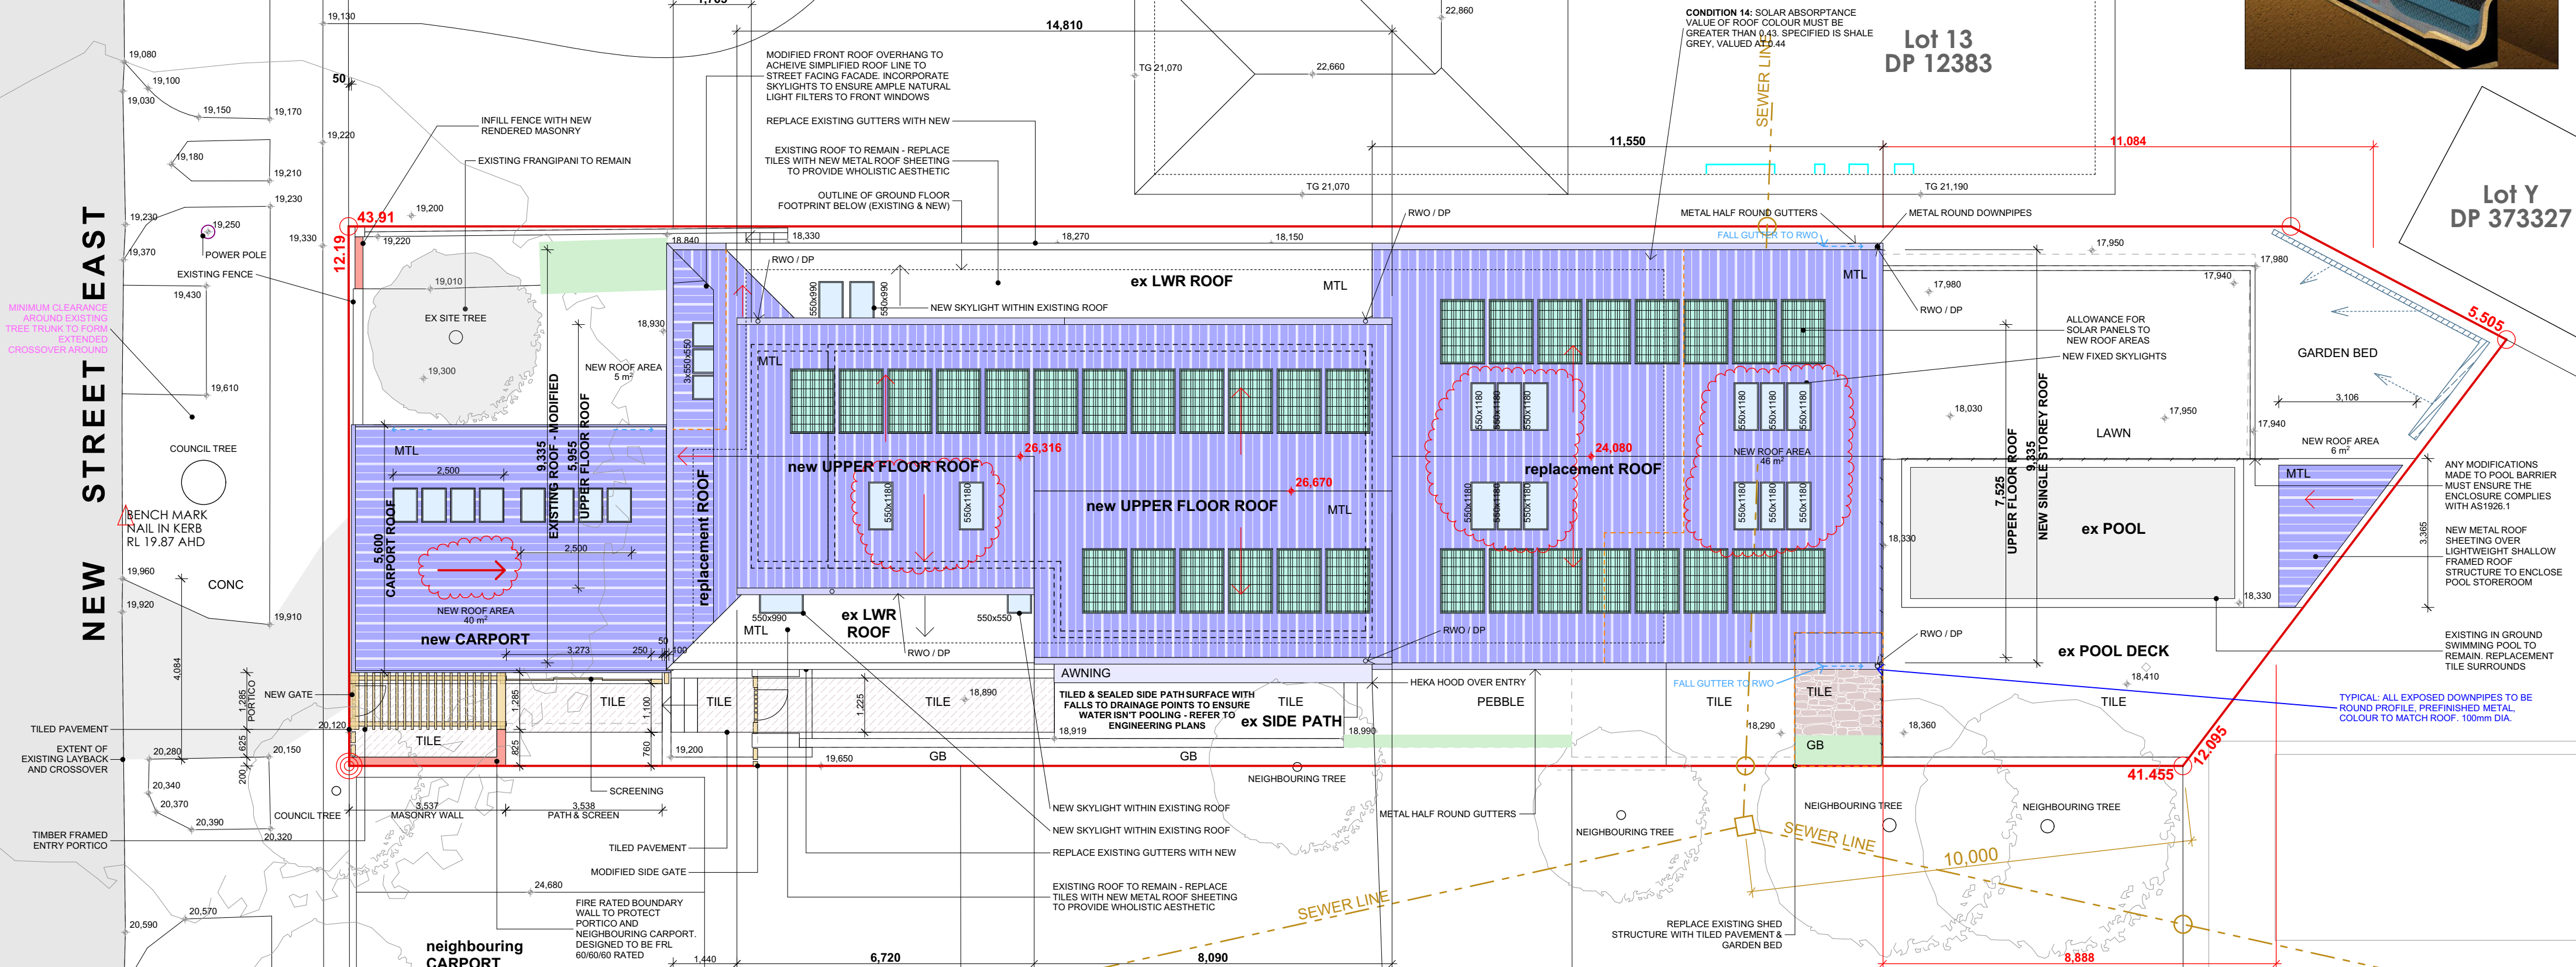

CODES, STANDARDS AND CONDITIONS TO COMPLY WITH:

NCC (National Construction Code), 2022 with the ABCB Housing Provisions

REFER ALSO TO GA-000 OF THIS SET FOR NCC (BCA) PARTS

PART 3.3 - SURFACE WATER DRAINAGE/EXTERNAL STEP DOWN
Provide minimum 50mm step-down to external areas

PART 3.4 - TERMITE RISK MANAGEMENT
Provide physical or chemical system (as appropriate) to AS3660.1 & BCA Part 3.4

PART 6.2 - SUBFLOOR VENTILATION
Provide subfloor openings & ground clearance (climatic zone C):
- min clearance 150mm increasing to 400mm over 2m (ground clearance)
- min 77.5mm x 17.5mm nett opening/metre (subfloor ventilation openings)

PART 7 - WALL & ROOF CLADDING
Must be compliant with BCA Part 7 & DTS provisions (BCA Vol 2 A5G3)
NOTE: Off-form concrete walls only permissible to non-habitable rooms or when used in conjunction with additional cavity construction.

PART 9 - FIRE SEPARATION
External Wall (and any openings in that wall) within 900mm of boundary - provide min 60/60/60 FRL
Separating Wall (eg duplex, terrace etc) - provide min 60/60/60 FRL (& Rw +Ctr 50+ Sound Separation system).
Separating Floor (eg secondary dwelling on top of non-ancillary garage) - provide min 30/30/30 FRL in accordance with DTS solution/approved system

PART 9.5 - SMOKE ALARMS
Provide hardwired, interconnected smoke alarms to every storey.
Predominantly located outside bedrooms protecting them from remainder of building

PART 10.2 - WET AREA WATERPROOFING
Provide floor wastes (FW) both inside and outside the shower area (unenclosed) (10.2.18).
Provide min 1:80 fall to floor wastes inside and outside shower area (10.2.12).
Detail water resistant surface materials ie, tiles (10.2.10).
Waterproofing to AS3740 or BCA Part 10.2 (choice to be made by applicant)

VOL 2 H2D8 - EXTERNAL BALCONIES
Provide min 50mm-100mm step-down to external areas (dependent on property's wind classification to be determined by project engineer) - finished internal surface to finished external surface.
Provide min 1:100 fall away from dwelling to drain (provide overflow if enclosed).
Waterproof to AS4654.1 & AS4654.2
NOTE: please provide details/technical specification of pedestal tile system or threshold strip/channel drain if proposed.

PART 10.3 - ROOM HEIGHTS
HABITABLE ROOM - minimum 2.4m.
OTHER SPACES - minimum 2.1m (including kitchen, corridor, passageway etc, bathroom, shower room, laundry, sanitary compartment, airlock, pantry, storeroom, garage, car parking area or the like).
Stairway, ramp, landing or the like - minimum 2.0m measured vertically above stairway treads nosing line or floor surface of ramp, landing or the like.
ATTIC - minimum 2.2m for at least two thirds of floor area.
NOTE: For rooms with sloping ceilings the minimum heights must be achieved for at least two thirds of the floor area (for the purposes of calculating the floor areas of a room or space, any part of that has a ceiling height of <1.5m is not included)

PART 10.4 - LAUNDRIES (incl those in cabinets & kitchens)
A dedicated laundry space comprising of at least one washbasin & space for a washing machine must be provided. Laundries shall be waterproofed to AS3740 and provided with water resistant floors (tiled), graded and drained to a floor waste.
NOTE 1: Timber is not deemed water resistant by definition under NCC/BCA provisions.
NOTE 2: A kitchen sink or washbasin must not be counted as a laundry washbasin.
NOTE 3: Mechanical ventilation is to be provided to laundries in cabinets or in rooms with no direct openings to outdoor air.
NOTE 4: No joinery will impede any water overflow path to floor waste

PART 10.6 & 10.8.2 - VENTILATION & EXHAUST SYSTEMS
For rooms with no opening to outdoor air, provide mechanical ventilation ducted to outdoor air.
- 25L/s - bathrooms and WCs
- 40L/s - kitchens and laundries

PART 11.3.7 & 11.3.8 - PROTECTION OF OPENABLE WINDOWS
BEDROOMS - where floor to surface below is >2m provide 1.7m sill height or child-safe restriction/screen (no openings >125mm).
OTHER ROOMS - where floor to surface below is >4m openable part must be protected by a sill/barrier min 865mm above FFL with no horizontal elements between 150-760mm and permanently fixed with no openings >125mm.

PART 11 - STAIRS & HANDRAILS
Provide a slip-resistant treatment to treads/nosing strip/landings to AS4586 (Dry-P3, Wet-P4) and a continuous handrail for the full length of the flight.
Riser: min 115mm - max 190mm
Going/tread: min 240mm - max 355mm
Slope Relationship (2R+G): min 550mm - max 700mm
Riser/tread dimensions to be constant for each flight

PART 11.3 - BALUSTRADES
A continuous barrier must be provided along the side of a trafficable surface where it is possible to fall 1m or more to the surface beneath.
The height of the barrier must be not less than 1m above FFL (or not less than 865mm above the nosing line for stairs).
No horizontal elements to facilitate climbing between 150mm to 760mm where floor to ground level below is >4m (solid or vertically configured only).
Openings must be constructed so that they do not permit a 125mm sphere to pass through.

ALL CONDITIONS OF CONSENT 2025/008 dated 11.04.2025 ORIGINAL DA CONSENT

FLOODING: CONDITION 7-12. BUILDING ELEMENTS, FLOOR LEVELS, FENCING, STORAGE, POOLS MUST COMPLY WITH THESE CONDITIONS

CONDITION 14. DESIGN AMENDMENTS: VEHICLE GATE IS TO BE NO HIGHER THAN 1.65m ABOVE NATURAL GROUND LEVEL AT THE FRONT BOUNDARY

CONDITION 17. ROOF COLOUR IS SELECTED AS COLORBOND SHALE GREY (MEDIUM CLASSIFICATION) and SOLAR ABSORPTANCE VALUE OF 0.44 (>0.43)

REFER TO CONDITIONS 13 & 33 OF THE CONSENT DA2025/0088 FOR STORMWATER DRAINAGE REQUIREMENTS

ALL DIMENSIONS TO BE CONFIRMED AND SURVEY PEG OUT TO BE UNDERTAKEN IN ACCORDANCE WITH THE CONDITIONS OF THE CONSENT


INTERNAL MEASUREMENTS HAVE NOT HAD A FINAL CHECK. ALL DIMENSIONS TO BE CONFIRMED ON SITE. ANY MAJOR DISCREPANCY IS TO BE ADVISED BEFORE ANY CONSTRUCTION WORK / FABRICATION IS UNDERTAKEN



LOT & DP
LOT 12; DP 12383
COUNCIL
NORTHERN BEACHES COUNCIL
MANLY

PROJECT
ALTERATIONS AND ADDITIONS:
- Ground Floor Addition; New First Floor Addition; Internal and External Modifications; Rectifications and Improvements; and Landscape Concept
2 NEW STREET EAST, BALGOWLAH NSW, 2093

CLIENT
M & N DeGARIS

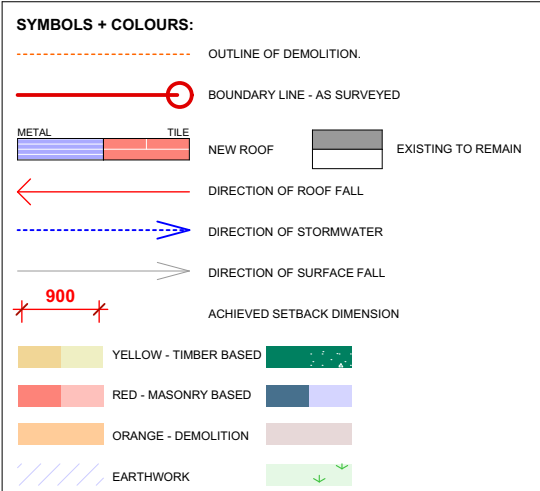

CODES, STANDARDS AND CONDITIONS TO COMPLY WITH:
NCC (National Construction Code), 2022 with the ABCB Housing Provisions
REFER TO GA-000 OF THIS SET FOR NCC (BCA) PARTS TO COMPLY WITH

A2 SIZE SHEET
1:100

DESIGNER
HARGROVES DESIGN CONSULTANTS
M: 0410 669 148
E: jacqui@hargroves.com.au


DATE: DEC 2021
SCALE: AS NOTED
DRAWN: R.P.
TITLE: **PROPOSED ROOF PLAN incl. STORMWATER CONCEPT**
Sheet No: **GA-106**
Issue: **S**

GENERAL NOTES
1. ALL DIMENSIONS, LEVELS, SEWER AND STORMWATER INVERT LEVELS AND FLOOR AREAS ARE TO BE CHECKED AND VERIFIED. ANY DISCREPANCIES ARE TO BE BROUGHT TO THE ATTENTION OF THE DESIGNER PRIOR TO THE COMMENCEMENT OF ANY BUILDING WORK.
2. DO NOT SCALE OFF DRAWINGS.

GENERAL ARRANGEMENT - FOR CONSTRUCTION

3. ALL BUILDING WORK IS TO BE DONE IN ACCORDANCE WITH THE MOST CURRENT EDITION or AS APPROVED EDITION OF THE BCA (NATIONAL CONSTRUCTION CODE), THE AUSTRALIAN STANDARDS AND CONDITIONS OF CONSENT.
4. THE INFORMATION PROVIDED ON THESE PLANS HAVE BEEN PRODUCED BASED ON THE INFORMATION PROVIDED TO US BY THE CLIENT, AND THE CLIENT'S CONSULTANTS.
5. IT IS THE RESPONSIBILITY OF THE CONTRACTOR TO HAVE ALL DIMENSIONS, LEVELS, SEWER AND STORMWATER INVERT LEVELS, UNDERGROUND AND OVERHEAD SERVICES, AND FLOOR AREAS CHECKED AND VERIFIED.
6. ANY DISCREPANCIES ARE TO BE BROUGHT TO THE ATTENTION OF THE PROJECT SUPERINTENDENT PRIOR TO THE COMMENCEMENT OF ANY BUILDING WORK or FABRICATION OF ITEMS.

Q	RP	CLIENT REQUESTED CHANGES B1 & B2 BACK ROOF AREA - INFILL EXISTING B3 & B4 ROOF CHANGES B5 ROOF CHANGES B6 ROOF CHANGES B7 ROOF CHANGES B8 ROOF CHANGES B9 ROOF CHANGES B10 ROOF CHANGES B11 ROOF CHANGES B12 ROOF CHANGES B13 ROOF CHANGES B14 ROOF CHANGES B15 ROOF CHANGES B16 ROOF CHANGES B17 ROOF CHANGES B18 ROOF CHANGES B19 ROOF CHANGES B20 ROOF CHANGES B21 ROOF CHANGES B22 ROOF CHANGES B23 ROOF CHANGES B24 ROOF CHANGES B25 ROOF CHANGES B26 ROOF CHANGES B27 ROOF CHANGES B28 ROOF CHANGES B29 ROOF CHANGES B30 ROOF CHANGES B31 ROOF CHANGES B32 ROOF CHANGES B33 ROOF CHANGES B34 ROOF CHANGES B35 ROOF CHANGES B36 ROOF CHANGES B37 ROOF CHANGES B38 ROOF CHANGES B39 ROOF CHANGES B40 ROOF CHANGES B41 ROOF CHANGES B42 ROOF CHANGES B43 ROOF CHANGES B44 ROOF CHANGES B45 ROOF CHANGES B46 ROOF CHANGES B47 ROOF CHANGES B48 ROOF CHANGES B49 ROOF CHANGES B50 ROOF CHANGES B51 ROOF CHANGES B52 ROOF CHANGES B53 ROOF CHANGES B54 ROOF CHANGES B55 ROOF CHANGES B56 ROOF CHANGES B57 ROOF CHANGES B58 ROOF CHANGES B59 ROOF CHANGES B60 ROOF CHANGES B61 ROOF CHANGES B62 ROOF CHANGES B63 ROOF CHANGES B64 ROOF CHANGES B65 ROOF CHANGES B66 ROOF CHANGES B67 ROOF CHANGES B68 ROOF CHANGES B69 ROOF CHANGES B70 ROOF CHANGES B71 ROOF CHANGES B72 ROOF CHANGES B73 ROOF CHANGES B74 ROOF CHANGES B75 ROOF CHANGES B76 ROOF CHANGES B77 ROOF CHANGES B78 ROOF CHANGES B79 ROOF CHANGES B80 ROOF CHANGES B81 ROOF CHANGES B82 ROOF CHANGES B83 ROOF CHANGES B84 ROOF CHANGES B85 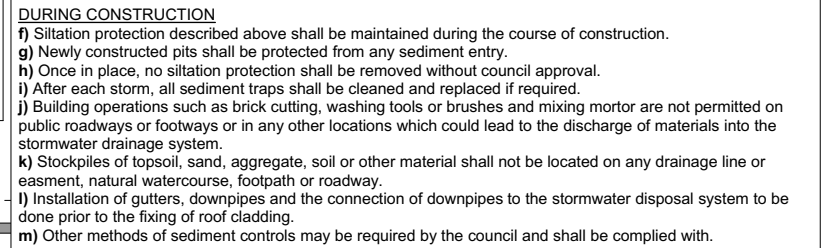[illegible]


- ALL EXTERNAL DOORS AND WINDOWS



Building Sustainability Index
www.planningportal.nsw.gov.au/development-and-assessment/basix


Certificate number: A1779439_03

- ROOF SHEETING and CAPPINGS / FLASHINGS

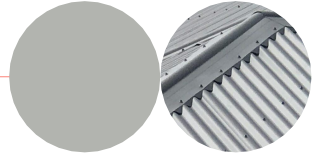

EDIM COLOUR UNDER
THE NCC (BCA)
CLASSIFICATION
SA VALUE 0.44

- ROOF PLUMBING ELEMENTS: HALF ROUND GUTTERS and ROUND DOWNPIPES

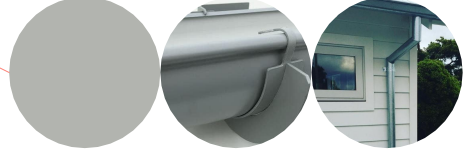

- PRIVACY SCREEN

- SOFFIT and EXPOSED RAFTER TAILS



- CLADDING and PAINTED EXTERNAL WALLS



- SCREENING, GATES AND FENCING



- PART FENCING, ANY FEATURE BATTENS




- SIDE PATHWAY, PATIO, POOL PAVEMENT and LANDSCAPE WALL CLADDING



LIMESTONE LOOK FOR COLOUR TONING


DARK TONE PEBBLES FOR DURABILITY AND RETENTION OF COLOUR

- FRONT FENCE, AND ALL OTHER EXISTING MASONRY LANDSCAPING OR FENCE WALLS (UNO


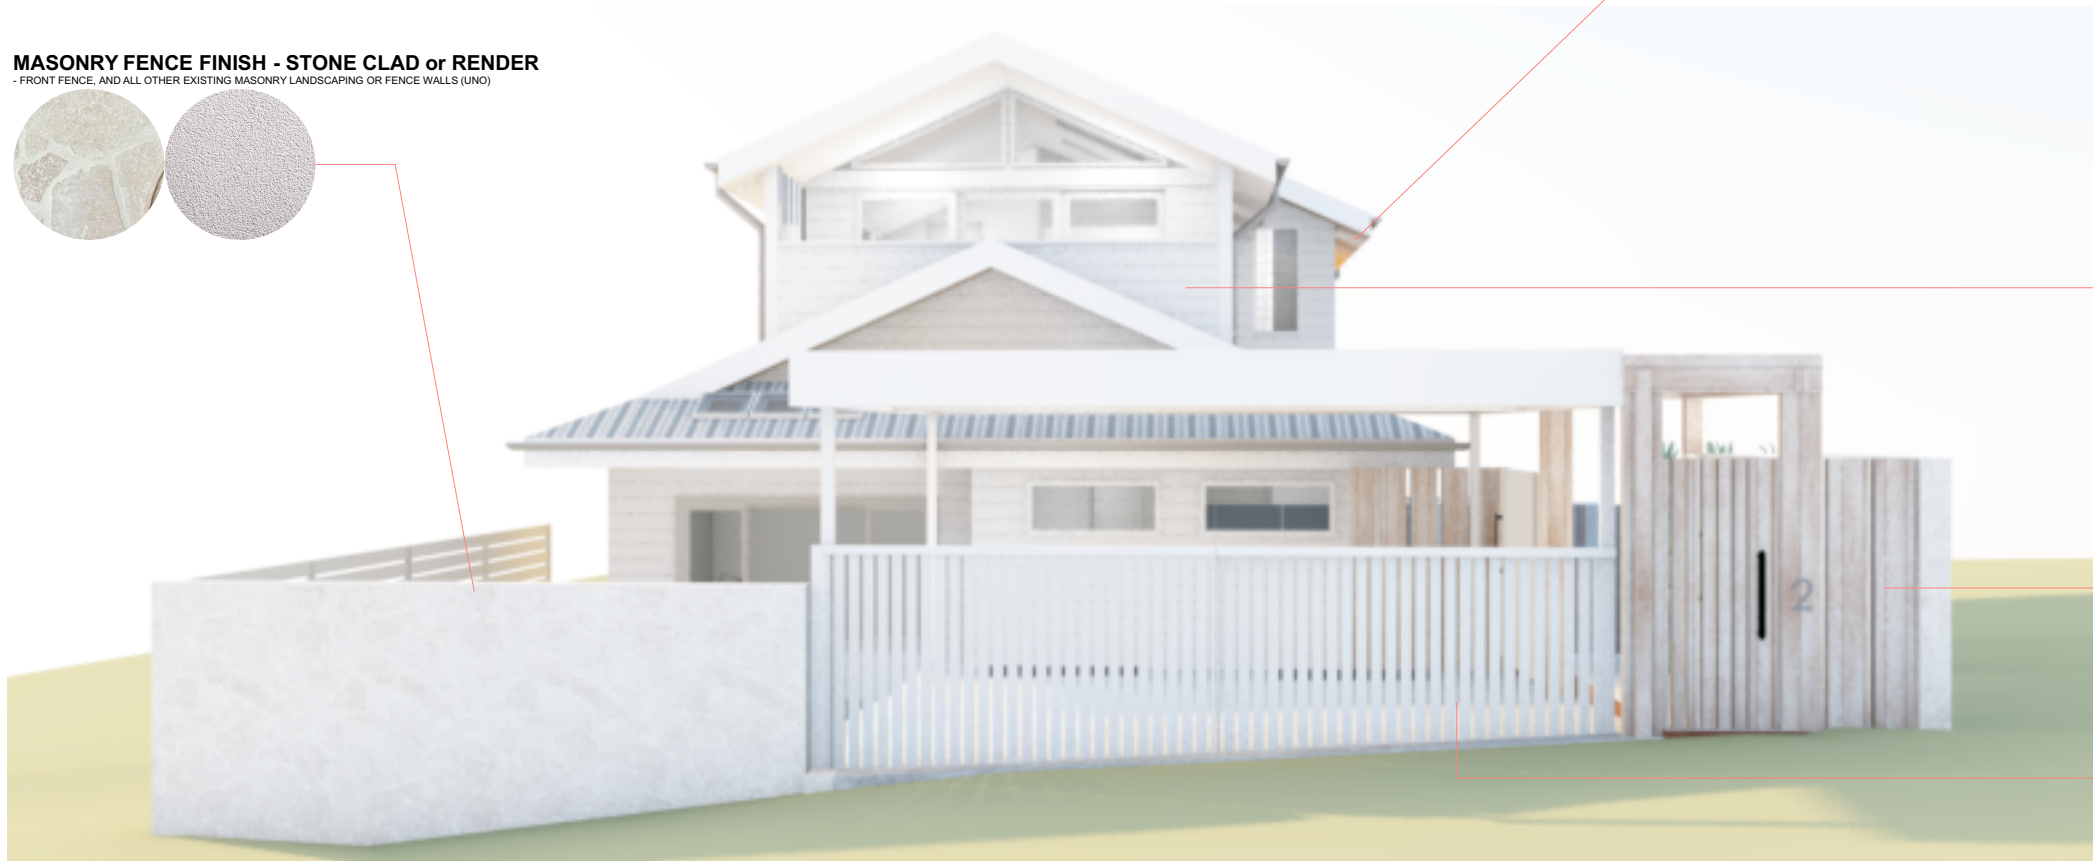


White Aluminium

CLIENT REQUESTED CHANGES W/ 1.2 MAGE HORIZONTAL - WALL EXISTING HARDWOOD CHAIRS LAMINATE KITCHEN CHAIRS AND NO BRICK COVE RETRAIL RIDGES IN GULLY CHANNELS CARPET ROOF PITCH MADE TO FALL TOWARDS HOUSE FOR SKYLIGHTS W/ 4 REMOVED			28.09.2025																																																																																																																																																																																																																																																																																																																																																																																																																																																																																																																																																																																																																																																																																																																																																																																																																																																																																																																																																																																																																																																																																																																																																																																																																																																																																																																																																																																			
--	--	--	------------	--	--	
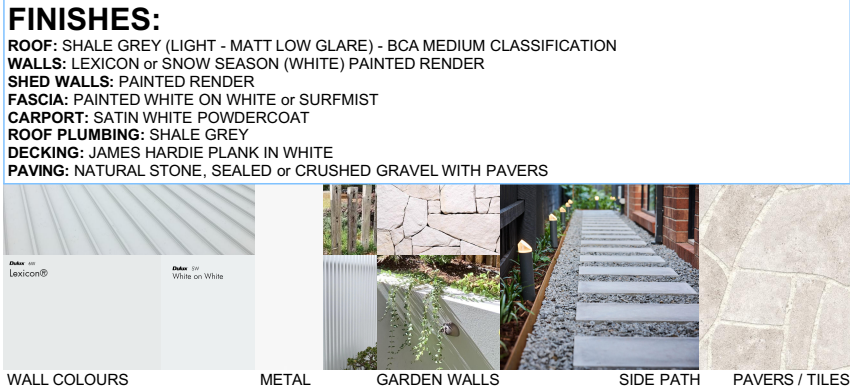

3.4.1.5 Excessive Glare or Reflectivity Nuisance:
All external material and finishes incorporated into the development must consider and mitigate any excessive glare or reflectivity nuisance.
SHALE GREY (LIGHT - MATT LOW GLARE) - BCA MEDIUM CLASSIFICATION
CONDITION 17: SOLAR ABSORPTANCE TO BE GREATER THAN 0.43. COLORBOND SHALE GREY HAS A NOMINAL SA VALUE OF 0.44

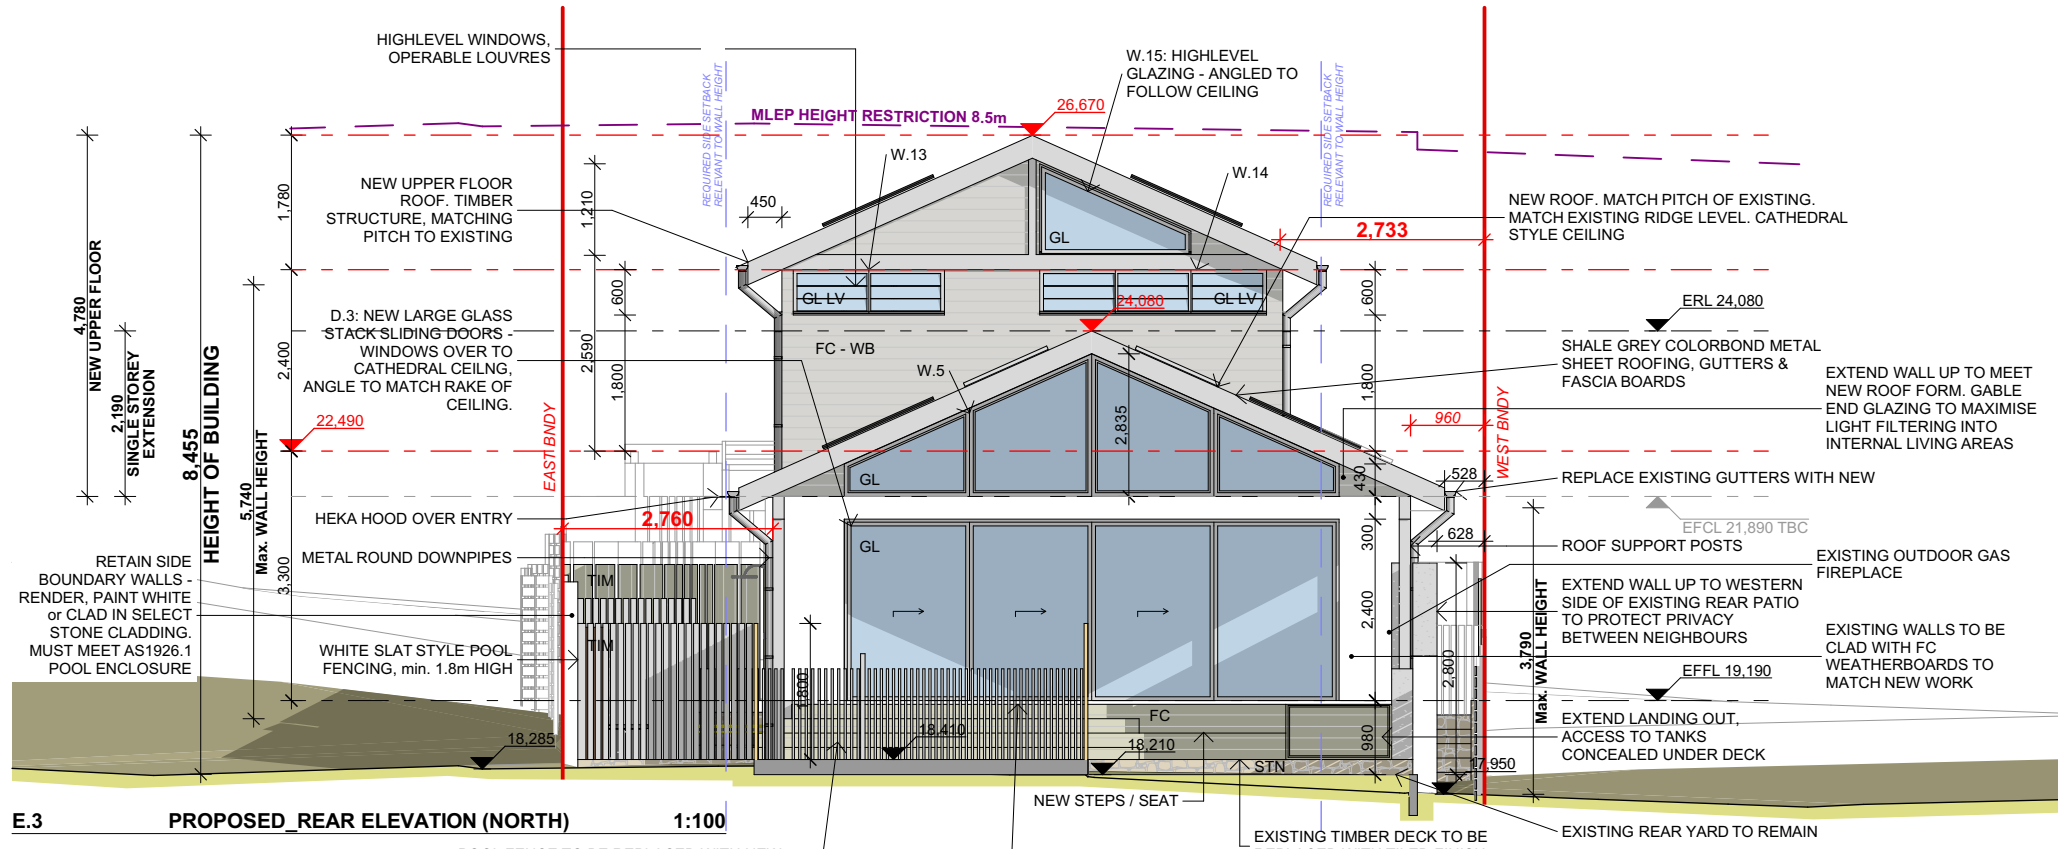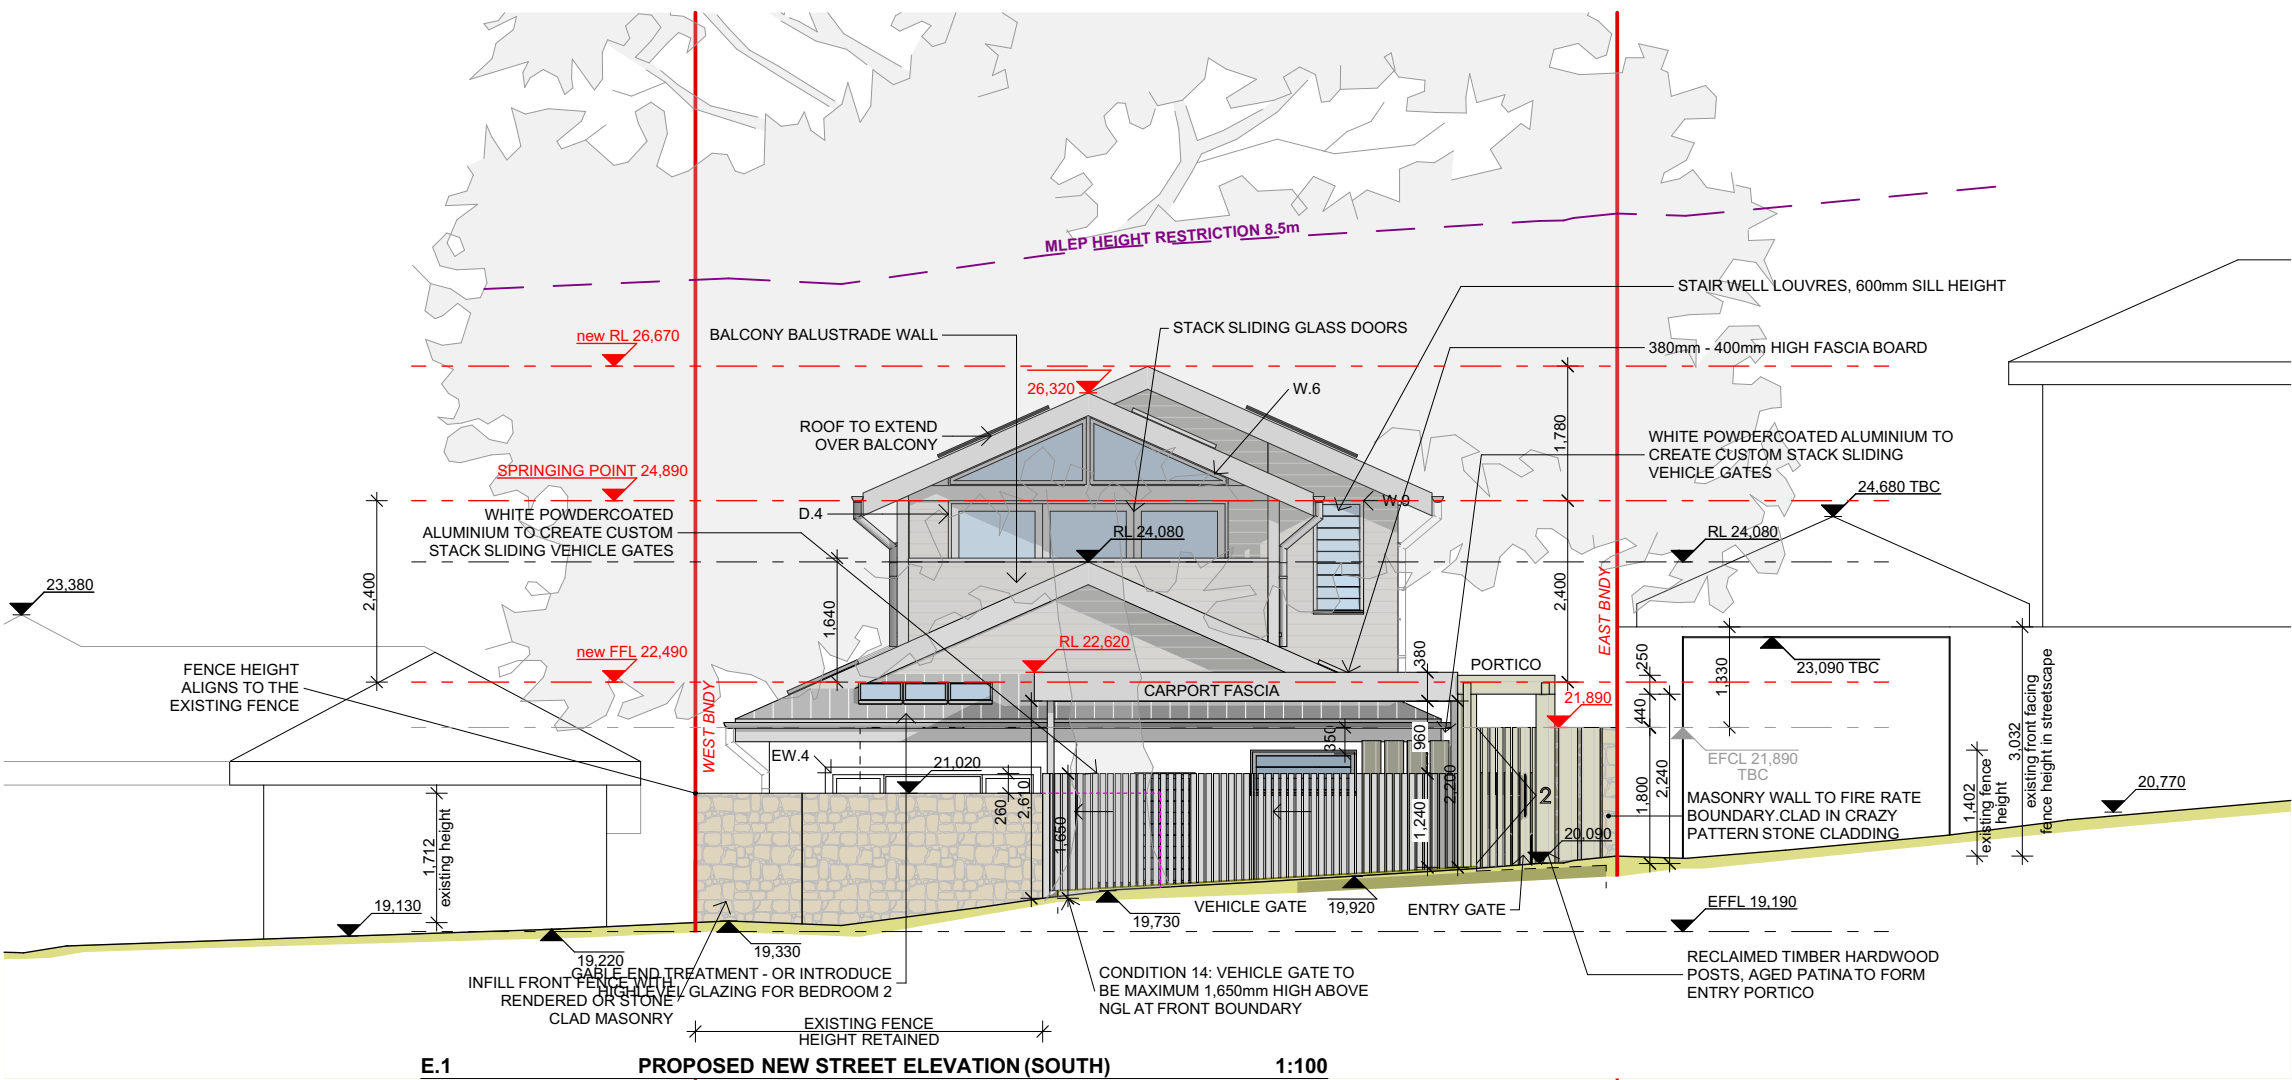

FLOODING: CONDITION 7-12. BUILDING ELEMENTS, FLOOR LEVELS, FENCING, STORAGE, POOLS MUST COMPLY WITH THESE CONDITIONS

CONDITION 17. ROOF COLOUR IS SELECTED AS COLORBOND SHALE GREY (MEDIUM CLASSIFICATION) and SOLAR ABSORPTANCE VALUE OF 0.44 (>0.43)

Architectural elevation drawing of the existing street facade from the south. The drawing shows a building with a carport and a portico. Key features include:

- Carport fascia at RL 24.080
- Portico
- Vehicle gate at RL 19.730
- Fence line at EFCL 19.190
- Existing fence heights: 1.712m and 3.052m
- Carport height: 2.020m
- Carport fascia height: 2.020m
- Carport fascia width: 21.020m
- Carport fascia depth: 20.000m
- Carport fascia area: 420.420m²
- Carport fascia volume: 840.840m³

The drawing is labeled "E.1 EXISTING NEW STREET ELEVATION (SOUTH)" and "1:100".

NCC (National Construction Code), 2022 with the ABCB Housing Provisions

NOTE 4: No joinery will impede any water overflow path to floor waste

EXISTING PO
REPLACED W

DRAWN	R.P	REAR ELEVATIONS
-------	-----	-----------------

[illegible]

A2 SIZE SHEET 1:100 

Designer
HARGROVES DESIGN CONSULTANTS
M: 0410 660 148

	M: 04 10 609 148 E: jacqui@hargroves.com.au		
	DATE	DEC 2021	TITLE
			Sheet No
			Issu

SCALE	AS NOTED @ A2	EXISTING & PROPOSED FRONT & REAR ELEVATIONS	GA-110	S
DRAWN	R.P			

GENERAL NOTES

1. ALL DIMENSIONS, LEVELS, SEWER AND STORMWATER INVERT LEVELS AND FLOOR AREAS ARE TO BE CHECKED AND VERIFIED. ANY DISCREPANCIES ARE TO BE BROUGHT TO THE ATTENTION OF THE DESIGNER PRIOR TO THE COMMENCEMENT OF ANY BUILDING WORK.

2. DO NOT SCALE OFF DRAWINGS.

3. ALL BUILDING WORK IS TO BE DONE IN ACCORDANCE WITH THE MOST CURRENT EDITION OF AS APPROVED EDITION OF THE BCA (NATIONAL CONSTRUCTION CODE), THE AUSTRALIAN STANDARDS AND CONDITIONS OF CONSENT.

4. THE INFORMATION PROVIDED ON THESE PLANS HAVE BEEN PRODUCED BASED ON THE INFORMATION PROVIDED TO US BY THE CLIENT, AND THE CLIENT'S CONSULTANTS.

5. THE RESPONSIBILITY OF THE CONTRACTOR TO HAVE ALL DIMENSIONS, LEVELS, ELEVATIONS AND STORMWATER INVERT LEVELS, UNDERGROUND AND OVERHEAD SERVICES, AND FLOOR AREAS CHECKED AND VERIFIED.





6. ANY DISCREPANCIES ARE TO BE BROUGHT TO THE ATTENTION OF THE PROJECT SUPERINTENDENT PRIOR TO THE COMMENCEMENT OF ANY BUILDING WORK OR FABRICATION OF ITEMS.

 DIAL 1100 BEFORE YOU DIG	NORTH 	LOT & DP LOT 12; DP 12383
	COPYRIGHT	COUNCIL NORTHERN BEACHES COUNCIL MANLY
THIS DESIGN AND THE ASSOCIATED DOCUMENTS ARE SUBJECT TO COPYRIGHT LAWS AND MAY NOT BE REPRODUCED IN ANY FORM WITHOUT WRITTEN CONSENT FROM HARGROVES DESIGN CONSULTANTS.		

PROJECT
ALTERATIONS and ADDITIONS:
- Ground Floor Addition; New First Floor Addition; Internal and External Modifications;
Rectifications and Improvements; and Landscape Concept
2 NEW STREET EAST, BALGOWLAH NSW, 2093


CLIENT
M & N DeGARIS

Designer HARGROVES DESIGN CONSULTANTS M: 0410 669 148 E: jacqui@hargroves.com.au			
DATE	DEC 2021	TITLE	Sheet No
SCALE	AS NOTED @ A2	EXISTING & PROPOSED FRONT & REAR ELEVATIONS	GA-110
DRAWN	R.P		

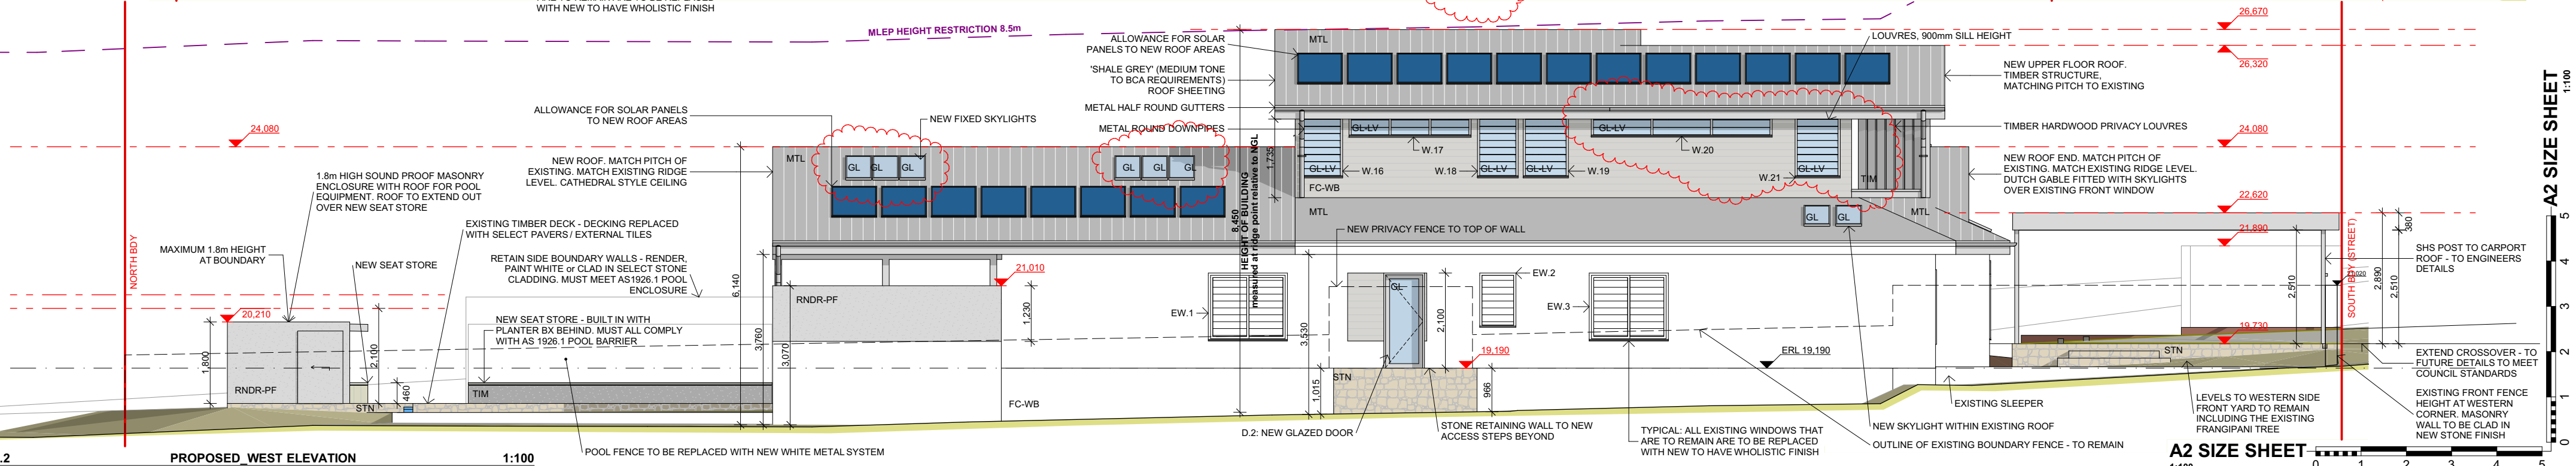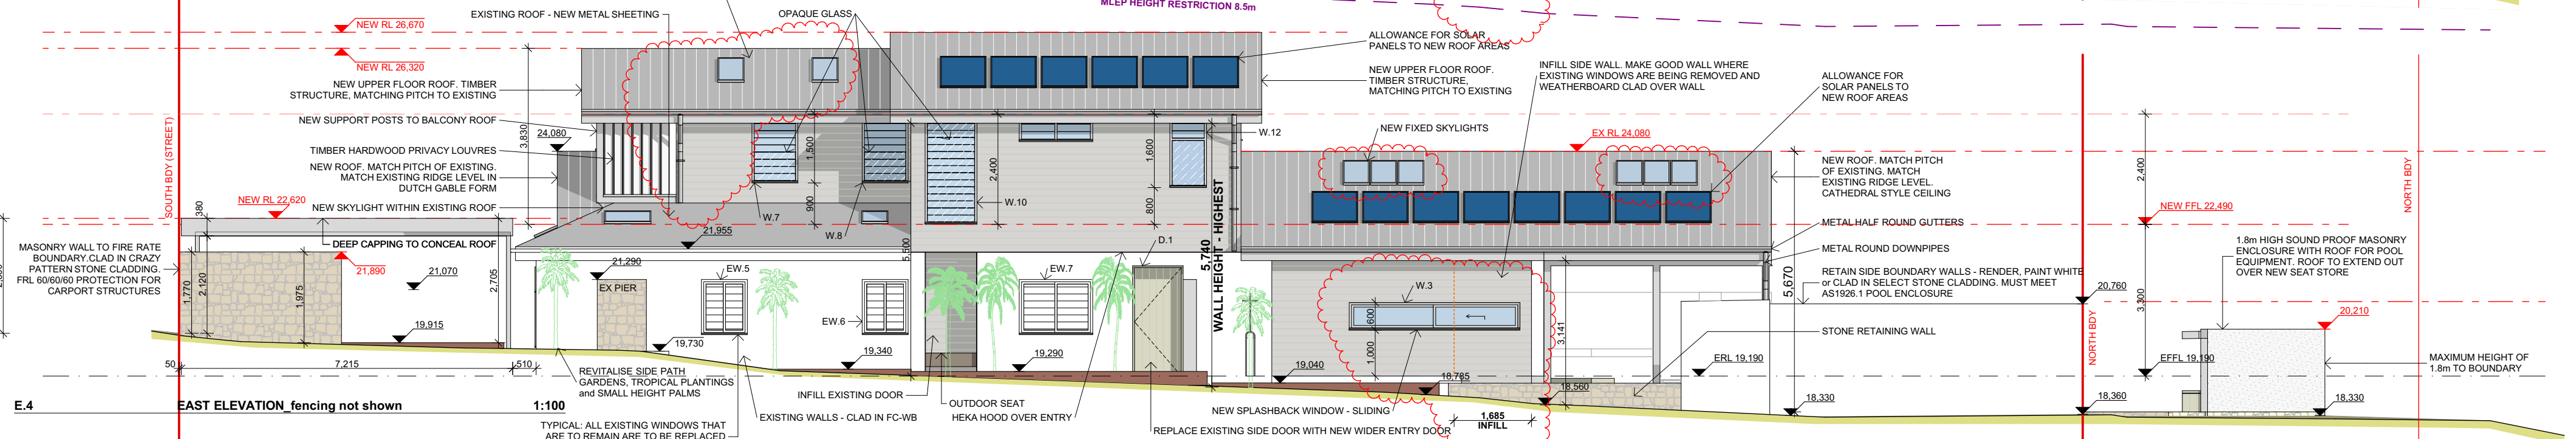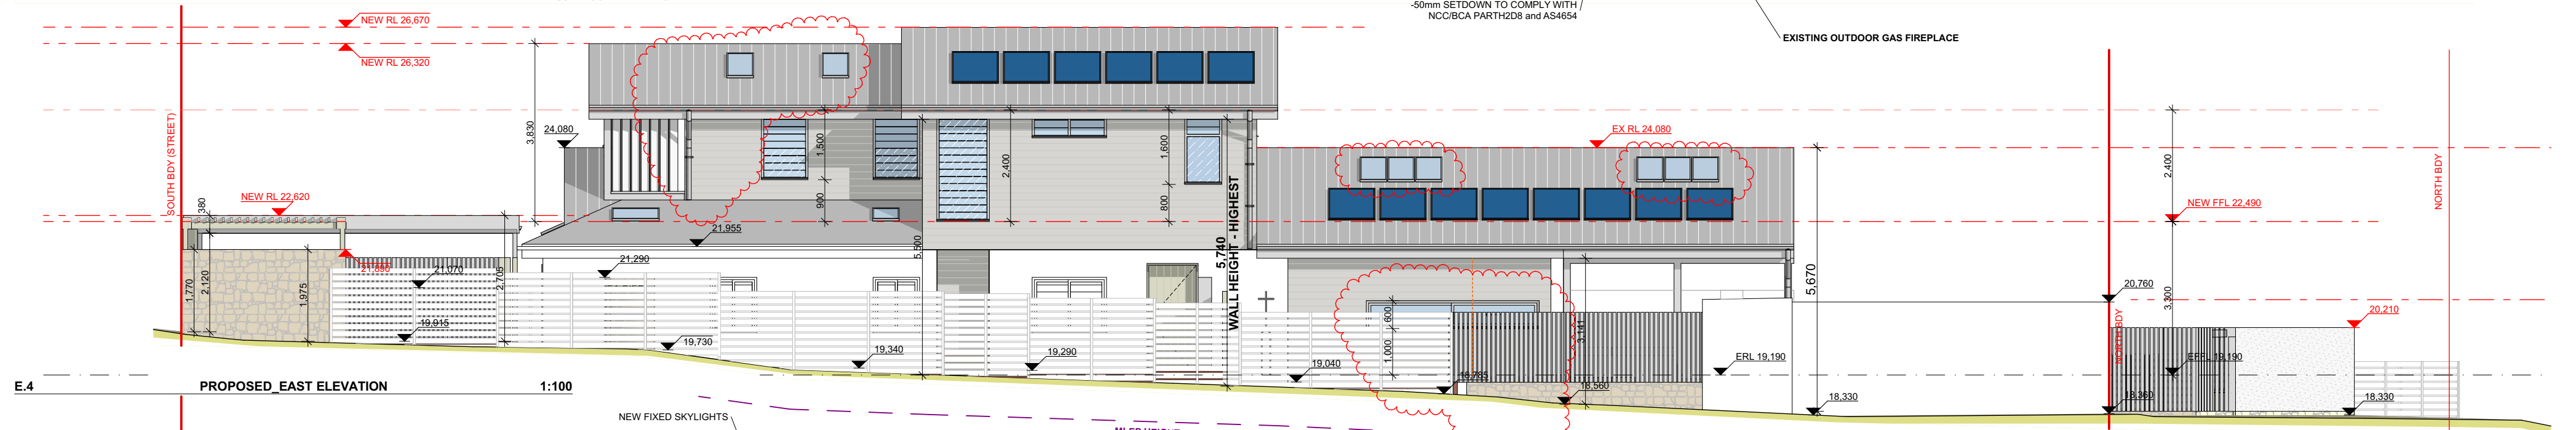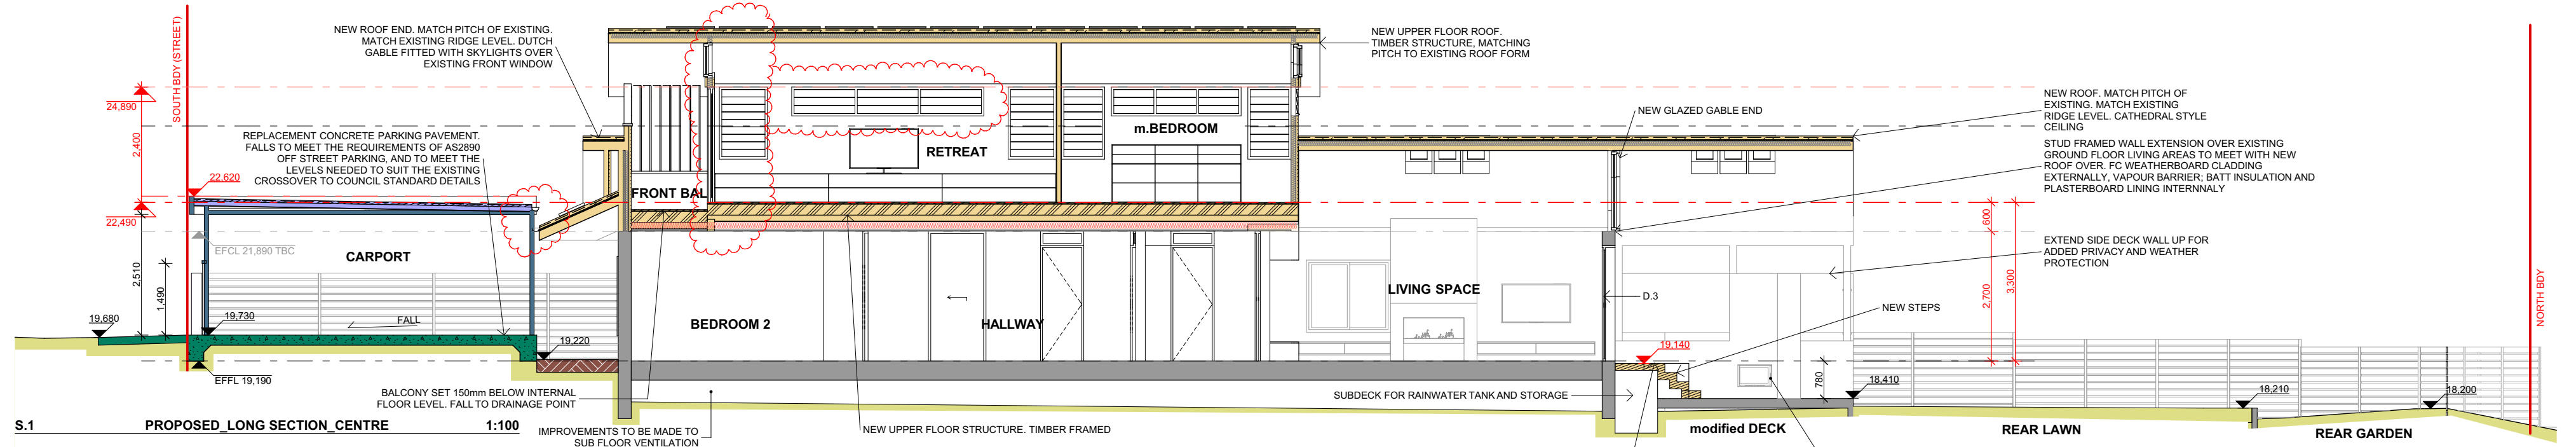


CLIENT REQUESTED CHANGES 1. 2. 3. 821. 82			
---	--	--	--

NEW STREET EAST

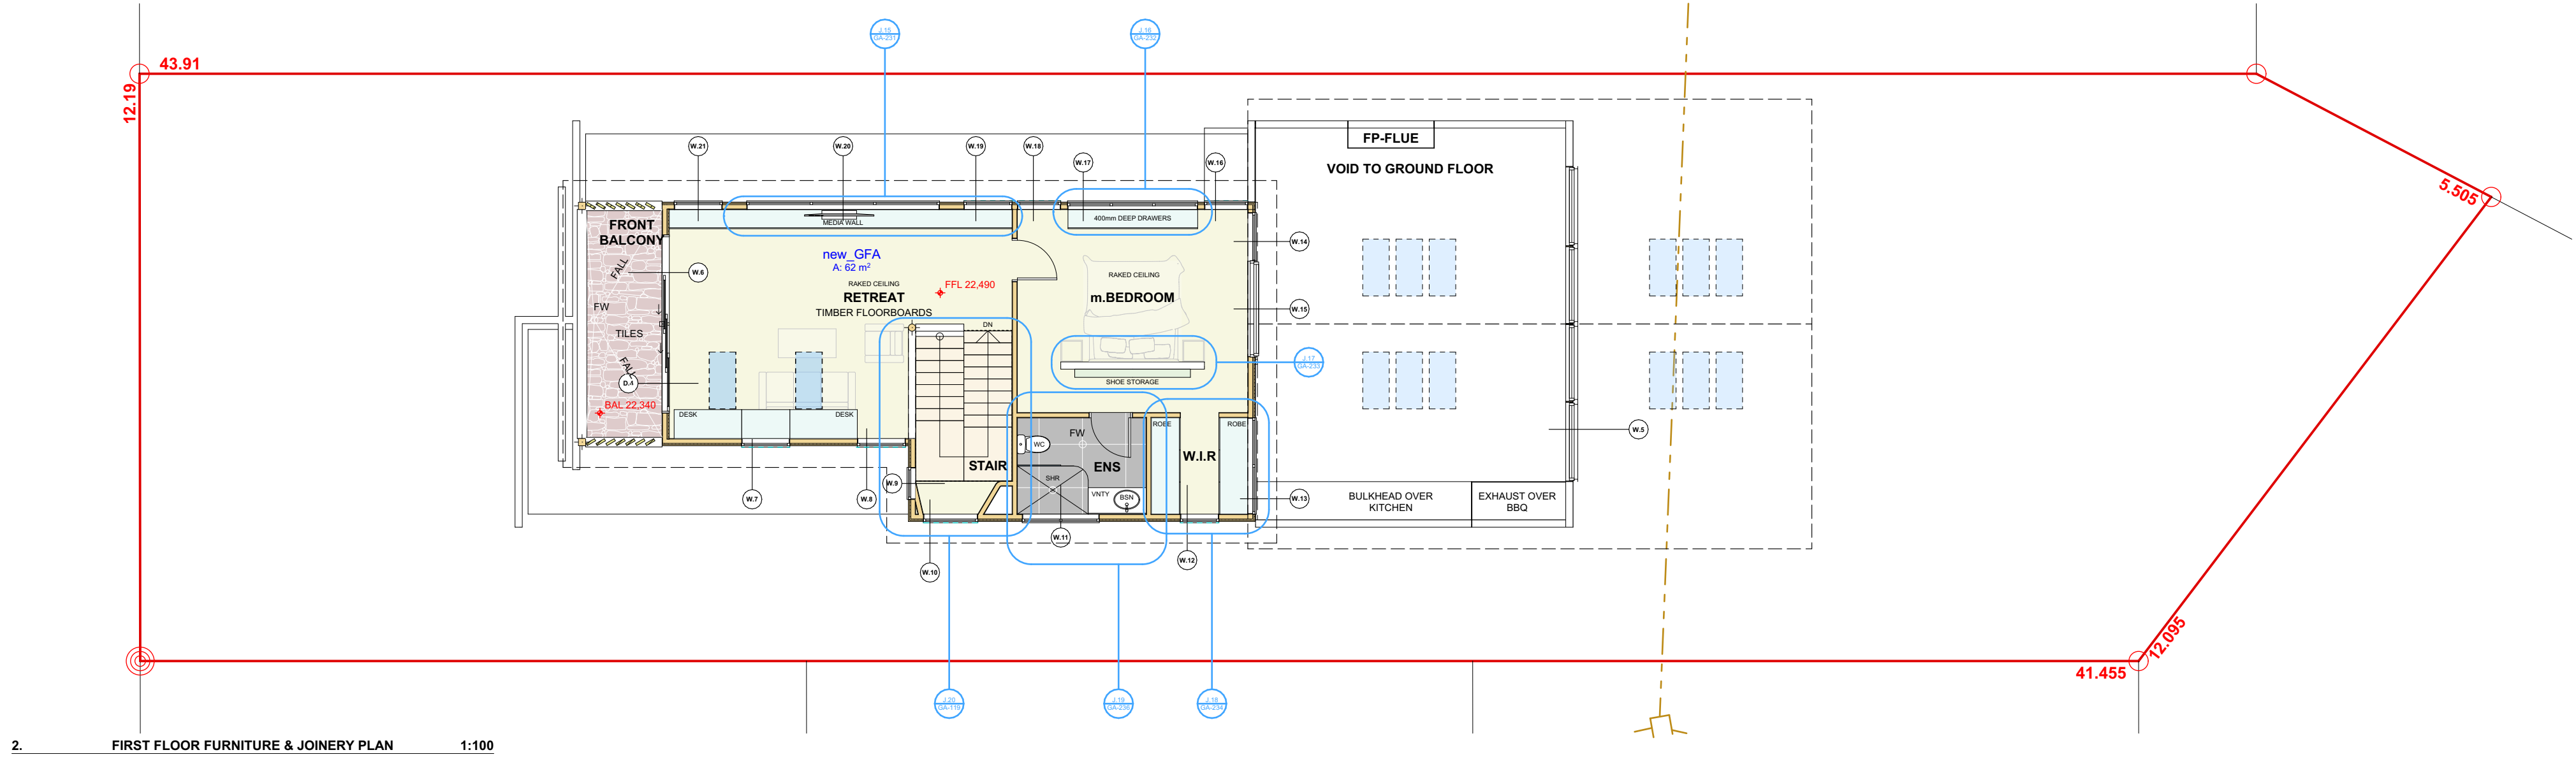

2. FIRST FLOOR FURNITURE & JOINERY PLAN 1:100

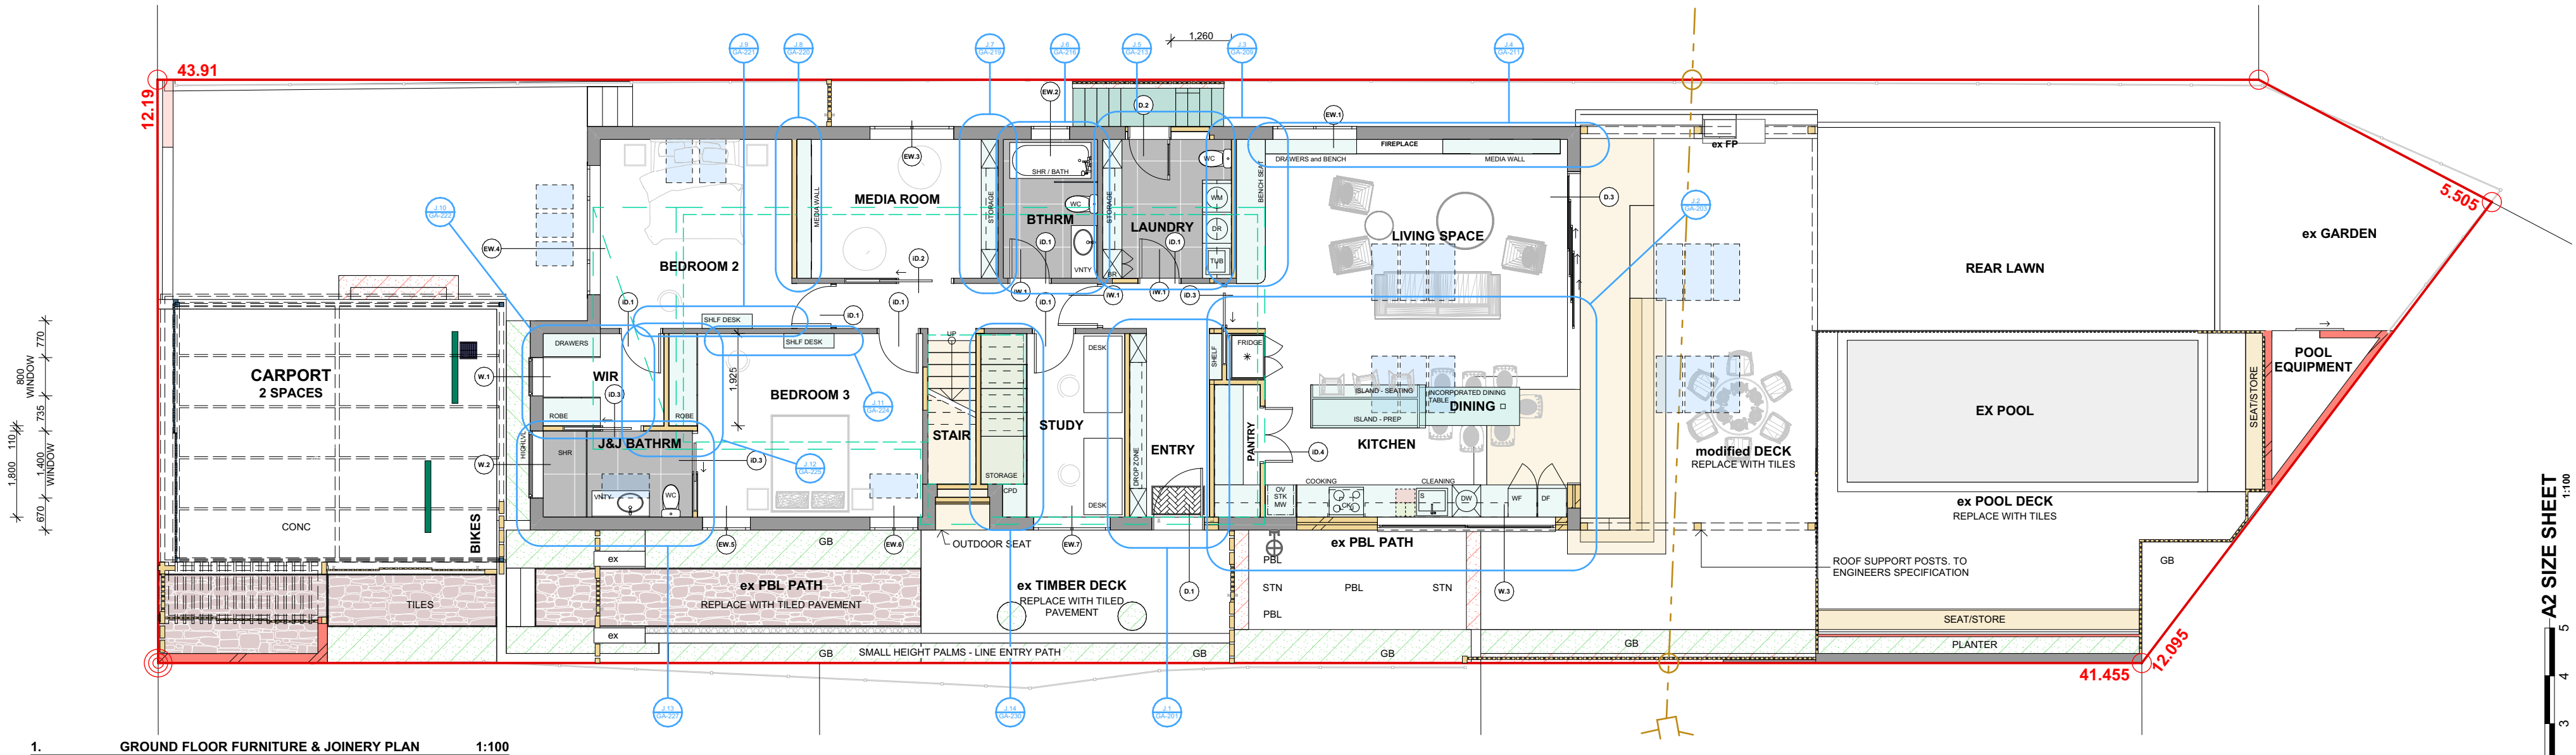

1. GROUND FLOOR FURNITURE & JOINERY PLAN 1:100

CODES, STANDARDS and CONDITIONS TO COMPLY WITH:

NCC (National Construction Code), 2022 with the ABCB Housing Provisions

REFER TO GA-000 OF THIS SET FOR NCC (BCA) PARTS TO COMPLY WITH

A2 SIZE SHEET 1:100

0 1 2 3 4 5

DESIGNER HARGROVES DESIGN CONSULTANTS

M: 0410 669 148

E: jacqui@hargroves.com.au

DATE DEC 2021 TITLE FURNITURE & JOINERY LAYOUTS

SCALE AS NOTED

DRAWN R.P.

Sheet No GA-114

Issue S

GENERAL NOTES

1. ALL DIMENSIONS, LEVELS, SEWER AND STORMWATER INVERT LEVELS AND FLOOR AREAS ARE TO BE CHECKED AND VERIFIED. ANY DISCREPANCIES ARE TO BE BROUGHT TO THE ATTENTION OF THE DESIGNER PRIOR TO THE COMMENCEMENT OF ANY BUILDING WORK.

2. DO NOT SCALE OFF DRAWINGS.

3. ALL BUILDING WORK IS TO BE DONE IN ACCORDANCE WITH THE MOST CURRENT EDITION or AS APPROVED EDITION OF THE BCA (NATIONAL CONSTRUCTION CODE), THE AUSTRALIAN STANDARDS AND CONDITIONS OF CONSENT.

4. THE INFORMATION PROVIDED ON THESE PLANS HAVE BEEN PRODUCED BASED ON THE INFORMATION PROVIDED TO US BY THE CLIENT, AND THE CLIENT'S CONSULTANTS.

5. IT IS THE RESPONSIBILITY OF THE CONTRACTOR TO HAVE ALL DIMENSIONS, LEVELS, SEWER AND STORMWATER INVERT LEVELS, UNDERGROUND AND OVERHEAD SERVICES, AND FLOOR AREAS CHECKED AND VERIFIED.

6. ANY DISCREPANCIES ARE TO BE BROUGHT TO THE ATTENTION OF THE PROJECT SUPERINTENDENT PRIOR TO THE COMMENCEMENT OF ANY BUILDING WORK or FABRICATION OF ITEMS.

GENERAL ARRANGEMENT

- FOR CONSTRUCTION



NORTH

LOT 12; DP 12383

COUNCIL NORTHERN BEACHES COUNCIL

MANLY

CLIENT M & N DeGARIS

PROJECT ALTERATIONS and ADDITIONS:

- Ground Floor Addition; New First Floor Addition; Internal and External Modifications; Rectifications and Improvements; and Landscape Concept

2 NEW STREET EAST, BALGOWLAH NSW, 2093

THIS DESIGN AND THE ASSOCIATED DOCUMENTS ARE SUBJECT TO COPYRIGHT LAWS AND MAY NOT BE REPRODUCED IN ANY FORM WITHOUT WRITTEN CONSENT FROM HARGROVES DESIGN CONSULTANTS

Copyright

THIS DESIGN AND THE ASSOCIATED DOCUMENTS ARE SUBJECT TO COPYRIGHT LAWS AND MAY NOT BE REPRODUCED IN ANY FORM WITHOUT WRITTEN CONSENT FROM HARGROVES DESIGN CONSULTANTS

Copyright


THIS DESIGN AND THE ASSOCIATED DOCUMENTS ARE SUBJECT TO COPYRIGHT LAWS AND MAY NOT BE REPRODUCED IN ANY FORM WITHOUT WRITTEN CONSENT FROM HARGROVES DESIGN CONSULTANTS

Copyright


THIS DESIGN AND THE ASSOCIATED DOCUMENTS ARE SUBJECT TO COPYRIGHT LAWS AND MAY NOT BE REPRODUCED IN ANY FORM WITHOUT WRITTEN CONSENT FROM HARGROVES DESIGN CONSULTANTS

Copyright

PRELIMINARY - FOR DISCUSSION

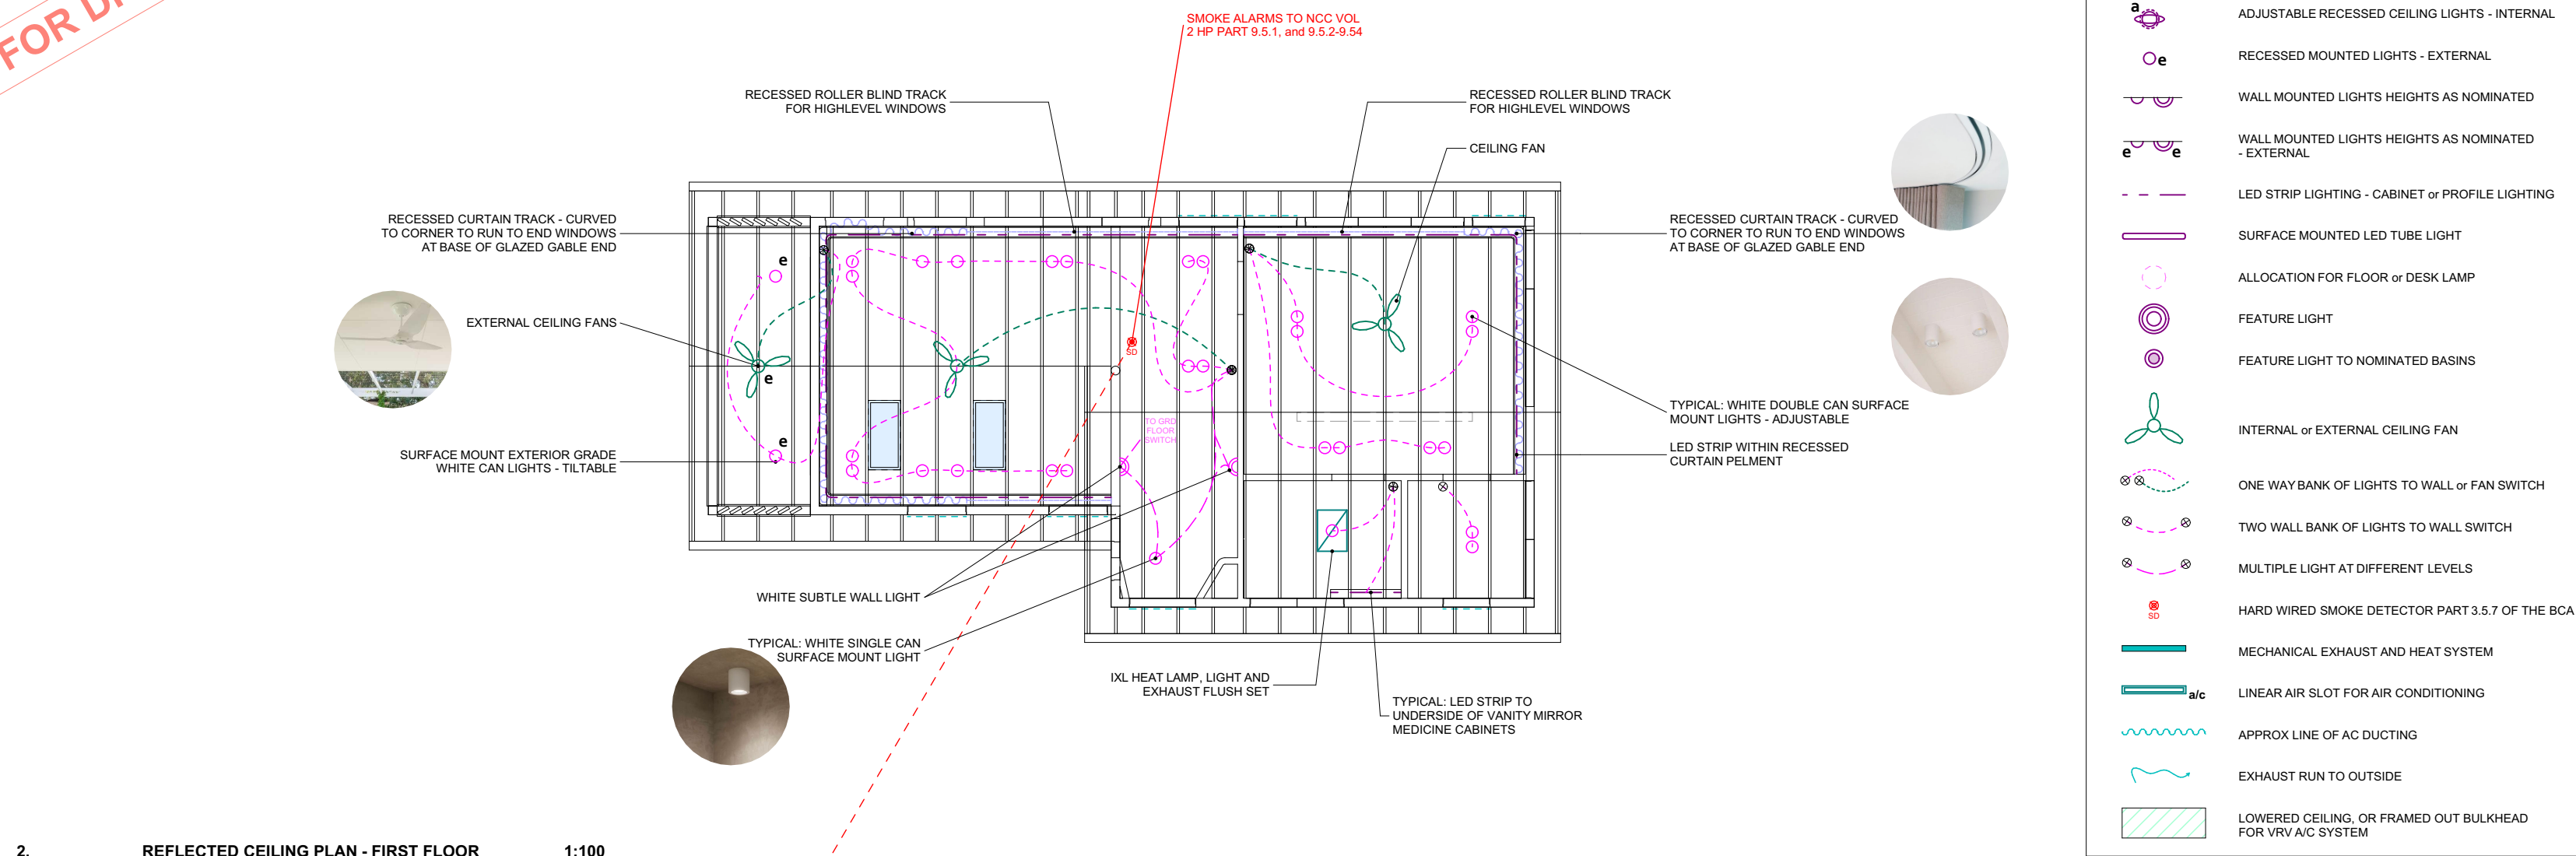

- | |
|--|
| <p>ALLOW FOR SECURITY SYSTEM - INDICATIVE PLAN FOR CONTRACTOR ALLOWANCES</p> |
| <p>CEILING & ELECTRICAL NOTES:</p> <ol style="list-style-type: none">1. ALLOW FOR NEW LINEAR GRILL A/C OUTLETS TO CEILING OF UPPER FLOOR - DUCTED A/C WITH EXTERNAL COMPRESSOR.2. PROVIDE NEW INSULATION TO CEILINGS - BETWEEN FLOORS ALLOW min. R3.0 ROCKWOOL BATTS; TO CEILING AT ROOF AREA, min. HIGH PERFORMANCE 150mm THICK GOLD CEILING BATTS. RONDO SHADOWLINE CORNICE THROUGHOUT3. THE LIGHTING & ELECTRICAL LAYOUT IS INDICATIVE FOR PRICING PURPOSES. FINAL LAYOUT AND EXTENT OF FITTINGS IS TO BE CO-ORDINATED ON SITE WITH THE INTERIOR DESIGNER.4. EXISTING CEILINGS TO REMAIN WHERE POSSIBLE - ALLOW FOR NEW PAINT FINISH.5. WHERE CEILING IS TO BE ALTERED BY NEW WORKS, ALLOW FOR ALL REPAIRS, PATCHING AND MAKING GOOD TO ALL SURFACES TO MATCH THE EXISTING, INCLUDING CORNICES and TRIMS.6. ALL EXISTING LIGHT FITTINGS TO BE UPDATED - CONFIRM NUMBER ON SITE7. ALL LIGHTS TO BE DIMMABLE |
| <p>AIR CONDITIONING NOTES:</p> <ol style="list-style-type: none">1. VRV AC GRILLES ABOVE ROBES THROUGHOUT, UNLESS NOTED OTHERWISE OR IF ROBE SPACE DOES NOT ALLOW. |
| <p>HOT WATER UNIT:</p> <ol style="list-style-type: none">1. REPLACE EXISTING HOT WATER UNIT WITH A GAS INSTANTANEOUS UNIT TO EXTERIOR OF KITCHEN WALL, RECESS AND LOCKABLE UNIT |
| <p>THESE PLANS MUST BE READ IN CONJUNCTION WITH JOINERY / WET ROOM DETAILS FOR LED STRIP LOCATIONS/SIZES, AS WELL AS ELECTRICAL REQUIREMENTS</p> |
| <p>AIR PURIFICATION:</p> <ol style="list-style-type: none">1. INSTALL PREMIUM AIR PURIFICATION SYSTEM TO DUCTED AIR CONDITIONING ON BOTH LEVELS |

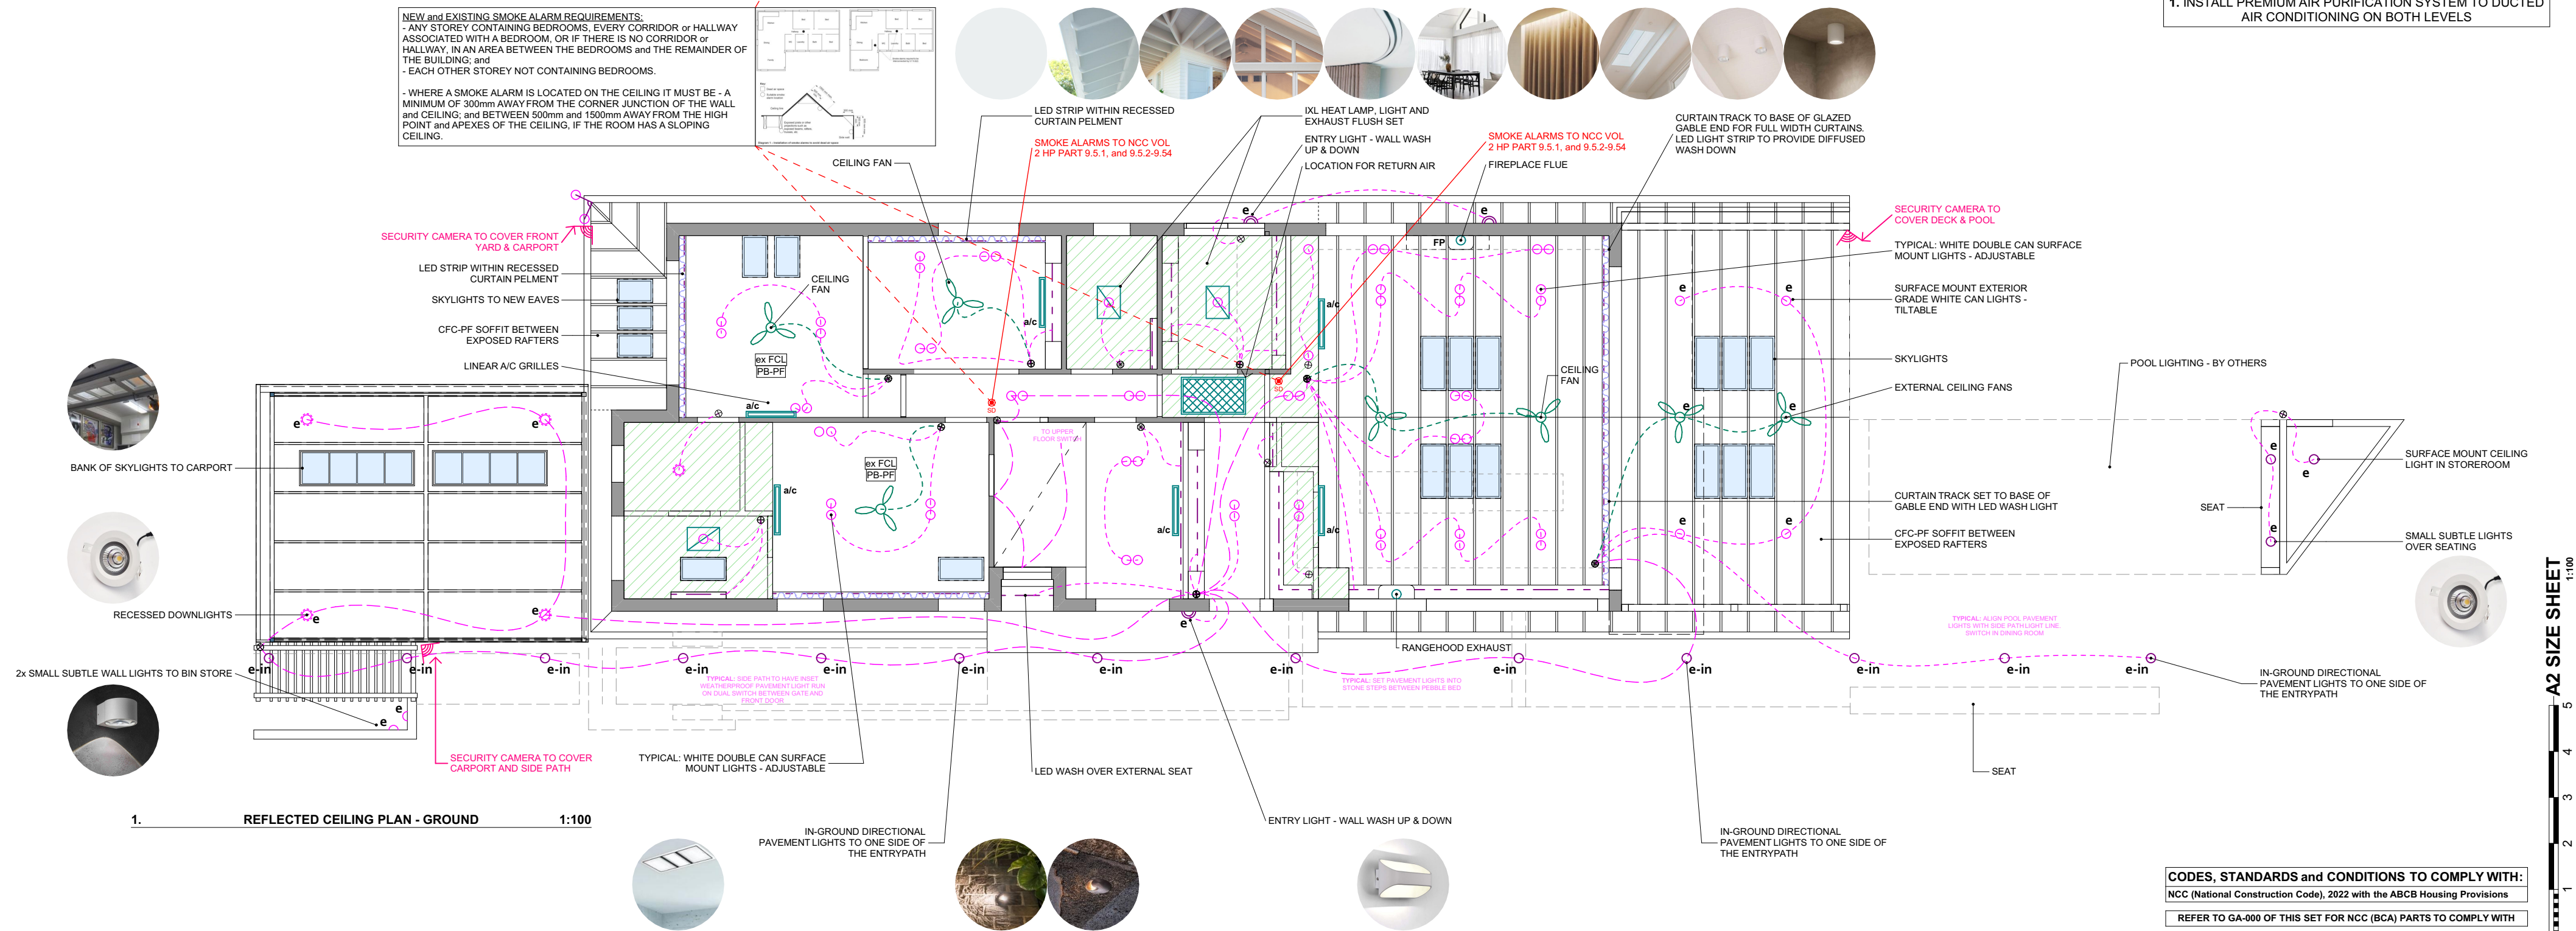

CODES, STANDARDS and CONDITIONS TO COMPLY WITH:
NCC (National Construction Code), 2022 with the ABCB Housing Provisions
REFER TO GA-000 OF THIS SET FOR NCC (BCA) PARTS TO COMPLY WITH

A2 SIZE SHEET 0 1 2 3 4 5
1:100

Designer HARGROVES DESIGN CONSULTANT M: 0410 669 141 E: jacqui@hargroves.com.au			
DATE	DEC 2021	TITLE	Sheet No
SCALE	AS NOTED @ A2	REFLECTED CEILING PLANS	GA-115
DRAWN	R.P		

Q	RP	CLIENT REQUESTED CHANGES W/ 1.5 MACK ROW-LED, R/FALL EXISTING BOLTS & WOOD CHANGES LAUNDRY CHANGE BANK REMOVED STITCH CHANGES AND 10 BRG ALLOWED RETREAT DOGGER / BALCONY SMALLER FLOORING CHANGES GARAGE DOOR PITCH MADE TO FALL TOWARDS HOUSE FOR SKYLIGHTS WE REMOVED	26.09.2025				
P	RP	GENERAL ARRANGEMENT FOR CONSTRUCTION - CC SUBMISSION	14.07.2025	S	RP	UPDATED WINDOW SCHEDULE	01.10.2025
P	RP	GENERAL ARRANGEMENT FOR CONSTRUCTION - CC SUBMISSION	30.06.2025	R	RP	UPDATED DOOR AND WINDOW SCHEDULES	30.09.2025
ISSUE	BY	DESCRIPTION	DATE	ISSUE	BY	DESCRIPTION	DATE

GENERAL NOTES


1. ALL DIMENSIONS, LEVELS, SEWER AND STORMWATER INVERT LEVELS AND FLOOR AREA ARE TO BE CHECKED AND VERIFIED. ANY DISCREPANCIES ARE TO BE BROUGHT TO THE ATTENTION OF THE DESIGNER PRIOR TO THE COMMENCEMENT OF ANY BUILDING WORK.
2. DO NOT SCALE OFF DRAWINGS.

3. ALL BUILDING WORK IS TO BE DONE IN ACCORDANCE WITH THE MOST CURRENT EDITION or AS APPROVED EDITION OF THE BCA (NATIONAL CONSTRUCTION CODE), THE AUSTRALIAN STANDARDS AND CONDITIONS OF CONSENT.

4. THE INFORMATION PROVIDED ON THESE PLANS HAVE BEEN PRODUCED BASED ON THE INFORMATION PROVIDED TO US BY THE CLIENT, AND THE CLIENT'S CONSULTANTS.

5. IT IS THE RESPONSIBILITY OF THE CONTRACTOR TO HAVE ALL DIMENSIONS, LEVELS, GRADES AND DRAINAGE INVERT LEVELS, UNDERGROUND AND OVERHEAD SERVICES, AND FLOOR AREAS CHECKED AND VERIFIED.

6. ANY DISCREPANCIES ARE TO BE BROUGHT TO THE ATTENTION OF THE PROJECT SUPERINTENDENT PRIOR TO THE COMMENCEMENT OF ANY BUILDING WORK or FABRICATION OF ITEMS.

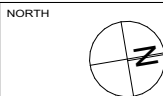

COPYRIGHT

THIS DESIGN AND THE ASSOCIATED DOCUMENTS ARE SUBJECT TO COPYRIGHT LAWS AND MAY NOT BE REPRODUCED IN ANY FORM WITHOUT WRITTEN CONSENT FROM HARGROVES DESIGN CONSULTANTS.

LOT & DP LOT 12; DP 12383
COUNCIL NORTHERN BEACHES COUNCIL MANLY

PROJECT

ALTERATIONS and ADDITIONS:

- Ground Floor Addition; New First Floor Addition; Internal and External Modifications Rectifications and Improvements; and Landscape Concept


2 NEW STREET EAST, **BALGOWLAH NSW, 2093**

CLIENT
M & N DeGARIS


PRELIMINARY - FOR DISCUSSION

12.19

43.91

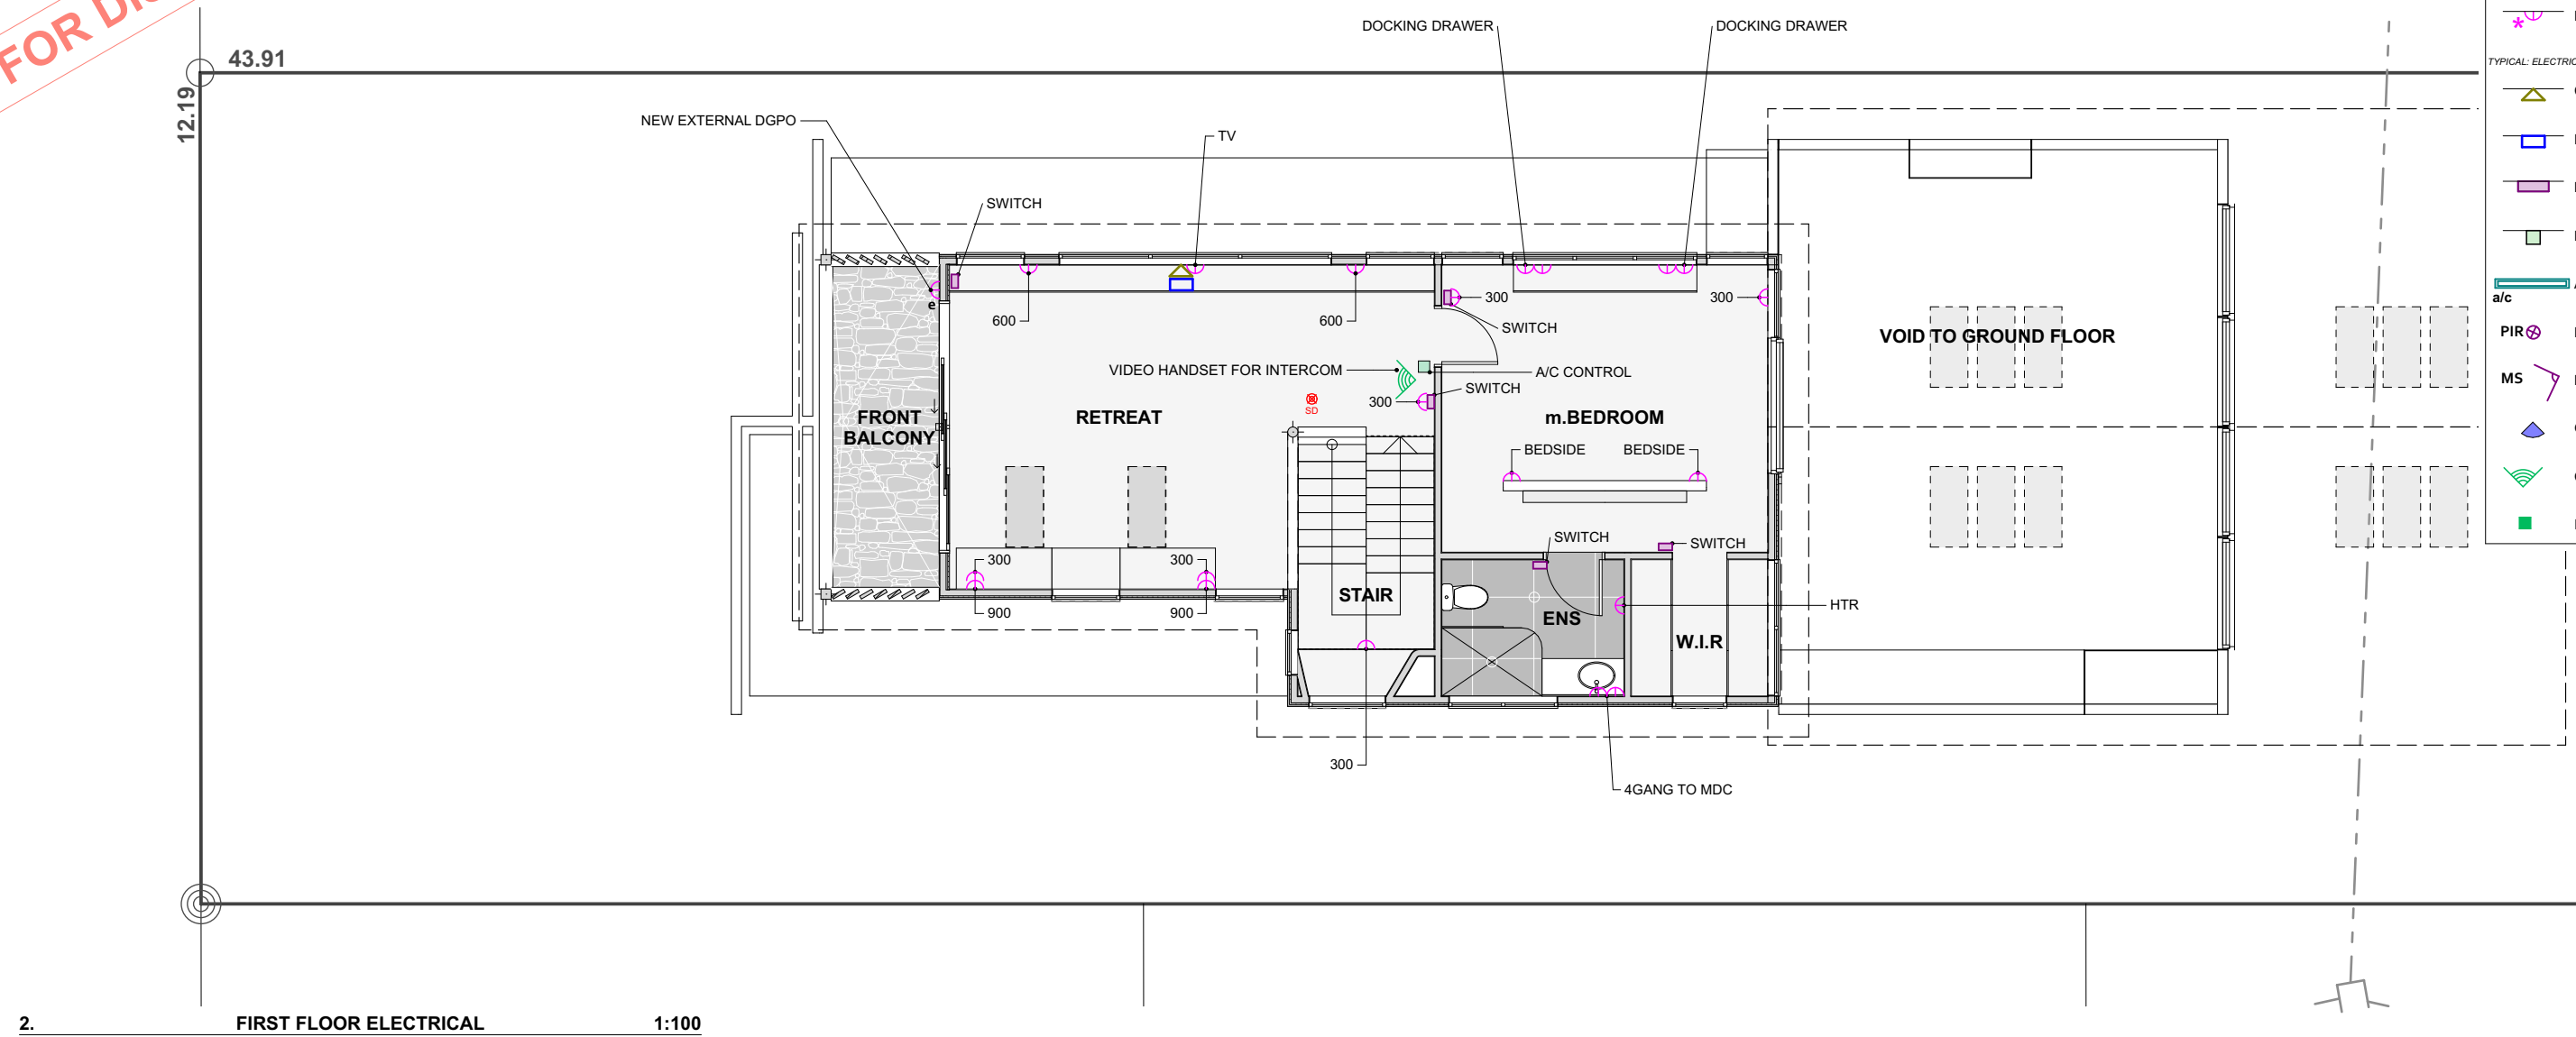

- | | |
|---|--|
| ALLOW FOR SECURITY SYSTEM - INDICATIVE PLAN FOR CONTRACTOR ALLOWANCES | |
| CEILING & ELECTRICAL NOTES: | |
| 1. ALLOW FOR NEW LINEAR GRILL A/C OUTLETS TO CEILING OF UPPER FLOOR - DUCTED A/C WITH EXTERNAL COMPRESSOR. | |
| 2. PROVIDE NEW INSULATION TO CEILINGS - BETWEEN FLOORS ALLOW min. R3.0 ROCKWOOL BATTS; TO CEILING AT ROOF AREA, min. HIGH PERFORMANCE 150mm THICK GOLD CEILING BATTS. RONDO SHADOWLINE CORNICE THROUGHOUT | |
| 3. THE LIGHTING & ELECTRICAL LAYOUT IS INDICATIVE FOR PRICING PURPOSES. FINAL LAYOUT and EXTENT OF FITTINGS IS TO BE CO-ORDINATED ON SITE WITH THE INTERIOR DESIGNER. | |
| 4. EXISTING CEILINGS TO REMAIN WHERE POSSIBLE - ALLOW FOR NEW PAINT FINISH. | |
| 5. WHERE CEILING IS TO BE ALTERED BY NEW WORKS, ALLOW FOR ALL REPAIRS, PATCHING AND MAKING GOOD TO ALL SURFACES TO MATCH THE EXISTING, INCLUDING CORNICES and TRIMS. | |
| 6. ALL EXISTING LIGHT FITTINGS TO BE UPDATED - CONFIRM NUMBER ON SITE | |
| 7. ALL LIGHTS TO BE DIMMABLE | |
| AIR CONDITIONING NOTES: | |
| 1. VRV AC GRILLES ABOVE ROBES THROUGHOUT, UNLESS NOTED OTHERWISE OR IF ROBE SPACE DOES NOT ALLOW. | |
| HOT WATER UNIT: | |
| 1. REPLACE EXISTING HOT WATER UNIT WITH A GAS INSTANTANEOUS UNIT TO EXTERIOR OF KITCHEN WALL, RECESS AND LOCKABLE UNIT | |
| THESE PLANS MUST BE READ IN CONJUNCTION WITH JOINERY / WET ROOM DETAILS FOR LED STRIP LOCATIONS/SIZES, AS WELL AS ELECTRICAL REQUIREMENTS | |
| SKYLIGHTS and ANY HIGH LEVEL GLAZING: | |
| ALLOW FOR ELECTRIC BLINDS TO ALL SKYLIGHTS or HIGHLEVEL, UNACCESSIBLE GLAZING - INCLUDE POWER and SWITCHES FOR EACH | |

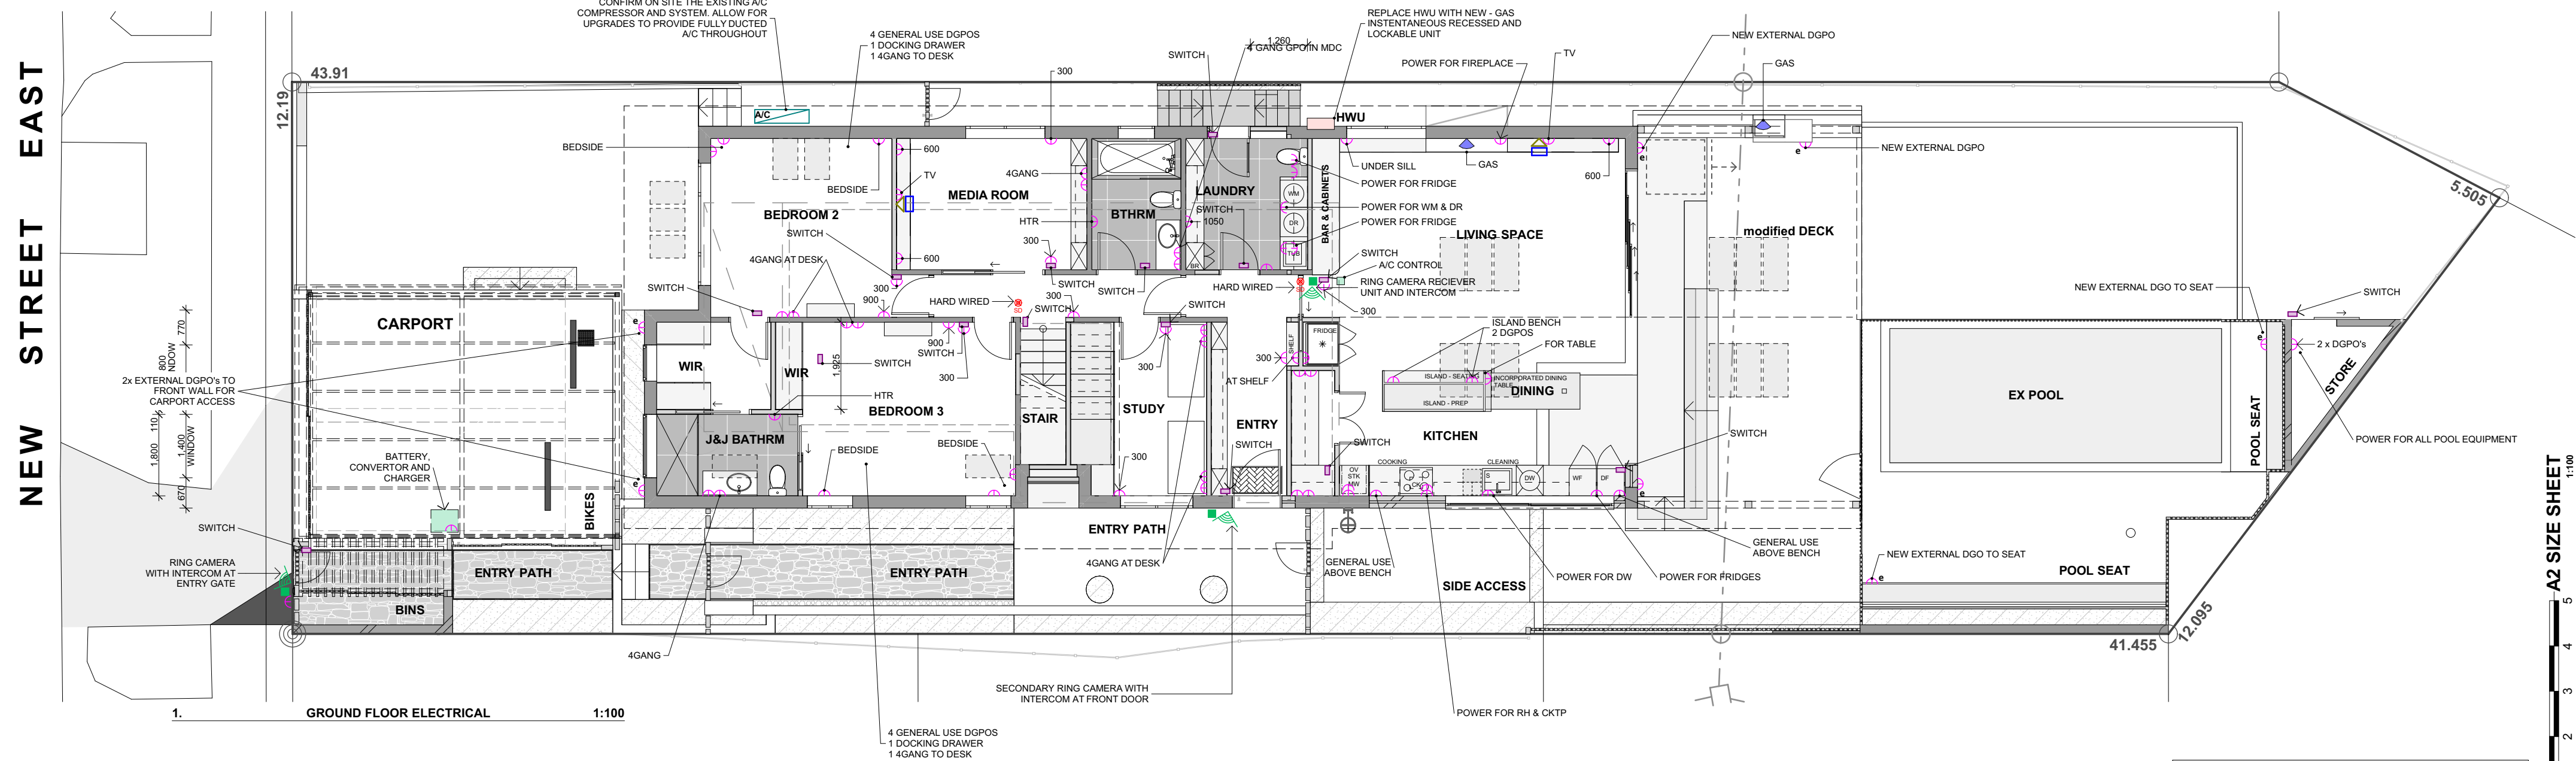

CODES, STANDARDS and CONDITIONS TO COMPLY WITH:

NCC (National Construction Code), 2022 with the ABCB Housing Provisions

REFER TO GA-000 OF THIS SET FOR NCC (BCA) PARTS TO COMPLY WITH

A2 SIZE SHEET 1:100 

Designer HARGROVES DESIGN CONSULTANT M: 0410 669 141 E: jacqui@hargroves.com.au			
DATE	DEC 2021	TITLE	Sheet No
SCALE	AS NOTED @ A2	ELECTRICAL PLAN - GROUND & FIRST FLOOR	GA-116
DRAWN	R.P		

Q	RP	CLIENT REQUESTED CHANGES W/1.3 MADE MOVE/ELEV. - RPTFLY EXTERIOR RSLA.3 FIBRE CHANGES LAUNDRY CHANGES BANK REMOVED W/1.3.1.2.3.4.5.6.7.8.9.10.11.12.13.14.15.16.17.18.19.20.21.22.23.24.25.26.27.28.29.30.31.32.33.34.35.36.37.38.39.40.41.42.43.44.45.46.47.48.49.50.51.52.53.54.55.56.57.58.59.60.61.62.63.64.65.66.67.68.69.70.71.72.73.74.75.76.77.78.79.80.81.82.83.84.85.86.87.88.89.90.91.92.93.94.95.96.97.98.99.100.101.102.103.104.105.106.107.108.109.110.111.112.113.114.115.116.117.118.119.120.121.122.123.124.125.126.127.128.129.130.131.132.133.134.135.136.137.138.139.140.141.142.143.144.145.146.147.148.149.150.151.152.153.154.155.156.157.158.159.160.161.162.163.164.165.166.167.168.169.170.171.172.173.174.175.176.177.178.179.180.181.182.183.184.185.186.187.188.189.190.191.192.193.194.195.196.197.198.199.200.201.202.203.204.205.206.207.208.209.210.211.212.213.214.215.216.217.218.219.220.221.222.223.224.225.226.227.228.229.230.231.232.233.234.235.236.237.238.239.240.241.242.243.244.245.246.247.248.249.250.251.252.253.254.255.256.257.258.259.260.261.262.263.264.265.266.267.268.269.270.271.272.273.274.275.276.277.278.279.280.281.282.283.284.285.286.287.288.289.290.291.292.293.294.295.296.297.298.299.300.301.302.303.304.305.306.307.308.309.310.311.312.313.314.315.316.317.318.319.320.321.322.323.324.325.326.327.328.329.330.331.332.333.334.335.336.337.338.339.340.341.342.343.344.345.346.347.348.349.350.351.352.353.354.355.356.357.358.359.360.361.362.363.364.365.366.367.368.369.370.371.372.373.374.375.376.377.378.379.380.381.382.383.384.385.386.387.388.389.390.391.392.393.394.395.396.397.398.399.400.401.402.403.404.405.406.407.408.409.410.411.412.413.414.415.416.417.418.419.420.421.422.423.424.425.426.427.428.429.430.431.432.433.434.435.436.437.438.439.440.441.442.443.444.445.446.447.448.449.450.451.452.453.454.455.456.457.458.459.460.461.462.463.464.465.466.467.468.469.470.471.472.473.474.475.476.477.478.479.480.481.482.483.484.485.486.487.488.489.490.491.492.493.494.495.496.497.498.499.500.501.502.503.504.505.506.507.508.509.510.511.512.513.514.515.516.517.518.519.520.521.522.523.524.525.526.527.528.529.530.531.532.533.534.535.536.537.538.539.540.541.542.543.544.545.546.547.548.549.550.551.552.553.554.555.556.557.558.559.560.561.562.563.564.565.566.567.568.569.570.571.572.573.574.575.576.577.578.579.580.581.582.583.584.585.586.587.588.589.590.591.592.593.594.595.596.597.598.599.600.601.602.603.604.605.606.607.608.609.610.611.612.613.614.615.616.617.618.619.620.621.622.623.624.625.626.627.628.629.630.631.632.633.634.635.636.637.638.639.640.641.642.643.644.645.646.647.648.649.650.651.652.653.654.655.656.657.658.659.660.661.662.663.664.665.666.667.668.669.670.671.672.673.674.675.676.677.678.679.680.681.682.683.684.685.686.687.688.689.690.691.692.693.694.695.696.697.698.699.700.701.702.703.704.705.706.707.708.709.710.711.712.713.714.715.716.717.718.719.720.721.722.723.724.725.726.727.728.729.730.731.732.733.734.735.736.737.738.739.740.741.742.743.744.745.746.747.748.749.750.751.752.753.754.755.756.757.758.759.760.761.762.763.764.765.766.767.768.769.770.771.772.773.774.775.776.777.778.779.780.781.782.783.784.785.786.787.788.789.790.791.792.793.794.795.796.797.798.799.800.801.802.803.804.805.806.807.808.809.810.811.812.813.814.815.816.817.818.819.820.821.822.823.824.825.826.827.828.829.830.831.832.833.834.835.836.837.838.839.840.841.842.843.844.845.846.847.848.849.850.851.852.853.854.855.856.857.858.859.860.861.862.863.864.865.866.867.868.869.870.871.872.873.874.875.876.877.878.879.880.881.882.883.884.885.886.887.888.889.890.891.892.893.894.895.896.897.898.899.900.901.902.903.904.905.906.907.908.909.910.911.912.913.914.915.916.917.918.919.920.921.922.923.924.925.926.927.928.929.930.931.932.933.934.935.936.937.938.939.940.941.942.943.944.945.946.947.948.949.950.951.952.953.954.955.956.957.958.959.960.961.962.963.964.965.966.967.968.969.970.971.972.973.974.975.976.977.978.979.980.981.982.983.984.985.986.987.988.989.990.991.992.993.994.995.996.997.998.999.1000.1001.1002.1003.1004.1005.1006.1007.1008.1009.1010.1011.1012.1013.1014.1015.1016.1017.1018.1019.1020.1021.1022.1023.1024.
---	----	---


GENERAL NOTES 1. ALL DIMENSIONS, LEVELS, SEWER AND STORMWATER INVERT LEVELS AND FLOOR AREAS ARE TO BE CHECKED AND VERIFIED. ANY DISCREPANCIES ARE TO BE BROUGHT TO THE ATTENTION OF THE DESIGNER PRIOR TO THE COMMENCEMENT OF ANY BUILDING WORK. 2. DO NOT SCALE OFF DRAWINGS.	
GENERAL ARRANGEMENT - FOR CONSTRUCTION	

3. ALL BUILDING WORK IS TO BE DONE IN ACCORDANCE WITH THE MOST CURRENT EDITION OF AS APPROVED EDITION OF THE BCA (NATIONAL CONSTRUCTION CODE), THE AUSTRALIAN STANDARDS AND CONDITIONS OF CONSENT.

4. THE INFORMATION PROVIDED ON THESE PLANS HAVE BEEN PRODUCED BASED ON THE INFORMATION PROVIDED TO US BY THE CLIENT, AND THE CLIENT'S CONSULTANTS.

5. IT IS THE RESPONSIBILITY OF THE CONTRACTOR TO HAVE ALL DIMENSIONS, LEVELS, SEWER AND STORMWATER INVERT LEVELS, UNDERGROUND AND OVERHEAD SERVICES, AND FLOOR AREAS CHECKED AND VERIFIED.

6. ANY DISCREPANCIES ARE TO BE BROUGHT TO THE ATTENTION OF THE PROJECT SUPERINTENDENT PRIOR TO THE COMMENCEMENT OF ANY BUILDING WORK OR FABRICATION OF ITEMS.

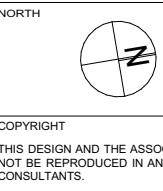

	LOT & DP
	LOT 12; DP 12383
	COUNCIL
	NORTHERN BEACHES COUNCIL
	MANLY

CIATED DOCUMENTS ARE SUBJECT TO COPYRIGHT LAWS AND MAY
Y FORM WITHOUT WRITTEN CONSENT FROM HARGROVES DESIGN

PROJECT
ALTERATIONS and ADDITIONS:
- Ground Floor Addition; New First Floor Addition; Internal and External Modifications;
Rectifications and Improvements; and Landscape Concept
2 NEW STREET EAST, BALGOWLAH NSW, 2093


CLIENT
M & N DeGARIS

PRELIMINARY - FOR DISCUSSION

SOLAR NOTES:
ALLOW TO INSTALL SOLAR BATTERY, SOLAR CONVERTOR,
METER AND CAR CHARGING POINT WITHIN CARPORT

max. ALLOWANCE FOR
ROOF SOLAR PANELS

NEW STREET EAST

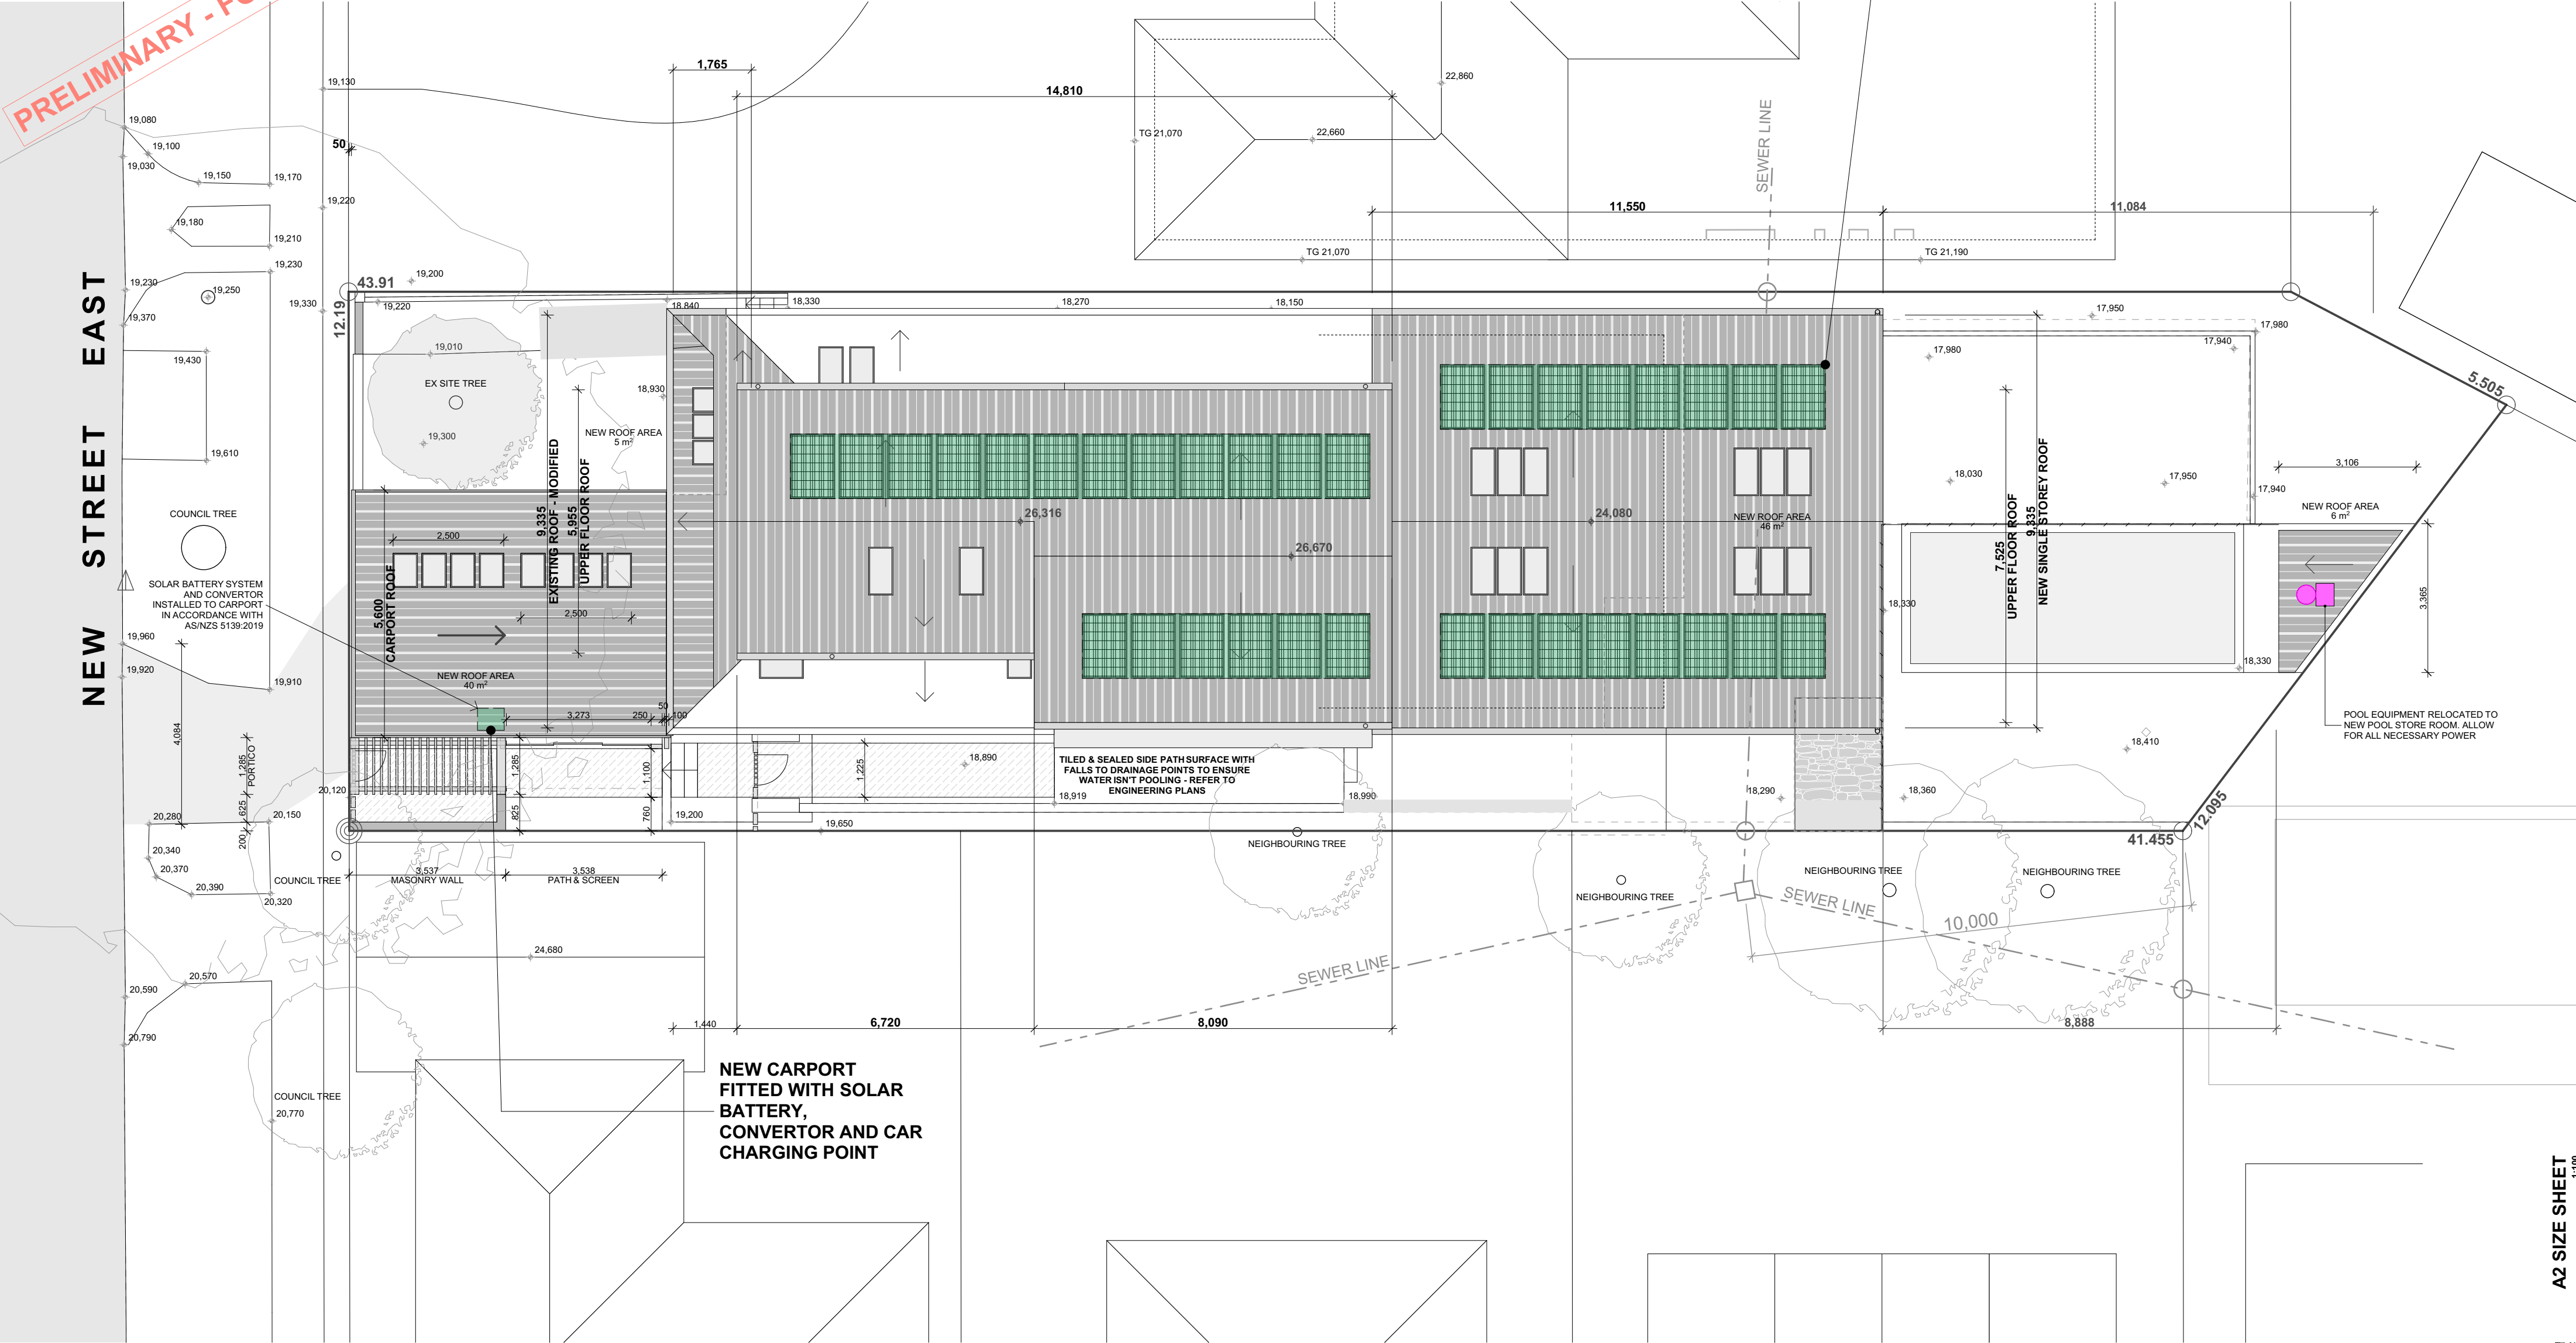

4. PROPOSED ROOF PLAN 1:100

NEW CARPORT
FITTED WITH SOLAR
BATTERY,
CONVERTOR AND CAR
CHARGING POINT

TILED & SEALED SIDE PATH SURFACE WITH
FALLS TO DRAINAGE POINTS TO ENSURE
WATER ISN'T POOLING - REFER TO
ENGINEERING PLANS

POOL EQUIPMENT RELOCATED TO
NEW POOL STORE ROOM. ALLOW
FOR ALL NECESSARY POWER

GENERAL NOTES

1. ALL DIMENSIONS, LEVELS, SEWER AND STORMWATER INVERT LEVELS AND FLOOR AREAS ARE TO BE CHECKED AND VERIFIED. ANY DISCREPANCIES ARE TO BE BROUGHT TO THE ATTENTION OF THE DESIGNER PRIOR TO THE COMMENCEMENT OF ANY BUILDING WORK.
2. DO NOT SCALE OFF DRAWINGS.

3. ALL BUILDING WORK IS TO BE DONE IN ACCORDANCE WITH THE MOST CURRENT EDITION or AS APPROVED EDITION OF THE BCA (NATIONAL CONSTRUCTION CODE), THE AUSTRALIAN STANDARDS and CONDITIONS OF CONSENT.
4. THE INFORMATION PROVIDED ON THESE PLANS HAVE BEEN PRODUCED BASED ON THE INFORMATION PROVIDED TO US BY THE CLIENT, and THE CLIENT'S CONSULTANTS.
5. IT IS THE RESPONSIBILITY OF THE CONTRACTOR TO HAVE ALL DIMENSIONS, LEVELS, SEWER AND STORMWATER INVERT LEVELS, UNDERGROUND and OVERHEAD SERVICES, and FLOOR AREAS CHECKED AND VERIFIED.
6. ANY DISCREPANCIES ARE TO BE BROUGHT TO THE ATTENTION OF THE PROJECT SUPERINTENDENT PRIOR TO THE COMMENCEMENT OF ANY BUILDING WORK or FABRICATION OF ITEMS.



NORTH



LOT & DP

LOT 12; DP 12383
COUNCIL:
NORTHERN BEACHES COUNCIL
MANLY

PROJECT

ALTERATIONS and ADDITIONS:
- Ground Floor Addition; New First Floor Addition; Internal and External Modifications; Rectifications and Improvements; and Landscape Concept
2 NEW STREET EAST, BALGOWLAH NSW, 2093

CLIENT

M & N DeGARIS

CODES, STANDARDS and CONDITIONS TO COMPLY WITH:
NCC (National Construction Code), 2022 with the ABCB Housing Provisions

REFER TO GA-000 OF THIS SET FOR NCC (BCA) PARTS TO COMPLY WITH

A2 SIZE SHEET 1:100

Designer
HARGROVES DESIGN CONSULTANTS

M: 0410 669 148
E: jacqui@hargroves.com.au

DATE: DEC 2021 TITLE: ELECTRICAL PLAN - ROOF LEVEL

SCALE: AS NOTED DRAWN: R.P.

Sheet No: GA-117

Issue: S



**STAIR TO BE BUILT IN ACCORDANCE WITH THE NCC (BCA) 2022
FFL - FFL PROPOSED AT 3,300mm (CONFIRM ON SITE)
18 RISERS @ 183.3mm HIGH
15 TREADS @ 250mm DEEP
2 LANDINGS**



J.20-S.A STAIR SECTION A 1:20

[illegible]