

1 Site Plan 1:500 @ A1

> DESIGN INTENT FOR APPROVAL ONLY, NOT FOR CONSTRUCTION

 Solution
 <td

© Luchetti Krelle Pty Ltd Nominated Architect (NSW Australia only) Tommy Ford 9178. Copyright in all documents and drawings prepared by Luchetti Krelle and in any work executed from those documents and drawings shall remain the property of Luchetti Krelle or on creation vest in Luchetti Krelle. These documents must not be used, reproduced or copied, in whole or in part, nor may the information, ideas, concepts therein contained (which are confidential to Luchetti Krelle) be disclosed to any person without the prior written consent of that company. Do not scale drawings. Use figured dimensions only.
All works to be in accordance with the Building Code of Australia (BCA), Australian Standards (AS), and relevant authorities' requirements.
Any discrepancies, dimensional inconsistencies or the need for clarification must be reported to Luchetti Krelle and consultants immediately.
This drawing is to be read with all Luchetti Krelle and project documentation, including

 specifications, schedules, drawings and reports.
 All areas yeilds and calculations are preliminary and indicative only and subject to detailed and further survey, design and client and consultant input and advice. Rev Description
A Draft Issue for Consultant Review
B Issue for approval review
C Issue for approval review

D Issue for approval review

Date 8/11/19 11/11/19 13/11/19 20/11/19

ISSUE FOR AUTHORITY APPROVAL

Hotel Steyne

19049 75 The Corso Manly NSW 2095

Iris Capital

Site Plan


Date 5/11/19

Scale 1:500@A1

Scale 1:500 20 Drawn: LK 40 metres

DRAWING NO.
DA.010
REVISION
D

All floors	SQM
Existing	3971
Previously approved DA	4004
Proposed DA	3998

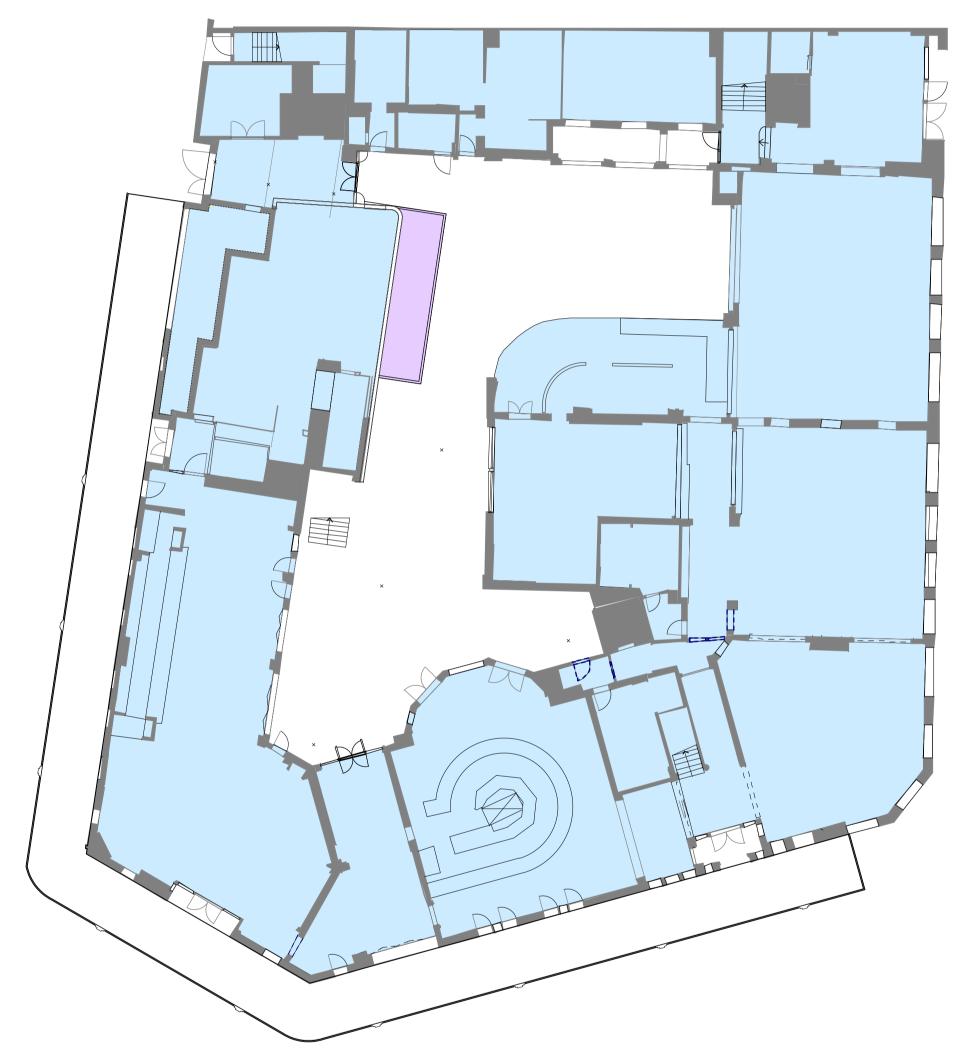



GFA Calcs - Ground Floor 1:200 @ A1

Ground floor	SQM	Total SQM
Existing	1459	1459
Proposed DA	-21	1437



© Luchetti Krelle Pty Ltd Nominated Architect (NSW Australia only) Tommy Ford 9178. Copyright in all documents and drawings prepared by Luchetti Krelle and in any work executed from those documents and drawings shall remain the property of Luchetti Krelle or on creation vest in Luchetti Krelle. These documents must not be used, reproduced or copied, in whole or in part, nor may the information, ideas, concepts therein contained (which are confidential to Luchetti Krelle) be disclosed to any person without the prior written consent of that company.

- Do not scale drawings. Use figured dimensions only. - All works to be in accordance with the Building Code of Australia (BCA), Australian Standards (AS), and relevant authorities' requirements. - Any discrepancies, dimensional inconsistencies or the need for clarification must be reported to Luchetti Krelle and consultants immediately. - This drawing is to be read with all Luchetti Krelle and project documentation, including specifications, schedules, drawings and reports. - All areas yeilds and calculations are preliminary and indicative only and subject to detailed and further survey, design and client and consultant input and advice.

DESIGN INTENT FOR APPROVAL ONLY, NOT FOR CONSTRUCTION



===

GFA Calcs - First Floor 1:200 @ A1


2

First Floor	SQM	Total SQM
Existing	1344	1344
Previously approved DA	10	1365
Previously approved DA	11	1365
Proposed DA	15	1381

Rev Description A Issue for approval B Issue for approval review

Date 13/11/19 20/11/19

0 Scale 1:200@A1

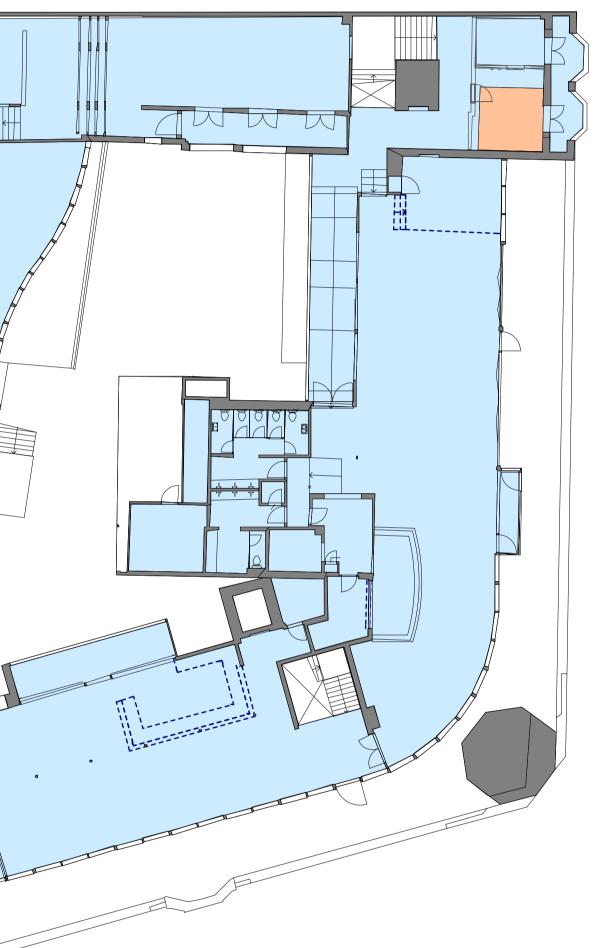

3 GFA Calcs - Second Floor 1:200 @ A1

Second Floor	SQM	Total SQM
Existing	1168	1168
Previously approved DA	11	1180

ISSUED FOR AUTHORITY APPROVAL

The Steyne Hotel Manly | GFA Calcs

DRAWING NO.

DA.020

19049 75 The Corso Manly NSW 2095

Iris Capital


Date Nov 19

Scale 1:200 @ A1 Drawn: LK

REVISION Β

EXISTING WALLS TO BE RETAINED

DEMO EXISTING WALLS/INFILLS/SERVICES

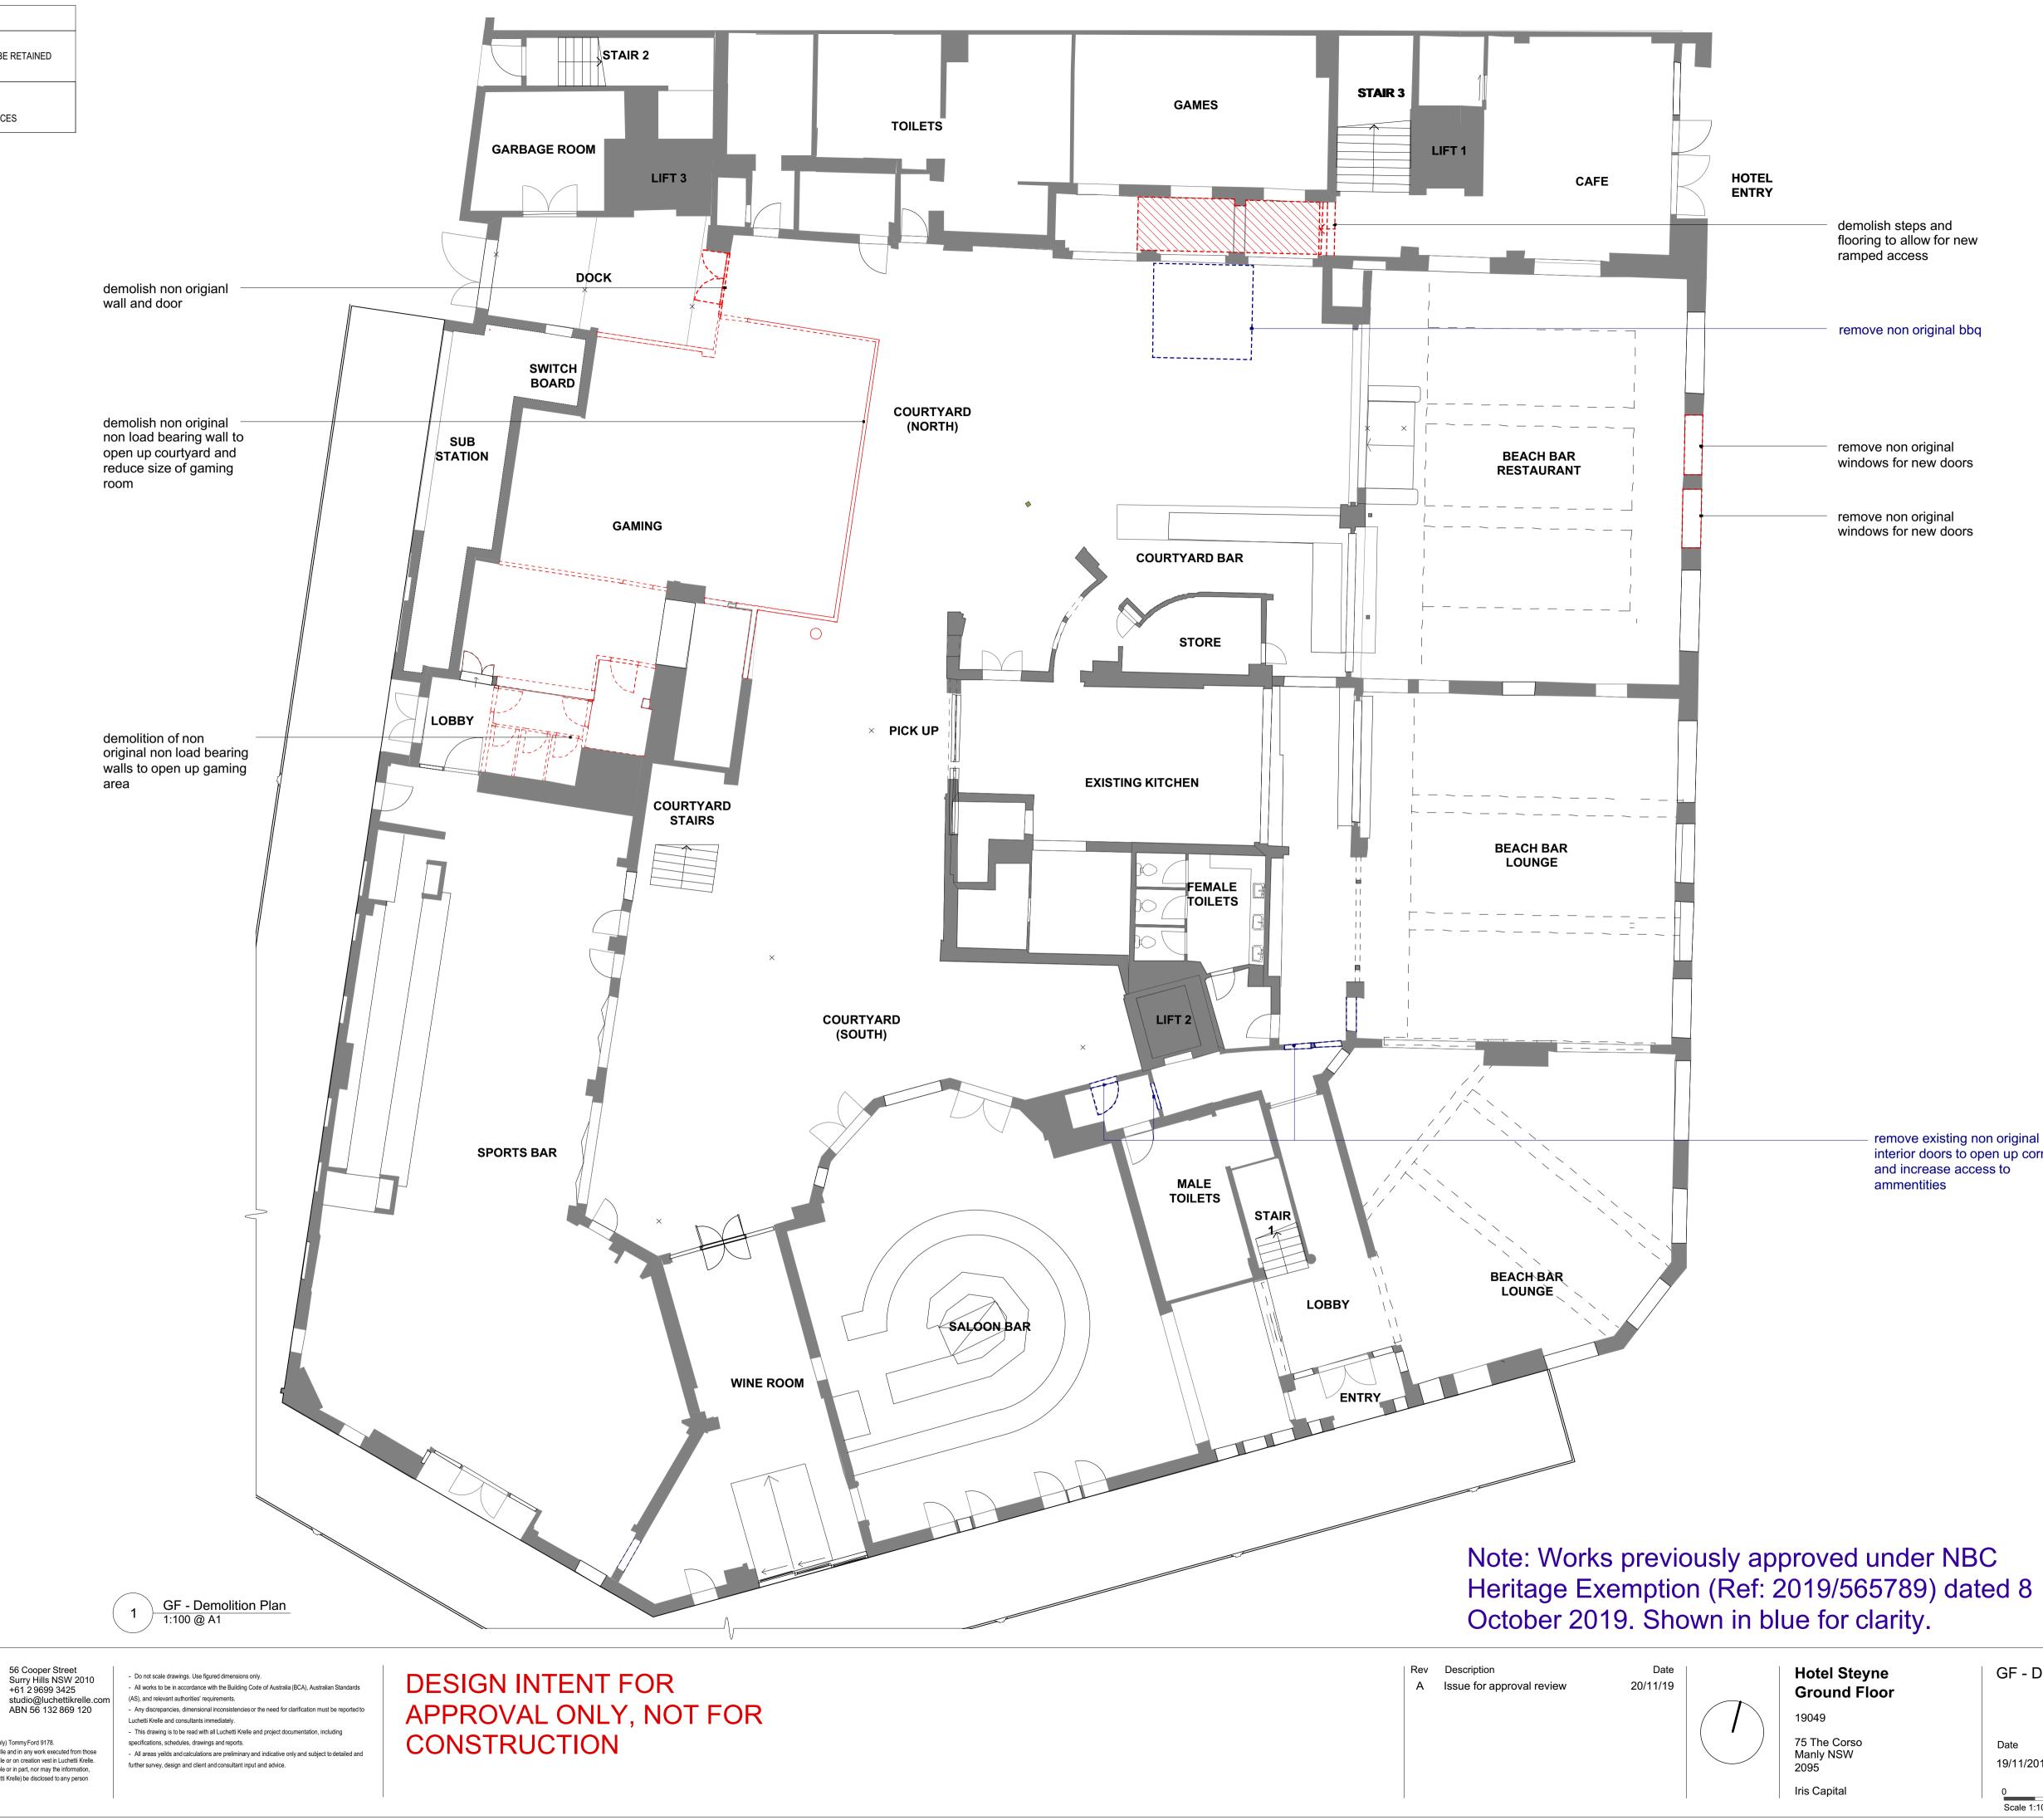

© Luchetti Krelle Pty Ltd Nominated Architect (NSW Australia only) Tommy Ford 9178. Copyright in all documents and drawings prepared by Luchetti Krelle and in any work executed from those documents and drawings shall remain the property of Luchetti Krelle or on creation vest in Luchetti Krelle. These documents must not be used, reproduced or copied, in whole or in part, nor may the information, ideas, concepts therein contained (which are confidential to Luchetti Krelle) be disclosed to any person without the prior written consent of that company.

LUCHETTI

KREI

demolish steps and flooring to allow for new ramped access

remove non original bbq

remove non original windows for new doors

remove non original windows for new doors

> remove existing non original interior doors to open up corridors and increase access to ammentities

Hotel Steyne **Ground Floor**

19049 75 The Corso Manly NSW 2095

Iris Capital

GF - Demolition Plan

DRAWING NO.

DA.030



19/11/2019
0
Scale 1:100@A

Date

metre

1:100

Drawn: LK

ISSUE FOR AUTHORITY APPROVAL


PARTITION TYPE LEGEND

EXISTING WALLS TO BE RETAINED

NEW WALLS



S/INFILLS/SERVICES

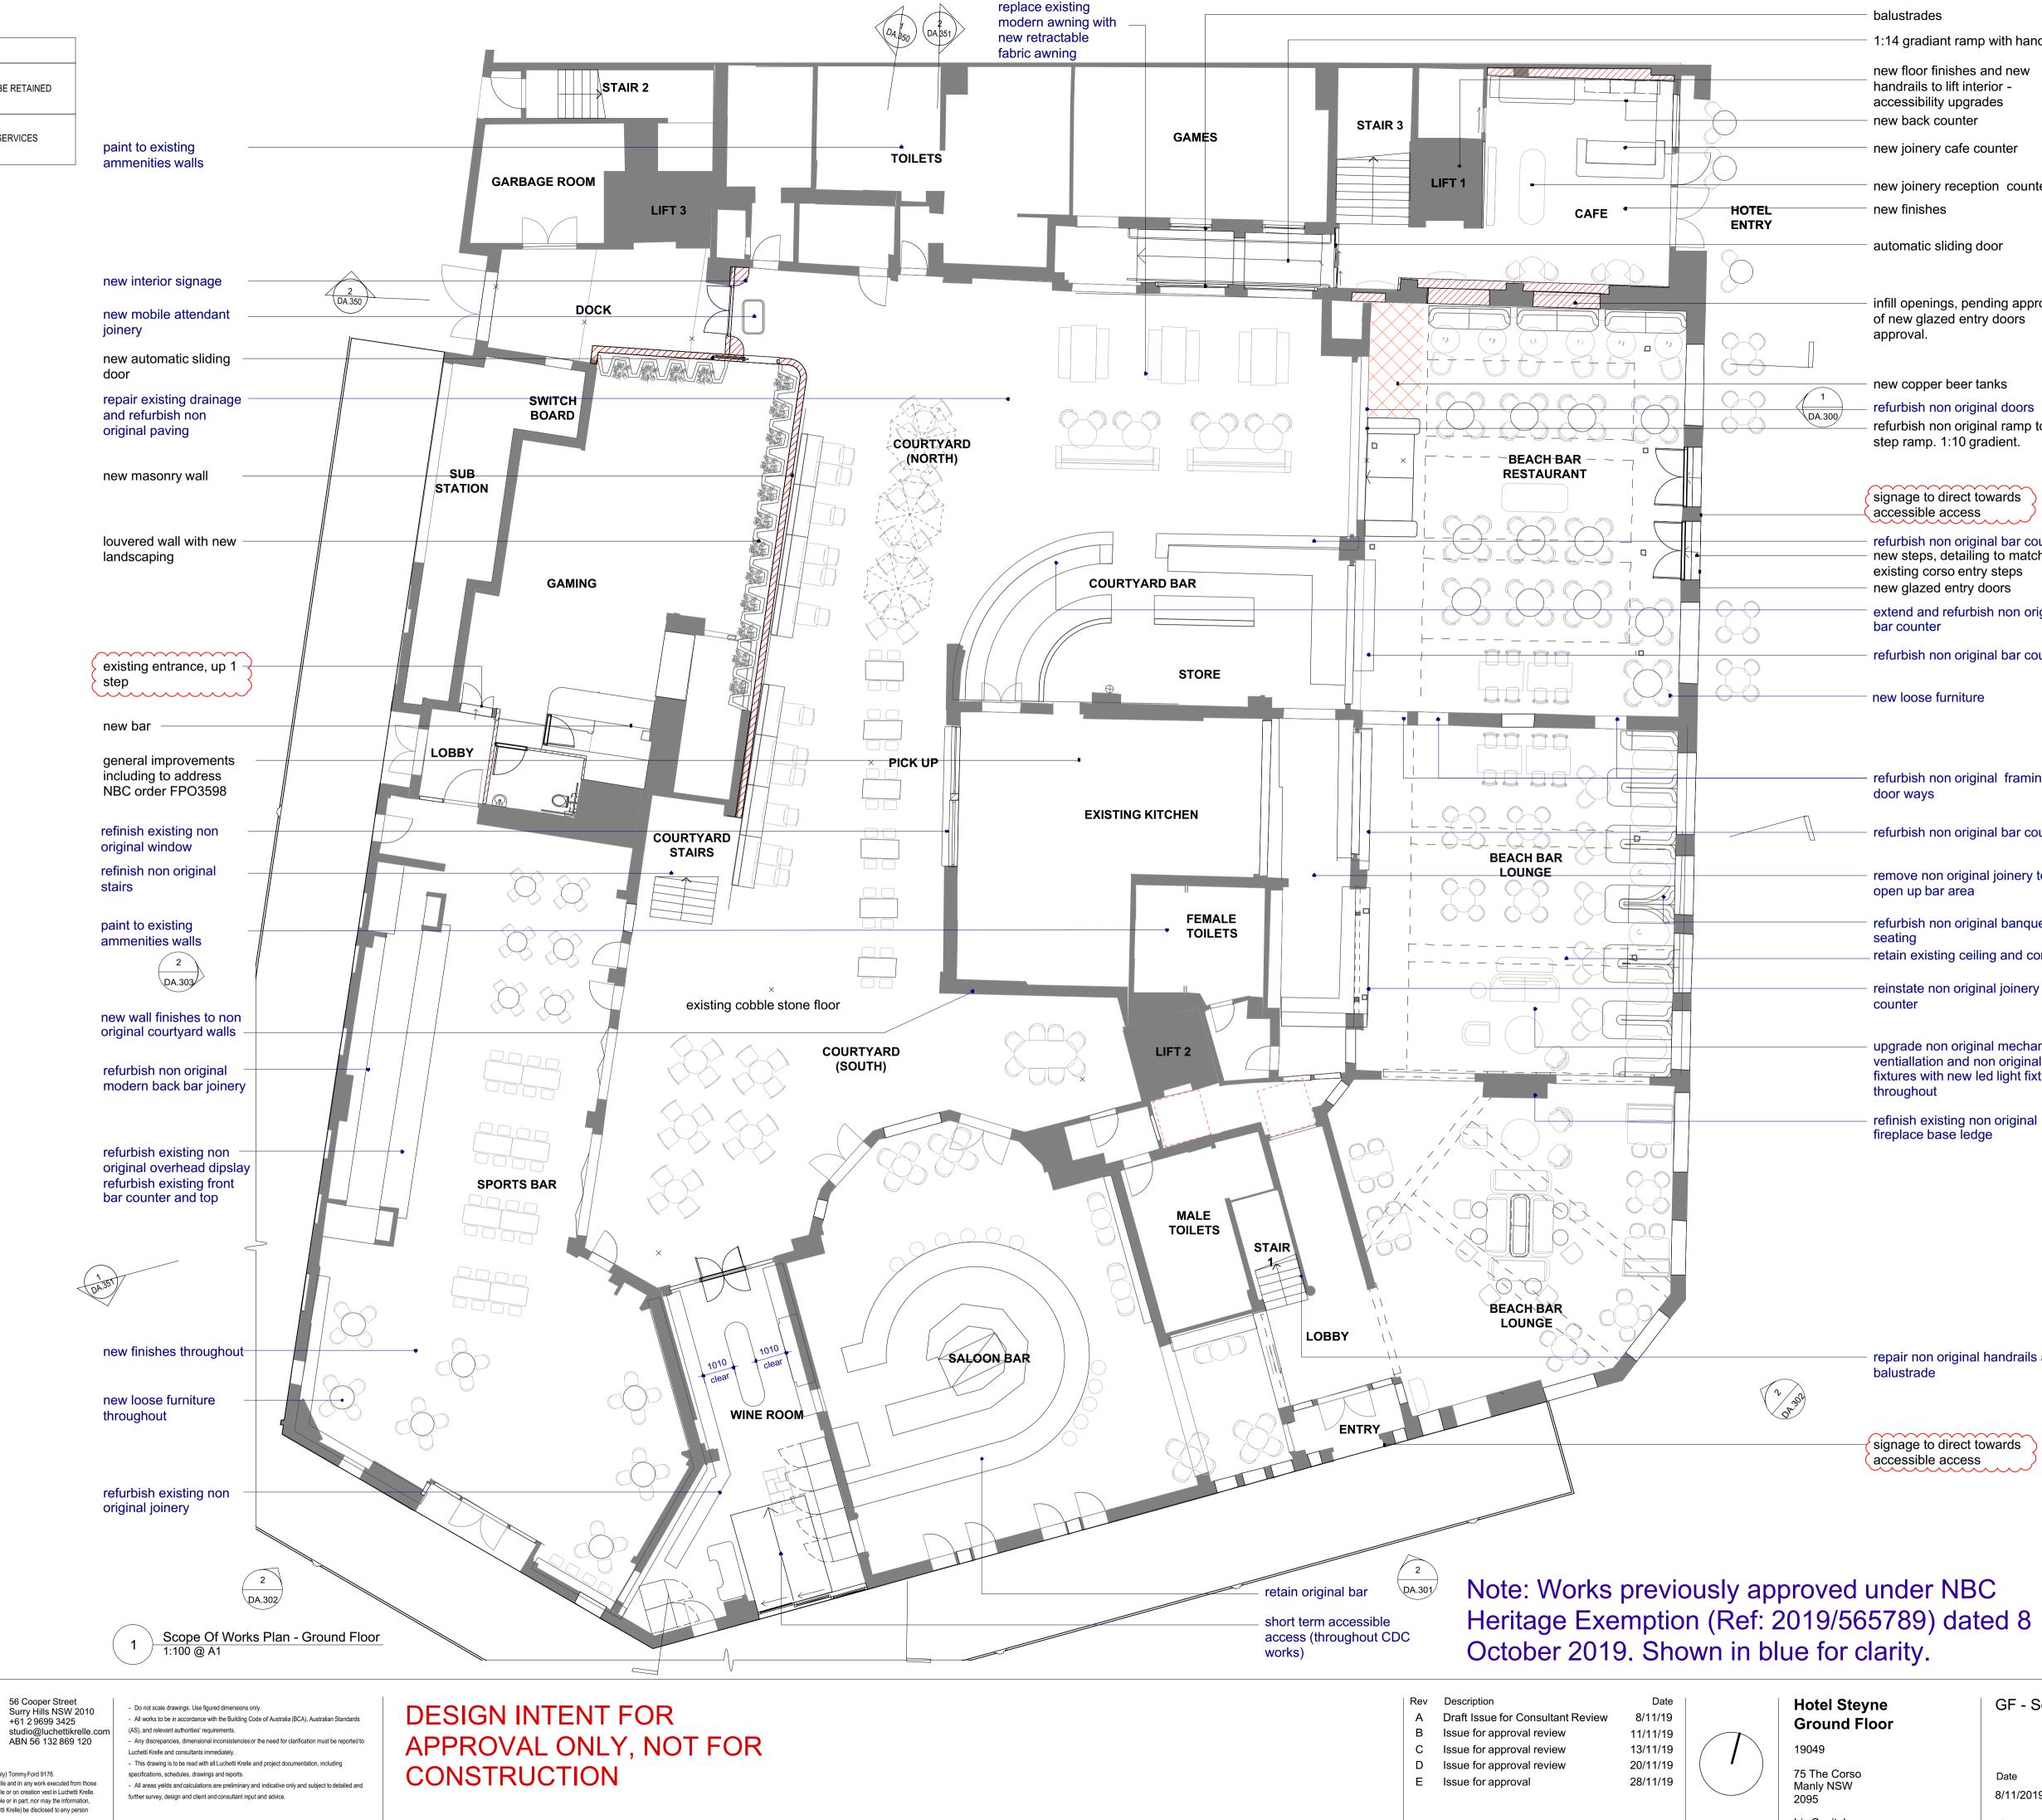

© Luchetti Krelle Pty Ltd Nominated Architect (NSW Australia only) Tommy Ford 9178. Copyright in all documents and drawings prepared by Luchetti Krelle and in any work executed from those documents and drawings shall remain the property of Luchetti Krelle or on creation vest in Luchetti Krelle. These documents must not be used, reproduced or copied, in whole or in part, nor may the information, ideas, concepts therein contained (which are confidential to Luchetti Krelle) be disclosed to any person without the prior written consent of that company.

LUCHETTI

KREI

	balustrades
	1:14 gradiant ramp with handrails
	new floor finishes and new handrails to lift interior - accessibility upgrades
	new back counter
	new joinery cafe counter
	new joinery reception counter
	new finishes
	automatic sliding door
	infill openings, pending approval of new glazed entry doors approval.
	new copper beer tanks
	refurbish non original doors
DA.300	refurbish non original ramp to be step ramp. 1:10 gradient.
(signage to direct towards accessible access
	refurbish non original bar counter new steps, detailing to match existing corso entry steps new glazed entry doors
	extend and refurbish non original bar counter
	refurbish non original bar counter
	new loose furniture
	refurbish non original framing to door ways
[]	refurbish non original bar counter
	remove non original joinery to open up bar area
	refurbish non original banquette seating retain existing ceiling and cornice
	reinstate non original joinery counter
	upgrade non original mechanical ventiallation and non original light fixtures with new led light fixtures throughout

refinish existing non original fireplace base ledge

repair non original handrails and balustrade

 \sim signage to direct towards accessible access

Hotel Steyne **Ground Floor**

19049 75 The Corso Manly NSW 2095

Iris Capital

ISSUE FOR AUTHORITY APPROVAL

GF - Scope of Works Plan

1:100

Drawn

DRAWING NO. DA.040


Date 8/11/2019

metres

LK

REVISION Ε

Scale 1:100@A1

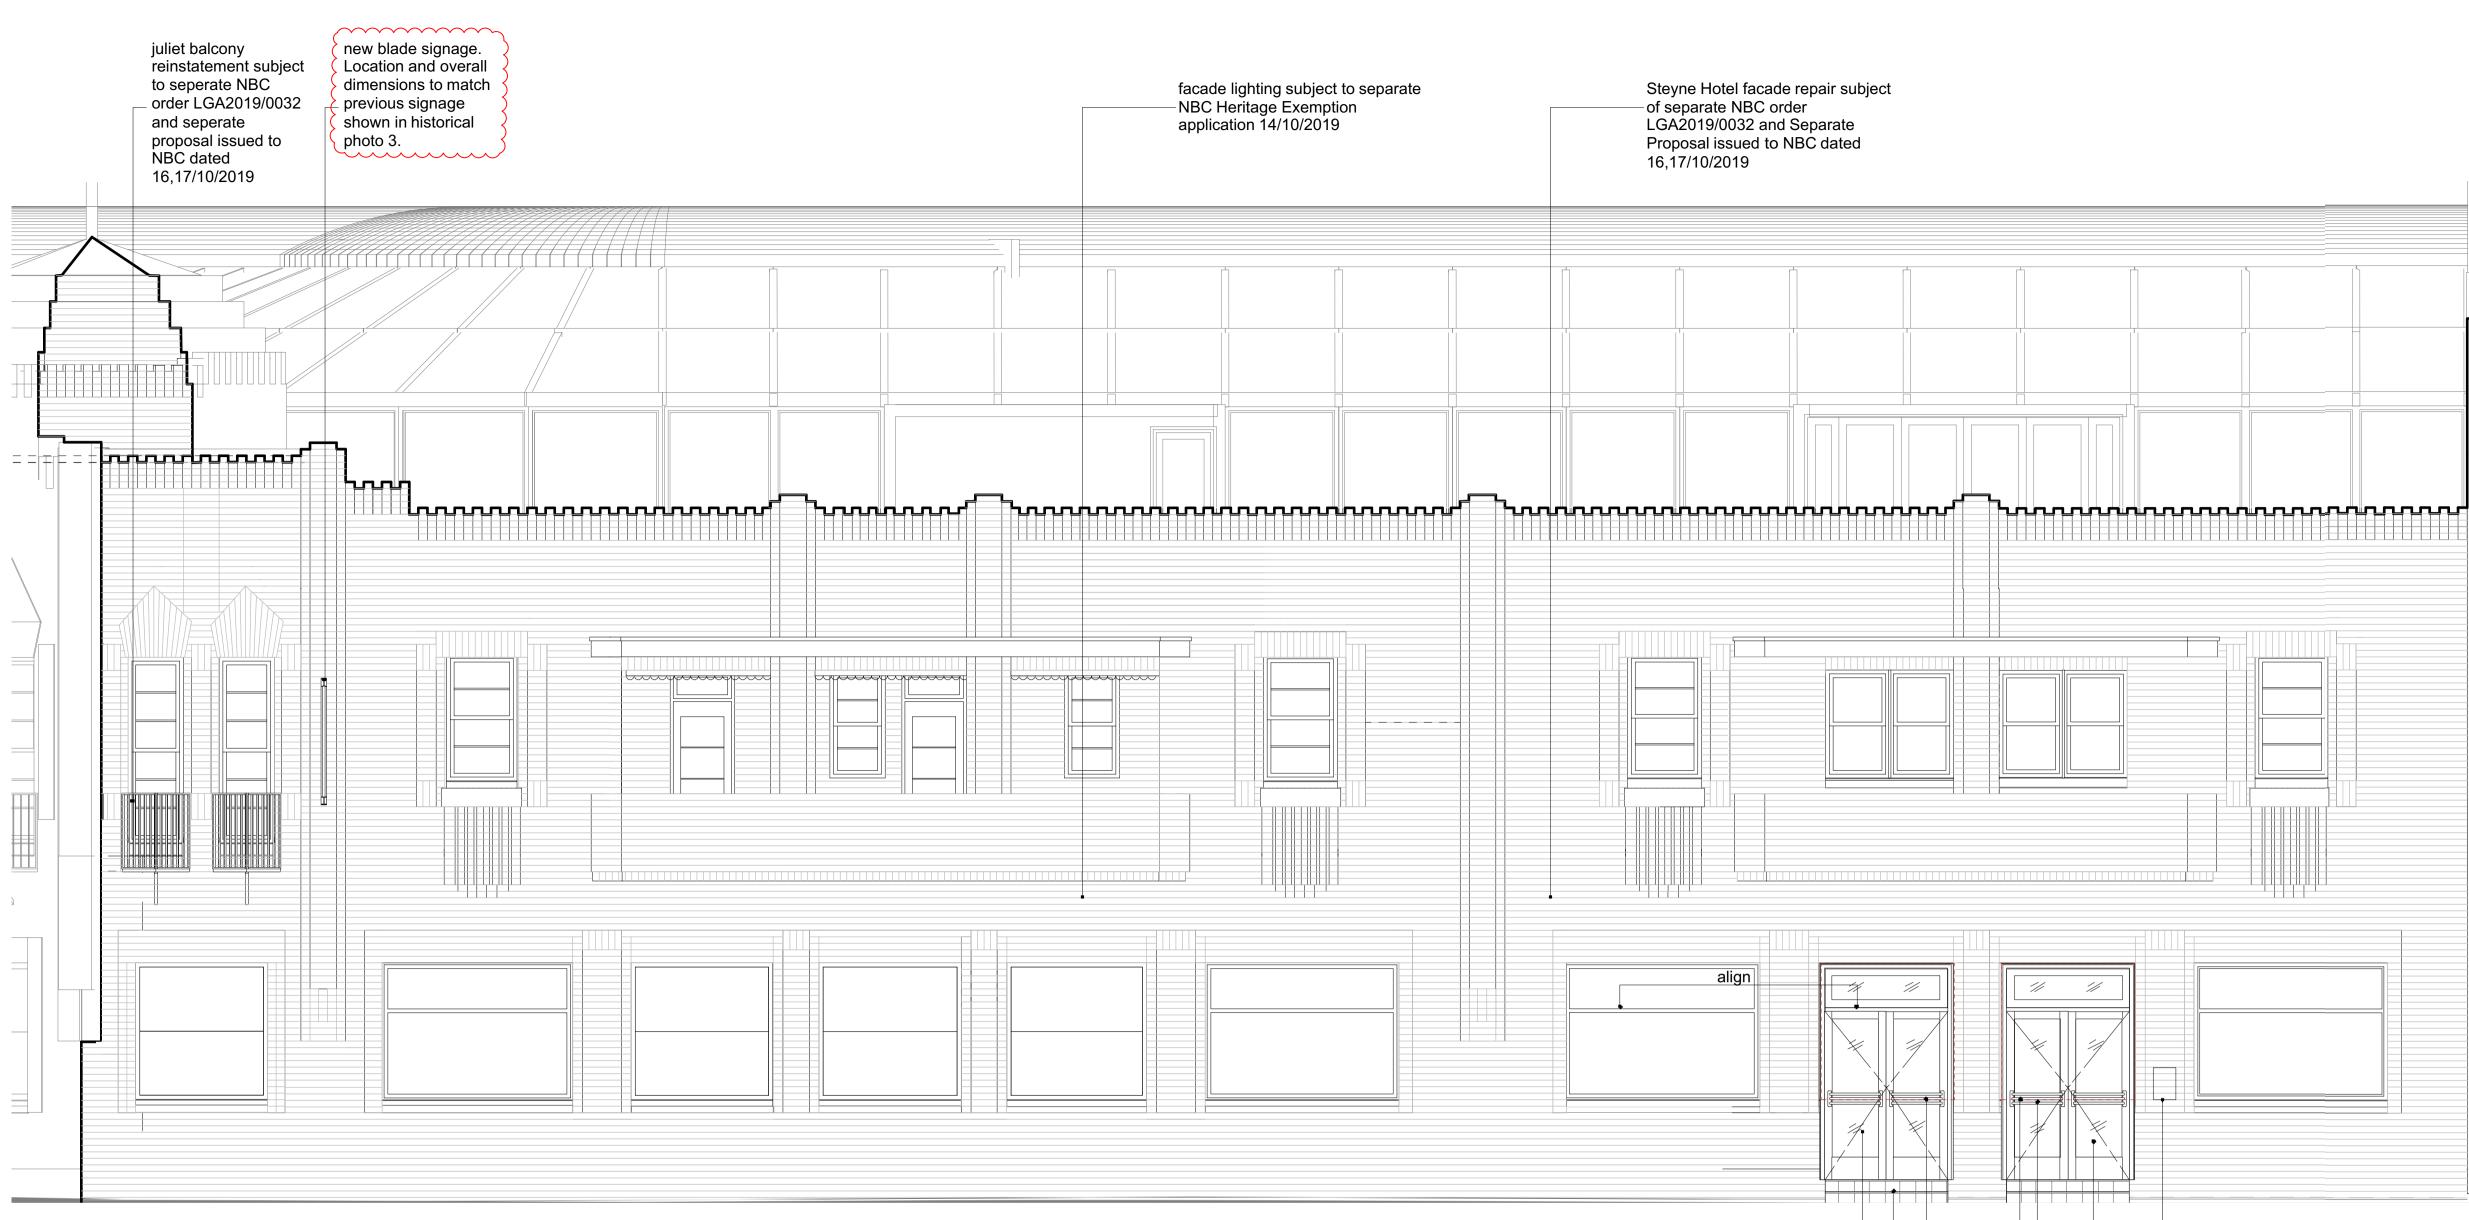

Exterior Elevation - New Entry Doors 1:50 @ A1 1



(3) Historical Photo - South East - The Corso N.T.S

56 Cooper Street Surry Hills NSW 2010 +61 2 9699 3425 LUCHETTI KREI studio@luchettikrelle.com ABN 56 132 869 120

© Luchetti Krelle Pty Ltd Nominated Architect (NSW Australia only) Tommy Ford 9178. Copyright in all documents and drawings prepared by Luchetti Krelle and in any work executed from those documents and drawings shall remain the property of Luchetti Krelle or on creation vest in Luchetti Krelle. These documents must not be used, reproduced or copied, in whole or in part, nor may the information, ideas, concepts therein contained (which are confidential to Luchetti Krelle) be disclosed to any person without the prior written consent of that company.

- Do not scale drawings. Use figured dimensions only. - All works to be in accordance with the Building Code of Australia (BCA), Australian Standards (AS), and relevant authorities' requirements. - Any discrepancies, dimensional inconsistencies or the need for clarification must be reported to Luchetti Krelle and consultants immediately. - This drawing is to be read with all Luchetti Krelle and project documentation, including specifications, schedules, drawings and reports. - All areas yeilds and calculations are preliminary and indicative only and subject to detailed and further survey, design and client and consultant input and advice.

DESIGN INTENT FOR APPROVAL ONLY, NOT FOR CONSTRUCTION

_____ bricks to be salvaged for facade repair "NBC order LGA 2019/0032 and seperate proposal issued to NBC dates 16, 17/10/2019"

······ new entry steps to match corso entry door steps

remove non original windows (shown dashed) for new doors

	+/-1765	
	check on site	Ī
		check on site
2 Plan Detail- New Entry Door 1:10 @ A1		

Rev Description A Draft Issue for Consultant Review

B Issue for approval review

C Issue for approval review D Issue for approval review

Date 8/11/19 11/11/19 13/11/19 20/11/19



Hotel Steyne Ground Floor	_	Exterior Elevations - New Entry Doors		
19049	20010	DA.3		
75 The Corso Manly NSW 2005	Date 8/11/19	Scale 1:50	Drawn: LK	REVISION

4.300


19049 75 The (Manly N 2095

Iris Capital

Scale 1:50@A1

4 metres

D

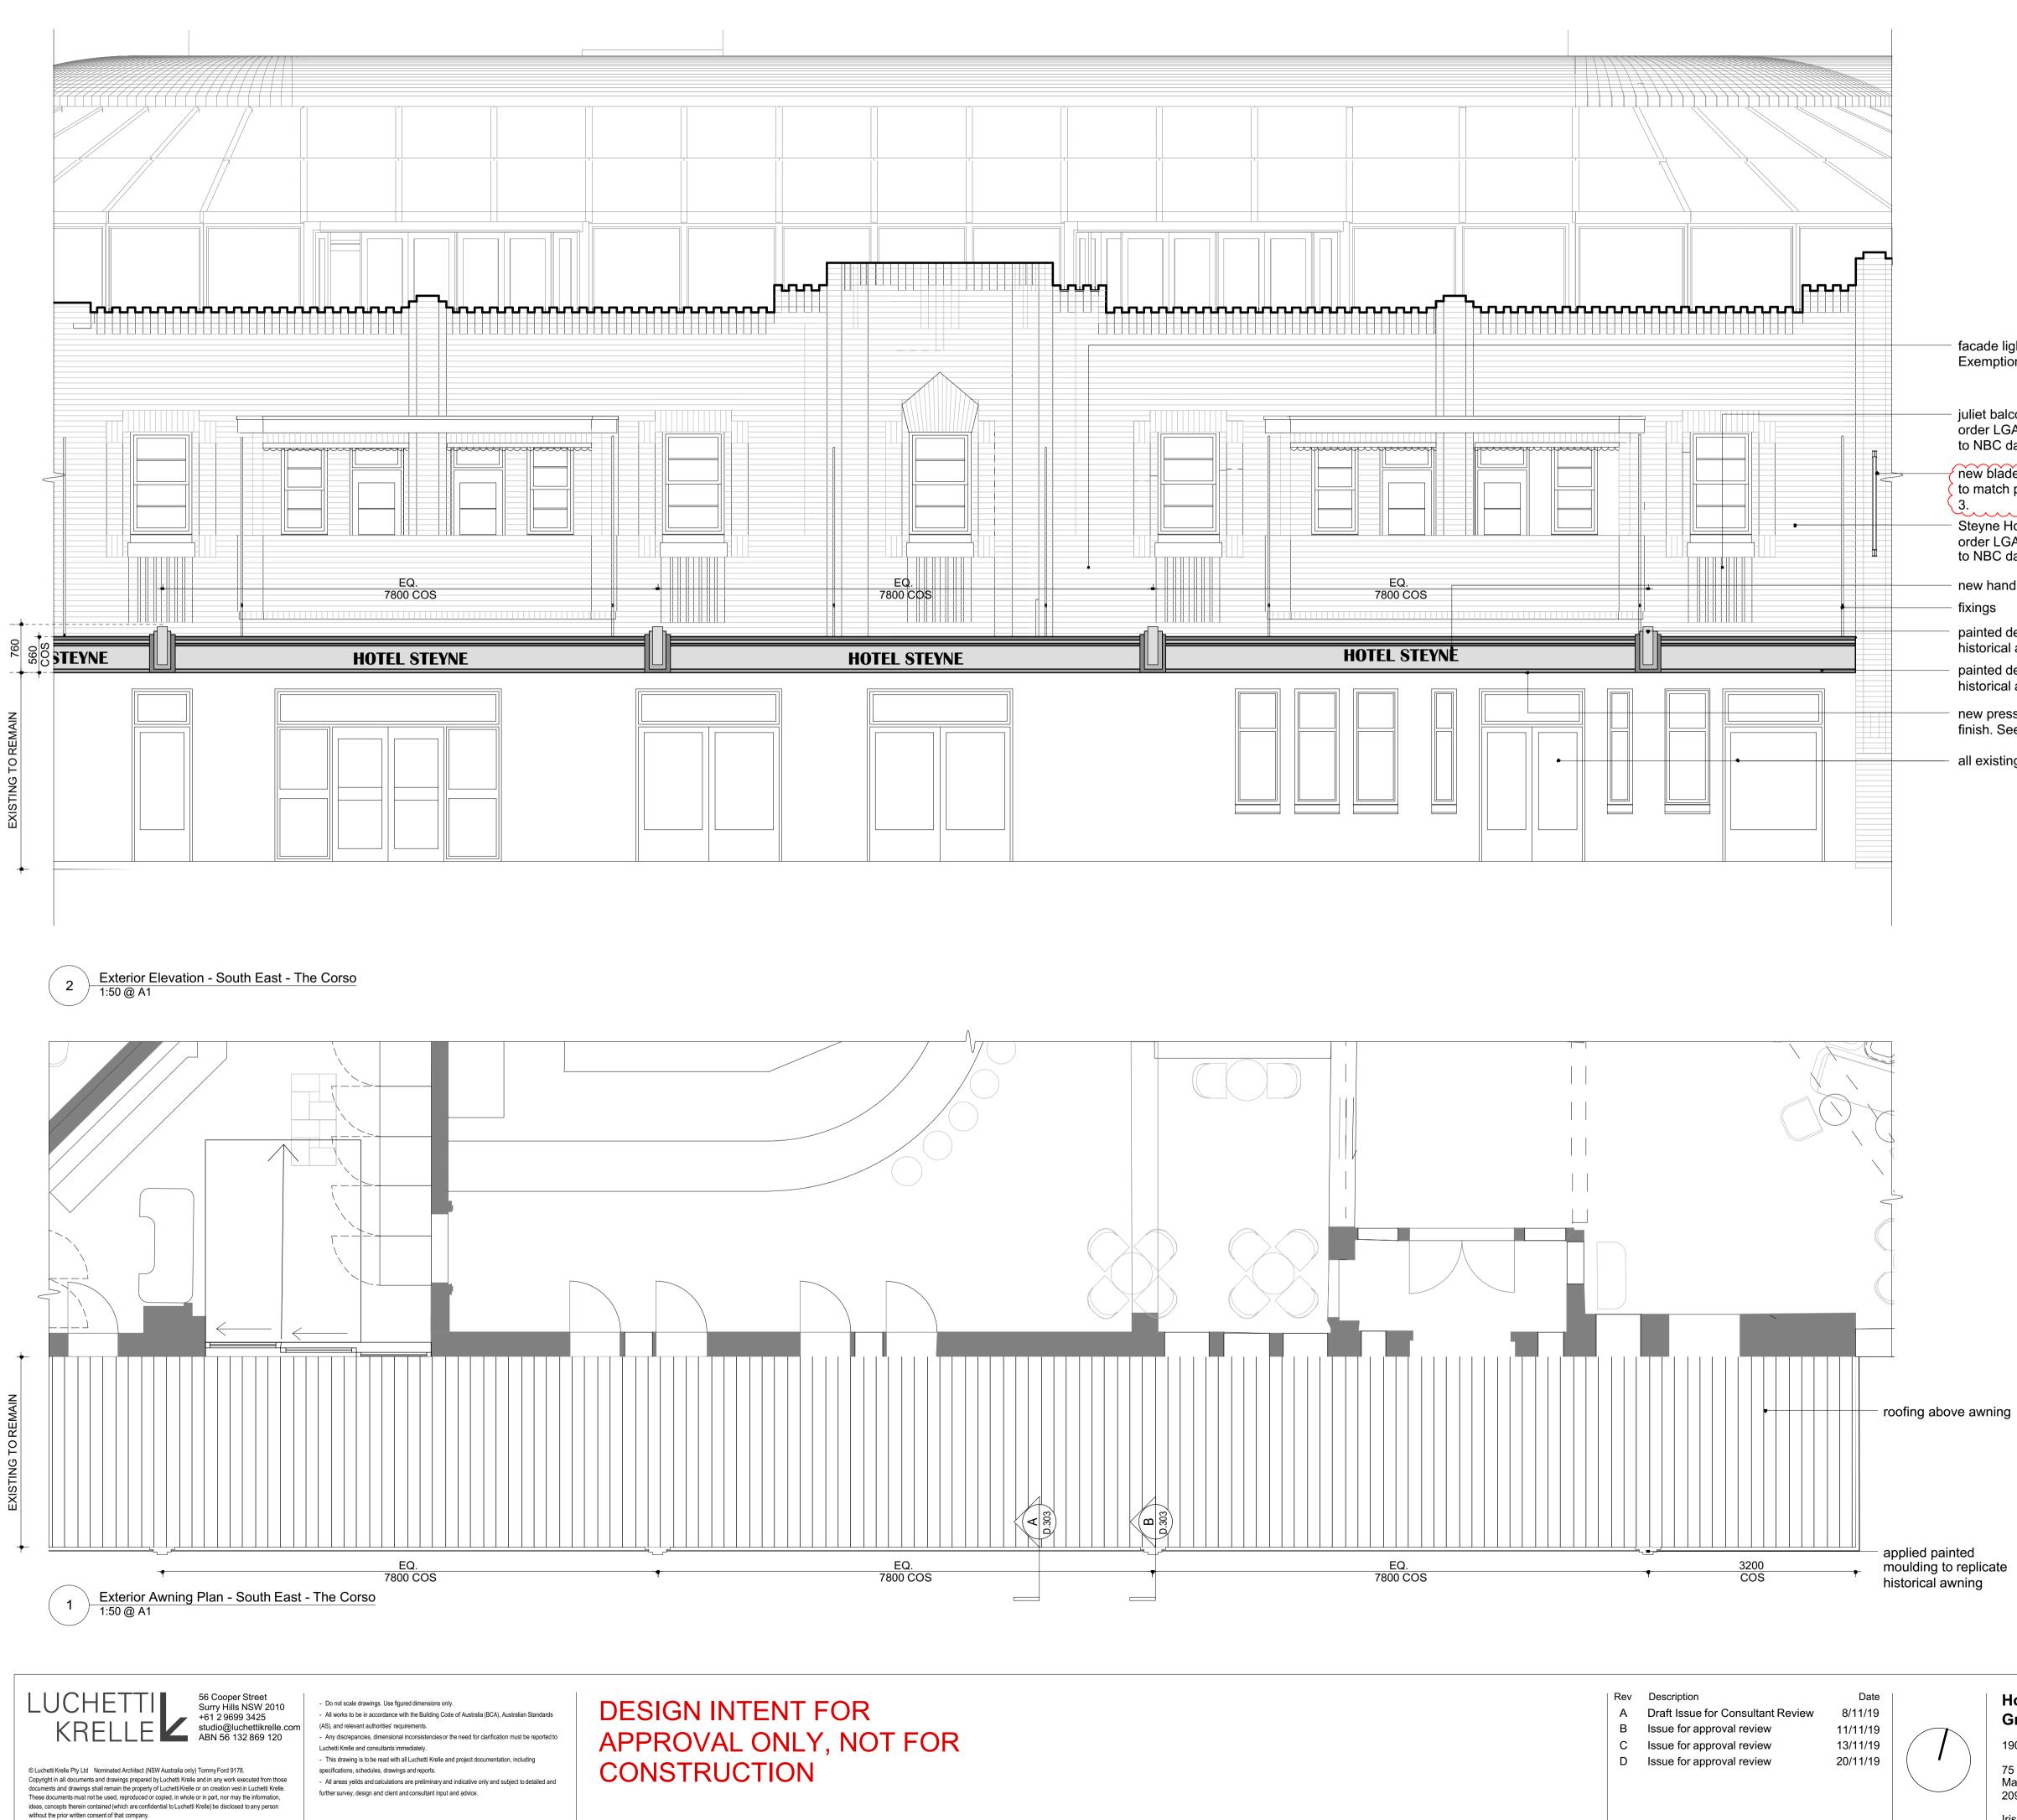

facade lighting subject of separate NBC Heritage Exemption application 14/10/2019

juliet balcony reinstatement subject to seperate NBC order LGA2019/0032 and seperate proposal issued to NBC dated 16,17/10/2019

new blade signage. Location and overall dimensions to match previous signage shown in historical photo

Steyne Hotel facade repair subject of separate NBC order LGA2019/0032 and Separate Proposal issued to NBC dated 16,17/10/2019

new hand painted signage to face

painted decorative applied moulding to replicate historical awning

painted decorative applied moulding to replicate historical awning

new pressed tin ceiling to underside with painted finish. See Image 5 on DA.303 for pattern

all existing doors and windows to remain



Historical Photo - South East - The Corso N.T.S 3





Historical Photo - South East - The Corso



Historical Photo - South East - The Corso N.T.S 5

ISSUE FOR AUTHORITY APPROVAL

Hotel Steyne **Ground Floor**

19049 75 The Corso Manly NSW 2095

Iris Capital

Exterior Elevation - External Awning Improvements


DRAWING NO. DA.301 REVISION

 \Box

Date		Scale
8/11/19		1:50
0	1	2
Scale 1:5	50@A1	


Drawn:


LK metres

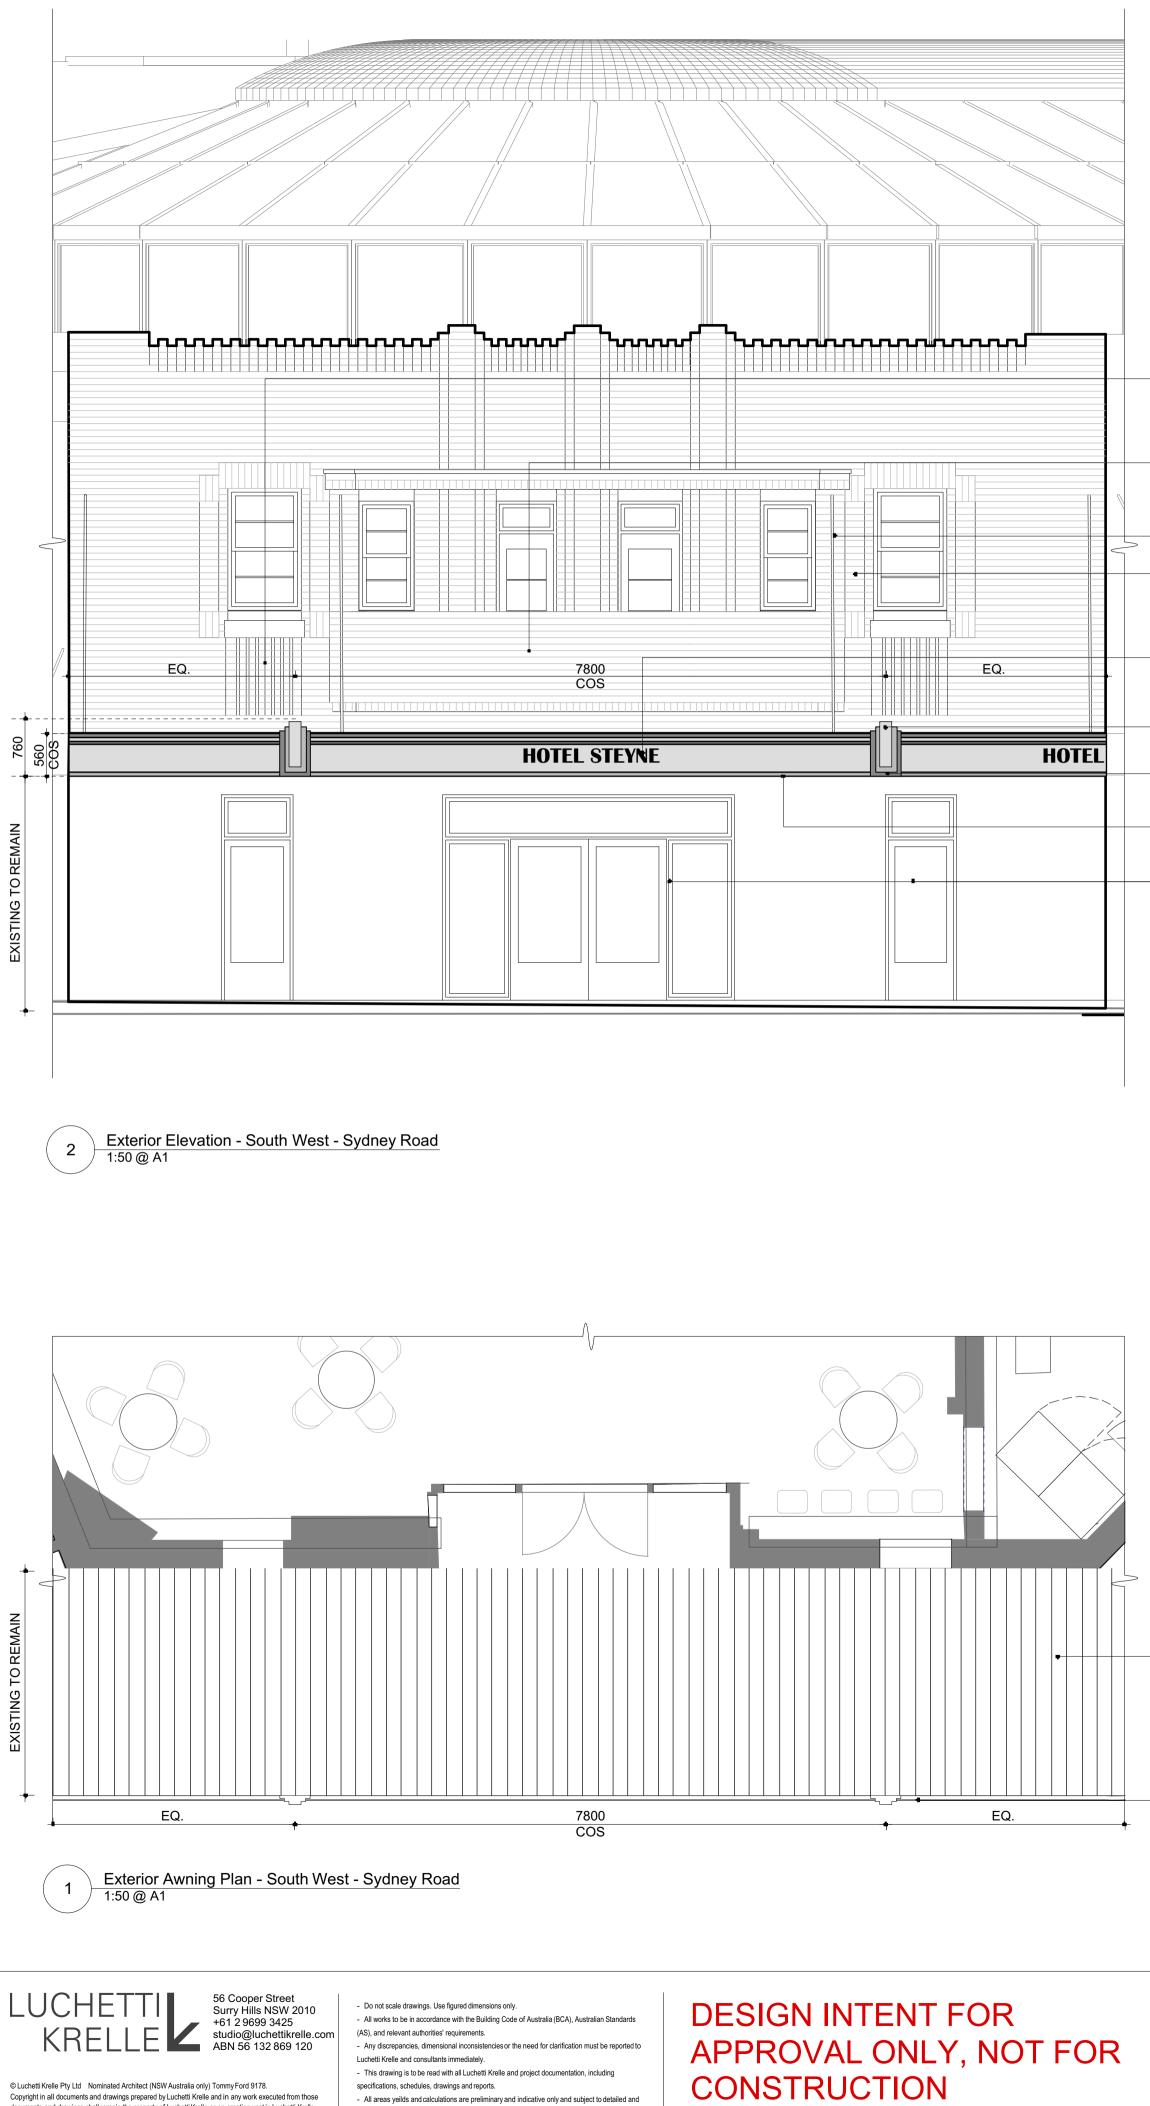

documents and drawings shall remain the property of Luchetti Krelle or on creation vest in Luchetti Krelle. These documents must not be used, reproduced or copied, in whole or in part, nor may the information, ideas, concepts therein contained (which are confidential to Luchetti Krelle) be disclosed to any person without the prior written consent of that company.

further survey, design and client and consultant input and advice.

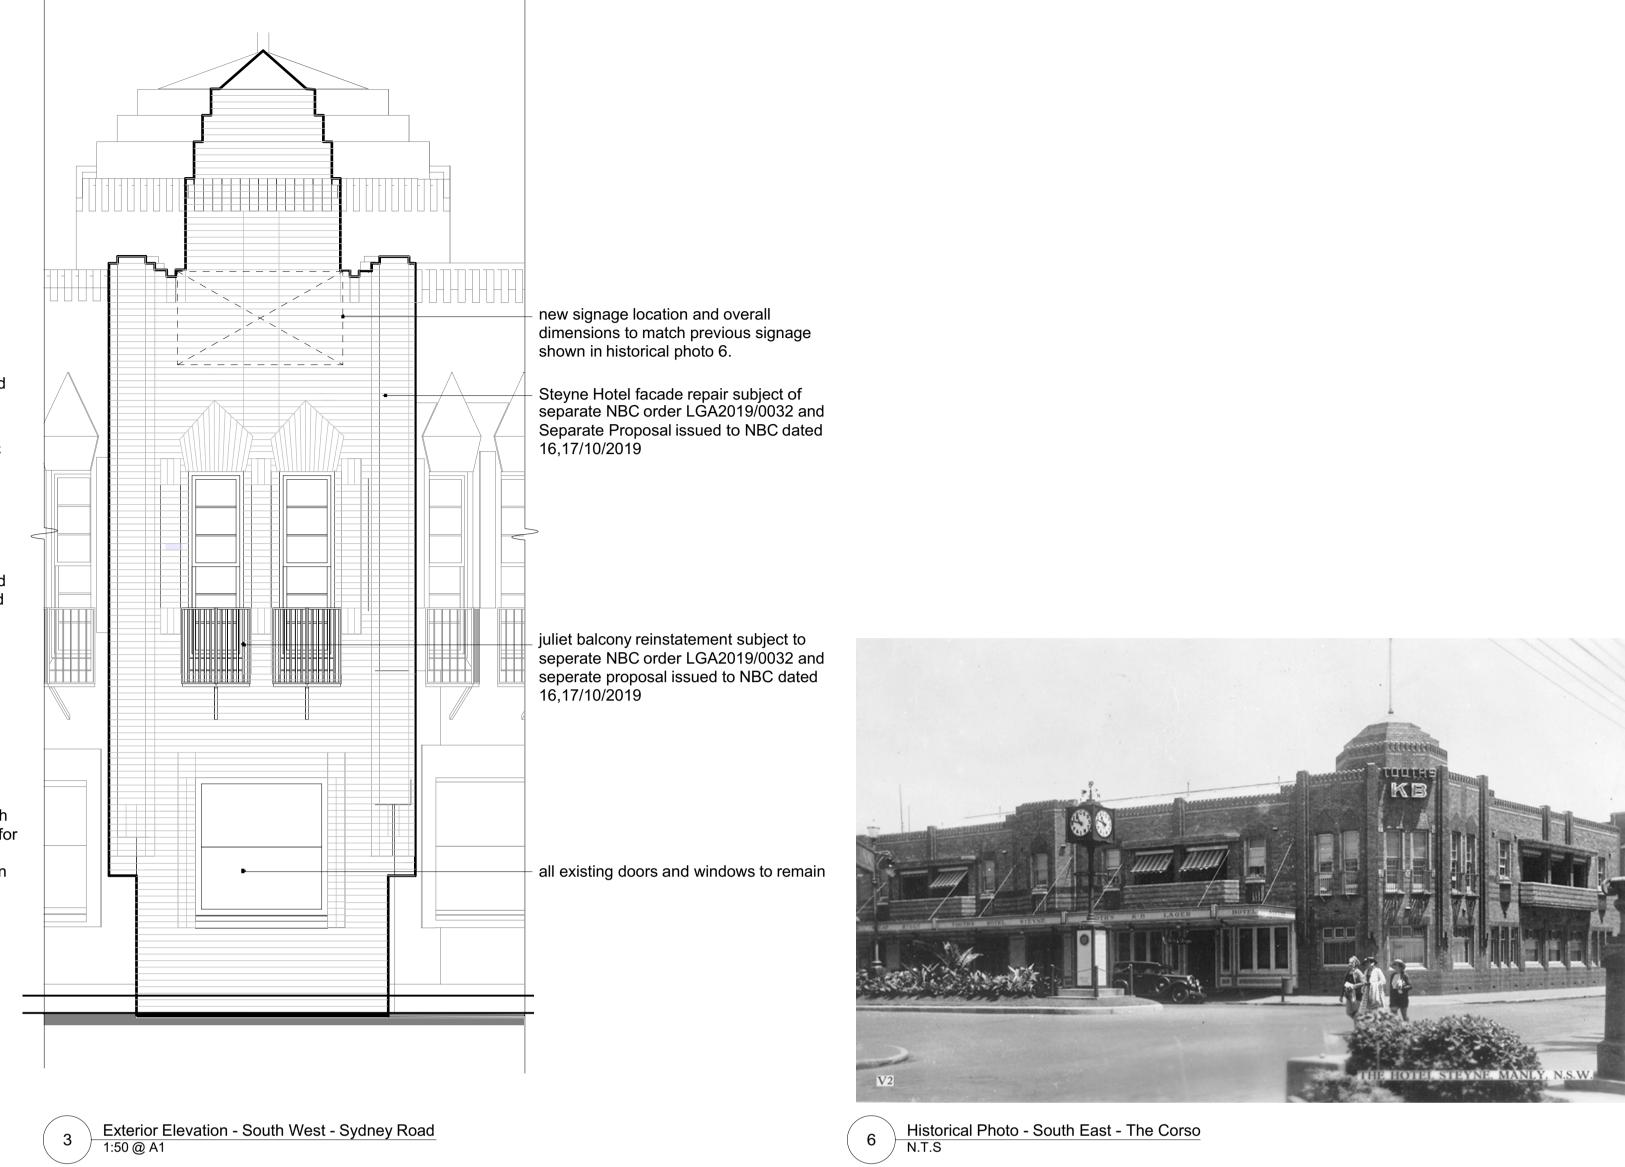

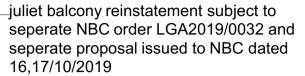

facade lighting subject to separate NBC Heritage Exemption application 14/10/2019

fixings

Steyne Hotel facade repair subject of separate NBC order LGA2019/0032 and Separate Proposal issued to NBC dated 16,17/10/2019

new hand painted signage to face

painted decorative applied moulding to replicate historical awning

painted decorative applied moulding to replicate historical awning

- new pressed tin ceiling to underside with painted finish. See Image 5 on DA.303 for pattern all existing doors and windows to remain




Historical Photo - South East - The Corso N.T.S 4

Rev Description

- A Issue for authority approval
- B Draft Issue for Consultant Review C Issue for approval review
- D Issue for approval review
- E Issue for approval review



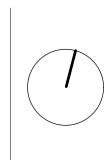

5

19049

2095

Iris Capital

75 The Corso Manly NSW

roofing above awning


applied painted moulding to replicate historical awning




Historical Photo - South East - The Corso


ISSUE FOR AUTHORITY APPROVAL

DRAWING NO. Hotel Steyne Exterior Elevations - External Awning Improvements and **Ground Floor** DA.302 Signage REVISION Date Drawn: 8/11/19 LK 1.50Ε Scale 1:50@A1 metres

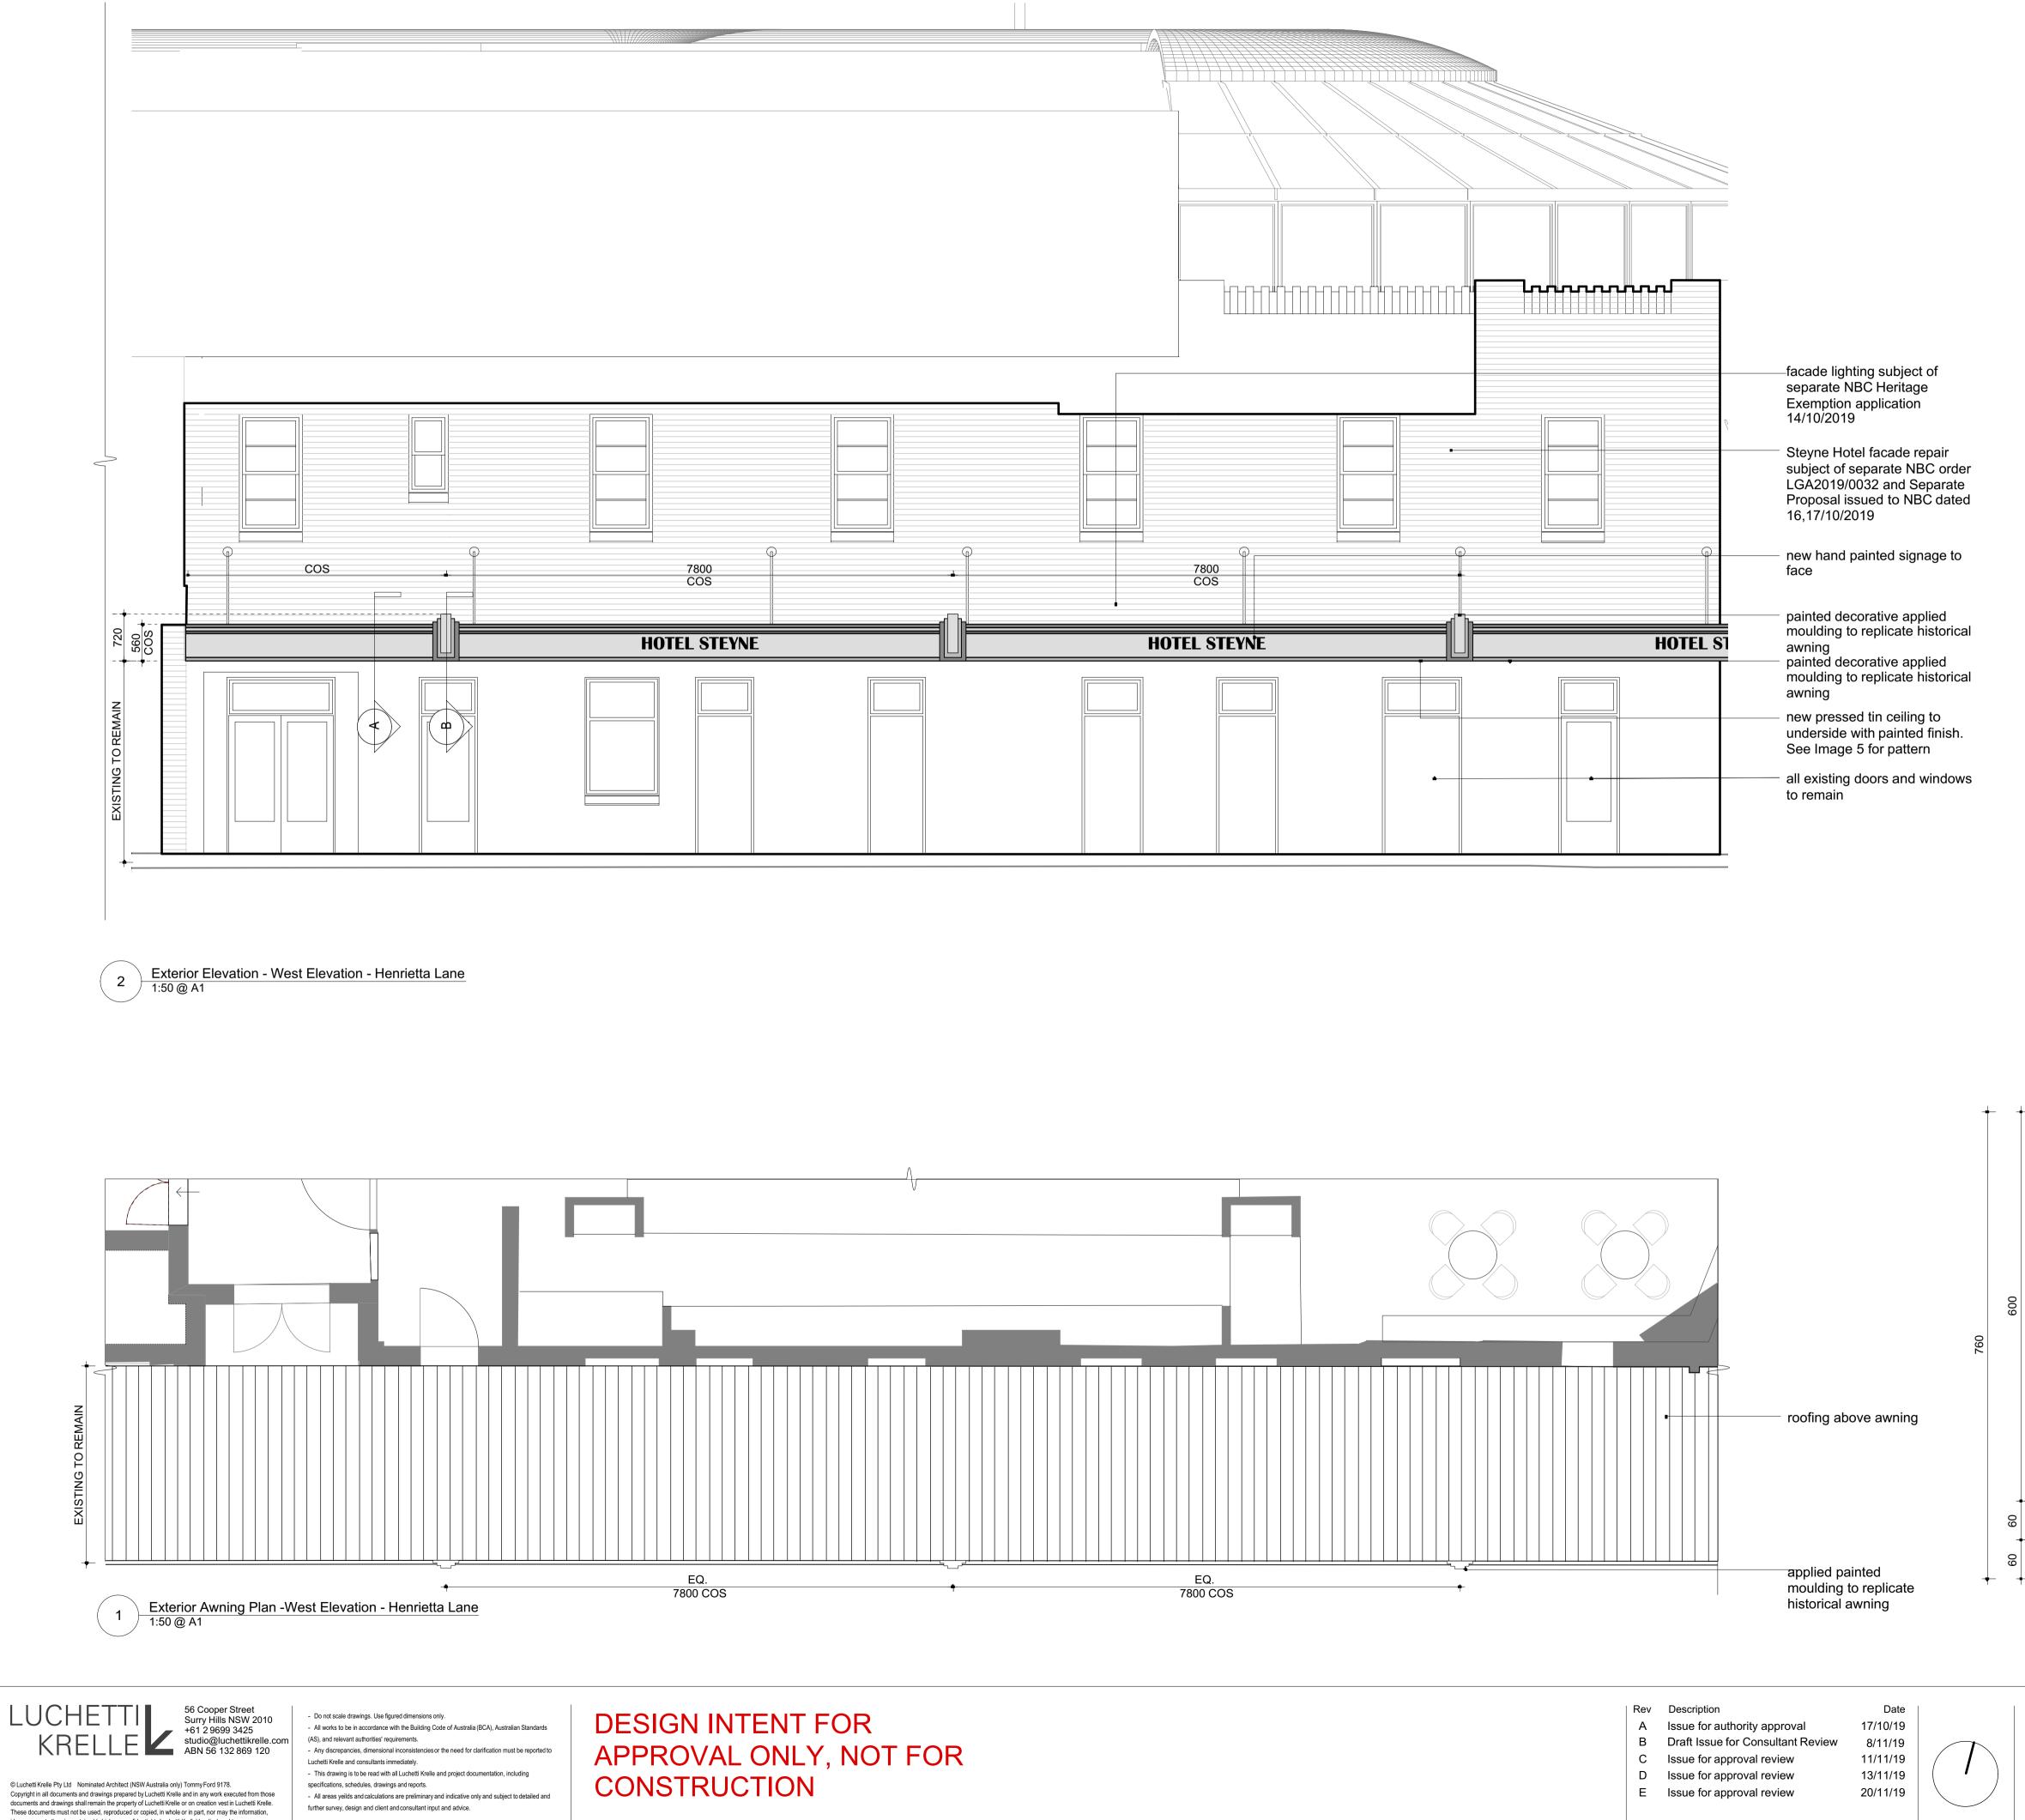

© Luchetti Krelle Pty Ltd Nominated Architect (NSW Australia only) Tommy Ford 9178. Copyright in all documents and drawings prepared by Luchetti Krelle and in any work executed from those documents and drawings shall remain the property of Luchetti Krelle or on creation vest in Luchetti Krelle. These documents must not be used, reproduced or copied, in whole or in part, nor may the information, ideas, concepts therein contained (which are confidential to Luchetti Krelle) be disclosed to any person without the prior written consent of that company.

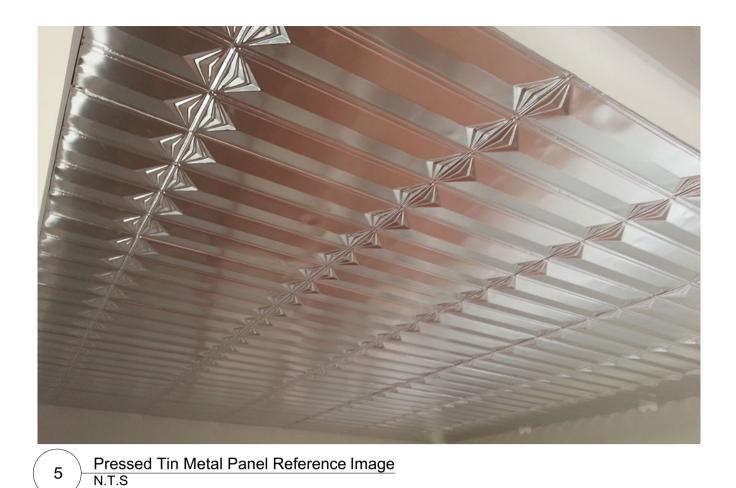

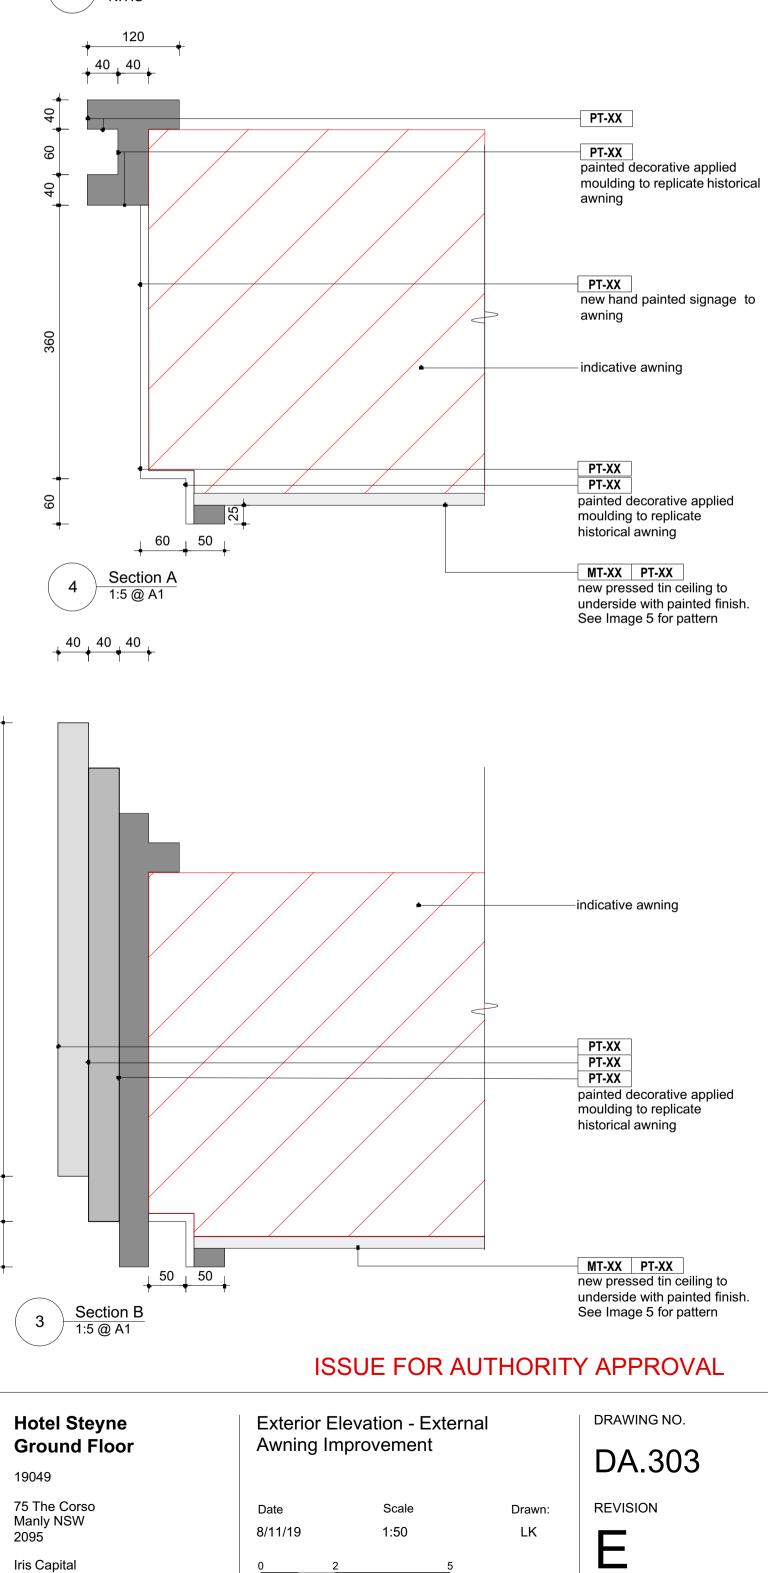


Iris Capital

Scale 1:100@A1 metres



2 Section 1:100 @ A1

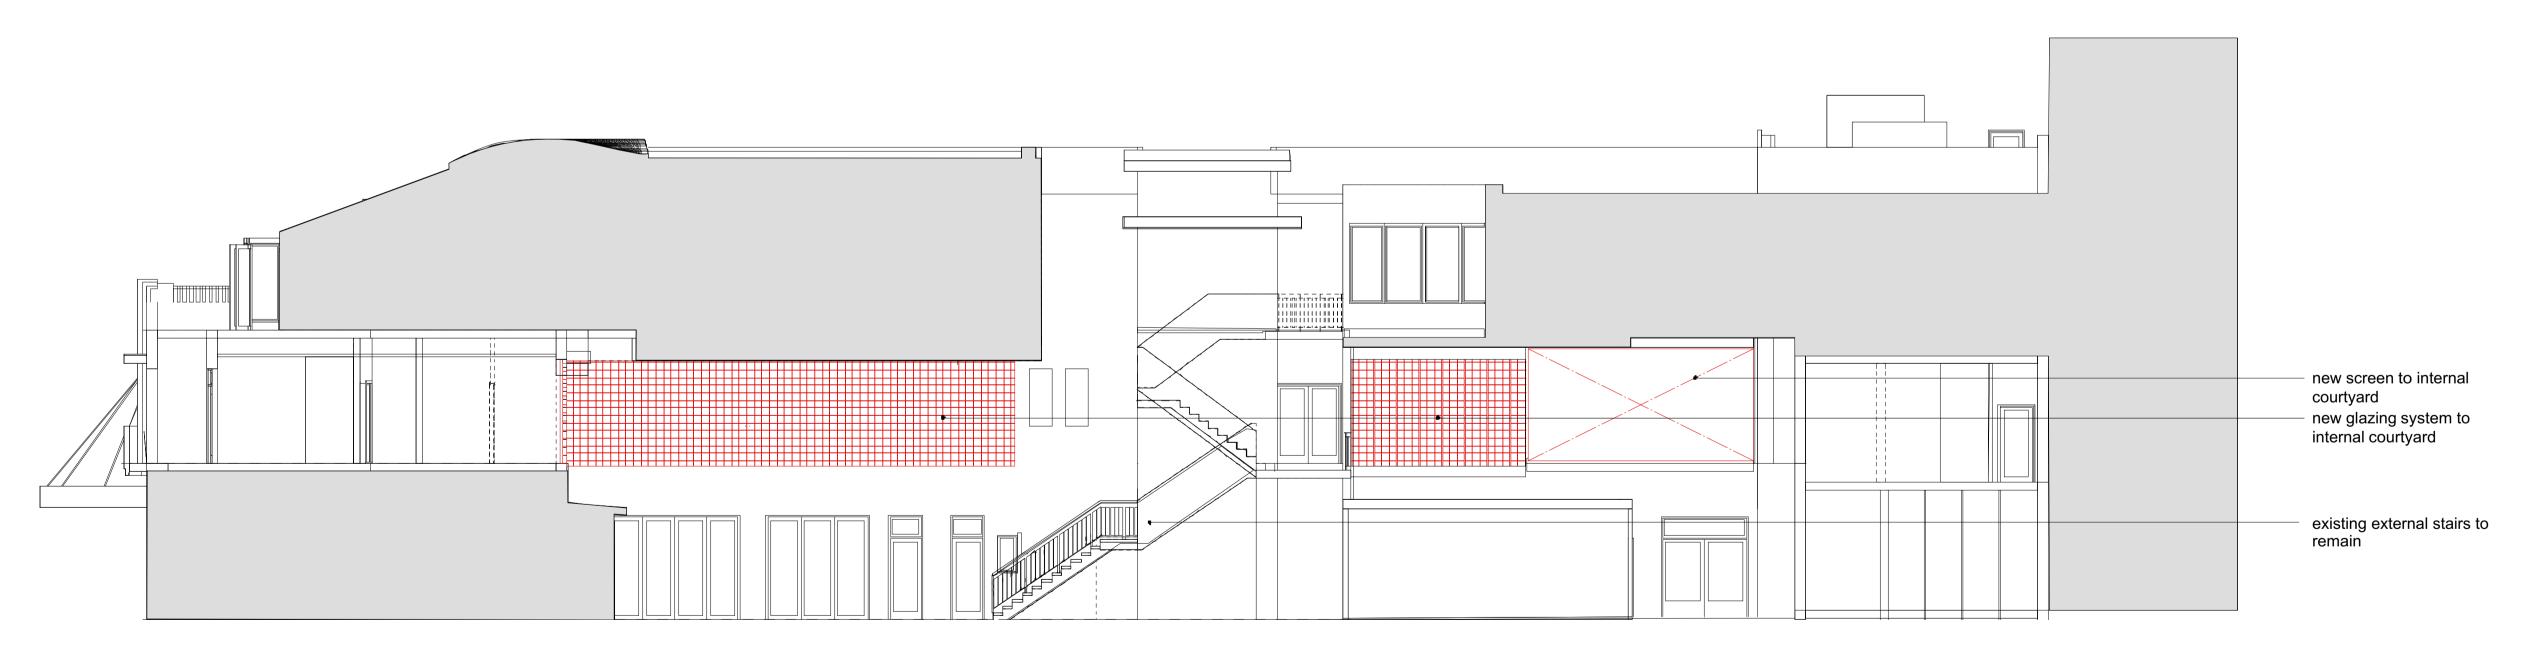

1 Section 1:100 @ A1

56 Cooper Street Surry Hills NSW 2010 +61 2 9699 3425 studio@luchettikrelle.com ABN 56 132 869 120 LUCHETTI KREL Ľ,

© Luchetti Krelle Pty Ltd Nominated Architect (NSW Australia only) Tommy Ford 9178. Copyright in all documents and drawings prepared by Luchetti Krelle and in any own't executed from those documents and drawings shall remain the property of Luchetti Krelle or on creation vest in Luchetti Krelle. These documents must not be used, reproduced or copied, in whole or in part, nor may the information, ideas, concepts therein contained (which are confidential to Luchetti Krelle) be disclosed to any person without the prior written consent of that company.

- Do not scale drawings. Use figured dimensions only. - All works to be in accordance with the Building Code of Australia (BCA), Australian Standards (AS), and relevant authorities' requirements. - Any discrepancies, dimensional inconsistencies or the need for clarification must be reported to Luchetti Krelle and consultants immediately. - This drawing is to be read with all Luchetti Krelle and project documentation, including specifications, schedules, drawings and reports.

- All areas yeilds and calculations are preliminary and indicative only and subject to detailed and further survey, design and client and consultant input and advice.

DESIGN INTENT FOR APPROVAL ONLY, NOT FOR CONSTRUCTION

Rev Description

A Draft Issue for Consultant Review

B Issue for approval review

C Issue for approval review D Issue for approval review 8/11/19 11/11/19 13/11/19 20/11/19

Date

– ne int
– ne
er
er at
– ex

new glazing system to nternal courtyard new glazing system to enclose existing balcony at new hotel room.

existing mural to remain

ISSUE FOR AUTHORITY APPROVAL

Hotel Steyne **Ground Floor**

19049 75 The Corso Manly NSW 2095

Iris Capital

Overall Sections

Date 8/11/19

0 2 Scale 1:100@A1

Scale 1:100

metres

Drawn: LK

DRAWING NO. DA.350

REVISION

D



 LUCHETTI
 56 Cooper Street

 Surry Hills NSW 2010
 +61 2 9699 3425

 +61 2 9699 3425
 studio@luchettikrelle.com

 ABN 56 132 869 120

© Luchetti Krelle Pty Ltd Nominated Architect (NSW Australia only) Tommy Ford 9178. Copyright in all documents and drawings prepared by Luchetti Krelle and in any work executed from those documents and drawings shall remain the property of Luchetti Krelle or on creation vest in Luchetti Krelle. These documents must not be used, reproduced or copied, in whole or in part, nor may the information, ideas, concepts therein contained (which are confidential to Luchetti Krelle) be disclosed to any person without the prior written consent of that company. Do not scale drawings. Use figured dimensions only.
 All works to be in accordance with the Building Code of Australia (BCA), Australian Standards (AS), and relevant authorities' requirements.
 Any discrepancies, dimensional inconsistencies or the need for clarification must be reported to Luchetti Krelle and consultants immediately.
 This drawing is to be read with all Luchetti Krelle and project documentation, including specifications, schedules, drawings and reports.
 All areas velids and calculations are preliminary and indicative only and subject to detailed and

 specifications, schedules, drawings and reports.
 All areas yeilds and calculations are preliminary and indicative only and subject to detailed and further survey, design and client and consultant input and advice.

DESIGN INTENT FOR APPROVAL ONLY, NOT FOR CONSTRUCTION

Rev	Description
А	Draft Issue for Consultant Review
В	Issue for approval review
С	Issue for approval review
D	Issue for approval review

Date 8/11/19 11/11/19 13/11/19 20/11/19 _ new doors to terrace _ over internal courtyard

 extension to existing terrace over internal courtyard

 new glazing system to internal courtyard

ISSUE FOR AUTHORITY APPROVAL

Hotel Steyne Ground Floor

19049 75 The Corso Manly NSW 2095

Iris Capital

Overall Sections

Date 8/11/19

Scale 1:100@A1

Scale 1:100

metres

Drawn: LK drawing no.

DEMOLITION TYPE LEGEND

	EXISTING WALLS AND DOORS TO BE RETAINED - CHECK ON SITE			
	EXISTING WALLS AND DOORS TO BE DEMOLISHED - CHECK ON SITE			
CL	EXISTING DOORS TO BE PERMANENTLY CLOSED OFF. RETAIN DOOR AND ARCHITRAVE IN SITU TO CORRIDOR SIDE AND INSTALL LINING OVER DOOR TO GUESTROOM - CHECK ON SITE			
TGL	EXISTING DOORS TO BE PERMANENTLY CLOSED OFF. RETAIN EXISTING DOOR IN SITU AND REPLACE EXISTING GLASS WITH TRANSLUCENT GLASS TO MAINTAIN PRIVACY - CHECK ON SITE			
R	EXISTING DOORS TO BE RETAINED FOR RELOCATION OR REVERSAL IN SITU - CHECK ON SITE			

cased opening







© Luchetti Krelle Pty Ltd Nominated Architect (NSW Australia only) Tommy Ford 9178. Copyright in all documents and drawings prepared by Luchetti Krelle and in any own't executed from those documents and drawings shall remain the property of Luchetti Krelle or on creation vest in Luchetti Krelle. These documents must not be used, reproduced or copied, in whole or in part, nor may the information, ideas, concepts therein contained (which are confidential to Luchetti Krelle) be disclosed to any person without the prior written consent of that company.

- Do not scale drawings. Use figured dimensions only. - All works to be in accordance with the Building Code of Australia (BCA), Australian Standards (AS), and relevant authorities' requirements. - Any discrepancies, dimensional inconsistencies or the need for clarification must be reported to Luchetti Krelle and consultants immediately. - This drawing is to be read with all Luchetti Krelle and project documentation, including specifications, schedules, drawings and reports. - All areas yeilds and calculations are preliminary and indicative only and subject to detailed and

further survey, design and client and consultant input and advice.

DESIGN INTENT FOR APPROVAL ONLY, NOT FOR CONSTRUCTION

Rev Description A Draft Issue for Consultant Review B Issue for approval review

C Issue for approval

D Issue for approval

8/11/19 11/11/19 12/11/19 20/11/19

Date

7	-demolish wall for new access
	-demolish existing window and form new opening in existing wall for new doors as part of new proposed plan works
	-demolish existing bathrooms and all associated flooring, equipment and fixtures shown in red dotted line
	-form new opening in existing wall to accomodate new bathroom as part of new proposed plan works
	form new opening in existing wall to accomodate new bathroom as part of new proposed plan works
þ	

ISSUED FOR AUTHORITY APPROVAL

The Steyne Hotel Manly | L1 - Demolition Plan

19049 75 The Corso Manly NSW 2095

Date

Scal September 2019 1:100 @ A1 Scale 1:100@A1

Drawn: LK

metres


DRAWING NO.

REVISION

D

DA1.030

Iris Capital

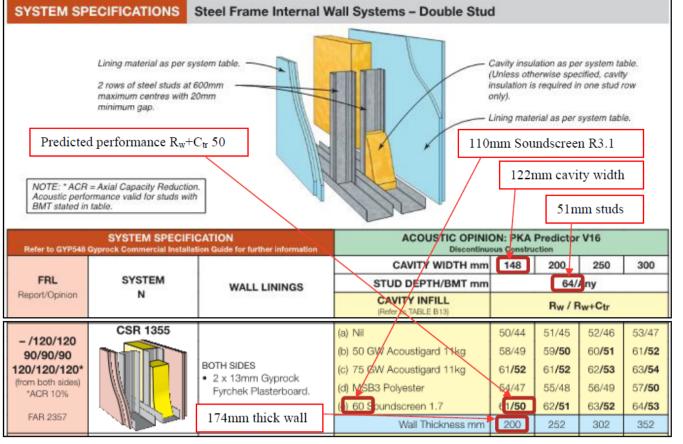


Acoustic wall type for all new internal walls

Accomodation Capacity	Room quantity	Capacity
Existing	25 rooms	58 people
Previously approved DA	41 rooms	82 people
Proposed DA	42 rooms	84 people

PARTITION TYPE LEGEND				
	EXISTING WALLS TO BE RETAINED			
	NEW WALLS/INFILLS/SERVICES			
• - •	NEW GLAZING SYSTEM			



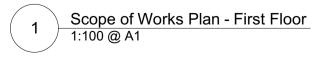



© Luchetti Krelle Pty Ltd Nominated Architect (NSW Australia only) Tommy Ford 9178. Copyright in all documents and drawings prepared by Luchetti Krelle and in any work executed from those documents and drawings shall remain the property of Luchetti Krelle or on creation vest in Luchetti Krelle. These documents must not be used, reproduced or copied, in whole or in part, nor may the information, ideas, concepts therein contained (which are confidential to Luchetti Krelle) be disclosed to any person without the prior written consent of that company.

- Do not scale drawings. Use figured dimensions only. - All works to be in accordance with the Building Code of Australia (BCA), Australian Standards (AS), and relevant authorities' requirements. - Any discrepancies, dimensional inconsistencies or the need for clarification must be reported to Luchetti Krelle and consultants immediately. - This drawing is to be read with all Luchetti Krelle and project documentation, including specifications, schedules, drawings and reports. - All areas yeilds and calculations are preliminary and indicative only and subject to detailed and further survey, design and client and consultant input and advice.

DESIGN INTENT FOR APPROVAL ONLY, NOT FOR CONSTRUCTION

- Rev Description A Draft Issue for Consultant Review B Issue for approval review C Issue for approval review
- D Issue for approval review E Issue for approval review
- 11/11/19 12/11/19 20/11/19 29/11/19

8/11/19

-new platform lift

ISSUED FOR AUTHORITY APPROVAL

The Steyne Hotel Manly | L1 - Scope of Works Plan

19049 75 The Corso Manly NSW 2095

Iris Capital

1:100 @ A1

metres


Drawn: LK

DRAWING NO.



Sep 19 Scale 1:100@A1

Date

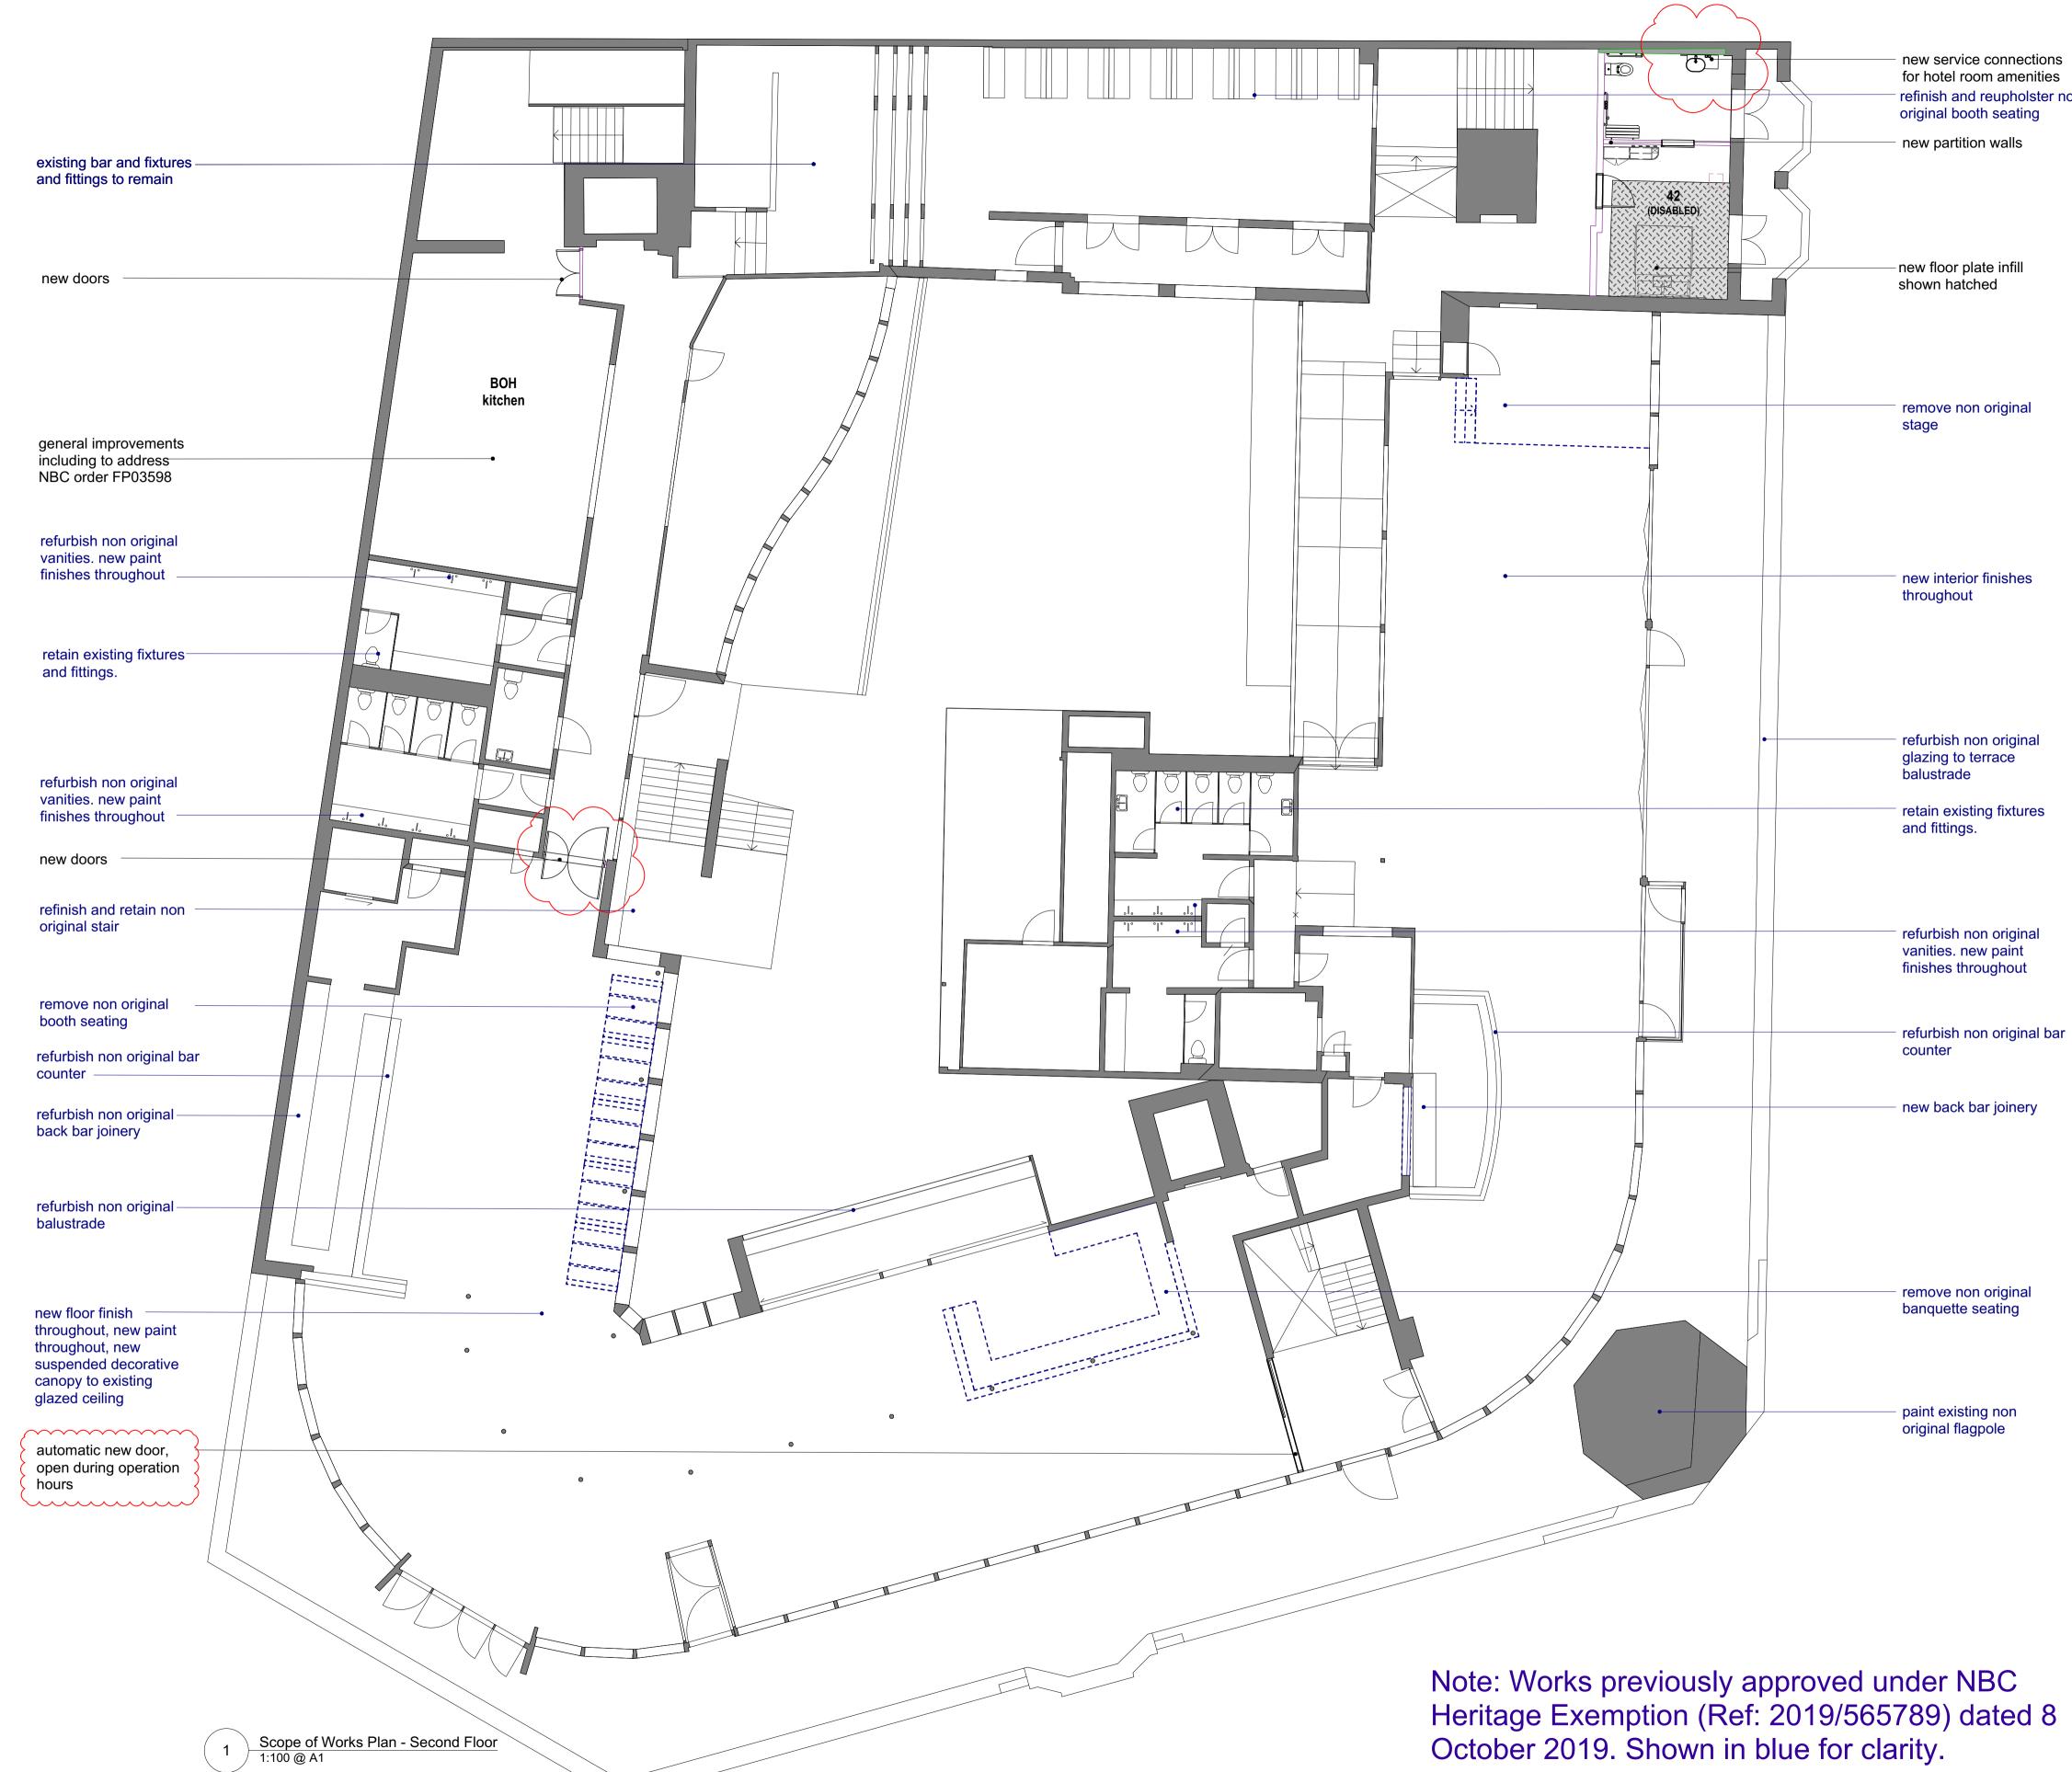

LUCHETTI 56 Cooper Street Surry Hills NSW 2010 +61 2 9699 3425 KREL www.luchettikrelle.com ABN 56 132 869 120

© Luchetti Krelle Pty Ltd Copyright in all documents and drawings prepared by Luchetti Krelle and in any work executed from those documents and drawings shall remain the property of Luchetti Krelle or on creation vest in Luchetti Krelle. These documents must not be used, reproduced or copied, in whole or in part, nor may the information, ideas, concepts therein contained (which are confidential to Luchetti Krelle) be disclosed to any person without the prior written consent of that company.


DO NOT SCALE DRAWINGS. USED FIGURED DIMENSIONS ONLY. VERIFY ALL DIMENSIONS ON SITE.

ALL WORKS TO BE IN ACCORDANCE WITH THE BUILDING CODE OF AUSTRALIA (BCA), AUSTRALIAN STANDARDS (AS), AND RELEVENT AUTHORITIES' REQUIREMENTS. ANY DISCREPANCIES, DIMENSIONAL INCONSISTENCIES OR THE NEED FOR CLARIFICATION MUST BE REPORTED TO LUCHETTI KRELLE & CONSULTANTS IMMEDIATELY THIS DRAWING IS TO BE READ WITH ALL LUCHETTI KRELLE & PROJECT DOCUMENTATION, INCLUDING SPECIFICATIONS, SCHEDULES, DRAWINGS & REPORTS. - ALL AREAS YIELDS & CALCULATIONS ARE PRELIMINARY & INDICATIVE ONLY & SUBJECT TO DETAILED & FURTHER SURVEY, DESIGN & CLIENT AND CONSULTANT INPUT & ADVICE.

DESIGN INTENT FOR APPROVAL ONLY, NOT FOR CONSTRUCTION

- Rev Description A Draft Issue for Consultant Review B Issue for approval review C Issue for approval review
- D Issue for approval review
- E Issue for approval review



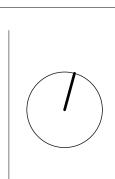


	new service connections for hotel room amenities refinish and reupholster non
	original booth seating new partition walls
J	
	new floor plate infill shown hatched
	remove non original stage
	new interior finishes throughout
	refurbish non original
	glazing to terrace balustrade
	retain existing fixtures and fittings.
	er ford is house a sisteral
	refurbish non original vanities. new paint finishes throughout
	refurbish non original bar counter
	new back bar joinery
	remove non original banquette seating
	point existing pop
	paint existing non original flagpole

ISSUE FOR AUTHORITY APPROVAL

The Steyne Hotel Manly	L2 - Scope o	DRAWING NO.		
19049				DA2.040
75 The Corso Manly NSW 2095	Date November 19	Scale 1:100	Drawn: LK	
Iris Capital	0 <u>2</u> Scale 1:100@A1	5 metres		

BEACH BAR FINISHES


MARBLE - BAR TOP
 WASHED PAINTED TIMBER - BAR FRONT
 TILES - COURTYARD ADJACENT BAR FRONT
 TILE MOSAIC - FLOOR
 TIMBER WALNUT - THORUGHOUT
 GRANITE STONE - ENTRY FLOOR
 UPHOLSTERY - BANQUETTES
 VINYL FLOOR

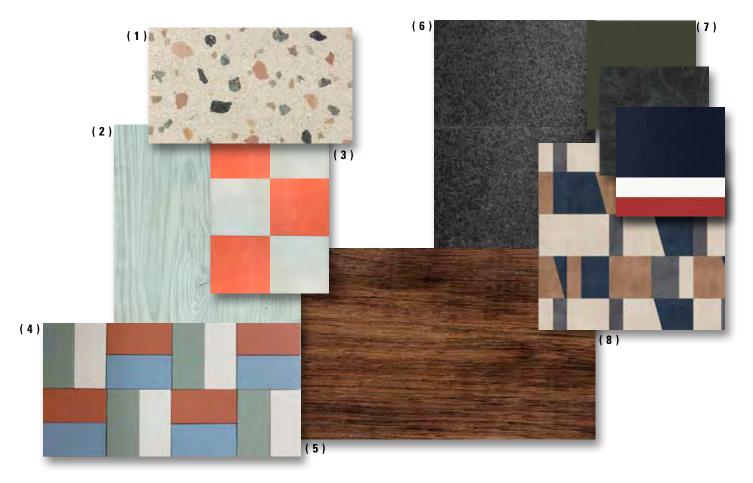

SALOON BAR FINISHES

EXISTING BRASS POLISHED - TROUGHOUT
 LINO FLOOR - TO MATCH HISTORICAL LINO

3. EXISTING TIMBER RESTORED - THROUGHOUT

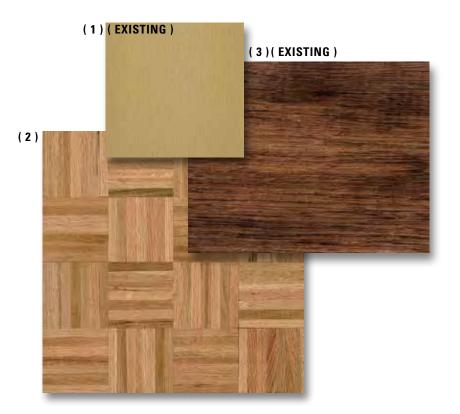


BOTTLE SHOP

FINISHES

1. MARBLE - JOINERY

- 2. CORK THROUGHOUT
- **3.** TIMBER WALNUT THROUGHOUT
- 4. WIRE SAFETY GLASS JOINERY
- 5. EXISTING CONCRETE FLOOR RETAINED

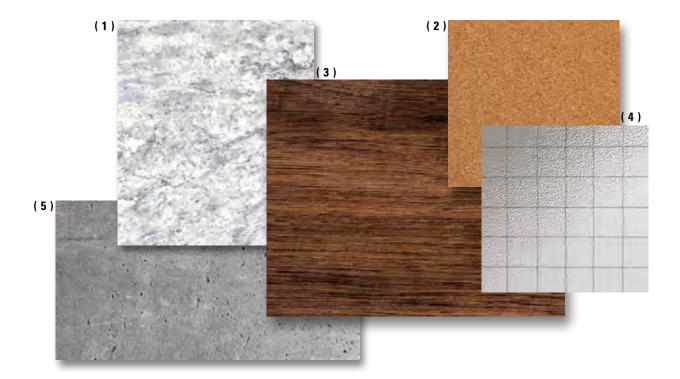

SPORTS BAR

FINISHES


ACOUSTIC CEILING
 TIMBER WALNUT - THROUGHOUT
 EXISTING CONCRETE FLOOR RETAINED
 BRASS - THORUGHOUT
 BRONZE - THORUGHOUT
 MIRROR - JOINERY
 EXISTING FLOOR TILES RETAINED



COURTYARD

FINISHES

MARBLE - BAR TOP
 TIMBER WHITE WASHED
 BLUESTSONE PAVING
 TILE - JOINERY
 TILE - BAR FRONT
 FLOOR TILE - GAMES AREA

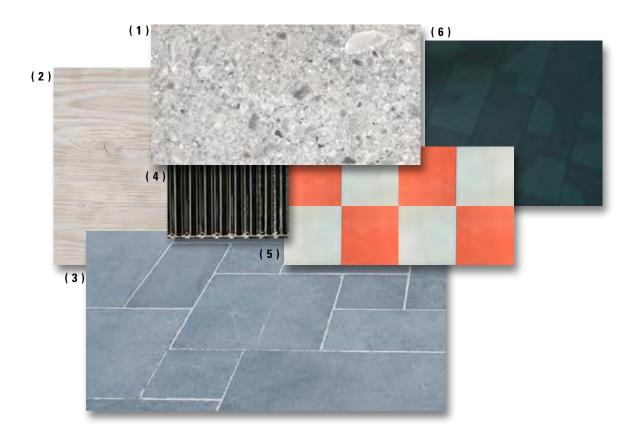

GAMING FINISHES

MARBLE - JOINERY
 TILE - JOINERY
 MARBLE MOSAIC FLOORING
 CARPET
 TILE - AMENITIES

