





As Built drawing number ID 2.01 rev 2, provided to PMDL by Lendlease. All dimenisons to be confirmed on site prior to commencement of works.

2. Refer to DA005 for proposed new works to elevation.







Proposed Floor Plan

NAB Manly NSW


pmdl.com.au

1:100 @ A3

23.11.21



MOD2021/0924

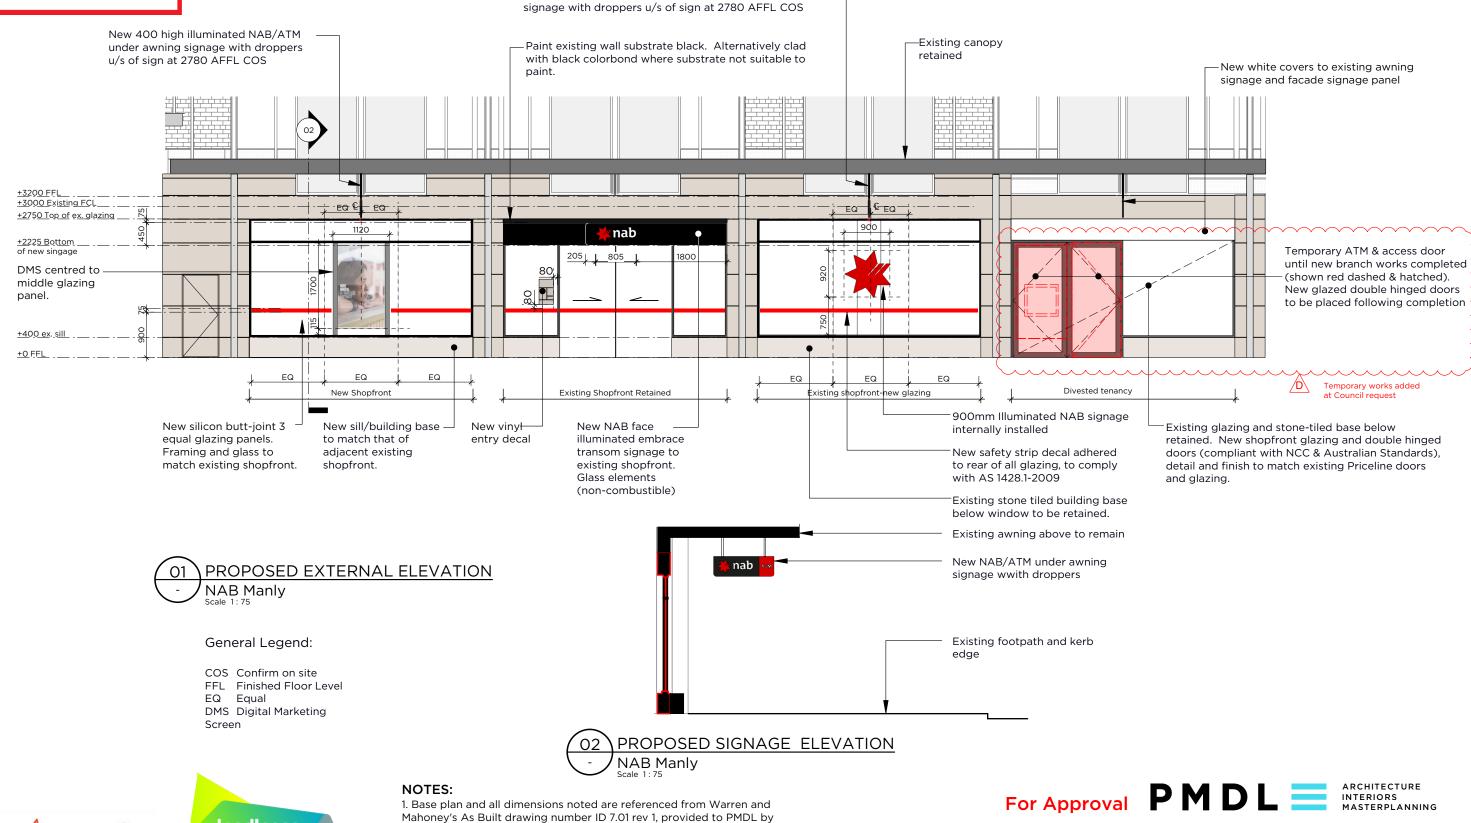

Proposed Elevation

pmdl.com.au

2997 Scale

1:75 @ A3

NAB Manly NSW

DA005 D

15.11.21

Lendlease. All dimenisons to be confirmed on site prior to commencement of

New 400 high illuminated NAB/ATM under awning



works.