

Peter J Boyce & Associates

Ph 0412 928 500

P O Box 375 Strathfield 2135 Ph 9868 2855
Level 2, 41 Rawson Street, Epping 2121
Building Surveyor Acc No BPB0043 Fax 9868 2655

Your ref D/A NO371/06 – NO371/06(M)

28th April 2010

The General Manager
Pittwater Council
PO Box 882
MONA VALE NSW 1660

Dear Sir,

Re Copy of Partial Construction Certificate
22 Quarter Sessions Road Church Point


Please find enclosed copy of Partial Construction Certificate issued
for the above property under D/A NO371/06 – NO371/06(M)

Please find cheque enclosed for \$30 00 for registration of Partial
Construction Certificate

Yours faithfully



Peter Boyce

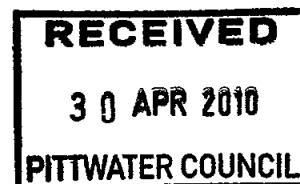

PRVC \$30 REC 278967
30/4/10

Application for Amended Construction Certificate

RECEIVED 21 APR 2006
PARTIAL

Issued under the Environmental Planning and Assessment Act 1997 Part 3 - Schedule 1

Local Council Area

City, Council or Shire

PITWATER COUNCIL

Applicant

Name

NICHOLAS DUNN & ASSOCIATES

Address

10/281 PACIFIC HIGHWAY, NORTH SYDNEY NSW 2060

Phone

(02) - 9956 - 5454

Owner

Name

R. MANOEL & S. MCCARTHY

Address

22 QUARTER SESSIONS ROAD

Phone


CHURCH POINT NSW 2105

(02) 9999-2765

Consent of all owner(s)

I/we consent to this application

Signature

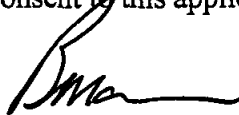

Subject Land with lot & deposited plan number

Address

LOT 2 IN DP 618481

22 QUARTER SESSIONS RD, CHURCH POINT

Brief description of development

Type of Development

MODIFICATIONS TO HOME DWELLING

i.e Dwelling Addition

Excluding spa, pergola & refit swimming pool

Building code of Australia

Building Classification

Class 1a

Development Consent

Development consent number

N0371/06

Date of Determination

10th November 2006

Builder/Owner Builder

Name or Permit number

Address

GRATER CONSTRUCTION GROUP

572 WILLONGHBY ROAD

WILLONGHBY, NSW 2068


Lic No 71953C

Value of Work \$212,000

Required attachments --- Copy of D/A approval with Conditions
Three copies of the plans & Specification
Plan Nos
List of supporting documents

Schedule --- The building schedule must be completed as part of this
application for the Australian Bureau of Statistics

Applicants Signature

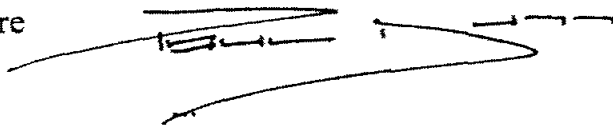A handwritten signature in black ink, consisting of several horizontal strokes and a large, sweeping loop at the bottom.

Peter J Boyce & Associates

Level 2, 41 Rawson St Epping NSW 2121

Ph 9868 2855

email info@boycecorp.com.au

Fax 9868 2655

Planning NSW Building Surveyor No BPB0043

PARTIAL CONSTRUCTION CERTIFICATE

Certificate No. BP7210 (A)

This certificate is issued by a certifying authority and verifies that, if the applicant carries out the proposed work in accordance with the plans and specifications that are approved, the work will comply with the Environmental Planning and Assessment Act 1979 and Regulations 2000

Applicant

Name	Mr R. Mander & Ms S McCarthy
Address	22 Quarter Sessions Road Church Point
Contact Number	9999 2765
Email	-

Development

Development Consent No	D/A NO371/06 – NO371/06(M)
Consent Date	10 th November 2006 – 13 th March 2007(M)
Site Address	22 Quarter Sessions Road Church Point
Property Identification	Lot 2 DP 618481
Building Classification under BCA	1a

Pursuant to Section 109C (1) (b), 81A (2) and 81A (4) Of the Environmental Planning & Assessment Act, 1979 the construction certificate has been determined by approval in accordance with the stamped plans and specifications

Approval

Plan Nos Approved	Nicholas Dunn & Associates – Drawing Nos 02 to 10 & 27
Description of works Approved	Alterations and additions to existing dwelling excluding spa, pergola and re-fit of the swimming pool
Partial Construction Certificate Determination Date	BP7210(A) 28 APR 2007

Note

Prior to commencement of work, Section 81A (2) (b) and/or 81A (4) (b) and (c) Of the Environmental Planning & Assessment Act, 1979 must be satisfied (see form 7 of the Regulation) i.e name of the Principal Certifying Authority

I certify that the work if completed in accordance with the documents, plans and specifications accompanying the application will comply with the requirements of this regulation as are referred to in Section 81A (5) of the Environmental Planning & Assessment Act 1979

Accredited Certifier

Name of Accredited Certifier	Peter Boyce
Accreditation No of Certifier	Planning NSW Accreditation No BPB0043
Signature	

Peter J Boyce & Associates

Ph 9868 2855 P O Box 375 Strathfield NSW 2135 Fax 9868 2655
Planning NSW Accreditation No BPB0043

Tax Invoice

ABN 92 616 124 481

Mander R & McCarthy S

Invoice # 00002807
Date 21/04/2010

Services Rendered	Amount	Code
2 Quarter Sessions Road Church Point - BP7210 (A)		
1/4/10 - Amended Construction Certificate	\$400 00	GST
Council Registration Fee	\$30 00	N-T
Council Registration Fee PAID	-\$30 00	N-T

Terms 7 Days	GST	\$40 00
	Total Inc	\$440 00
	Amount	\$440 00
	Balance Due	\$0 00


"This is a payment claim made under the Building and Construction Industry Security of Payment Act 1999 NSW"

Payment Options		
 Mail your Payment	 Electronic Payments	 Credit Card
Please make cheques payable to Peter J Boyce & Assoc and post, along with remittance advice, to P O Box 375 Strathfield NSW 2135	Please make payments to, BSB. 032 087 Account # 19 89 67 Please ensure invoice # is inserted as reference	Please call 9868 2855 during business hours to pay your invoice by Visa or Mastercard

Remittance Advice

Mander R & McCarthy S

Invoice # 00002807
Date
Balance Due \$0 00

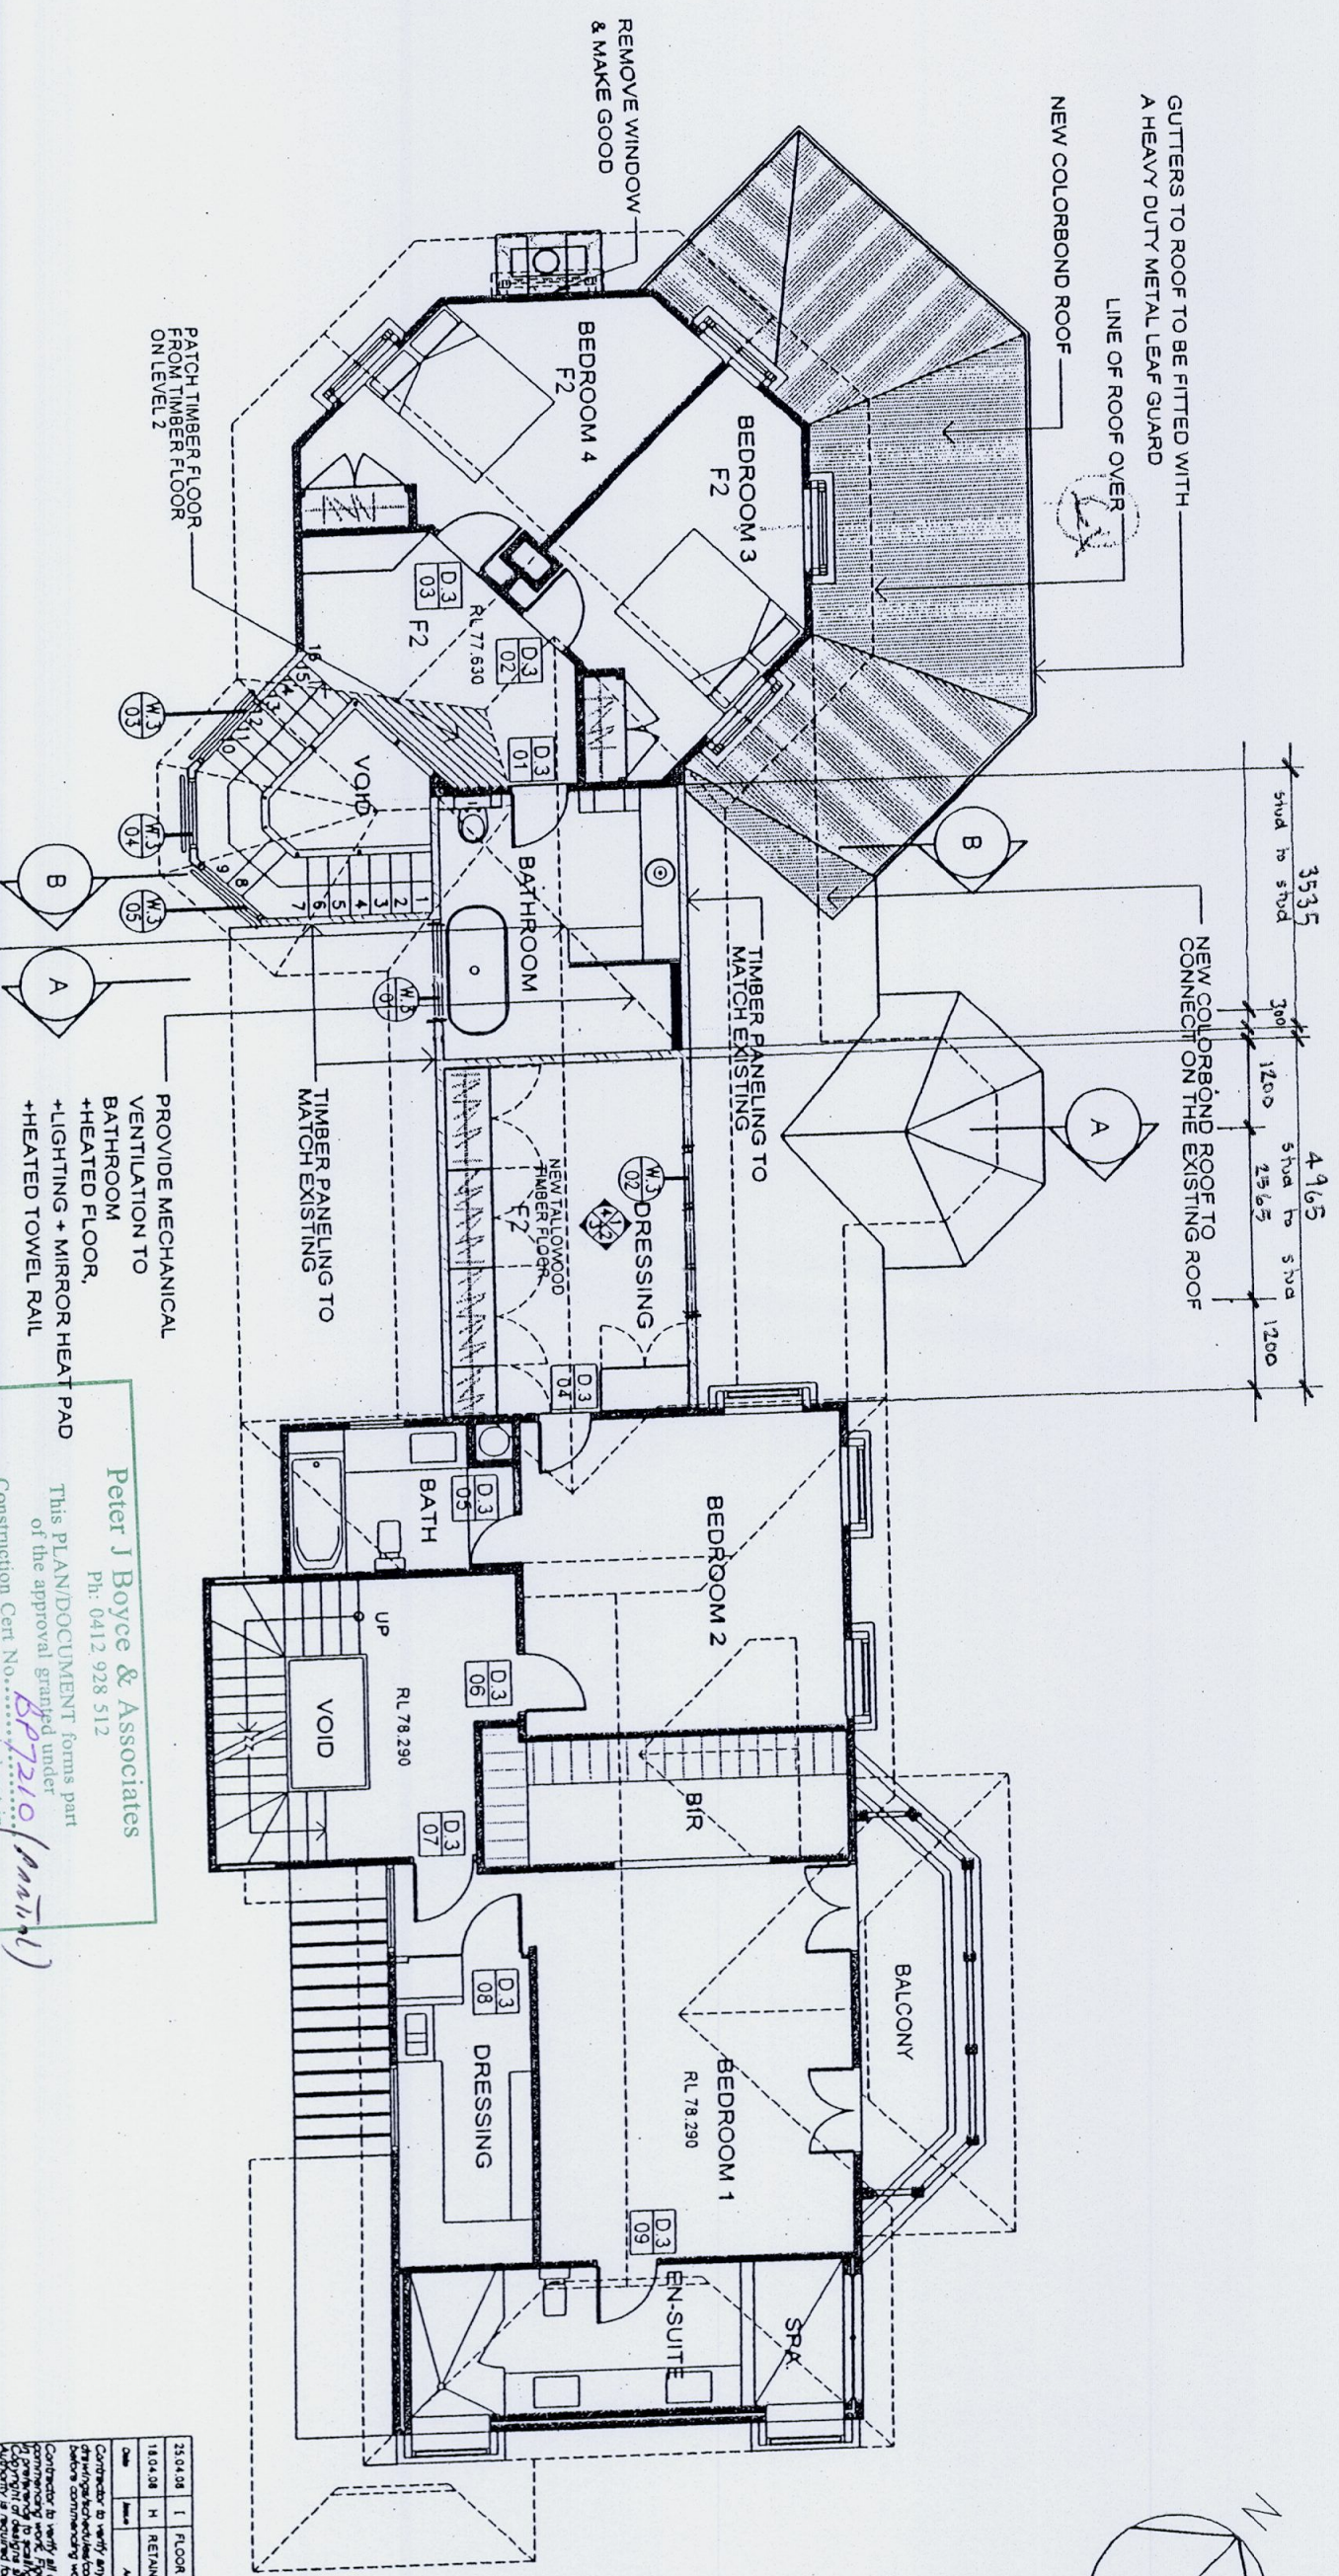

PROVIDE MECHANICAL VENTILATION TO BATHROOM + HEATED FLOOR, + LIGHTING + MIRROR HEAT PAD + HEATED TOWEL RAIL

REFER TO CONSULTANTS LAYOUT - ROBERT DYSON DESIGN

Peter J Boyce & Associates
Ph: 0412 928 512
This PLAN/DOCUMENT forms part of the approval granted under Construction Cert No. **BP7210 (partial)**
And all work must be carried out in accordance with the Building Code of Australia 2007 and subsequent amendments
Accredited Building Surveyor BSB No. 0043

NOTE:

- PROVIDE NEW CEILING IN THIS AREA.
- CEILING TO FOLLOW ROOF FORM.
- TIMBER IS REQUIRED FOR PATCHING LEVEL 2 FLOORS, THE TIMBER IN THIS AREA TO BE USED.
- ALLOW FOR NEW TIMBER FLOOR IN THIS AREA.

LIGHTING:

- "C - BUS" NOT TO BE USED
- ALL PLATES AND SWITCHES TO BE THE CLIPSAL "SATURN COLLECTION" FLAT PLATE FOR BOTH NEW AND EXISTING

PLAN - LEVEL 3

25.04.08 1 FLOOR & ROOF FINISHES REVISED		
Date	By	Approved
18.04.08	H	REIN EXISTING ROOF OVER BEDRM 3 & 4

Contractor to verify all dimensions on site before commencing work. Revised dimensions given are to be taken from the original drawings and are to be taken as correct. No liability is accepted for any reproduction.

NICHOLAS DUNN + ASSOCIATES
10/180 Pacific Highway
Newcastle NSW 1590
Australia
Telephone 3955 5454
Facsimile 3955 8280

CLIENT
BOB MANDER & SUSIE MCCARTHY

PROJECT
**RENOVATION AND ALTERATIONS
22 QUARTER SESSIONS ROAD
CHURCH POINT**



DRAWING		PLAN LEVEL 3 UPPER FLOOR EXISTING + PROPOSED
Scale	1:100	
Date	JAN 2006	Drawing Number
Drawn By	PZ	04 J

ALL GUTTERS TO ROOF TO BE
FITTED WITH A METAL LEAF GUARD

NEW COLORBOND
ROOF

EXISTING ROOF TO BE REPLACED
WITH NEW COLORBOND ROOF
ALL GUTTERS TO ROOF TO BE
FITTED WITH A METAL LEAF GUARD

EXISTING ROOF TO BE REPLACED
WITH NEW COLORBOND ROOF
ALL GUTTERS TO ROOF TO BE
FITTED WITH A METAL LEAF GUARD

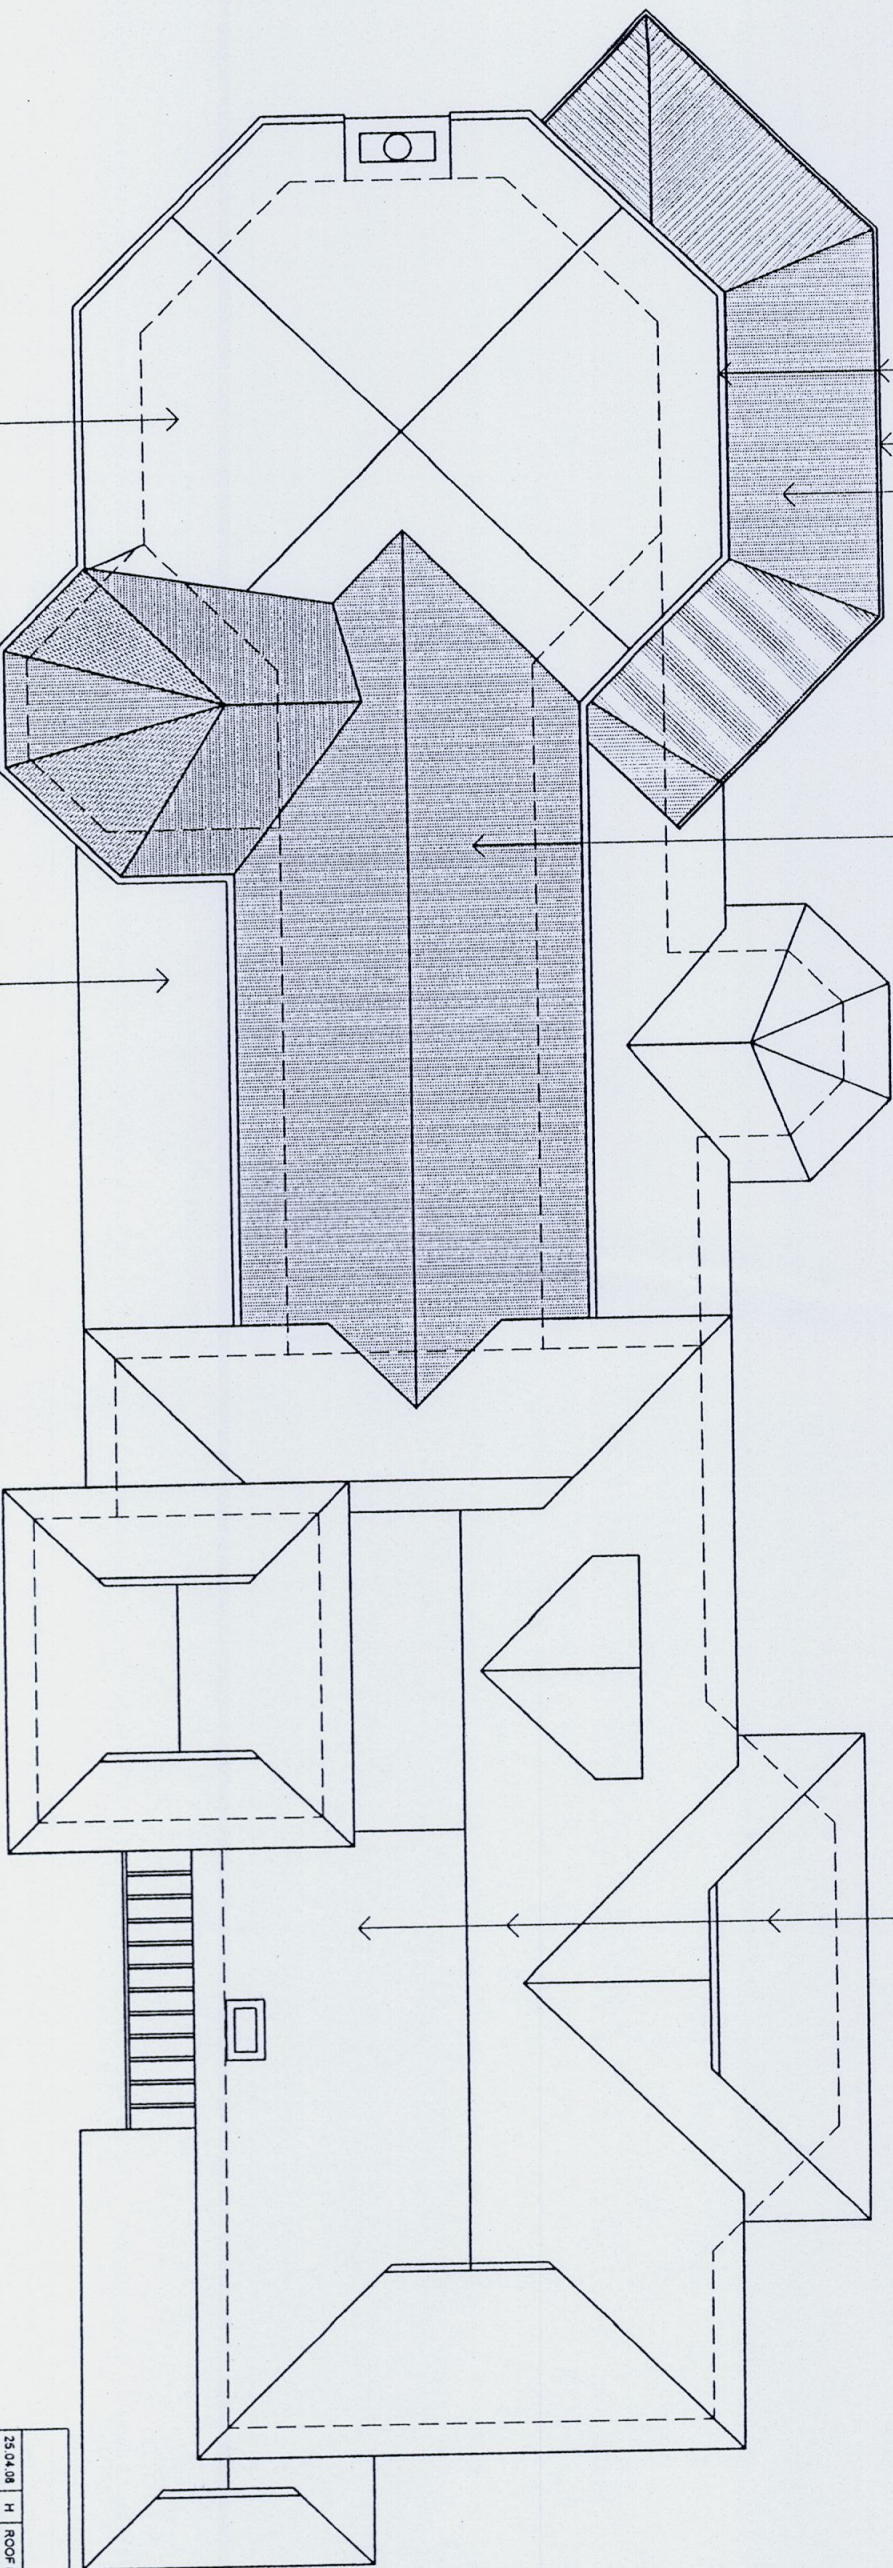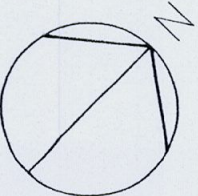

Peter J Boyce & Associates
Ph: 0412 928 512

This PLAN/DOCUMENT forms part
of the approval granted under

Construction Cert No.

And all work must be carried out in
accordance with the Building Code of

Australia 2001 and subsequent amendment

Accredited Building Surveyor BSB No.

NOTE:

1. ALL EXISTING ROOFING TO BE REPLACED
INCLUDING THE GARAGES WITH A SELECTED
COLORBOND ROOFING

2. GUTTERS TO BE HALF-ROUND IN THE SAME
COLORBOND

3. GUTTERS TO BE FITTED WITH A METAL LEAF GUARD

PLAN - ROOF

25.04.08	H	ROOF FINISHES REVISED & NOTE ADDED
18.04.08	G	RETAIN EXISTING ROOF OVER BEDRM 3 & 4
Contractor to verify any discrepancy that may exist between existing and proposed roof finishes and report back to the architect before commencing work. Contractor to verify all dimensions on site before commencing work. Figure dimensions given are to be taken in preference to scaling. Contractor to ensure that any necessary work is carried out in accordance with the Building Code of Australia 2001 and subsequent amendment. Authority is required for any reproduction.		

NICHOLAS
DUNN
+ ASSOCIATES

10/180 Pacific Highway
Australia 2000
Telephone 3955 5454
Facsimile 3955 5250

CLIENT
BOB MANDER & SUSIE Mc CARTHY

PROJECT
RENOVATION AND ALTERATIONS
22 QUARTER SESSIONS ROAD
CHURCH POINT

DRAWING
PLAN - ROOF
EXISTING + PROPOSED

Scale	1:100	Job	
Date	JAN 2006	Drawing Number	
Drawn By	PZ		05
Check By	PD		H

RL 86.625 (EXISTING)

SELECTED METAL
BI-FOLD LOUVRES
TO BE INSTALLED

LINE OF EXISTING
RIDGE

TIMBER PANELING
TO MATCH EXISTING

NEW COLORBOND ROOF

EXISTING ROOF

RL 83.575 (EXISTING)

RL 82.940 (EXISTING)

RL 80.675 (EXISTING)

NEW ROOF OVER
BALCONY

RL 77.630 LEVEL 3 (EXISTING)

RL 74.940
LEVEL 2
(EXISTING)

REMOVE GEORGIAN FRAMED
WINDOWS AND REPLACE WITH
PLAIN GLASS

FINISH EXISTING WALL WITH
A SELECTED STONE VENEER

71.95

NEW LEVEL OF PATH

EXISTING WINDOWS TO
BE RETAINED AND REPAIRED
REMOVE GEORGIAN FRAMED
WINDOWS AND REPLACE WITH
PLAIN GLASS

S.S. BALUSTRADE
REFER TO DRAWING
NO. 11, SECTION C-C

69.76

73.34

69.76

67.92

EXISTING WALL

NOTE:

— REMOVE EXISTING 'GEORGIAN FRAMED' WINDOWS
& REPLACE WITH PLAIN GLASS

NORTH EAST ELEVATION

Peter J Boyce & Associates

Ph. 0412 928 512

This PLAN/DOCUMENT forms part
of the approval granted under

Construction Cert No. **BP7210 (Mat. 1)**

And all work must be carried out in
accordance with the Building Code of
Australia 2007 and subsequent amendments

Accredited Building Surveyor BSB No. 0043

CLIENT

BOB MANDER & SUSIE Mc CARTHY

**NICHOLAS
DUNN
+
ASSOCIATES**
10/180 Pacific Highway
North Sydney 2060
Australia
Tel: 9554 5454
Fax: 9554 8280

Contractor to verify all dimensions and levels before commencing work.
Contractor to verify all dimensions and levels before commencing work.
Date	Issue	Amendment
18/03/09	K	MODIFICATIONS
25/04/08	J	RETAIN WINDOWS AT NOOK AREA
18/04/08	I	BASEMENT LEVEL 1 WALL REVISED
23/10/07	H	RETAIN ROOF OVER BEDRM 3 & 4
		BASEMENT LEVEL 1 RL REVISED

PROJECT
RENOVATION AND ALTERATIONS
22 QUARTER SESSIONS ROAD
CHURCH POINT

DRAWING
ELEVATION - NORTH EAST
EXISTING + PROPOSED

Scale	1:100	Job	
Date	JAN 2006	Drawing Number	
Drawn by	PZ	06	K
Chk by	PD		

RL 86.625
(EXISTING)

EXISTING ROOF TO BE REPLACED
WITH NEW COLORBOND ROOF

SELECTED METAL
BI-FOLD LOUVRES
TO BE INSTALLED

RL 83.575 (EXISTING)

RL 82.940 (EXISTING)

NEW COLORBOND
ROOF

RL 80.675 (EXISTING)

**NEW COLORBOND —
ROOF OVER BALCONY**

RL 77.630 LEVEL 3 (EXISTING)

— STONE CLADDING
TO CHIMNEY + BASE

S.S. BALUSTRADE

RL 74.940 LEVEL 2 (EXISTING)

—EXISTING STEPS

RL 71.980 LEVEL 1 BASEMENT

CONCRETE STAIRS-
WITH SELECTED

—RE-USE EXISTING TIMBER DECK
AND FOR ACCESS TO A/C DOORS
—ACCESS DOORS TO UNDERCROFTICE & Associates
TO REVIEW ON SITE
Ph. 0412 928 512

THIS PLANDOCUMENT Form, part
of the approval granted under
Construction Cert No. 687210
And all work must be carried out in
accordance with the Building Code of
Australia 2007 and subsequent amendments

NORTH WEST ELEVATION

Date	Issue	Amendment
22.05.08	K	ACCESS TIMBER DECK ADDED
25.04.08	J	REPLACE EXISTING ROOF WITH NEW COLORBOND ROOF
18.04.08	I	NOTE TO ACCESS DOOR REVISED. RETAIN EXISTING ROOF OVER BEDRM 1 & 4
23.10.07	H	BASEMENT LEVEL 1 RL REVISED

Contributor to verify any discrepancy that may exist between drawings/schedule/colour boards/details/instructions, etc before commencing work.

Contributor to verify all dimensions on site before commencing work. Planned dimensions given are to be taken in preference to as-built.

Copyright of designs remain inherent is maintained by the office. Admittance is required for any reproduction.

**NICHOLAS
DUNN +
ASSOCIATES**

▲ 101180 Pacific Highway
North Sydney 2060
Australia
Telephone : 9958 5454
Facsimile : 9956 8280

CUEN/
BOB MANDER & SUSIE Mc CARTHY

PROJECT
RENOVATION AND ALTERATIONS
22 QUARTER SESSIONS ROAD
CHURCH POINT

DRAWING
ELEVATION - NORTH WEST
EXISTING + PROPOSED

Scale	1:100	Job	
Date	JAN 2006	Drawing Number	
Drawn By	PZ		
Cal By	PD	08	K

RL 86.625 (EXISTING)

RL 83.575 (EXISTING)


RL 82.940 (EXISTING)

RL 80.675 (EXISTING)

RL 77.630 LEVEL 3 (EXISTING)

RL 74.940 LEVEL 2 (EXISTING)

RL 71.980 BASEMENT LEVEL 1

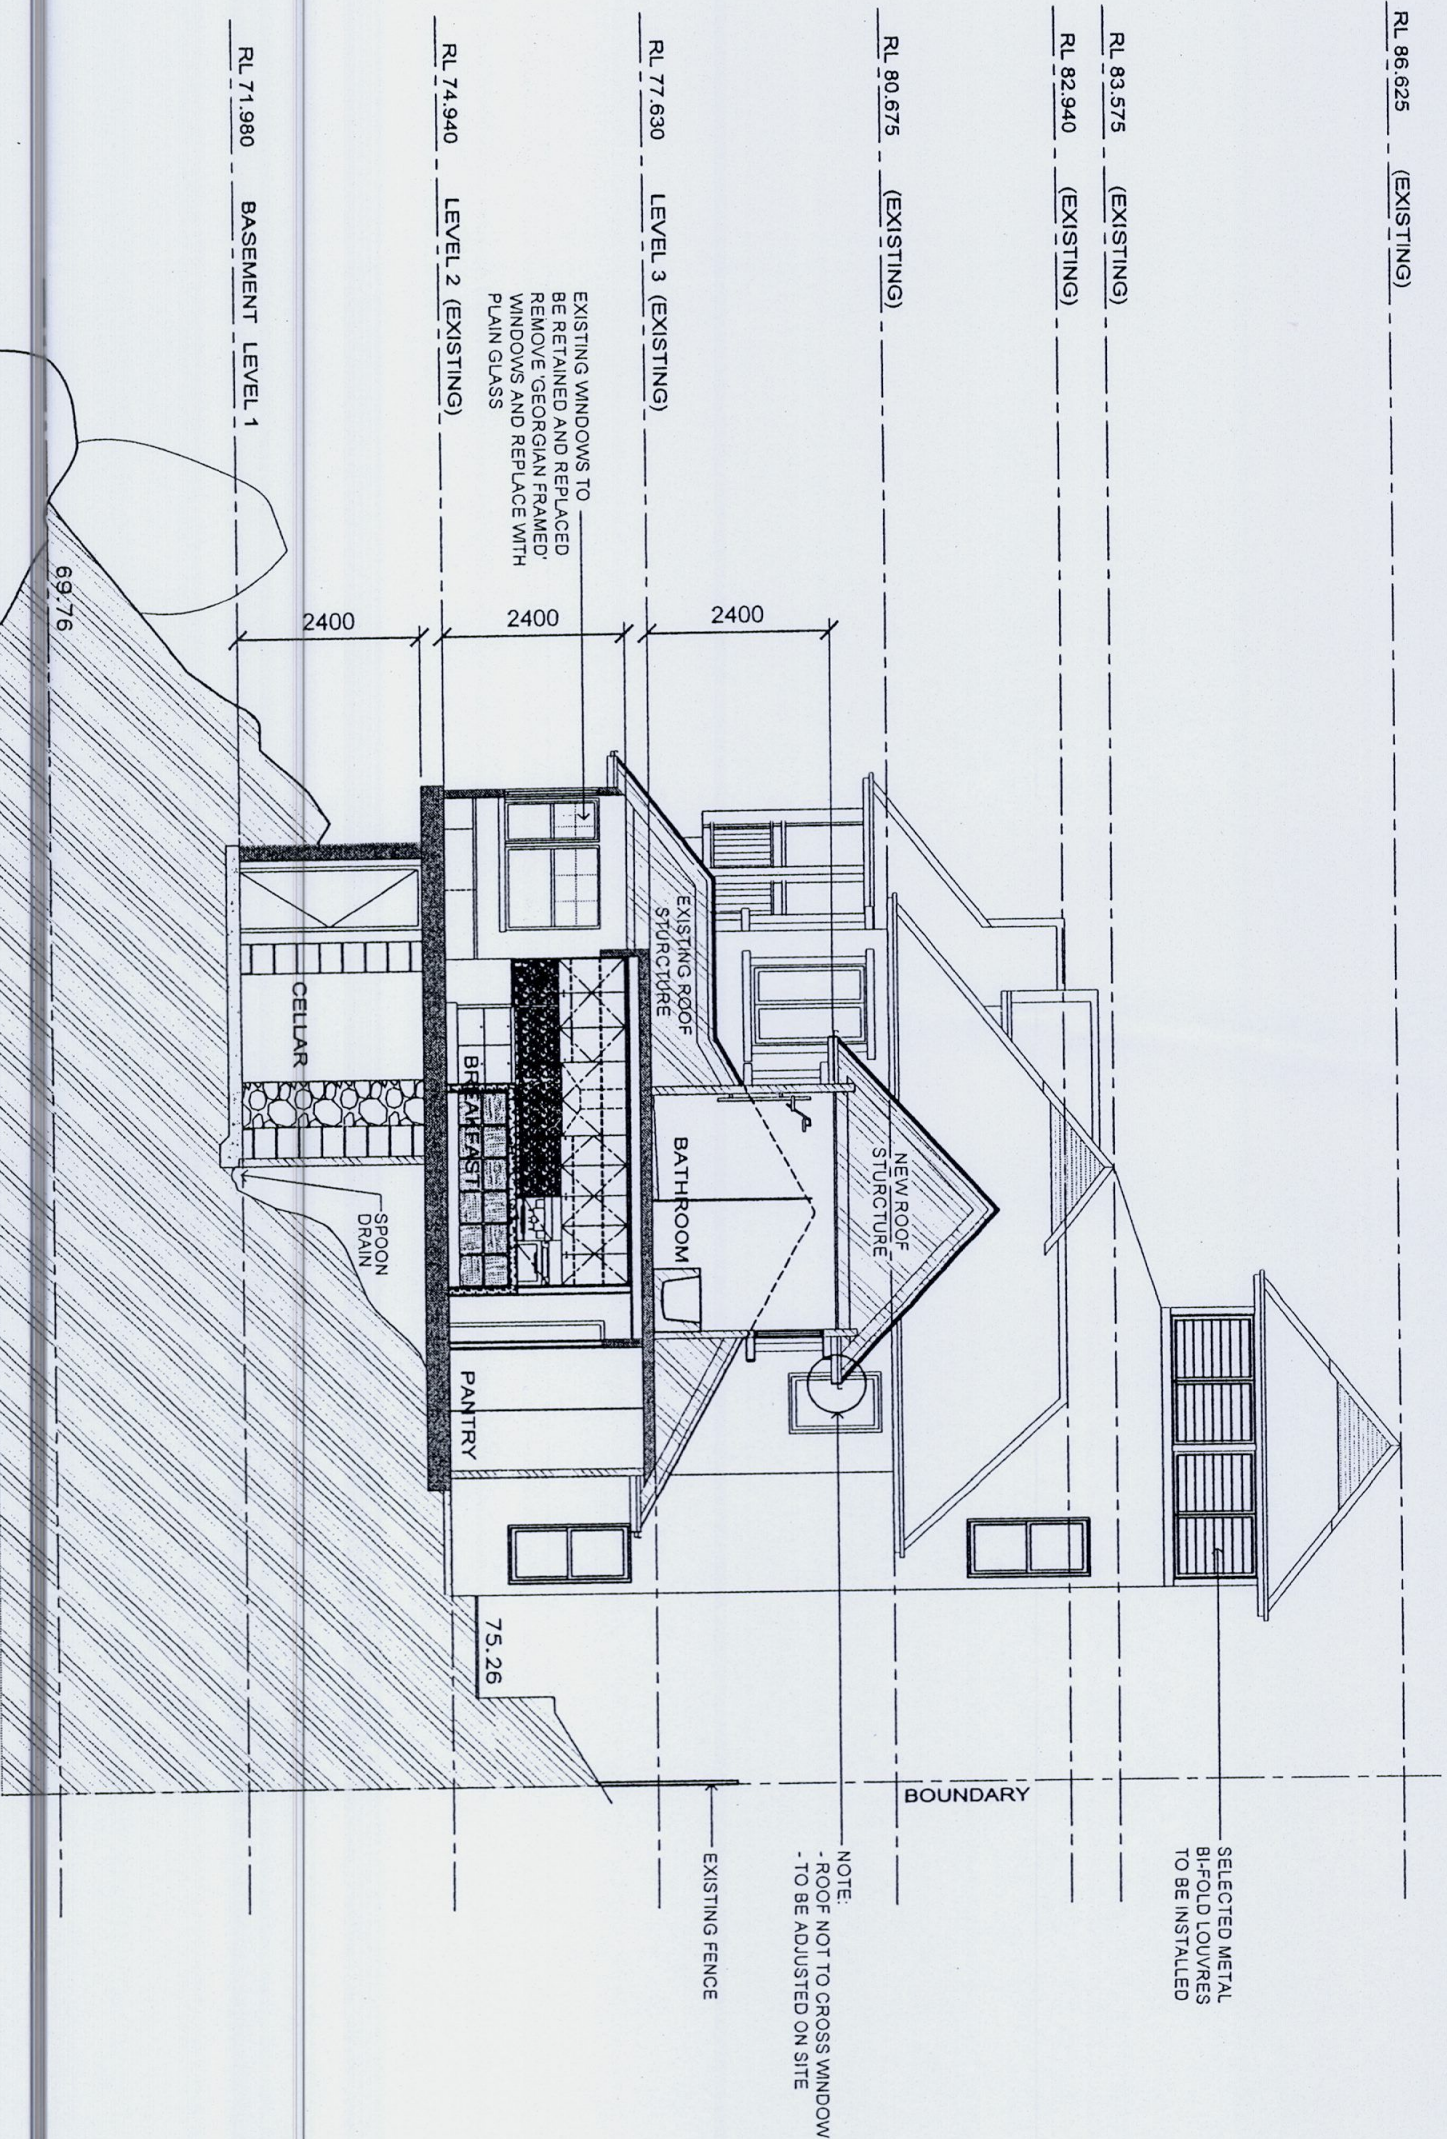

SECTION A-A

Peter J Boyce & Associates

Ph: 0412 928 512

This PLAN/DOCUMENT forms part of the approval granted under

Construction Cert No. 80210 (partial)

And all work must be carried out in accordance with the Building Code of Australia 2007 and subsequent amendments

Accredited Building Surveyor BSB No. 0043

25.04.08	J	SECTION AMENDED, NOTE ADDED
18.04.08	I	BASEMENT LEVEL 1 SECTION REVISED
23.10.07	G	BASEMENT LEVEL 1 RL REVISED
Date	Issue	Amendment

Contractor to verify any discrepancy that may exist between the existing and proposed levels and/or structural details. The contractor is to verify all dimensions on site before commencing work. Any discrepancy between the proposed and existing levels and/or structural details must be reported to the architect immediately. The architect is not responsible for any discrepancy between the proposed and existing levels and/or structural details.


NICHOLAS DUNN + ASSOCIATES
101/180 Pacific Highway
Newcastle NSW 2200
Australia
Telephone : 0955 5454
Facsimile : 0955 8280

CLIENT
BOB MANDER & SUSIE Mc CARTHY

PROJECT
RENOVATION AND ALTERATIONS
22 QUARTER SESSIONS ROAD
CHURCH POINT

DRAWING
SECTION A-A
EXISTING + PROPOSED

Scale	1:100	Job	
Date	JAN 2006	Drawing Number	
Drawn By	PZ		09
Chk By	PD		J

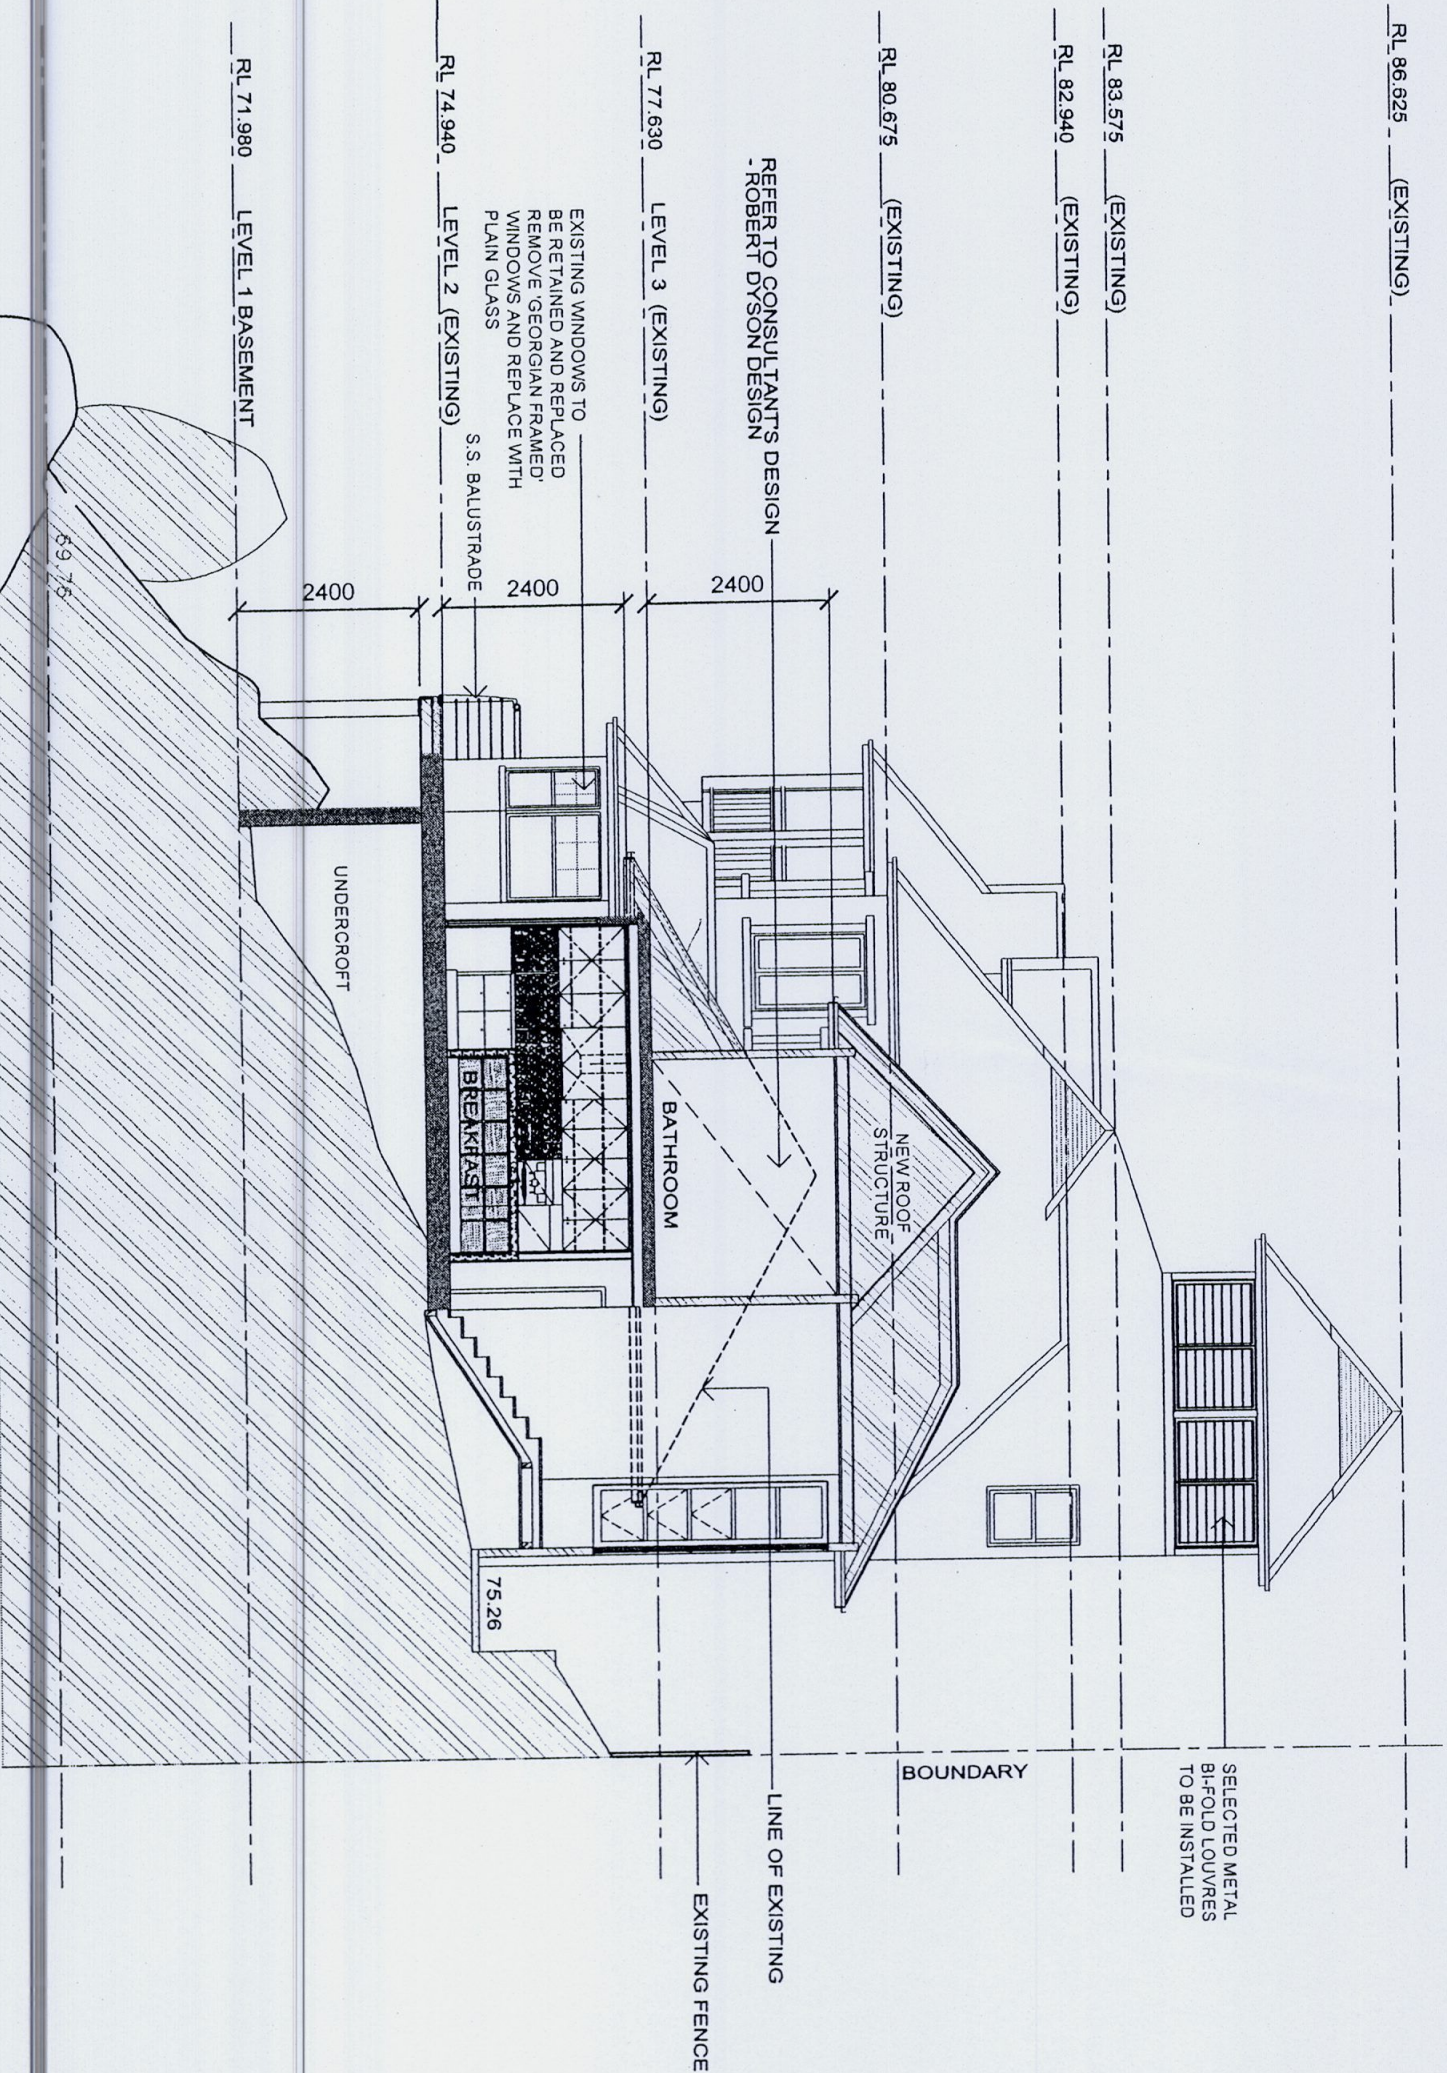

SECTION B - B

Peter J Boyce & Associates
Ph: 0412 928 512
This PLAN/DRAWING forms part
of the approval granted under
Construction Cert No. **807210 (A.T.V.)**
And all work must be carried out in
accordance with the Building Code of
Australia 2007 and subsequent amendments
Accredited Building Surveyor BSB No. 0043

Date	Issue	Amendment
25.04.08	J	SECTION AMENDED
19.04.08	I	BASEMENT LEVEL 1 SECTION REVISED
23.10.07	G	BASEMENT LEVEL 1 RL REVISED

Contractor to verify all dimensions that may exist between
existing and proposed structure and to ensure all dimensions
are correctly noted.
Contractor to verify all dimensions on site before
commencing work. If any dimensions given are to be taken
from the drawing, the dimensions given are to be taken
from the drawing. If any dimensions given are to be taken
from the drawing, the dimensions given are to be taken
from the drawing.

**NICHOLAS
DUNN +
ASSOCIATES**
10/180 Pacific Highway
Newcastle NSW 2060
Australia
Telephone 3955 5454
Facsimile 3955 5280

CLIENT
BOB MANDER & SUSIE MC CARTHY

PROJECT
RENOVATION AND ALTERATIONS
22 QUARTER SESSIONS ROAD
CHURCH POINT

DRAWING
SECTION B - B
EXISTING + PROPOSED

Scale	1:100	Job	Issue
Date	JAN 2006	Drawing Number	10
Drawn By	PZ	Issue	J
Check By	PD		

EXISTING GARAGE
RL 76.160

EXISTING GARAGE
RL 74.500

PAVING
RL 74.210

EXISTING MURRAYA
TO REMAIN

CITRUS TO BE REMOVED

STONE RETAINING WALLS
TO MATCH EXISTING

Peter J Boyce & Associates
Ph: 0412 928 512

This
EXISTING RESIDENCE

Construction Cert No.

And all work must be carried out in

accordance with the Building Code of

Australia 2007 and subsequent amendments

Accredited Building Surveyor BSB No. 0043

RL 75.320

BP 7210 (Mat. 1)

PAVING

RL 72.68

BC(1)

RL 71.14

RL 71.88

RL 71.98

NEW TILED DECK AREA RL 74.920

GRANITE PATH

PAVED AREA TO
FORMAL GARDEN

BIRD BATH

BIRD BATH

GRANITE PATH

LAWN

LAWN

LAWN

T.O.W RL 70.140

RL 69.14

PR(24)

LT(36)

NICHOLAS
DUNN +
ASSOCIATES

CLIENT
BOB MANDER & SUSIE MC CARTHY

PROJECT
RENOVATION AND ALTERATIONS
22 QUARTER SESSIONS ROAD
CHURCH POINT

DRAWING
PLAN - RETAINING WALLS
- GARDEN

Scale	1:100	Job	
Date	AUG. 08	Drawing Number	
Drawn By	PD		27
Check By	PD		A