

# NAB Manly

## Development Application

Architect

**PMDL**


**Sydney** Level 17, 124 Walker Street North Sydney NSW 2060  
Phone +61 2 8458 5500 Email: sydney@pmdl.com.au

**Melbourne** Level 3, 479 St Kilda Road Melbourne Vic 3004  
Phone +61 3 9427 8885 Email: melbourne@pmdl.com.au

**Hong Kong** 20/F, Hollywood Centre, 233 Hollywood Road Sheung Wan Hong Kong  
Phone +852 2836 6992 Email: hongkong@pmdl.com.au


Andrew Pender 5317 / David Morris 5865 / Vicki van Dijk 9476

NAB Branch Location

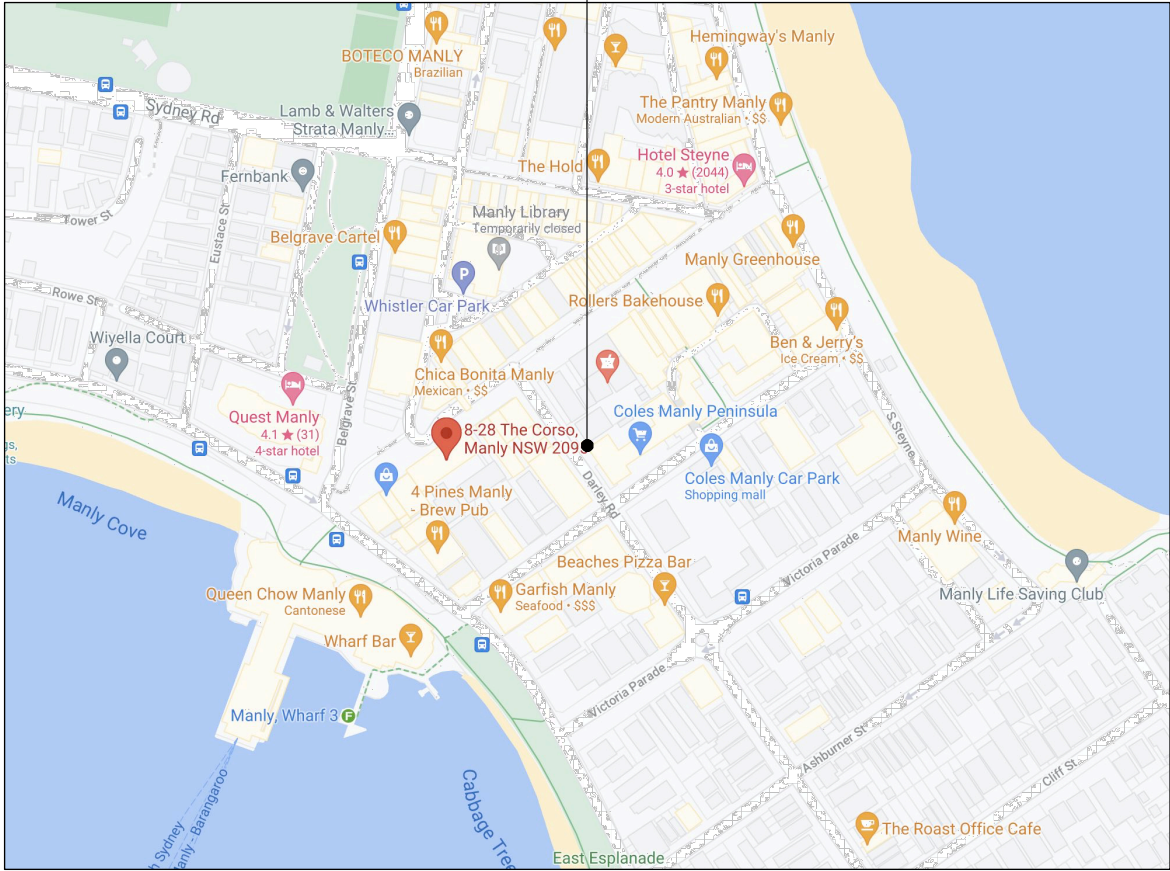

01 LOCATION MAP  
- NAB Manly

Extent of NAB Branch within the building shown in red.

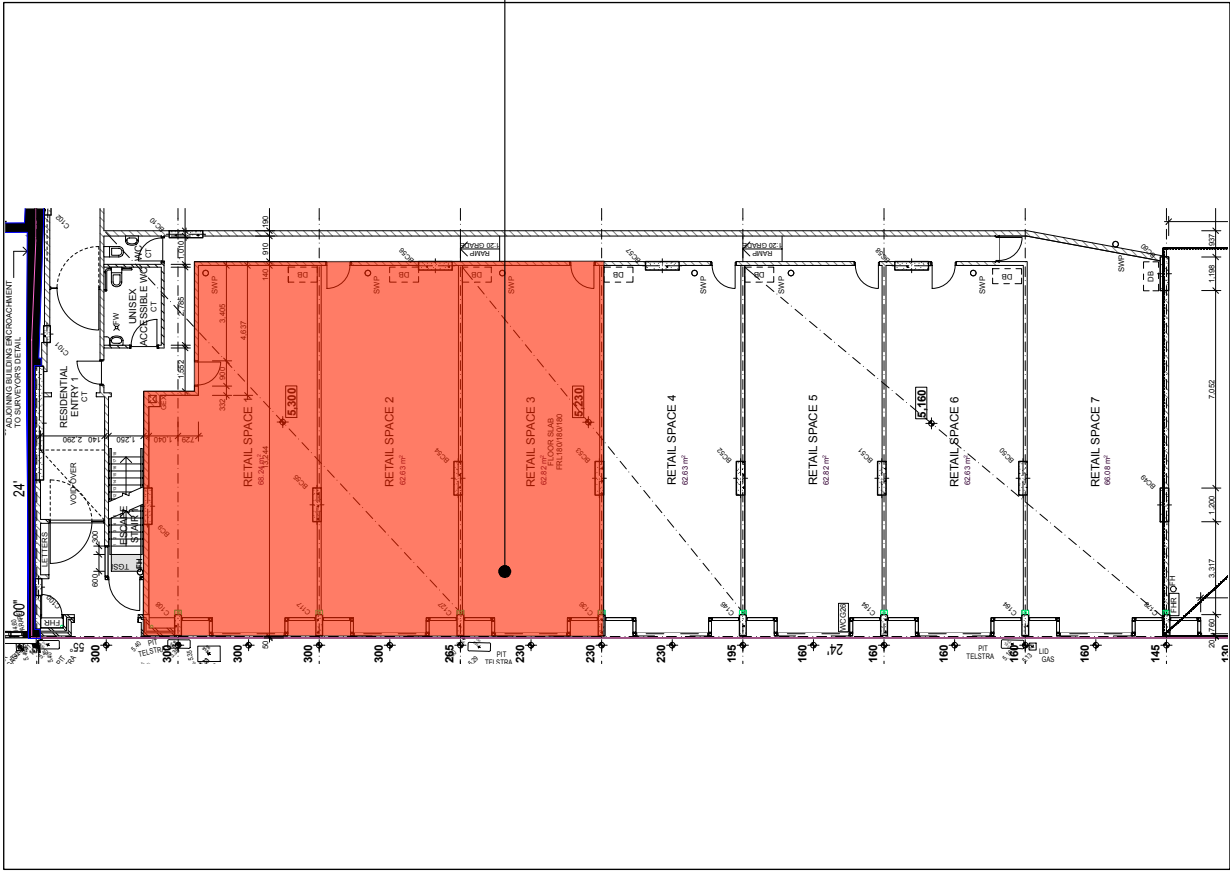

02 LOCATION PLAN  
- NAB Manly



**NAB MANLY**  
Existing tenancy: 8-28 The Corso  
Manly NSW 2095

### DRAWING REGISTER

DA SET REVISION D 29.09.21

- DA000-C COVER PAGE
- DA001-A EXISTING SITE PHOTOS
- DA002-C DEMOLITION PLAN
- DA003-C PROPOSED PLAN
- DA004-B DEMOLITION ELEVATION
- DA005-B PROPOSED ELEVATION

### Cover Page

© PMDL pmdl.com.au Project 2997 Scale NTS Date 29.09.21 Dwg DA000 C

For Approval **PMDL** ARCHITECTURE INTERIORS MASTERPLANNING

### NAB Manly NSW






01 SITE PHOTO  
- Existing shopfront



02 SITE PHOTO  
- Existing Frontage & ATMs



03 SITE PHOTO  
- Existing Entry & Forex

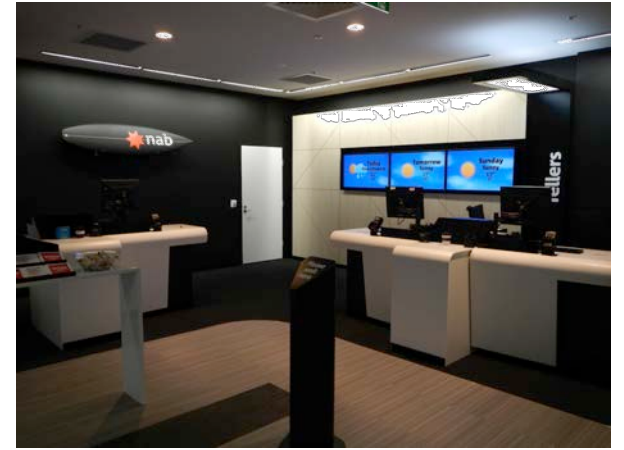

04 SITE PHOTO  
- Existing Tellers



05 SITE PHOTO  
- Existing FOH - Feature Ceiling



06 SITE PHOTO  
- Existing FOH from Tellers




07 SITE PHOTO  
- Existing BOH -Comms & EDB



08 SITE PHOTO  
- Existing BOH




09 SITE PHOTO  
- Existing Bunker

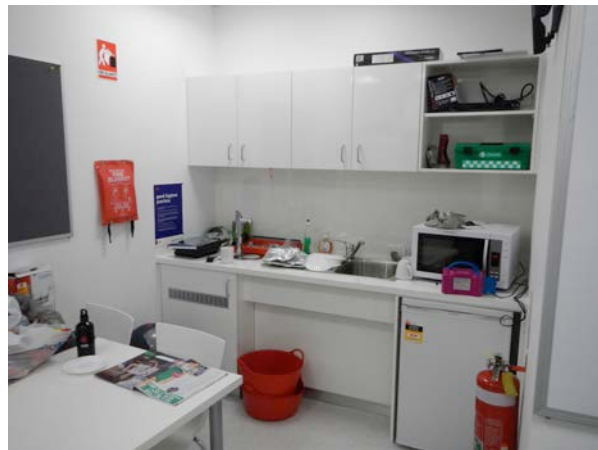


10 SITE PHOTO  
- Existing BOH Kitchenette



11 SITE PHOTO  
- Existing DDA WC

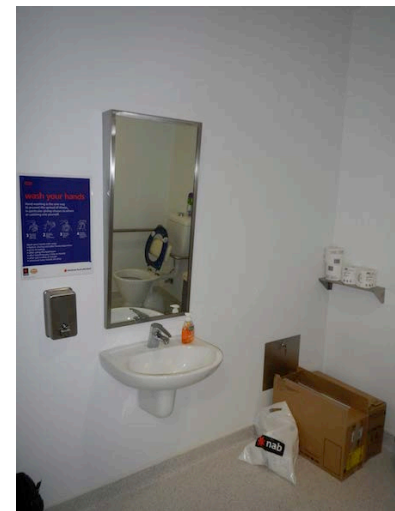


12 SITE PHOTO  
- Existing DDA WC

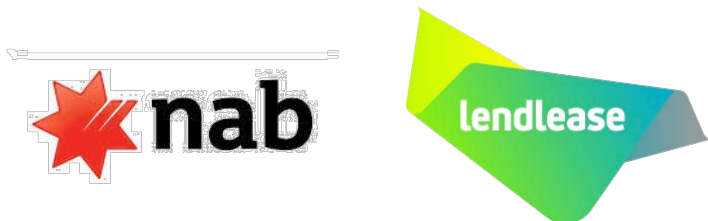

For Approval **PMDL** ARCHITECTURE  
INTERIORS  
MASTERPLANNING  
NAB Manly NSW

Existing site photos

© PMDL pmdl.com.au Project 2997 Scale NTS Date 19 Aug 2021 Dwg DA001 A

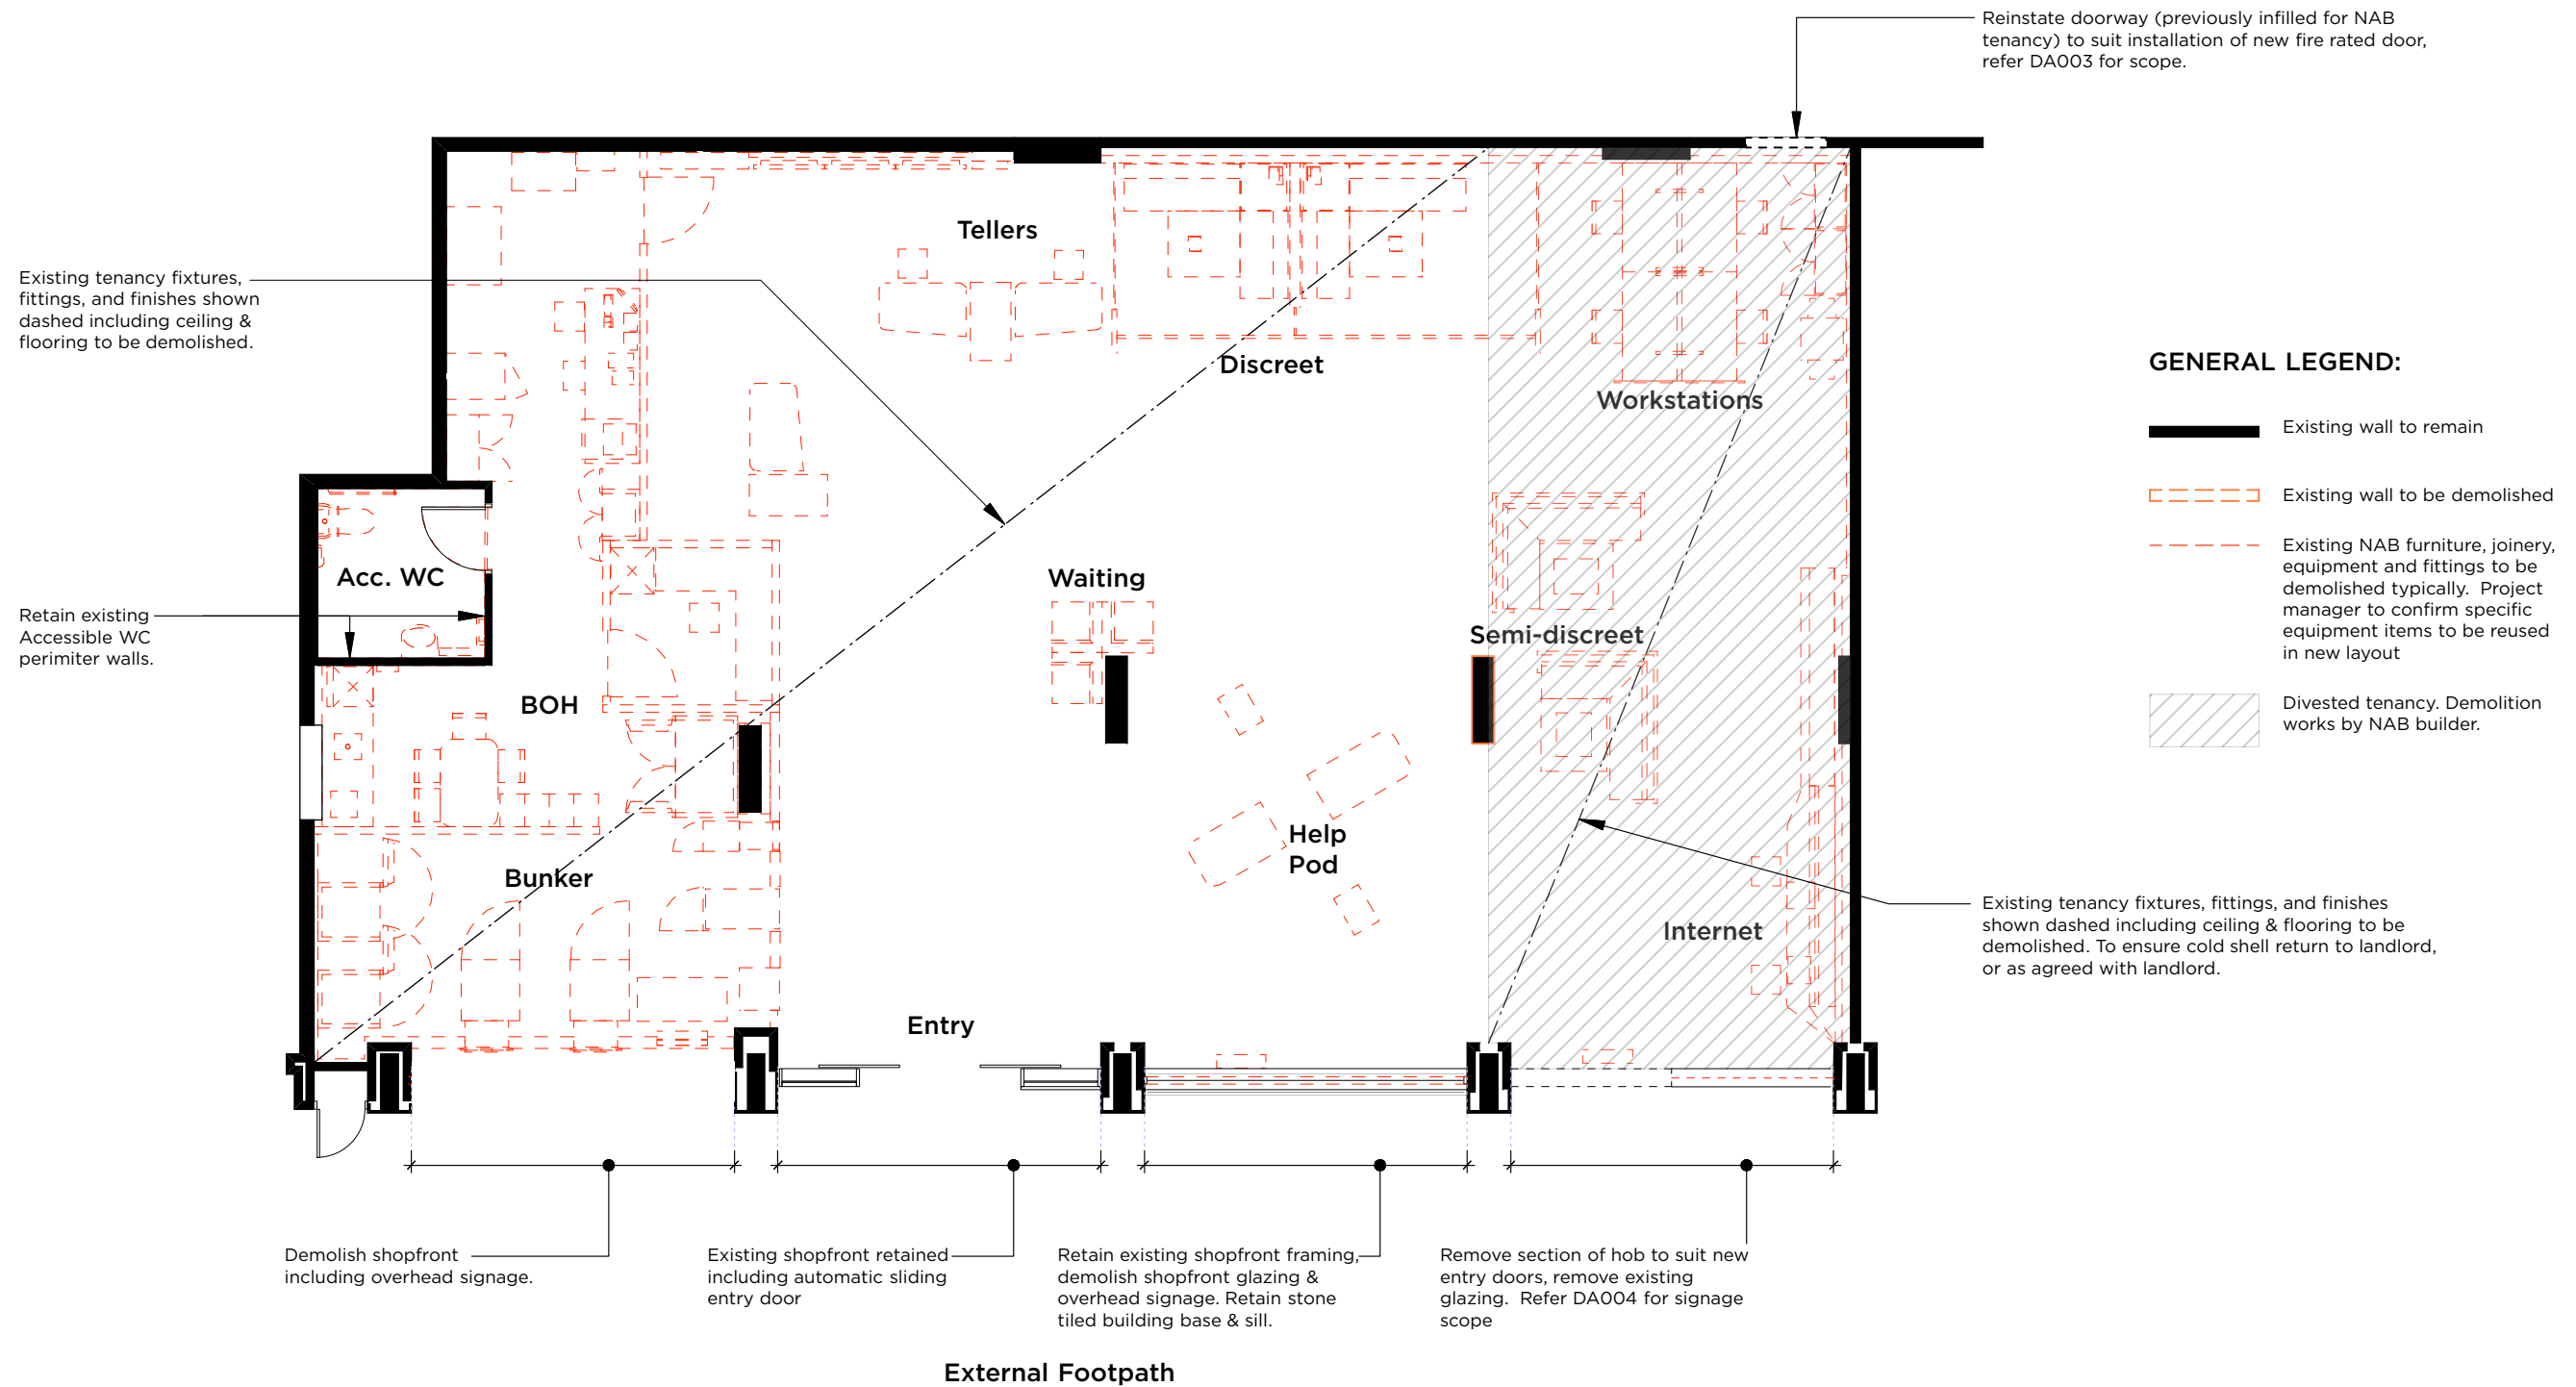

01 DEMOLITION PLAN  
- NAB Manly  
Scale 1:100

#### NOTES :

1. Base plan and all dimensions noted are referenced from Warren and Mahoney's As Built drawing number ID 2.01 rev 2, provided to PMDL by Lendlease.
2. Existing tenancy fit-out to be removed entirely to leave a cold shell prior to construction.
3. Refer to DA004 for proposed demolition works to elevation.




For Approval **PMDL** ARCHITECTURE INTERIORS MASTERPLANNING

#### Demolition Plan

© PMDL pmdl.com.au Project 2997 Scale 1:100 @ A3 Date 30.08.21 Dwg DA002 C

NAB Manly NSW



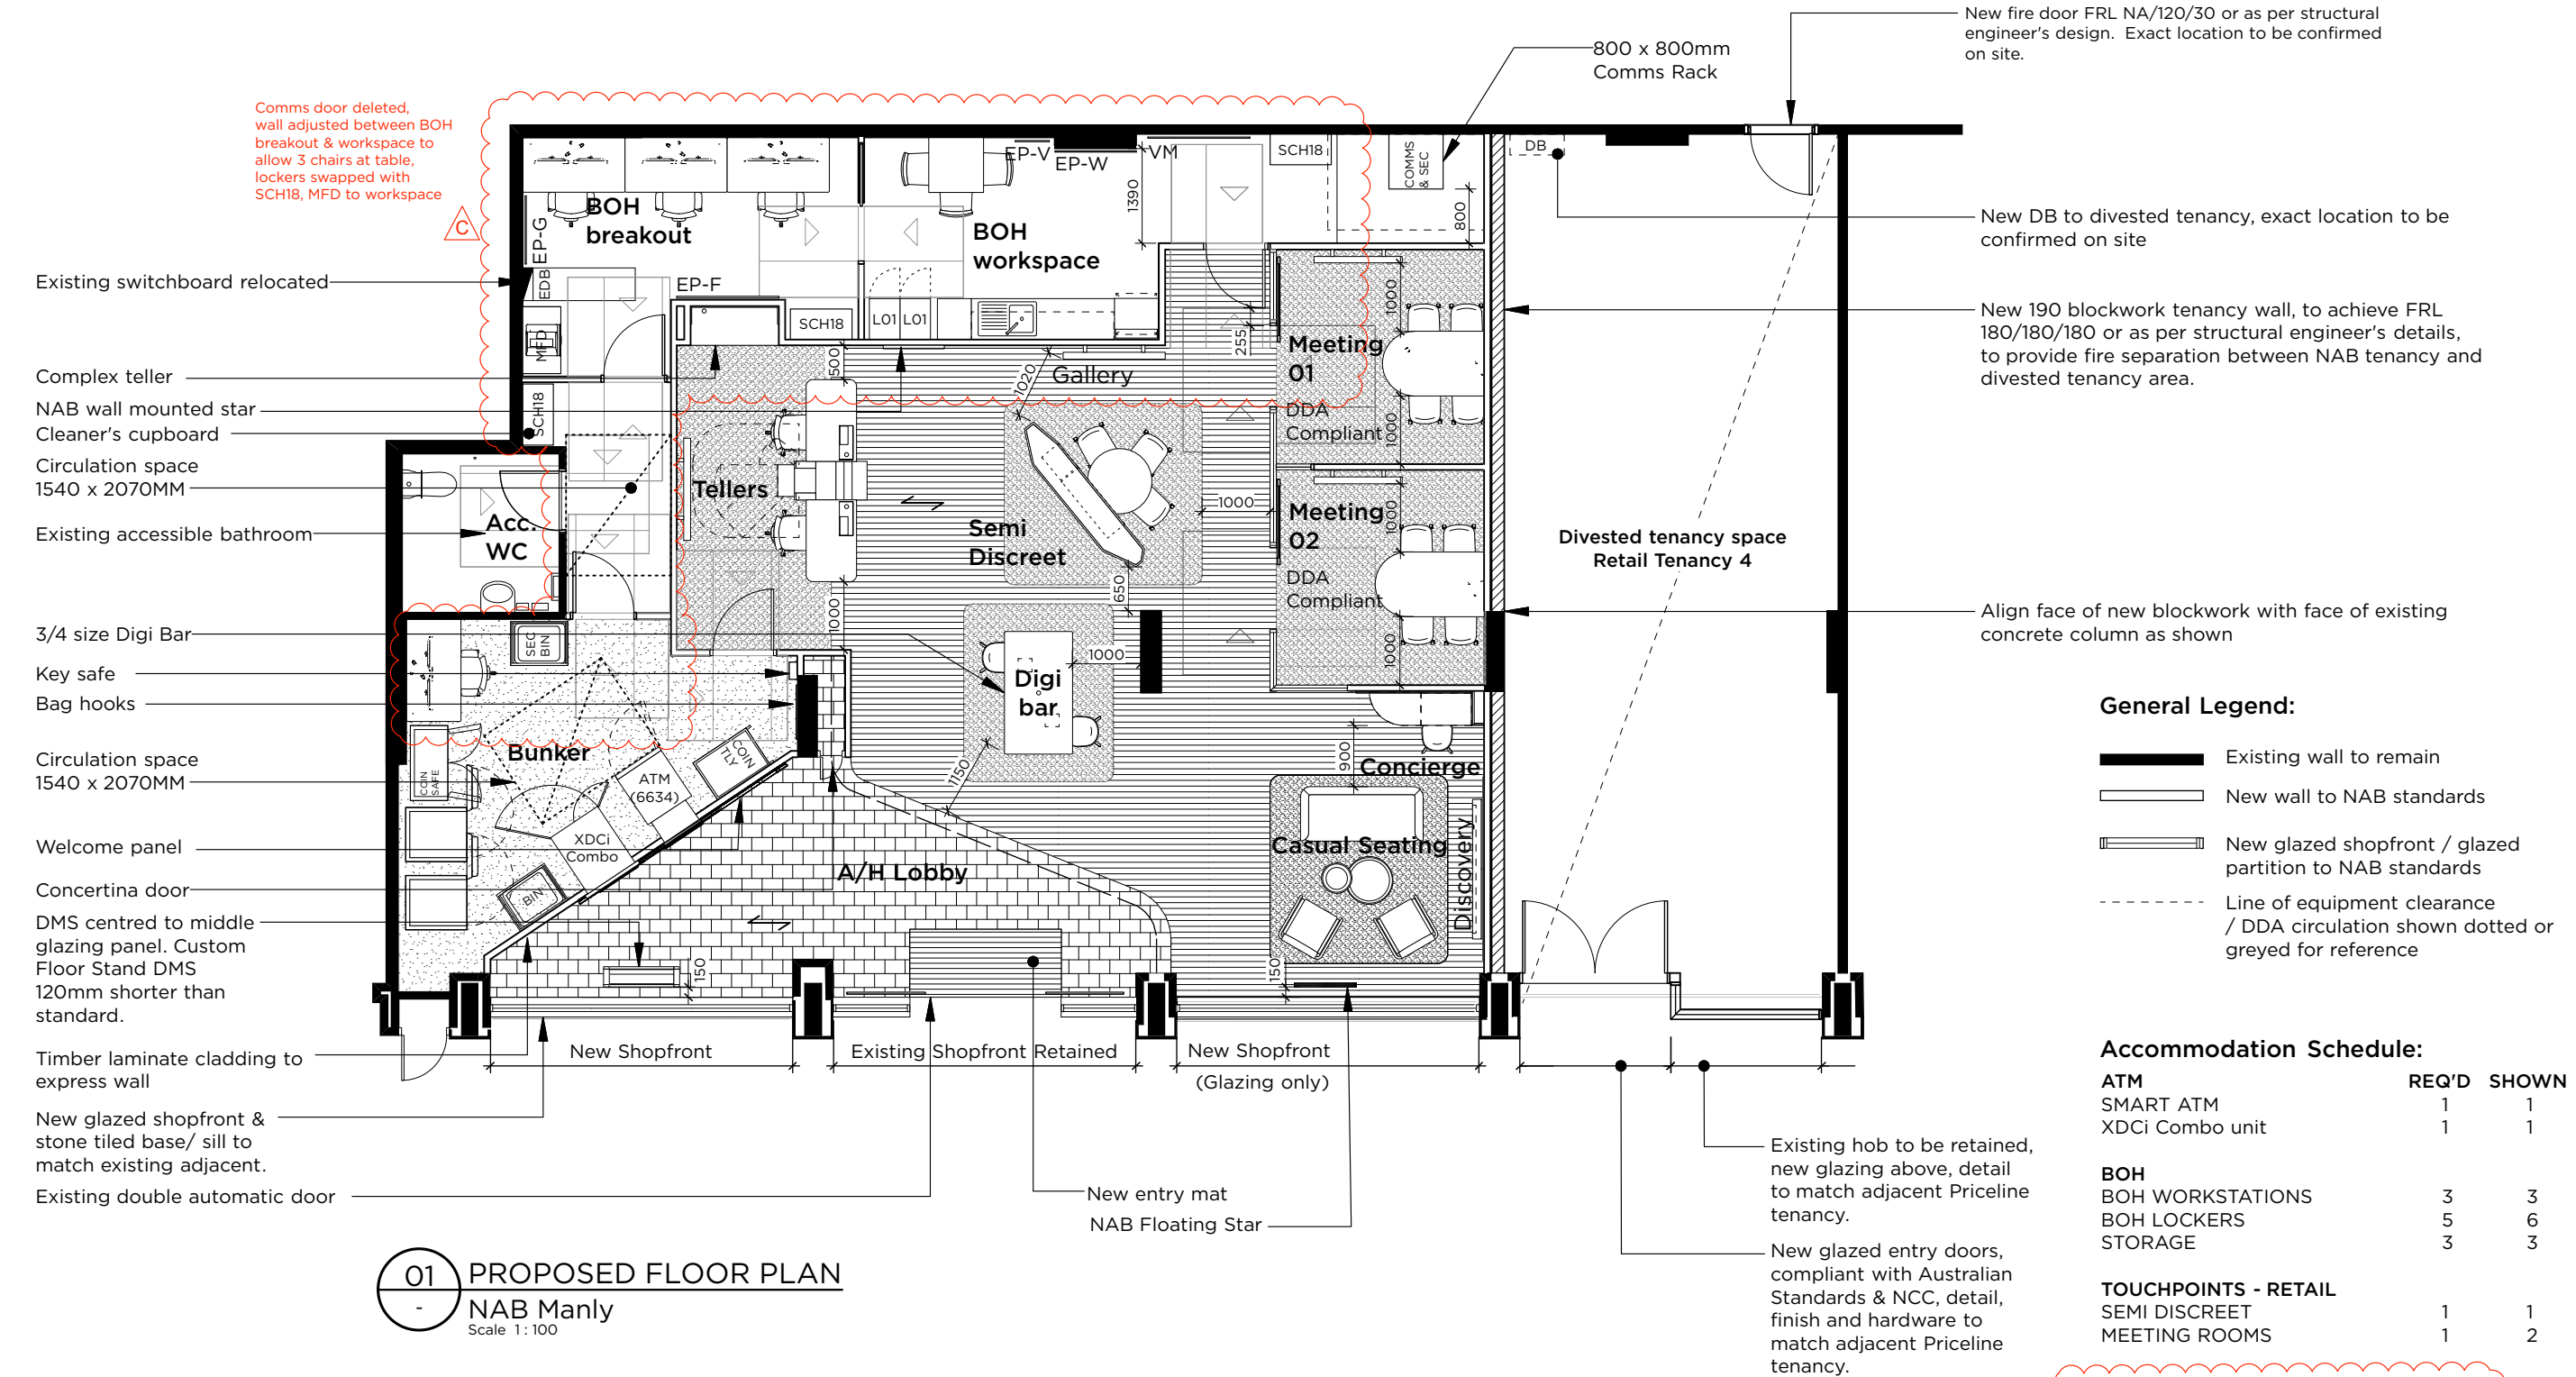

01 PROPOSED FLOOR PLAN  
- NAB Manly  
Scale 1: 100

- General Legend:**
- Existing wall to remain
  - New wall to NAB standards
  - New glazed shopfront / glazed partition to NAB standards
  - Line of equipment clearance / DDA circulation shown dotted or greyed for reference


**Accommodation Schedule:**

	REQ'D	SHOWN
<b>ATM</b>		
SMART ATM	1	1
XDCi Combo unit	1	1
<b>BOH</b>		
BOH WORKSTATIONS	3	3
BOH LOCKERS	5	6
STORAGE	3	3
<b>TOUCHPOINTS - RETAIL</b>		
SEMI DISCREET	1	1
MEETING ROOMS	1	2

- NAB Signage Schedule:**
- VM - Visual Management Board
  - EP-G - Engagement Panel - Graphic
  - EP-F - Engagement Panel - Felt Board
  - EP-V - Engagement Panel - Values
  - EP-W - Whiteboard

- NOTES:**
- Base plan and all dimensions noted are referenced from Warren and Mahoney's As Built drawing number ID 2.01 rev 2, provided to PMDL by Lendlease. All dimensions to be confirmed on site prior to commencement of works.
  - Refer to DA005 for proposed new works to elevation.



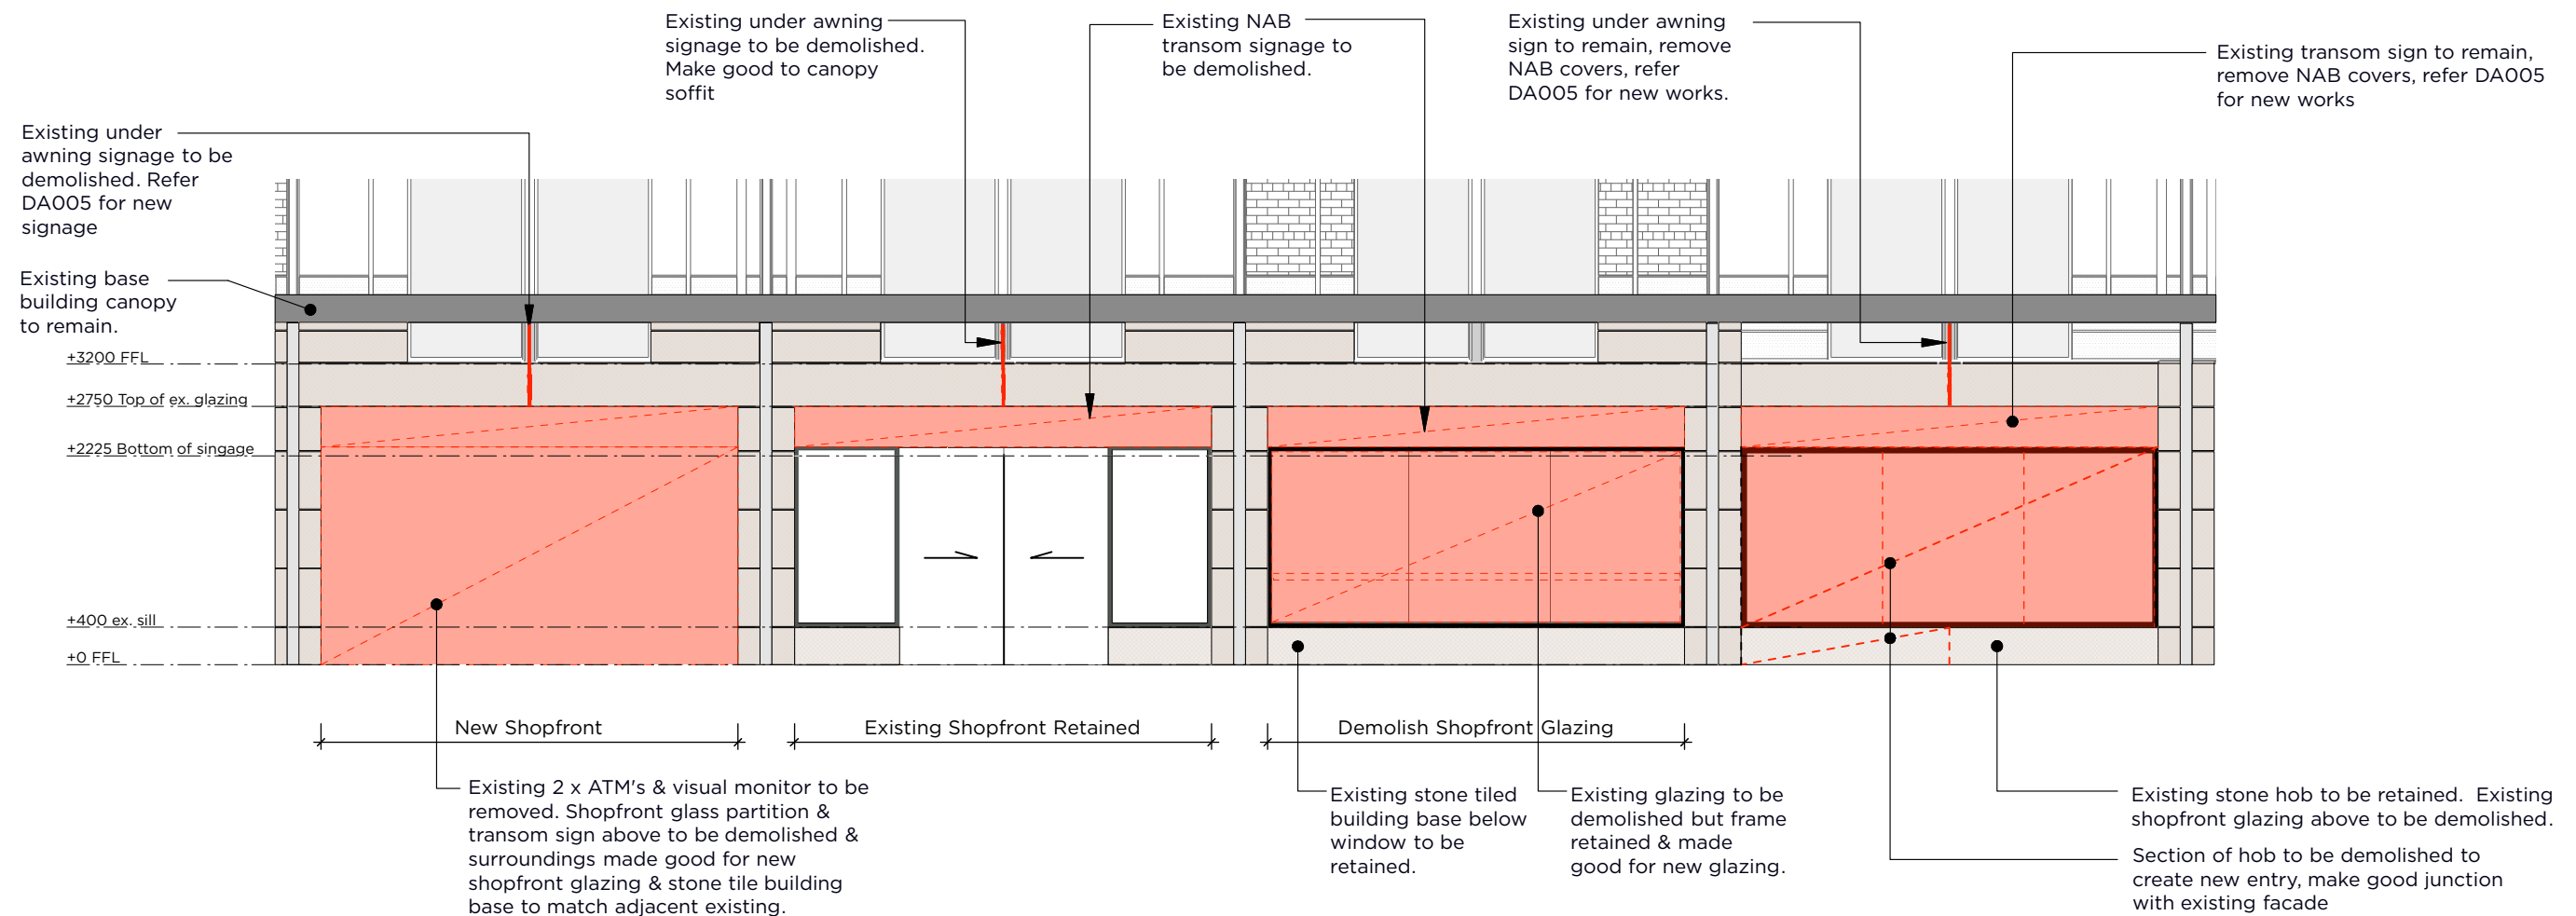

01 DEMOLITION EXTERNAL ELEVATION  
- NAB Manly  
Scale 1: 75



#### DEMOLITION NOTES:

1. Existing base building canopy to be retained & protected throughout the demolition process.
2. Make good to any base building structure impacted by demolition.

For Approval

**PMDL** ARCHITECTURE  
INTERIORS  
MASTERPLANNING

#### Demolition Elevation

© PMDL pmdl.com.au Project 2997 Scale 1:75 @ A3 Date 26.08.21 Dwg DA004 B

NAB Manly NSW

