

SITE PLAN  
SCALE 1:100

DA ARCHITECTURAL PLANS (MASTER SET) FOR USE OF PREMISES FOR SALE OF TOBACCO AND ASSOCIATED GOODS

1. BUILDER TO CHECK AND CONFIRM ALL NECESSARY DIMENSIONS ON SITE PRIOR TO CONSTRUCTION. DO NOT SCALE THE DRAWING.
2. ALL DIMENSIONS THAT RELATE TO SITE BOUNDARIES, SETBACKS AND EASEMENTS ARE SUBJECT TO VERIFICATION BY A SITE SURVEY.
3. ALL WORK TO BE IN ACCORDANCE WITH BUILDING CODE OF AUSTRALIA & TO THE SATISFACTION OF LOCAL COUNCIL REQUIREMENTS.
4. ALL TIMBER CONSTRUCTION TO BE IN ACCORDANCE TO TIMBER FRAMING CODE.
5. ROOF WATER & SUB SOIL DRAINAGE TO BE DISPOSED OF IN THE APPROVED MANNER OR AS A DIRECTED BY LOCAL COUNCIL.
6. ALL ELECTRICAL POWER & LIGHT OUTLETS TO BE DETERMINED BY OWNER.
7. MAKE GOOD AND REPAIR ALL EXISTING FINISHES DAMAGED BY NEW WORK. REUSE EXISTING MATERIAL WHERE POSSIBLE.
8. ALL NEW DOWN PIPES ARE TO BE CONNECTED TO THE EXISTING STORM WATER SYSTEM.
9. COPYRIGHT OF ALL PLANS BELONGS TO 'HIGH DESIGN' - Architectural Design

PROJECT ADDRESS:  
315 BARRENJOEY ROAD  
NEWPORT

APRIL, 2025



DRAWN BY:  
B. V.

CLIENT:

DRAWING No.  
1-1 1077 25





"HIGH DESIGN" - ABN 51 476 054 183  
architectural design and drafting service  
mobile : fax :  
041 3389 036 9981 55 56  
E-mail: info@highdesign.com.au  
Web: highdesign.com.au

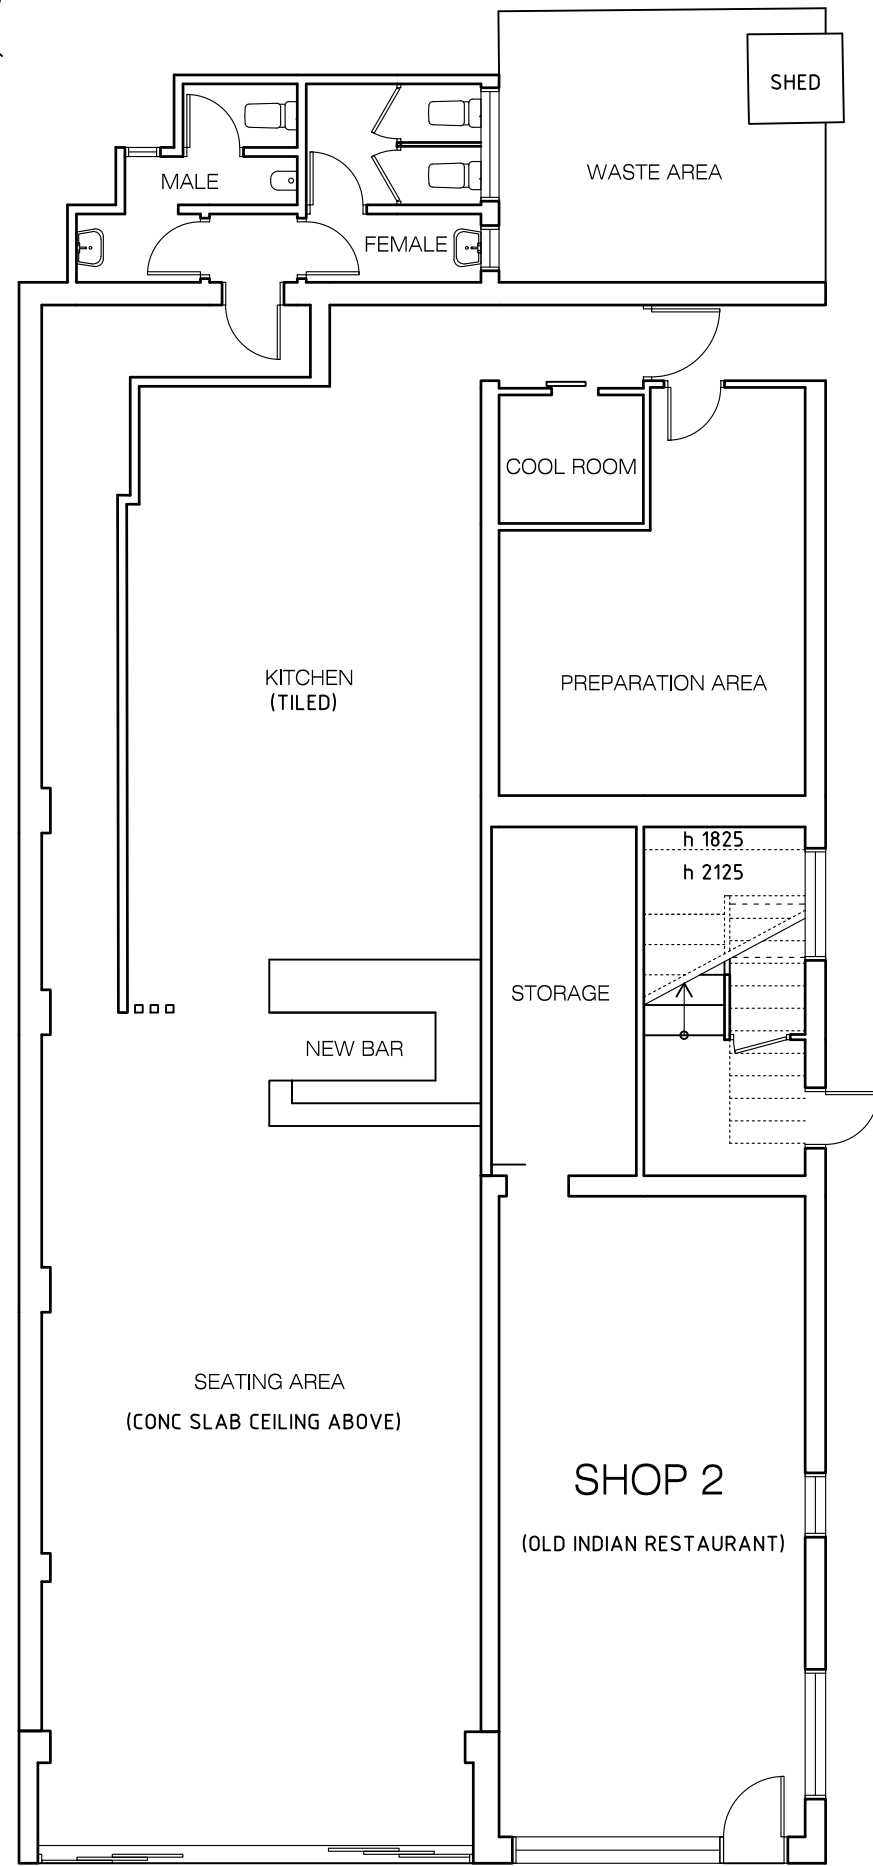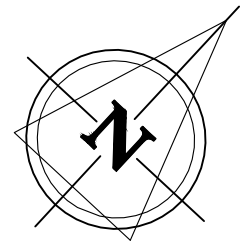

SHOP 2 - GROSS FLOOR AREA 43 sqm

### EXISTING GROUND FLOOR PLAN


SCALE 1:100

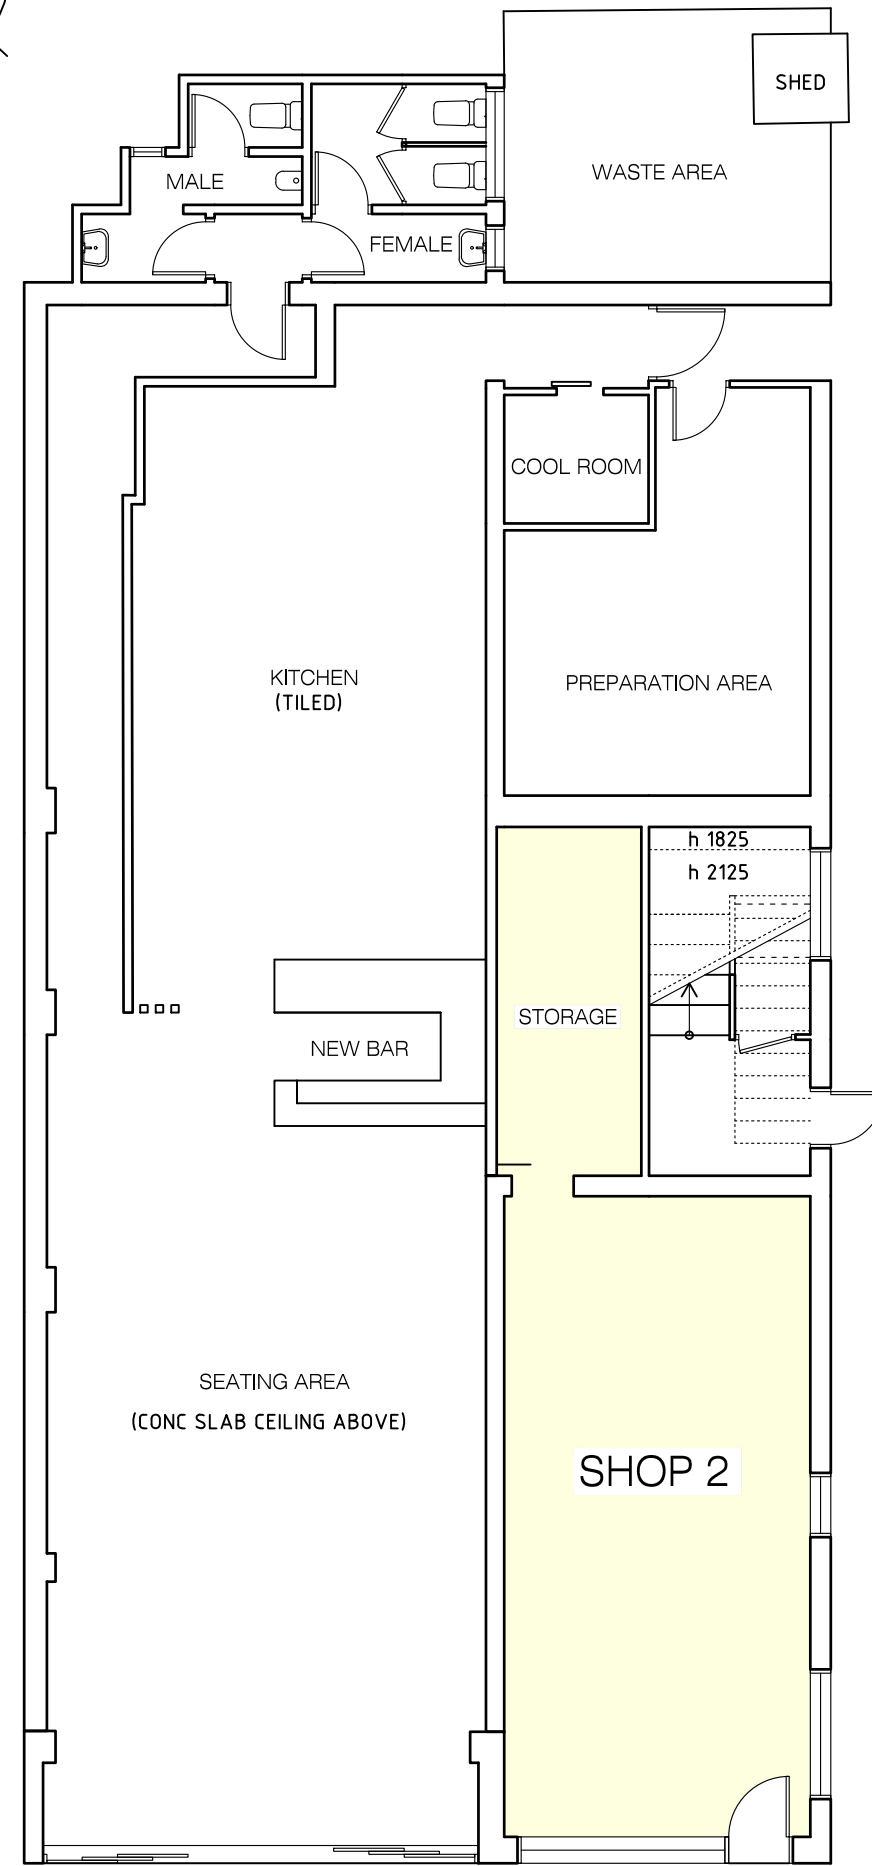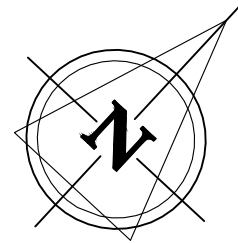

SHOP 2 - GROSS FLOOR AREA 43 sqm

### "AS BUILT" GROUND FLOOR PLAN

SCALE 1:100

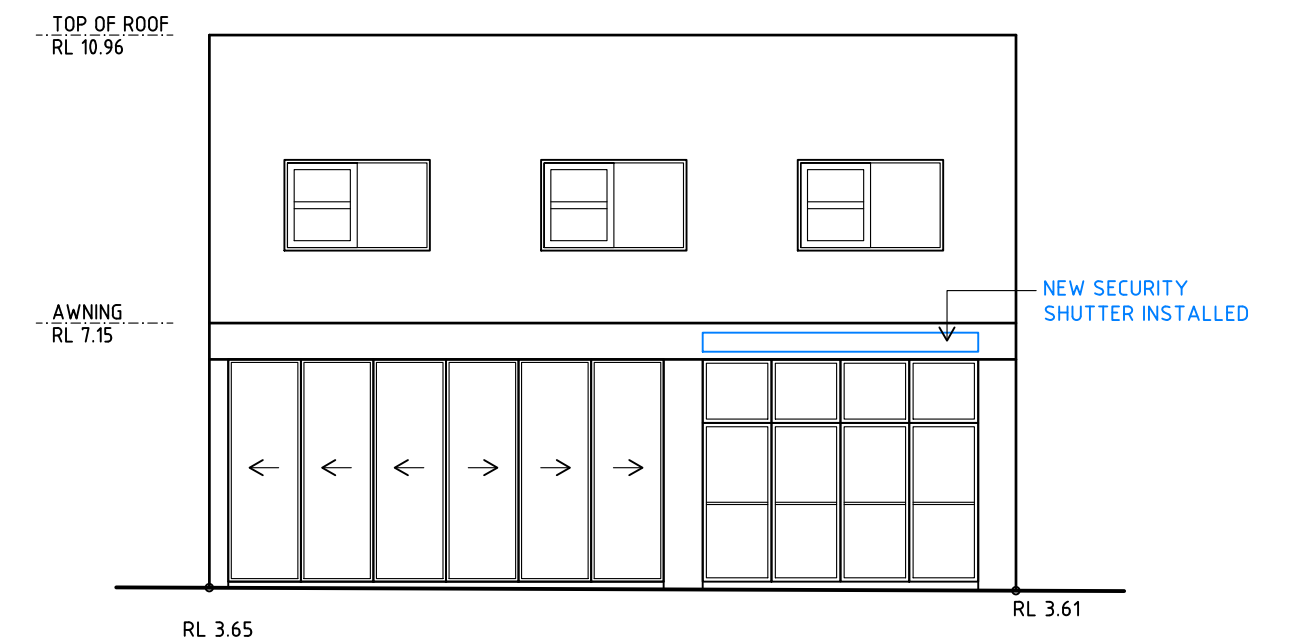

### "AS BUILT " FRONT ELEVATION

SCALE 1:100

0 1:100 5m

DA ARCHITECTURAL PLANS (MASTER SET) FOR USE OF PREMISES FOR SALE OF TOBACCO AND ASSOCIATED GOODS

1. BUILDER TO CHECK AND CONFIRM ALL NECESSARY DIMENSIONS ON SITE PRIOR TO CONSTRUCTION. DO NOT SCALE THE DRAWING.  
2. ALL DIMENSIONS THAT RELATE TO SITE BOUNDARIES, SETBACKS AND EASEMENTS ARE SUBJECT TO VERIFICATION BY A SITE SURVEY.  
3. ALL WORK TO BE IN ACCORDANCE WITH BUILDING CODE OF AUSTRALIA & TO THE SATISFACTION OF LOCAL COUNCIL REQUIREMENTS.  
4. ALL TIMBER CONSTRUCTION TO BE IN ACCORDANCE TO TIMBER FRAMING CODE.  
5. ROOF WATER & SUB SOIL DRAINAGE TO BE DISPOSED OF IN THE APPROVED MANNER OR AS A DIRECTED BY LOCAL COUNCIL.  
6. ALL ELECTRICAL POWER & LIGHT OUTLETS TO BE DETERMINED BY OWNER.  
7. MAKE GOOD AND REPAIR ALL EXISTING FINISHES DAMAGED BY NEW WORK. REUSE EXISTING MATERIAL WHERE POSSIBLE.  
8. ALL NEW DOWN PIPES ARE TO BE CONNECTED TO THE EXISTING STORM WATER SYSTEM.  
9. COPYRIGHT OF ALL PLANS BELONGS TO 'HIGH DESIGN' - Architectural Design

PROJECT ADDRESS:  
**315 BARRENJOEY ROAD  
NEWPORT**

APRIL, 2025

DRAWN BY:  
B. V.

CLIENT:

DRAWING No.  
**1-2 1077 25**



"HIGH DESIGN" - ABN 51 476 054 183  
architectural design and drafting service  
mobile : fax :  
041 3389 036 9981 55 56  
E-mail: info@highdesign.com.au  
Web: highdesign.com.au

