



ORLANDO ROAD

INMAN ROAD

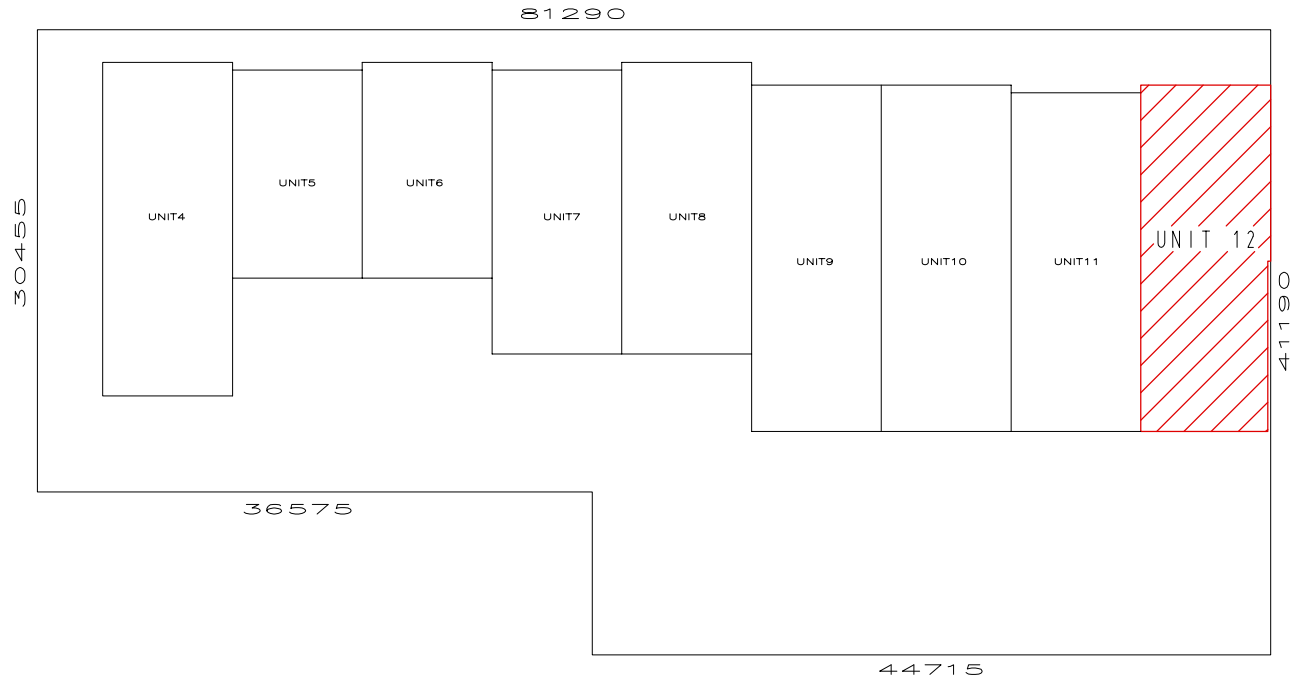

 SITE PLAN

SCALE 1:500

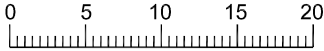

AMENDMENTS		
DEC2020	B	FENCE HEIGHT

THE WORK IS TO BE COMPLETED WITH THE BUILDING CODE OF AUSTRALIA, SAA CODES AND RELEVANT BY-LAWS.

THE BUILDING / MANUFACTURER SHALL CHECK AND VERIFY ALL DIMENSIONS, RL, GROUNDLINES AND CONSTRUCTION METHODS PRIOR TO COMMENCEMENT OF WORK.

PREFERENCES OF DIMENSIONED MEASUREMENTS TO BE TAKEN OVER SCALED MEASUREMENTS.

THESE DRAWINGS HAVE BEEN PREPARED BY CORONA PROJECTS AND REMAIN THE PROPERTY OF THE ABOVE NAMED PARTY. THESE DRAWINGS ARE NOT TO BE USED IN ANY WAY WITHOUT THE PERMISSION OF CORONA PROJECTS AND ARE SUBJECT TO COPYRIGHT LAWS.


A COPY OF THIS PLAN IS TO BE SUBMITTED BY THE PROPRIETOR TO THE WATERBOARD FOR APPROVAL AS REQUIRED BY THE LOCAL COUNCIL.


DESIGN INTENT ONLY. NOT FOR CONSTRUCTION.

**Corona Projects**

PO BOX 1749 BONDI JUNCTION NSW 1355
PHONE: 0419 438 956
EMAIL: info@coronaprojects.com

DRAWING: SITE PLAN	PROJECT: AS BUILT
SCALE: 1:500 @ A3	ADDRESS: UNIT12-14 INMAR RD CROMER

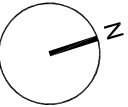SHEET No: 02	
DATE: JUNE 2021	

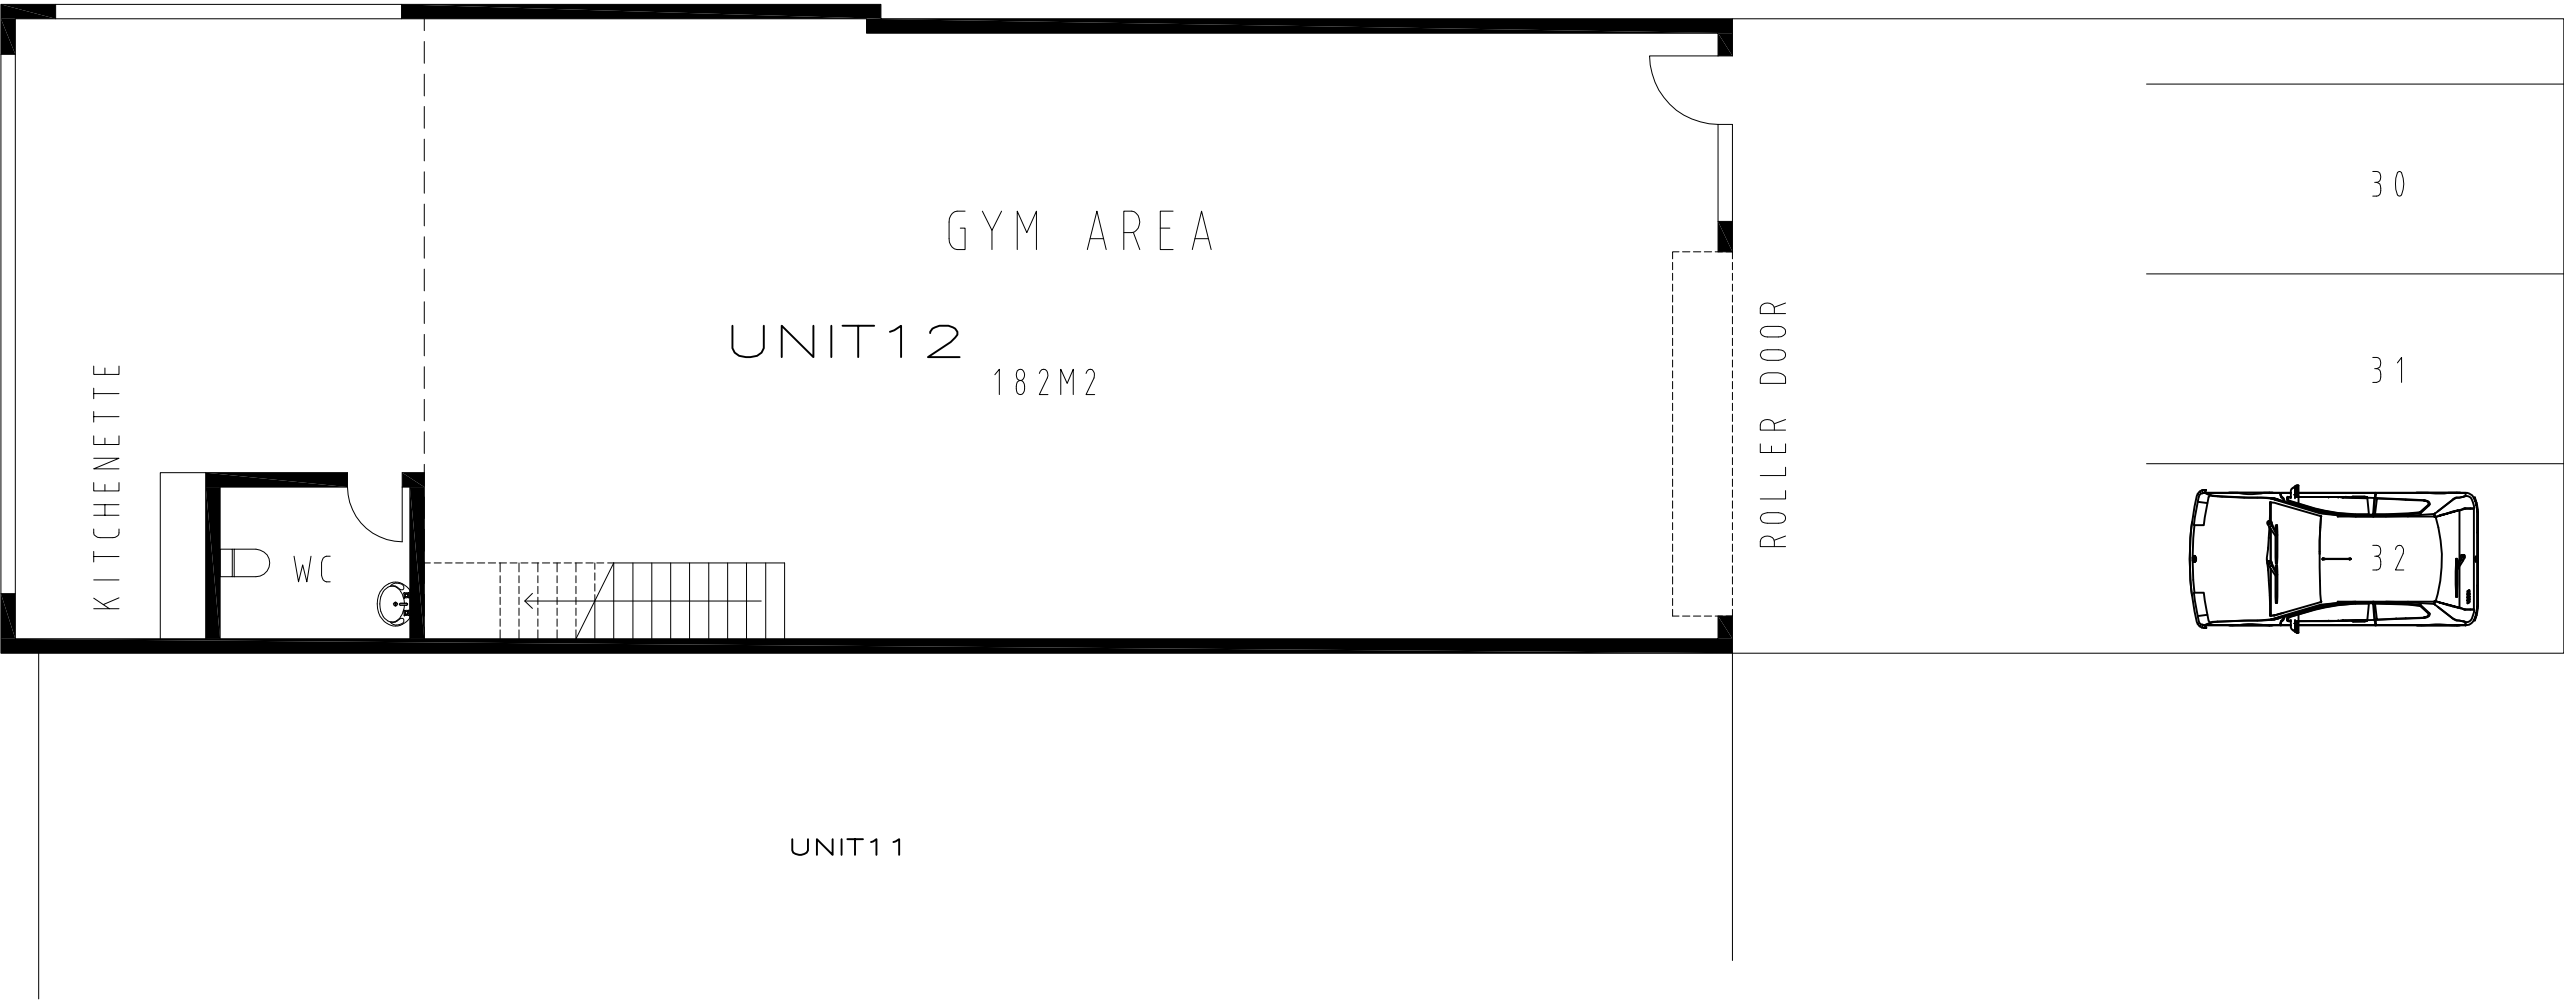

EXISTING FLOOR PLAN

SCALE 1:100



AMENDMENTS

DEC2020	B	FENCE HEIGHT

THE WORK IS TO BE COMPLETED WITH THE BUILDING CODE OF AUSTRALIA, SAA CODES AND RELEVANT BY-LAWS.

THE BUILDING / MANUFACTURER SHALL CHECK AND VERIFY ALL DIMENSIONS, RL, GROUND LINES AND CONSTRUCTION METHODS PRIOR TO COMMENCEMENT OF WORK.

PREFERENCE OF DIMENSIONS MEASUREMENTS TO BE TAKEN OVER SCALED MEASUREMENTS.

THESE DRAWINGS HAVE BEEN PREPARED BY CORONA PROJECTS AND REMAIN THE PROPERTY OF THE ABOVE NAMED PARTY. THESE DRAWINGS ARE NOT TO BE USED IN ANY WAY WITHOUT THE PERMISSION OF CORONA PROJECTS AND ARE SUBJECT TO COPYRIGHT LAWS.

A COPY OF THIS PLAN IS TO BE SUBMITTED BY THE PROPRIETOR TO THE WATERBOARD FOR APPROVAL AS REQUIRED BY THE LOCAL COUNCIL.

DESIGN INTENT ONLY. NOT FOR CONSTRUCTION.



Corona Projects

PO BOX 1749 BONDI JUNCTION NSW 1355
PHONE: 0419 438 956
EMAIL: info@coronaprojects.com

DRAWING:
FLOOR PLAN


SCALE:
1:100 @ A3


PROJECT:
AS BUILT

ADDRESS:
UNIT12-14 INMAR RD
CROMER

SHEET No:
02

DATE:
JUNE
2021

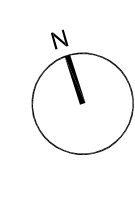

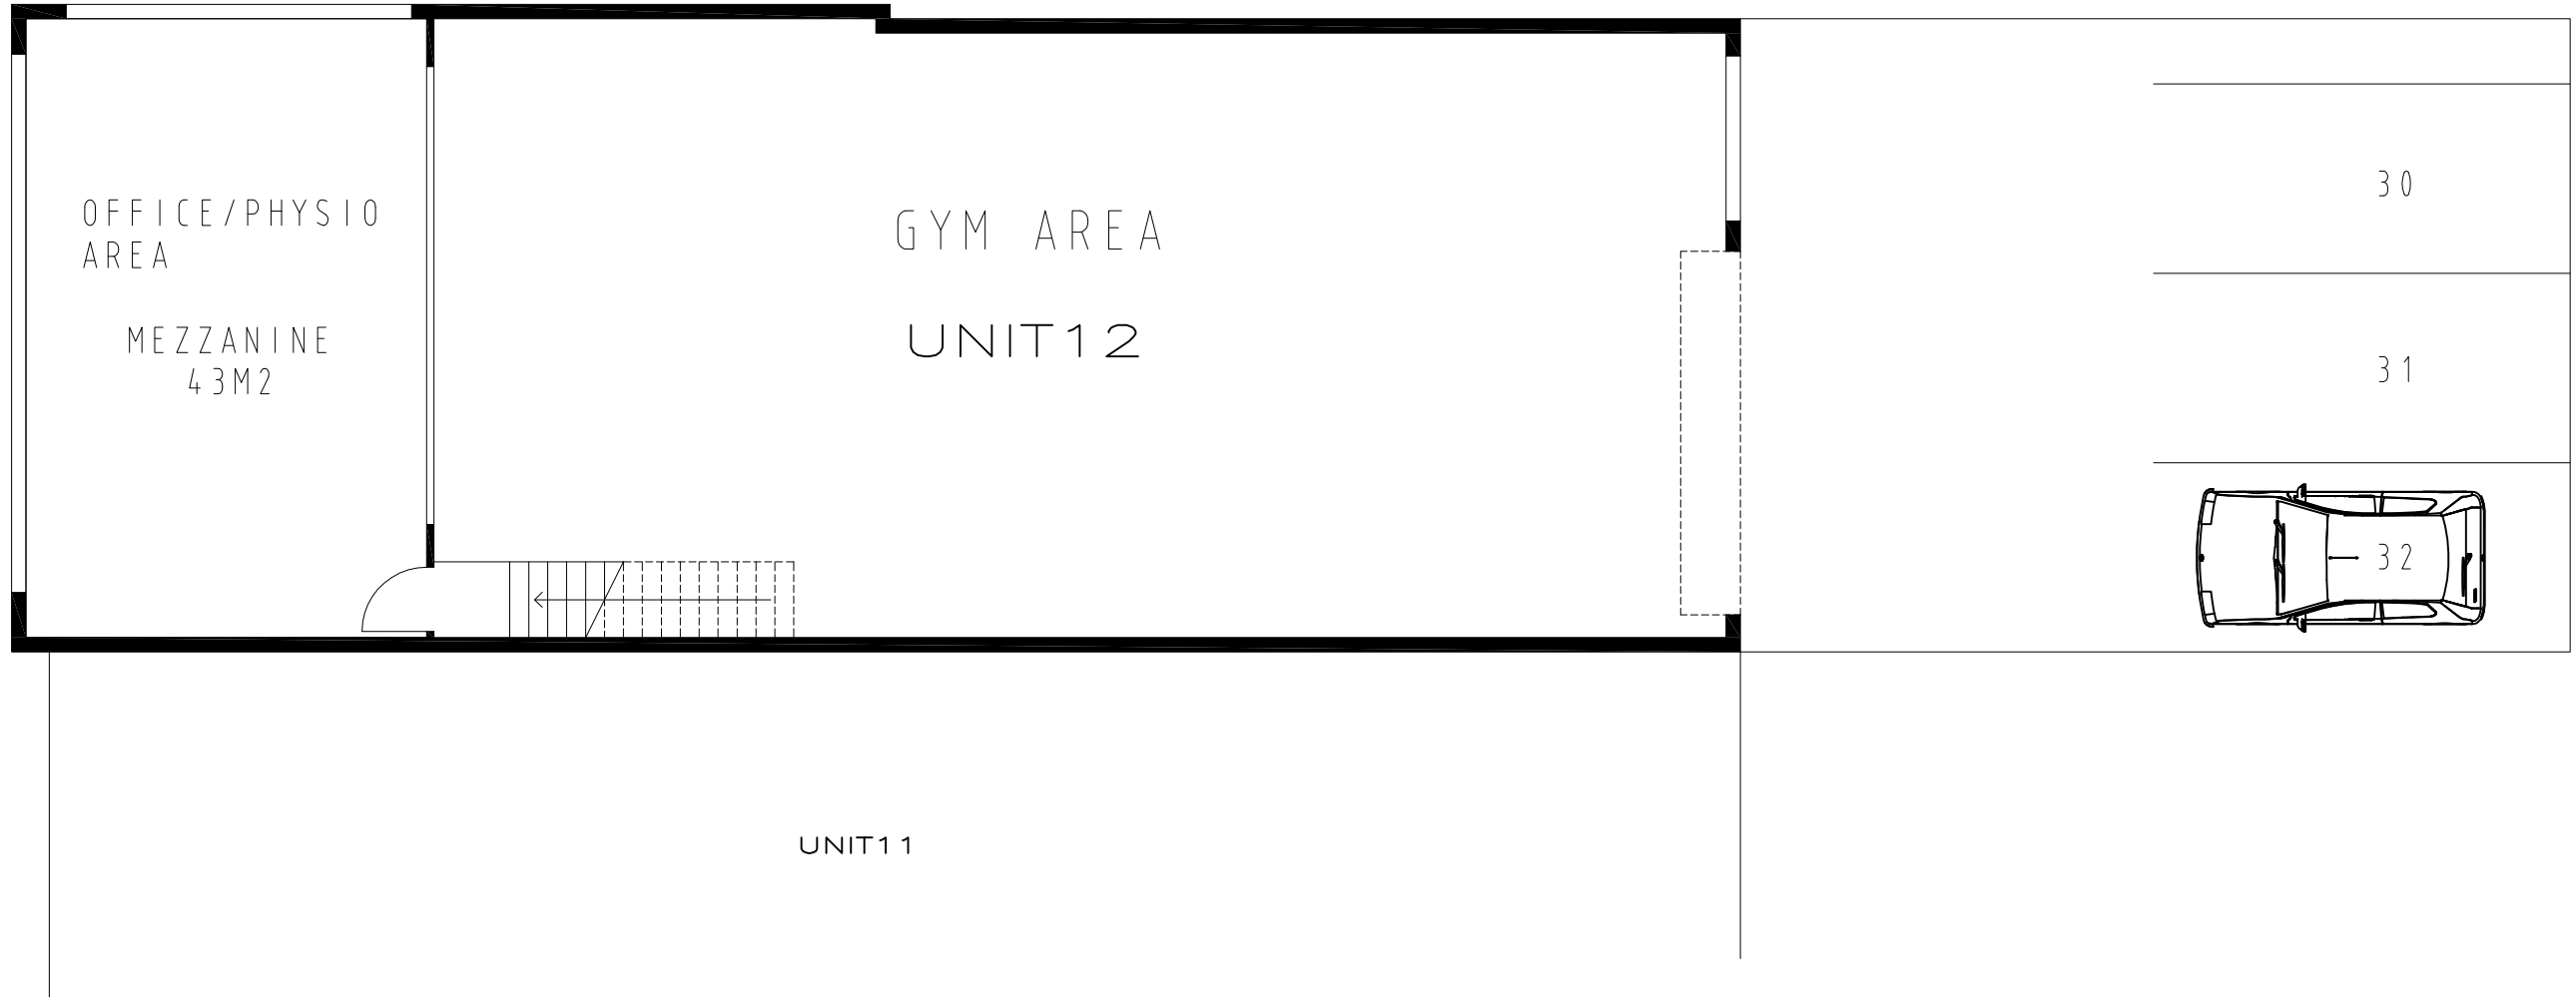

MEZZANINE FLOOR PLAN

SCALE 1:100



AMENDMENTS		
DEC2020	B	FENCE HEIGHT

THE WORK IS TO BE COMPLETED WITH THE BUILDING CODE OF AUSTRALIA, SAA CODES AND RELEVANT BY-LAWS.

THE BUILDING / MANUFACTURER SHALL CHECK AND VERIFY ALL DIMENSIONS, RL, GROUND LINES AND CONSTRUCTION METHODS PRIOR TO COMMENCEMENT OF WORK.

PREFERENCES OF DIMENSIONED MEASUREMENTS TO BE TAKEN OVER SCALED MEASUREMENTS.

THESE DRAWINGS HAVE BEEN PREPARED BY CORONA PROJECTS AND REMAIN THE PROPERTY OF THE ABOVE NAMED PARTY. THESE DRAWINGS ARE NOT TO BE USED IN ANY WAY WITHOUT THE PERMISSION OF CORONA PROJECTS AND ARE SUBJECT TO COPYRIGHT LAWS.

A COPY OF THIS PLAN IS TO BE SUBMITTED BY THE PROPRIETOR TO THE WATERBOARD FOR APPROVAL AS REQUIRED BY THE LOCAL COUNCIL.

DESIGN INTENT ONLY. NOT FOR CONSTRUCTION.



Corona Projects

PO BOX 1749 BONDI JUNCTION NSW 1355
PHONE: 0419 438 956
EMAIL: info@coronaprojects.com

DRAWING: FLOOR PLAN	PROJECT: AS BUILT	SHEET No: 03
SCALE: 1:100 @ A3	ADDRESS: UNIT12-14 INMAR RD CROMER	DATE: JUNE 2021

