



DEMOLITION
balustrades to be demolished
shown in red hatching

1 22 CENTRAL AVENUE FRONT FACADE
1:250

 northern
beaches
council

**THIS PLAN IS TO BE READ IN
CONJUNCTION WITH
THE CONDITIONS OF DEVELOPMENT
CONSENT**

DA2023/0972


SHEET NAME:

OWNER AND PROJECT LOCATION: The Owners Corporation SP7114 22
Ground Floor, 22, Central Avenue, Manly NSW

DATE: 16/5/2023
DRAWN BY: Author
SHEET NUMBER: A001b
SCALE: 1:250

COPYRIGHT
This drawing is the copyright of urbane pty ltd
It is issued on condition that it is not to be copied or reproduced in any form
or disclosed to any unauthorised person, either wholly, or in part without
the express written consent of urbane pty ltd
Do not scale from this drawing

urbaine
ARCHITECTURE
urbaine pty ltd, 8/15, The Corso, Manly, NSW 2095: Tel: 02 8355 6770

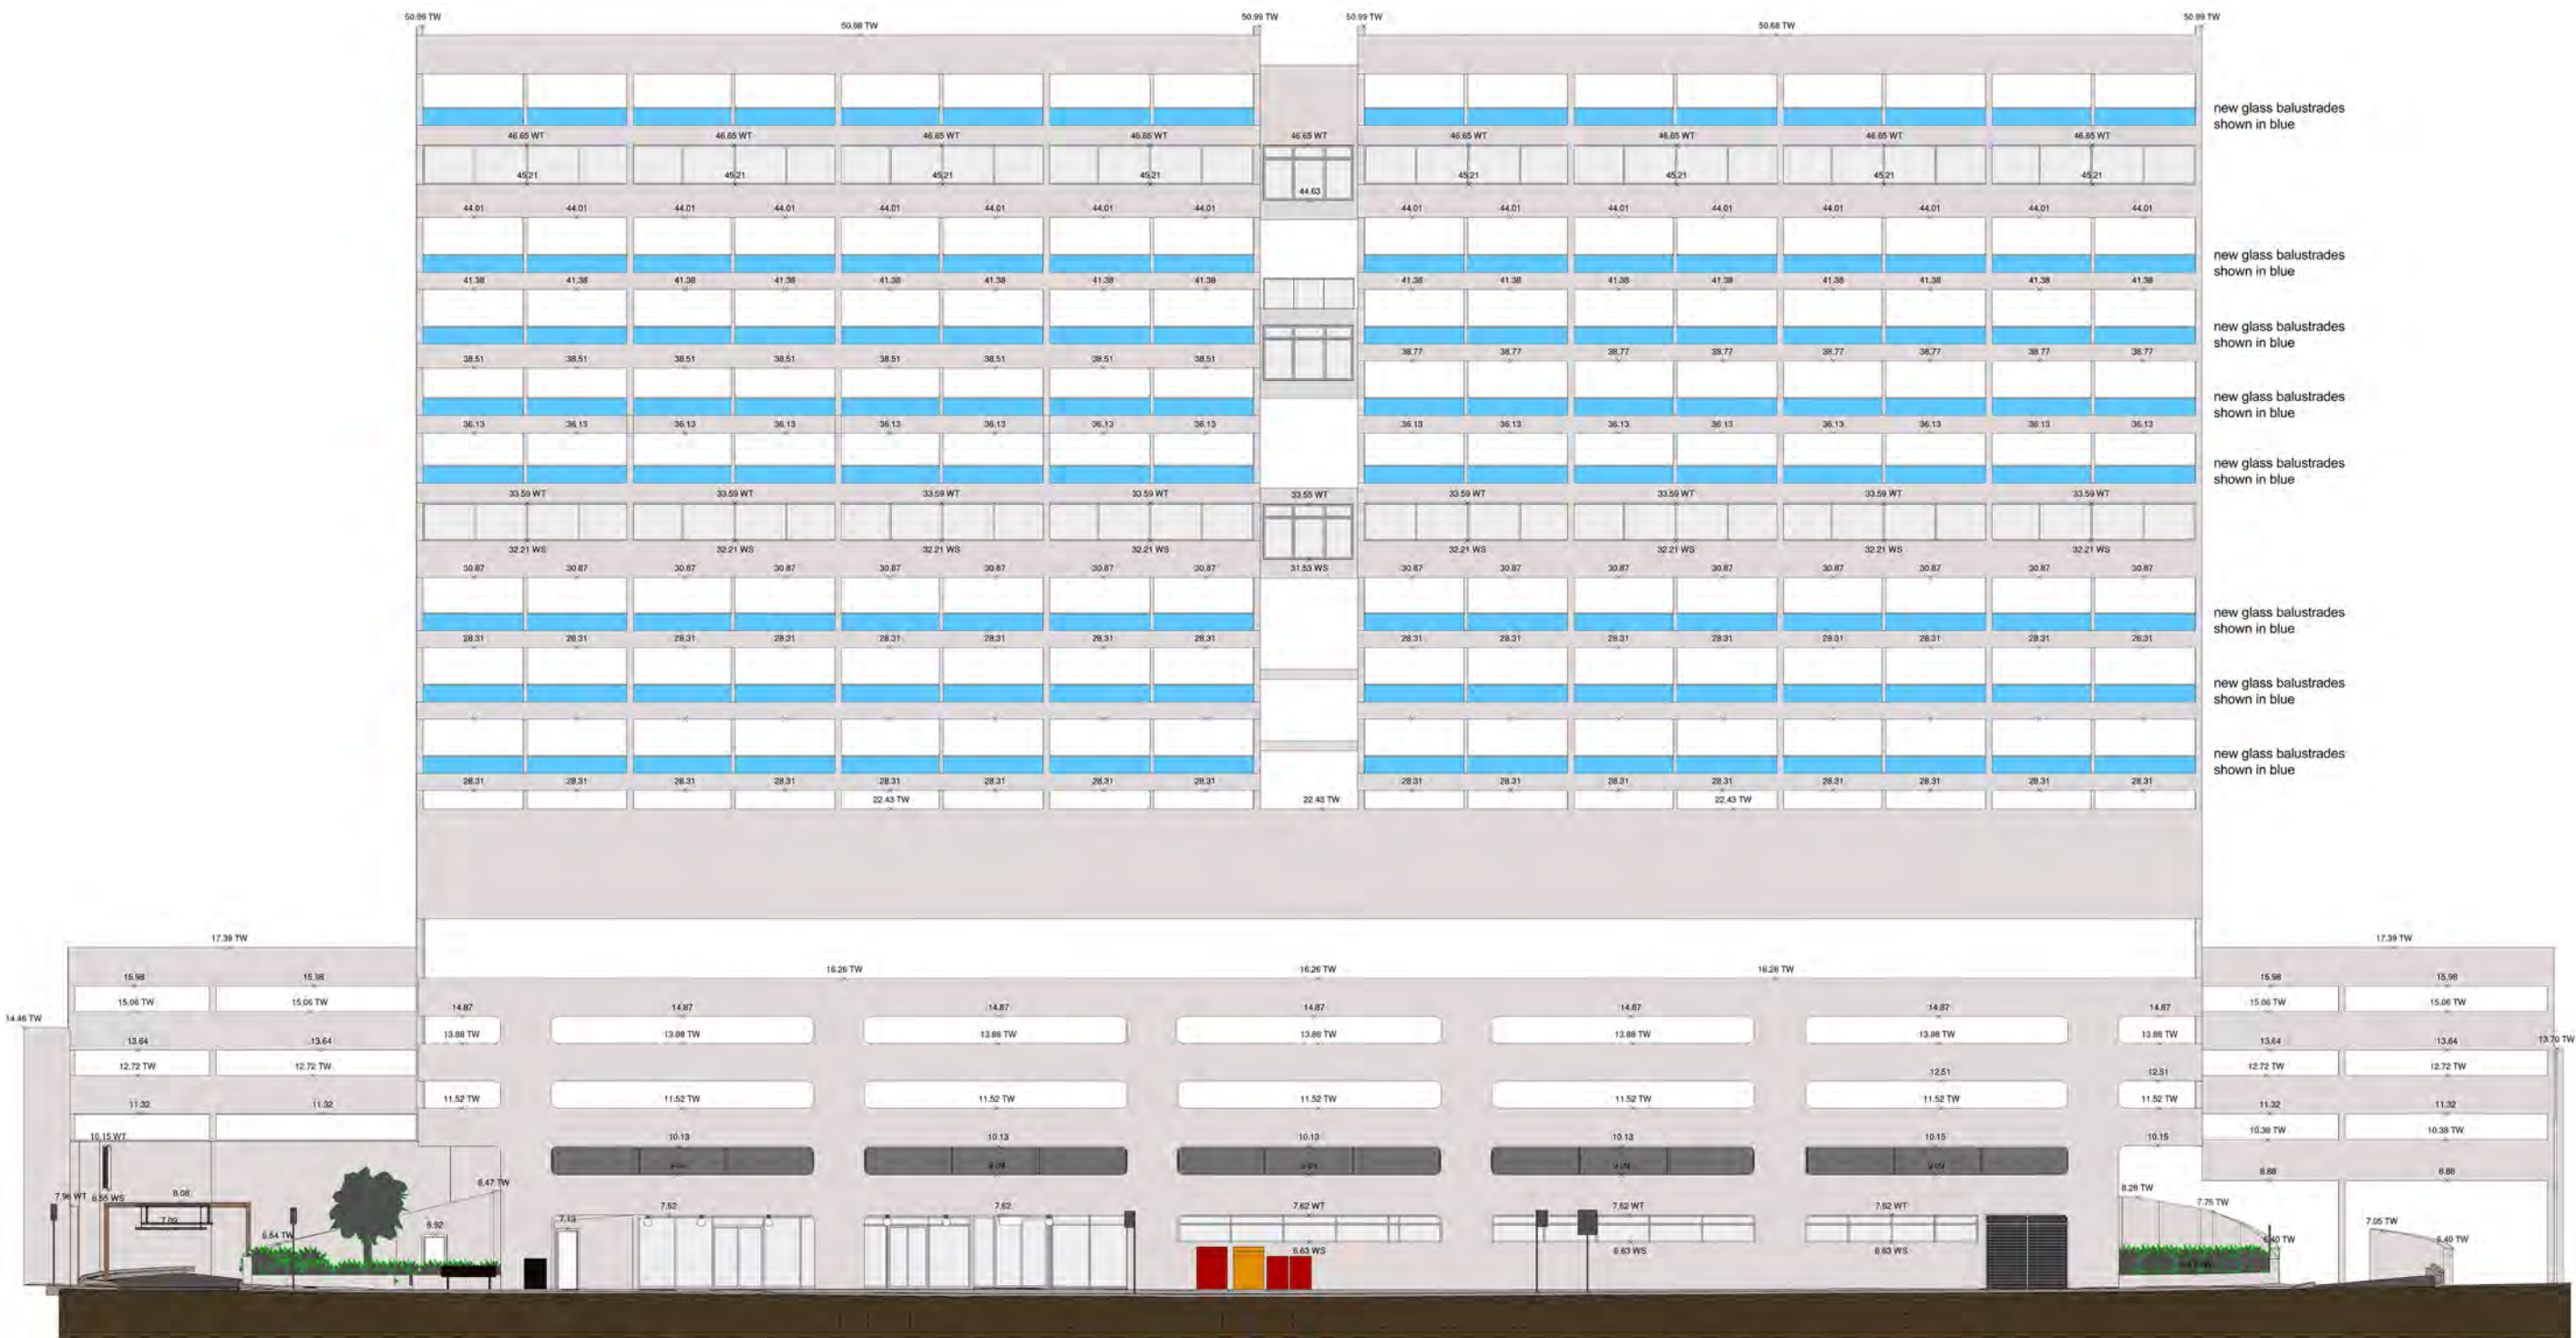

new glass balustrades shown in blue

new glass balustrades shown in blue

1 22 CENTRAL AVENUE FRONT FACADE
1:250

NEW PROPOSAL
new glass balustrades shown in blue

 northern beaches council



THIS PLAN IS TO BE READ IN CONJUNCTION WITH THE CONDITIONS OF DEVELOPMENT CONSENT

DA2023/0972

SHEET NAME:	EAST ELEVATION
OWNER AND PROJECT LOCATION:	The Owners Corporation SP7114 22 Ground Floor, 22, Central Avenue, Manly NSW


DATE:	16/5/2023
DRAWN BY:	Author
SHEET NUMBER:	A001c
SCALE:	1:250

COPYRIGHT
This drawing is the copyright of urbane ply ltd. It is issued on condition that it is not to be copied or reproduced in any form, or disclosed to any unauthorised person, without the express written consent of urbane ply ltd. Do not scale from this drawing.

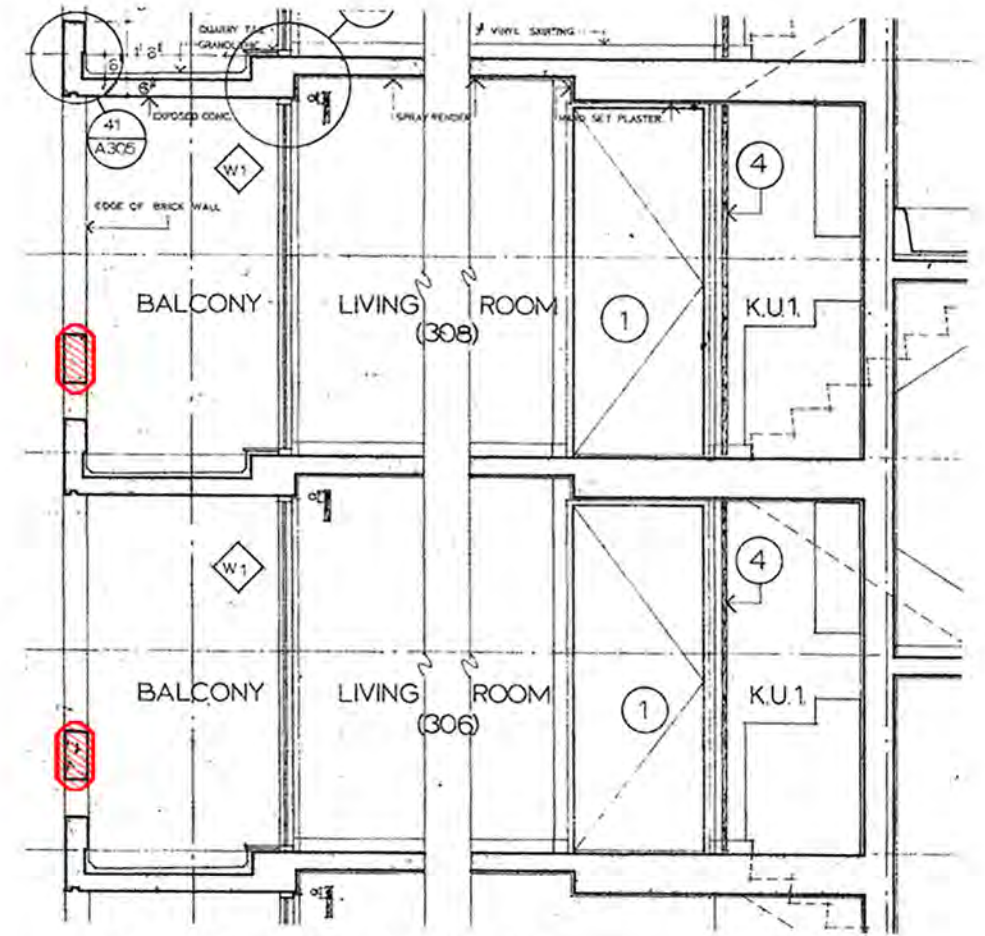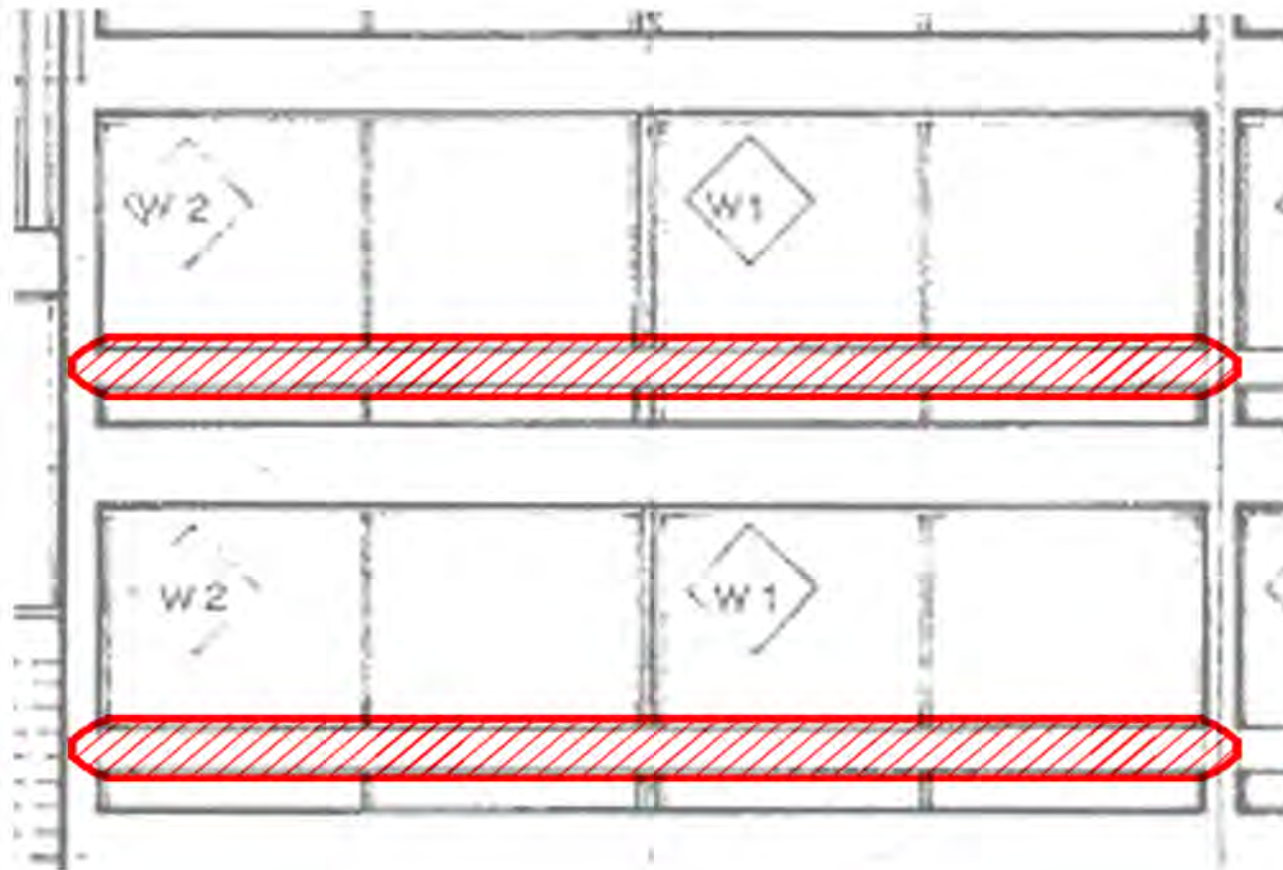


2 STOREY TYPICAL SECTION @ 1:50

Elements to be demolished indicated in red hatching overlay.
This applies to all residential floors as shown in DWG00

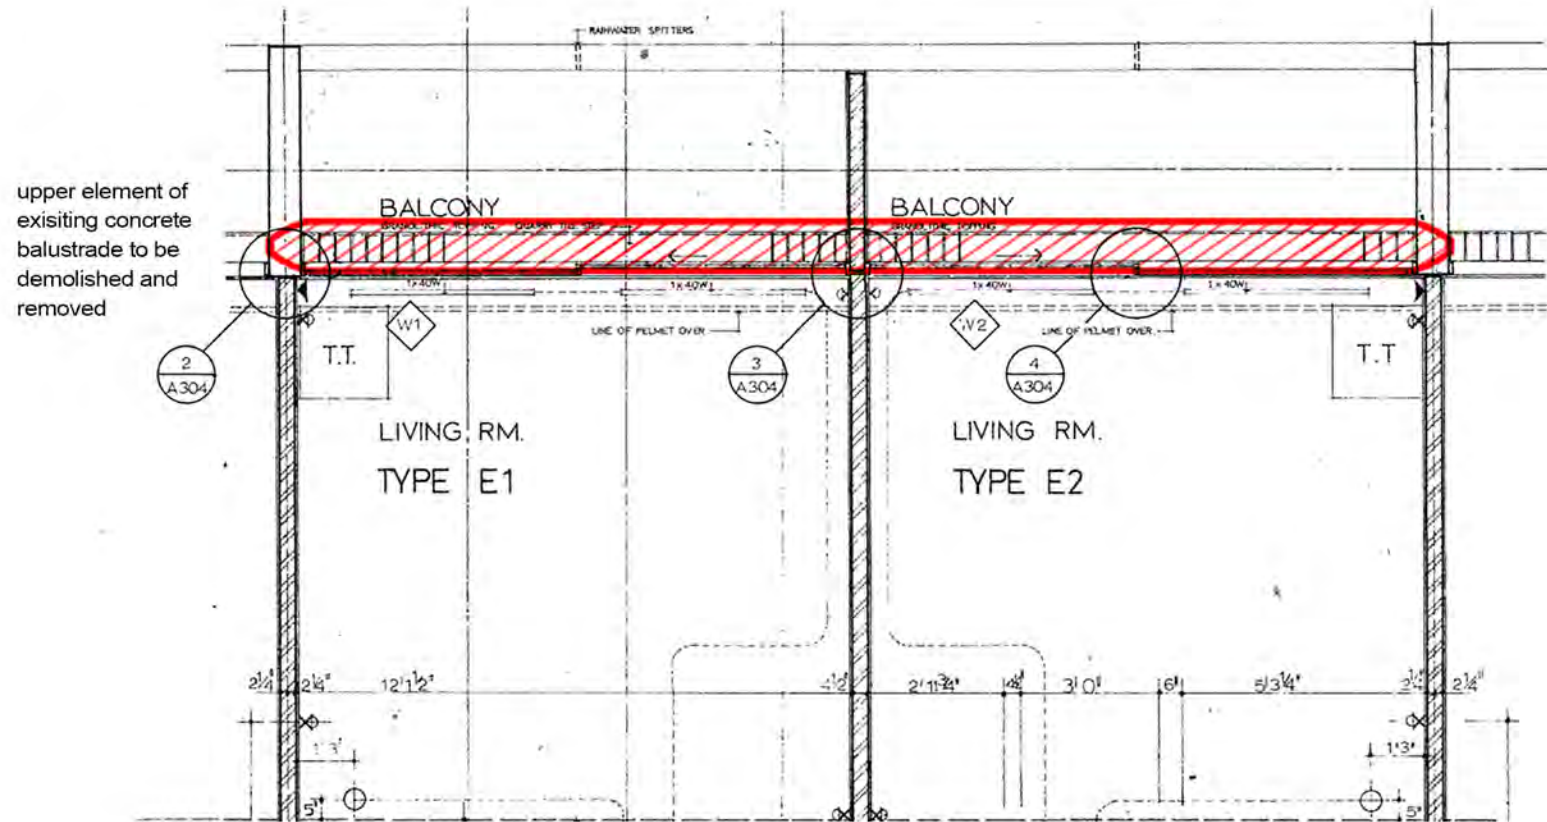

2 APARTMENT TYPICAL PLAN @ 1:50

Elements to be demolished indicated in red hatching overlay.
This applies to all residential floors as shown in DWG00

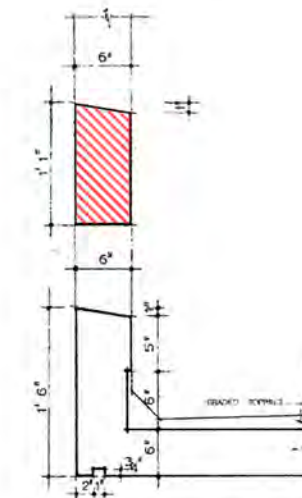

EXISTING BALUSTRADE - DETAIL SECTION 1:20

Elements to be demolished indicated in red hatching overlay.
This applies to all residential floors as shown in DWG00

ALL DIMENSIONS TO BE CONFIRMED ON SITE

SHEET NAME:	EXISTING TO DEMOLISH
OWNER AND PROJECT LOCATION:	The Owners Corporation SP7114 22 Ground Floor, 22, Central Avenue, Manly NSW


DATE:	16/5/2023
DRAWN BY:	Author
SHEET NUMBER:	A002
SCALE:	Various

northern beaches council

THIS PLAN IS TO BE READ IN CONJUNCTION WITH THE CONDITIONS OF DEVELOPMENT CONSENT

DA2023/0972

COPYRIGHT
This drawing is the copyright of urbane ply ltd. It is issued on condition that it is not to be copied or reproduced in any form, or disclosed to any unauthorised person, without the express written consent of urbane ply ltd. Do not scale from this drawing.

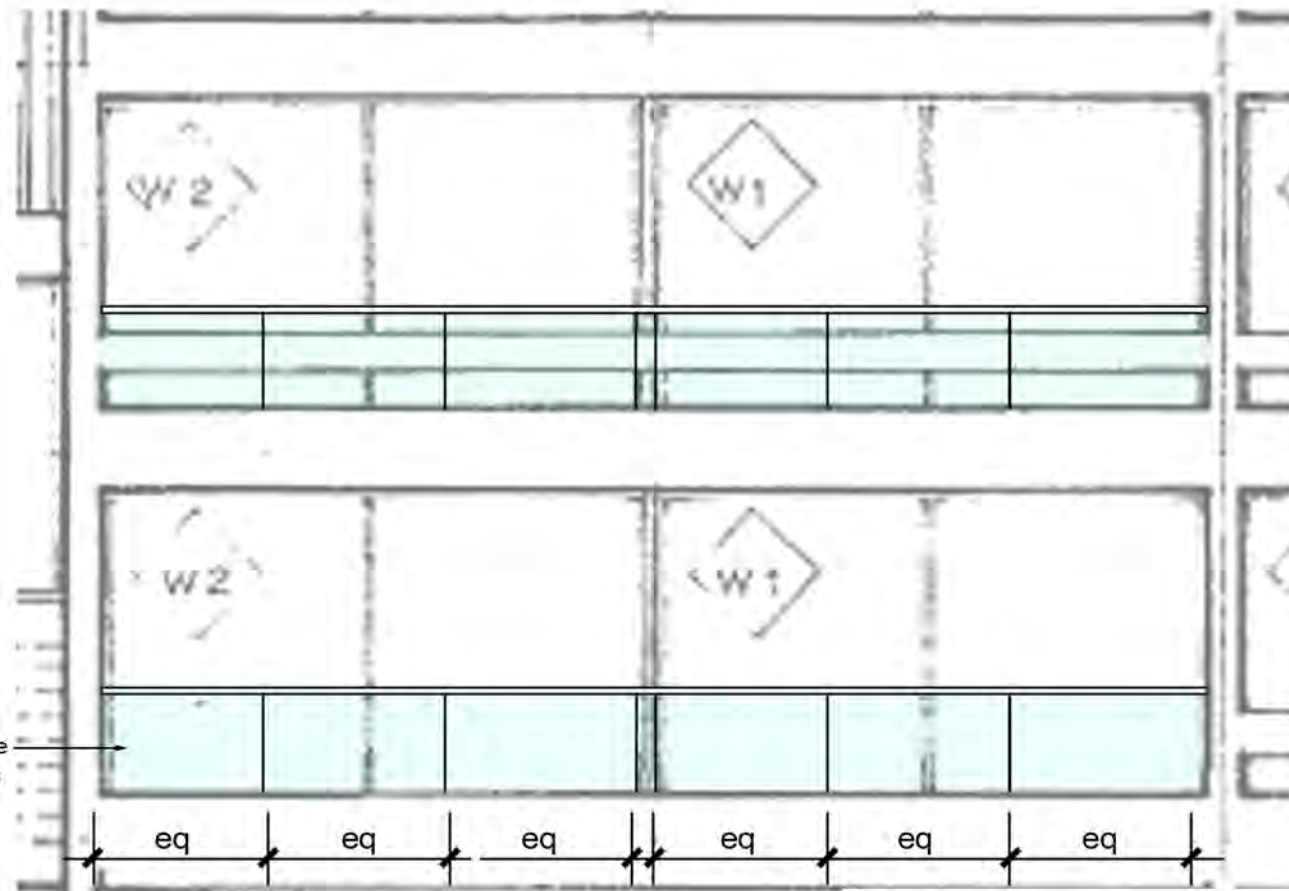


2 STOREY TYPICAL ELEVATION @ 1:50

Elements to be demolished indicated in red hatching overlay.
This applies to all resident floors as shown in DWG00

ALL DIMENSIONS TO BE CONFIRMED ON SITE

new glass balustrade
3 equal panel widths
fixed to existing hob
with mechanical s/s
fixing - to engineer's
detail

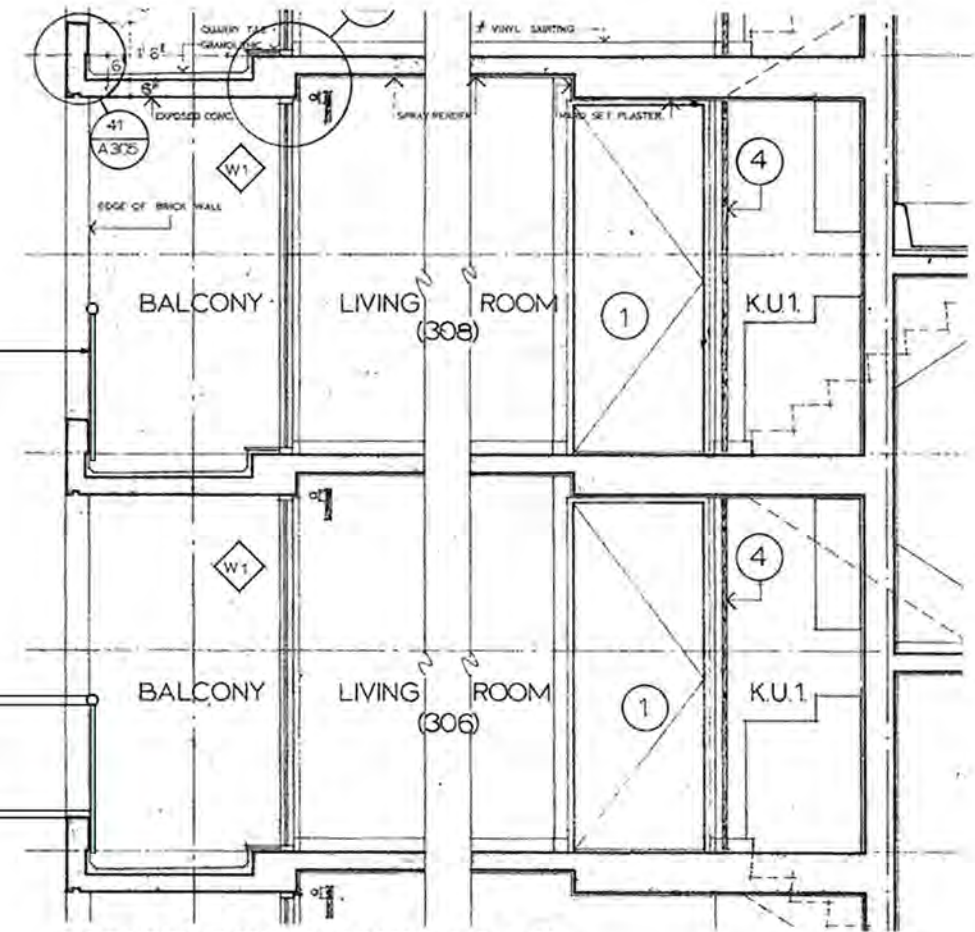

2 STOREY TYPICAL SECTION @ 1:50


Elements to be demolished indicated in red hatching overlay.
This applies to all resident floors as shown in DWG00

new glass balustrade
3 equal panel widths
fixed to existing hob
with mechanical s/s
fixing - to engineer's
detail

handrail - 25mm
to engineer's detail

overall height above
tiles 1100mm


gap from base of
glass to top of tiling

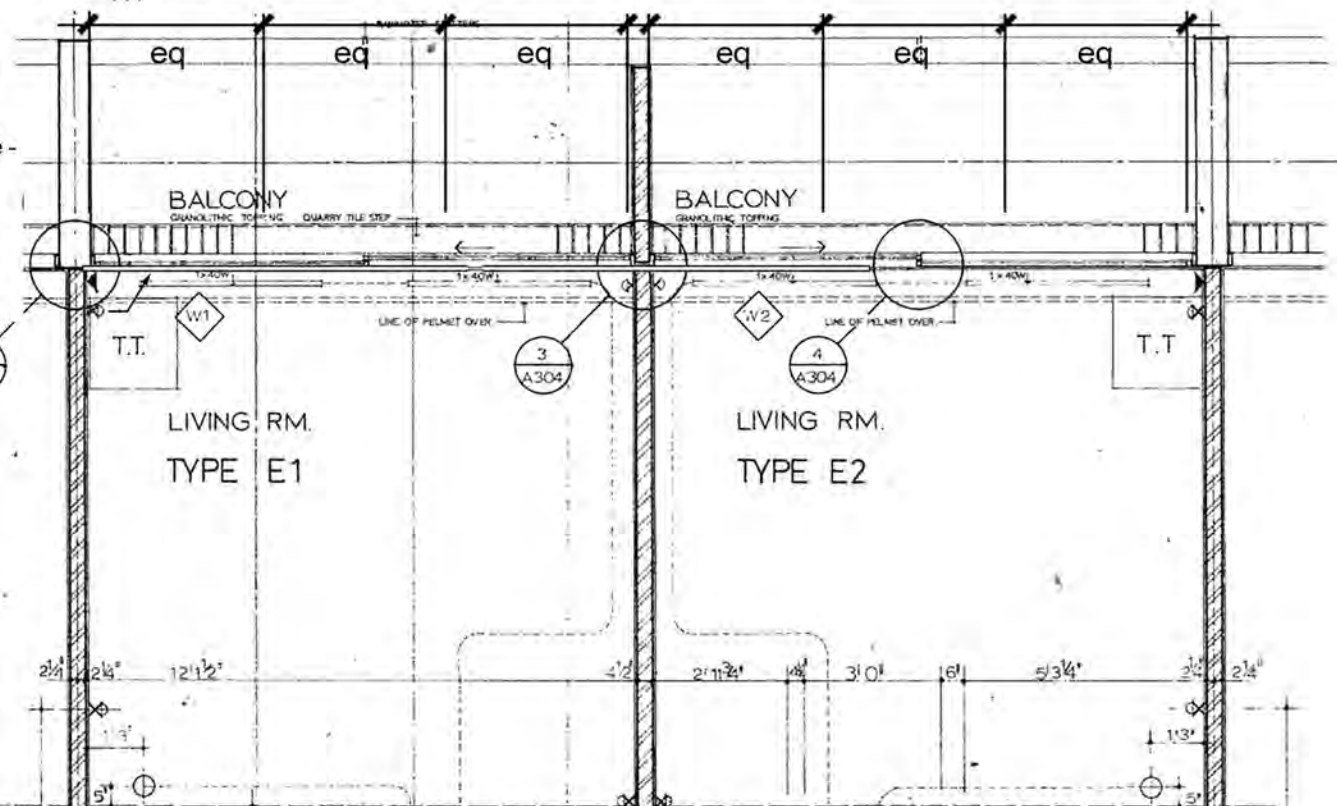

2 APARTMENT TYPICAL PLAN @ 1:50

Elements to be demolished indicated in red hatching overlay.
This applies to all resident floors as shown in DWG00

new glass balustrade -
3 equal panel widths
fixed to inside of
existing hob
with mechanical s/s
fixing - to engineer's
detail

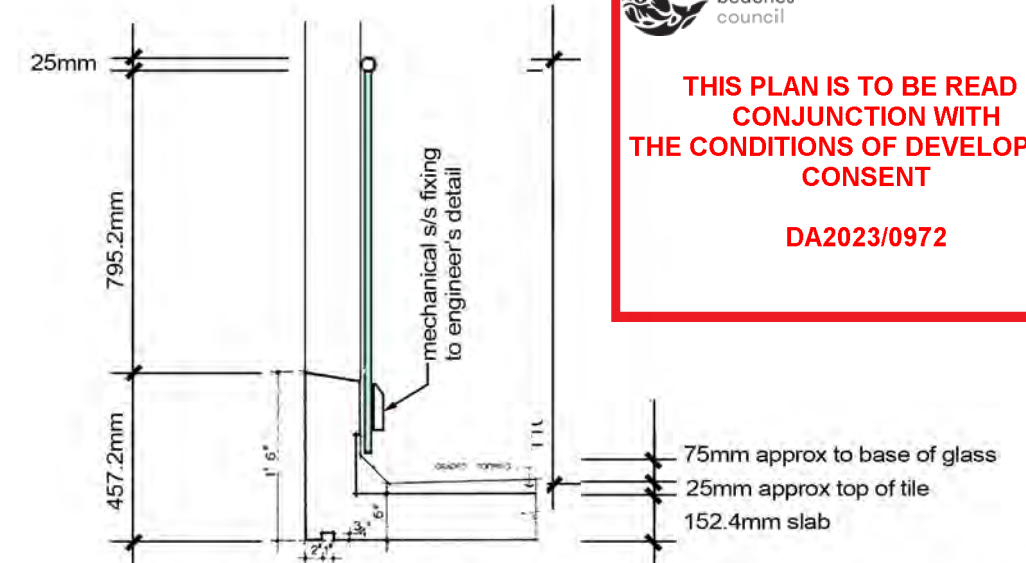

PROPOSED BALUSTRADE - DETAIL SECTION @ 1:20

Elements to be added.
This applies to all resident floors as shown in DWG00

northern beaches council

THIS PLAN IS TO BE READ IN CONJUNCTION WITH THE CONDITIONS OF DEVELOPMENT CONSENT

DA2023/0972

SHEET NAME: **NEW BALUSTRADE PROPOSAL**

OWNER AND PROJECT LOCATION: **The Owners Corporation SP7114 22
Ground Floor, 22, Central Avenue, Manly NSW**

DATE: **16/5/2023**

DRAWN BY: **Author**

SHEET NUMBER: **A003**

SCALE: **Various**

urbaine
ARCHITECTURE
urbaine pty ltd, 8/15, The Corso, Manly, NSW 2095. Tel: 02 8355 6770

COPYRIGHT
This drawing is the copyright of urbane pty ltd
It is issued on condition that it is not to be copied or reproduced in any form
or disclosed to any unauthorized person, either wholly, or in part without
the express written consent of urbane pty ltd
Do not scale from this drawing.