


- NOTES:
1. Original survey by Montek Property Surveys dated 19.12.04
 - 1-1 Boundaries, dimensions and areas shown hereon are title and subject to full survey.
 - 1-2 Boundaries are approximate only and should be clearly marked prior to construction.
 - 1-3 Origin of levels SSM 10737 Adopted as RL 110.933 AHD.
 - 1-4 No investigation has been made of underground services on or adjacent to this land.
 - 1-5 Restriction on building may apply to this land.
 - 1-6 Tree spreads are diagrammatic only
 - 1-7 Features and Levels Shown are to Topographical Mapping Accuracy
 - 1-8 Sewer position is approximate only, scaled from Diagram of Sanitary Drainage
 2. No.110 Cook St. survey updated by HAO Design Pty Ltd 12.09.18 based on DA2011/1652 + CDC2012/0223 notification plans info from formal Warringah Council & visual site inspection
 3. No.39 Starkey St Secondary Dwelling (DA2014/0958) as-built info updated by HAO Design Pty Ltd 19.02.19

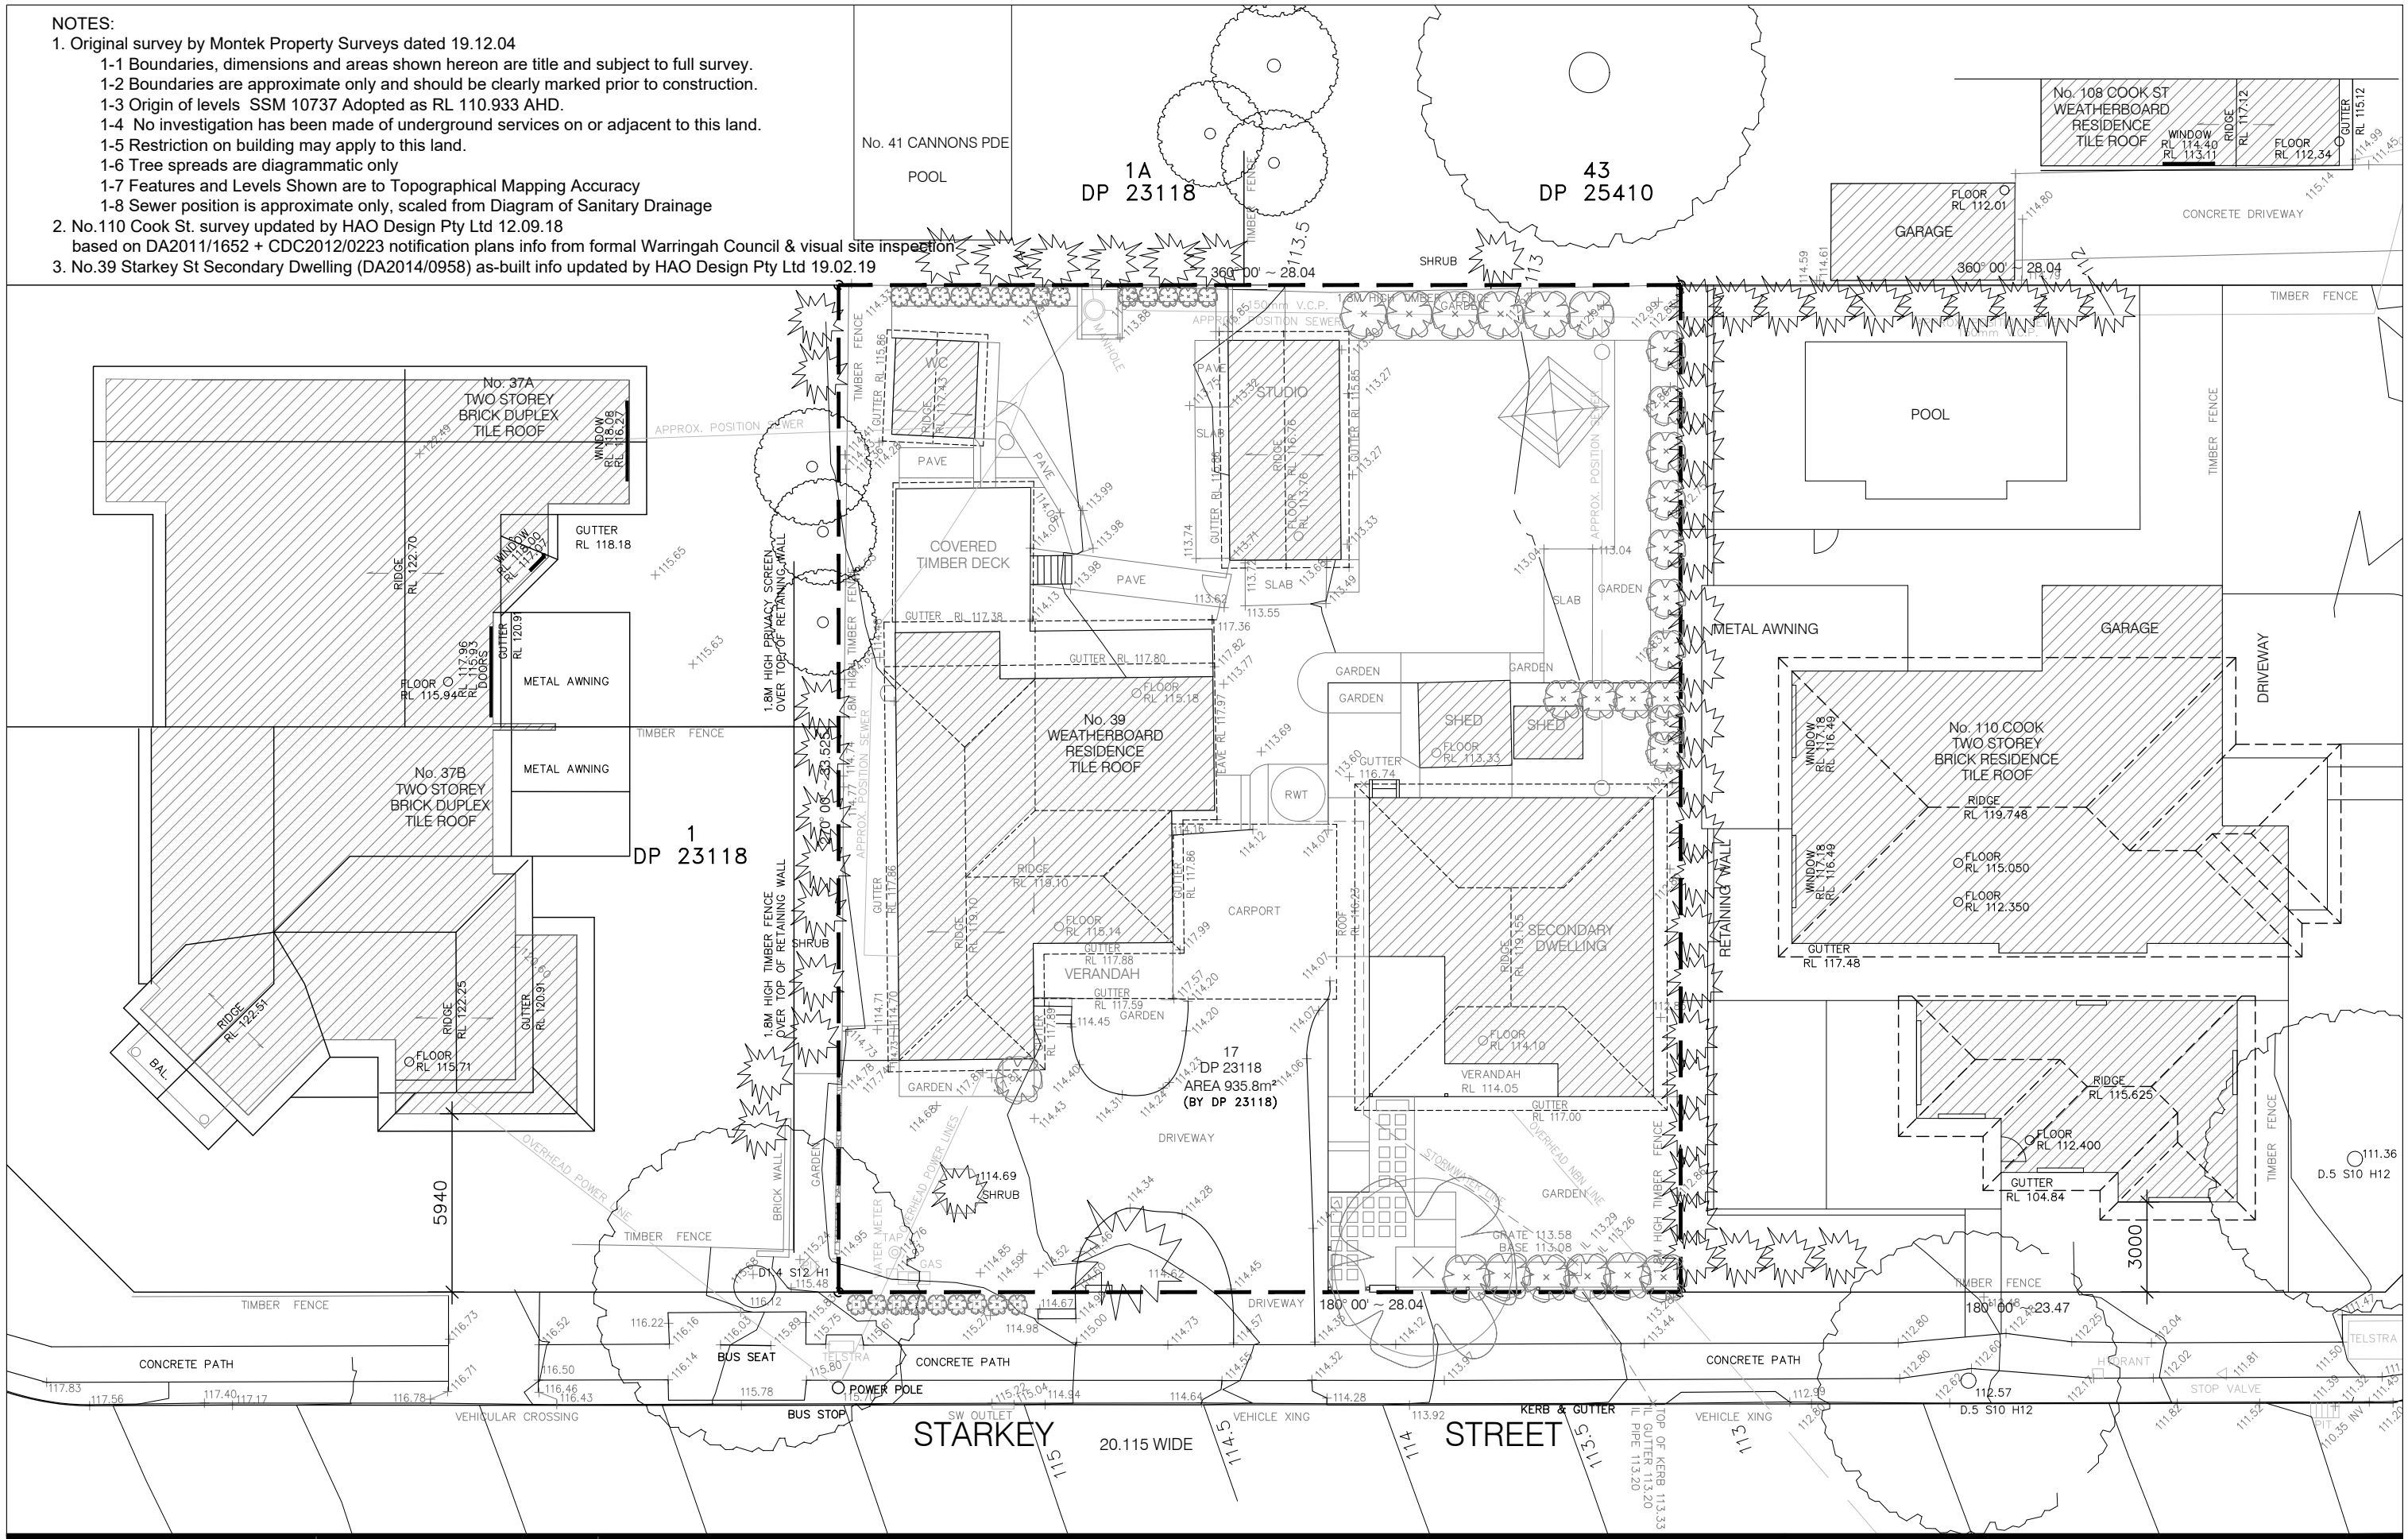

www.hao.com.au
M: 0403 263 365
admin@hao.com.au

C	DEVELOPMENT APPLICATION	10.02.20
B	DEVELOPMENT APPLICATION DA2019/0358	19.02.19
A	DEVELOPMENT APPLICATION DA2014/0958	11.08.14
REVISION	AMENDMENT	DATE

PROJECT:
ALTERATIONS & ADDITIONS
APPLICANT: TSU-HAO LIN
LOT 17, DP 23118
39 STARKEY STREET
FORESTVILLE NSW 2087



DRAWING TITLE:
LEVEL & FEATURE SURVEY
LOT 17, DP23118
DRAWING STATUS:
PLANNING
APPROVAL

SCALE:	1:200	CAD FILE:	survey-starkey.dwg
SIZE:	A3	DESIGN:	N/A
DATE:	10 FEBRUARY 2020	CAD:	DL
PROJECT No:	140808	DRAWING No:	S01
		REVISION:	C