# **CO-LOCATION MANLY**

GG Project Number: **Project Name:** 

**Project Location:** 

WES203498D St George MANLY

15A & 17 THE CORSO MANLY NSW 2095 Australia

# **PROJECT CONTACTS**

PROJECT PM:	Lawrence Duong Iduong@mostyncopper.com.au
DESIGNER:	Rachel Moon


# Please find enclosed the following drawings:

		,					
	DAY	09	05				
WES203498D E	MONTH	04	09				
MANLY	YEAR	24	24				

										_	
SHT	HT TITLE REVISION										
0.0	Cover Page	А	В								
0.1	GENERAL NOTES	Α	Α								
0.2	GENERAL NOTES	Α	Α								
1.1	SITE PHOTOS	Α	Α								
1.2	EXISTING / DEMOLITION PLAN (A2)	Α	В								
1.3	CONSTRUCTION PLAN (A2)	Α	В								
1.4	PROPOSED FLOOR PLAN (A2)	Α	В								
1.5	SHOPFRONT ELEVATIONS	Α	Α								
1.6	DOOR SCHEDULE	Α	Α								

# DISTRIBUTION LIST

LAWRENCE DUONG - MOSTYN COPPER	$\checkmark$	/				

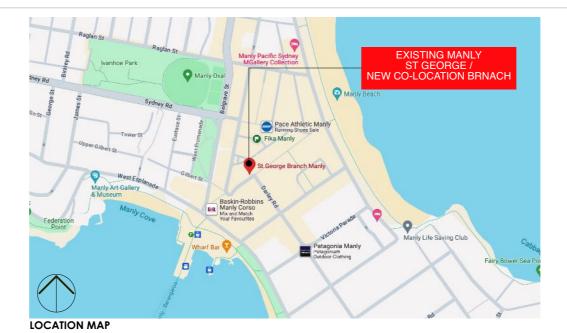





**EXISTING SHOPFRONT PHOTOS** 



REVISIONS				
#	Amendment:	Init:	Date:	
Α	DA PACK ISSUE FOR COUNCIL APPROVAL	RM	09/04/26	IS
В	DA PACK ISSUE FOR COUNCIL APPROVAL	RM	05/09/26	
				С
				N
				15

st.george FOR COUNCIL APPROVAL



CO-LOCATION						
MANLY						
15A & 17, THE CORSO,						
MANIY NSW 2095						

DRAWING: Cover Page

Date: 5/9/2024 Drawn: RM Scale: N/A Size: A3 GG Project: WES203498D Rev by: -Rev: 0.0

# 1.0 GENERAL SPECIFICATIONS

- 1.1 THE PURPOSE OF THIS CONCEPT / TENDER DRAWINGS IS TO PROVIDE THE DESIGN INTENT OF THE PROPOSED FITOUT WORKS.
  - WORK IN THIS SECTION COMPRISES THE PROVISION OF ALL SAFETY, SUPERVISION, LABOUR, MATERIALS, PLANT AND EQUIPMENT NECESSARY TO COMPLETE THE SUPPLY AND INSTALLATION OF THE FITOUT WORKS INCLUDING RELATED ITEMS AS INDICATED ON THE DRAWINGS AND SPECIFICATION TO THE SATISFACTION OF THEDESIGN STANDARDS, LOCAL AUTHORITIES, AUSTRALIAN STANDARDS AND CODES OF PRACTICE.
- THIS DOCUMENT IS TO BE READ IN CONJUNCTION WITH THE RETAIL DESIGN STANDARDS PROVIDED BY WESTPAC GROUP OR ITS NOMINATED DESIGN CONSULTANT OR PROJECT MANAGER.
- THE FOLLOWING CLAUSES SHALL BE READ IN CONJUNCTION WITH THE DRAWINGS, SPECIFICATIONS AND ALL RELEVANT CLAUSES ARE APPLICABLE.
- THE SUBCONTRACTOR IS TO ENSURE THAT REFERENCING TO THE DRAWINGS IS CARRIED OUT PRIOR TO ALL WORKS THROUGHOUT 5.0 THE DURATION OF THE PROJECT

#### 2.0 **SITE VALIDATION**

- 2.1 THE FOLLOWING CONCEPT / TENDER DRAWING PACKAGE SHOULD BECHECKED ON SITE (C.O.S.) AND VALIDATEDFOR THE PROPOSED LAYOUT DESIGN WORKS WITH THE INTENDED TENANCY.
- 2.2 IT IS EXPECTED THE DESIGN CONSULTANT, PROJECT MANAGER AND HEAD CONTRACTOR CONFIRM ALL SITE MEASUREMENTS & INSPECT THE SITE OF WORKS THOROUGHLY PRIOR TO COMMENCING THE START OF ANY FITOUT WORKS.
- PREPARATION OF SITE SPECIFIC SHOP DRAWINGS OR FABRICATION DRAWINGS TO BE SUBMITTED TO WESTPAC GROUP OR ITS NOMINATED DESIGN CONSULTANT PRIOR TO THE START OF WORKS.
- 2.4 ANY DISCREPANCIES ARE TO BE FORWARDED TO THE DESIGN CONSULTANT & PROJECT MANAGER FOR RESOLUTION & INSTRUCTIONS.
- DIMENSIONS ARE TAKEN FROM FINISHED FACE UNLESS NOTED OTHERWISE.

# 3.0 NATIONAL CONSTRUCTION CODE (NCC)

- 3.1 FIRE HAZARD PROPERTIES FOR ALL LININGS AND MATERIALS TO COMPLY WITH NCC (BCA) SPECS C1.10. CRITICAL RADIANT FLUX (CRF IN KW/M2) FOR NEW FLOOR, WALL AND CEILING LINING MATERIALS NOT TO BE LESS THAN 2.2 FOR GENERAL OFFICE AREAS (OR 1.2 IF SPRINKLERED) TO COMPLY WITH BCA C1.10A. MATERIAL SUPPLIER TO PROVIDE MATERIAL SPECIFICATIONS SHOWING COMPLIANCE DETAILS.
- 3.2 ALL GLAZING TO COMPLY WITH PART B1 OF THE BCA WHICH REQUIRES COMPLIANCE WITH AS 1288 - 2006 AND AS 2047 - 1999. ALL EXTERNAL GLAZING TO ALSO COMPLY WITH THE REQUIREMENTS OF PART J2 OF THE BCA.
- ALL WET AREAS, I.E. TOILETS, TO BE MADE WATER RESISTANT OR WATERPROOFED IN ACCORDANCE WITH AS3740.
- NON-DISCRIMINATORY ACCESS REQUIREMENTS TO PREMISES, I.E. NO STEP ENTRY, RAMPS, STAIRS, TO COMPLY WITH APPLICABLE PROVISIONS OF AS1428.1-2009 AND NCC (BCA).

# 4.0 AUSTRALIAN STANDARDS

- 4.1 PARTITIONS & DOORS
- 4.1.1 ALL NEW GLAZED PARTITIONS & DOORS TO COMPLY WITH

- AS1288 & AS2047 AS RELEVANT.
- 4.1.2 ENSURE DOOR HARDWARE TO COMPLY WITH BCA D2.21 AND AS1428.1-2009 CLAUSE 13. ALL DOORS TO BE OPERABLE BY A SINGLE LEVER ACTION & IN ACCORDANCE WITH AS1428.1-2009 IN PATH OF EGRESS.

## 4.2 CONSTRUCTION & BUILD

- 4.2.1 ALL MATERIALS TO BE APPLIED &/OR INSTALLED TO MANUFACTURERS SPECIFICATIONS.
- 4.2.2 ALL WORKS INCLUDING SERVICES INSTALLATIONS ARE TO BE CARRIED OUT IN AN ACCEPTABLE TRADESMAN-LIKE MANNER & SHALL COMPLY WITH THENATIONAL CONSTRUCTION CODE (NCC) & ALL RELEVANT AUSTRALIAN STANDARDS. THE REQUIREMENTS OF THE LOCAL BUILDING CERTIFIER & OTHER RELEVANT STATUTORY GUIDELINES.
- 4.2.3 DEEMED TO SATISFY PROVISIONS AND CURRENT WESTPAC DESIGN STANDARDS ARE TO TAKE PRECEDENCE OVER ARCHITECTURAL DOCUMENTATION. IF A CONFLICT IS FOUND. BEFORE ANY FURTHER WORK IS UNDERTAKEN, NOTIFY ARCHITECT IMMEDIATELY FOR DIRECTION ON HOW TO PROCEED.

# **DEMOLITION & REMOVAL**

ALL DEMOLITIONED BUILDING MATERIALS SHOULD BE REMOVED FROM THE SITE IN A CLEAN AND COMMERCIAL MANNER.

#### 5.2 STAFF ITEMS IN MEETING ROOMS

5.2.1 ALL STAFF OWNED ITEMS EG. AWARDS OR PHOTOGRAPHS SHOULD BE REMOVED FROM TYPICAL MEETING ROOMS AND RETURNED TO STAFF TO TAKE HOME.

#### 5.2 LOCAL ARTEFACTS OR MEMORABILIA

5.2.1 IF THERE IS ANY LOCAL MEMORABILIA OR ARTEFACTS THAT EXIST IN THE BRANCH THIS SHOULD BE REMOVED AND RETURNED TO STAFF OR LOCAL BUSINESS TO REMOVE FROM NEW BRANCH STANDARDS.

#### 5.3 **SHOPFRONTS**

- 5.3.1 ALL MARKETING DECALS UNLESS NOTED OTHERWISE SHOULD BE REMOVED FROM SHOPFRONT GLASS TO ENSURE NEW DECALS TAKE PRECEDENCE.
- 5.3.2 ALL ACM BRANCH PLAQUES ARE TO BE REMOVED FROM BRANCH.
- 5.3.3 ALL EXISTING SHOPFRONTS SHOULD BE COMMERCIALLY 'WHITE GLOVE CLEANED' - NO DIRT, DUST, GRIT, STAINS ARE

#### 5.4 ENTRY WAY

5.4.1 ALL SHOPFRONT ENTRY WAYS ARE TO BE GIRNIED CLEAN WITH ACID WASH TO TILES, ENSURE NO GRIT, DIRT OR DUST IS REMAINING ON ENTRY FLOOR, GLAZING MULLION, ATM BUNKER, BOLLARDS AND TO NEW ENTRY MAT WELL

# 6.0 CONSTRUCTION

GENERAL

REFER TO CHAPTER 5 WESTPAC GROUP RETAIL DESIGN STANDARDS FOR DOOR & HARDWARE SCHEDULE & DOOR MASTER DRAWING SPECIFICATION. REFER TO CHAPTER 5 WESTPAC GROUP RETAIL DESIGN STANDARDS FOR PARTITION SCHEDULE & MASTER DRAWING SPECIFICATION.

- **DOORS & PARTITIONS**
- 6.2.1 ENSURE DOOR HARDWARE TO COMPLY WITHBCA D2.21 AND AS1428.1-2009 CLAUSE 13.5. ALL DOORS TO BE OPERABLE BY A SINGLE LEVER ACTION & IN ACCORDANCE WITH AS1428.1-2009 IN PATH OF EGRESS.
- 6.2.2 ALL NEW DOOR CLEAR OPENINGS MINIMUM OF 850mm CLEAR LEAF OPENING UNLESS OTHERWISE NOTED

- 6.2.3 ENSURE DOOR CLEARANCE AS PERAS1428.1-20.09
- 6.2.4 DOORS TO AREA WHERE FACILITIES WITH SAFE OR ATM MACHINE TO HAVE 950mm CLEAR DOOR OPENING.
- 6.2.5 ENSURE DOOR CIRCULATION TO ALL EXISTING DOORS ARE NOT AFFECTED BY NEW WORKS.
- 6.2.6 HEAD CONTRACTOR TO PATCH & REPAIR ANY DAMAGE TO WALLS, DOORS & CEILINGS WHICH ARE AFFECTED BY NEW WORK TO THE WESTPAC GROUP RETAIL DESIGN STANDARD.
- 6.3 WALL MOUNTED VIDEO CONFERENCING UNIT
- 6.3.1 ALL NOMINATED LOCATIONS FOR THE WALL MOUNTED VIDEO CONFERENCE (VC) UNIT LOCATED WITHIN A "CONNECT NOW" OR "BUSINESS CONNECT" MEETING ROOM SHOULD BE MOUNTED ONTO A CONCEALED PLYWOOD OR MDF SHEET TO ENSURE STRUCTURAL STABILITY OF THE CISCO VC UNIT AND WALL BRACKET (SPEC - CHIEF TS218S).
- 6.3.2 NOMINATED WALL MOUNT BRACKET SPECIFICATIONHIEF TS218SU THINSTALL DUAL SWING ARM WITH PHONE STAND (WWW.CHIEFMFG.COM/PRODUCTS/TS218SU) NOMINATED VIDEO CONFERENCING HARDWARE SPECIFICIATION -CISCO EX90 & CISCO PHONEHTTP://WWW.CISCO.COM/C/EN/US/ SUPPORT/COLLABORATION-ENDPOINTS/TELEPRESENCE-SYSTEM-EX90/MODEL.HTML).
- 6.3.3 MOUNTING HEIGHT IS TO BE 1200 AFFL TO THE CENTRELINE OF THE WALL BRACKET - REFER TO CHAPTER 5 GENERIC CONSTRUCTION.
- 6.3.4 MOUNTING WIDTH IS TO BE 450 WIDE FROM LINE OF JOINERY DESK - REFER TO CHAPTER 3 PLANNING PRINCIPLES & CHAPTER 6 GENERIC JOINERY.
- 6.3.5 POWER & DATA SWITCHES ARE TO BE MOUNTED 1200 AFFL BESIDE THE WALL MOUNTED BRACKET. ALL EXCESS CABLING & POWER TRANSFORMER IS TO BE CABLE TIED AND STRAPPED TO THE VC UNIT.

#### 6.4 TELLER BLOCK OFF

- 6.4.1 REFER TO WESTPAC GROUP'S TELLER BLOCK OFF STANDARD DETAILS FOR THE APPROVED BLOCK OFF GRADE DETAILS.
- 6.4.2 PROJECT MANAGER SHOULD COORDINATE WITH THE NOMINATED SECURITY CONTRACTOR TŒNSURE NO SECURITY OR SERVICES ITEMS ARE AFFECTED WITH THE NEW WORKS
- 6.4.3 TELLER BLOCK OFFS SHOULD NOT IMPEDE ON CCTV VIEW AND SIGHTLINES. SECURITY STAKEHOLDER TO RECONFIGURE NEW LOCATION.
- 6.4.4 WHERE NEW PARTITIONS OVER SCREENED TELLERS ARE INSTALLED AND AFFECTS THE GENERAL LIGHTING TO FOH / CUSTOMER SIDEALLOW FOR RELOCATION OF EXISTING OR SUPPLY NEW TROFFS TO REBALANCE LIGHT DISTRIBUTION.

## 6.5 **CEILINGS**

- 6.5.1 REFER TO SITE SPECIFIC REFLECTED CEILING PLANS AND THE WESTPAC GROUP RETAIL DESIGN & ENGINEERING DESIGN STANDARDS FOR LIGHT FEATURE SPECIFICATIONS AND POSITIONS.
- 6.5.2 FOR NEW BUILDS ALLOW FOR SET PLASTERBOARD CEILING TO FRONT OF HOUSE (FOH) AND GRID CEILING TO BACK OF HOUSE (BOH).
- 6.5.3 FOR EXISTING BRANCHES PROJECT MANAGER HEAD CONTRACTOR TO REVIEW & VALIDATE CONDITION OF THE CEILING TILES AND REPLACE ANY DAMAGED OR BROWN CEILING TILES WITH NEW
- 6.5.4 FOR NEW BUILDS WHERE SECURITY NOMINATED WALLS ARE TO BE INSTALLED, ENSURE ADJUSTMENT OF VERTICAL OR HORIZONTAL F72 MESH LOCATION TO SUIT NEW CEILING WORKS
- 6.5.5 FOR NEW BUILDS ALLOW MECHANICAL LINEAR DIFFUSER TO BE CONCEALED ABOVE CEILING & BULKHEADS.

(CONTINUE TO NEXT SHEET)



\*ALIQUATIC SMORE DETECTION AND ARM SYSTEM TO COMMY WITH SPECIFICATION 822A OF THE ALIQUATION OF THE AL

DLOUR TEMPERATURE TO BE 3000K UNLESS SPECIFIED OTHERWISE IICAL VENTILATION SYSTEM TO COMPLY WITH AS.1668.2 AND AS.3666 / NZS 1688.2 FOR NID AS 3666 / NZS 4303 - 1999 FOR FRESH AIR. ALL MECHANICAL AND FIRE SERVICES TO RE FRY THE APPROPRIET AUTHORITY.

#### **REVISIONS**

#	Amendment:	Init:	Date:
Α	Issue for Council Approval	RM	09/04/24
В	Issue for Council Approval	RM	05/09/24

CLIENT:



ISSUE:

# FOR COUNCIL APPROVAL

# **CO-LOCATION MANLY**

15A & 17, THE CORSO, MANLY NSW 2095, Australia

DRAWING: **GENERAL NOTES** 

	Users/rachel/GG		D(Rev.
Scale:		Size:	А3
GG Project:	WES203498D	Rev by:	-
Sheet:	0.1	Rev:	Α

# 7.0 **FINISHES**

#### **GENERAL**

REFER TO CHAPTER 7 WESTPAC GROUP RETAIL DESIGN STANDARDS FOR MASTER FINISHES & FIXTURES SCHEDULE REFER TO CHAPTER 5 – GENERIC CONSTRUCTION MASTER SCHEDULE & DRAWINGS FOR FLOOR JUNCTION STANDARDS.

#### 7.2 **PARTITIONS**

- 7.2.1 ALL AFFECTED WALLS TO BE PAINTED TO MATCH ADJOINING WALL FINISH.
- 7.2.2 ALL WALLS TO BE PAINTED IN THE BRAND SPECIFIC COLOUR JUNLESS NOTED OTHERWISE, REFER TO SITE SPECIFIC DRAWINGS.
- 7.2.3 ALL TENANCY COLUMNS MUST BE FINISHED IN HIGH GLOSS.

#### 7.4 FLOORING

- 7.4.1 ALL FLOOR JUNCTION DETAILS ARE TO BE BUILT AS PER THE WESTPAC GROUP RETAIL DESIGN STANDARDS - REFER TO CHAPTER 5 - GENERIC CONSTRUCTION DRAWINGS DWG FD-01; FD-02 & FD-03.
- 7.4.2 HEAD CONTRACTOR / BUILDER TO CONFIRM ON SITE EXTENT OF FEATURE CARPET TO FRONT OF HOUSE AREA MODIFY CARPET TO SUIT NEW LAYOUT.
- 7.4.3 ALL INTEGRATED ANTI-FATIGUE MAT WELLS REQUIRE A 1.0M -1.2M SCREEDO ENSURE SMOOTH RAMPING FROM FLOOR LEVEL TO FINISHED LEVEL OF INTEGRATED MAT.

#### 7.5 **TELLER COUNTERS**

- 7.5.1 TELLER TOP FINISHES SHOULD REMAIN AS IS. FRONT PANELS OF TELLER COUNTERS SHOULD BE RESURFACED WITH WRAPPED TOP, SIDES & BOTTOM INDINOC PRODUCT SPEC "BRIGHT OR SNOW WHITE" (HTTP://WWW. 3M.COM/3M /EN\_US/COMPANY-US/ALL-3M-PRODUCTS/~/ALL-3M-PRODUCTS/DESIGN-CONSTRUCTION/ ARCHITECTURAL-DESIGN/ARCHITECTURE-CONSTRUCTION/ ARCHITECTURAL- FINISHES/ SURFACE-FINISHES)
- 7.5.2 ALL EXISTING TELLER NUMBERS AND RED/GREY VINYL BANDS ARE TO BE REMOVED FROM EXISTING ANTI-JUMP BARRIERS (AJB).

# 8.0 SIGNAGE & NOMINATED GRAPHICS

REFER TO CHAPTER 11 WESTPAC GROUP RETAIL DESIGN STANDARDS - FOR SIGNAGE MANUAL MAKE GOOD TO SURFACES FOLLOWING REMOVAL OF SIGNS.

#### STATUTORY SIGNS

- 8.1.1 REPLACE ALL STATUTORY & DIRECTIONAL SIGNAGE TO AFFECTED DOORS, SIGNAGE AS PER WESTPAC STANDARDS.
- GRAPHICS FEATURE
- 8.2.1 ANY PARTITIONS WHICH ARE TO RECEIVE A DIGITAL PRINTED GRAPHIC IS TO BE PRIMED AND PREPPED AS PER THE BLUE MEDIA GROUP WALL PREPARATION GUIDELINES TO ENSURE NO PEELING OF DECALS OCCUR.
- 8.3 STAFF ONLY DOORS
- 8.3.1 ALL DOORS LEADING INTO BACK OF HOUSE (BOH) SHOULD BE LABELLED 'STAFF ONLY'.

# EXTERNAL SIGNAGE

- 8.4.1 ALL NEW EXTERNAL SIGNAGE SHOULD BE SET ON TIMER. REFER TO ENGINEERING STANDARDS FOR HOURS.
- 8.4.2 FOR UNDERAWNING LIGHT BOXES THE WESTPAC LOGO SHOULD BE CLOSEST TO THE CURB.

# 9.0 **JOINERY**

#### **GENERAL**

REFER TO WESTPAC GROUP RETAIL DESIGN STANDARDS -CHAPTER 6: MASTER DRAWING & SCHEDULES. REFER TO WESTPAC GROUP'S DESIGN & ENGINEERING STANDARDS FOR POWER & DATA SETOUT AND STANDARDS.

#### 9.1 WALL FEATURES

- 9.1.1 ALL WALL HUNG OR FIXED JOINERY IS TO BE SUPPLIED WITH APPROPRIATE STRUCTURAL SUPPORT TO COMMERCIAL GRADE QUALITY.
- 9.1.2 HALO LIGHTING IS TO BE SUPPLIED AND INSTALLED TO ALL NEW WALL JOINERY UNITS.

#### 9.2 POWER & DATA RETICULATION

- 9.2.1 ALLOW FOR CHASING OF ALL POWER & DATA TO FREESTANDING JOINERY ITEMS. SEEK STRUCTURAL & BUILDING OWNER APPROVALS PRIOR TO COMMENCING CONSTRUCTION.
- 9.2.2 JF08, JF09, JF11 & JF12 POWER AND DATA OUTLETS TO BE HARDWIRED DIRECTLY ONTO THE PARTITION WITHIN THE NOMINATED JOINERY CUTOUT ZONE.

#### 9.3 MFU CUPBOARD

9.3.1 PROJECT MANAGER TO ALLOW FOR EXTRACTION FAN WHERE MFU PRINTER CUPBOARD IS TO BE INSTALLED NEW OR RELOCATED.

#### 10.0 SECURITY

#### **GENERAL**

REFER TO SITE SPECIFIC SECURITY BRIEF & SCOPE AT ALL TIMES. PROJECT MANAGER TO CONFIRM WITH SECURITY STAKEHOLDER PRIOR TO START OF WORKS.

#### 10.1 TELLER BLOCK OFFS

10.1.1REFER TO NOMINATED, SITE SPECIFIC BLOCK OFF GRADES. 10.1.2WHERE TELLER BLOCK OFFS ARE SCOPED INTO A BRANCH ALL AFFECTED CCTV CAMERAS SHOULD BE RELOCATED TO SUIT NEW LAYOUT.

#### 10.2 ATM BUNKERS

10.2.1WHERE AREAS WITHIN THE SHOPFRONT THAT IS EXPOSED AR GRADE SHEETINGOULD BE INSTALLED. REFER TO CHAPTER 5 - GENERIC CONSTRUCTION MASTER DRAWINGS & SCHEDULES.

# 10.3 FIRE EXTINGUISHERS

10.3.1FIRE EXTINGUISHERS ARE NOT TO BE LOCATED IN FOH FOR SAFETY AND SECURITY REASONS. EXISTING FIRE EXTINGUISHERS IN THE FOH ARE TO BE RELOCATED TO BOH IN CO-ORDINATION WITH SERVICES ENGINEERS OR A SUITABLY QUALIFIED PERSON FOR FIRE SAFETY COMPLIANCE.

# 11.0 TECHNOLOGY, AV & CABLE MANAGEMENT

# 11.1 CABLE TIDY

11.1.1FOR ALL MEETING ROOMS THE HEAD CONTRACTOR SHOULD SUPPLY CABLEITAN AV CABLE MANAGEMENT HOOK & LOOP FASTNER WRAP SOCK 2 METRE; PRODUCT SPEC: BDL-00071 TO TIDY CABLES FROM TABLE TO POWER/DATA POINT WITHIN ROOM. (HTTPS://WWW.VFMAUDIO.COM.AU/15498/TITAN-AV-CABLE-MANAGEMENT-HOOK-AND-LOOP-FASTENER-WRAP-SOCK-2-METRE-SET-OF-2/)

#### 11.2 QUICK SERVE DESKS

11.2.1REFER TO CHAPTER 6 - GENERIC JOINERY; JF-01 QUICK SERVE DESK AND CHAPTER 7 - BRANCH EQUIPMENT FOR REQUIRED TECHNOLOGY AND AV HARDWARE.

# 11.3 TELLER REMEDIATION

- 11.3.1REFER TO THE DETAIL JOINERY DRAWINGS FOR HARDWARE & EQUIPMENT LOCATIONS.
- 11.3.4THIN CLIENT TERMINALS ARE TO BE POSITIONED ABOVE BENCH BEHIND THE NEW PRIVACY ACRYLIC SCREEN.

# 11.4 MONITOR ARMS

11.4.1FOR TELLER REMEDIATION PROJECTS A NEW MONITOR ARM ACCESSORY IS TO BE APPLIED. 7FLEX WITH 2-INCH HEIGHT ADAPTER SHOULD BE SUPPLIED ONLY. NO THIN CLIENT BRACKET. SUPPLIER DETAILS - DAVID PARKER DAVID@UPLIFTING.COM; ABOO 79 80 52 FROM UPLIFTING

SOLUTIONS - PRODUCT SPEC MODEL 62457-7000-500

11.4.2ALL MEETING ROOMS SHOULD BE SUPPLIED WITH THE PROPRIETARY MONITOR STAND SUPPLIED WITH THE NOMINATED MONITOR SCREEN.

#### 11.5 **WI-FI**

11.5.1NOMINATED CISCO WI-FI ROUTER IS CEILING MOUNTED. PROJECT MANAGER TO COORDINATE WITH IT STAKEHOLDER AND SERVICES ENGINEER TO ENSURE COORDINATION IS

# 12.0 ATM's, NIGHT SAFES & ATM BUNKER

#### 12.1 GENERAL

FOR STG BRANCHES REFER TO THE OFF-SITE ATM DESIGN STANDARDS - CONTACT ATM ENGAGEMENT MANAGER OR DESIGN MANAGER FOR THE LATEST DOCUMENTATION.

12.2 WHEN RECLADDING EXISTING SHOPFRONTS A SITE SURVEY AND SITE MEASURE IS REQUIRED PRIOR TO FABRICATION OF ANY NEW PANELING.

#### 12.3 ATM SURROUND

- 12.3.1 ATM SURROUND IS SUPPLIED & INSTALLED BY NOMINATED CONTRACTOR & SUPPLIER OF SIGNAGE.
- 12.3.2 ATM SURROUND SHOULD BE SECURELY FIXED TO SHOPFRONT WITHAR GRADE SHEETING INTERNAL SIDE OF BUNKER.

#### 12.4 NIGHT SAFES

- 12.4.1 WHERE THE NIGHT SAFE IS SCOPED IN AS REDUNDANT, THE SCOPE IS TO RETAIN ON SITE AS IS AND REMOVE THE NIGHT SAFE TRAP & REPLACE WITH NEW STAINLESS STEEL PLATE OVERSHEET OVER SHOPFRONT HOLE / GAP WITH NEW GRADESECURITY SHEETING AND APPLY NEW "RED WAVE GRAPHIC" FINISH.
- 12.4.2 PROJECT MANAGER TO ENSURE COORDINATION ON SCOPE AND CONSTRUCTION BETWEEN SECURITY STAKEHOLDER AND ATM CONTRACTOR.



AND SMM UNLESS CHIERWISE SPECIFIED.

REARS TO BE IMPERVIOUS TO WAITE, WALL SURFACES BEHIND ANY BASIN, SINK ETC OF A WAL BIGHT OF 300MM ABOVE THE FIXTURE, WATERPROOFING TO WET AREAS TO COMPLY WITH AS OF THE NEW ZEALAND BUILDING CODE.

OF THE NEW ZEALAND BUILDING CODE.

ORTWAYS TO HAVE A MINIUM UN-OBSTRUCTED HEIGHT OF 2.1M. THE MINIMUM WIDTH OF NEW

COLOUR TEMPERATURE TO BE 3000K UNLESS SPECIFIED OTHERWISE INICAL VENTILATION SYSTEM TO COMPLY WITH AS.1668.2 AND AS.3666 / NZS 1688.2 FOR AND AS 3666 / NZS 4303 - 1990 FOR FRESH AIR. ALL MECHANICAL AND FIRE SERVICES TO RE-DAY THE APPROPRIATE ATMICHANTER.

#### **REVISIONS**

#	Amendment:	Init:	Date:
Α	Issue for Council Approval	RM	09/04/24
В	Issue for Council Approval	RM	05/09/24

CLIENT:



ISSUE:


# FOR COUNCIL APPROVAL

# **CO-LOCATION** MANLY

15A & 17, THE CORSO, MANLY NSW 2095, Australia

DRAWING: **GENERAL NOTES** 

CAD FILE NAME: /Users/rachel/GG Dropbox/Projects/Active Projects/St Gerage/ Manly - WES203498D/2. Design/02_Model/01_ArchiCAD/COLO_Manly_LD(Rev. E]_240902_RM.pln							
Date:	5/9/2024	Drawn:	RM				
Scale:		Size:	АЗ				
GG Project:	WES203498D	Rev by:	-				
Sheet:	0.2	Rev:	Α				

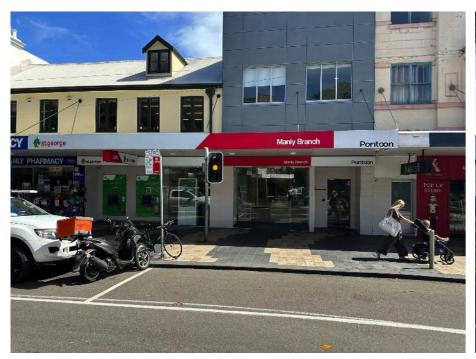











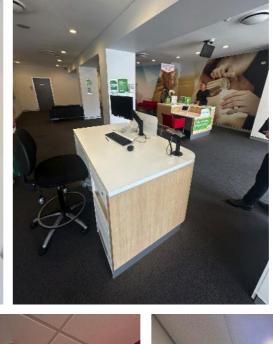






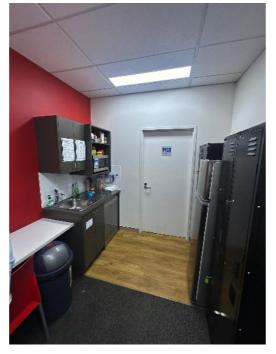



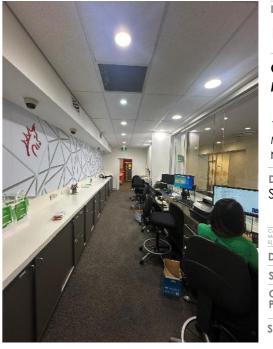



rww.greatergroup.com.a nfo@areatergroup.com.a

INTELLECTUAL PROPERTY AND COPYRIGHT:

- COPYRIGHT IN ALL THE CONCEPTS PRODUCED BY GREATER GROUP PTY LID (FORMERLY ANGLE'
ARROWSMITH PTY LID), INCLUDING DOCUMENTS, DRAWINGS, DESIGN, SPECIFICATION, IDEAS ETC WILL
REMAIN THE PROPERTY OF GREATER GROUP PTY LID. THERE MAY BE NO ERPRODUCTION OR COPYNIC

GENERAL AND CONSTRUCTION NOTES:

CONTRACTORS ARE TO VERIFY ALL DIMENSIONS AND LEVELS ON SITE PRIOR TO COMMENCING AS

IGURED DIMENSIONS TAKE PRECENDENCE OVER SCALED DIMENSIONS.
ALL MATERIALS, FINISHES AND BUILDING WORKS MUST BE AS SPECIFIED. REFER TO SEPA

AND ITCLOR TRUINGS PROVINCES FOR LIBERIALS, ANY AND ITCLOR TRUINGS IN A FAPROVED IN WINING B GREATER GROUP.

GLAZING TO BE IN ACCORDANCE WITH AS 1288-1994 & TABLE 12 OF THE BUILDING CODE C AUSTRALIA/M22 222. ALL EDGES TO BE ARISSED AND ALL EXPOSE EDGES POLISHED WITH A RADII OF AT LEAST SAMPLINESS OTHERWISE SPECIFIED.

AND TO BEAST TO BE REPORTED TO A WATER MAIN IS UPPLIED FOR THE PROVINCE OF A UNITED WATER AND AND ASSISTANCES.

WET AREAS TO BE IMPERVIOUS TO WATER, WALL SURFACES SEHIND ANY BASIN, SINK ETC OF A WAI
TO A HEIGHT OF SOMMA ASOVE THE FIXTURE. WATERPROOFING TO WET AREAS TO COMPLY WITH A
3740/ES OF THE NEW ZEALAND BUILDING CODE.
 ALL DOORWAYS TO HAVE A BUILDING STRUCTED HEIGHT OF 2.1M. THE MINIMUM WIDTH OF NEW
DOORWAYS NOT TO BE LESS THAN 850MM.

DODEWINS NOT TO SE LESS THAN 850MM.

ALL EDIT DODEN AND DODEN IN THE PATH OF TRAVEL TO EXITS ARE TO SE CAPABLE OF SEING OPENE
AT ALL TIMES FROM THE SIDE FACING A PERSON SESSING EGRESS FROM THE SULLDING WITH A SINGLE
AT ALL TIMES FROM THE SIDE FACING A CITION ON A SINGLE DEVICE WITHOUT THE USE OF A KEY AN
LOCASED SETWICEN FROM AND TO EXCEND A CITION ON A SINGLE DEVICE WITHOUT THE USE OF A KEY AN
LOCASED SETWICEN FROM AND TO EXCEND A CITION OF THE OWNER OWNER OF THE OWNER O

LOCALES SERVIEWS YOUNG AND TAXON ASCIVE FLOW LEVEL IN ACCORDANCE WHIT CLAUSE LY.

DIT SIGNS AND EMBRIGHCH LIGHTS TO COMPITY WITH AND SEZES 2003. ARTHRICAL USHTHEN
ACCORDANCE WITH AS 1880 - 1998 / PART 16.

CETTINGHISTERS IN ACCORDANCE WITH ASSAULT AND CLAUSE ELS OF THE BUILDING CODE
TO CHRISTOPHER AND THE SEZES AND THE SEZ

ECIFICATION C1.10 + C1.100 of THE BUILDING CODE OF AUSTRALLA/RELEVANT CODES OF THE ALAND BUILDING CHOIGH TO COMPRY WITHIN 43.2003-AUNTOL 71/82.300. ALL LIGHTING RETU-CLE FITTINGS TO BE C1.10X APPROVED. LOW YOLFAGE LIGHTS MUST USE APPROVED ELECTRIC AMSTORMARS
LILLIMPATIED SIGNAGE WIRING TO COMPRY AUSTRALIAN STANDARDS AND LOCAL AUTHO-DOSE, 200 VOLTS.

TRACTS AND AS 3666 / NZS 4303 - 1990 FOR FRESH AIR, ALL MECHANICAL AND FIRE SERVICES T PPROVED BY THE APPROPRAITE AUTHORITY. STRUCTURAL PROVISIONS TO COMPLY WITH CLAUSE B1.2 OF BUILDING CODE OF AUSTRALIA / B IE NEW ZEALAND BUILDING CODE.

# **REVISIONS**

#	Amendment:	Init:	Date:
Α	Issue for Council Approval	RM	09/04/24
В	Issue for Council Approval	RM	05/09/24

CLIENT:



ISSUE

# FOR COUNCIL APPROVAL


# CO-LOCATION MANLY

15A & 17, THE CORSO, MANLY, NSW 2095, Australia

DRAWING: SITE PHOTOS

AD FILE NAME: /Users/rachel/GG Dropbox/Projects/Active Projects/\$1 Gerog lanly - WES203498D/2. Design/02\_Model/01\_ArchiCAD/COLO\_Manly\_LD(Rev J\_240902\_RM.pln

E]_240902_RM.plr	1		
Date:	5/9/2024	Drawn:	RM
Scale:		Size:	А3
GG Project:	WES203498D	Rev by:	-
Sheet:	1 1	Rev:	Δ

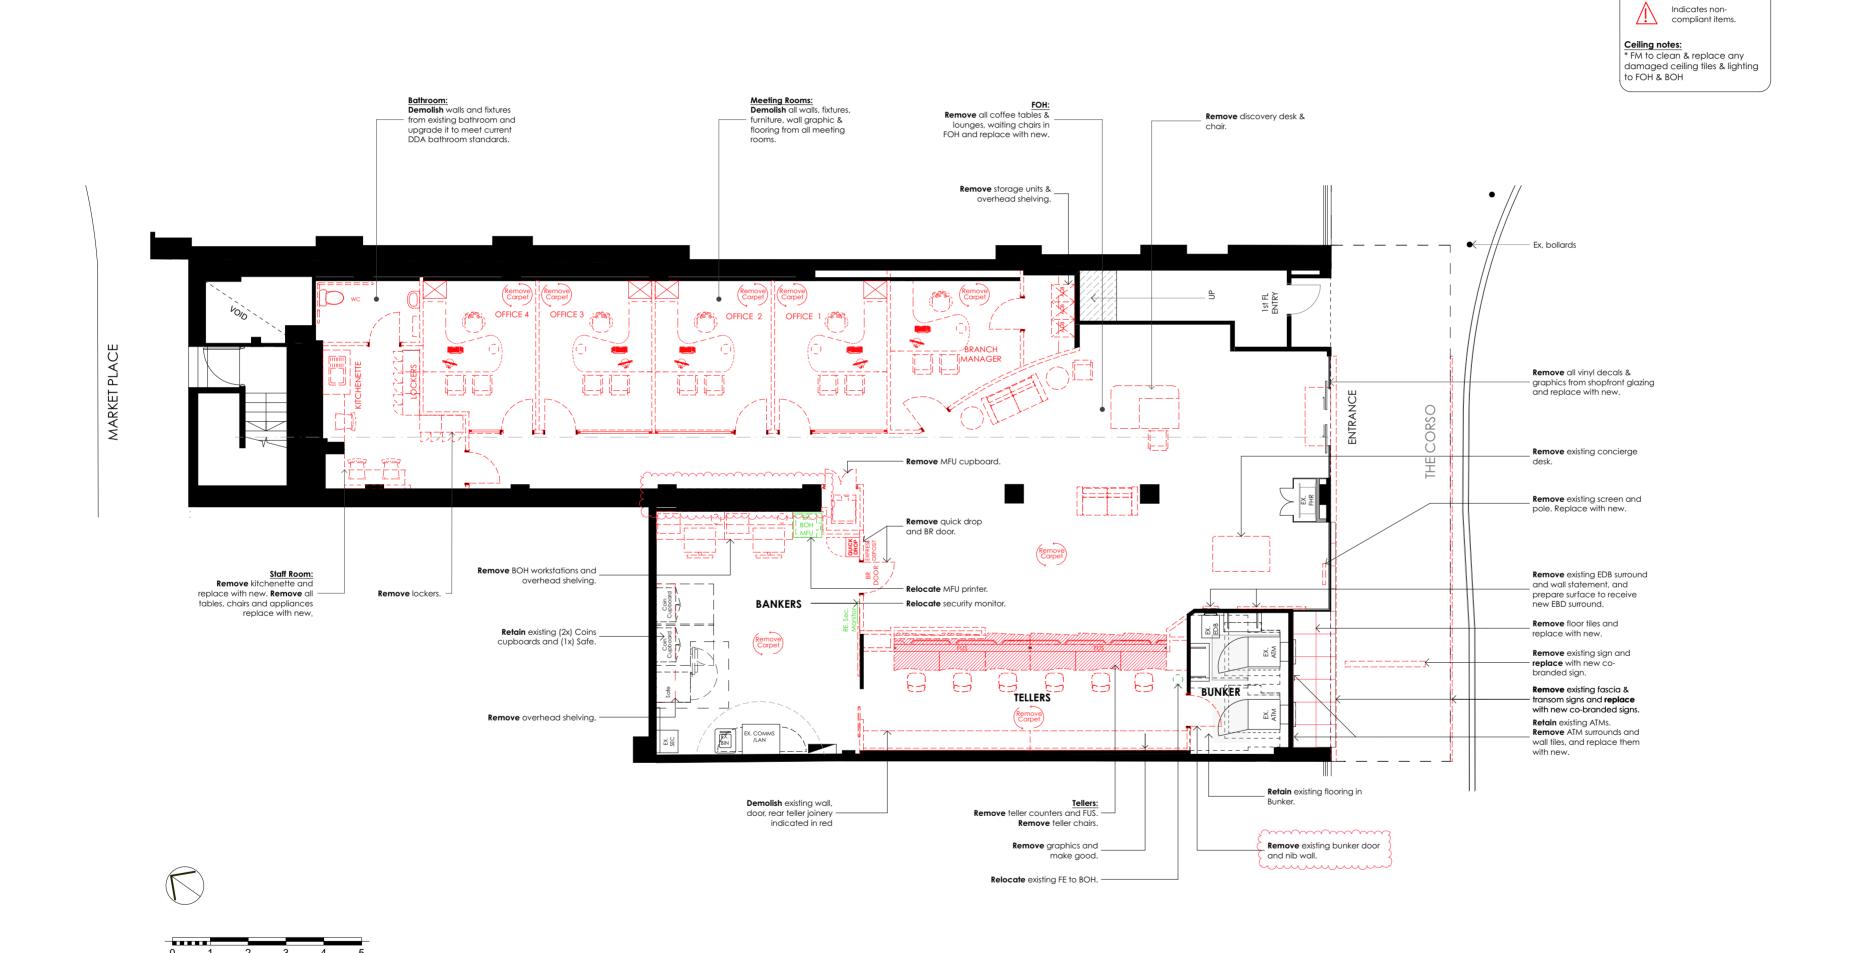

01 EXISTING/DEMO PLAN

1:100



NOTE: Floor plan is as per as built file only.

Subject to site measurement / validation on site prior to any work

LEGEND

Existing walls

Existing Columns Existing framed shop front glazing Existing items to be

To be removed/ 

# **REVISIONS**

#	Amendment:	Init:	Date:
Α	Issue for Council Approval	RM	09/04/24
Α	Issue for Council Approval	RM	05/09/24






# **CO-LOCATION** MANLY

15A & 17, THE CORSO, MANLY, NSW 2095, Australia

DRAWING:

EXISTING / DEMOLITION PLAN (A2)

Date:	5/9/2024	Drawn:	RM
Scale:		Size:	A2
GG Project	: WES203498D	Rev by:	-
Sheet:	1 2	Rev:	R

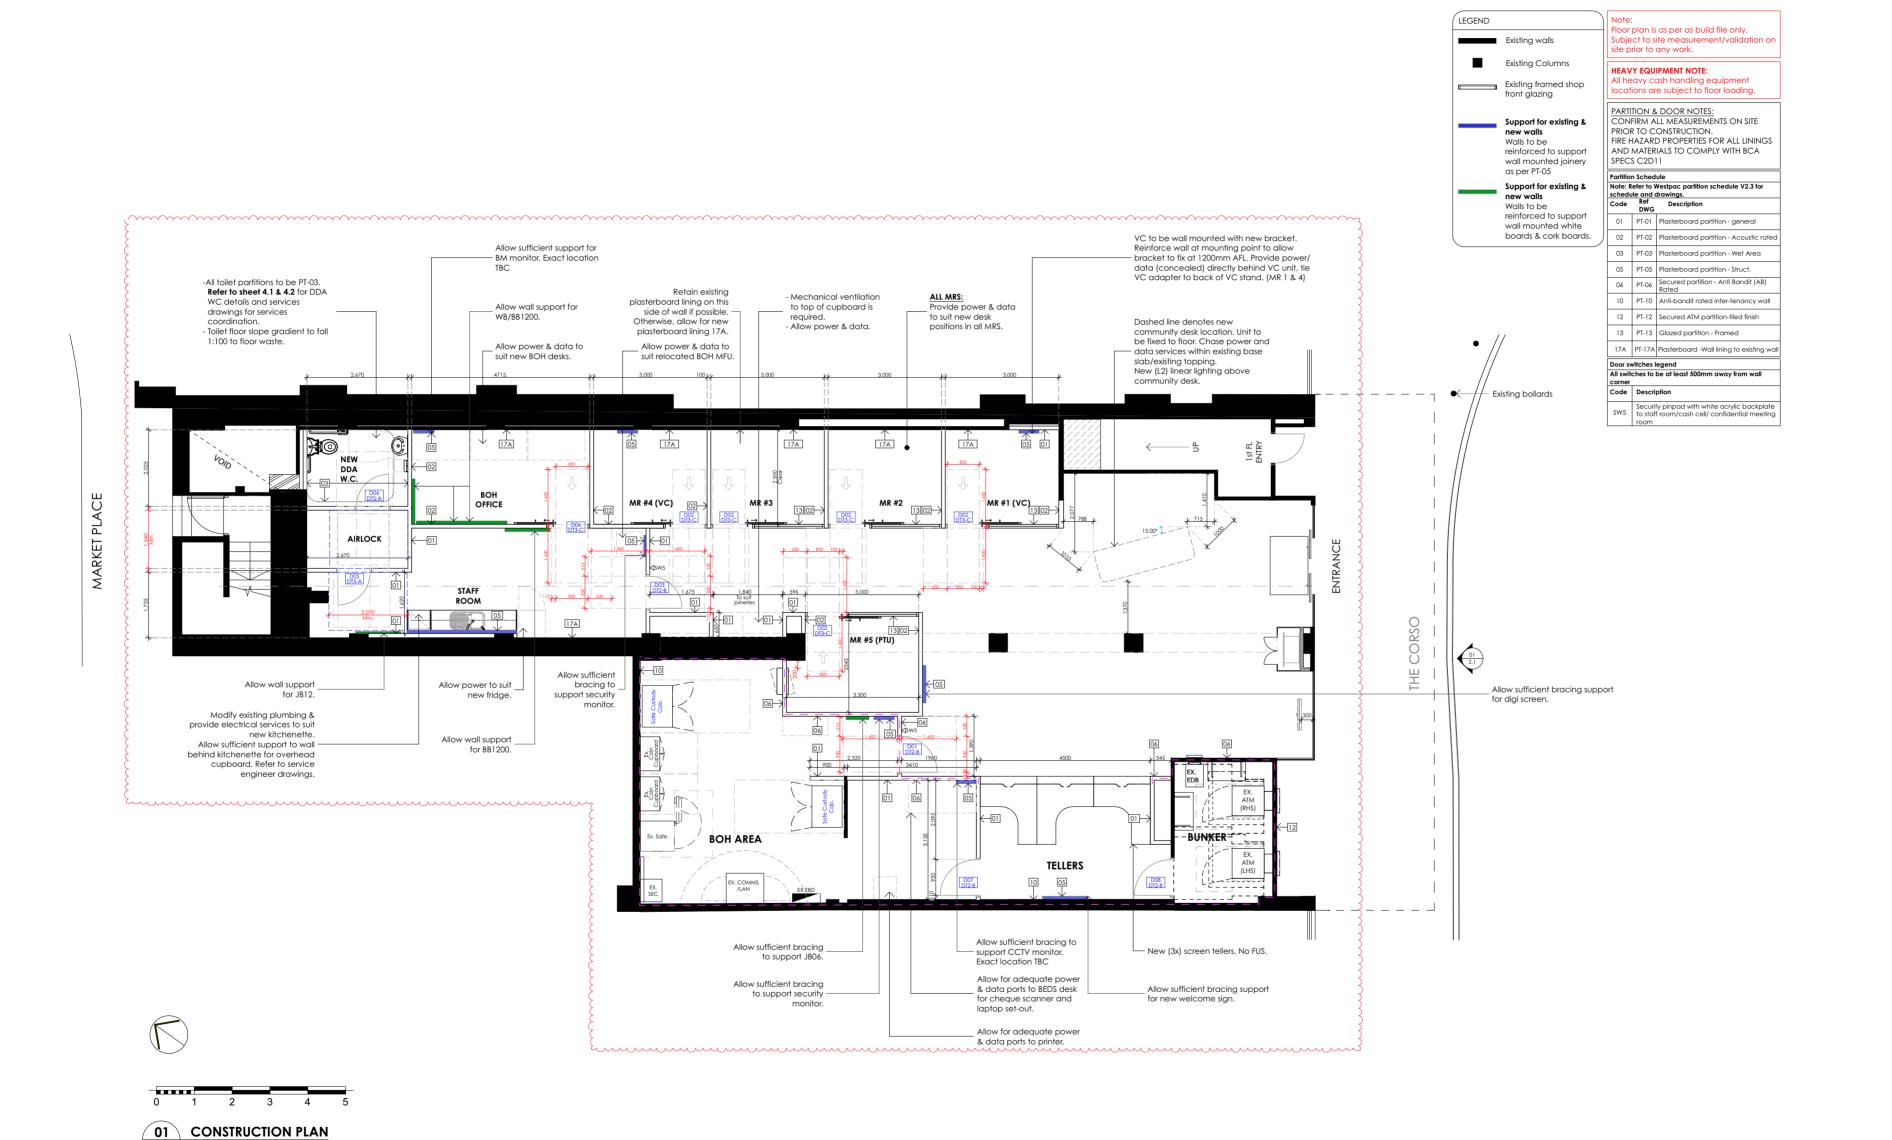

1:100



CORRECT AND CONSIDERATION ROTES.

CORRECT AND CONSIDERATE OF CREW ALL DIMENSIONS AND LEVELS ON SITE PRIOR TO COMMENCING ANY WORKS.

- RIGHED DIMENSIONS TARE PRECENDENCE OVER SCALED DIMENSIONS.

- RIGHED DIMENSIONS THE PRECENDENCE OVER SCALED DIMENSIONS.

- RIGHED DIMENSIONS AND REPORT OF THE PROPERTY OF THE PROPERTY

# **REVISIONS**

#	Amendment:	Init:	Date:
Α	Issue for Council Approval	RM	09/04/24
Α	Issue for Council Approval	RM	05/09/24





ISSUE:

# FOR COUNCIL APPROVAL


# CO-LOCATION MANLY

15A & 17, THE CORSO, MANLY, NSW 2095, Australia

DRAWING: CONSTRUCTION PLAN (A2)

Date:	5/9/2024	Drawn:	RM
Scale:		Size:	A2
GG Project	: WES203498D	Rev by:	-
Sheet:	1.3	Rev:	В



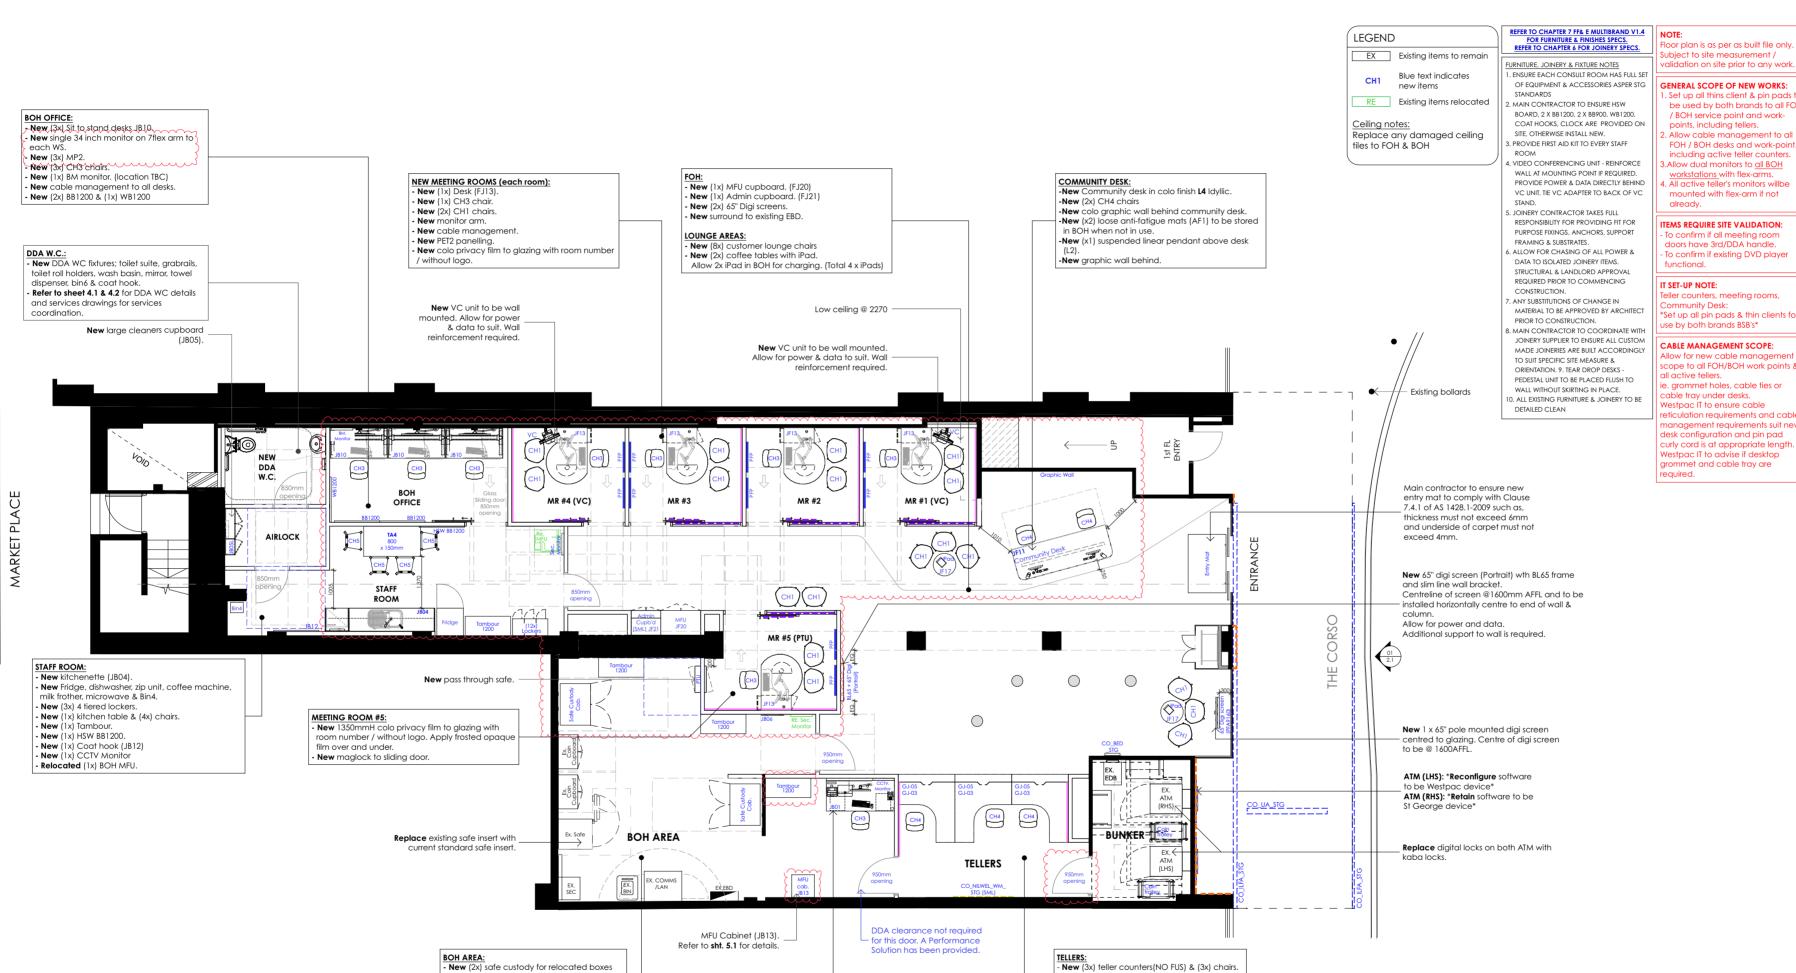

**Relocated** laptops and cheque

scanners from partner brand to

BEDs desk. Allow for power &

Data to suit.

- Refurbished (3x) Bosco units. All units to be

- Front panel to be in **L4** (Idyllic)
- Staff side joinery & footrest to be **L1** (Laminex

welcome wall centred on wall behind tellers.

- **New** (1x) non-illuminated small internal

Polar white)

from-partner-brand.....

JOINERY & FURNITURE PLAN

1:100

Relocated security monitor.
New (1x) MFU(600x600mm) on plinth.

- New (1x) BEDs desk (JB01)+ (1x) CH3 chair.

New (3x) 1200 Tambours
 New (1x) custom courier hooks. Allow for 4 hooks in total. (JB06).

Floor plan is as per as built file only. llidation on site prior to any work

# . Set up all thins client & pin pads to be used by both brands to all FOH

- FOH / BOH desks and work-point, including active teller counters. 3.Allow dual monitors to all BOH workstations with flex-arms.

  All active teller's monitors willbe mounted with flex-arm if not
- ITEMS REQUIRE SITE VALIDATION: o confirm if all meeting room loors have 3rd/DDA handle. confirm if existing DVD player

# IT SET-UP NOTE: er counters, meeting rooms Community Desk: Set up all pin pads & thin clients for

# CABLE MANAGEMENT SCOPE: Allow for new cable managemen ope to all FOH/BOH work points & Il active tellers. grommet holes, cable ties or cable tray under desks. Westpac IT to ensure cable reticulation requirements and cable management requirements suit new desk configuration and pin pad

SPEATER GROUP.

GLAZING TO BE IN ACCORDANCE WITH AS 1288-1994 & TABLE J2 OF THE BUILDING CODE OF USTRALIANTS 4223. ALL EDGES TO BE ARRSSED AND ALL EXPOSED EDGES POUSHED WITH A RADIUS. USISRALIANTS 4223. ALL EDGES TO BE ARRISED APID ALL EXTURE DESCRIPTION OF THE LEAST SAME MURES OTHERWISE SPECIFIED.

WET AREAS TO BE IMPERVIOUS TO WATER. WALL SURFACES BEHIND ANY BASIN, SINK ETC OF A WALL TO A HEIGHT OF SOOMM ABOVE HE FIXTURE. WASERPROOFING TO WET AREAS TO COMPLY WITH AS. STADIES OF THE NEW ZEALAND BUILDING CODE.

"A TOPOROWAY OF TAMES A NAMID MODISTRICTED HEIGHT OF 2.1M. THE MINIMUM WIDTH OF NEW 3740ES OF THE NEW TRAILAND BUILDING CODE.

ALL DOORWING TO HAVE A MIRBUR HOSTISTICTED HEIGHT OF 2.1M. THE INFIMMUM WIDTH OF NEW ALL DOORWING TO HAVE A NUMBER HOSTISTICTED HEIGHT OF 2.1M. THE INFIMMUM WIDTH OF NEW ALL DOOR HAVE AND DOOR HAVE THE CHARLES OF THE CONTROL ON THE CONTROL OF THE CONTROL ON THE CONTROL OF THE CONTROL ON THE CONTROL OF THE CONTROL ON THE CONTROL ON THE CO

# **REVISIONS**

#	Amendment:	Init	Date:
11	Amenamem.	111111.	Dale.
Α	Issue for Council Approval	RM	09/04/2
Α	Issue for Council Approval	RM	05/09/2
CLI	ENT:		





ISSUE:

# FOR COUNCIL APPROVAL

# CO-LOCATION MANLY

15A & 17, THE CORSO, MANLY, NSW 2095, Australia

DRAWING:

PROPOSED FLOOR PLAN (A2)

Date:	5/9/2024	Drawn:	RM
Scale:		Size:	A2
GG Project	: WES203498D	Rev by:	-
Sheet:	1.4	Rev:	B



# greater group

**DESCRIPTIONS** for both signage 1

SCHEDULE OF PROPOSED SIGNAGE SIGNAGE NAME

CO\_NILFA\_STG

CO\_ILFA\_STG

CO\_UA\_STG

**BUSINESS IDENTIFICATION SIGNS** 

Internal framework clad with Alpolic NC in both Anthracite and White joins should cut through logos. All graphics are face applied digital prints with satin laminate.

AREA

6.65 m<sup>2</sup>

0.95 m<sup>2</sup>

DIMENSIONS

1000mm(w) x 600mm(h) x 50mm(d)

1000mm(w) x 400mm(h) x 50mm(d)

2400mm(w) x 400mm(h) x 160mm(d)

#### DESCRIPTIONS for both signage 2

Internal framework clad with Alpolic NC in both Anthracite and White

**Westpac:** 25mm profile cut opal acrylic with face applied red translucent vinyl, with graphics sitting proud of cladded face by 21mm. The sides of the WBC acrylic graphics will be painted metallic silver and only the front of the logo will illuminate.

**St George:** 25mm profile cut opal acrylic with face applied translucent digital print with satin laminate, with graphics sitting proud of cladded face by 21mm. The sides of the STG acrylic graphics will remain as opal acrylic and will cast a slight halo illumination onto the sign backing Internal LED light tray behind both sets of graphics.

#### **DESCRIPTIONS** for signage 3

Internal framework clad with White Alpolic NC with grey section be masked & painted. Westpac: Cut and rebate 4.5 acrylic backing opal to push 5mm Westpac red acrylic for

St George: 6mm profile cut opal acrylic with face applied translucent digital print with satin laminate, with graphics sitting proud of cladded face by 2mm. The sides of the STG acrylic graphics will remain as opal acrylic and will cast a slight halo illumination onto the sign backing. Internal LED light tray behind both sets of graphics.


# **EXISTING SHOPFRONT PHOTOS**

RETAIN EXISTING ATM.

COLO SURROUNDS.

REMOVE ATM SURROUNDS

AND REPLACE WITH NEW

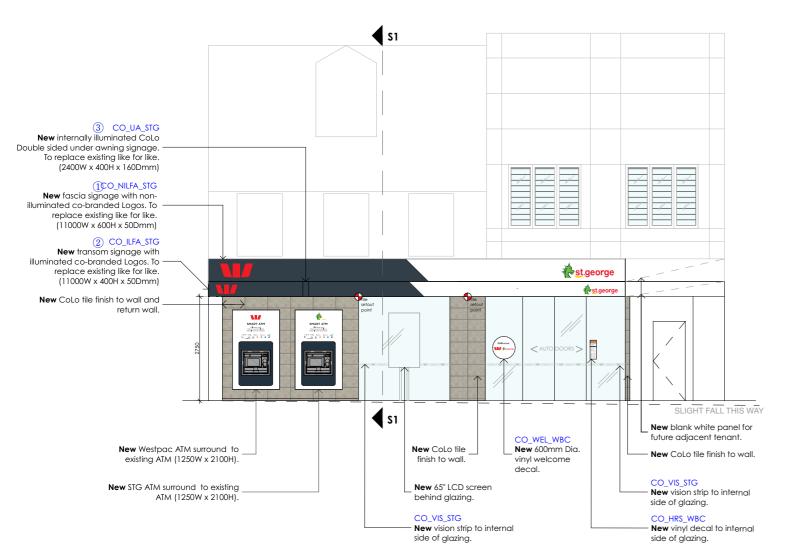

1 CO\_NILFA\_STG New fascia signage with non-illuminated co-branded Logos. To replace existing like for like (11000W x 600H x 50Dmm) (3) CO\_UA\_STG v internally illuminated CoLo Double sided under awning signage. To replace existing like for like. (2400W x 400H x 160Dmm) 2 CO\_ILFA\_STG New transom signage with illuminated co-branded Loaos. To replace existing like for like (11000W x 400H x 50Dmm)

> 02 PROPOSED SECTION 01 1:100 @A3

R GROUP.

NO TO BE IN ACCORDANCE WITH AL 1288-1994 & TABLE J2 OF THE BRIEDING CODE OF NO TO BE IN A COORDING WITH ALL 1288-1994 & TABLE J2 OF THE BRIEDING CODE OF ORDING WITH A SHOULD AND THE ALL 1288-10 BE INFORMATION TO WARRE WITH ALL SHOULD AND THE ALL SHOU

A JIONANIC MORE DESCRIBED TO BE SOON UNESS SECTION OF STANDARD SUDDAY AUTOMATIC STANDARD CODE OF THE NUMBER STANDARD COMEY AUTOMATIC MORE DESCRIBED AND CODES OF THE NOW ZEAAND BUILDING CODE.

FIRST STANDARD CODES OF THE NEW ZEAAND SUDDAY CODE.

FIRST STANDARD PROPERTIES OF MATERIALS, LINKOS AND SUBPACE FIRSDES TO COMEY WITH ZEAAND BUILDING CODE.

FIRST STANDARD PROPERTIES OF MATERIALS, LINKOS AND SUBPACE FIRSDES TO COMEY WITH ZEAAND BUILDING CODE.

FIRST STANDARD CODE.

FIRST STA

ZAU VOLIS

COLOUR TEMPERATURE TO BE 3000K UNILESS SPECIFIED OTHERWISE

ANNICAL VENTILATION SYSTEM TO COMPLY WITH AS 1.1688.2 AND AS 3666 / NZS 1688.2 FOR TS AND AS 3666 / NZS 4030 - 1990 FOR FRESH AIR. ALL MECHANICAL AND FIRE SERVICES TO BE FEED BY THE APPROPARIAE AUTHORITY. . H CLAUSE B1.2 OF BUILDING CODE OF AUSTRALIA / B1 (

#### **REVISIONS**

#	Amendment:	Init:	Date:
Α	Issue for Council Approval	RM	09/04/2
В	Issue for Council Approval	RM	05/09/2

CLIENT:



ISSUE:

# FOR COUNCIL APPROVAL

# **CO-LOCATION MANLY**

15A & 17, THE CORSO, MANLY, NSW 2095, Australia

**DRAWING:** SHOPFRONT ELEVATIONS

Date: 5/9/2024 Drawn: RM Scale: Size: Rev by: -Project: WES203498D Sheet: Rev:

PROPOSED SHOPFRONT ELEVATION 1:100 @A3

DOOR SCHEDULE (REFER TO PAGE 1.5) FOR DOOR LOCATIONS): REFER TO WESTPAC BANKNOW DESIGN V2.3 CHAPTER 5 FOR DOOR TYPES MARTER SCHEDULE AND GENERAL NOTES FOR DOOR HARDWARE, FINISH, ACCESSORIES, SIGNAGE, UNLESS OTHERWISE NOTED BELOW. REFER TO WESTPAC BANKNOW DESIGN STANDARD V2.3-5.2 KEYING SCHEDULE FOR DETAILS OF KEYING REQUIREMENTS AND QUANTITIES TO ENTRY/SECURITY DOORS AND JOINERY.

DOOR NO.	DOOR CODE	DOOR TYPE/ LOCATION	FRAME FINISH	HANDLE	LOCK	DOOR VIEWER	DOOR CLOSER	LEAF WIDTH	LEAF HEIGHT	NOTES
D01	DT2B	BOH Area	Natural anodise aluminium frame.	Madinoz MDZ-L75T. Install at height 1050mm AFFL to C/L	Require pin-pad with integrated shroud and manual door lock key override.	Ultra Vision 56M1232 door viewer. Natural anodised aluminium: 132 degree wide angle view range. Install at 1500mmAFFL to centre. Subject to security brief.	'CL3'- Dorma TS93 to be installed on the 'push' side.	1000mm	2400mm	Solidcore outward opening swing door, refer to DWG DT2-B for specs and information. 950mm minimum clear opening to allow equipment (safes) access. Install angle door viewer, electric strike and keypad to Westpac Security brief requirements. Ensure key operable from public side in the event of power failure. Door stop: Madinoz MDZ-DS102. Provide BDS Blocker Plate 09351188 170x50x2mm SS Fire Rated to suit PADDE ES200 ES2000. Ensure to install staff only signage to public side of door. Refer to Chapter 11 signage standard PAN_STAFF, 50mm high "STAFF ONLY" self adhesive individual vinyl letterings
D02	DT3-C	Meeting room Glass Sliding Door	Natural anodise aluminium frame.	Barben BAH-167/DDA pull handles. Handle to be fixed to aluminium framed glass sliding door.	N/A	N/A	N/A	1100mm	2400mm	Meeting room framed glass sliding door with offset sliding door handles. Internal 3rd handle set back 530mm from partition wall. Refer to Bank now DWG ST3-C for details and further info. Meeting room graphic privacy film supplied & coordinated by Westpac RMM. Note: this door had 3 x handles - Barben BAH - 167/DDA. COS for door handle length. Min. 850mm clear door opening as per AS1428.1.
D03	DT2B	FOH & Staff Room	Natural anodise aluminium frame.	Madinoz MDZ-L75T. Install at height 1050mm AFFL to C/L	Require pin-pad with integrated shroud and manual door lock key override.	Ultra Vision 56M1232 door viewer. Natural anodised aluminium: 132 degree wide angle view range. Install at 1500mmAFFL to centre. Subject to security brief.	'CL3'- Dorma TS93 to be installed on the 'push' side.	920mm	2400mm	Solidcore outward opening swing door, refer to DWG DT2-B for specs and information. 950mm minimum clear opening to allow equipment (safes) access. Install angle door viewer, electric strike and keypad to Westpac Security brief requirements. Ensure key operable from public side in the event of power failure. Door stop: Madinox MDZ-DS102. Provide BDS Blocker Plate 09351188 170x50x2mm SS Fire Rated to suit PADDE ES200 ES2000. Ensure to install staff only signage to public side of door. Refer to Chapter 11 signage standard PAN_STAFF, 50mm high "STAFF ONLY" self adhesive individual vinyl letterings
D04	DT3-C	BOH Office Glass Sliding Door	Natural anodise aluminium frame.	Barben BAH-167/DDA pull handles. Handle to be fixed to aluminium framed glass sliding door.	N/A	N/A	N/A	1100mm	2400mm	Meeting room framed glass sliding door with offset sliding door handles. Internal 3rd handle set back 530mm from partition wall. Refer to Bank now DWG ST3-C for details and further info. Meeting room graphic privacy film supplied & coordinated by Westpac RMM. Note: this door had 3 x handles - Barben BAH - 167/DDA. COS for door handle length. Min. 850mm clear door opening as per AS1428.1.
D05	DT5-A	Toilet Airlock	Natural anodise aluminium frame, brush seals	Madinoz MDZ-L75T pair. Install at height 1050mm AFFL to C/L	N/A	N/A	'CL4'- Dorma TS93 1-5 to be installed on the 'toilet' side.	920mm	2400mm	Solidcore inward opening swing door, refer to DWG DTS-A for details. Min. clear door opening 850mm. Ensure adequate hand clearance to door handle at open and closed positions to comply with AS1428.1-2009. Install signage to comply with AS1428.1-2009. Door stop: Madinoz MDZ-DS102. Lift-off hinges. 10mm gap under door leaf
D06	DT5-A	Accessible (DDA) toilet	Natural anodise aluminium frame, brush seals	Madinoz MDZ-L75T pair. Install at height 1050mm AFFL to C/L	N/A	N/A	'CL4'- Dorma TS93 1-5 to be installed on the 'toilet' side.	920mm	2400mm	Solidcore inward opening swing door, refer to DWG DT5-A for details. Min. clear door opening 850mm. Ensure adequate hand clearance to door handle at open and closed positions to comply with AS1428.1-2009. Install signage to comply with AS1428.1-2009. Door stop: Madinoz MDZ-DS102. Lift-off hinges. 10mm gap under door leaf
D07	DT2B	Teller & BOH Area	Natural anodise aluminium frame.	Madinoz MDZ-L75T. Install at height 1050mm AFFL to C/L	N/A	Ultra Vision 56M1232 door viewer. Natural anodised aluminium: 132 degree wide angle view range. Install at 1500mmAFFL to centre. Subject to security brief.	'CL3'- Dorma TS93 to be installed on the 'push' side.	1000mm	2400mm	Solidcore outward opening swing door, refer to DWG DT2-B for specs and information. 950mm minimum clear opening to allow equipment (safes) access. Install angle door viewer, electric strike and keypad to Westpac Security brief requirements, Ensure key operable from public side in the event of power failure. Door stop: Madinoz MDZ-DS102. Provide BDS Blocker Plate 09351188 170x50x2mm SS Fire Rated to suit PADDE ES200 ES2000. Ensure to install staff only signage to public side of door. Refer to Chapter 11 signage standard PAN_STAFF, 50mm high "STAFF ONLY" self adhesive individual vinyl letterings
D08	DT2B	Bunker	Natural anodise aluminium frame.	Madinoz MDZ-L75T. Install at height 1050mm AFFL to C/L	N/A	Ultra Vision 56M1232 door viewer. Natural anodised aluminium: 132 degree wide angle view range. Install at 1500mmAFFL to centre. Subject to security brief.	'CL3'- Dorma TS93 to be installed on the 'push' side.	1000mm	2400mm	Solidcore outward opening swing door, refer to DWG DT2-B for specs and information. 950mm minimum clear opening to allow equipment (safes) access. Install angle door viewer, electric strike and keypad to Westpac Security brief requirements. Ensure key operable from public side in the event of power failure. Door stop: Madinox MDZ-DS102. Provide BDS Blocker Plate 09351188 170x50x2mm SS Fire Rated to suit PADDE ES200 ES2000. Ensure to install staff only signage to public side of door. Refer to Chapter 11 signage standard PAN_STAFF, 50mm high "STAFF ONLY" self adhesive individual vinyl letterings



- OF ANY ASSET WHICH THE WITH PREMISSION OF GEREATE GROUP BY LID.

  GENERAL AND CONSTRUCTION NOTICE

  CONTRACTIONS OF WHICH THE WITH PREMISSION OF GEREATE GROUP BY LID.

  GENERAL AND CONSTRUCTION NOTICE

  CONTRACTIONS OF THE WITH PREMISSION OF GENERAL GROUP BY LID.

  FOR ANY ASSET OF THE SERVICE OF THE WITH PREMISSION OF GENERAL GROUP BY LID.

  FOR ANY ASSET OF THE SERVICE OF THE WITH PREMISSION OF THE SERVICE OF TH

# **REVISIONS**

#	Amendment:	Init:	Date:
Α	Issue for Council Approval	RM	09/04/24
В	Issue for Council Approval	RM	05/09/2

CLIENT:



ISSUE:

# FOR COUNCIL APPROVAL

# **CO-LOCATION** MANLY

15A & 17, THE CORSO, MANLY, NSW 2095, Australia

DRAWING: DOOR SCHEDULE

Date:	5/9/2024	Drawn:	RM
Scale:		Size:	АЗ
GG Project	: WES203498D	Rev by:	-
Sheet:	1.6	Rev:	_