


Ammended Section 96 Note: Changed pitching point lowered ridge and relocated ridge away from boundary. Reduced roof overhang to upper & lower floor gable roof on east side.

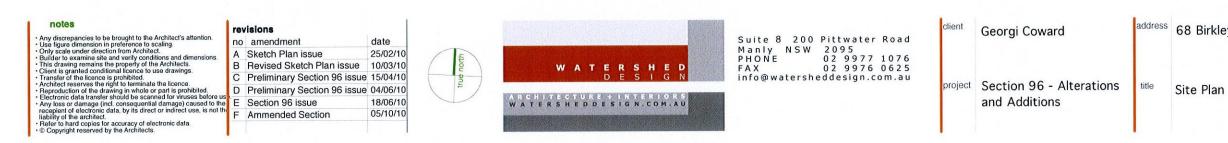

10 0 LAWSON PL

address 68 Birkley Rd, Manly job no 10008 drawing no title Site Plan checked mk scale 1:200 PA F