

# NAB Manly

## Development Application

Architect

PMDL


Sydney Level 17, 124 Walker Street North Sydney NSW 2060  
Phone +61 2 8458 5500 Email: sydney@pmdl.com.au

Melbourne Level 3, 479 St Kilda Road Melbourne Vic 3004  
Phone +61 3 9427 8885 Email: melbourne@pmdl.com.au


Hong Kong 20/F, Hollywood Centre, 233 Hollywood Road Sheung Wan Hong Kong  
Phone +852 2836 6992 Email: hongkong@pmdl.com.au

Andrew Pender 5317 / David Morris 5865 / Vicki van Dijk 9476

NAB Branch Location

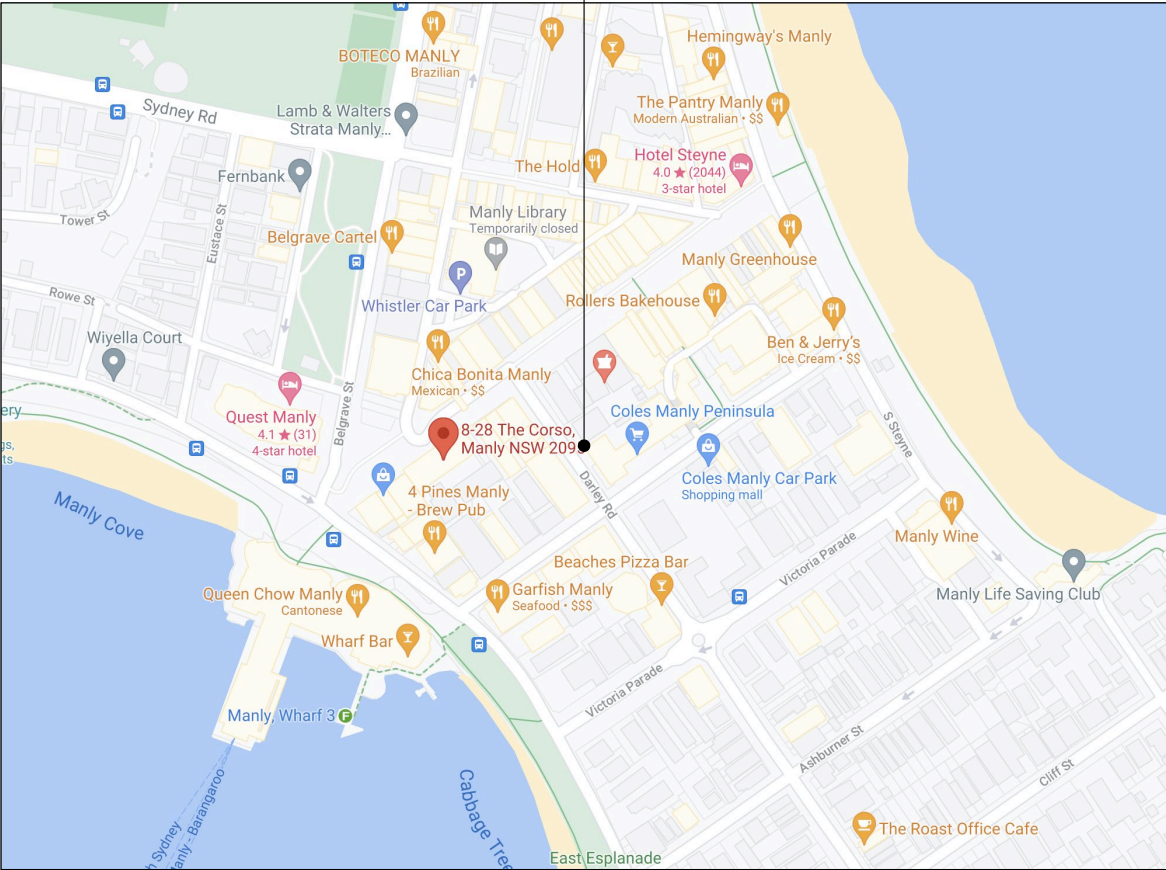

Extent of NAB Branch within the building shown in red.

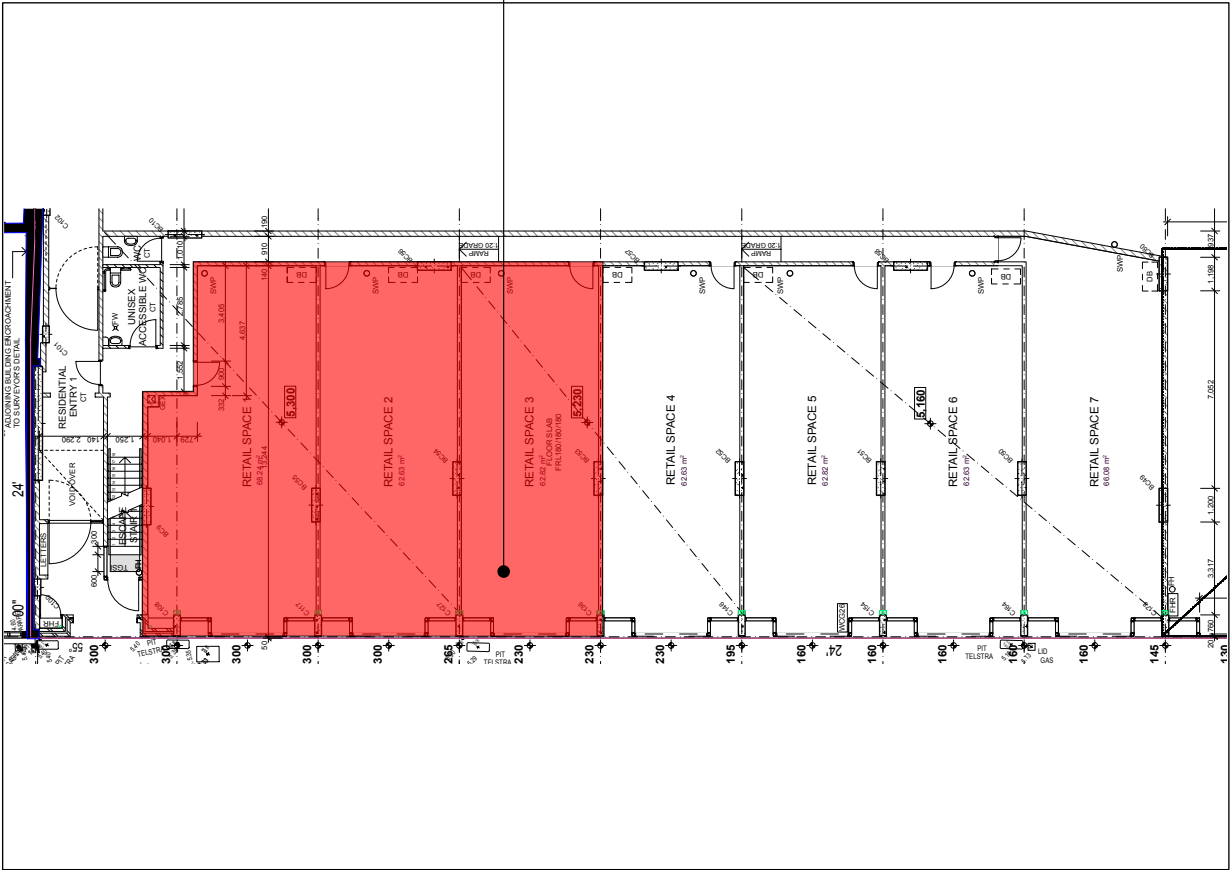

01 LOCATION MAP  
- NAB Manly

02 LOCATION PLAN  
- NAB Manly

### NAB MANLY

Existing tenancy: 8-28 The Corso,  
Manly NSW 2095

### DRAWING REGISTER

#### DA SET REVISION E 15.11.21

- DA000-D COVER PAGE
- DA001-A EXISTING SITE PHOTOS
- DA002-C DEMOLITION PLAN
- DA003-D PROPOSED PLAN
- DA004-B DEMOLITION ELEVATION
- DA005-D PROPOSED ELEVATION

### Cover Page

© PMDL

pmdl.com.au

Project

Scale

Date

Dwg

For Approval **PMDL** ARCHITECTURE  
INTERIORS  
MASTERPLANNING

### NAB Manly NSW

DA000 D








01 SITE PHOTO  
- Existing shopfront



02 SITE PHOTO  
- Existing Frontage & ATMs



03 SITE PHOTO  
- Existing Entry & Forex

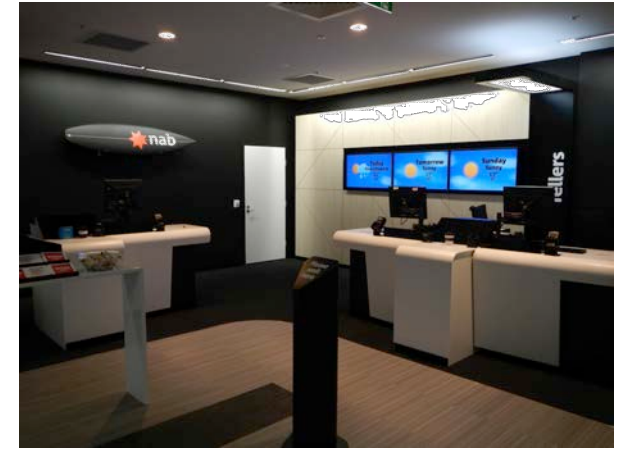


04 SITE PHOTO  
- Existing Tellers



05 SITE PHOTO  
- Existing FOH - Feature Ceiling




06 SITE PHOTO  
- Existing FOH from Tellers

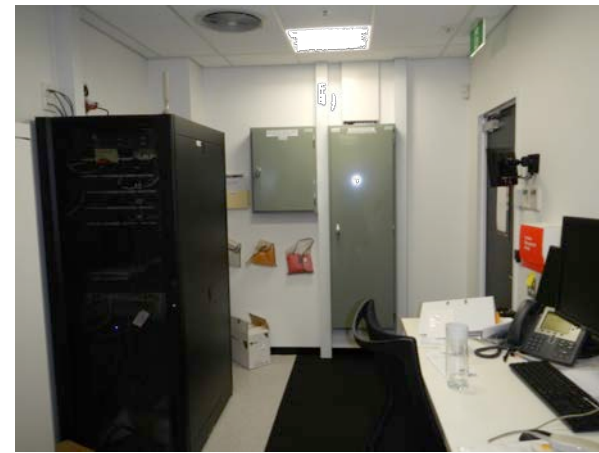

07 SITE PHOTO  
- Existing BOH -Comms & EDB




08 SITE PHOTO  
- Existing BOH

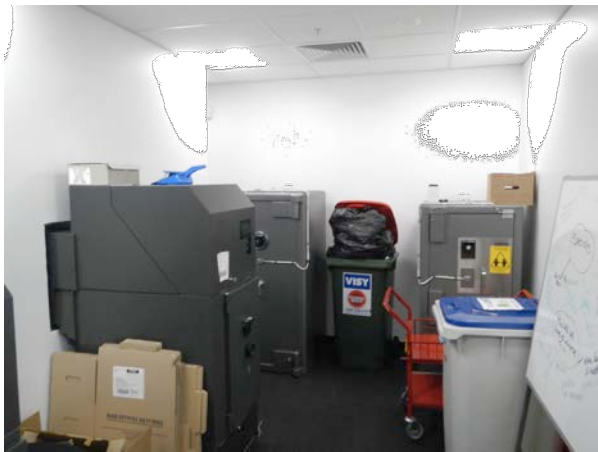


09 SITE PHOTO  
- Existing Bunker




10 SITE PHOTO  
- Existing BOH Kitchenette

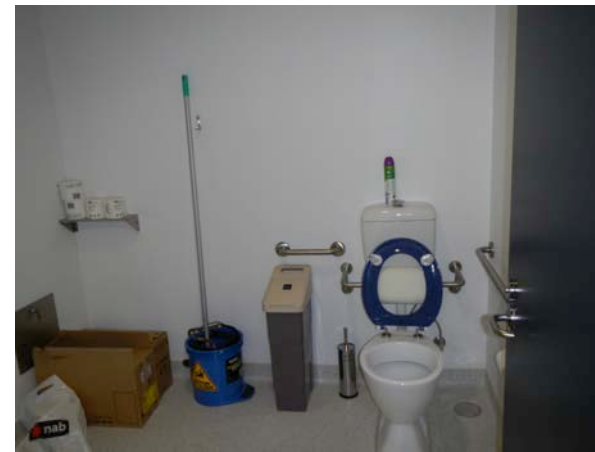

11 SITE PHOTO  
- Existing DDA WC

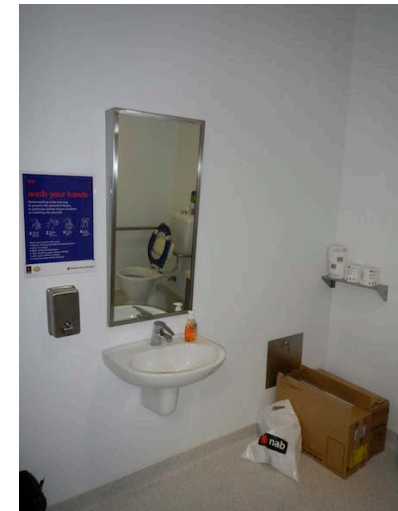


12 SITE PHOTO  
- Existing DDA WC

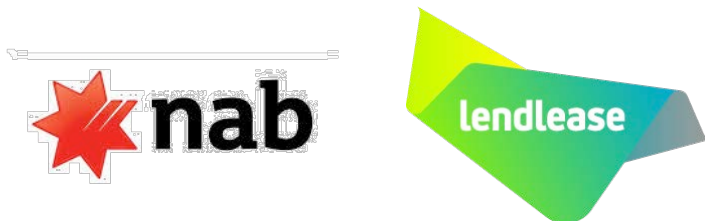

For Approval **PMDL** ARCHITECTURE  
INTERIORS  
MASTERPLANNING  
NAB Manly NSW

Existing site photos

© PMDL pmdl.com.au Project 2997 Scale NTS Date 19 Aug 2021 Dwg DA001 A

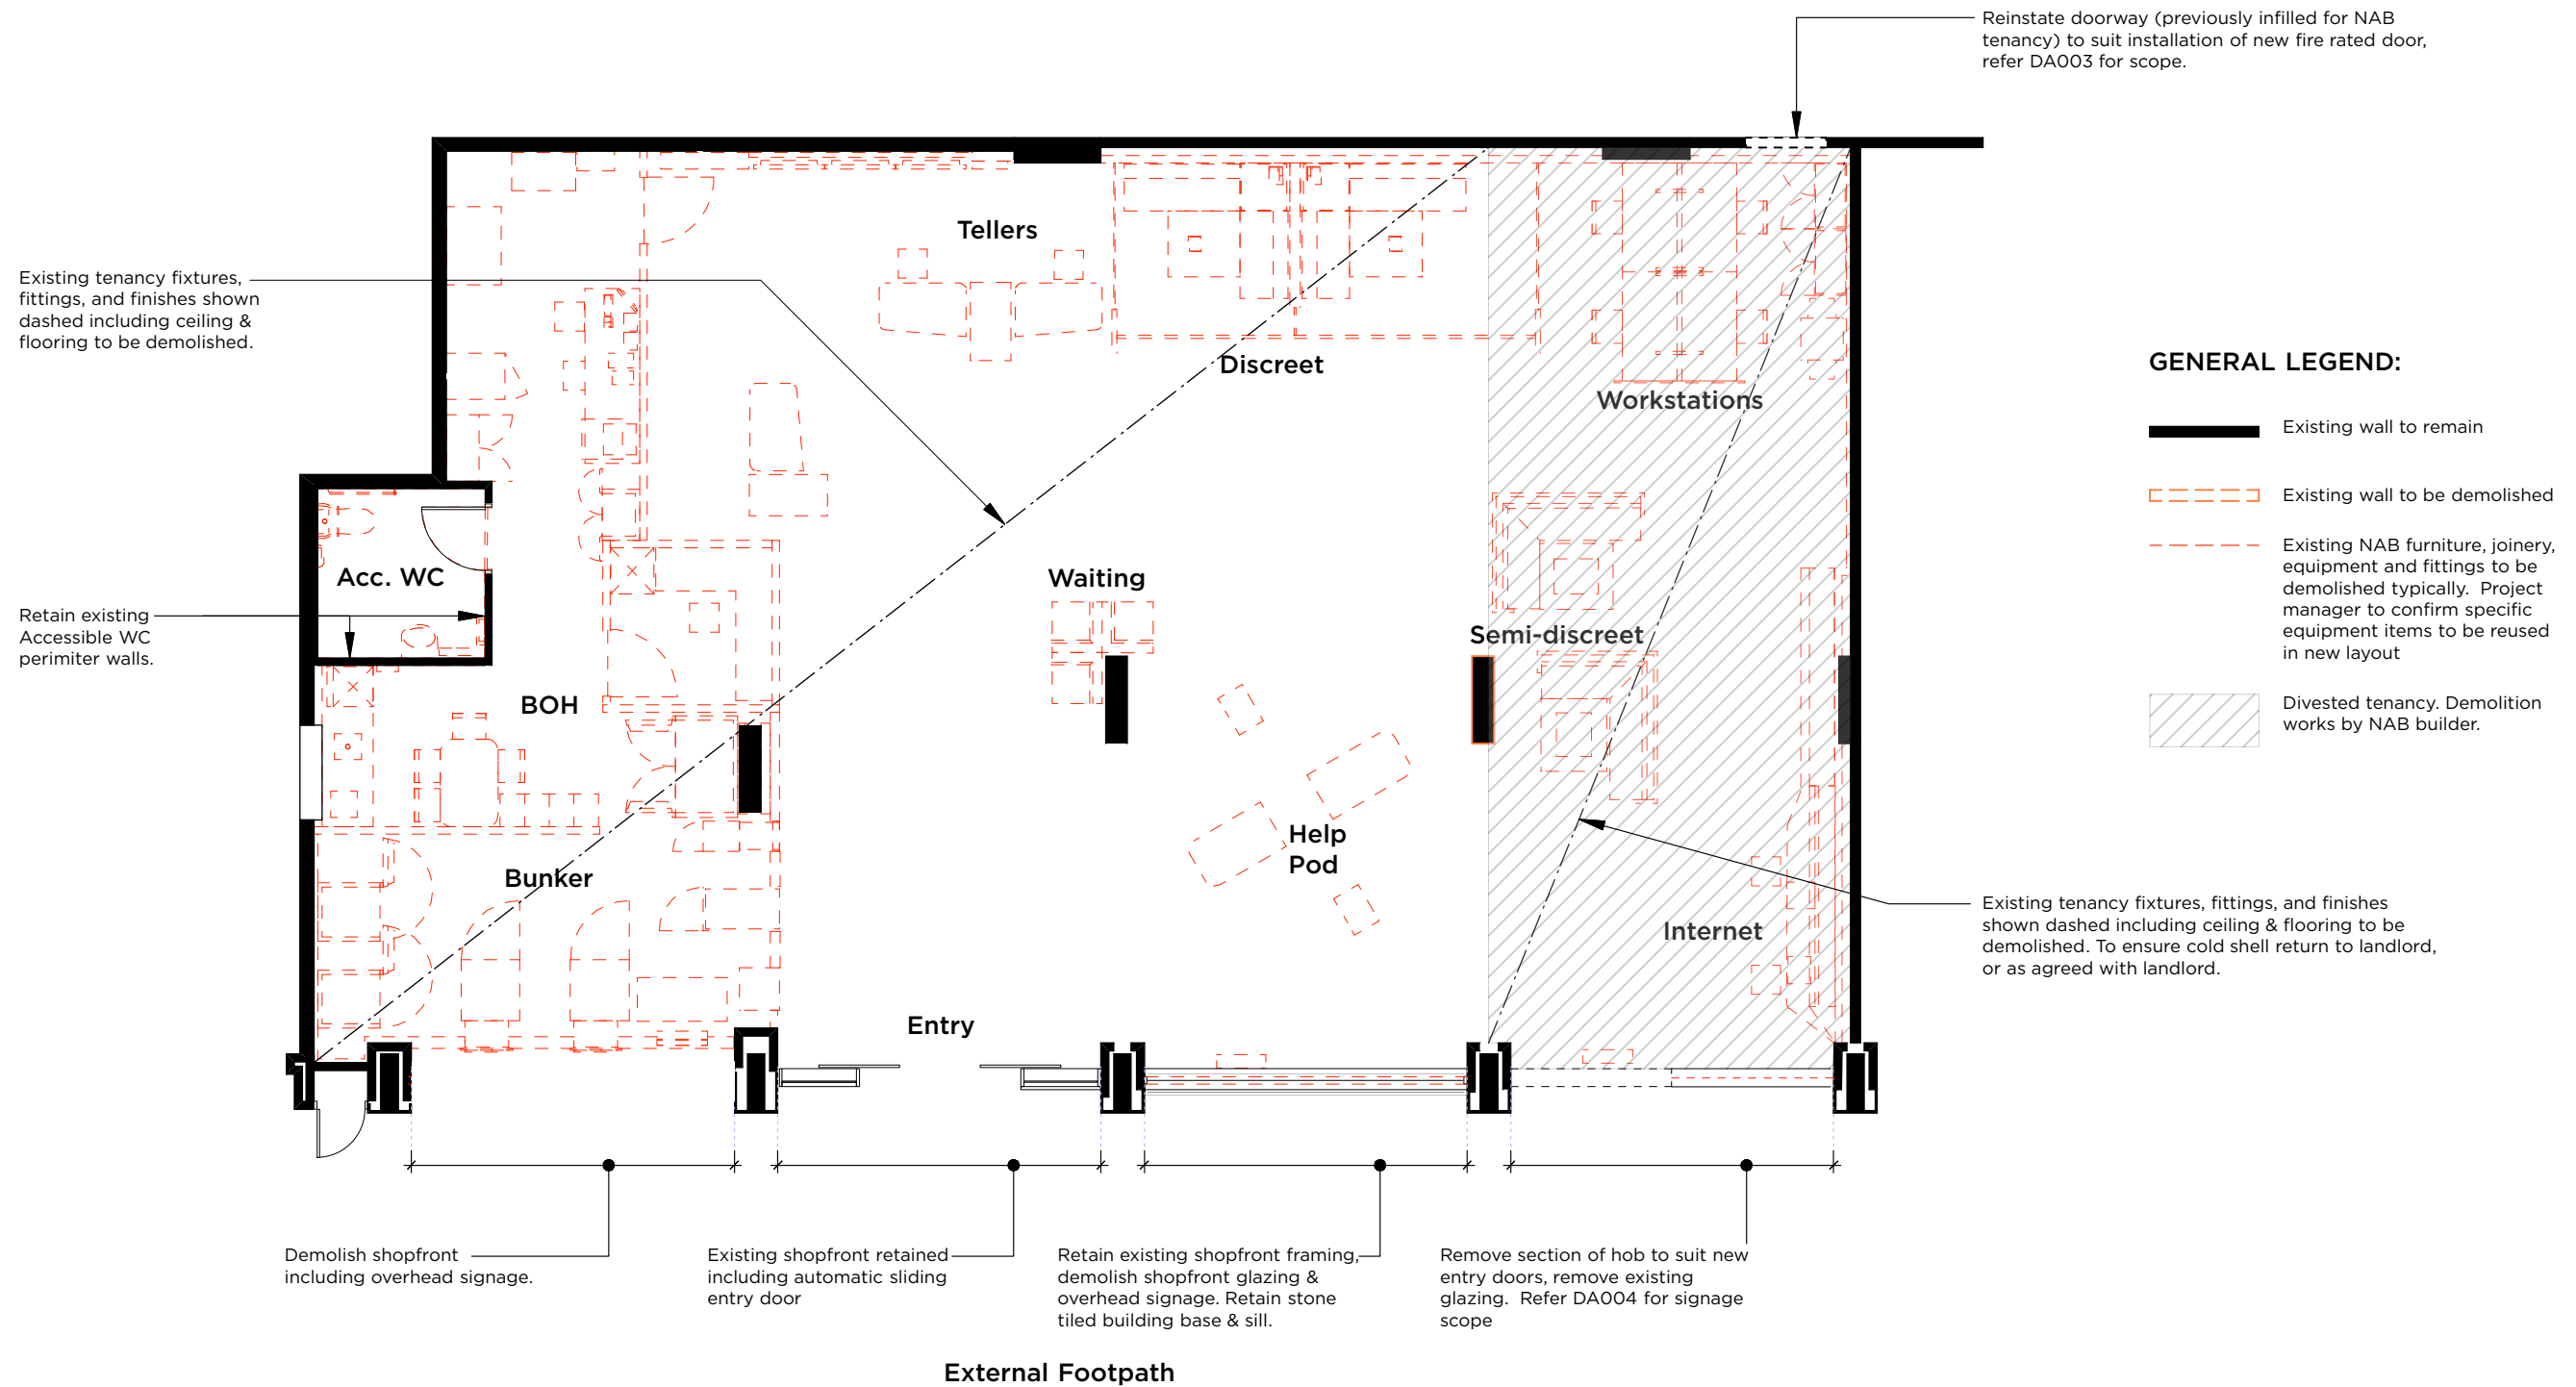

01 DEMOLITION PLAN  
- NAB Manly  
Scale 1:100

#### NOTES :

1. Base plan and all dimensions noted are referenced from Warren and Mahoney's As Built drawing number ID 2.01 rev 2, provided to PMDL by Lendlease.
2. Existing tenancy fit-out to be removed entirely to leave a cold shell prior to construction.
3. Refer to DA004 for proposed demolition works to elevation.



For Approval


**PMDL** ARCHITECTURE  
INTERIORS  
MASTERPLANNING

#### Demolition Plan

© PMDL pmdl.com.au Project 2997 Scale 1:100 @ A3 Date 30.08.21 Dwg DA002 C

NAB Manly NSW



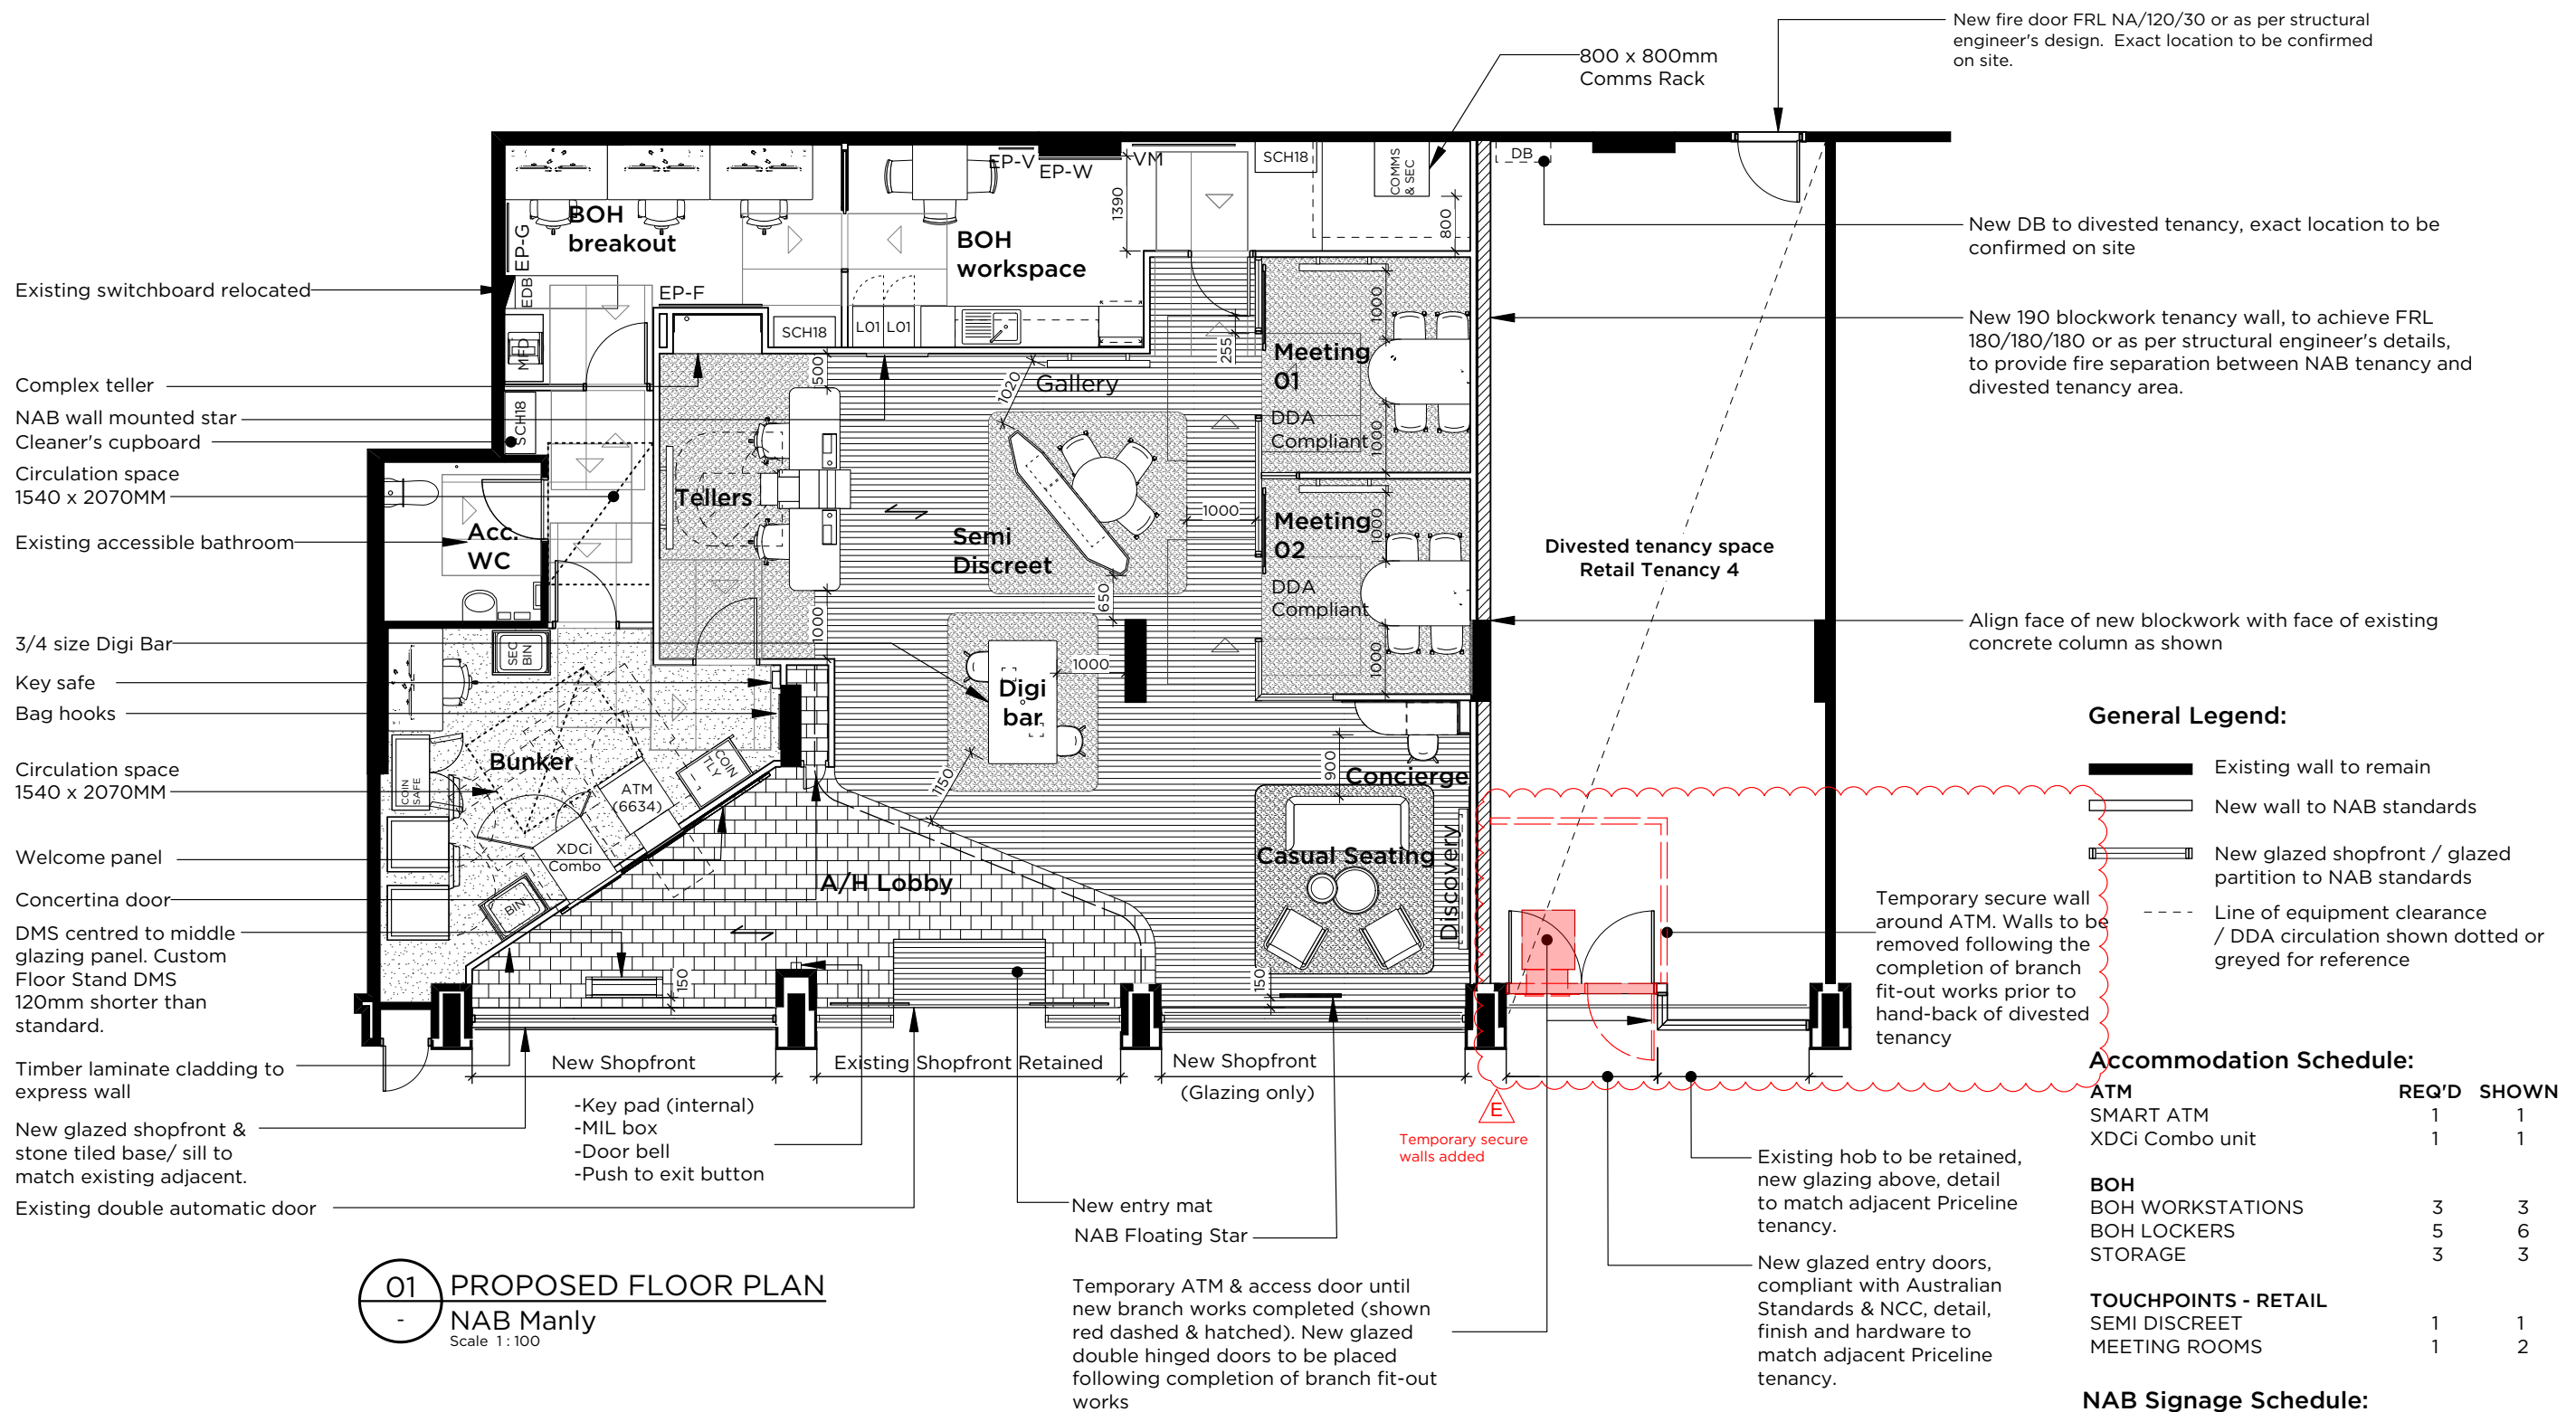


For Approval



## Proposed Floor Plan

NAB Manly NSW

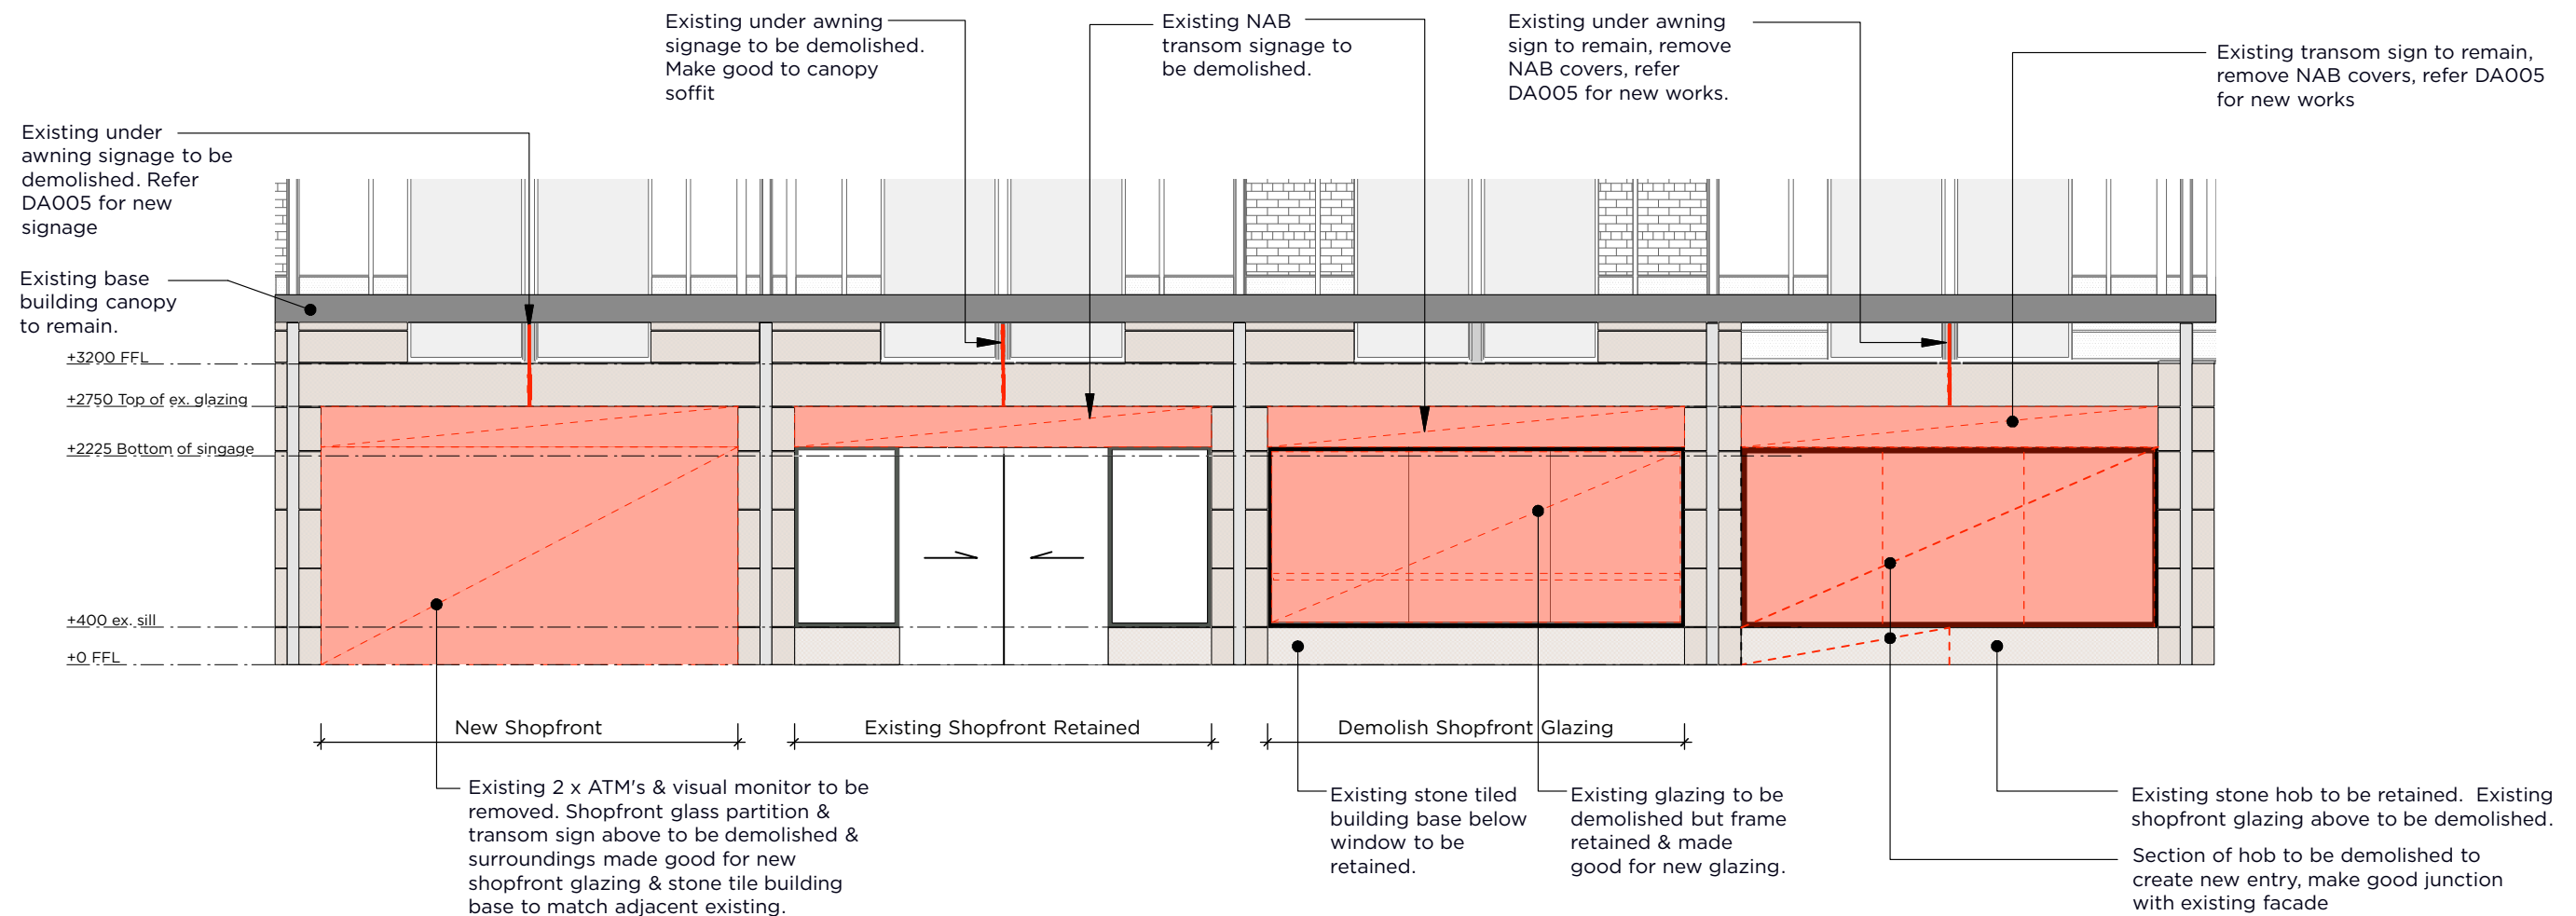

01 DEMOLITION EXTERNAL ELEVATION  
- NAB Manly  
Scale 1: 75



#### DEMOLITION NOTES:

1. Existing base building canopy to be retained & protected throughout the demolition process.
2. Make good to any base building structure impacted by demolition.

For Approval

**PMDL** ARCHITECTURE  
INTERIORS  
MASTERPLANNING

#### Demolition Elevation

© PMDL pmdl.com.au Project 2997 Scale 1:75 @ A3 Date 26.08.21 Dwg DA004 B

NAB Manly NSW

