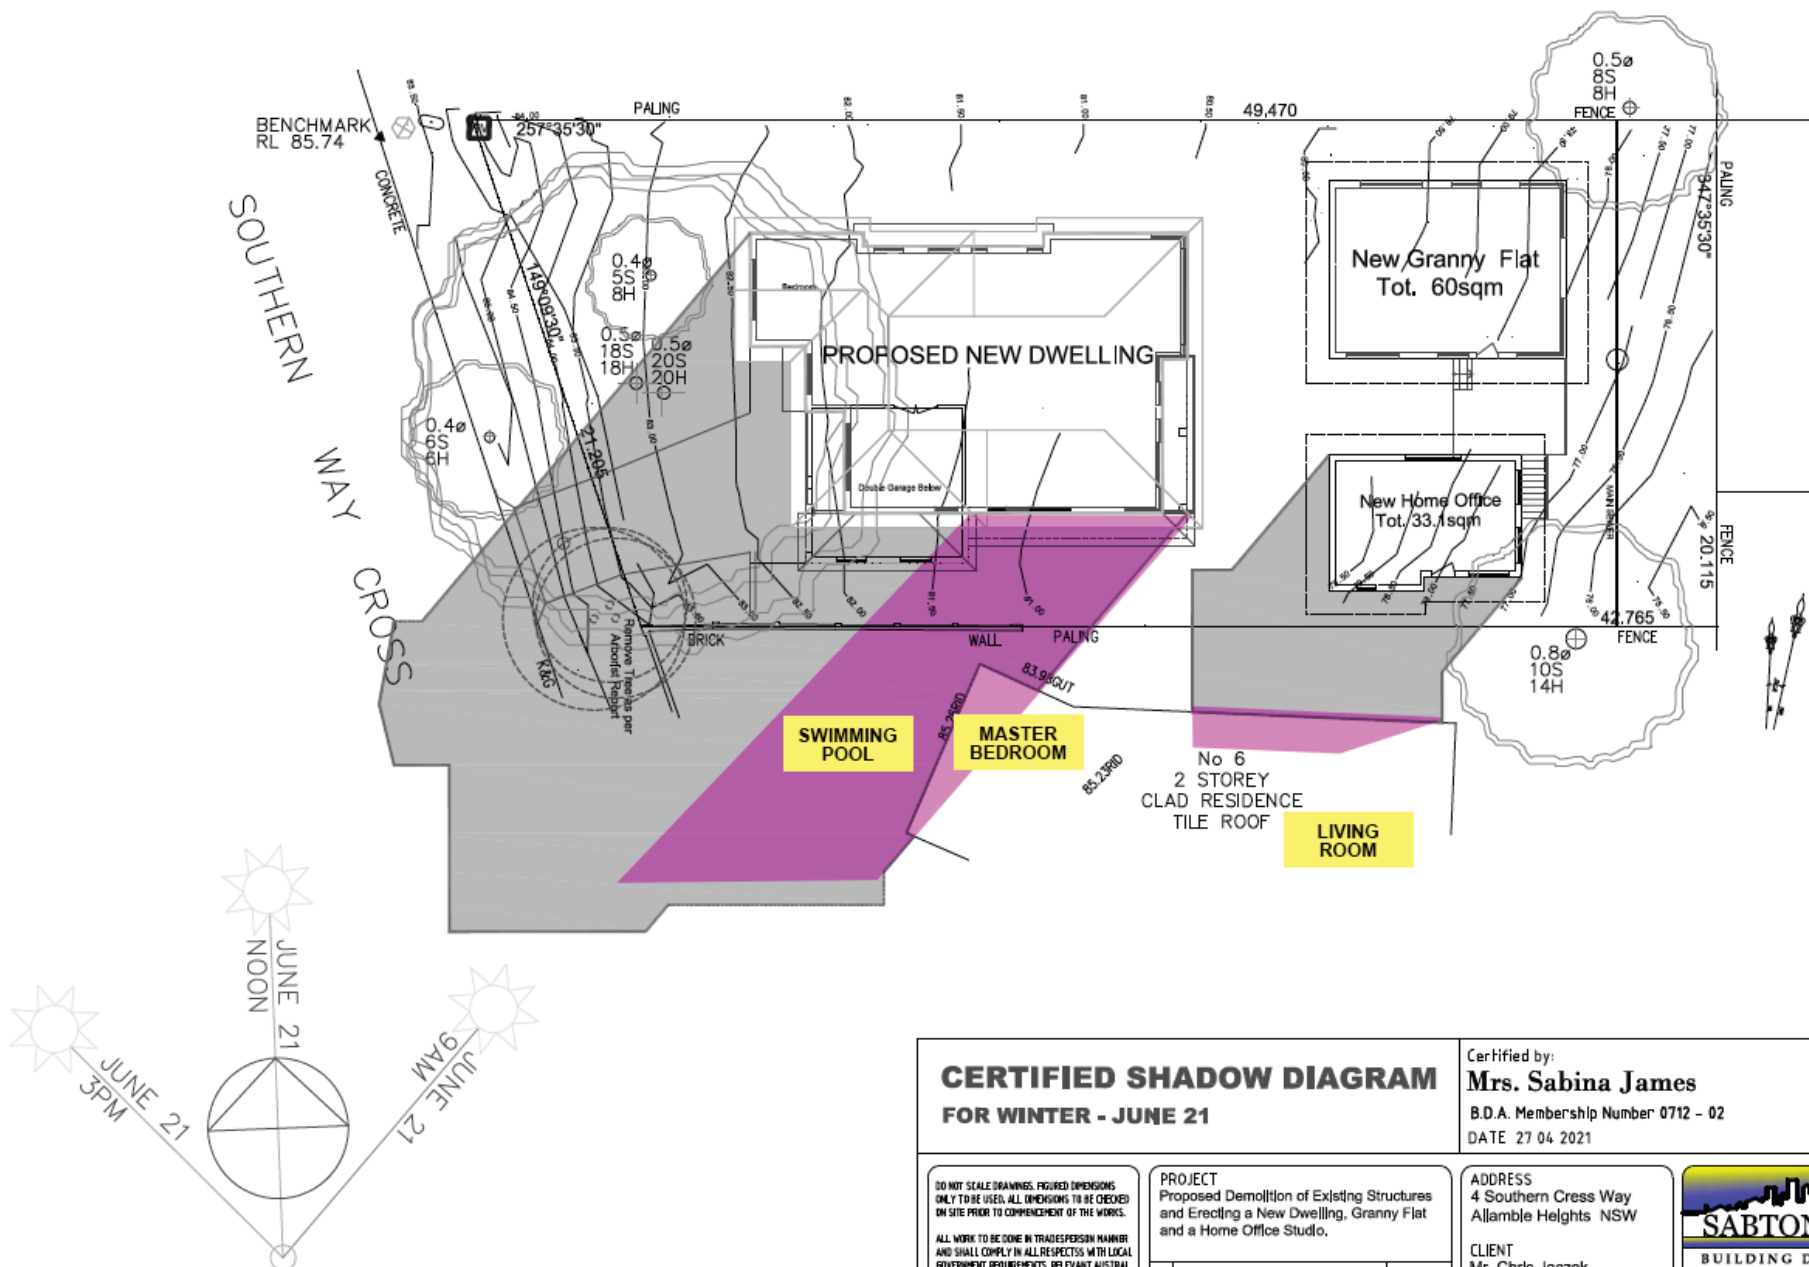

Sent: 24/05/2021 11:16:09 PM
Subject:
Attachments: 4SouthernCrossWay-ShadowDiagrams-Markup.pdf;

Dear Mr. Burns,

I have just submitted an objection for the amended plans of **Development Application DA2020/1691** via the council portal. Please see attached marked up shadow diagrams as an attachment to our objection.

Thank you in advance for your time,
Shelby Lane-Brown



**9AM SHADOW DIAGRAM
WINTER - JUNE 21**

CERTIFIED SHADOW DIAGRAM FOR WINTER - JUNE 21

Certified by:
Mrs. Sabina James
B.D.A. Membership Number 0712 - 02
DATE 27 04 2021



DO NOT SCALE DRAWINGS. FIGURED DIMENSIONS ONLY TO BE USED. ALL DIMENSIONS TO BE CHECKED ON SITE PRIOR TO COMMENCEMENT OF THE WORKS.

ALL WORK TO BE DONE IN TRADESPERSON MANNER AND SHALL COMPLY IN ALL RESPECTS WITH LOCAL GOVERNMENT REQUIREMENTS, RELEVANT AUSTRALIAN STANDARDS, BUILDING CODE OF AUSTRALIA AND INDUSTRY TRADE PRACTICE.

THESE DRAWINGS ARE THE PROPERTY OF SABTON & SON BUILDING DESIGNERS AND ARE PROTECTED BY A COPYRIGHT.

PROJECT
Proposed Demolition of Existing Structures and Erecting a New Dwelling, Granny Flat and a Home Office Studio.

B	AS PER COUNCIL'S LETTER - 19 APRIL 21	APR 2021
A	ISSUED FOR DA APPLICATION	OCT. 2020


ADDRESS
4 Southern Cross Way
Allamby Heights NSW

CLIENT
Mr. Chris Jaczak

DRAWN	SCALE	DATE
AJ	1:200	2021 04 27
DRAWING No:	ISSUE	
PR020.03, Page 1e.i	B	

SABTON & SON
BUILDING DESIGNERS and
STRUCTURAL & HYDRO ENGINEERS

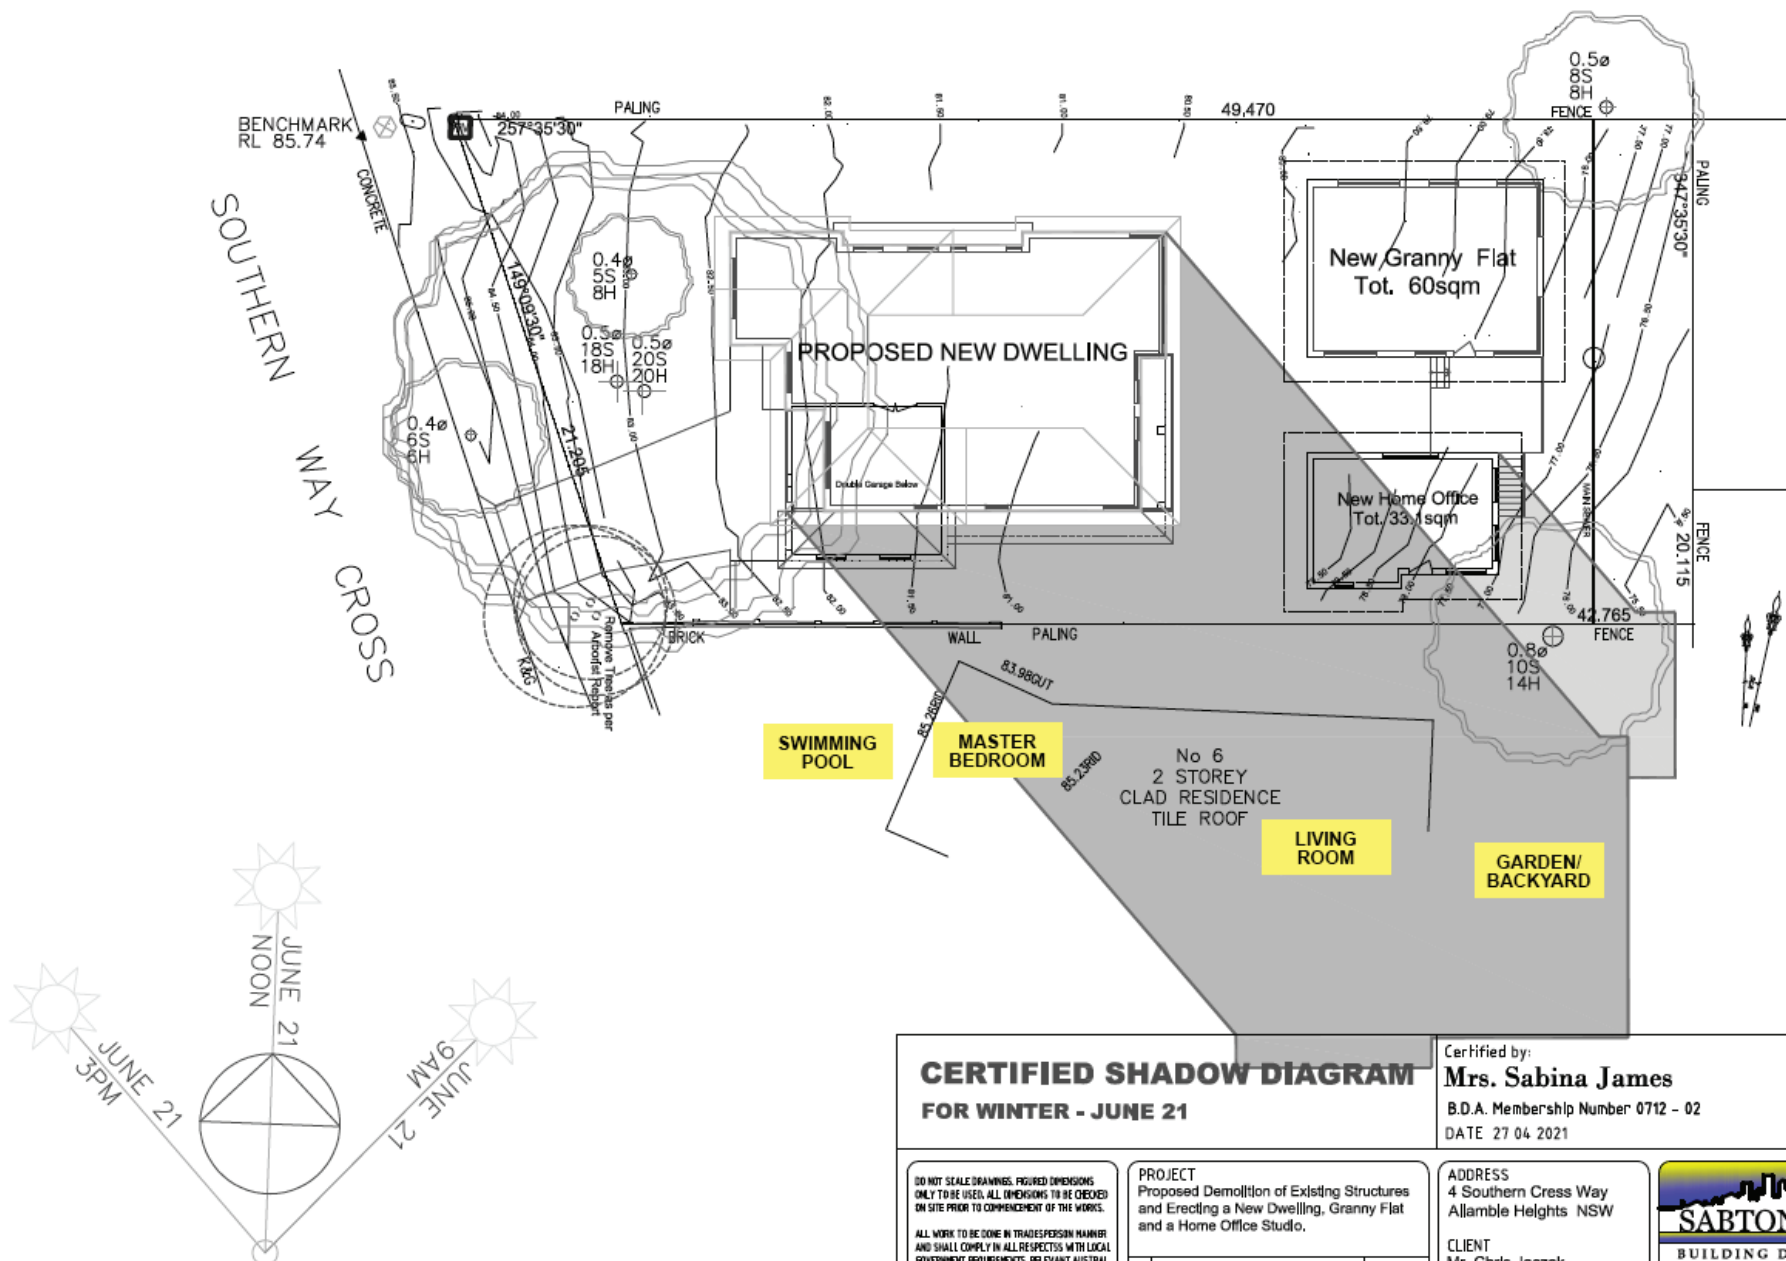sabton@optusnet.com.au
Mob: 0408 663 223
Tel: (612) 4567 2002



**3PM SHADOW DIAGRAM
WINTER - JUNE 21**

**CERTIFIED SHADOW DIAGRAM
FOR WINTER - JUNE 21**

Certified by:
Mrs. Sabina James
B.D.A. Membership Number 0712 - 02
DATE 27 04 2021



DO NOT SCALE DRAWINGS. FIGURED DIMENSIONS ONLY TO BE USED. ALL DIMENSIONS TO BE CHECKED ON SITE PRIOR TO COMMENCEMENT OF THE WORKS.

ALL WORK TO BE DONE IN TRADESPERSON MANNER AND SHALL COMPLY IN ALL RESPECTS WITH LOCAL GOVERNMENT REQUIREMENTS, RELEVANT AUSTRALIAN STANDARDS, BUILDING CODE OF AUSTRALIA AND INDUSTRY TRADE PRACTICE.

THESE DRAWINGS ARE THE PROPERTY OF SABTON & SON BUILDING DESIGNERS AND ARE PROTECTED BY A COPYRIGHT.

PROJECT
Proposed Demolition of Existing Structures and Erecting a New Dwelling, Granny Flat and a Home Office Studio.

B	AS PER COUNCIL'S LETTER -19 APRIL 21	APR 2021
A	ISSUED FOR DA APPLICATION	OCT 2020

ADDRESS
4 Southern Cross Way
Allamby Heights NSW

CLIENT
Mr. Chris Jaczak

DRAWN AJ	SCALE 1:200	DATE 2021 04 27
DRAWING No: PR020.03, Page 1e.iii	ISSUE B	

SABTON & SON
BUILDING DESIGNERS and
STRUCTURAL & HYDRO ENGINEERS
sabton@optusnet.com.au
Mob: 0408 663 223
Tel: (612) 4567 2002