


POSITIONS AND HEIGHTS OF PEG, PLACED BY ACOR WSC CONSULTANTS PTY LTD, AND MANHOLE FOUND ARE IN RED.

A Clerk
 ADAM CLERKE
 REGISTERED SURVEYOR
 28/11/2017

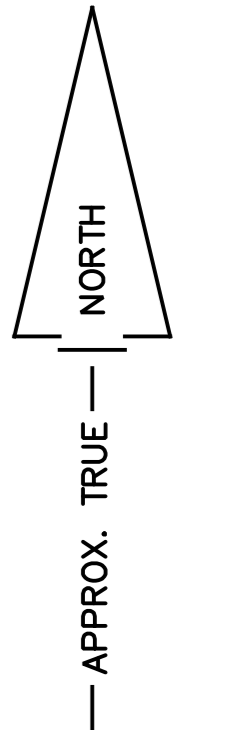

NOTES:

- TREE SPREADS & HEIGHTS ARE INDICATIVE ONLY.
- ONLY VISIBLE SERVICES HAVE BEEN SHOWN. UNDERGROUND SERVICES HAVE NOT BEEN LOCATED. NOTIFICATION OF ALL RELEVANT AUTHORITIES SHOULD BE UNDERTAKEN BEFORE CARRYING OUT ANY CONSTRUCTION ACTIVITY IN OR NEAR THE SURVEYED AREA.
- THIS SURVEY HAS BEEN CARRIED OUT FOR INFORMATION PURPOSES ONLY AND SURVEY MARKS SHOULD BE PLACED IF STRUCTURES ARE TO BE ERRECTED ON OR NEAR THE BOUNDARIES. BOUNDARIES ARE NOT TO BE ESTABLISHED FROM INFORMATION SHOWN ON DRAWING.
- CONTOUR INTERVAL - 1 METRE. CONTOURS ARE INDICATIVE ONLY. SPOT LEVELS SHOULD BE ADOPTED FOR DESIGN AND CALCULATION PURPOSES. CRITICAL SPOT LEVELS SHOULD BE CONFIRMED WITH SURVEYOR.
- ORIGIN OF LEVELS: P.M.85787 R.L51.50 A.H.D. CLASS/ORDER E/5 (SCIMS)
- COPYRIGHT © ADAM CLERKE SURVEYORS PTY LTD 2017
- THIS PLAN HAS BEEN PREPARED FOR THE EXCLUSIVE USE OF BROOKE STUART

ADAM CLERKE SURVEYORS PTY LTD
 incorporating PAUL KEEN & COMPANY
 LAND & ENGINEERING SURVEYORS
 38 KEVIN AVENUE, AVALON 2107
 TEL...9918 4111

DETAILS AND LEVELS OVER PART OF LOT 1 IN D.P. 940521

190 BARRENJOEY ROAD, NEWPORT

DATE... 27/10/17 REF... 4502G
 SCALE...1:100/A0 DATUM...A.H.D