

1 Floor Plan
1:50



Photo 01



Photo 02

TENDER ISSUE

Date	Issue	Description	Date	Issue	Description	Date	Issue	Description
09-02-23	H	Cafe DA						
21-02-23	G	Additional setback information						
31-03-23	F	N & W Wall FRL system revised, boxed for CC						
17-03-23	E	FRL Added						
17-03-23	D	ISSUED FOR TENDER						

The builder shall check and verify all dimensions and verify all entries and omissions to the Architect. Do not scale the drawings. Drawings shall not be used for construction purposes until issued by the Architect for construction.




GARTNER TROVATO ARCHITECTS
 1/100-1/101 BARKER STREET, PITTWATER NSW 2122
 P: 02 9615 4111 F: 02 9615 4800
 C: 02 9615 4111


PROJECT: **BILLIE'S CAFE**
 The Serpentine, Bilgola
 CLIENT: **PITTWATER COUNCIL**
 DRAWING: **Floor Plan - As Built**

Drawn/Designed: **J-JAH** Date: **28 February 2023**
 Project Number: **0602** Scale: **As Shown @ (A1)**
 Drawing No.: **A-01** Issue: **H**


1 South Elevation
1:50

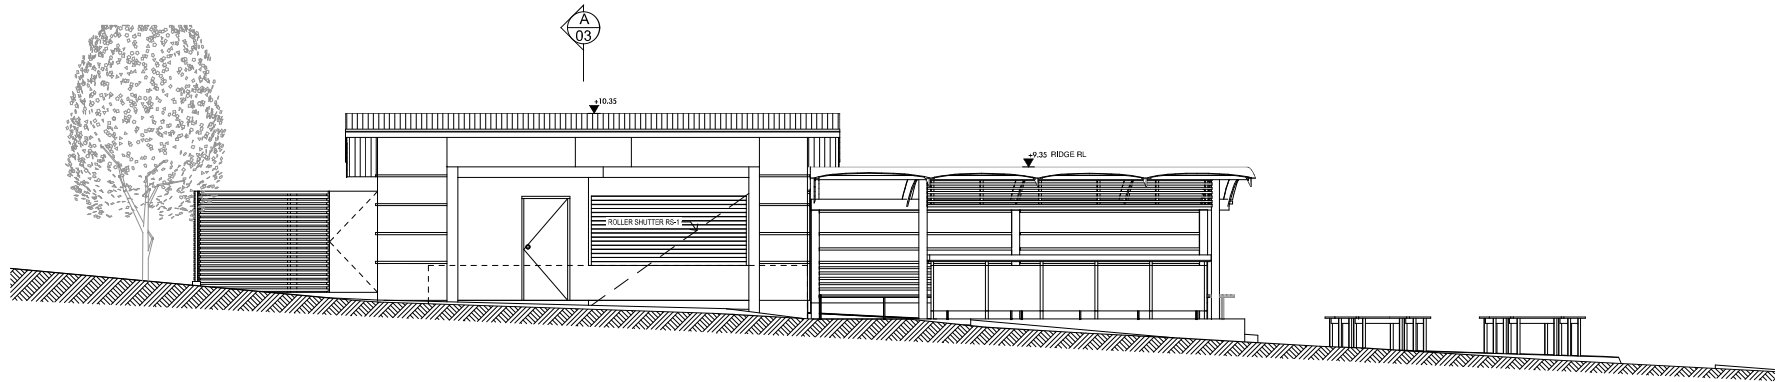


2 West Elevation 2
1:50

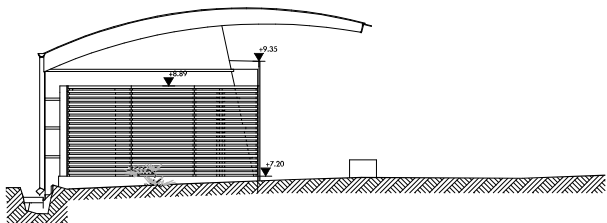


3 East Elevation
1:50

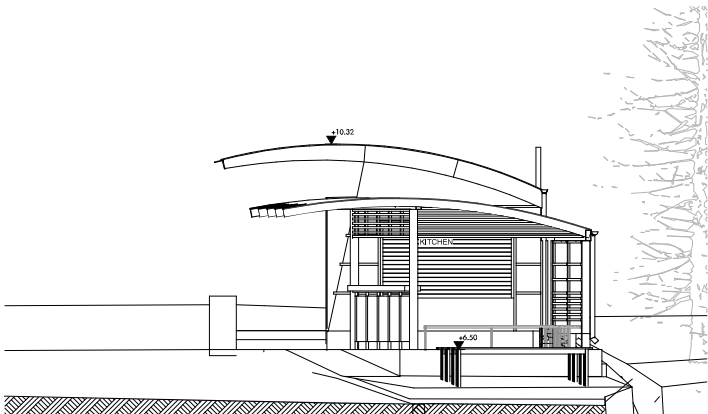

4 Section AA
1:50

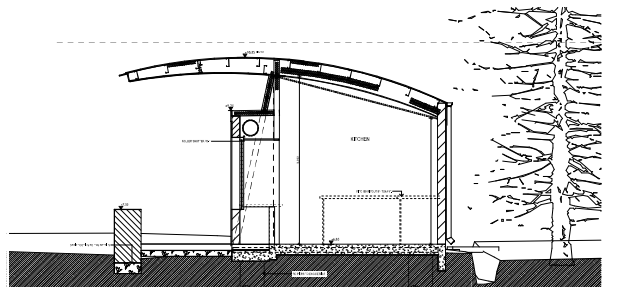

5 North Elevation
1:50

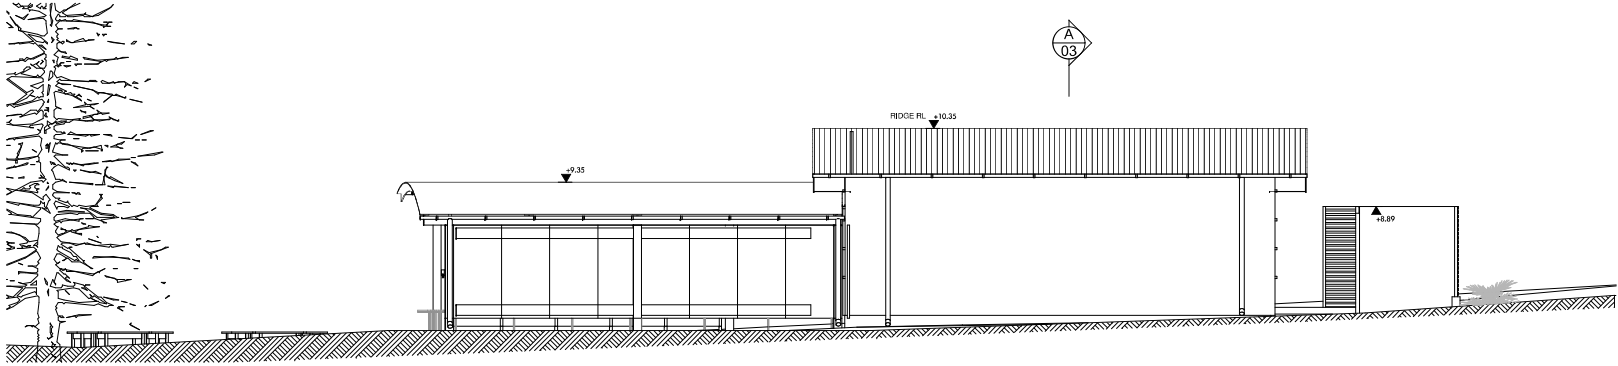

TENDER ISSUE

Date	Issue	Description	Date	Issue	Description	Date	Issue	Description
09-03-23	H	Cafe DA						
21-04-23	E	Walls Updated						
12-05-23	D	READY FOR TENDER						

The builder shall check and verify all dimensions and verify all areas and contents to the Architect. Do not scale the drawings. Drawings shall not be used for construction purposes until issued by the Architect for construction.

GARTNER TROVATO ARCHITECTS
GARTNER TROVATO ARCHITECTS
 1/111-112/113 BUNGA STREET, APO APO QLD 4870
 PHONE: 08 9393 4411
 F: 08 9393 4402
 C: 08 9393 4403

PROJECT: **BILLIES CAFE**
The Serpentine, Bigla
 CLIENT: **PITWATER COUNCIL**
 DRAWING: **Elevations & Section**

Drawn/Designed: **J.T./J.H.** Date: **28 February 2023**
 Project Number: **0602** Scale: **as shown @ (A1)**
 Drawing No.: **A-02** Issue: **H**