

Bryan Residence


Address: 26 Lentara Road, Bayview, 2104
Landscape Architectural Plans (As Built)

DRAWING LIST

| Drawing No. | Drawing Name | Scale | Size | Rev |
|-------------|---------------------------------------|-------|------|-----|
| Plans | | | | |
| LD-00 | Cover Page & Drawing List | N/A | A3 | A |
| LD-10 | Demolition Plan - As Built | 1:100 | A3 | A |
| LD-20 | Masterplan - As Built | 1:100 | A3 | A |
| LD-30 | Pavilion Section-Elevation - As Built | 1:50 | A3 | A |
| LD-31 | Eastern Elevation - As Built | 1:50 | A3 | A |

Documentation to be read in conjunction with the following documents:

- Survey Report & Identification Survey (Prepared by Cooper & Richards Surveyors, dated 22rd July 2024)
- Structural Inspection Certificate (Prepared by Patridge Structural Pty Ltd, dated 2rd August 2024)
- Geotechnical investigation (Prepared by White Geotechnical Group)
- Geotechnical Inspection (Prepared by White Geotechnical Group)

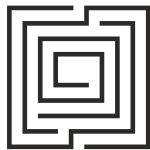

Secret Gardens
Landscape design, construction and maintenance | 17 Aylesbury Street, Botany NSW 2019
Phone 9314 5333 Fax 9314 5322
Secret Gardens retains intellectual property ownership, and moral rights are asserted. Copyright 2023 Secret Gardens of Sydney Pty Ltd. This drawing, including plant graphics, is for design guidance only. All dimensions are to be verified with a site survey, and final details must meet site conditions, building standards and relevant authorities.

| Rev | Amendment | Date | By |
|-----|-----------|---------|----|
| A | As Built | 2/08/24 | CL |
| | | | |
| | | | |

ADDRESS
26 Lentara RD, Bayview NSW

SCALE
N/A



DATE
2/08/2024

DRAWN
NT

PROJECT
Bryan Residence

DWG. TITLE
COVER PAGE

LD-00

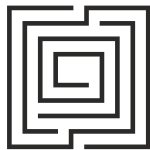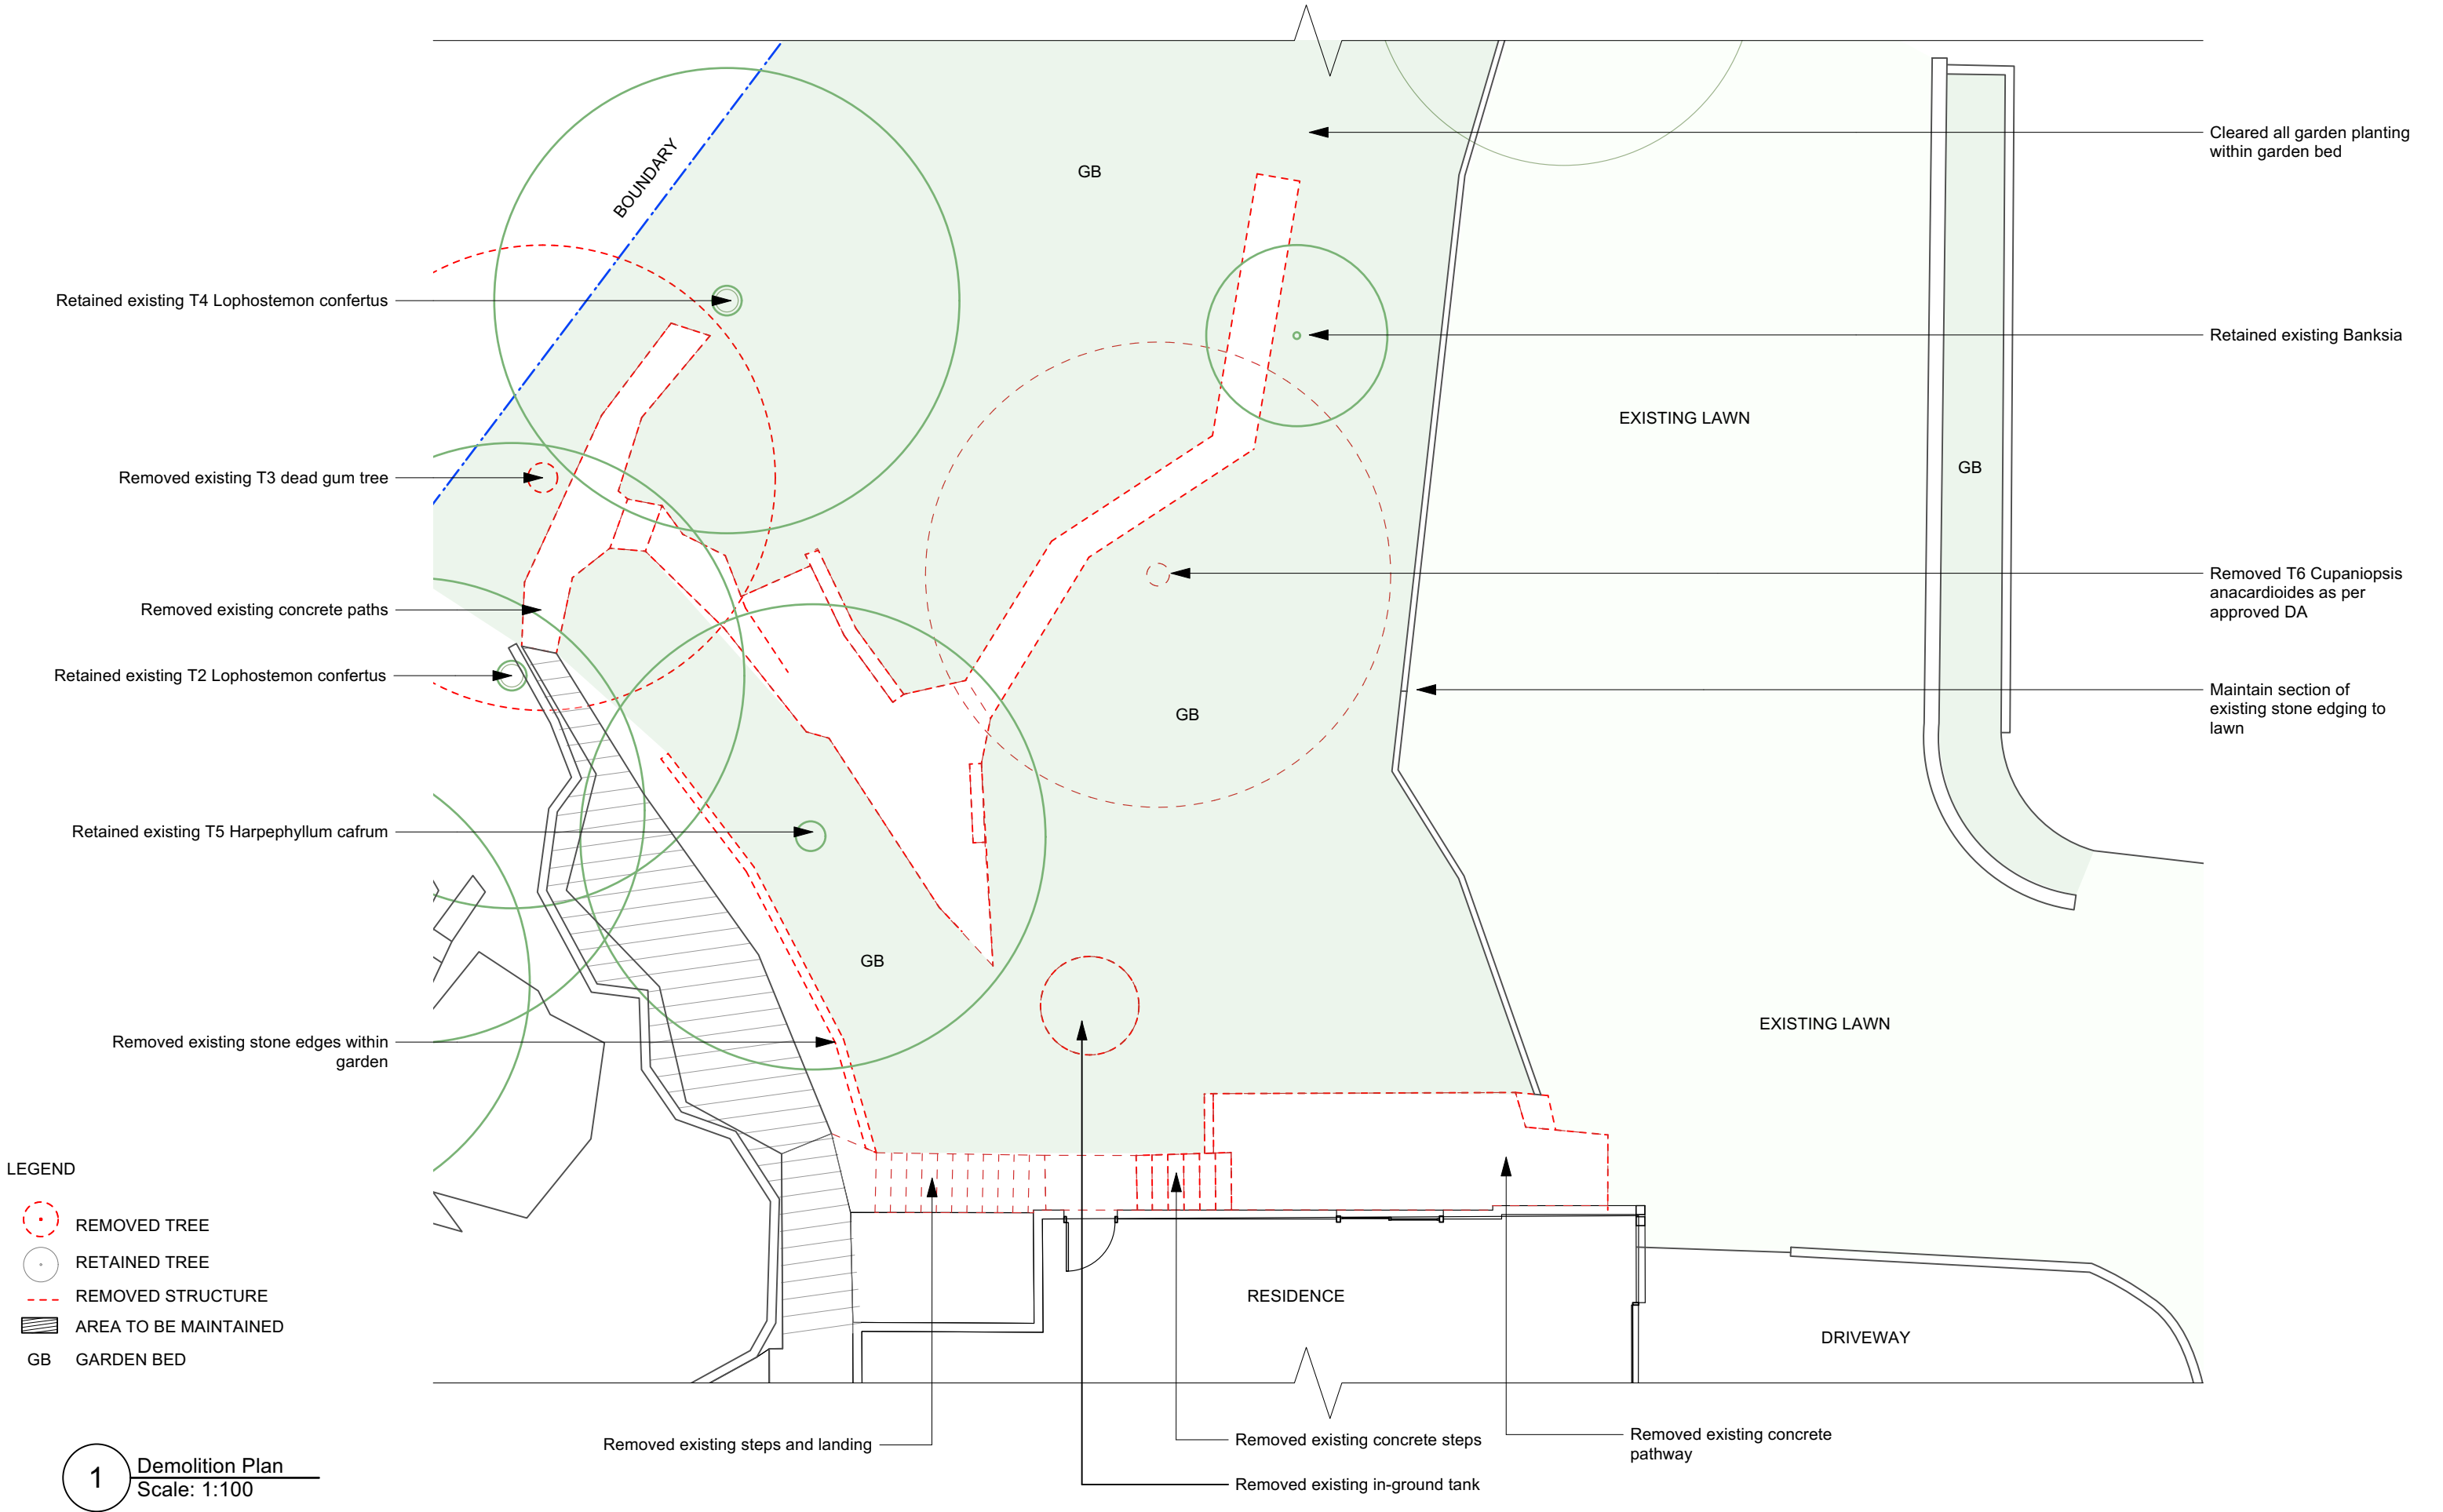

Secret Gardens
Landscape design, construction and maintenance | 17 Aylesbury Street, Botany NSW 2019
Phone 9314 5333 Fax 9314 5322
Secret Gardens retains intellectual property ownership, and moral rights are asserted.
Copyright 2023 Secret Gardens of Sydney Pty Ltd. This drawing, including plant graphics, is for design guidance only. All dimensions are to be verified with a site survey, and final details must meet site conditions, building standards and relevant authorities.

| Rev | Amendment | Date | By |
|-----|-----------|---------|----|
| A | As Built | 2/08/24 | CL |
| | | | |
| | | | |

ADDRESS
26 Lentara RD, Bayview NSW

SCALE
1:100


DATE
2/08/2024

DRAWN
NT

PROJECT
Bryan Residence


DWG. TITLE
DEMOLITION PLAN - AS BUILT

LD-10

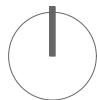



1 Masterplan - As Built
Scale: 1:100

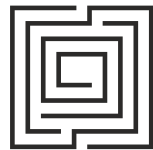

Secret Gardens
Landscape design, construction and maintenance | 17 Aylesbury Street, Botany NSW 2019
Phone 9314 5333 Fax 9314 5322
Secret Gardens retains intellectual property ownership, and moral rights are asserted.
Copyright 2023 Secret Gardens of Sydney Pty Ltd. This drawing, including plant graphics, is for design guidance only. All dimensions are to be verified with a site survey, and final details must meet site conditions, building standards and relevant authorities.

| Rev | Amendment | Date | By |
|-----|-----------|---------|----|
| A | As Built | 2/08/24 | CL |
| | | | |
| | | | |

ADDRESS
26 Lentara RD, Bayview NSW

SCALE
1:100

DATE
2/08/2024


DRAWN
NT

PROJECT
Bryan Residence


DWG. TITLE
MASTERPLAN REAR - AS BUILT

LD-20




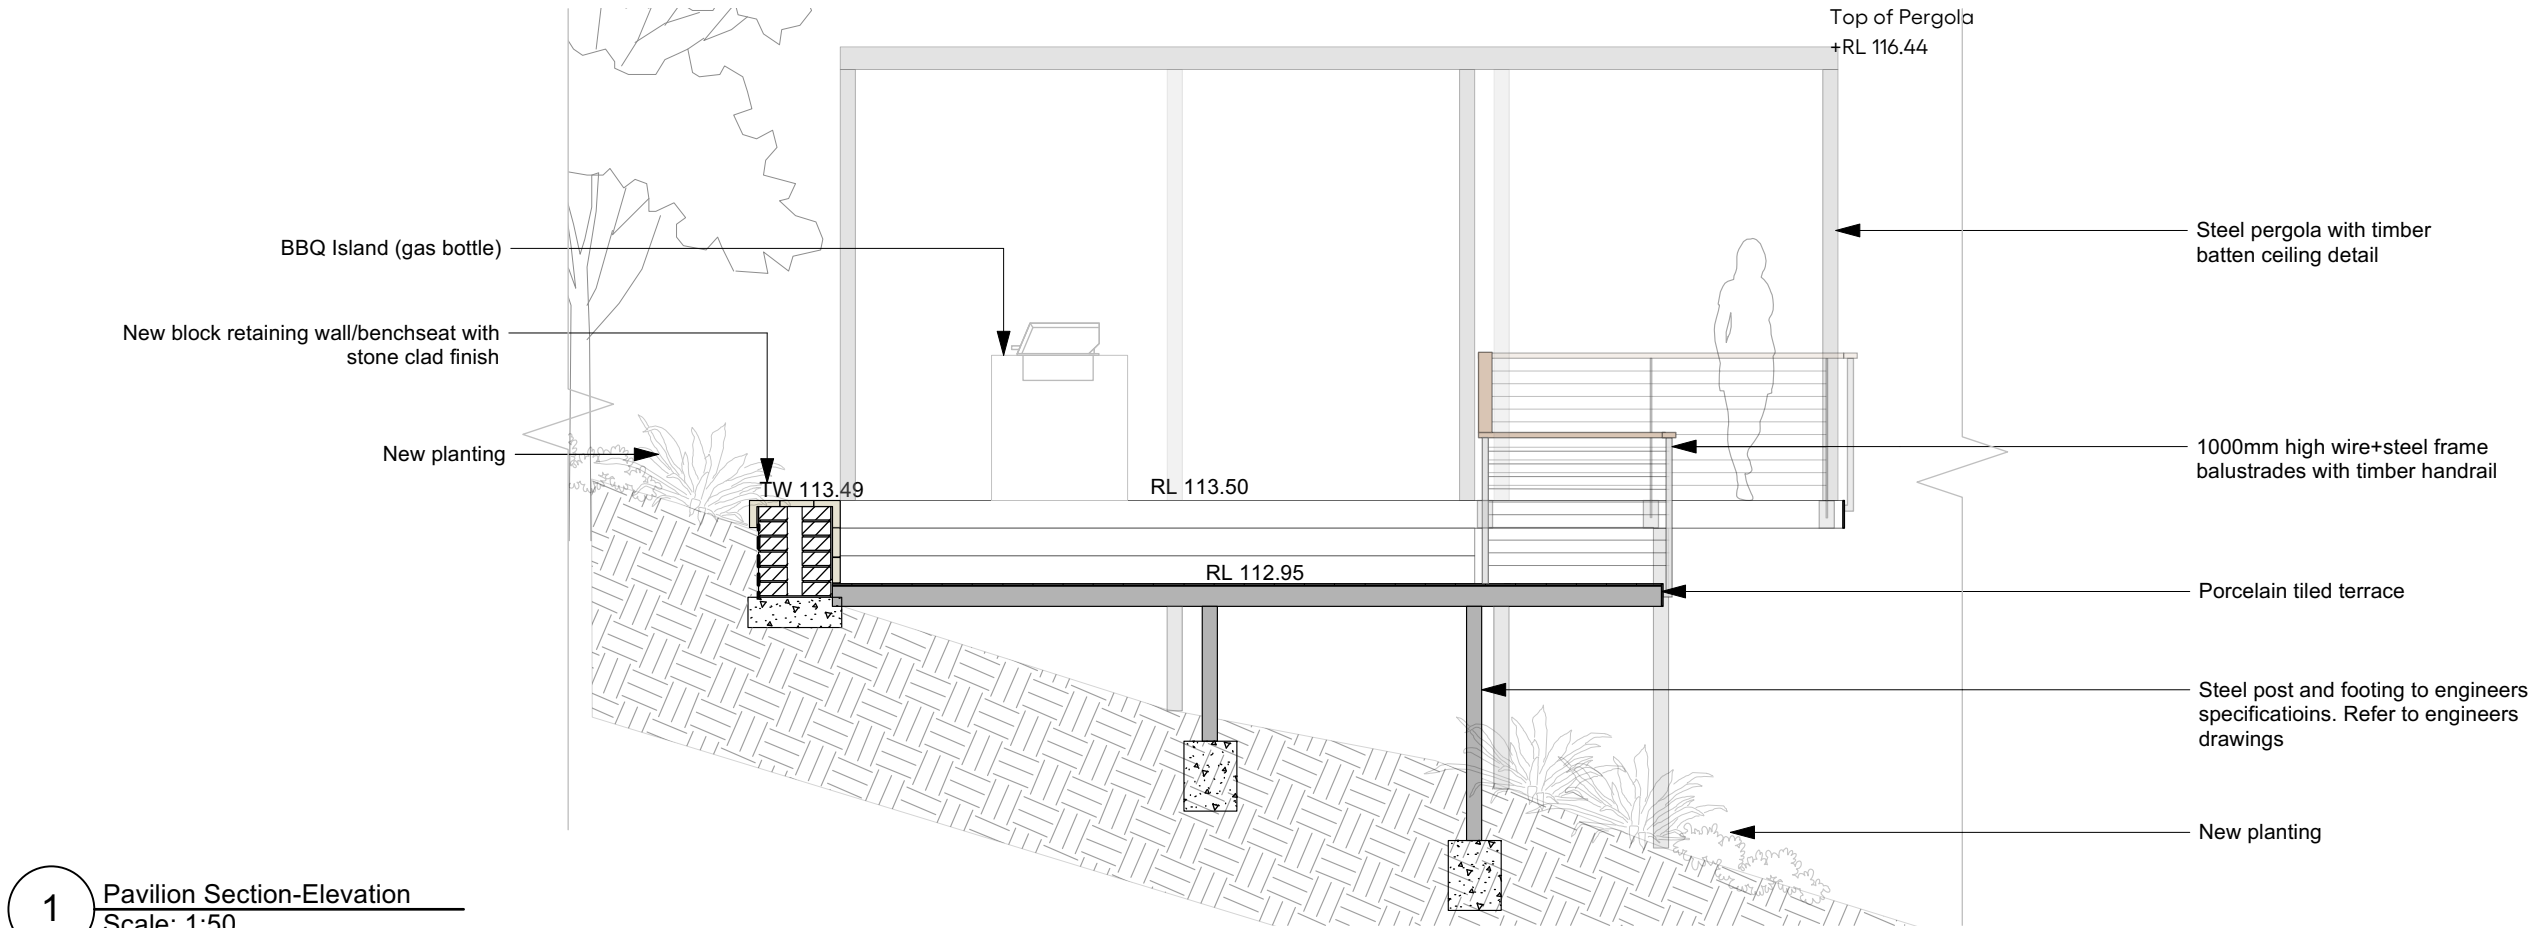

1 Pavilion Section-Elevation
Scale: 1:50

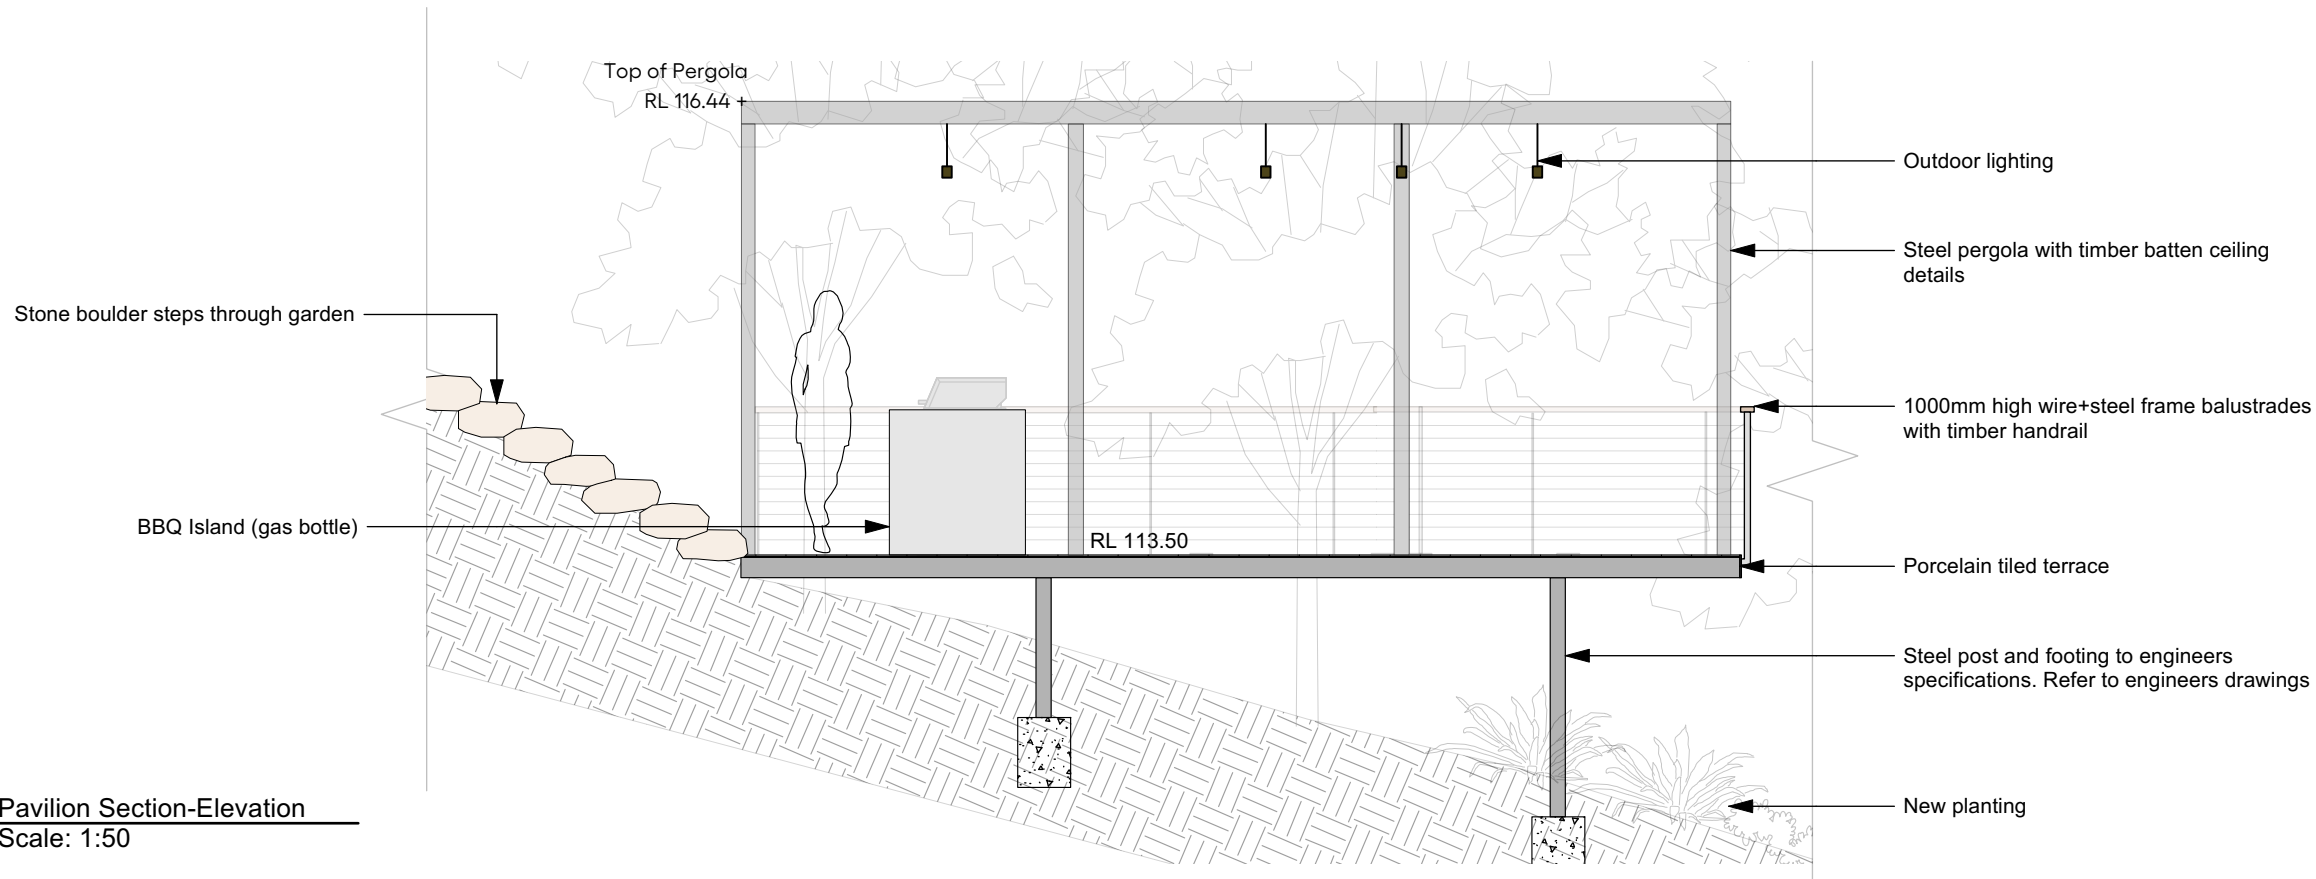

2 Pavilion Section-Elevation
Scale: 1:50

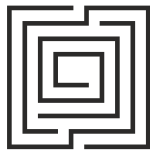

Secret Gardens
Landscape design, construction and maintenance | 17 Aylesbury Street, Botany NSW 2019
Phone 9314 5333 Fax 9314 5322
Secret Gardens retains intellectual property ownership, and moral rights are asserted.
Copyright 2023 Secret Gardens of Sydney Pty Ltd. This drawing, including plant graphics, is for design guidance only. All dimensions are to be verified with a site survey, and final details must meet site conditions, building standards and relevant authorities.

| Rev | Amendment | Date | By |
|-----|-----------|---------|----|
| A | As Built | 2/08/24 | CL |
| | | | |
| | | | |

ADDRESS
26 Lentara RD, Bayview NSW

SCALE
1:50


DATE
2/08/2024

DRAWN
NT


PROJECT
Bryan Residence

DWG. TITLE
SECTION ELEVATION - AS BUILT

LD-30

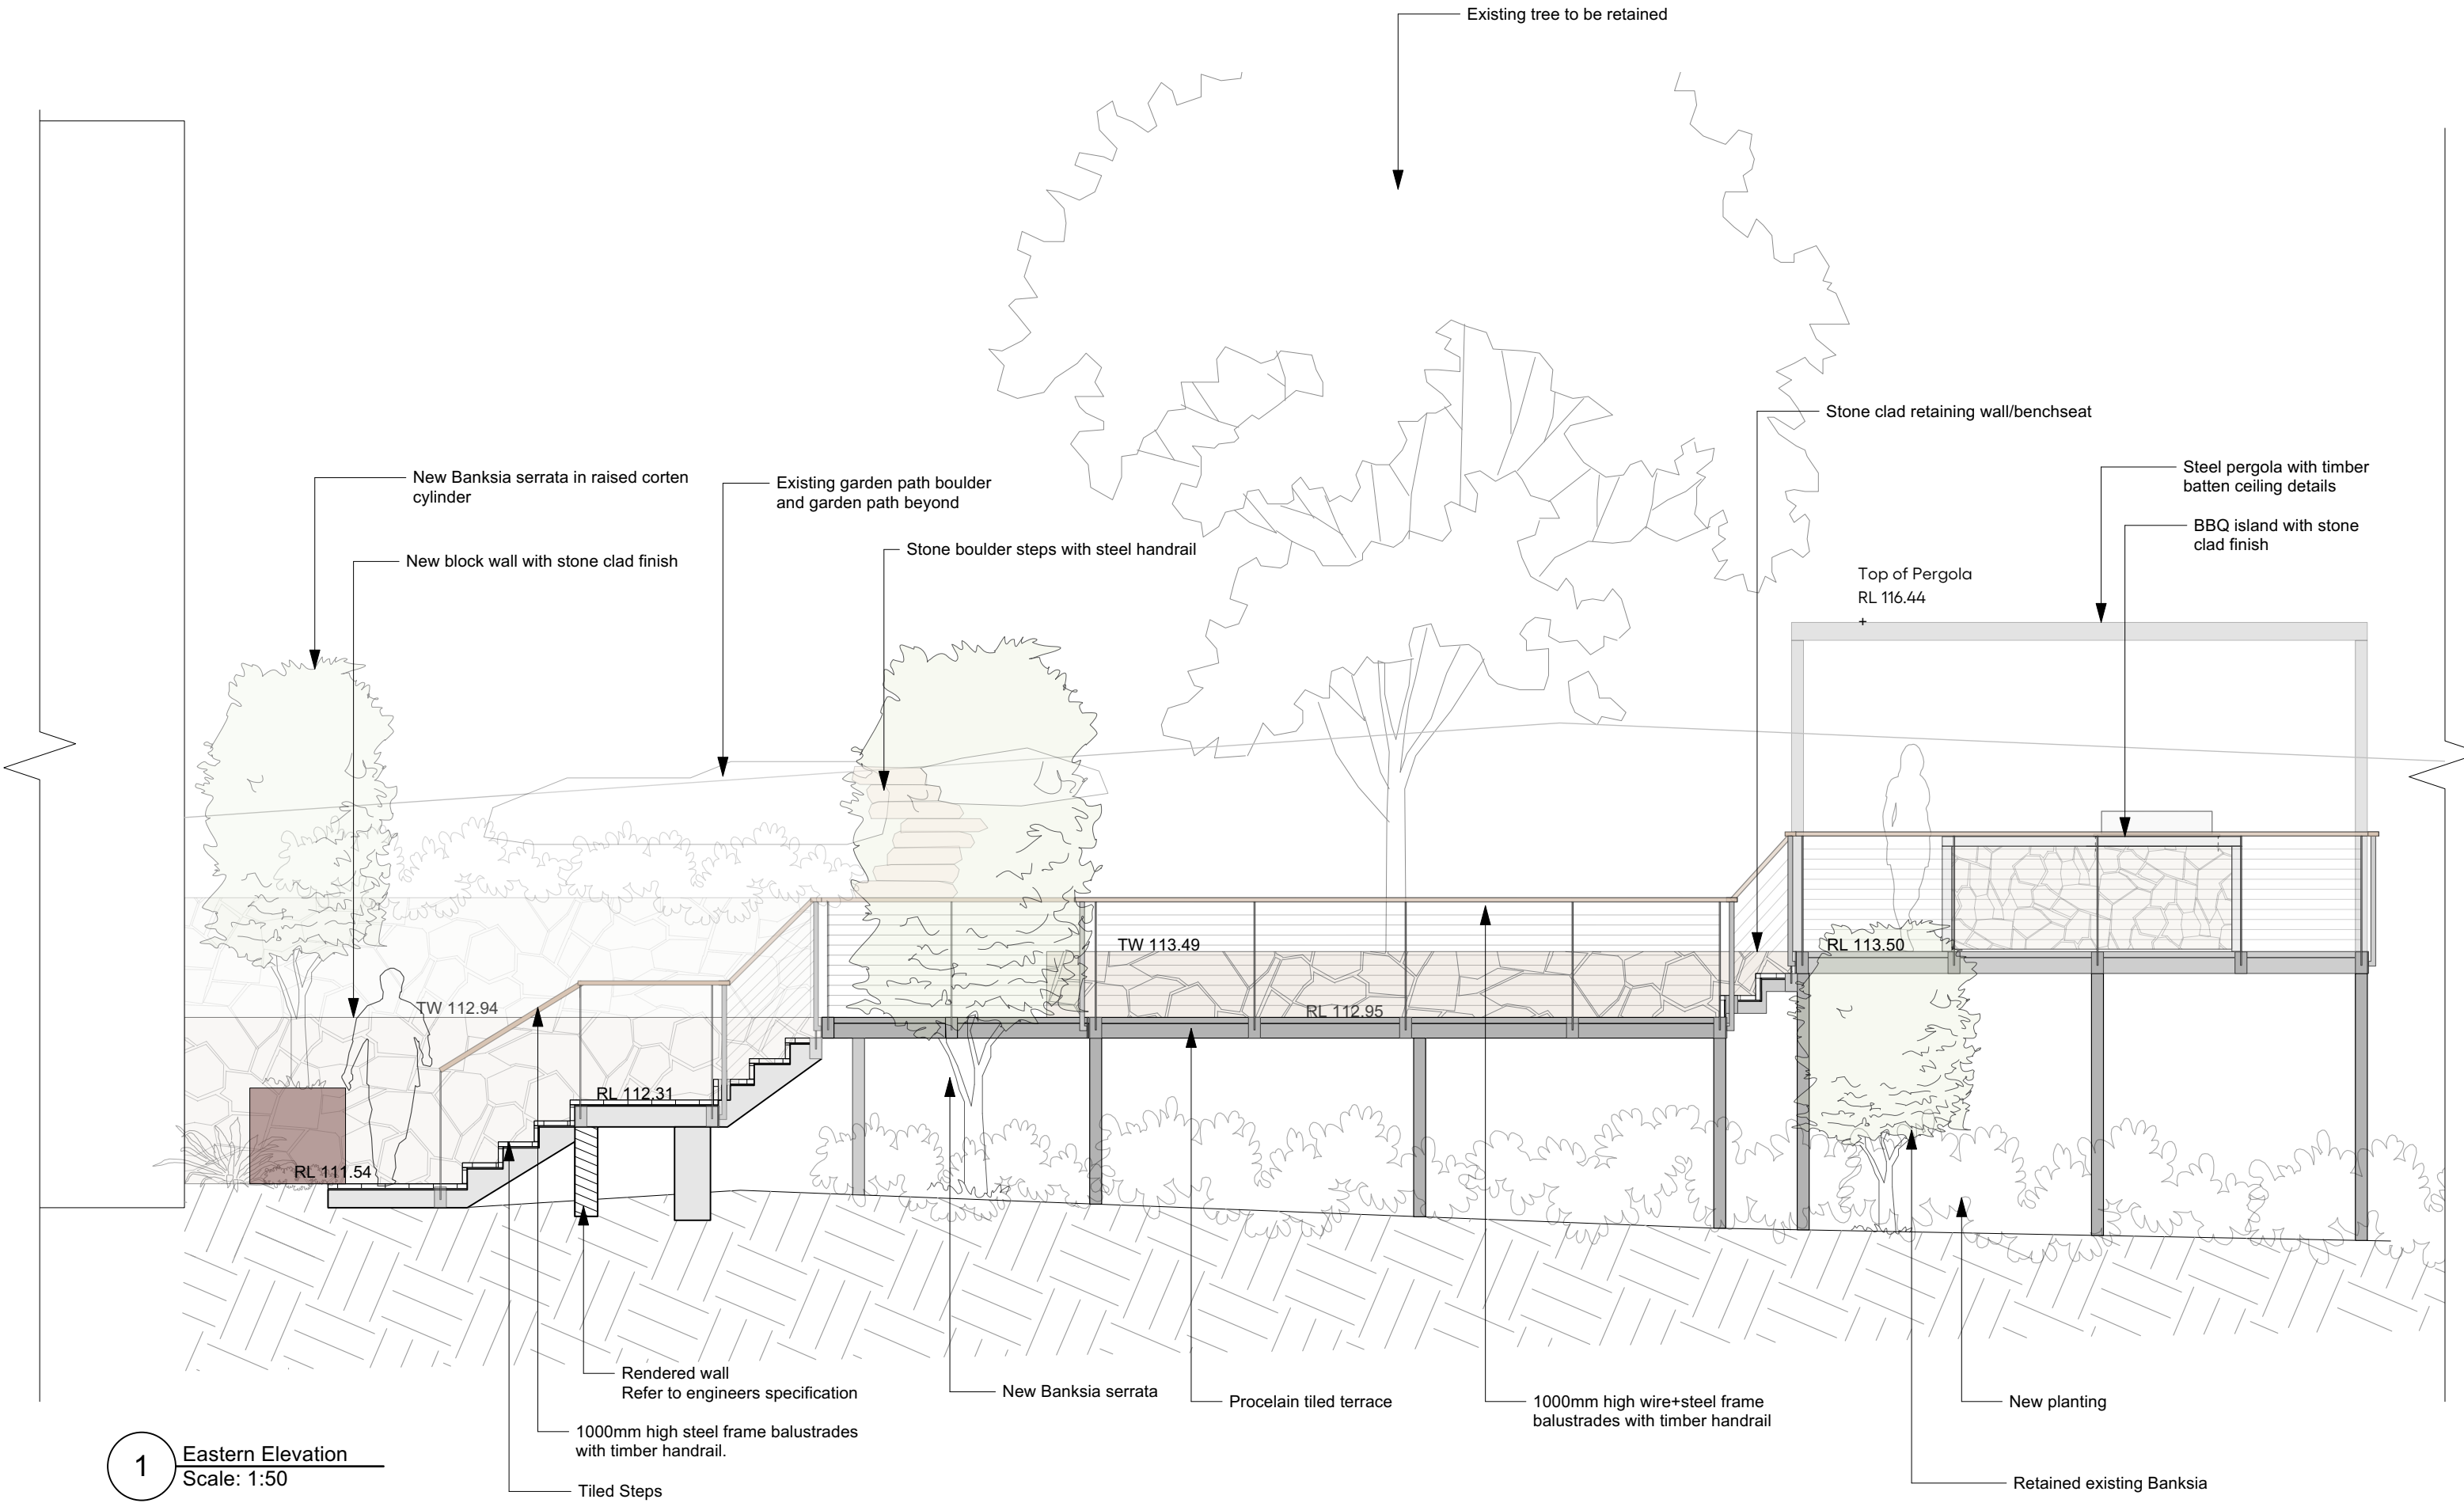

1 Eastern Elevation
Scale: 1:50

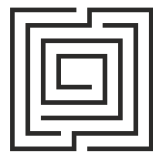

Secret Gardens

Landscape design, construction and maintenance | 17 Aylesbury Street, Botany NSW 2019
Phone 9314 5333 Fax 9314 5322

Secret Gardens retains intellectual property ownership, and moral rights are asserted.
Copyright 2023 Secret Gardens of Sydney Pty Ltd. This drawing, including plant graphics, is for design guidance only. All dimensions are to be verified with a site survey, and final details must meet site conditions, building standards and relevant authorities.

| Rev | Amendment | Date | By |
|-----|-----------|---------|----|
| A | As Built | 2/08/24 | CL |
| | | | |
| | | | |

ADDRESS
26 Lentara RD, Bayview NSW

SCALE
1:50

DATE
2/08/2024

DRAWN
NT

PROJECT
Bryan Residence

DWG. TITLE
EASTERN ELEVATION - AS BUILT

LD-31