

7 June 2018

Northern Beaches Council
PO Box 82
Manly NSW 1655

For the Attention of the Development Assessment Manager

Site: 46 Victoria Parade, Manly (SP10040)

Proposal: Section 4.56 Application to Modify a Development Consent (367/2010)

Activity: Residential Flat Building with Basement Level Parking

Subject: Traffic and Parking Statement

Introduction and Background

Consent was granted on 21 August 2014 for a Section 96AA Modification to Development Consent No. 367/2010 for the construction of a five (5) storey Residential Flat Building with basement level parking on the site at 46 Victoria Parade, Manly. Plans of the approved development are included for reference as **Attachment 1**.

Subsequent to this approval, necessary design modifications have resulted in some changes to the traffic elements of the scheme as previously approved.

InRoads Group was engaged to provide input into the design of the amended development scheme as shown in the drawings included **Attachment 2**, reviewing these plans against the approved development plans, as well as the requirements of the relevant design standards and planning controls.

The following sections document the results of our investigations addressing the following key traffic design elements and issues:

- On-site car parking provision;
- Vehicular access arrangements;
- Car park layout and design;
- Mechanical parking installation; and
- The traffic impact of the proposed development.

Subject Site and Adjacent Road Network

The subject site is located at 46 Victoria Parade, Manly, and is described as SP10040 (see **Figure 1** below). It is approximately 626m² in area, and is currently vacant. The site previously accommodated a 3-storey residential building containing six (6) units, with at-grade parking for eight (8) vehicles at the rear of the site.

The subject site has frontage to Victoria Parade to the north, and Dungowan Lane to the east.

Victoria Parade is a local road connecting East Esplanade with South Steyne. It has a two-way, two-lane undivided cross-section, and is restricted to a speed limit of 40km/hr as a high pedestrian activity area. 90 degree kerbside parking is provided on both sides of Victoria Parade clear of intersections and property access driveways.

Dungowan Lane is a one-way public laneway connecting from Ashburner Street to Victoria Parade (south to north), providing property access along its length. Dungowan Lane has a width of approximately 4m along the site frontage.



Figure 1: Subject Site

Source: Nearmap

Approved Development

The approved development is a 5-storey residential building comprising 13 dwelling units, including 6 x one-bedroom units, 6 x two-bedroom units, and 1 x three-bedroom unit, as shown in the approved plans included for reference as **Attachment 1**.

The approved development scheme provided a total of 21 parking spaces, including:

- Three (3) visitor parking spaces at-grade, in a 90-degree configuration off Dungowan Lane;
- 14 spaces within the mechanical parking installation (car stacker) in the basement;
- Two (2) standard parking spaces within the basement; and
- Two (2) accessible parking spaces within the basement.

Vehicular access to the basement under the approved scheme was via a single lane combined entry/exit ramp off Dungowan Lane, controlled by way of a traffic signal system with passive green for the entry movement (i.e. entering traffic given green priority, with all exiting traffic required to stop for a green signal before proceeding up the ramp, in order to minimise any potential for entry queues).

Amended Development Scheme

The scheme which is the subject of this Section 4.56 application is a 5-storey residential building comprising 11 dwelling units, including 5 x one-bedroom units, 3 x two-bedroom units, 2 x three-bedroom units and 1 x four-bedroom unit, as shown in the amended development plans included as **Attachment 2**. The development now proposed therefore comprises two (2) fewer units than the approved development scheme.

As shown in the drawings included as **Attachment 2**, the design of the amended scheme is largely consistent with the approved scheme from a traffic perspective, but includes some modifications to the parking arrangements which have been made as a result of design development.

The key traffic elements of amended scheme which is the subject of this Section 4.56 application are discussed in the following sections.

On-site Car Parking Provision

As shown in the drawings of the amended development scheme included as **Attachment 2**, the amended development scheme comprises a total of 22 parking spaces, including:

- Three (3) visitor parking spaces at-grade, in a 90-degree configuration off Dungowan Lane (consistent with the approved development scheme);
- 17 spaces within the mechanical parking installation (car stacker) in the basement; and
- Two (2) accessible parking spaces within the basement.

The amended development scheme therefore increases the on-site parking provision by one (1) space, whilst reducing the apartment yield by two (2) dwelling units, improving the level of on-site parking provision.

Notwithstanding the above, an assessment of the amended parking provision against the provisions of Council's Development Control Plan (DCP) has been undertaken. The proposed development is within the R3 Medium Density Residential Zone, therefore the applicable parking rates as outlined in Schedule 3 – Part A1 are as follows:

- 1 resident parking space for each dwelling (irrespective of number of bedrooms), plus
- 0.2 resident parking spaces for each 2 bedroom dwelling, plus
- 0.5 resident parking space for each 3 (or more) bedroom dwelling, and plus
- 0.25 visitor parking space for each dwelling (irrespective of number of bedrooms).

The application of the above parking rates to the proposed development yield (5 x one-bedroom units, 3 x two-bedroom units, and 3 x three and four-bedroom units) indicates that a minimum of 14 parking spaces for residents, and three (3) parking spaces for visitors, are required.

The amended development scheme provides 19 parking spaces for residents and three (3) parking spaces for visitors, and therefore complies with Council's DCP parking requirements. Furthermore, the amended development scheme increases the level of on-site parking provision when compared with the approved development scheme, and is therefore considered to represent an improvement on this basis.

In accordance with Condition 4 of Development Consent No. 367/2010, two (2) parking spaces for people with disabilities are proposed within the basement, in convenient proximity to the lift.

Vehicular Access Arrangements

As shown in the approved plans included for reference as **Attachment 1**, vehicular access to the basement under the approved scheme was via a single lane combined entry/exit ramp off Dungowan Lane. This ramp was to be controlled by way of a traffic signal system with passive green for the entry movement (i.e. entering traffic given green priority, and all exiting traffic required to stop for a green signal before proceeding up the ramp, in order to minimise any potential for entry queues).

As shown in the drawings of the amended development scheme included as **Attachment 2**, the access arrangement is generally consistent with the approved development scheme and the requirements of AS2890.1, comprising a single lane ramp which has a width of approximately 3.6m and which will be

adequate to accommodate the entry and exit manoeuvres of a B99 passenger vehicle as shown in the vehicle tracking diagrams included as **Attachment 3** (subject to minor refinement to the northern splay to better accommodate the exit movement of a large car).

The ramp has a small crest approximately 2m inside the property boundary as a result of flooding requirements. A vehicle seeking to exit the site onto Dungowan Lane (positioned inside the property boundary as shown in **Figure 1** below) would be sitting at a gradient of approximately 4% - 5, effectively meeting the requirement for pedestrian safety as stipulated in AS2890.1 (Clause 3.3(a)), which is a maximum gradient of 1:20 (5%) for a distance of 6m inside the property boundary.

In order to achieve satisfactory sight distance to pedestrians, sight splays of 2.5m (inside the property boundary) x 2.0m (along the boundary) should be provided on both sides of the ramp in accordance with Figure 3.3 of AS2890.1. It is anticipated that this requirement could reasonably be addressed at detailed design stage, in response to a condition of the consent.

Overall, the proposed access arrangements are consistent with the approved development, and generally consistent with the requirements stipulated in AS2890.1, subject to refinement at detailed design stage.

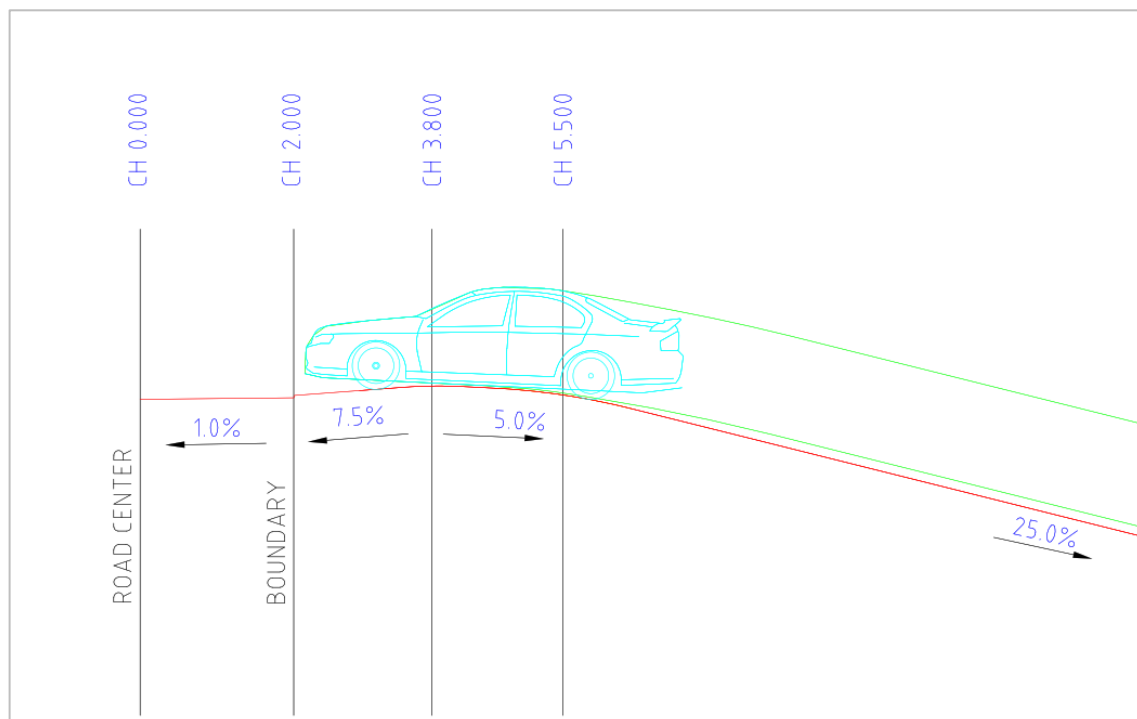


Figure 1: Gradient of Vehicle

Car Park Layout and Design

The modified site layout as shown in the plans included as **Attachment 2** is designed in accordance with the requirements of the relevant Australian Standards (AS2890.1 and AS2890.6), as summarised following:

- Standard parking spaces have minimum dimensions of 2.4m x 5.4m, which is acceptable for low turnover (residential) car parking, and consistent with the approved scheme;
- The ramp has a minimum width of 3.6m between kerbs, with an inside radius on the bend of 4m (with 0.3m clearance) and an outside radius of 7.6m (with 0.5m clearance) in accordance with Table 2.2 and Figure 2.9 in AS2890.1;
- The ramp has a maximum gradient of 1:4, which is acceptable for a ramp in a private car park under Clause 2.5.3 of AS2890.1. Transitions are proposed at the top and bottom of the ramp, and the results of the vertical clearance assessment undertaken by FJA Consulting Engineers (which are

included in **Attachment 4**) demonstrate that the proposed ramp profile should not result in vehicle underside scraping;

- The accessible parking spaces are 2.4m wide and 5.4m long with a 2.4m wide adjacent shared area, in accordance with the requirements of AS2890.6. A bollard (positioned 800mm back from the parking aisle) should be located within the shared area, to prevent vehicles from parking in this area.
- The parking spaces within the mechanical parking installation (car stacker) are 2.7m wide and 5.5m long, exceeding the minimum car parking dimensions in AS2890.1 (2.4m x 5.4m), but in accordance with advice provided by the supplier of the system (SAM Technology on behalf of Wohr);
- The parking aisles in the basement is approximately 6m wide minimum (measured to the fire stairs), which is marginally narrower than the width recommended in AS2890.1, which is 6.1m including 300mm clearance. However given the parking spaces within the car stacker are substantially wider than standard parking bays, the parking aisle width is adequate for manoeuvring into these spaces, as evidenced in the vehicle tracking diagrams included as **Attachment 5**;
- 300mm clearances are provided where parking spaces are adjacent to columns or vertical obstructions, to achieve the required clearance envelope as shown in Figure 5.2 of AS2890.1; and
- A 1m terminated aisle extension is provided at the end of the basement parking level in accordance with Figure 2.3 in AS2890.1, to accommodate manoeuvring to/from the end parking space.

Whilst the effective parking aisle width for the three (3) visitor parking bays on the ground level is less than that recommended in AS2890.1, the vehicle tracking diagrams included as **Attachment 6** demonstrate satisfactory manoeuvring to/from these spaces for a B85 passenger vehicle, subject to reverse entry to the bays (which could be signed accordingly).

Overall, the modified site layout as shown in the plans included as **Attachment 2** is generally consistent with the approved scheme, and is designed generally in accordance with the requirements of the relevant Australian Standards.

Mechanical Parking Installation

The proposed mechanical parking system is the Wohr Combilift 543-2, which is a compact and efficient parking system on three levels, with independent access to all spaces within the system.

The Wohr Combilift 543-2 system will accommodate 17 vehicles in a 6 x 3 grid arrangement, leaving one empty space to shuffle platforms to park and retrieve vehicles. The platforms at the entrance level will shift laterally by one space so that the empty space is above the lower level platform to be raised, or below the upper floor platform to be lowered.

The supplier advises that the operating speed of the system is approximately 1.8m per minute, therefore the wait time to park or retrieve a vehicle is generally no more than 1 – 2 minutes. The system can be operated via operation panel or remote control.

Specifications of the system are included for reference as **Attachment 7**, along with a statement from the supplier in relation to the popularity and reliability of the system. The Wohr Combilift 543-2 system is designed and manufactured in Germany, and maintenance by the supplier will be undertaken every 6 months under an ongoing maintenance program.

In summary, it is anticipated that the Wohr Combilift 543-2 mechanical parking installation will operate safely and effectively, whilst maximizing the on-site parking capacity at the development.

Traffic Impact of Proposal

The approved development comprised 13 units.

The development now proposed comprises 11 units, therefore is expected to generate a lower volume of traffic than the previously approved development, i.e. in the order of six (6) vehicle trips in the peak hours. This equates to one (1) vehicle trip per 10 minutes on average during the peak hours, which is clearly negligible from a traffic engineering and transport planning perspective.

Importantly, given the low volumes of traffic the development will generate, the frequency with which residents would be required to wait or queue to enter or exit the mechanical parking installation is expected to be extremely low, i.e. negligible.

Accordingly, and given the efficient basement car park design, and the approximately 20m queue storage from the basement car park to Dungowan Lane, the potential for any impact upon the adjacent road network due to the operation of the mechanical parking system is considered to be negligible.

Conclusion and Recommendation

In summary, the amended development scheme provides several improvements to the design of traffic elements, when compared with the previously approved scheme. The key improvements are as follows:

- Increased on-site parking provision;
- Improved vehicle manoeuvrability to/from the visitor car parking spaces accessed via Dungowan Lane (through recessing these spaces and increasing the effective aisle width);
- Refinement of positions and dimensions of parking spaces within the basement, to provide necessary clearances and improve vehicle manoeuvrability to/from the spaces;
- Refinement of mechanical parking installation arrangements, to provide clearances and improve vehicle manoeuvrability to/from the car stacker;
- Rationalisation of the accessible parking spaces, so the two (2) spaces proposed share the shared area, and are both in convenient proximity to the lift; and
- Removal of the parking space at the base of the ramp, immediately adjacent to the ramp, which would have been very difficult for a vehicle to access or egress.

On the basis of the above and the information provided herein, it is recommended that the Section 4.56 Application to Modify Development Consent 367/2010, in accordance with the drawings of the amended development scheme included as **Attachment 2**, be approved from a traffic engineering perspective.

We trust this information is of assistance. Should you have any queries regarding the above, please do not hesitate to contact the undersigned.

Regards,




Anne Coutts

Director, InRoads Group
BE (Civil) | MIEAust | MAITPM

Attachment 1

Approved Plans of Development

11/11/14

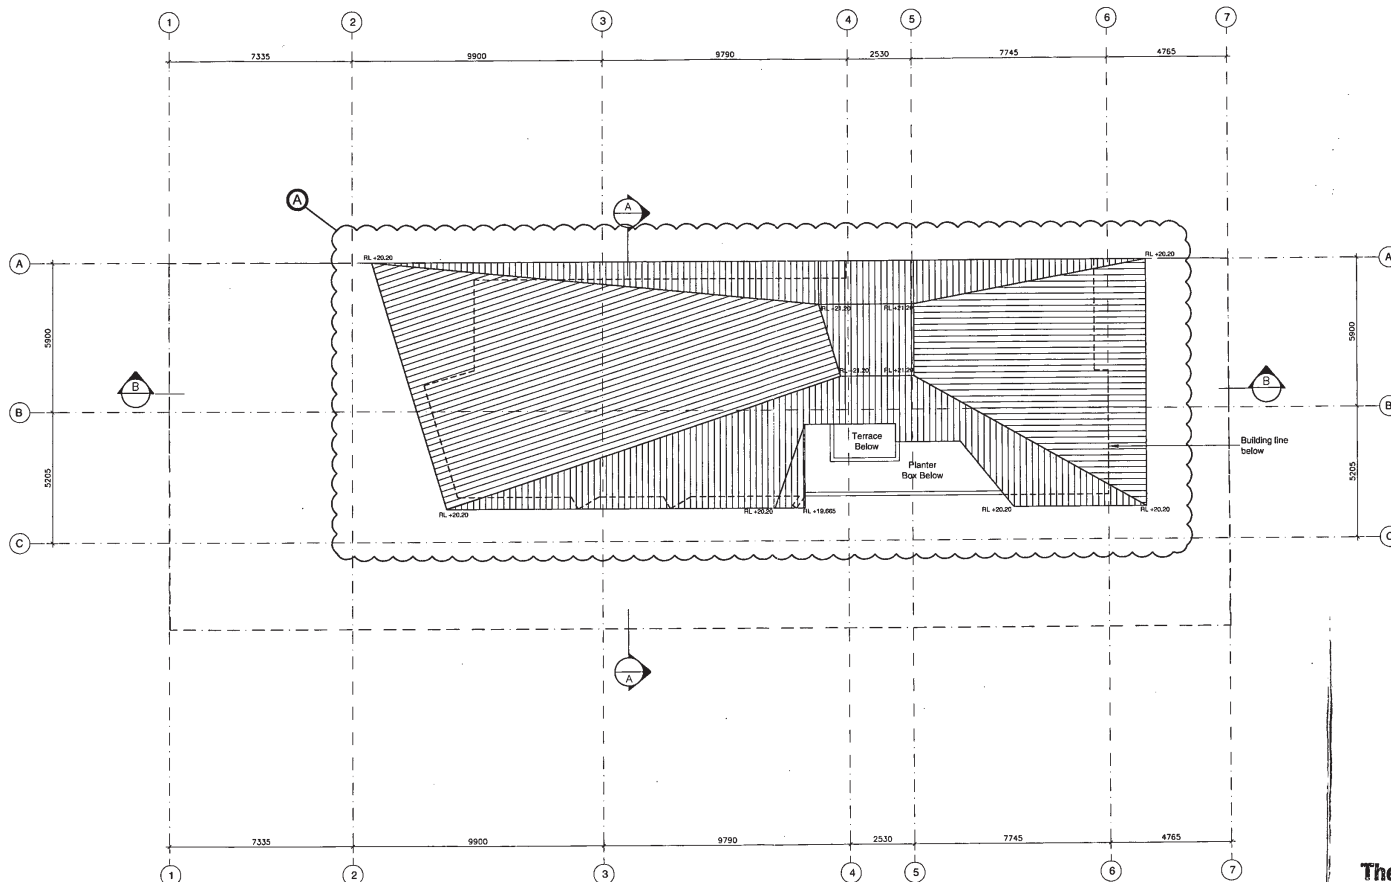

Determined by
Manly Independent
Assessment Panel

DA# 367/10 (S96)
Date: 21/8/14



These plans relate to Development

Consent No. 367/10-S96(AA)-PS
The plans are NOT for construction.

Roof Plan
1:200 (on A3)

REVISION	AMENDMENT	DATE	DRAWN
C	AMENDED IN RESPONSE TO COUNCIL FEEDBACK RECEIVED 26.05.14 & EMAIL DATED 27.05.14	28.05.14	JPB
B	AMENDED IN RESPONSE TO COUNCIL EMAIL CORRESPONDENCE DATED 02.05.14	19.05.14	JPB
A	ISSUED FOR SECTION 95 SUBMISSION	24.03.2014	NM

NOTE:
DESIGN CUBICLE PTY LTD IS A REGISTERED COMPANY UNDER THE NEW
ARCHITECTS REGISTRATION BOARD IN ACCORDANCE WITH SECTION 27
OF THE ARCHITECTS ACT 2003.
ALL DIMENSIONS AND LEVELS ARE TO BE CHECKED ON SITE, PRIOR TO THE
CONSTRUCTION OF WORK. DIMENSIONS ARE NOT TO BE SCALE. ALL DIMENSIONS
ARE GIVEN IN METERS.
THE DRAWING IS PART OF A SET AND MUST BE READ IN CONJUNCTION WITH ALL
OTHER DRAWINGS INCLUDING THE SHOP AND FINISH SCHEDULES TO NOT BE
USED IN ISOLATION.
DESIGN CUBICLE PTY LTD
44 Somers Street
North Manly NSW 151
Tel: 9683 2778
Fax: 9683 3242
Email: info@designcubicle.com.au
Web: www.designcubicle.com.au
ABN: 47 116 316 333



design cubicle
ARCHITECTURAL SOLUTIONS

Design Cubicle Pty Ltd
Address: 44 Somers Street
North Manly NSW 151
Tel: 9683 2778
Fax: 9683 3242
Email: info@designcubicle.com.au
Web: www.designcubicle.com.au
ABN: 47 116 316 333



SHEET TITLE
ROOF PLAN

LOCATED AT: MANLY COUNCIL

DRAWN BY:
NM
CHECKED BY:
FC
DATE:
DEC 12

PROPOSED RESIDENTIAL
DEVELOPMENT
46 VICTORIA PARADE
MANLY
JOB NO.
130526 S96:200

SCALE:
1:200



Manly Council

This plan is sheet of sheet/s referred to in Council's
Notice of Determination letter dated in respect
Of Development Application No. 357/10 - 396(AA) - Part 3.
Signed:

This plan is to be read in conjunction with conditions contained within the
Notice of Determination that may change the form of the development or the
manner in which the development proceeds.

These plans are not for construction. Where demolition, site works or
building works are proposed a Construction Certificate is to be obtained prior
to commencement of work.


A copy of the approved Development Application Plans and Construction
Certificate must be kept on site for the duration of the works.

RECEIVED

07 JUL 2014

BY:

11 AUG 14

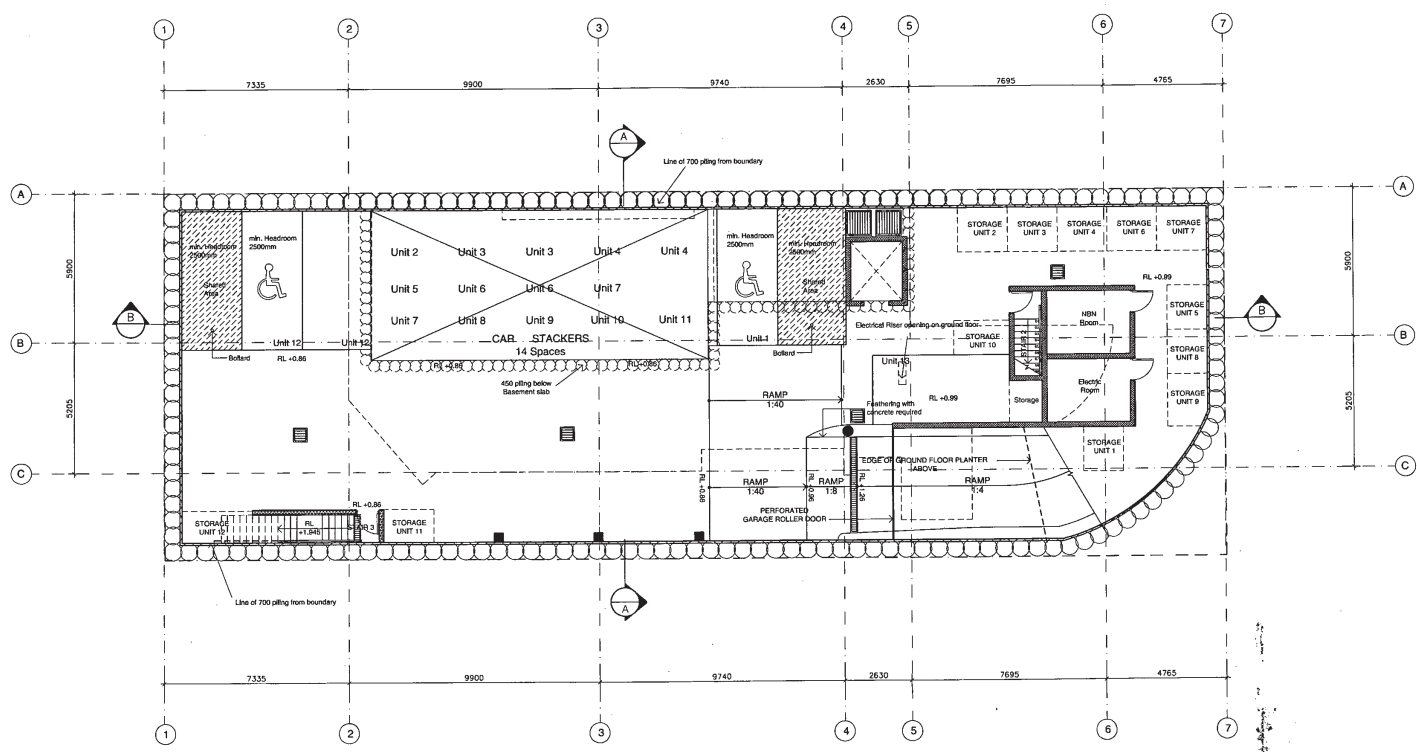


These plans relate to Development
 Consent No. 367/10-S96(AA) - P3
 The plans are NOT for construction.

Basement Plan
 1:200 (on A3)

--	--	
11A614

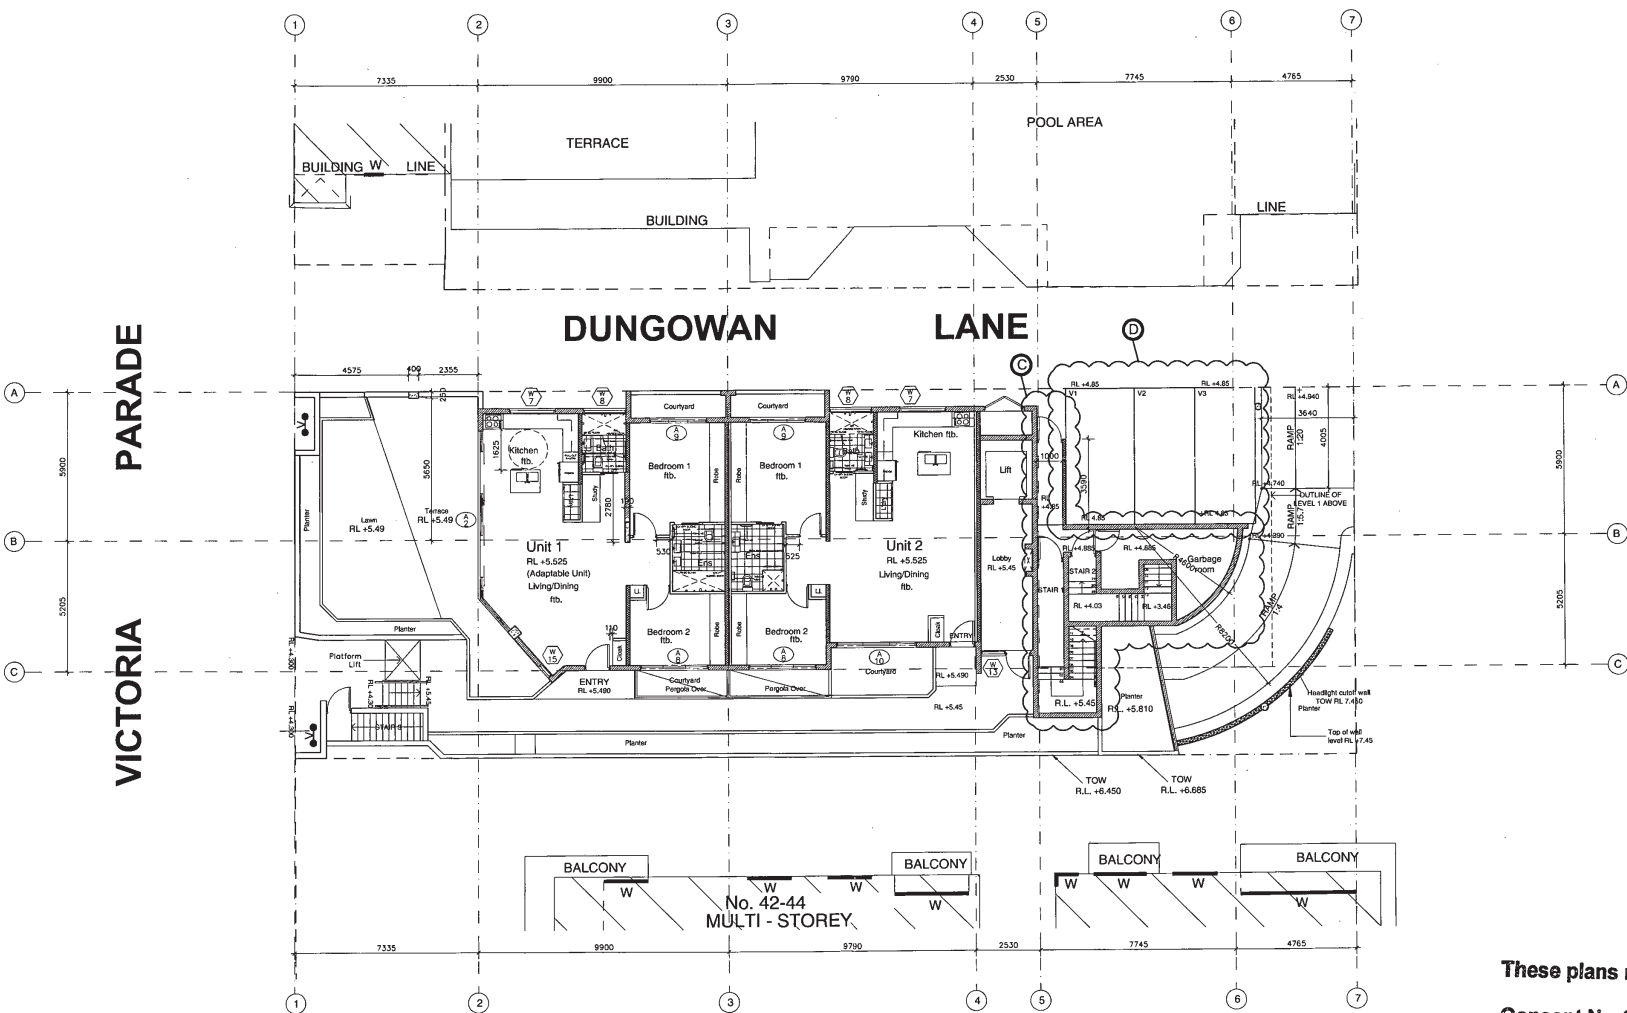


These plans relate to Development
Consent No. 367/10-S96(AA)-P3
The plans are NOT for construction.

Ground Floor Plan
1:200 (on A3)

ISSUE	AMENDMENT	DATE	DRAWN
B	AMENDED IN RESPONSE TO COUNCIL EMAIL CORRESPONDENCE DATED 02.05.14	18.05.14	JFB
A	ISSUED FOR SECTION 18 SUBMISSION	24.01.2014	HW

NOTE:
DESIGN CUBICLE PTY LTD IS A REGISTERED COMPANY UNDER THE NEW
ARCHITECTS REGISTRATION BOARD IN ACCORDANCE WITH SECTION 27
OF THE NEW ARCHITECTS ACT 1991.
ALL DIMENSIONS AND LEVELS ARE TO BE CHECKED ON SITE. PRIOR TO THE
CONSTRUCTION OF ANY WORK, DIMENSIONS AND LEVELS SHOULD BE CHECKED
AND RECORDED.
THE DRAWING IS PART OF A SET AND MUST BE READ IN CONJUNCTION WITH ALL
OTHER DOCUMENTS INCLUDING THE SHOP AND PERMITS SUBMITTED BY THE
DESIGNER TO THE COUNCIL.
DESIGN CUBICLE PTY LTD IS A REGISTERED COMPANY UNDER THE NEW
ARCHITECTS REGISTRATION BOARD IN ACCORDANCE WITH SECTION 27
OF THE NEW ARCHITECTS ACT 1991.

Design Cubicle Pty Ltd
Address: 44 Somers Street
North Parramatta 2151 NSW
Tel: 0683 2778
Fax: 0683 3242
Email: info@designcubicle.com.au
www.designcubicle.com.au
ABN: 47 116 316 333

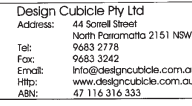


SHEET TITLE
GROUND FLOOR PLAN

DRAWN BY:
JAM
CHECKED BY:
FG
DATE:
DEC 12

PROPOSED RESIDENTIAL
DEVELOPMENT
46 VICTORIA PARADE
MANLY
JOB NO.
130526 S96:204

ISSUE:
B
SCALE:
1:200

M
11 AUG 14

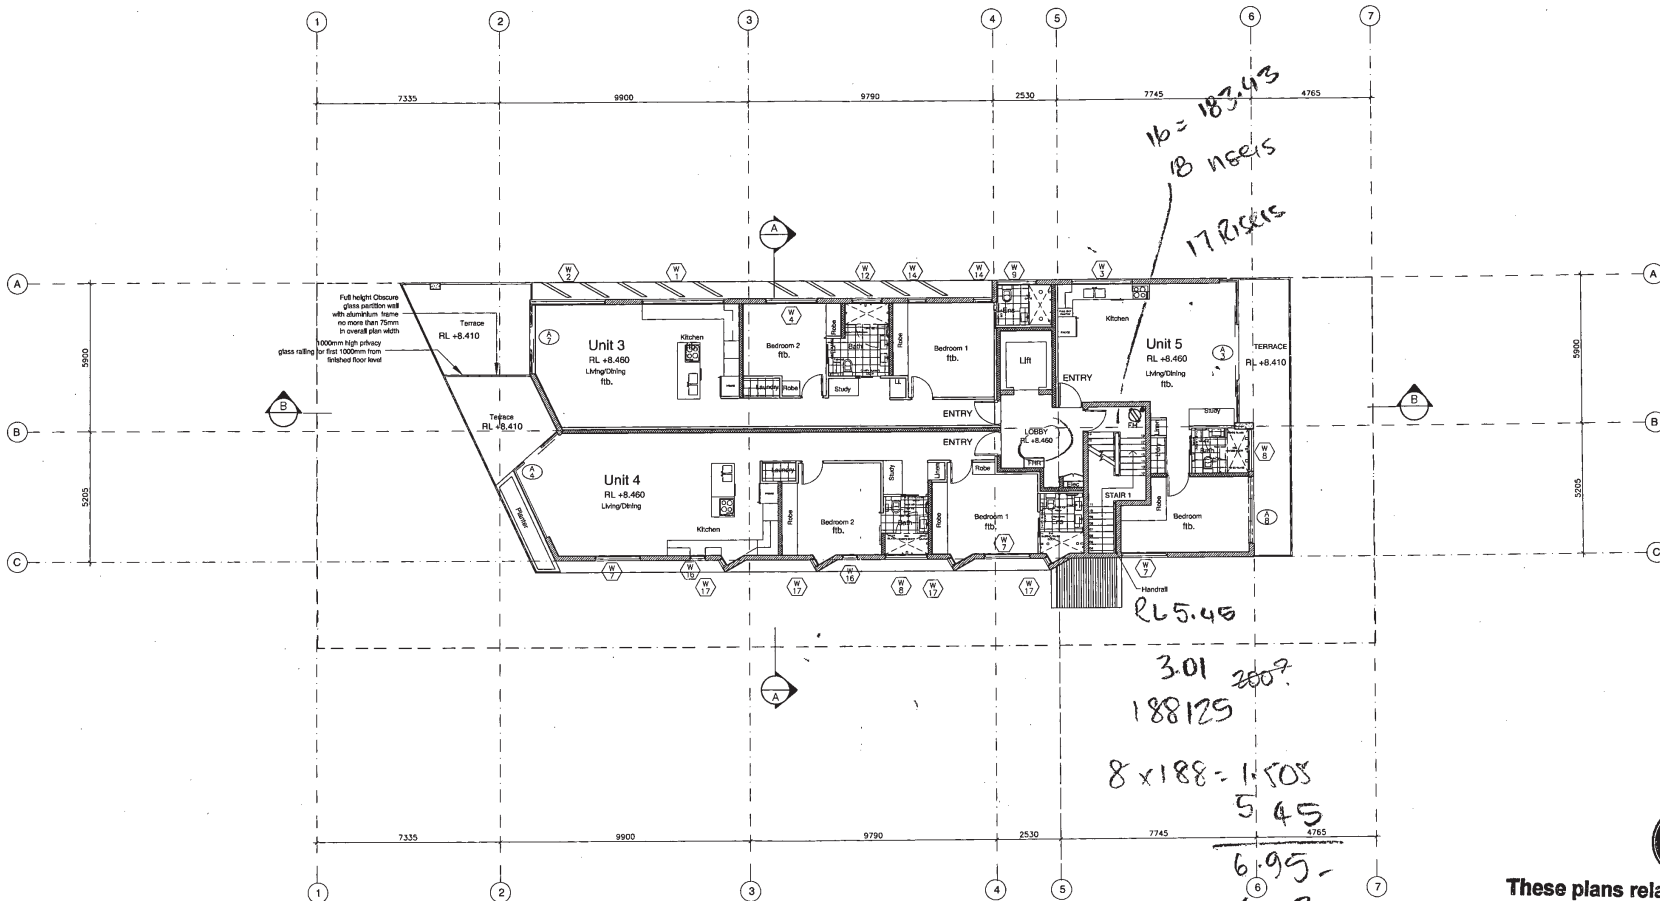

These plans relate to Development
Consent No. 367/10-S96(AA)-P3
The plans are NOT for construction.

First Floor Plan
 1:200 (on A3)

ISSUE	FOR SECTION 95 SUBMISSION	AMENDMENT	DATE	DRAWN
B	ISSUED FOR SECTION 95 SUBMISSION		01.07.14	JFB

NOTE:
 DESIGN CUBICLE PTY LTD IS A REGISTERED COMPANY UNDER THE NSW ARCHITECTS REGISTRATION BOARD IN ACCORDANCE WITH SECTION 27 OF THE NSW ARCHITECTS ACT 2002.
 ALL DIMENSIONS AND SPACES ARE TO BE CHECKED ON SITE, PRIOR TO THE COMMENCEMENT OF WORK. DIMENSIONS ARE NOT TO BE SCALE. THE ONLY TRUSTED DIMENSION IS THE DIMENSION ON SITE.
 THE DRAWING IS PART OF A SET AND MUST BE READ IN CONJUNCTION WITH ALL OTHER DOCUMENTS INCLUDING THE CONTRACT AND RELEVANT LEGISLATION. NO PART OF THIS DRAWING IS TO BE USED IN ANY OTHER PROJECT WITHOUT THE WRITTEN APPROVAL OF DESIGN CUBICLE PTY LTD.
 OFFICE OF THE STATE ARCHITECT IN THE DEPARTMENT OF HERITAGE AND ARCHITECTURE
 OFFICE OF THE STATE ARCHITECT IN THE DEPARTMENT OF HERITAGE AND ARCHITECTURE

design cubicle
 ARCHITECTURAL SOLUTIONS

Design Cubicle Pty Ltd
 Address: 44 Donald Street
 North Parramatta 2151 NSW
 Tel: 9683 2778
 Fax: 9683 3242
 Email: info@designcubicle.com.au
 Web: www.designcubicle.com.au
 ABN: 47 116 316 333



SHEET TITLE:
 FIRST FLOOR PLAN
LOANED AT:
 MANLY COUNCIL

DRAWN BY:
 AM
CHECKED BY:
 FG
DATE:
 DEC 12

PROPOSED RESIDENTIAL DEVELOPMENT
 46 VICTORIA PARADE
 MANLY
 130526 S96:208

ISSUE:
 B
SCALE:
 1:200

Full height Obscure glass partition wall with aluminium frame — no more than 15mm in overall glass width

1000mm high privacy glass or first 1000mm from finished floor level

Terrace RL +11.345

Unit 6
RL +11.395
Living/Dining ffb.

Kitchen ffb.

Bedroom 2 ffb.

Study ffb.

Bedroom 1 ffb.

Lift

ENTRY

Unit 7
RL +11.395
Living/Dining ffb.

Kitchen ffb.

Bedroom 2 ffb.

Study ffb.

Bedroom 1 ffb.

Lobby RL +11.395

ENTRY

Unit 8
RL +11.395
Living/Dining ffb.

Kitchen ffb.

Bedroom 2 ffb.

Study ffb.

Bedroom 1 ffb.

Lobby RL +11.395

ENTRY

Terrace RL +11.345

These plans are for information only and are not to be used for construction purposes.



These plans relate to Development
Consent No. 367/10-S76(AA)-P3
The plans are NOT for construction.

Second Floor Plan
1:200 (on A3)

B	ISSUED FOR SECTION 90 SUBMISSION	01.07.14	JFB
ISSUE	AMENDMENT	DATE	DRAWN

NOTE:
DESIGN CUBICLE PTY LTD IS A REGISTERED COMPANY UNDER THE NSW ARCHITECTS REGISTRATION BOARD IN ACCORDANCE WITH SECTION 27 OF THE NSW ARCHITECTS ACT 2001.
ALL DIMENSIONS AND LENGTHS ARE TO BE CHECKED ON SITE. PRIOR TO THE COMMENCEMENT OF WORK, DRAWINGS ARE NOT TO BE SEALED. USE ONLY REQUIRED DIMENSIONS.
THIS DRAWING IS PART OF A SET AND MUST BE READ IN CONJUNCTION WITH ALL OTHER DOCUMENTS INCLUDING THE DOOR AND FINISHES SCHEDULES. DO NOT USE THIS DRAWING IN ISOLATION.
REFERENCE TO THIS DRAWING IS THE COPYRIGHT OF DESIGN CUBICLE PTY LTD.
DESIGN CUBICLE PTY LTD
10/100, WILSONS LANE, WILSONS PROMENADE, SYDNEY, NSW 2030, AUSTRALIA
TEL: 02 9550 1000
WWW.DESIGNCUBICLE.COM.AU



design cubicle

Design Cubicle Pty Ltd
Address: 44 Sorell Street
North Parramatta 2151 NSW
Tel: 9683 2778
Fax: 9683 3242
Email: info@designcubicle.com.au
Http: www.designcubicle.com.au
ABN: 47 116 316 333



SHEET TITLE:
SECOND FLOOR PLAN

LOADED AT: MANLY COUNCIL

DRAWN BY:
NEM

CHECKED BY:
FG


DATE:
DEC 12

PROPOSED RESIDENTIAL
DEVELOPMENT
46 VICTORIA PARADE
MANTLY
200 No.
130526 S96:209

ISSUE:
B

SCALE:
1:200

11A06 14

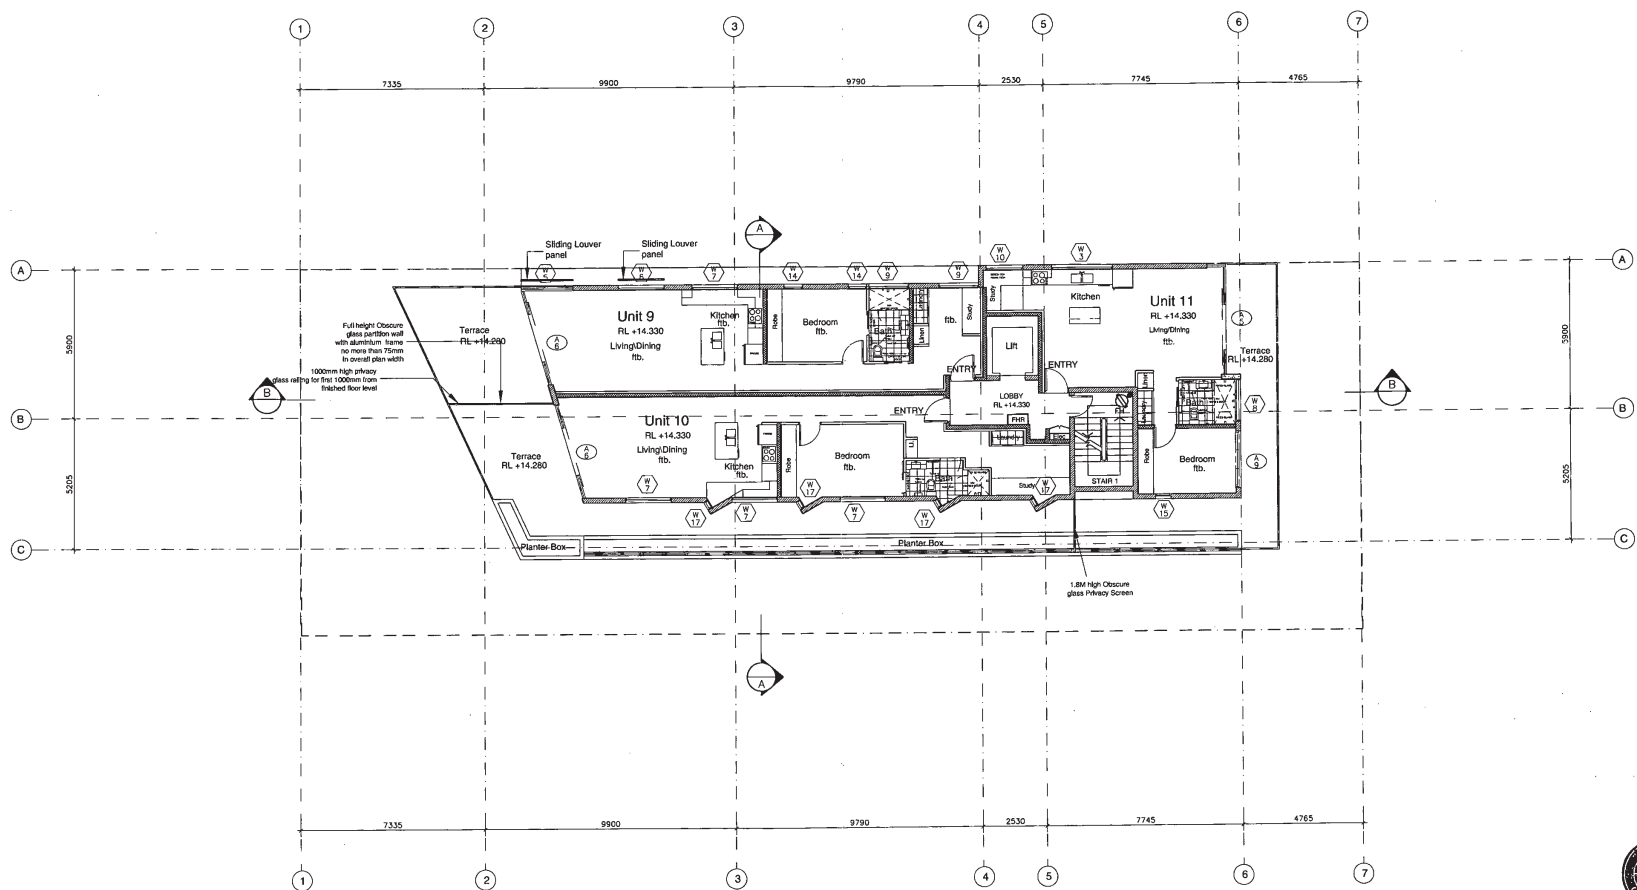

Third Floor Plan
1:200 (on A3)

These plans relate to Development
Consent No. 367/10-S96(AA)-P3
The plans are NOT for construction.

ISSUE	AMENDMENT	DATE	DRAWN
0	ISSUED FOR SECTION 90 SUBMISSION	01.07.14	JMB
1			
2			
3			

NOTE:
DESIGN CUBICLE PTY LTD IS A REGISTERED COMPANY UNDER THE NSW ARCHITECTS REGISTRATION BOARD IN ACCORDANCE WITH SECTION 27 OF THE NSW ARCHITECTS ACT 2002.
ALL DIMENSIONS AND LOCATIONS ARE TO BE CHECKED ON SITE. PRIOR TO THE COMMENCEMENT OF WORK, DIMENSIONS ARE TO BE CHECKED ON-SITE. DIMENSIONS TO BE CHECKED ON-SITE.
THIS DRAWING IS PART OF A SET AND MUST BE READ IN CONJUNCTION WITH ALL OTHER DRAWINGS INCLUDING THE SPEC AND FINISH SCHEDULES. DO NOT USE THIS DRAWING IN ISOLATION.
COPYRIGHT
NOTHING IN THIS DRAWING IS TO BE REPRODUCED OR TRANSMITTED IN ANY FORM OR BY ANY MEANS, ELECTRONIC OR MECHANICAL, INCLUDING PHOTOCOPYING, RECORDING, OR BY ANY INFORMATION STORAGE AND RETRIEVAL SYSTEM, WITHOUT PERMISSION IN WRITING FROM DESIGN CUBICLE PTY LTD.



Design Cubicle Pty Ltd
Address: 44 Somers Street
North Parramatta 2151 NSW
Tel: 9683 2778
Fax: 9683 3242
Email: info@designcubicle.com.au
Http: www.designcubicle.com.au
ABN: 47 116 316 333



SHEET TITLE:
THIRD FLOOR PLAN
LOADED BY: MANLY COUNCIL

DRAWN BY:
NM
CHECKED BY:
FO
DATE:
DEC 12

PROPOSED RESIDENTIAL
DEVELOPMENT
46 VICTORIA PARADE
MANLY
JOB NO:
130526 S96:210

ISSUE:
B
SCALE:
1:200

This architectural floor plan illustrates the layout of two adjacent residential units, Unit 12 and Unit 13, situated on a floor with a grid system (1-7 horizontally, A-C vertically). The plan includes the following details:


- Unit 12 (Adaptable Unit):** Located on the left, it features a Terrace (RL +17.215), Dining area, Living area, Kitchen, and three Bedrooms (Bedroom 1 cpt., Bedroom 3 cpt., and Bedroom cpt.). It also includes a Storage room, a central Hall, and a Bathroom.
- Unit 13:** Located on the right, it features a Terrace (RL +17.215), Living/Dining area, Kitchen, and two Bedrooms (Bedroom 1 ftb. and Bedroom 1 ftb.). It includes a central Hall, a Bathroom, and a Plantar Box.
- Common Areas:** A central Lobby (RL +17.265) contains a Lift and a Terrace. A shared Entry and Staircase are also shown.
- Structural and Environmental Features:** The plan shows various windows (W 1 through W 17), doors, and a Sliding Louver panel. It also indicates the 'LINE OF LEVEL 3 BELOW' and provides 'Access to Planter area to be for movable and maintenance only, see per condition 96 of DMS 9/10'.
- Dimensions:** Horizontal dimensions at the top and bottom are 7335, 9900, 9790, 2530, 7745, and 4785. Vertical dimensions on the left and right are 5900 and 5205.

B	ISSUED FOR SECTION 96 SUBMISSION	28.05.14	JFB
ISSUE	AMENDMENT	DATE	DRAWN

NOTE:
DESIGN CURELLI PTY LTD IS A REGISTERED COMPANY UNDER THE NEW
ARCHITECTS REGISTRATION BOARD IN ACCORDANCE WITH SECTION 27
OF THE NEW ARCHITECTS ACT 2003.
ALL CONDITIONS AND LEVELS ARE TO BE CHECKED ON SITE PRIOR TO THE
COMMENCEMENT OF WORK. DRAWINGS ARE NOT TO BE SEALED, USE ONLY PICTURED
DIMENSIONS.
THIS DRAWING IS PART OF A SET AND MUST BE READ IN COLLOCATION WITH ALL
OTHER DOCUMENTS INCLUDING THE ORDER AND FINISHES SCHEDULES. DO NOT USE
THIS DRAWING IN ISOLATION.
COPYRIGHT
INFORMATION ON THIS DRAWING IS THE COPYRIGHT OF DESIGN CURELLI PTY LTD
COPYING OF THIS DRAWING IN WHOLE OR IN PART WITHOUT WRITTEN PERMISSION FORFEITS COPYRIGHT



design cubicle
ARCHITECTURAL SOLUTIONS

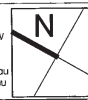


DRAWN BY: NM
CHECKED BY: FG
DATE: DEC 12


PROPOSED RESIDENTIAL
DEVELOPMENT
46 VICTORIA PARADE
MANLY
JOB No.
130526 S96:207

ISSUE: E
SCALE: 1:200

11 AUG 14

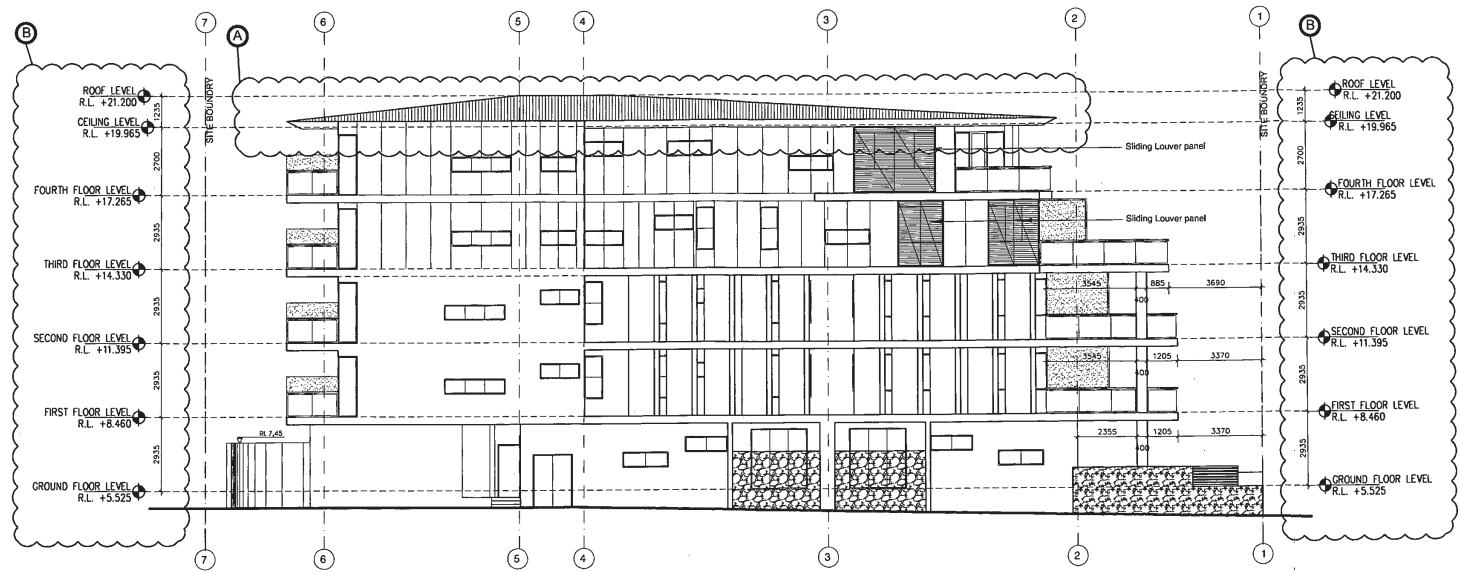

East Elevation
1:200 (on A3)

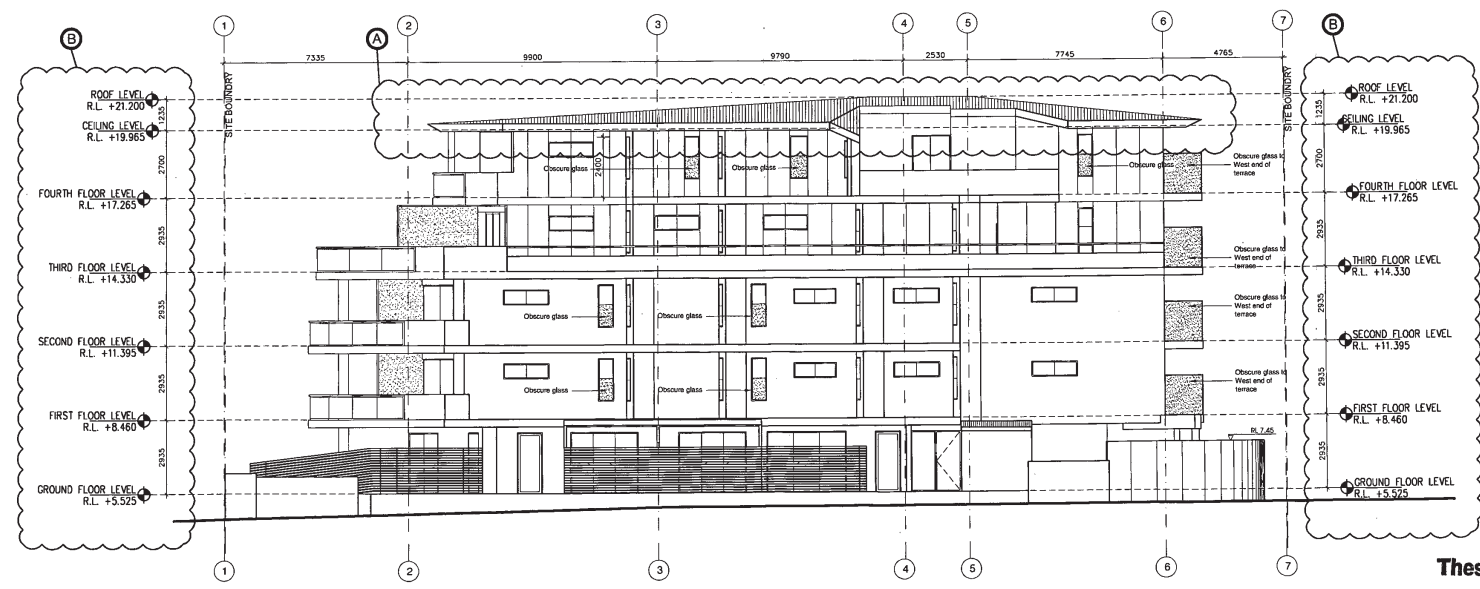

West Elevation
1:200 (on A3)




These plans relate to Development
Consent No. 367/16-996(AA)-P3
The plans are NOT for construction.

ISSUE	AMENDMENT	DATE	DRAWN
C	AMENDED IN RESPONSE TO COUNCIL FEEDBACK RECEIVED 26.05.14 IN EMAIL DATED 27.05.14	28.05.14	JFB
B	AMENDED IN RESPONSE TO COUNCIL EMAIL CORRESPONDENCE DATED 02.05.14	19.05.14	JFB
A	ISSUED FOR SECTION 96 SUBMISSION	24.01.2014	RAW

NOTE:
DESIGN CUBICLE PTY LTD IS A REGISTERED COMPANY UNDER THE 1991 ARCHITECTS REGISTRATION BOARD IN ACCORDANCE WITH SECTION 27 OF THE 1991 ARCHITECTS ACT 2001.
ALL INFORMATION AND DETAILS ARE TO BE CHECKED ON SITE. THIS IS THE RESPONSIBILITY OF THE ARCHITECT. THE ARCHITECT IS NOT RESPONSIBLE FOR THE CONSTRUCTION OF THE WORK. THE ARCHITECT IS NOT RESPONSIBLE FOR THE CONSTRUCTION OF THE WORK. THE ARCHITECT IS NOT RESPONSIBLE FOR THE CONSTRUCTION OF THE WORK.

DESIGN CUBICLE PTY LTD
444 Scrimm Street
North Parramatta 2151 NSW
Tel: 0683 2778
Fax: 0683 3242
Email: info@designcubicle.com.au
www.designcubicle.com.au
ABN: 47 116 316 333



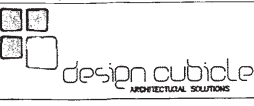


DESIGN CUBICLE PTY LTD
444 Scrimm Street
North Parramatta 2151 NSW
Tel: 0683 2778
Fax: 0683 3242
Email: info@designcubicle.com.au
www.designcubicle.com.au
ABN: 47 116 316 333

SHEET TITLE:
EAST ELEVATION
WEST ELEVATION
DRAWN BY:
RAW
CHECKED BY:
FC
DATE:
DEC 12
LOGGED BY:
MANLY COUNCIL

PROPOSED RESIDENTIAL
DEVELOPMENT
46 VICTORIA PARADE
MANLY
JFB:W
130526 S96:201
SCALE:
1:200

11 AUG 14

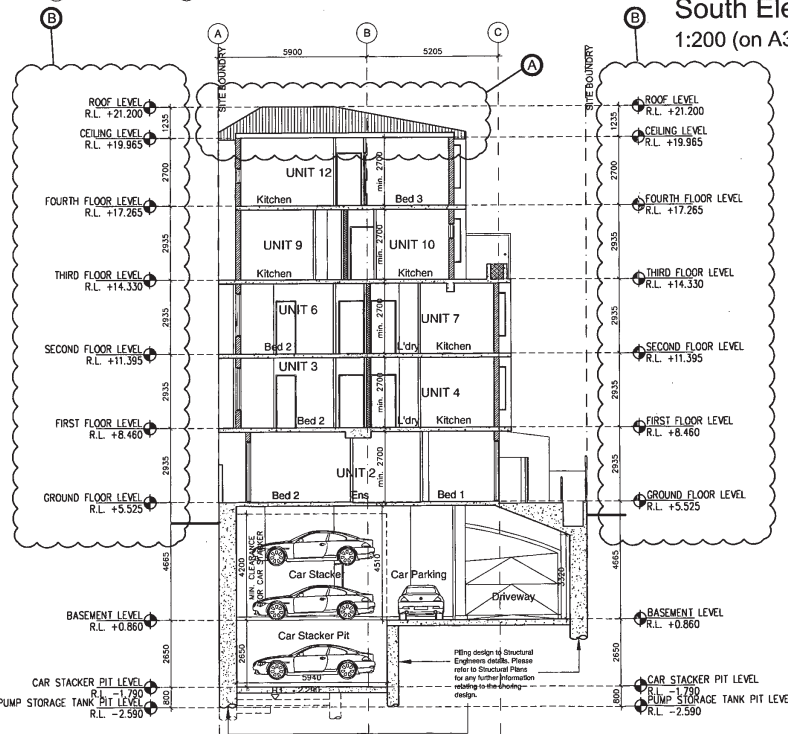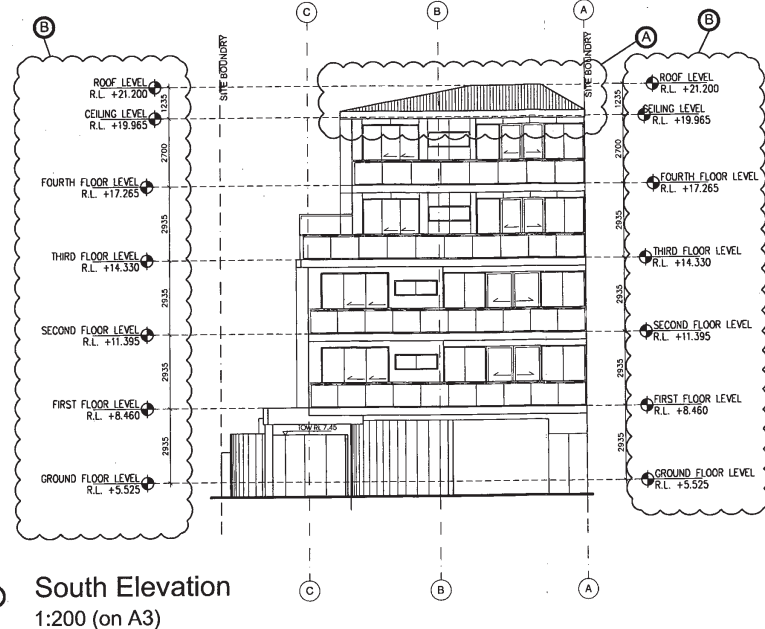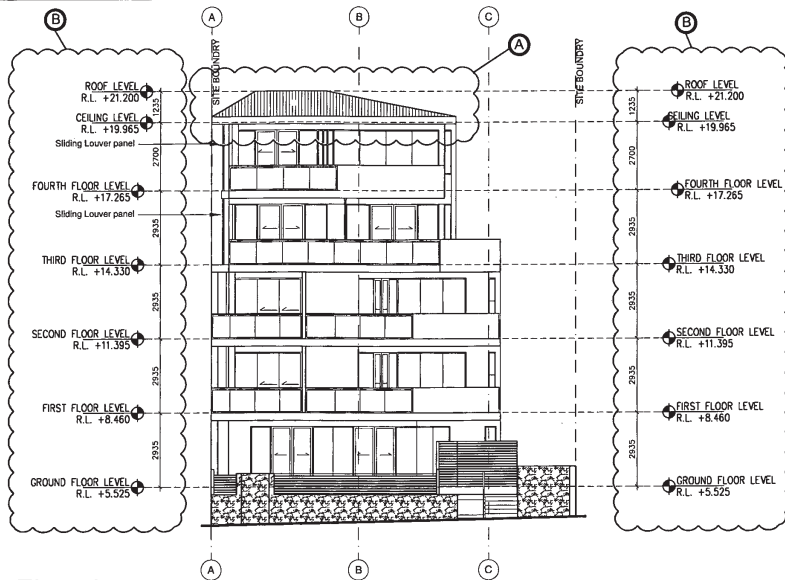

These plans relate to Development
 Consent No. 367/10-S96(AA)-P3
 The plans are NOT for construction.

ISSUE	AMENDMENT	DATE	DRAWN
C	AMENDED IN RESPONSE TO COUNCIL FEEDBACK RECEIVED 19.05.14 & EMAIL DATED 27.05.14	28.05.14	JFB
B	AMENDED IN RESPONSE TO COUNCIL EMAIL CORRESPONDENCE DATED 02.05.14	19.05.14	JFB
A	ISSUED FOR SECTION 95 SUBMISSION	24.01.2014	NA

NOTE:
 DESIGN CUBICLE PTY LTD IS A REGISTERED COMPANY UNDER THE NEW
 ARCHITECTS REGISTRATION BOARD IN ACCORDANCE WITH SECTION 27
 OF THE ARCHITECTS ACT 2003.
 ALL INFORMATION AND DETAILS ARE TO BE CHECKED ON SITE PRIOR TO THE
 COMMENCEMENT OF WORK. DESIGNER HAS NOT BEEN ADVISED OF ANY
 CHANGES TO THE DESIGN SINCE THE DATE OF THE DESIGN. THE DESIGNER
 HAS DRAWN A PART OF A SET AND MUST BE USED IN CONJUNCTION WITH ALL
 OTHER DOCUMENTS INCLUDING THE SPEC AND PERMITS DETAILED ON THE SET
 DRAWING IN ORDER.



design cubicle
 ARCHITECTURAL SOLUTIONS

Design Cubicle Pty Ltd
 Address: 44 Somers Street
 North Parramatta 2151 NSW
 Tel: 9683 3278
 Fax: 9683 3242
 Email: info@designcubicle.com.au
 Http: www.designcubicle.com.au
 ABN: 47 116 316 333


SHEET TITLE
 NORTH ELEVATION
 SOUTH ELEVATION
 SECTION AA
 LOGGED AT: MANLY COUNCIL

DRAWN BY:
 NA
 CHECKED BY:
 FG
 DATE:
 DEC 12


PROPOSED RESIDENTIAL
 DEVELOPMENT
 46 VICTORIA PARADE
 MANLY
 JOB NO.
 130526 S96: 202

SCALE:
 1:200


11 AUG 12

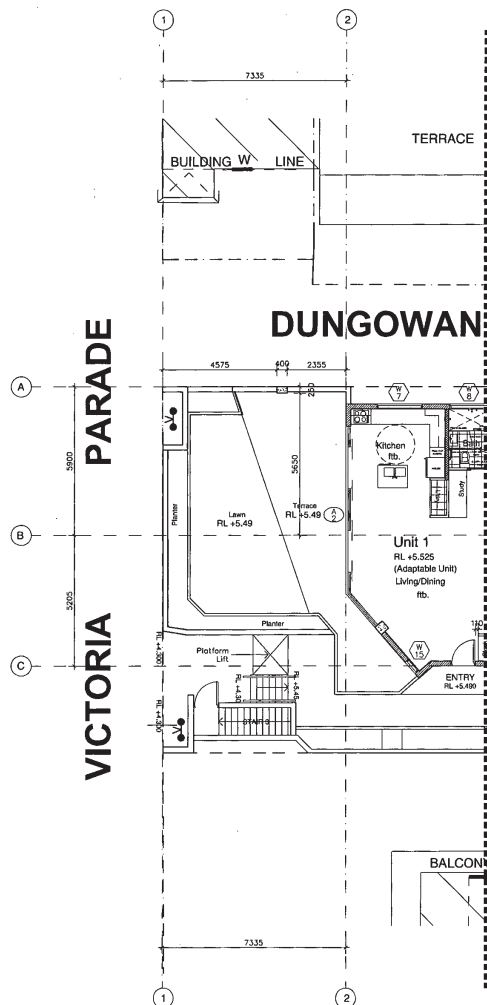

Partial Ground Floor Plan
External Column Location
1:200 (on A3)

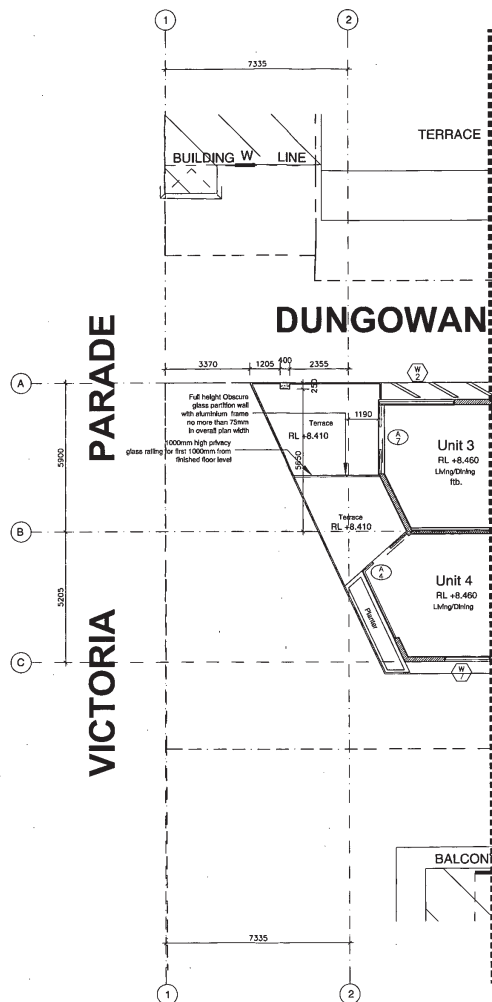

Partial First Floor Plan
External Column Location
1:200 (on A3)

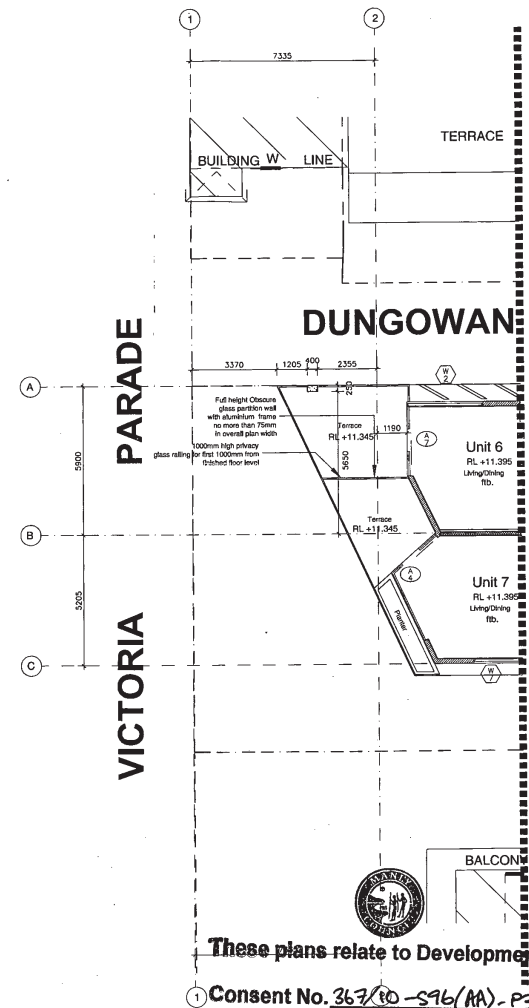

Partial Second Floor Plan
External Column Location
1:200 (on A3)

These plans relate to Development
Consent No. 367/10-S96/MA-P3
The plans are NOT for construction.

ISSUE	DESCRIPTION	DATE	DRAWN
1	ISSUED FOR SECTION 10 SUBMISSION	19.05.2014	JMB
2	AMENDMENT		

NOTE:
DESIGN CUBICLE PTY LTD IS A REGISTERED COMPANY UNDER THE NEW
ARCHITECTS REGISTRATION BOARD IN ACCORDANCE WITH SECTION 27
OF THE NEW ARCHITECTS ACT 2011.
ALL DIMENSIONS AND LEVELS ARE TO BE CHECKED ON SITE. FROM THE
COMPLETION OF WORK, DIMENSIONS ARE NOT TO BE SCALE. USE ONLY FOUR
DIMENSIONS.
THIS DRAWING IS PART OF A SET AND MUST BE READ IN CONJUNCTION WITH ALL
OTHER DRAWINGS RELATING TO THE WORK AND TYPED OR PRINTED BY THE
DESIGNER OR ARCHITECT.

design cubicle
ARCHITECTURAL SOLUTIONS

Design Cubicle Pty Ltd
Address: 44 Small Street
North Parramatta 2151 NSW
0683 2778
0683 3242
Email: info@designcubicle.com.au
www.designcubicle.com.au
ABN: 47 116 316 333



SHEET TITLE:
PARTIAL FLOOR PLANS -
EXTERNAL COLUMN
LOCATION
LOBBY: MANLY COUNCIL


DRAWN BY:
NM
CHECKED BY:
FC
DATE:
DEC 12

PROPOSED RESIDENTIAL
DEVELOPMENT
46 VICTORIA PARADE
MANLY
JOB NO:
130526 S96:205

ISSUE:
B
SCALE:
1:200


LANDSCAPE PLAN-GROUND FLOOR

Scale: 1:100@A2

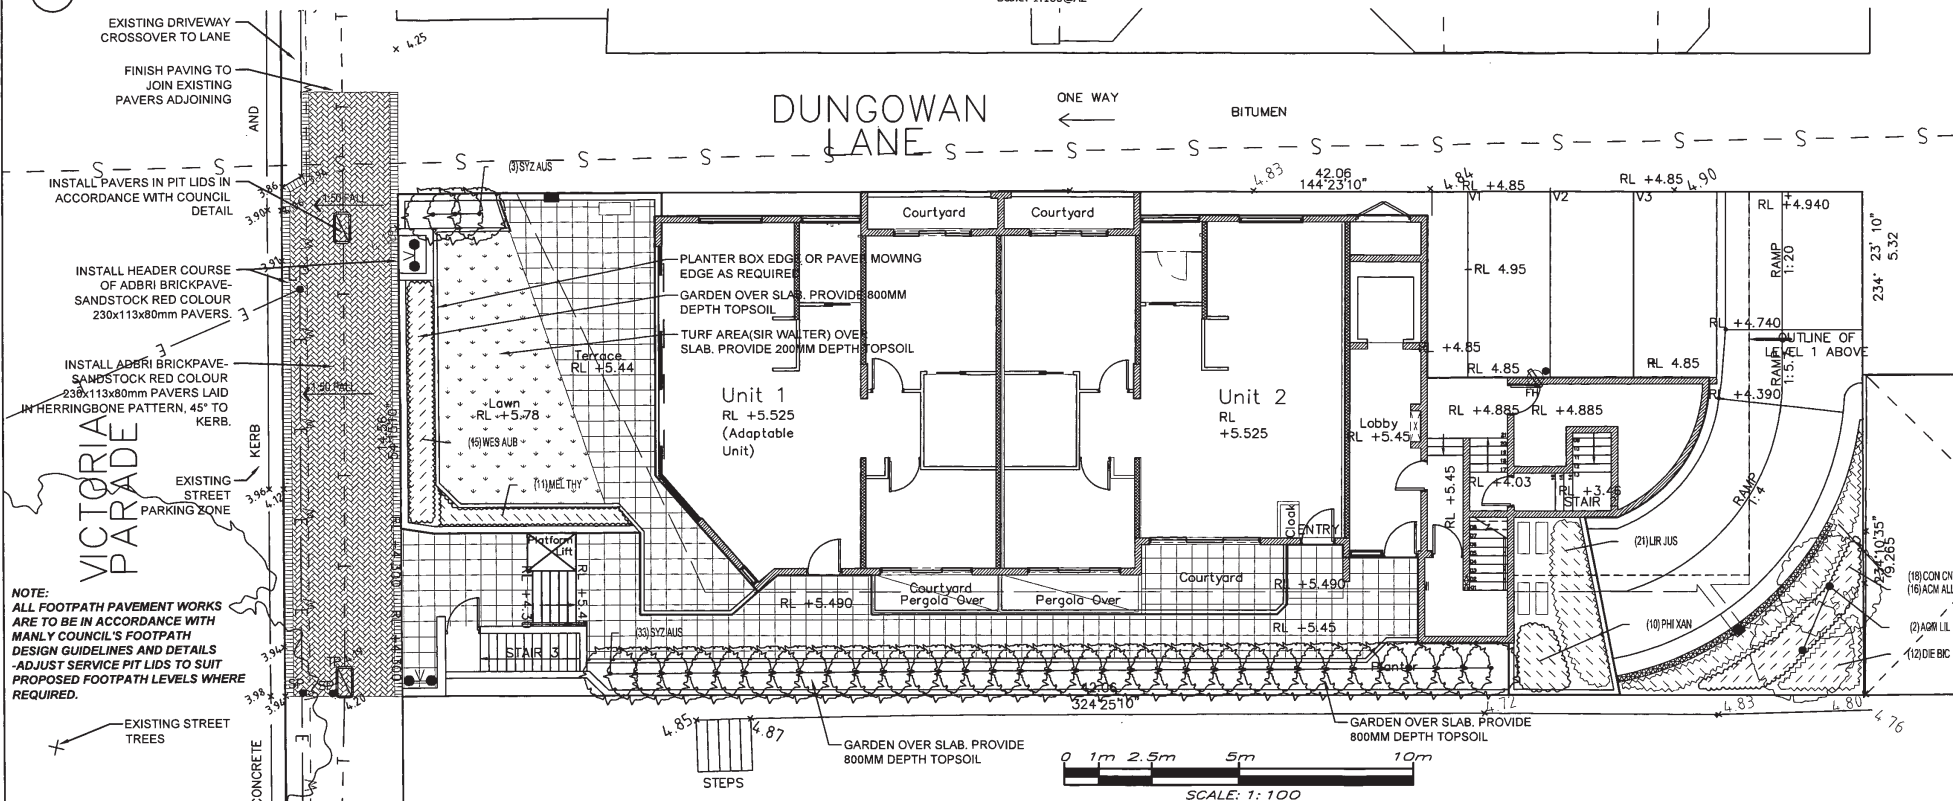

NOTE:
ALL FOOTPATH PAVEMENT WORKS
ARE TO BE IN ACCORDANCE WITH
MANLY COUNCIL'S FOOTPATH
DESIGN GUIDELINES AND DETAILS
-ADJUST SERVICE PIT LIDS TO SUIT
PROPOSED FOOTPATH LEVELS WHERE
REQUIRED.

KEY TO PLAN:

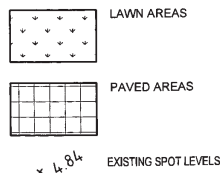

PLANT SCHEDULE

TREES	BOTANICAL NAME / COMMON NAME	CONT	QTY	
ACM LIL	ACMENA SUBLIME / SUBLIME	25L	2	
PALM TREES	BOTANICAL NAME / COMMON NAME	CONT	QTY	
RHA EXC	RHAPIS EXCELSA / LADY PALM	300MM	3	
SHRUBS	BOTANICAL NAME / COMMON NAME	CONT	QTY	
SYZ AUS	SYZYGIVUM AUSTRALE "RESILIENCE" / RESILIENCE BRUSH CHERRY	200MM	36	
SHRUB AREAS	BOTANICAL NAME / COMMON NAME	CONT	DENSITY	QTY
ACM ALL	ACMENA SMITHII "ALLYN MAGIC" / DWARF LILLY PILLY	200 MM	4/m²	16
ASP ELA	ASPIDISTRA ELATIOR / CAST IRON PLANT	200 MM	5/m²	18
MEL THY	MELALEUCA THYMIFOLIA / THYME HONEY-MYRTLE	200 MM	4/m²	11
PHI XAN	PHILODENDRON X "XANADU" / PHILODENDRON	200 MM	5/m²	10
RUS EQU	RUSSELLIA EQUESTIFORMIS / FIRECRACKER PLANT	200 MM	4/m²	12
WES AUB	WESTRINGIA AUSSIE BOX / AUSSIE BOX WESTRINGIA	200 MM	4/m²	15
GROUND COVERS	BOTANICAL NAME / COMMON NAME	CONT	DENSITY	QTY
CLU MIT	CLIVIA MINIATA / KAFFIR LILLY	140 MM	5/m²	9
CON CNE	CONVOLVULUS CNEORUM / BUSH MORNING GLORY	140 MM	4/m²	18
DIE BIC	DIETES BICOLOR / FORTNIGHT LILY	140 MM	5/m²	12
LIR JUS	LIRIOPE MUSCARI "JUST RIGHT" / JUST RIGHT LIRIOPE	140 MM	5/m²	26



These plans relate to Development

Consent No. 367/10-596(AA) - PS

The plans are NOT for construction.

MARK BALDOCK
LANDSCAPE ARCHITECT
(B App.Sc.Blt.Env. Grad.Dip.Lands Arch.)
PO Box 373, Annerley Qld 4103

Tel: (07) 38488436
Fax: (07) 38923575
Mob: (0407) 114 605
Email: baldock@bigpond.net.au

CLIENT:
**NORTHWEST MANAGEMENT
SERVICES PTY LTD**

DRAWING TITLE
**LANDSCAPE PLAN
-GROUND LEVEL**


PROJECT DETAILS:
**46 VICTORIA PARADE,
MANLY NSW 2095**

DRAWING NUMBER:
1304-LP1
CURRENT ISSUE:
G

DATE:
January 14
PROJECT NO:
1304


LANDSCAPE PLAN-LEVEL 1

Scale: 1:100@A2

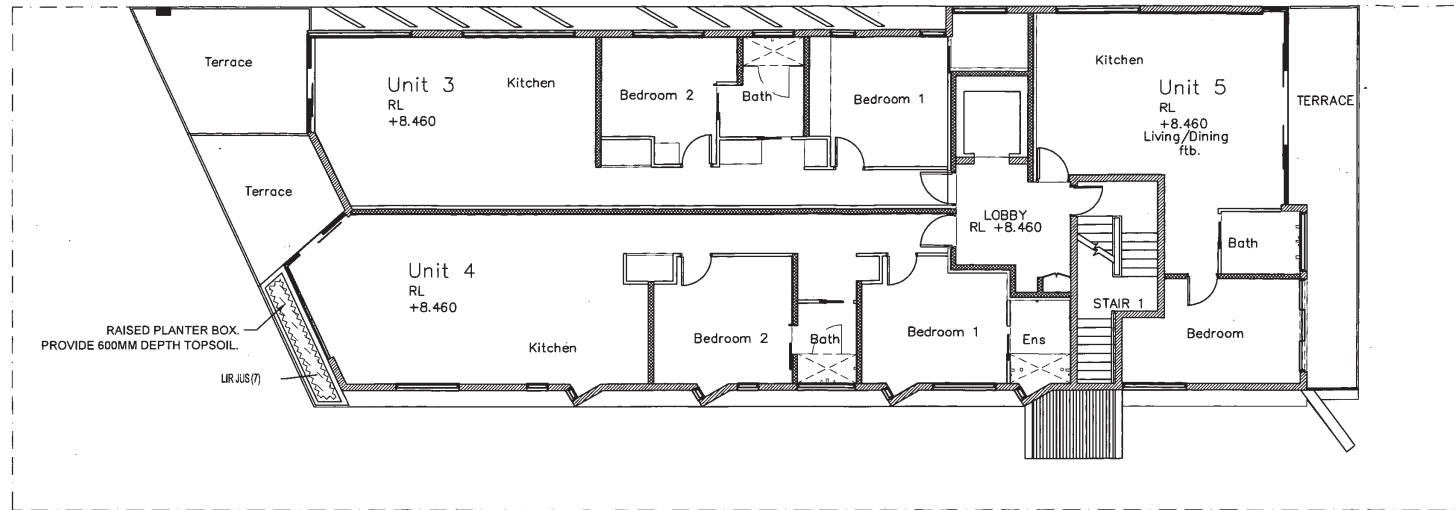


LANDSCAPE PLAN-LEVEL 2

Scale: 1:100@A2

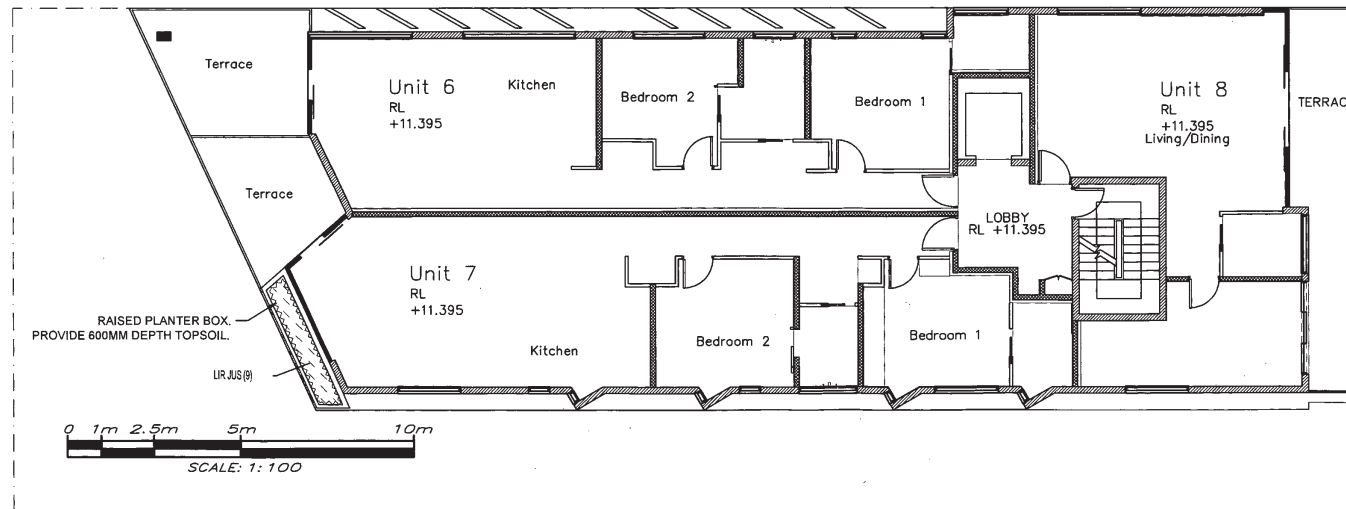

KEY TO PLAN:

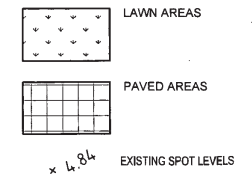

These plans relate to Development

Consent No. 367/10-S96(AA)-P3
The plans are NOT for construction.

MARK BALDOCK
LANDSCAPE ARCHITECT
(B.App.Sc.Blt.Env, Grad.Dip.Lands.Arch.)
PO Box 373, Annerley Qld 4103

Tel: (07) 38488436
Fax: (07) 38923575
Mob: (0407) 114 605
Email: baldock@bigpond.net.au

CLIENT:
**NORTHWEST MANAGEMENT
SERVICES PTY LTD**

DRAWING TITLE
**LANDSCAPE PLAN
-LEVEL 1, 2**

PROJECT DETAILS:
**46 VICTORIA PARADE,
MANLY NSW 2095**

DRAWING NUMBER:
1304-LP2
CURRENT ISSUE:
G




DATE:
January 14
PROJECT NO:
1304

AL
11 AUG 14


LANDSCAPE PLAN-LEVEL 3

Scale: 1:100@A2

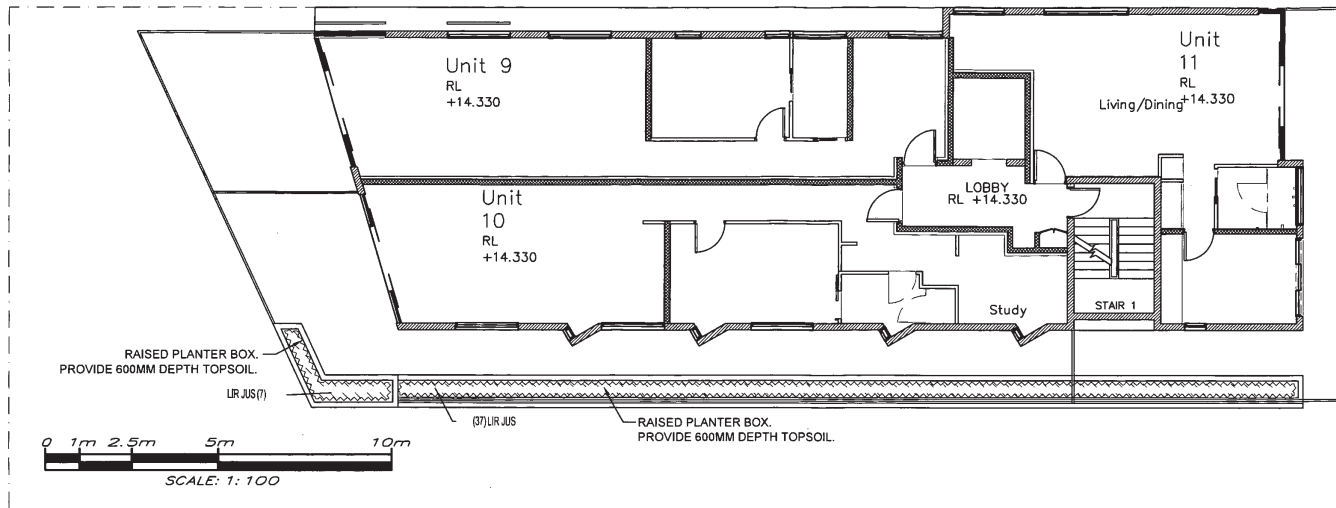

LANDSCAPE PLAN-LEVEL 4

Scale: 1:100@A2

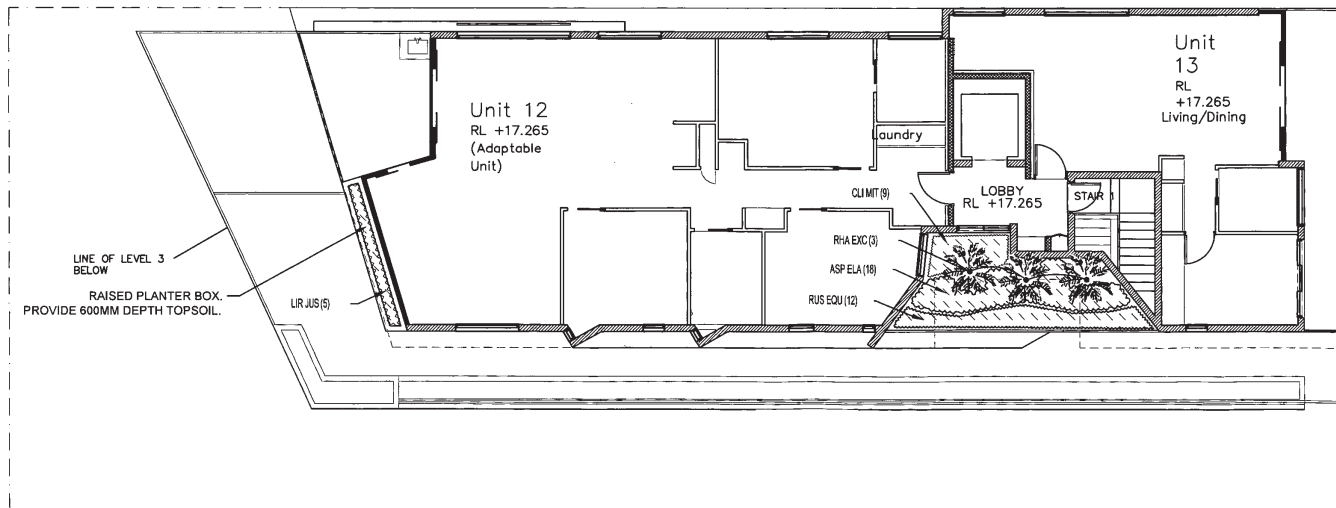

These plans relate to Development
Consent No. 36710-S94(AA)-P3
The plans are NOT for construction.

MARK BALDOCK
LANDSCAPE ARCHITECT
(B.App.Sc.Blt.Env, Grad.Dip.Lands.Arch.)
PO Box 373, Annerley Qld 4103

Tel: (07) 38488436
Fax: (07) 38923575
Mob: (0407) 114 605
Email: baldock@bigpond.net.au

CLIENT:
**NORTHWEST MANAGEMENT
SERVICES PTY LTD**


DRAWING TITLE
**LANDSCAPE PLAN
-LEVEL 1, 2**

PROJECT DETAILS:
**46 VICTORIA PARADE,
MANLY NSW 2095**


DRAWING NUMBER:
1304-LP3
CURRENT ISSUE:
G



DATE:
January 14
PROJECT NO:
1304

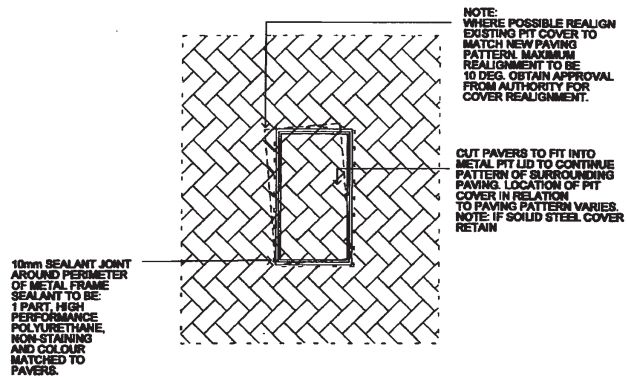

Plan 1:20

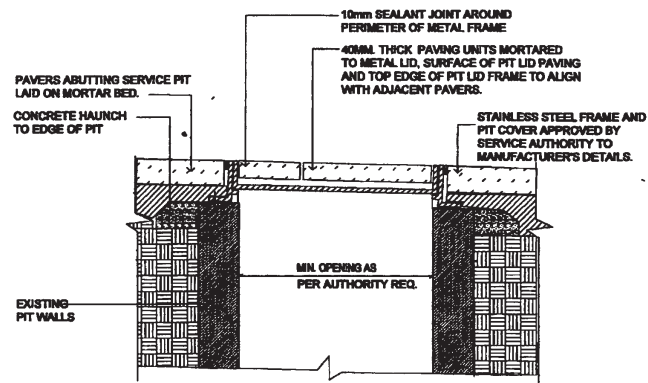


Section 1:10

TYPICAL SERVICE PIT COVER (TWO PART COVER SIMILAR)


MANLY COUNCIL

PAVING DESIGN GUIDELINES

NOT TO SCALE

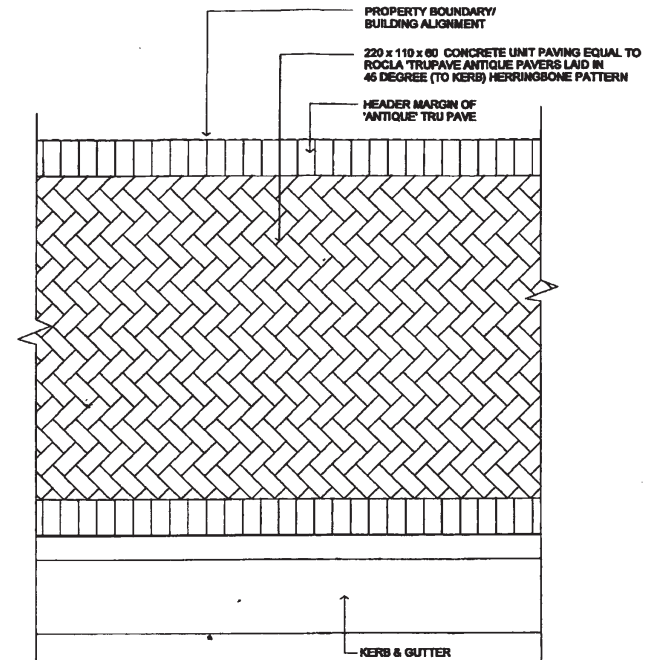

Plan 1:25

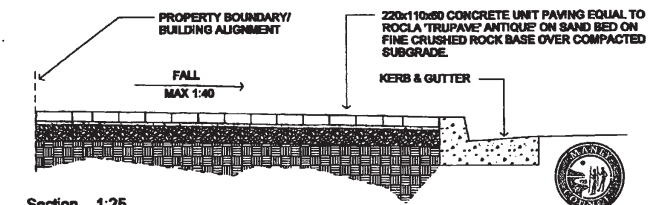

Section 1:25

PAVING TYPE 2 - TYPICAL PLAN AND SECTION

MANLY COUNCIL

PAVING DESIGN GUIDELINES

NOT TO SCALE

MARK BALDOCK
LANDSCAPE ARCHITECT
(B.App.Sc.Blt.Env., Grad.Dip.Lands.Arch.)
PO Box 373, Ammerley Qld 4103

Tel: (07) 38488436
Fax: (07) 38923575
Mob: (0407) 114 605
Email: baldock@bigpond.net.au

CLIENT:
**NORTHWEST MANAGEMENT
SERVICES PTY LTD**

DRAWING TITLE
**COUNCIL FOOTPATH
DETAILS**



PROJECT DETAILS:
**46 VICTORIA PARADE,
MANLY NSW 2095**

DRAWING NUMBER:
1304-LP5
CURRENT ISSUE:
G

DATE:
January 14
PROJECT NO:
1304

Attachment 2

Plans of Development

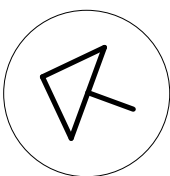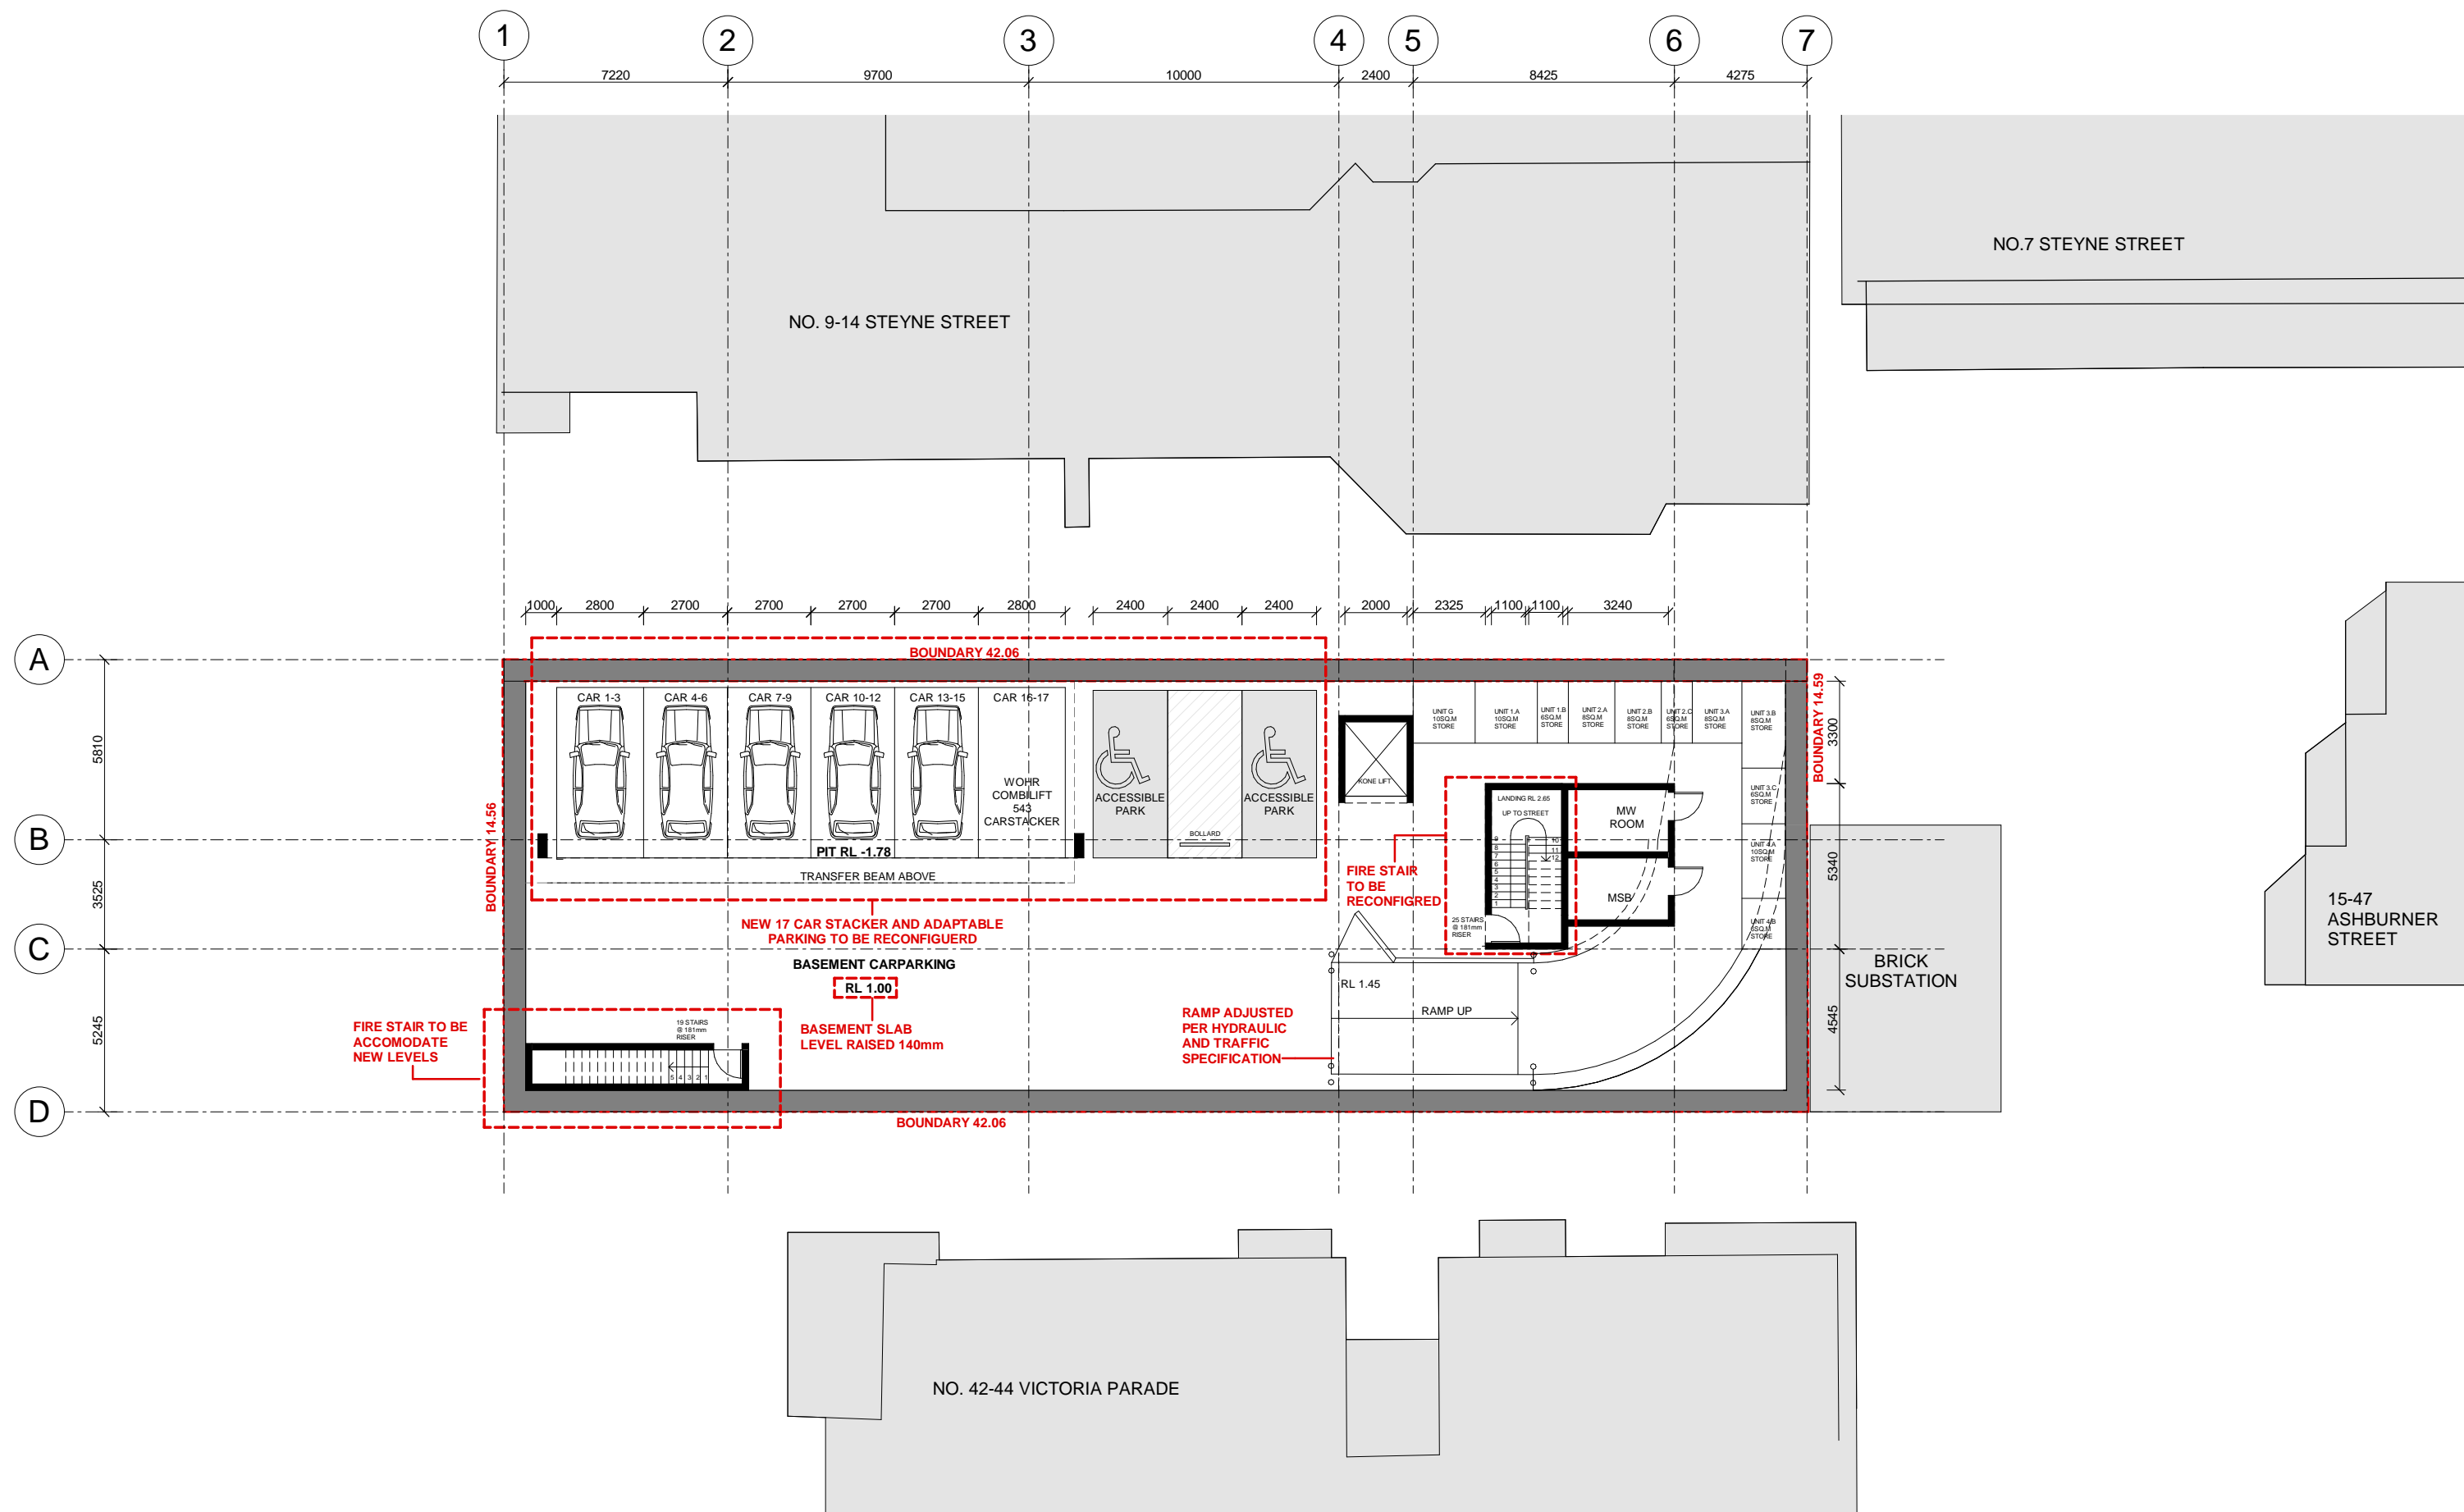

REV DESCRIPTION DATE			RESIDENTIAL DEVELOPMENT		BASEMENT		Architecture Planning Urban Design	
A	S96 SUBMISSION	2018						





MANLY OWNER'S GROUP
46 VICTORIA PARADE
MANLY, NSW 2095

S96-100

SCALE: 1 : 200
DATE: 05 JUNE 2018
DRAWN: ARC

Level 7 90 Pitt Street Sydney NSW 2000
TEL(02)92230280 FAX(02)9223 0283
mail@arcarchitects.com.au

arc

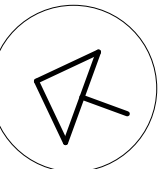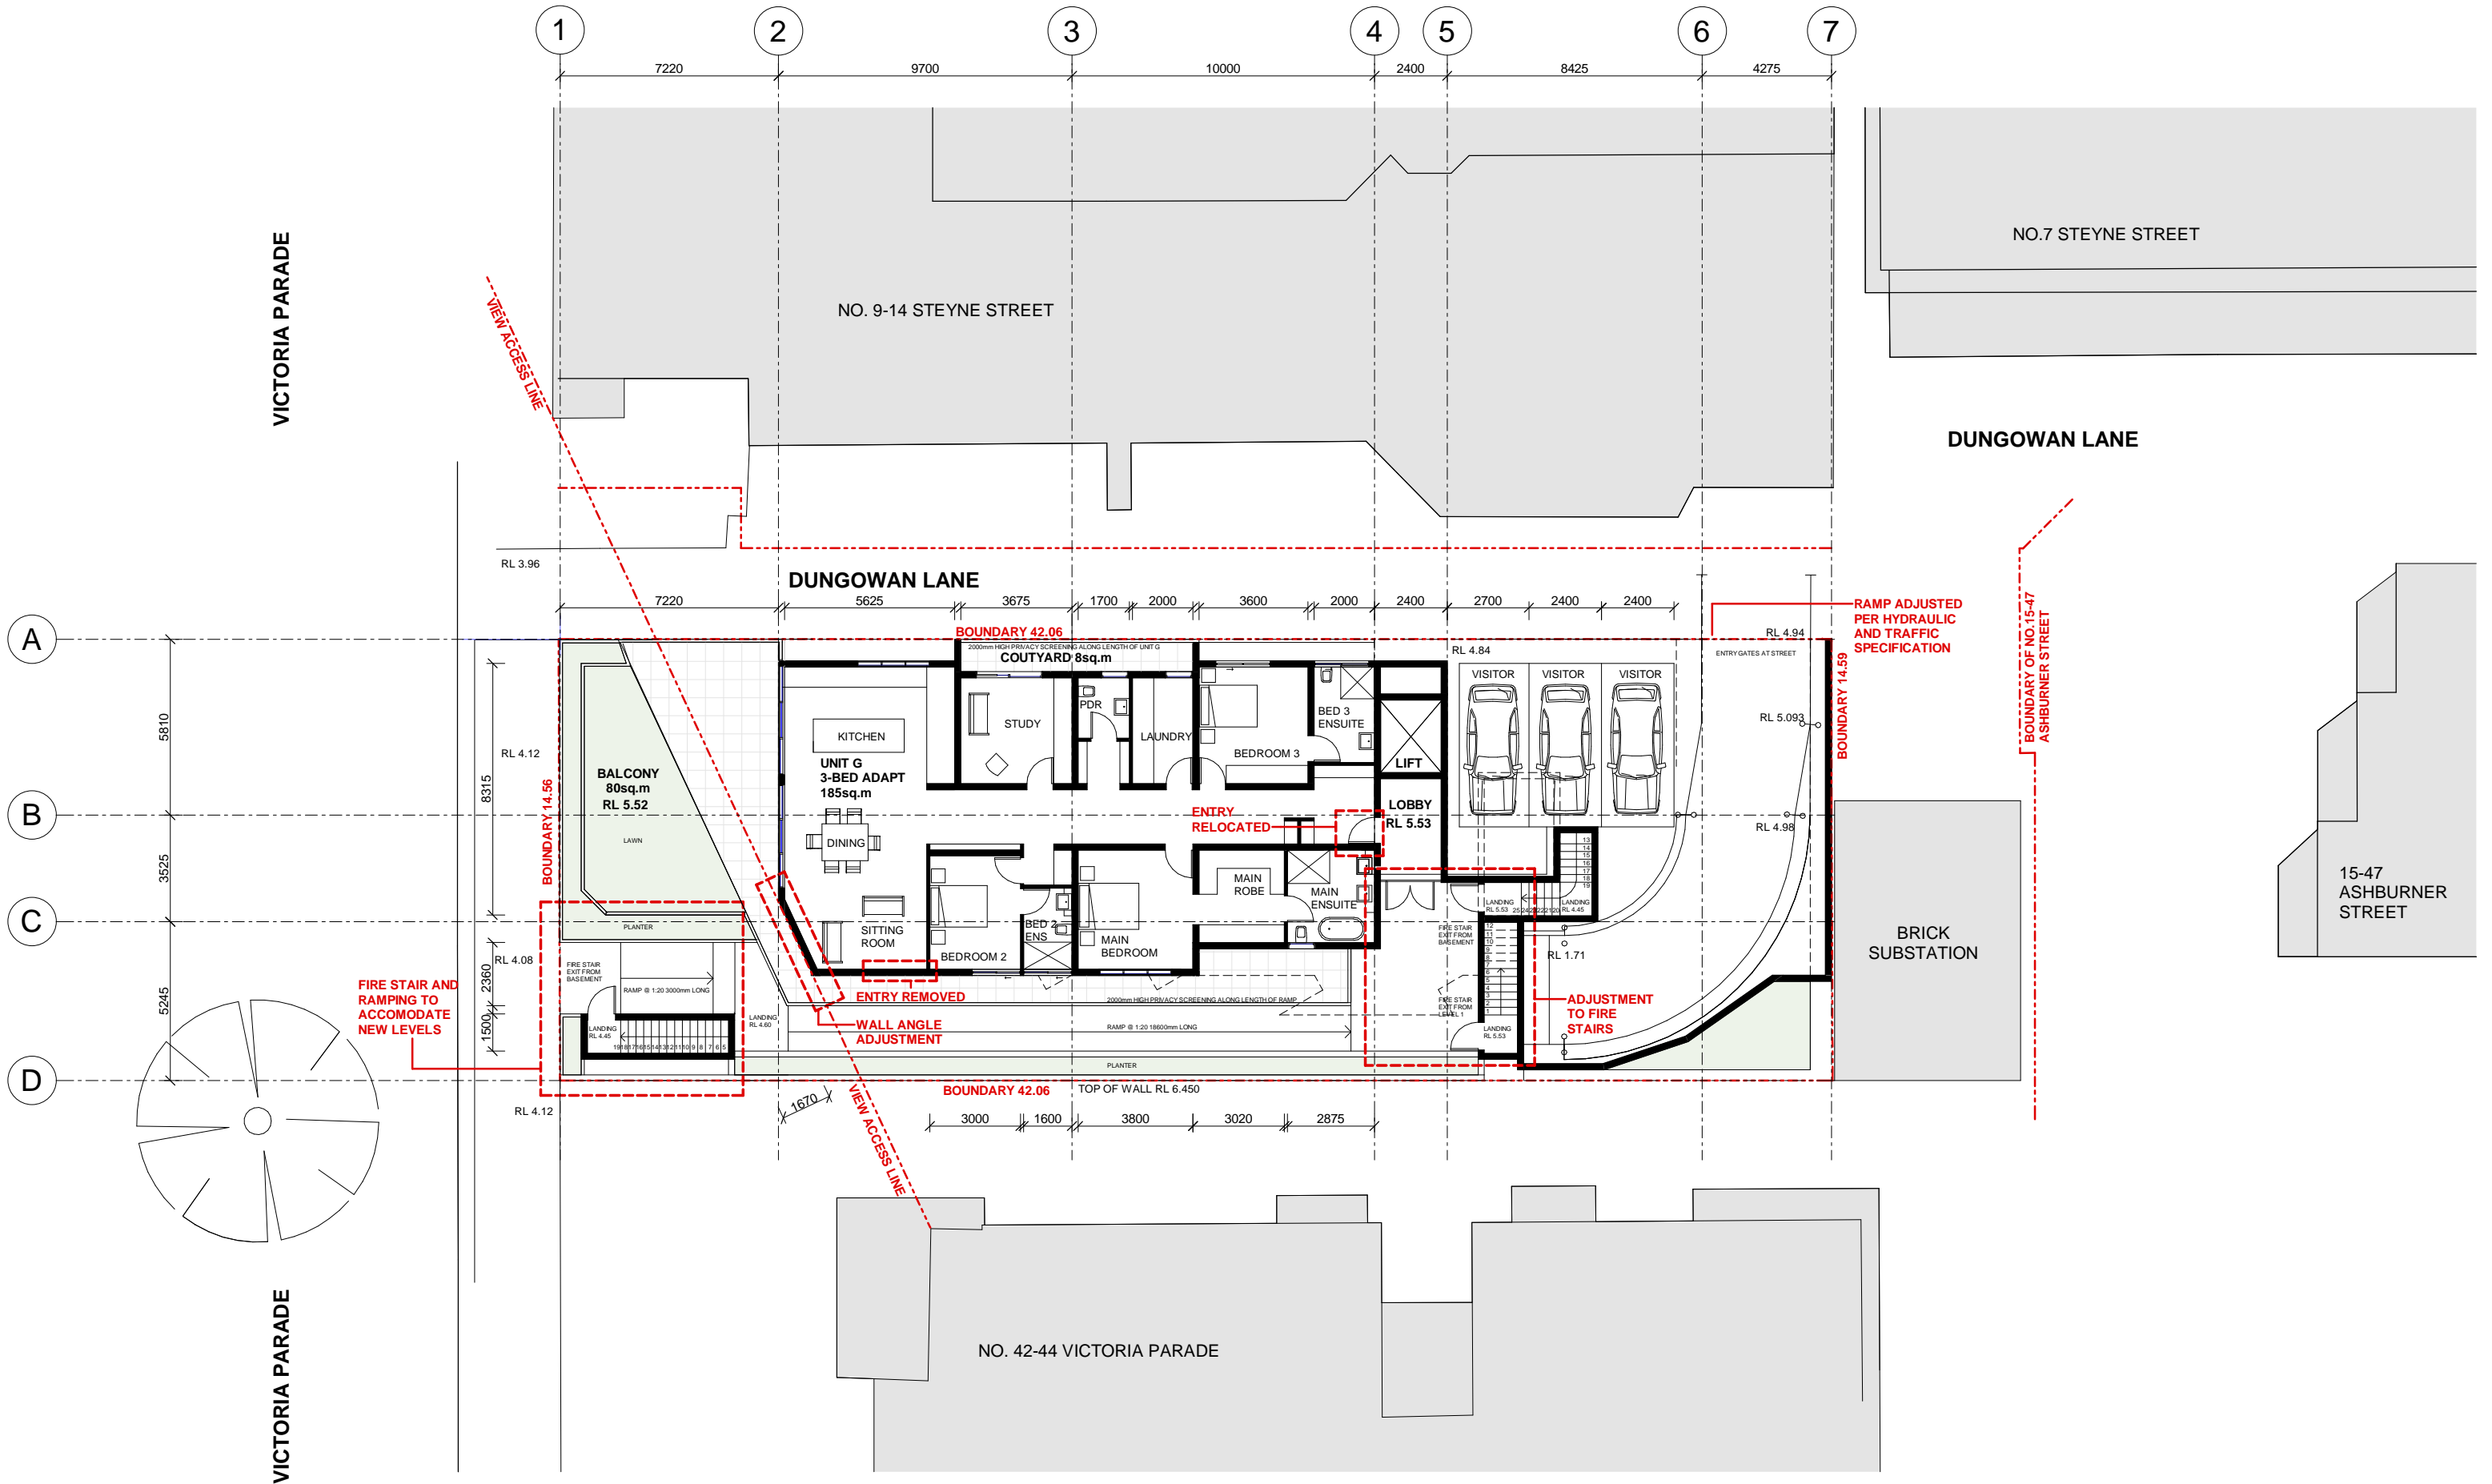

REV DESCRIPTION DATE			RESIDENTIAL DEVELOPMENT		GROUND FLOOR		Architecture Planning Urban Design	
A	S96 SUBMISSION	2018						





MANLY OWNER'S GROUP
46 VICTORIA PARADE
MANLY, NSW 2095

S96-101

SCALE: 1 : 200
DATE: 05 JUNE 2018
DRAWN: ARC

Level 7 90 Pitt Street Sydney NSW 2000
TEL(02)92230280 FAX(02)9223 0283
mail@arcarchitects.com.au

arc

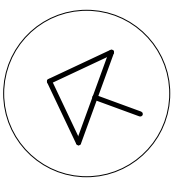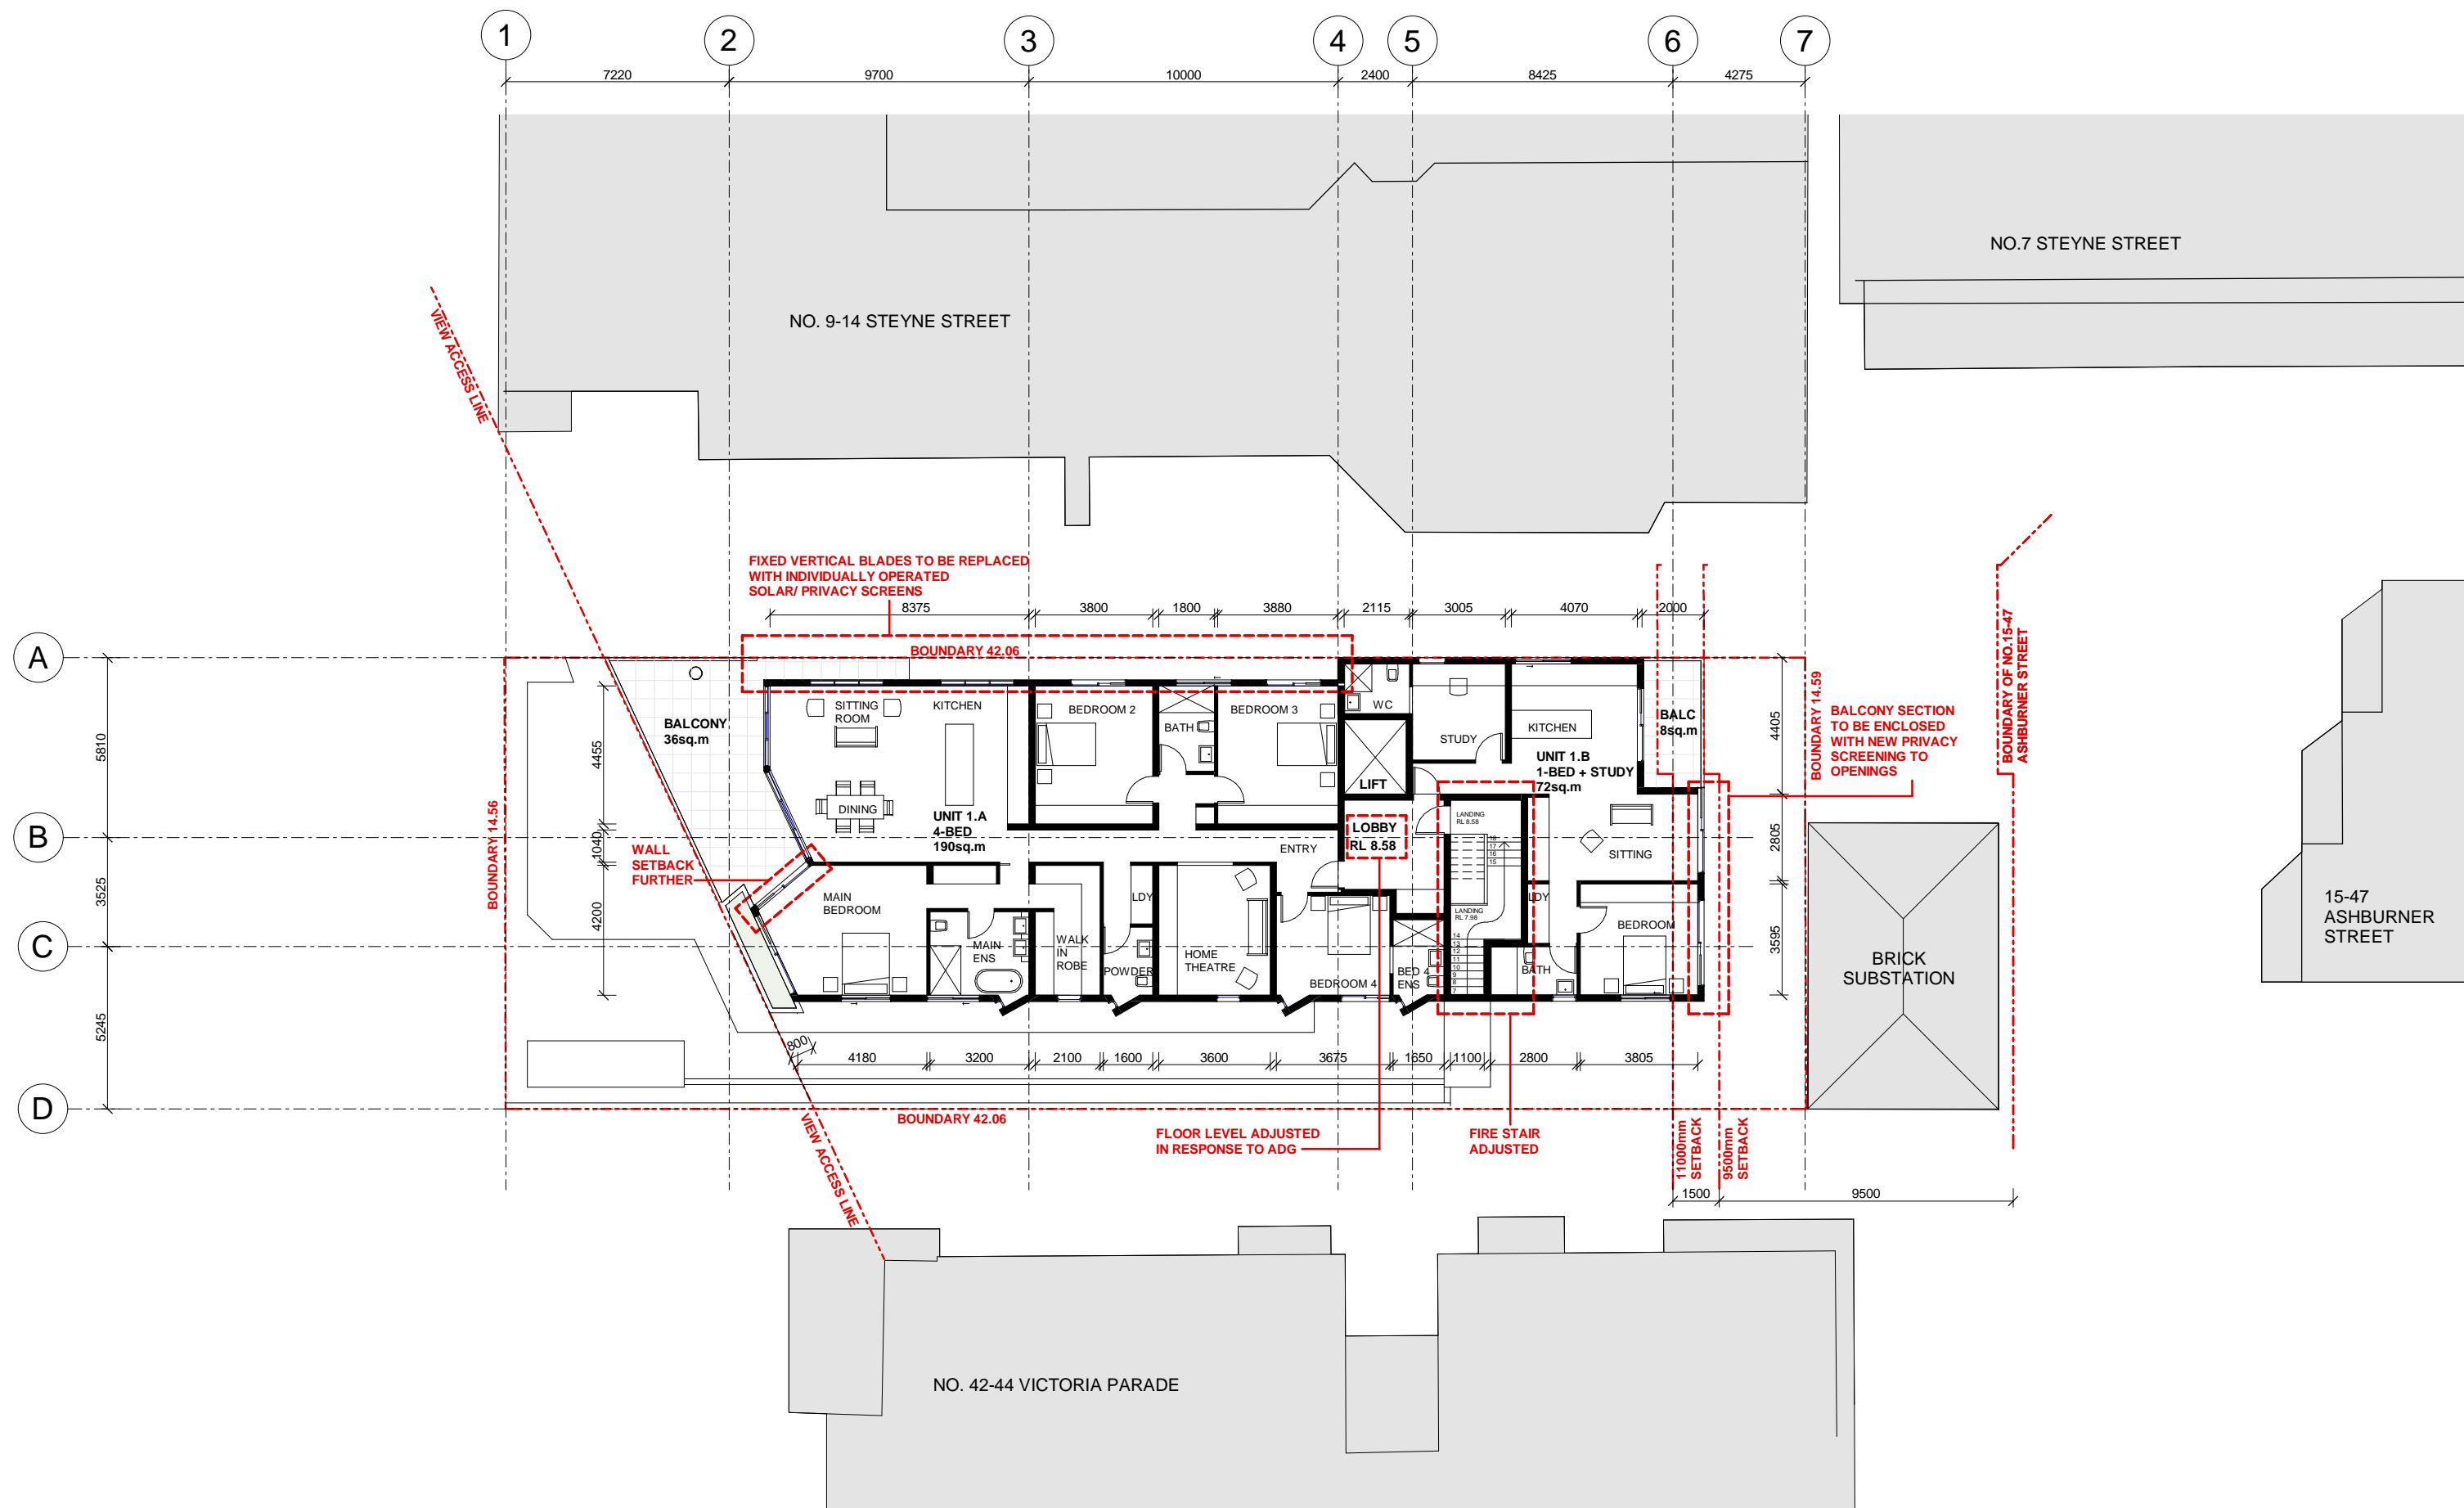

REV	DESCRIPTION	DATE			
A	S96 SUBMISSION	2018			

RESIDENTIAL DEVELOPMENT



MANLY OWNER'S GROUP
46 VICTORIA PARADE
MANLY, NSW 2095

FIRST FLOOR



S96-102

SCALE: 1 : 200
DATE: 05 JUNE 2018
DRAWN: ARC

Architecture Planning Urban Design

Level 7 90 Pitt Street Sydney NSW 2000
TEL(02)92230280 FAX(02)9223 0283
mail@arcarchitects.com.au



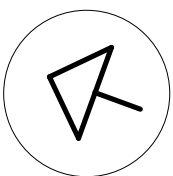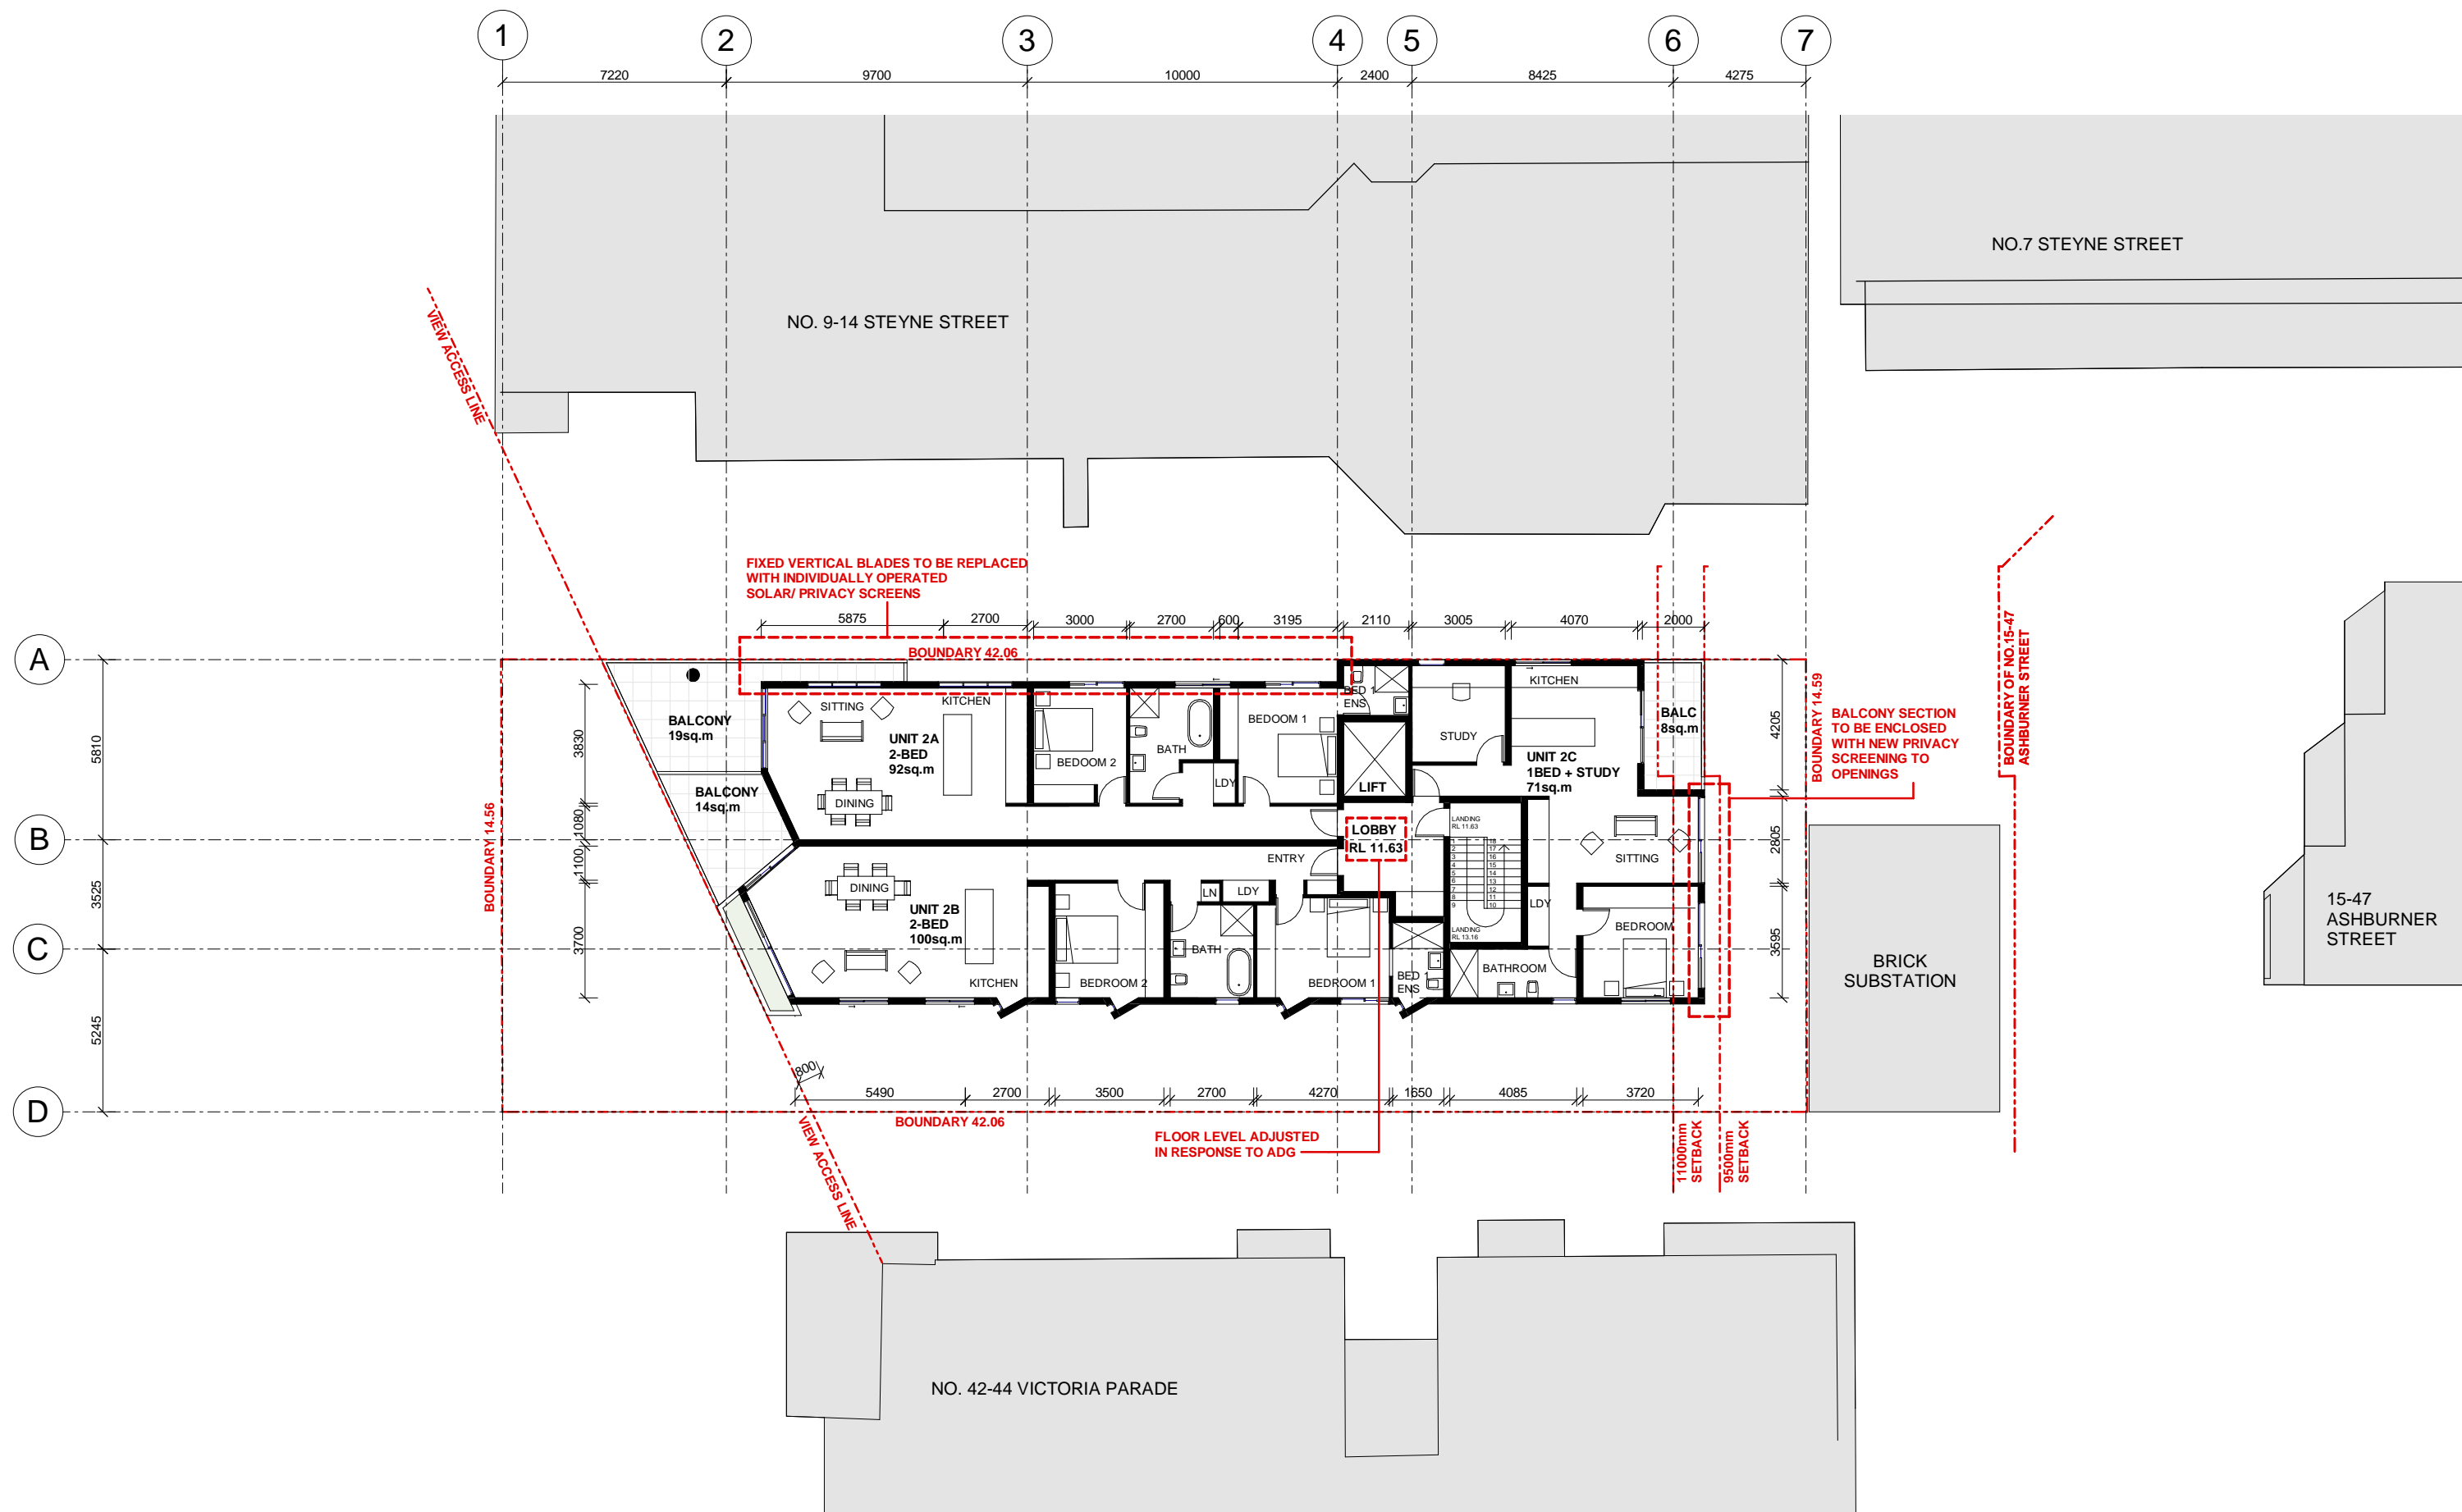

REV			DESCRIPTION			DATE			RESIDENTIAL DEVELOPMENT			SECOND FLOOR			Architecture Planning Urban Design		
A	S96 SUBMISSION	2018															





MANLY OWNER'S GROUP
46 VICTORIA PARADE
MANLY, NSW 2095

S96-103

SCALE: 1 : 200
DATE: 05 JUNE 2018
DRAWN: ARC

Level 7 90 Pitt Street Sydney NSW 2000
TEL(02)92230280 FAX(02)9223 0283
mail@arcarchitects.com.au



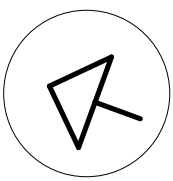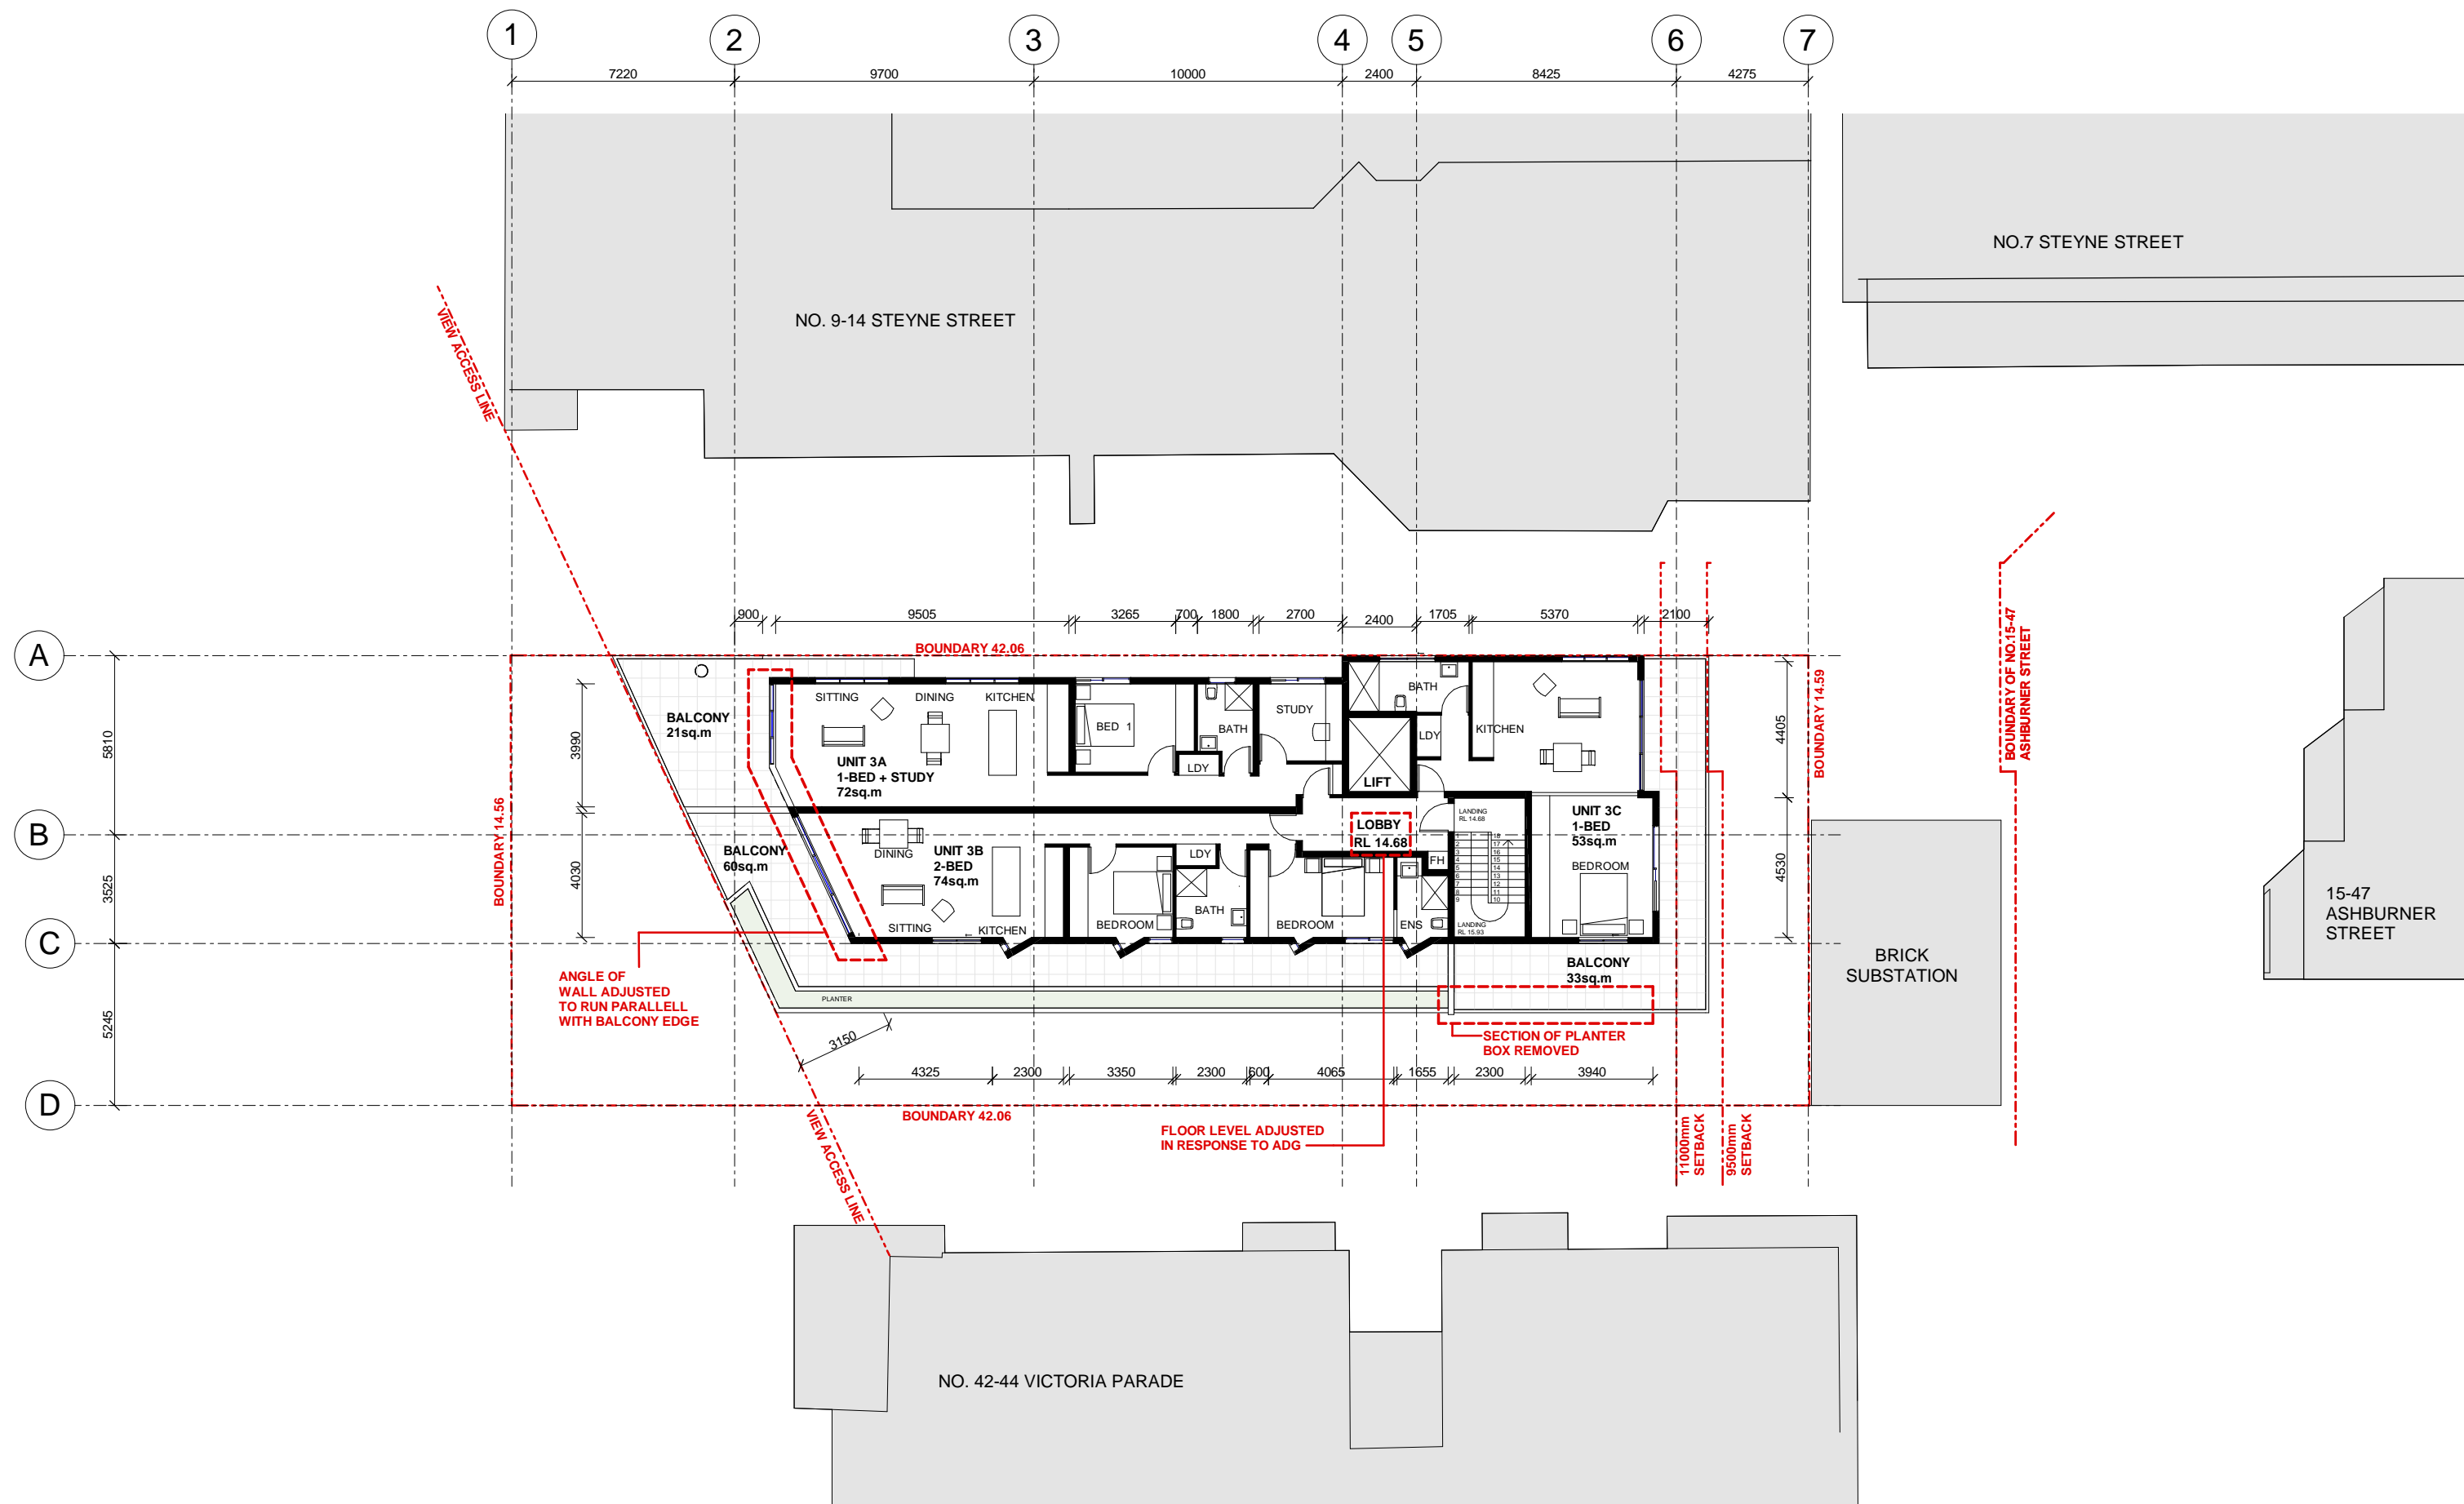

REV	DESCRIPTION	DATE			
A	S96 SUBMISSION	2018			

RESIDENTIAL DEVELOPMENT

THIRD FLOOR

Architecture Planning Urban Design





MANLY OWNER'S GROUP
46 VICTORIA PARADE
MANLY, NSW 2095

S96-104

SCALE: 1 : 200
DATE: 05 JUNE 2018
DRAWN: ARC

Level 7 90 Pitt Street Sydney NSW 2000
TEL(02)92230280 FAX(02)9223 0283
mail@arcarchitects.com.au



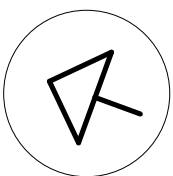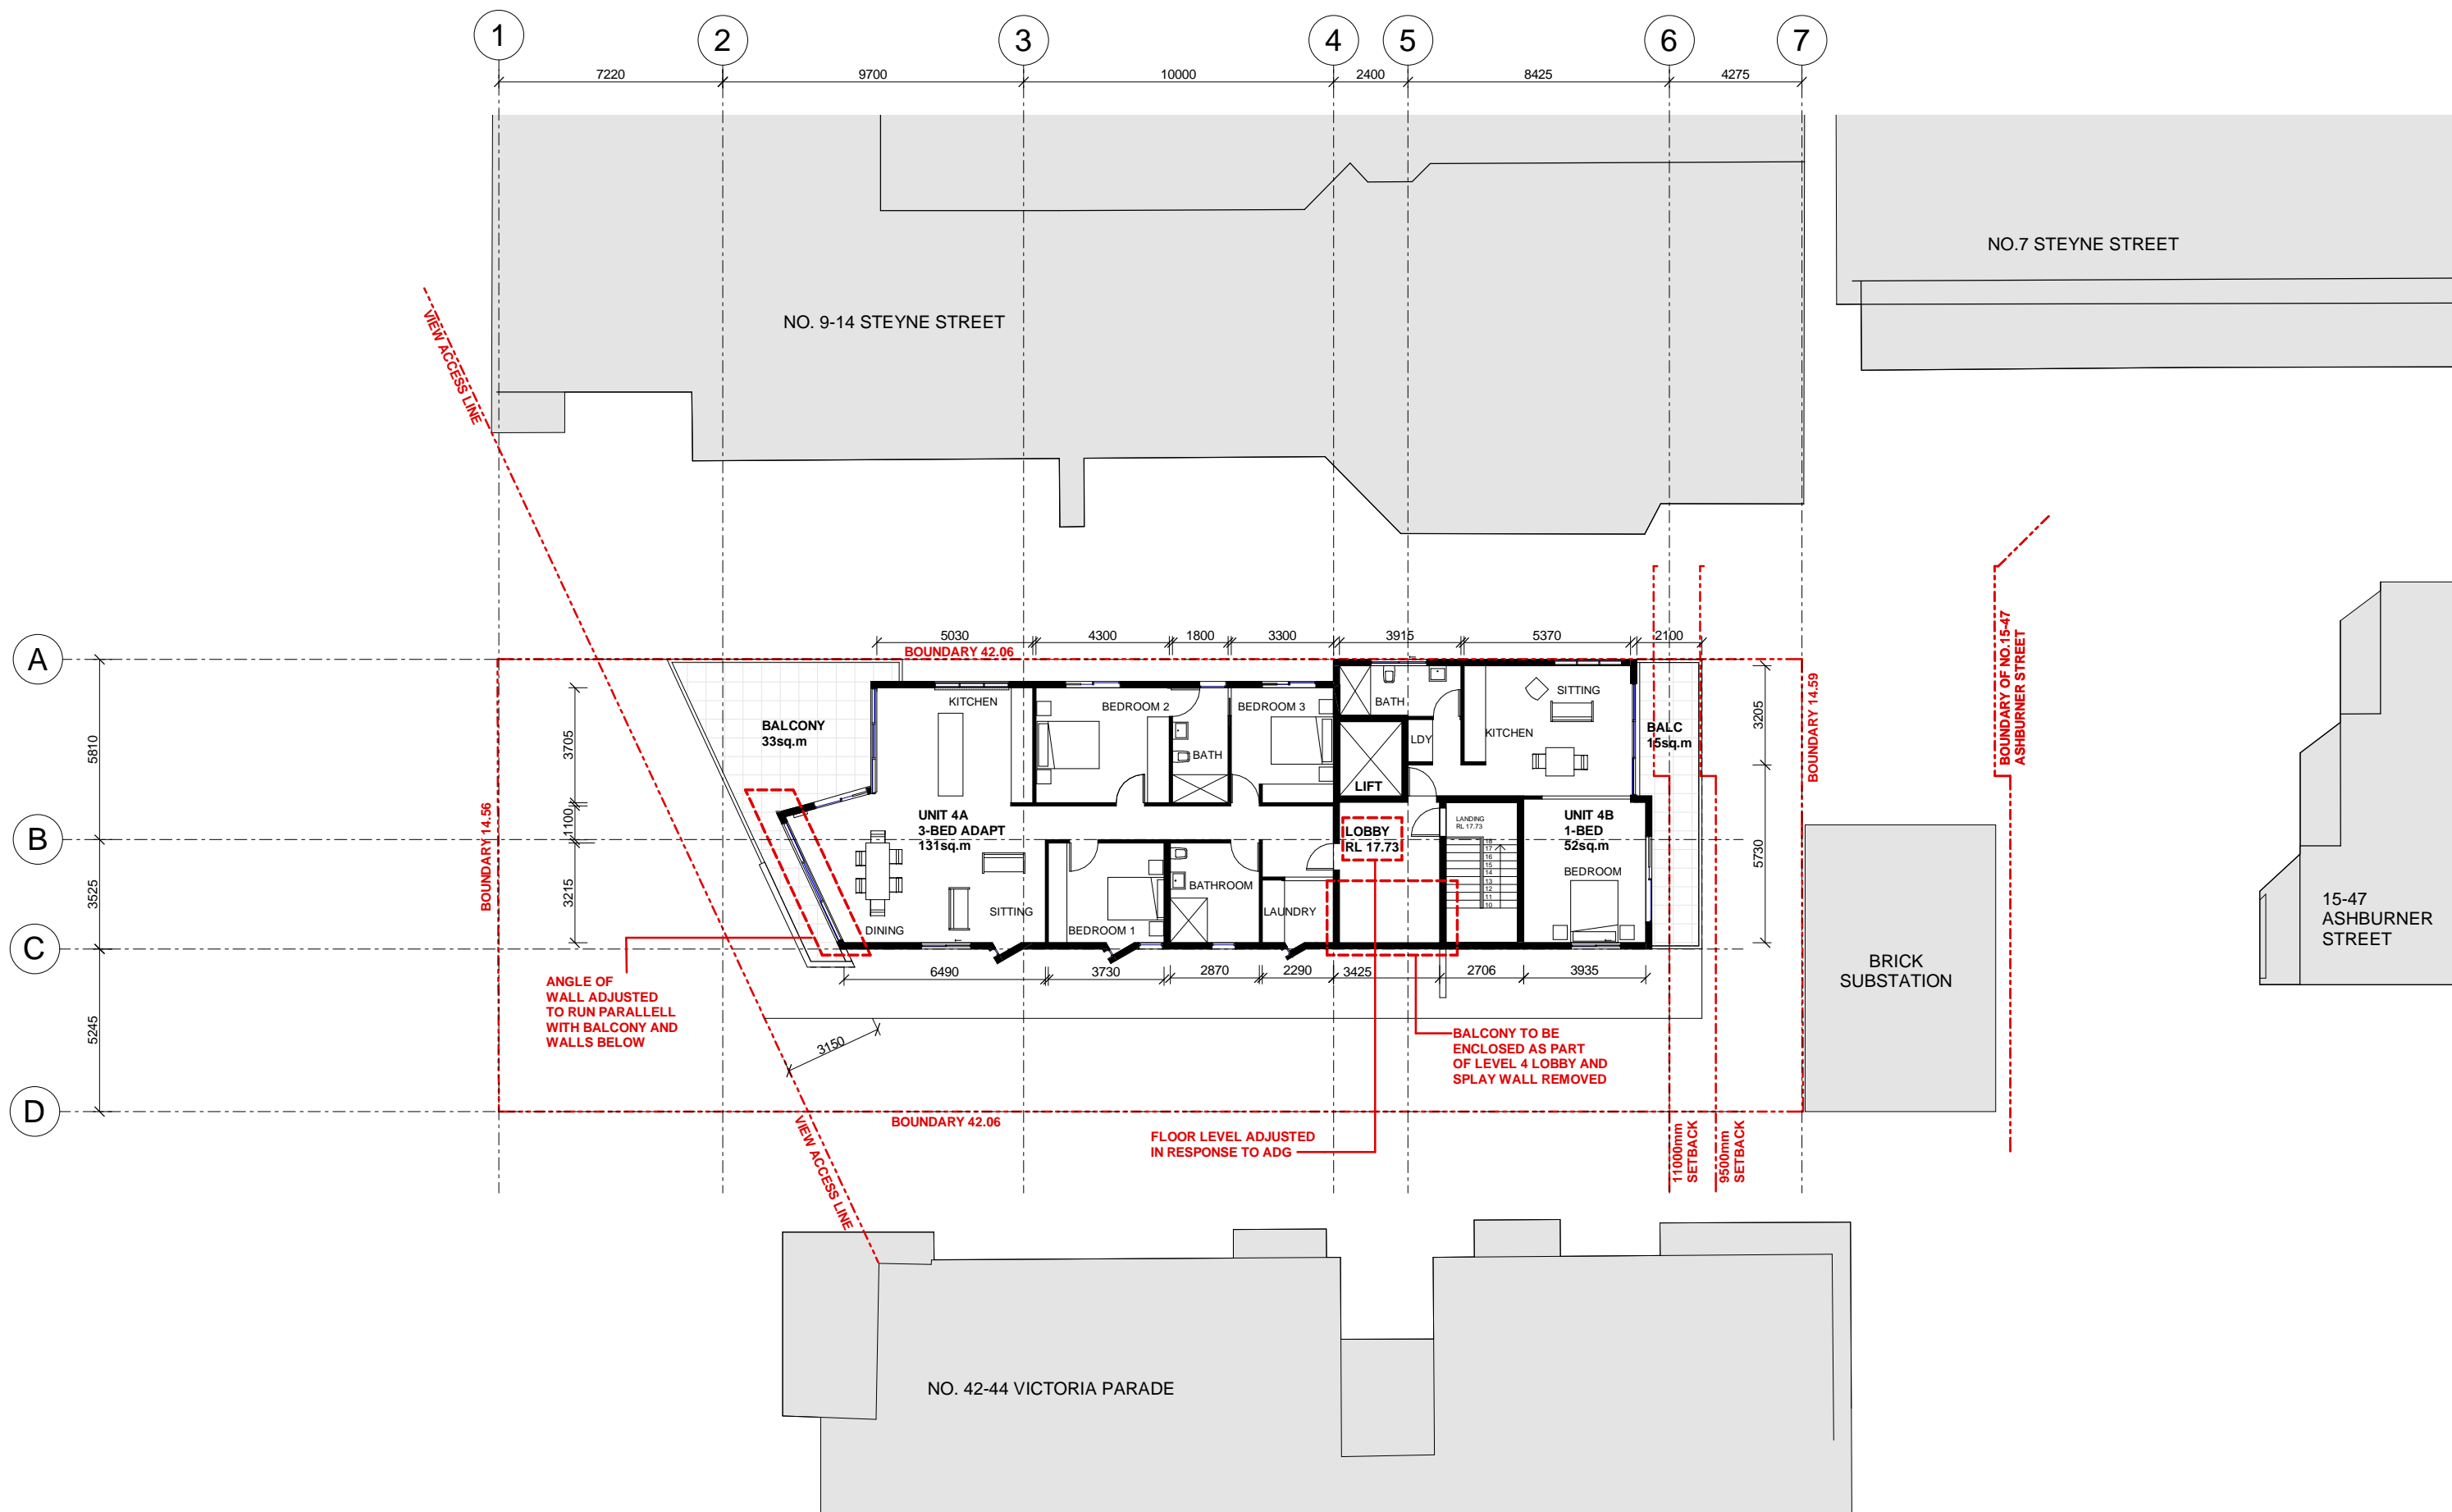

REV DESCRIPTION DATE			RESIDENTIAL DEVELOPMENT		FOURTH FLOOR		Architecture Planning Urban Design	
A	S96 SUBMISSION	2018						





MANLY OWNER'S GROUP
46 VICTORIA PARADE
MANLY, NSW 2095

S96-105
SCALE: 1 : 200
DATE: 05 JUNE 2018
DRAWN: ARC

Level 7 90 Pitt Street Sydney NSW 2000
TEL(02)92230280 FAX(02)9223 0283
mail@arcarchitects.com.au



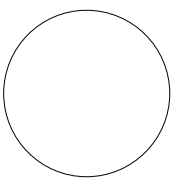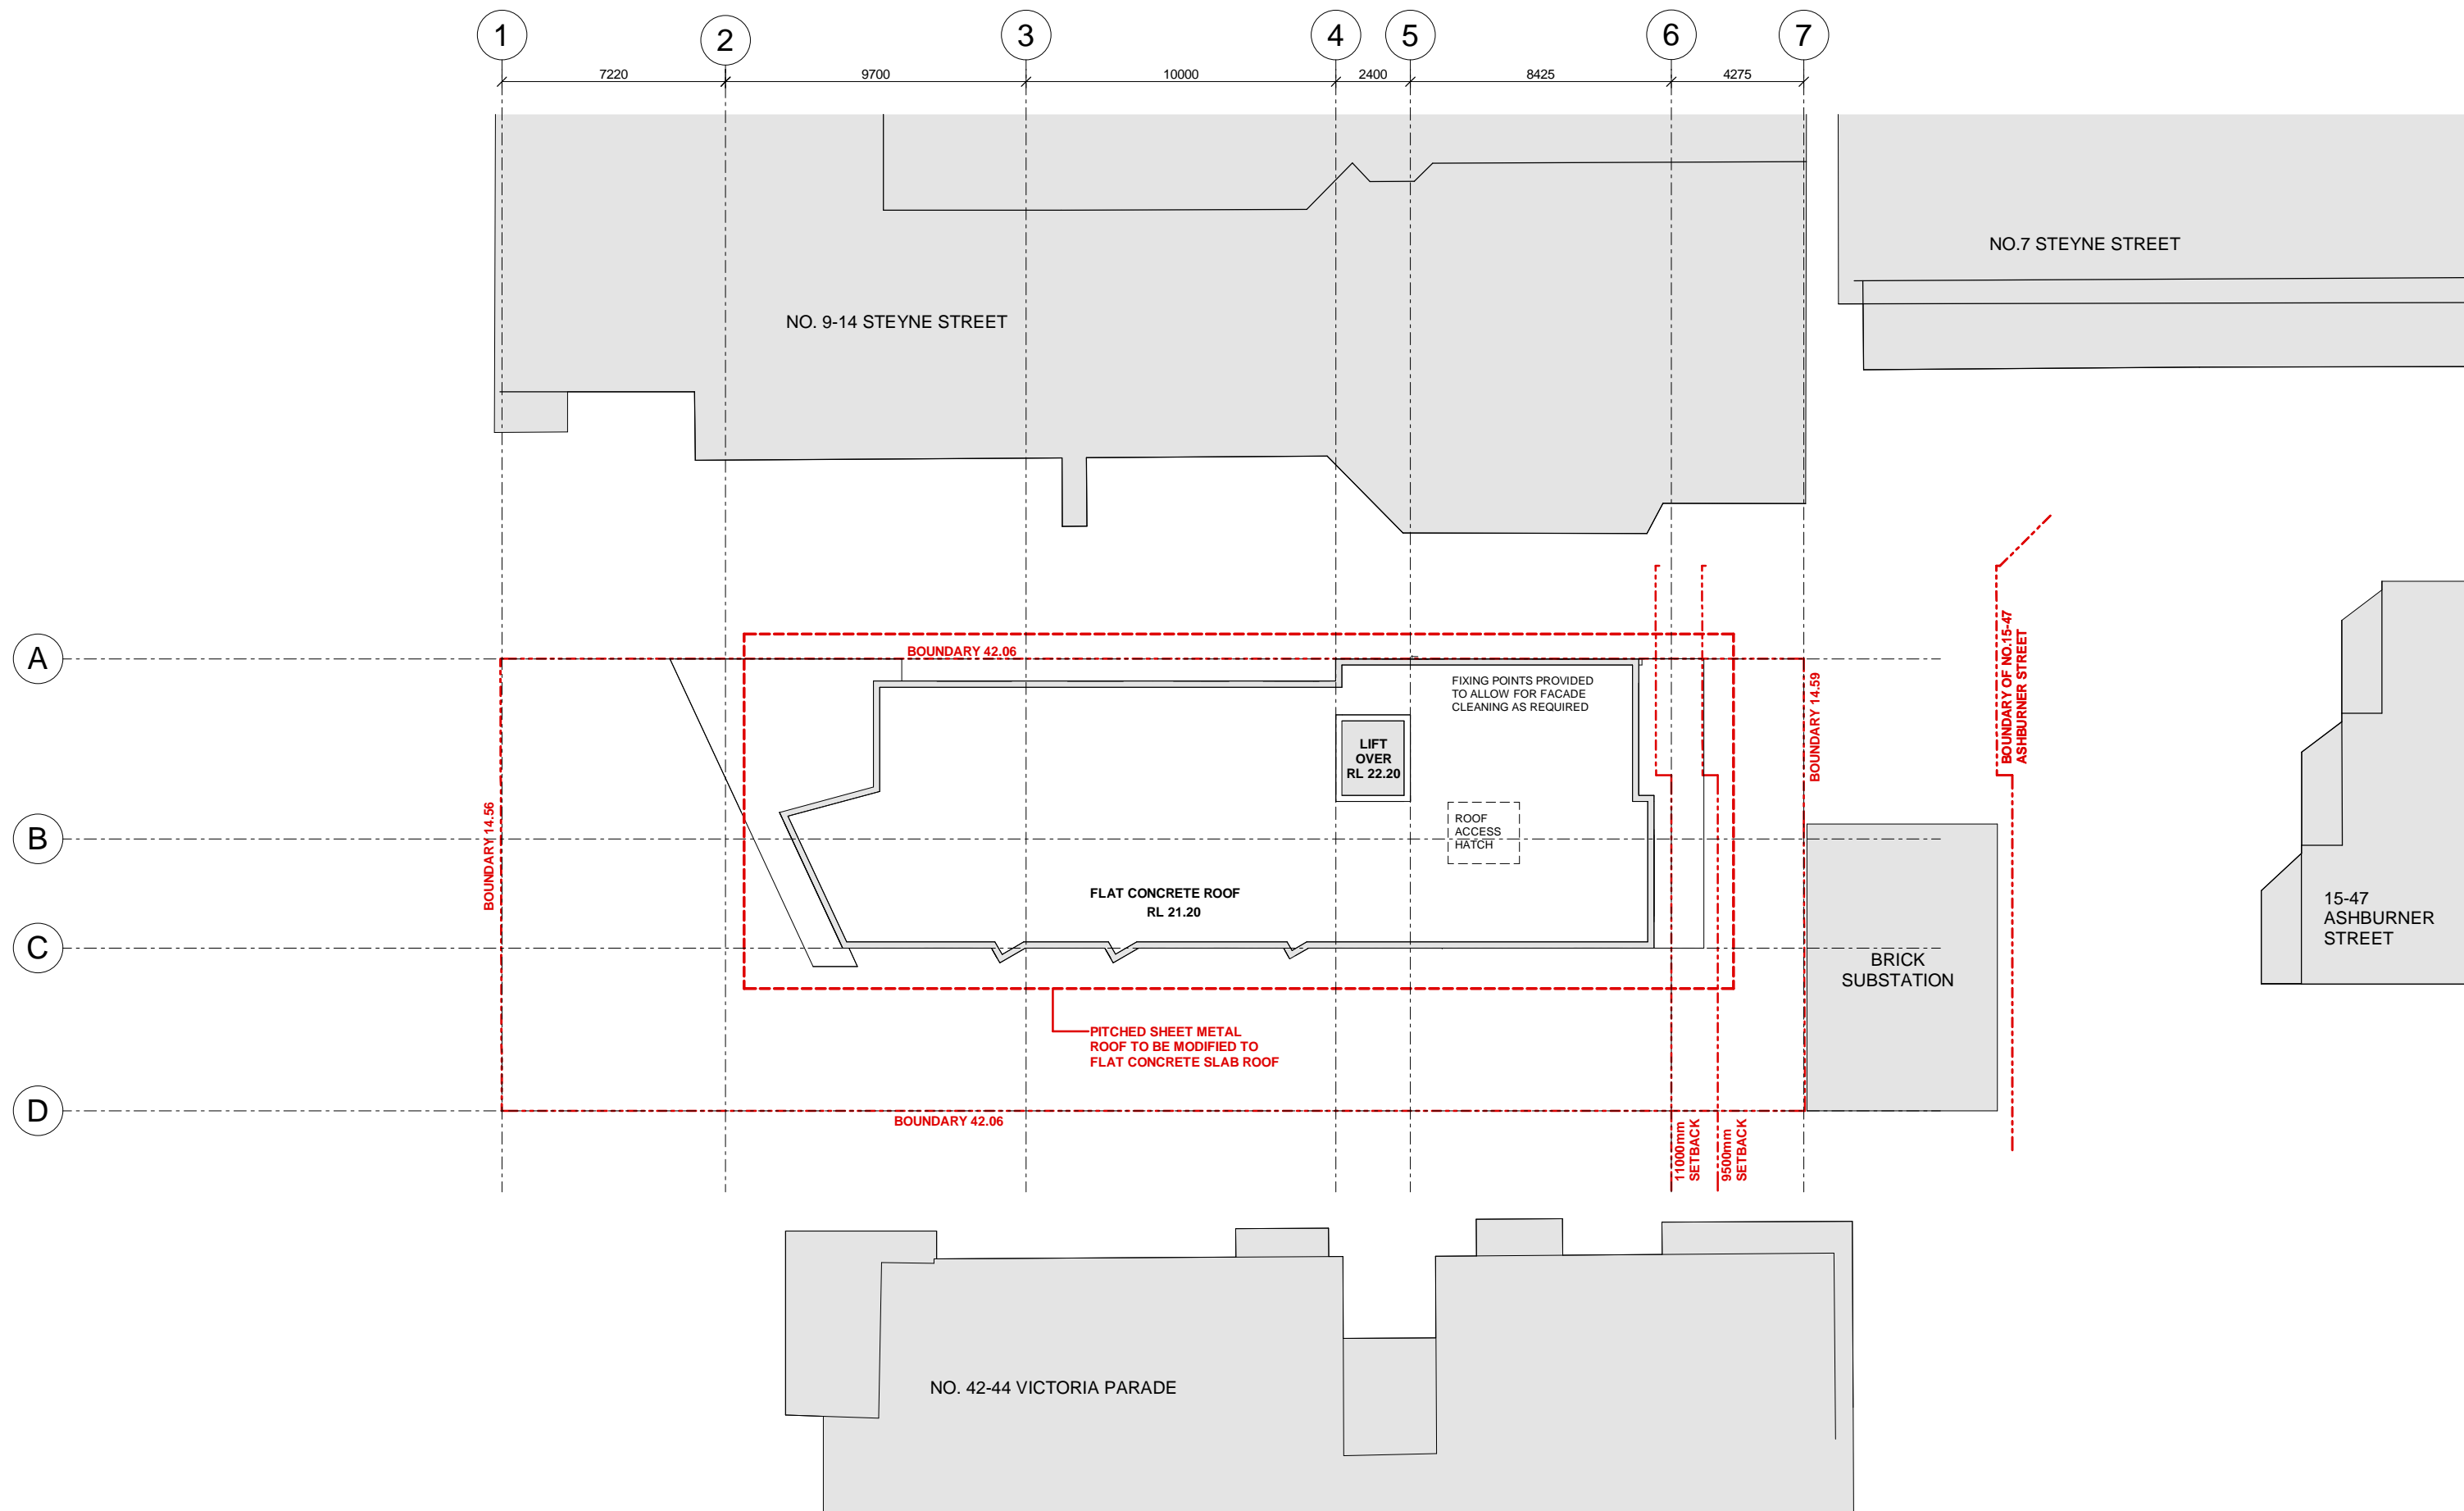

REV DESCRIPTION DATE			RESIDENTIAL DEVELOPMENT		ROOF PLAN		Architecture Planning Urban Design	
A	S96 SUBMISSION	2018						



MANLY OWNER'S GROUP
46 VICTORIA PARADE
MANLY, NSW 2095

S96-106


SCALE: 1 : 200
DATE: 05 JUNE 2018
DRAWN: ARC

Level 7 90 Pitt Street Sydney NSW 2000
TEL(02)92230280 FAX(02)9223 0283
mail@arcarchitects.com.au



Attachment 3

Vehicle Tracking Diagrams – Access

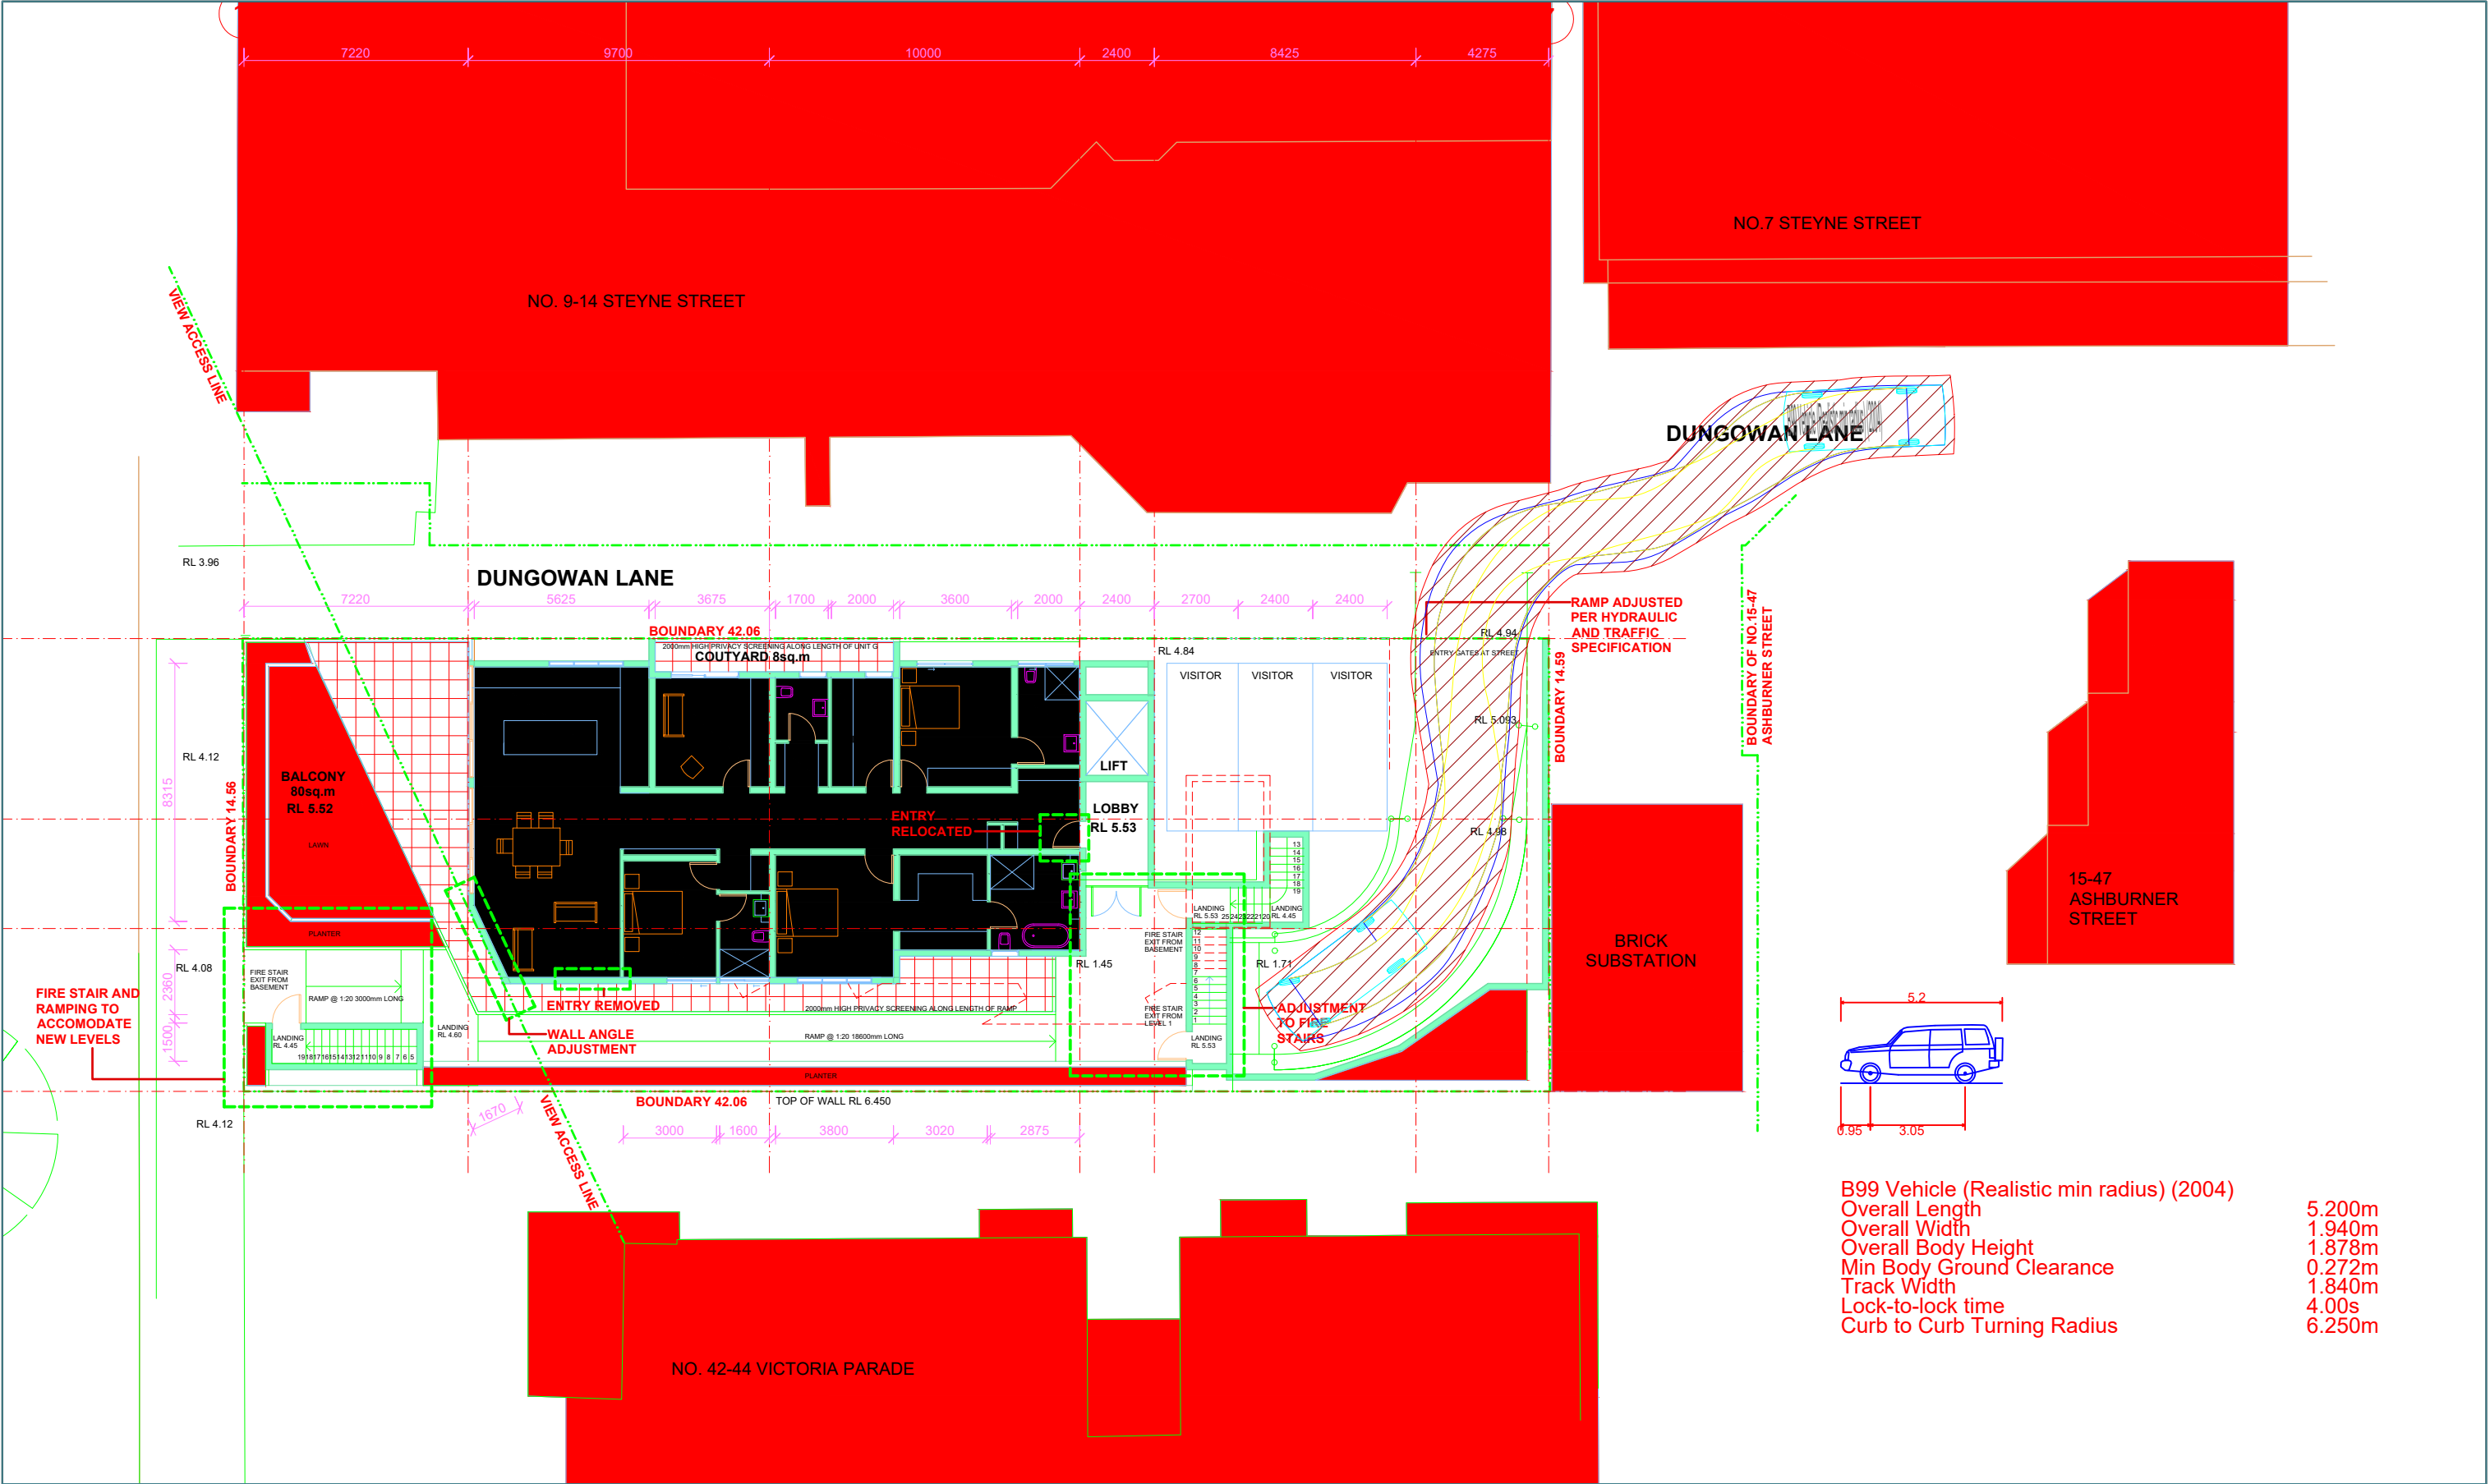

INROADS:GROUP

drawing prepared by

InRoads Group


PO Box 596
Potts Point NSW 1335
ABN: 25 608 559 897

project		46 Victoria Parade, Manly			
drawing title		Vehicle Tracking Analyses			
project no.	drawing no.	revision	date	scale	
18-014	DWG01	A	06/06/2018	1:200 @ A3	

FOR INFORMATION ONLY - NOT FOR CONSTRUCTION

InRoads Group is responsible for vehicle swept path diagrams and/or drawing mark-ups only. Base drawing prepared by others.

Vehicle swept path diagrams prepared using computer generated turning path software and associated drawing platforms. Vehicle data based upon relevant Australian Standards (AS/NZS 2890.1-2004 *Parking facilities - Off-street car parking*, and/or AS 2890.2-2002 *Parking facilities - Off-street commercial vehicle facilities*). These standards make allowance for a degree of tolerance, however the vehicle characteristics in these standards represent a suitable design vehicle and do not account for all variations in vehicle dimensions / specifications and/or driver ability or behaviour.

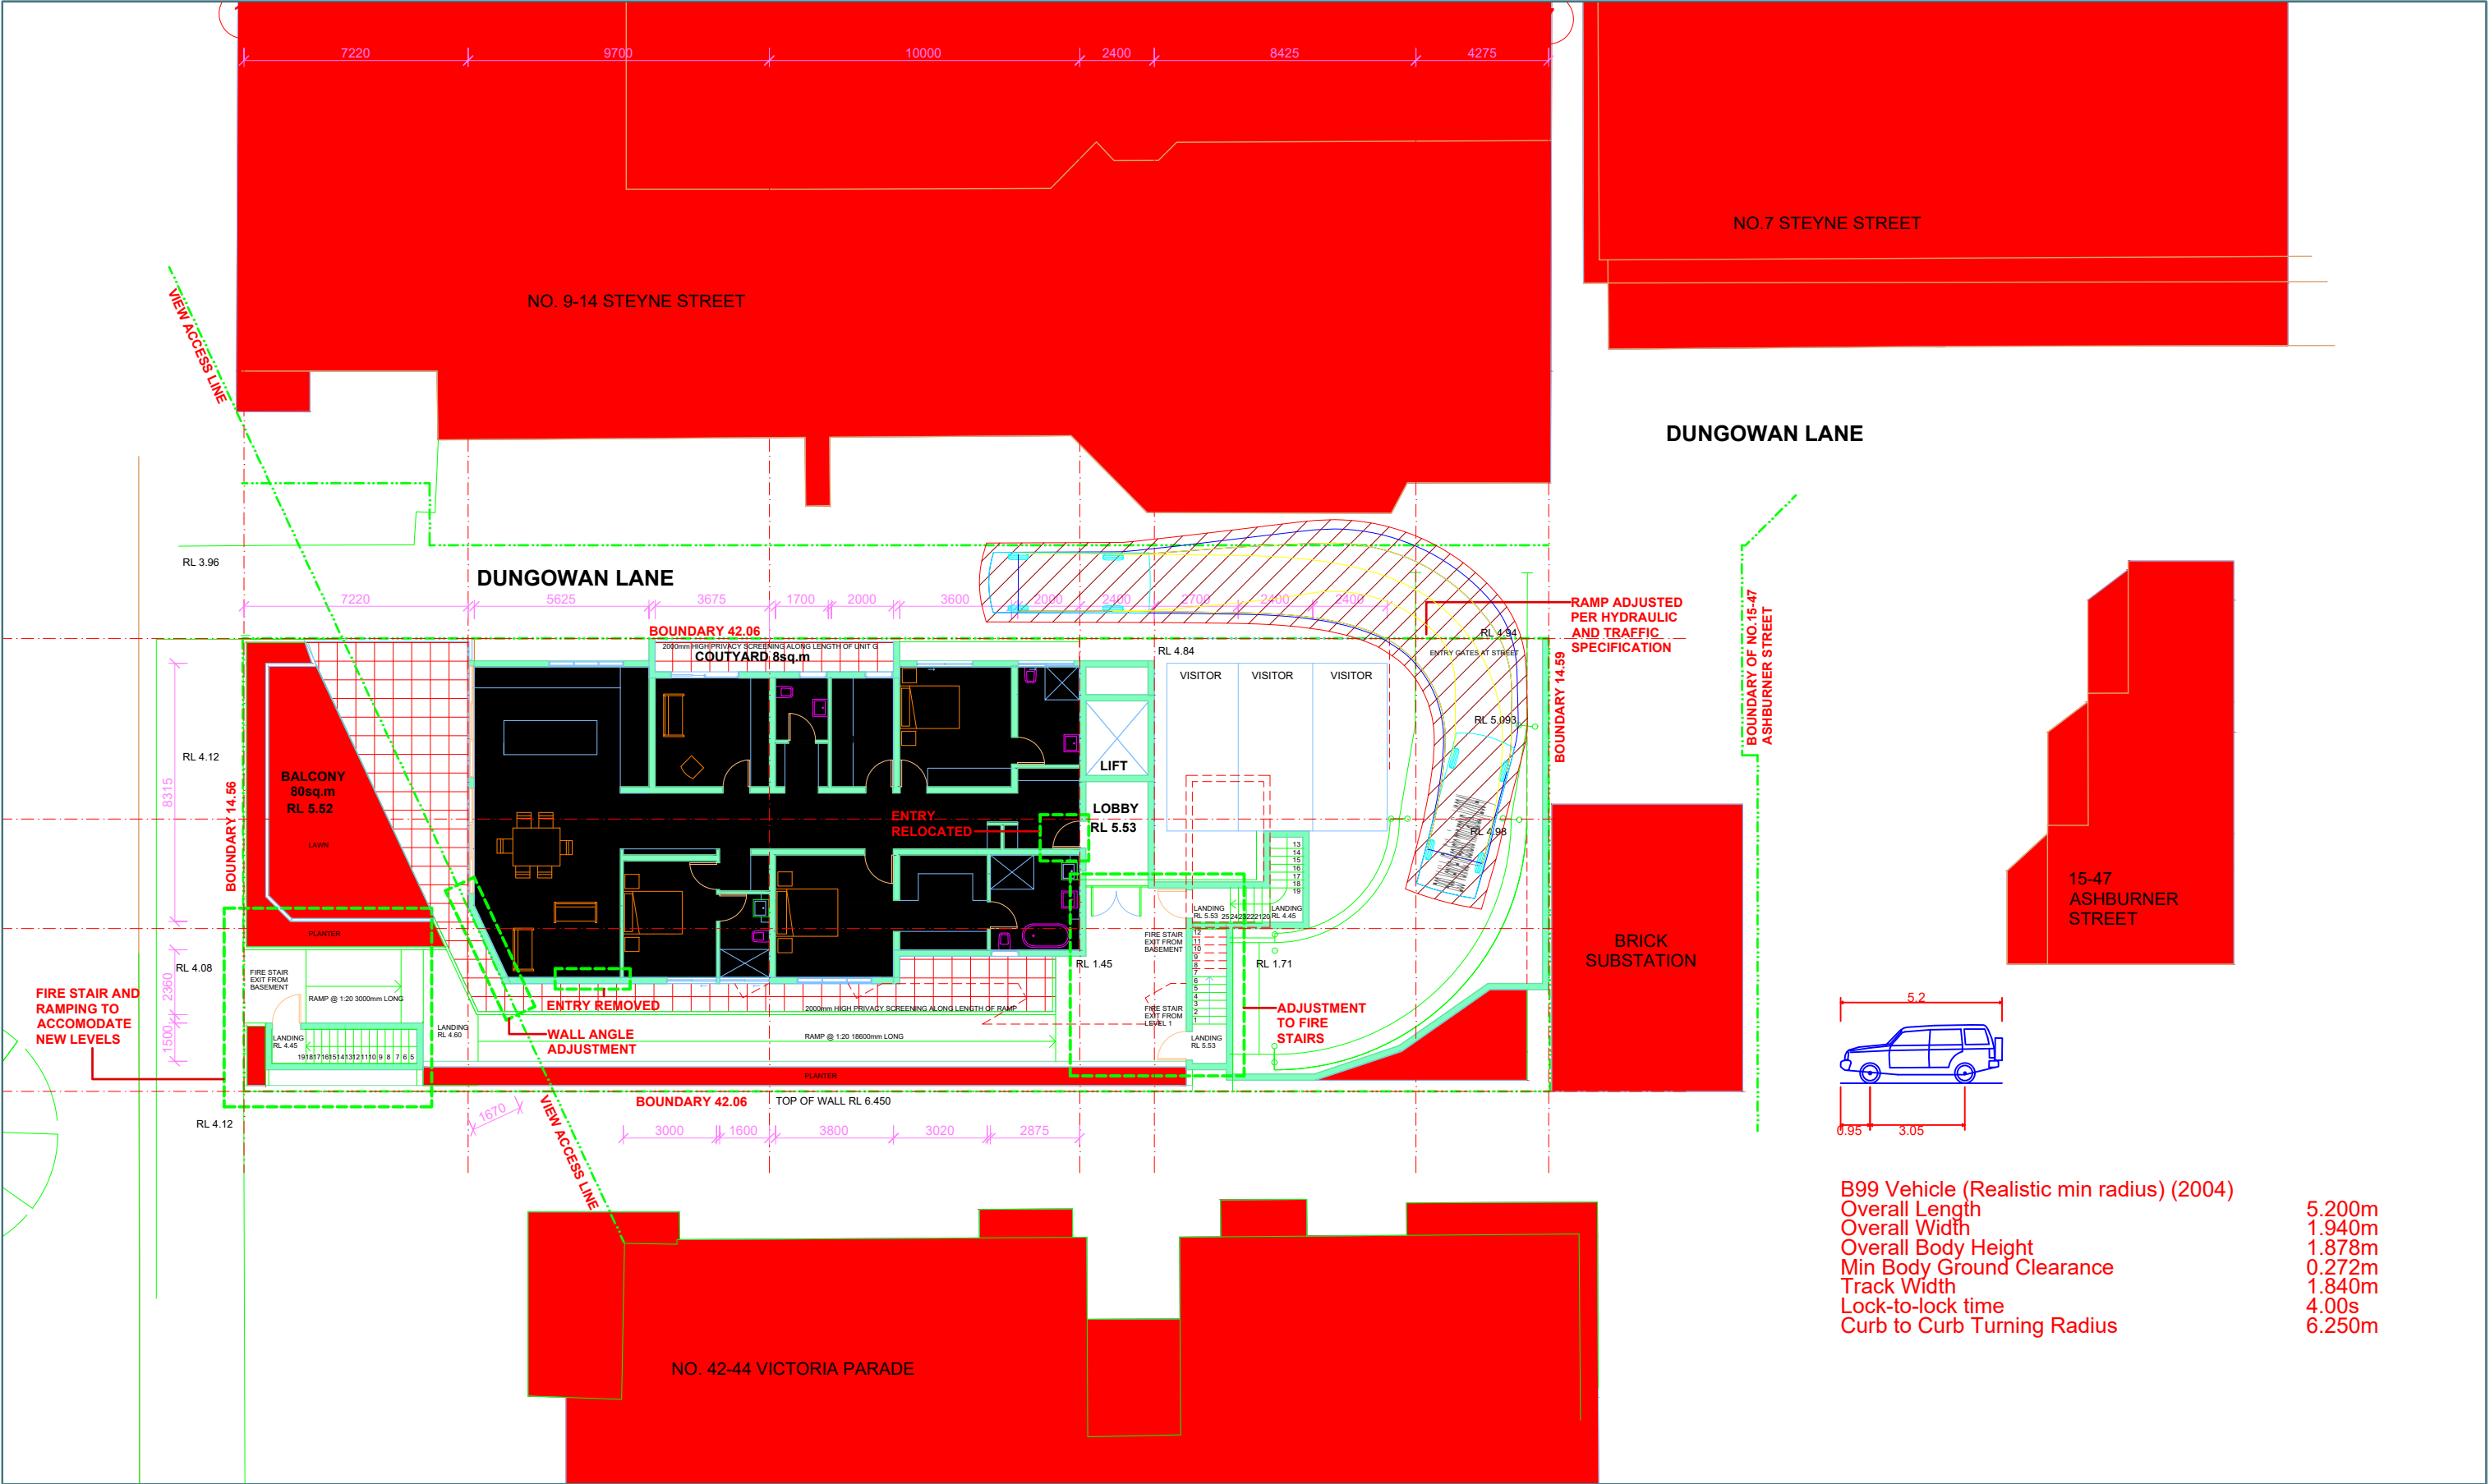

INROADS:GROUP

drawing prepared by

InRoads Group

PO Box 596
Potts Point NSW 1335
ABN: 25 608 559 897

project		46 Victoria Parade, Manly			
drawing title		Vehicle Tracking Analyses			
project no.	drawing no.	revision	date	scale	
18-014	DWG02	A	06/06/2018	1:200 @ A3	




FOR INFORMATION ONLY - NOT FOR CONSTRUCTION

InRoads Group is responsible for vehicle swept path diagrams and/or drawing mark-ups only. Base drawing prepared by others.

Vehicle swept path diagrams prepared using computer generated turning path software and associated drawing platforms. Vehicle data based upon relevant Australian Standards (AS/NZS 2890.1-2004 *Parking facilities - Off-street car parking*, and/or AS 2890.2-2002 *Parking facilities - Off-street commercial vehicle facilities*). These standards make allowance for a degree of tolerance, however the vehicle characteristics in these standards represent a suitable design vehicle and do not account for all variations in vehicle dimensions / specifications and/or driver ability or behaviour.


Attachment 4

Ramp Vertical Clearance Assessment

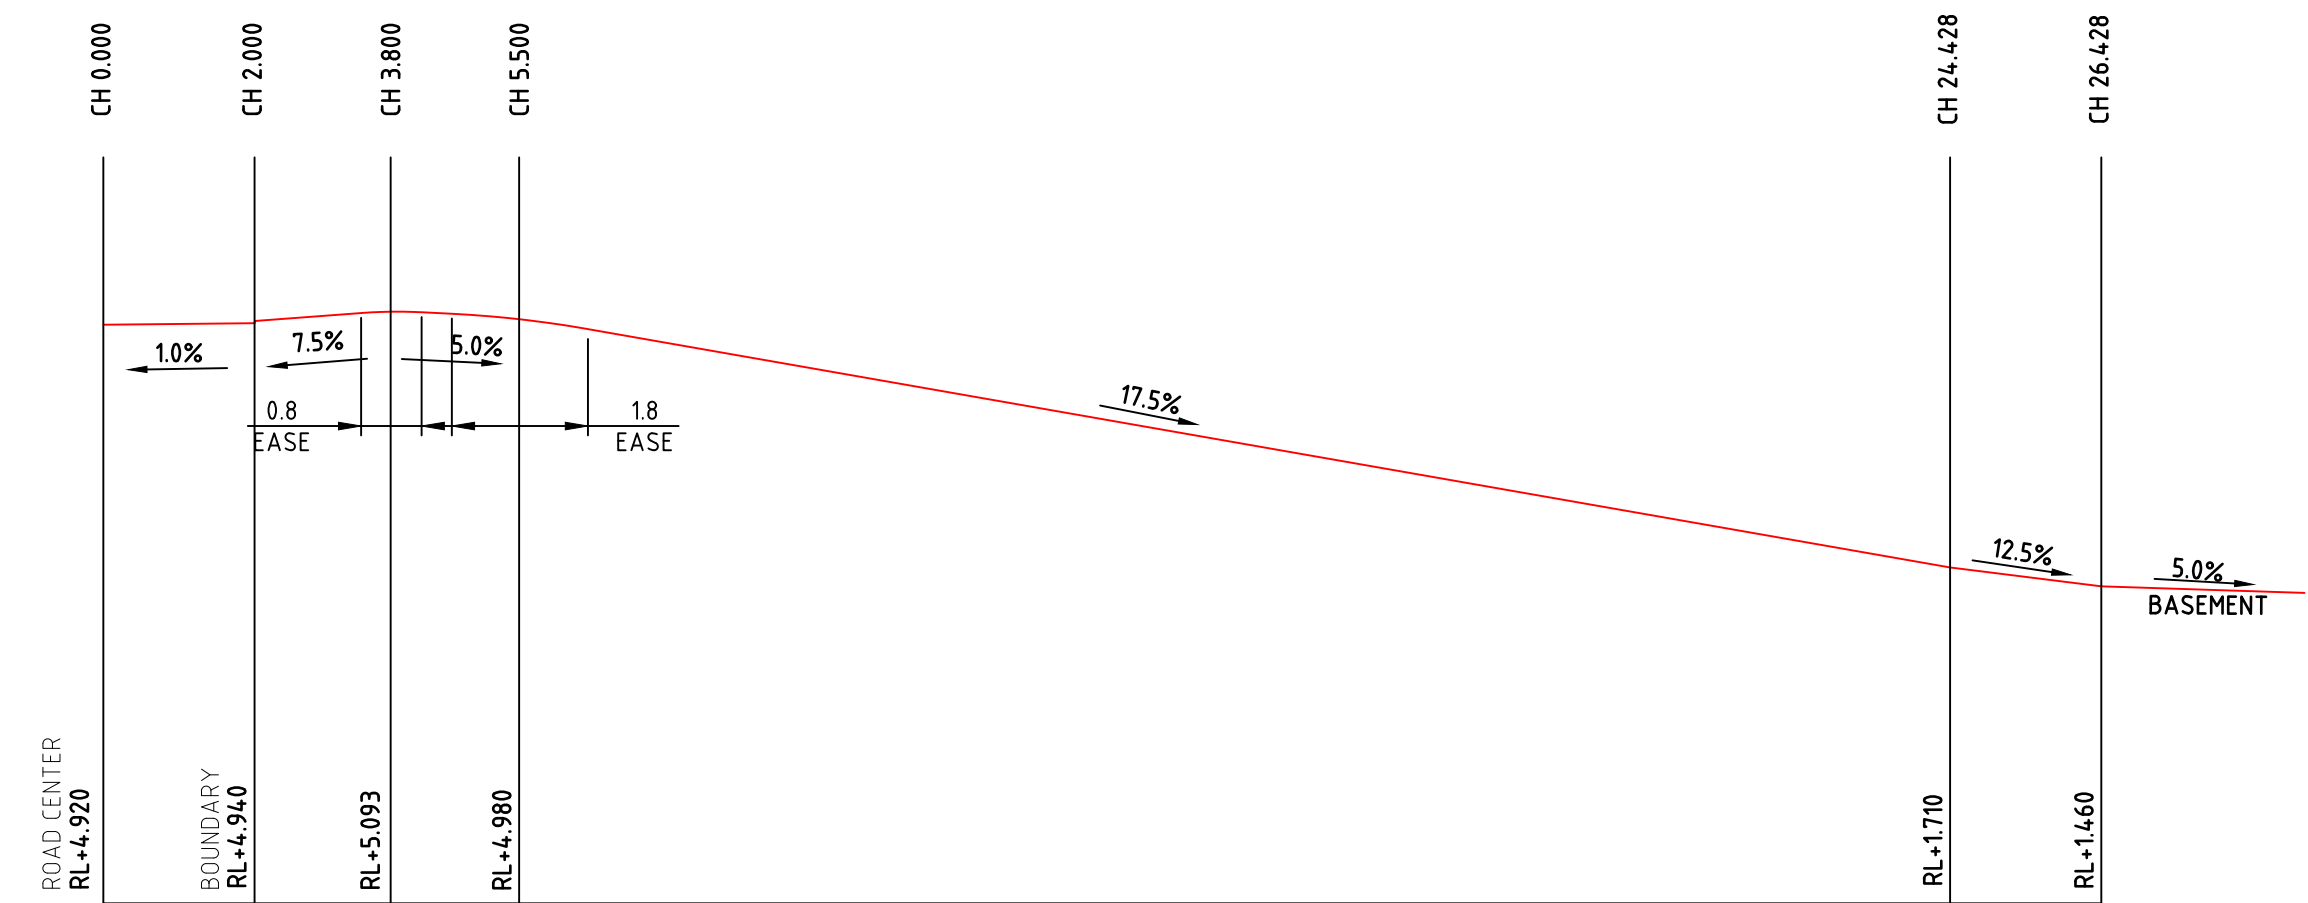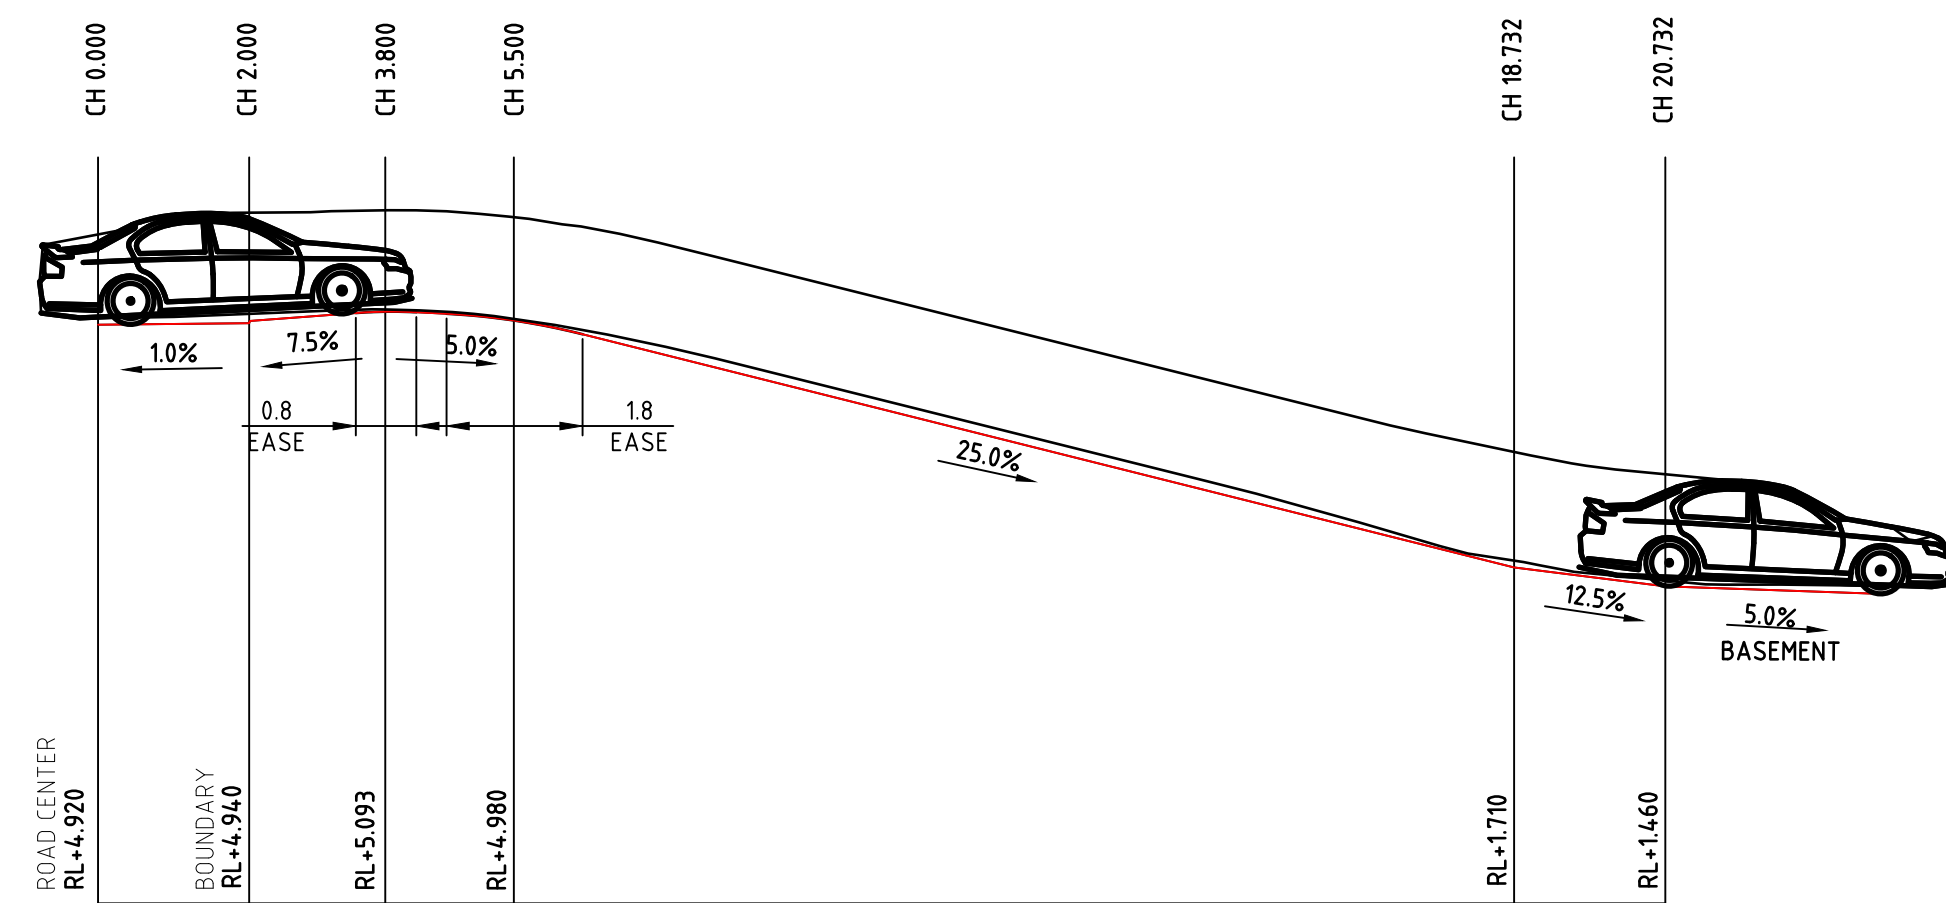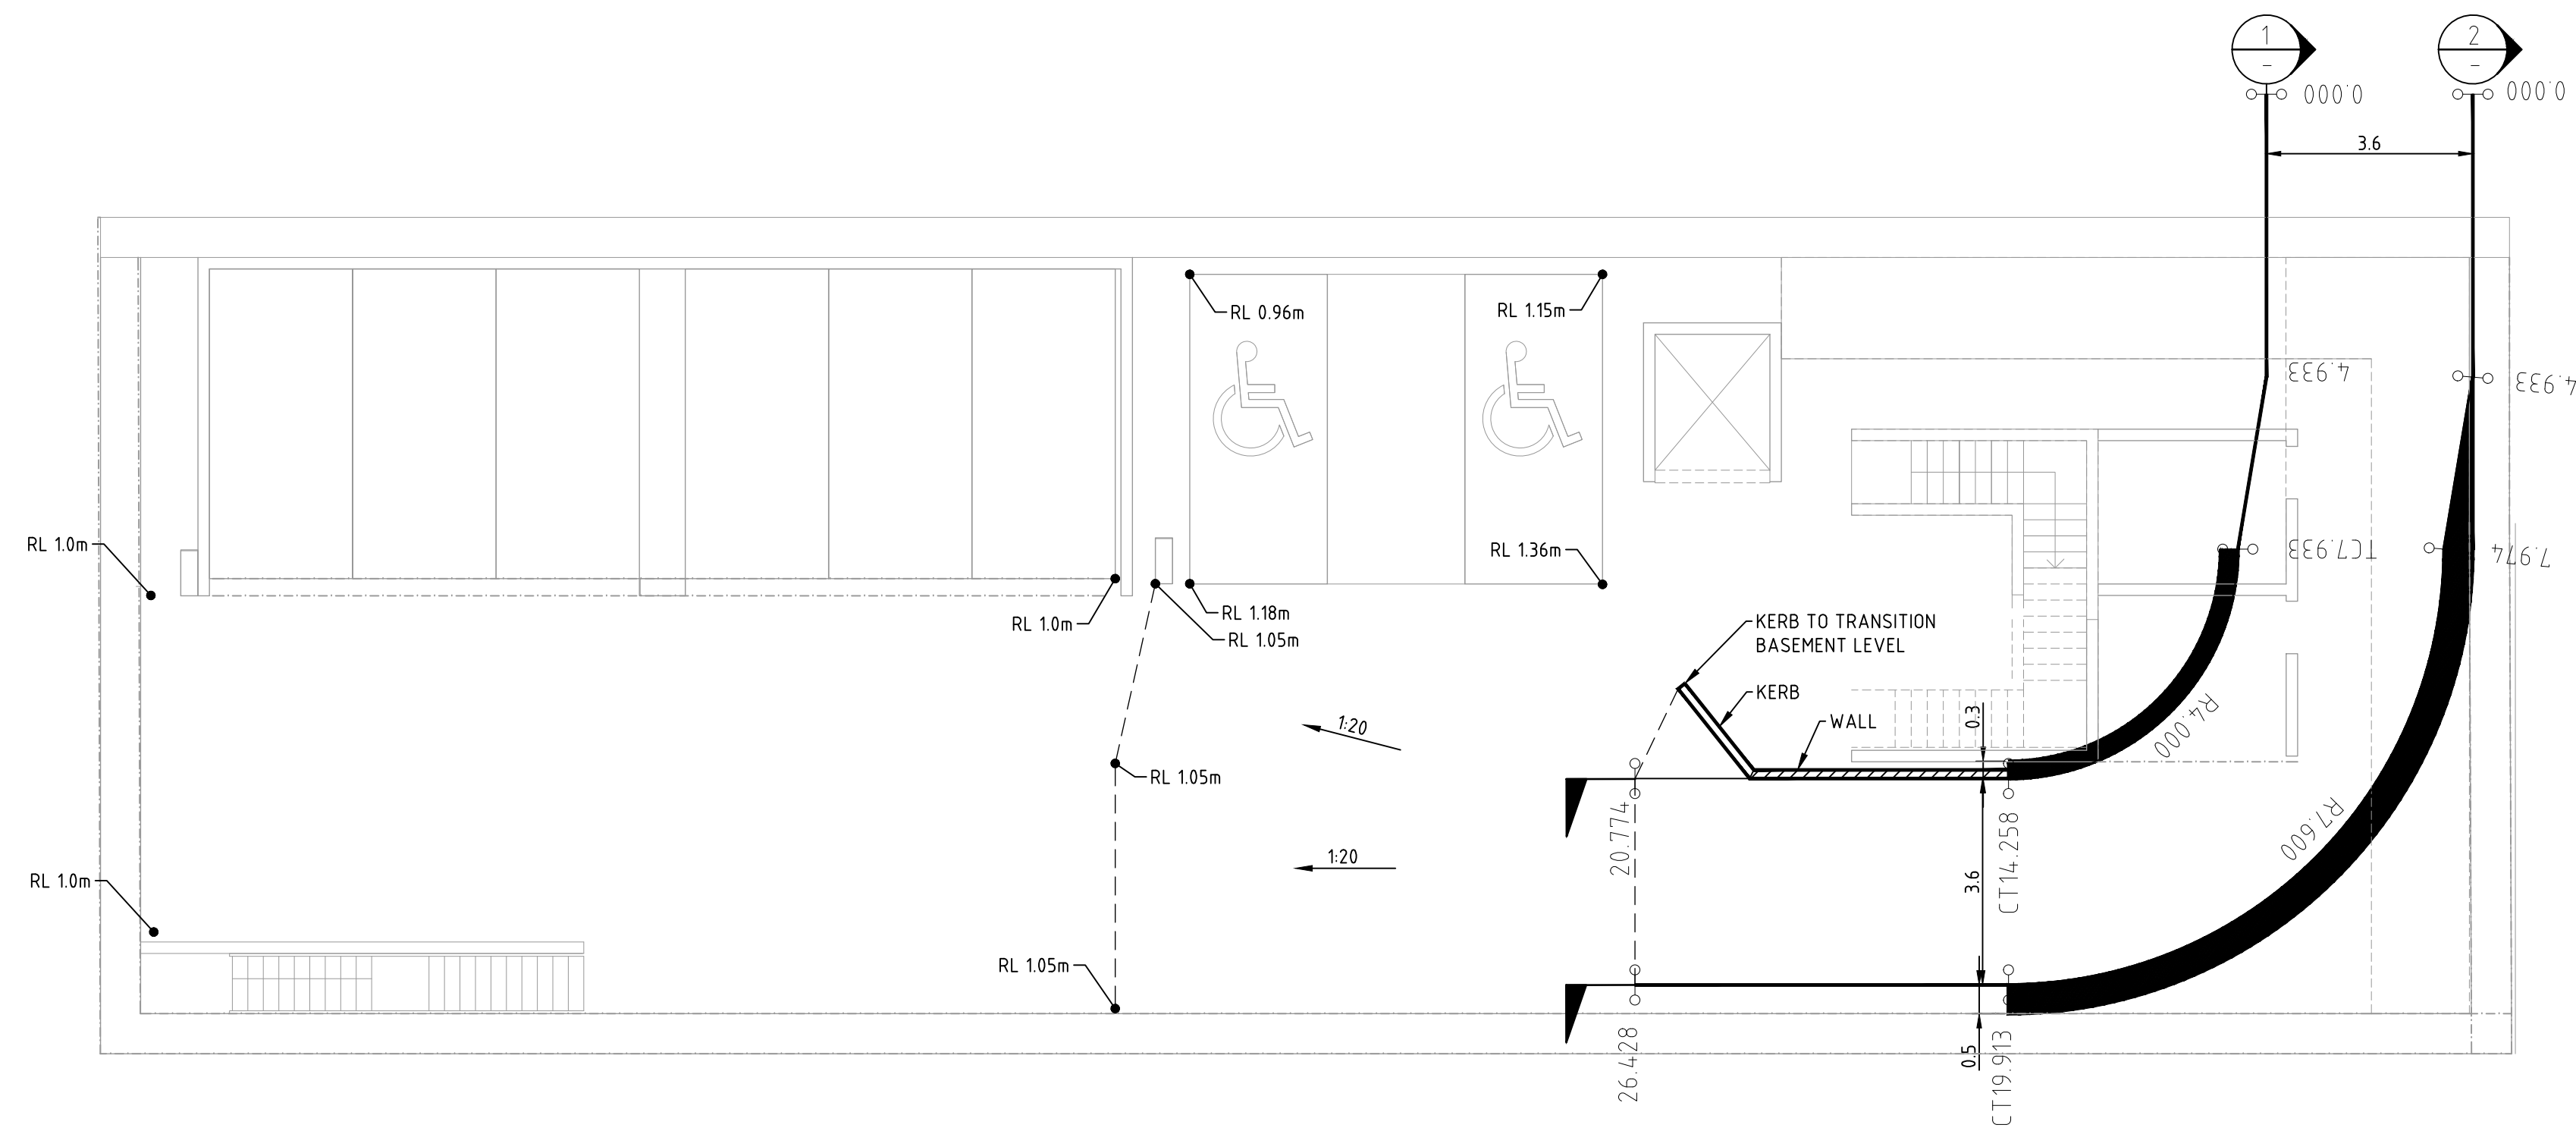[illegible]

Attachment 5

Vehicle Tracking Diagrams – Ground Level Parking

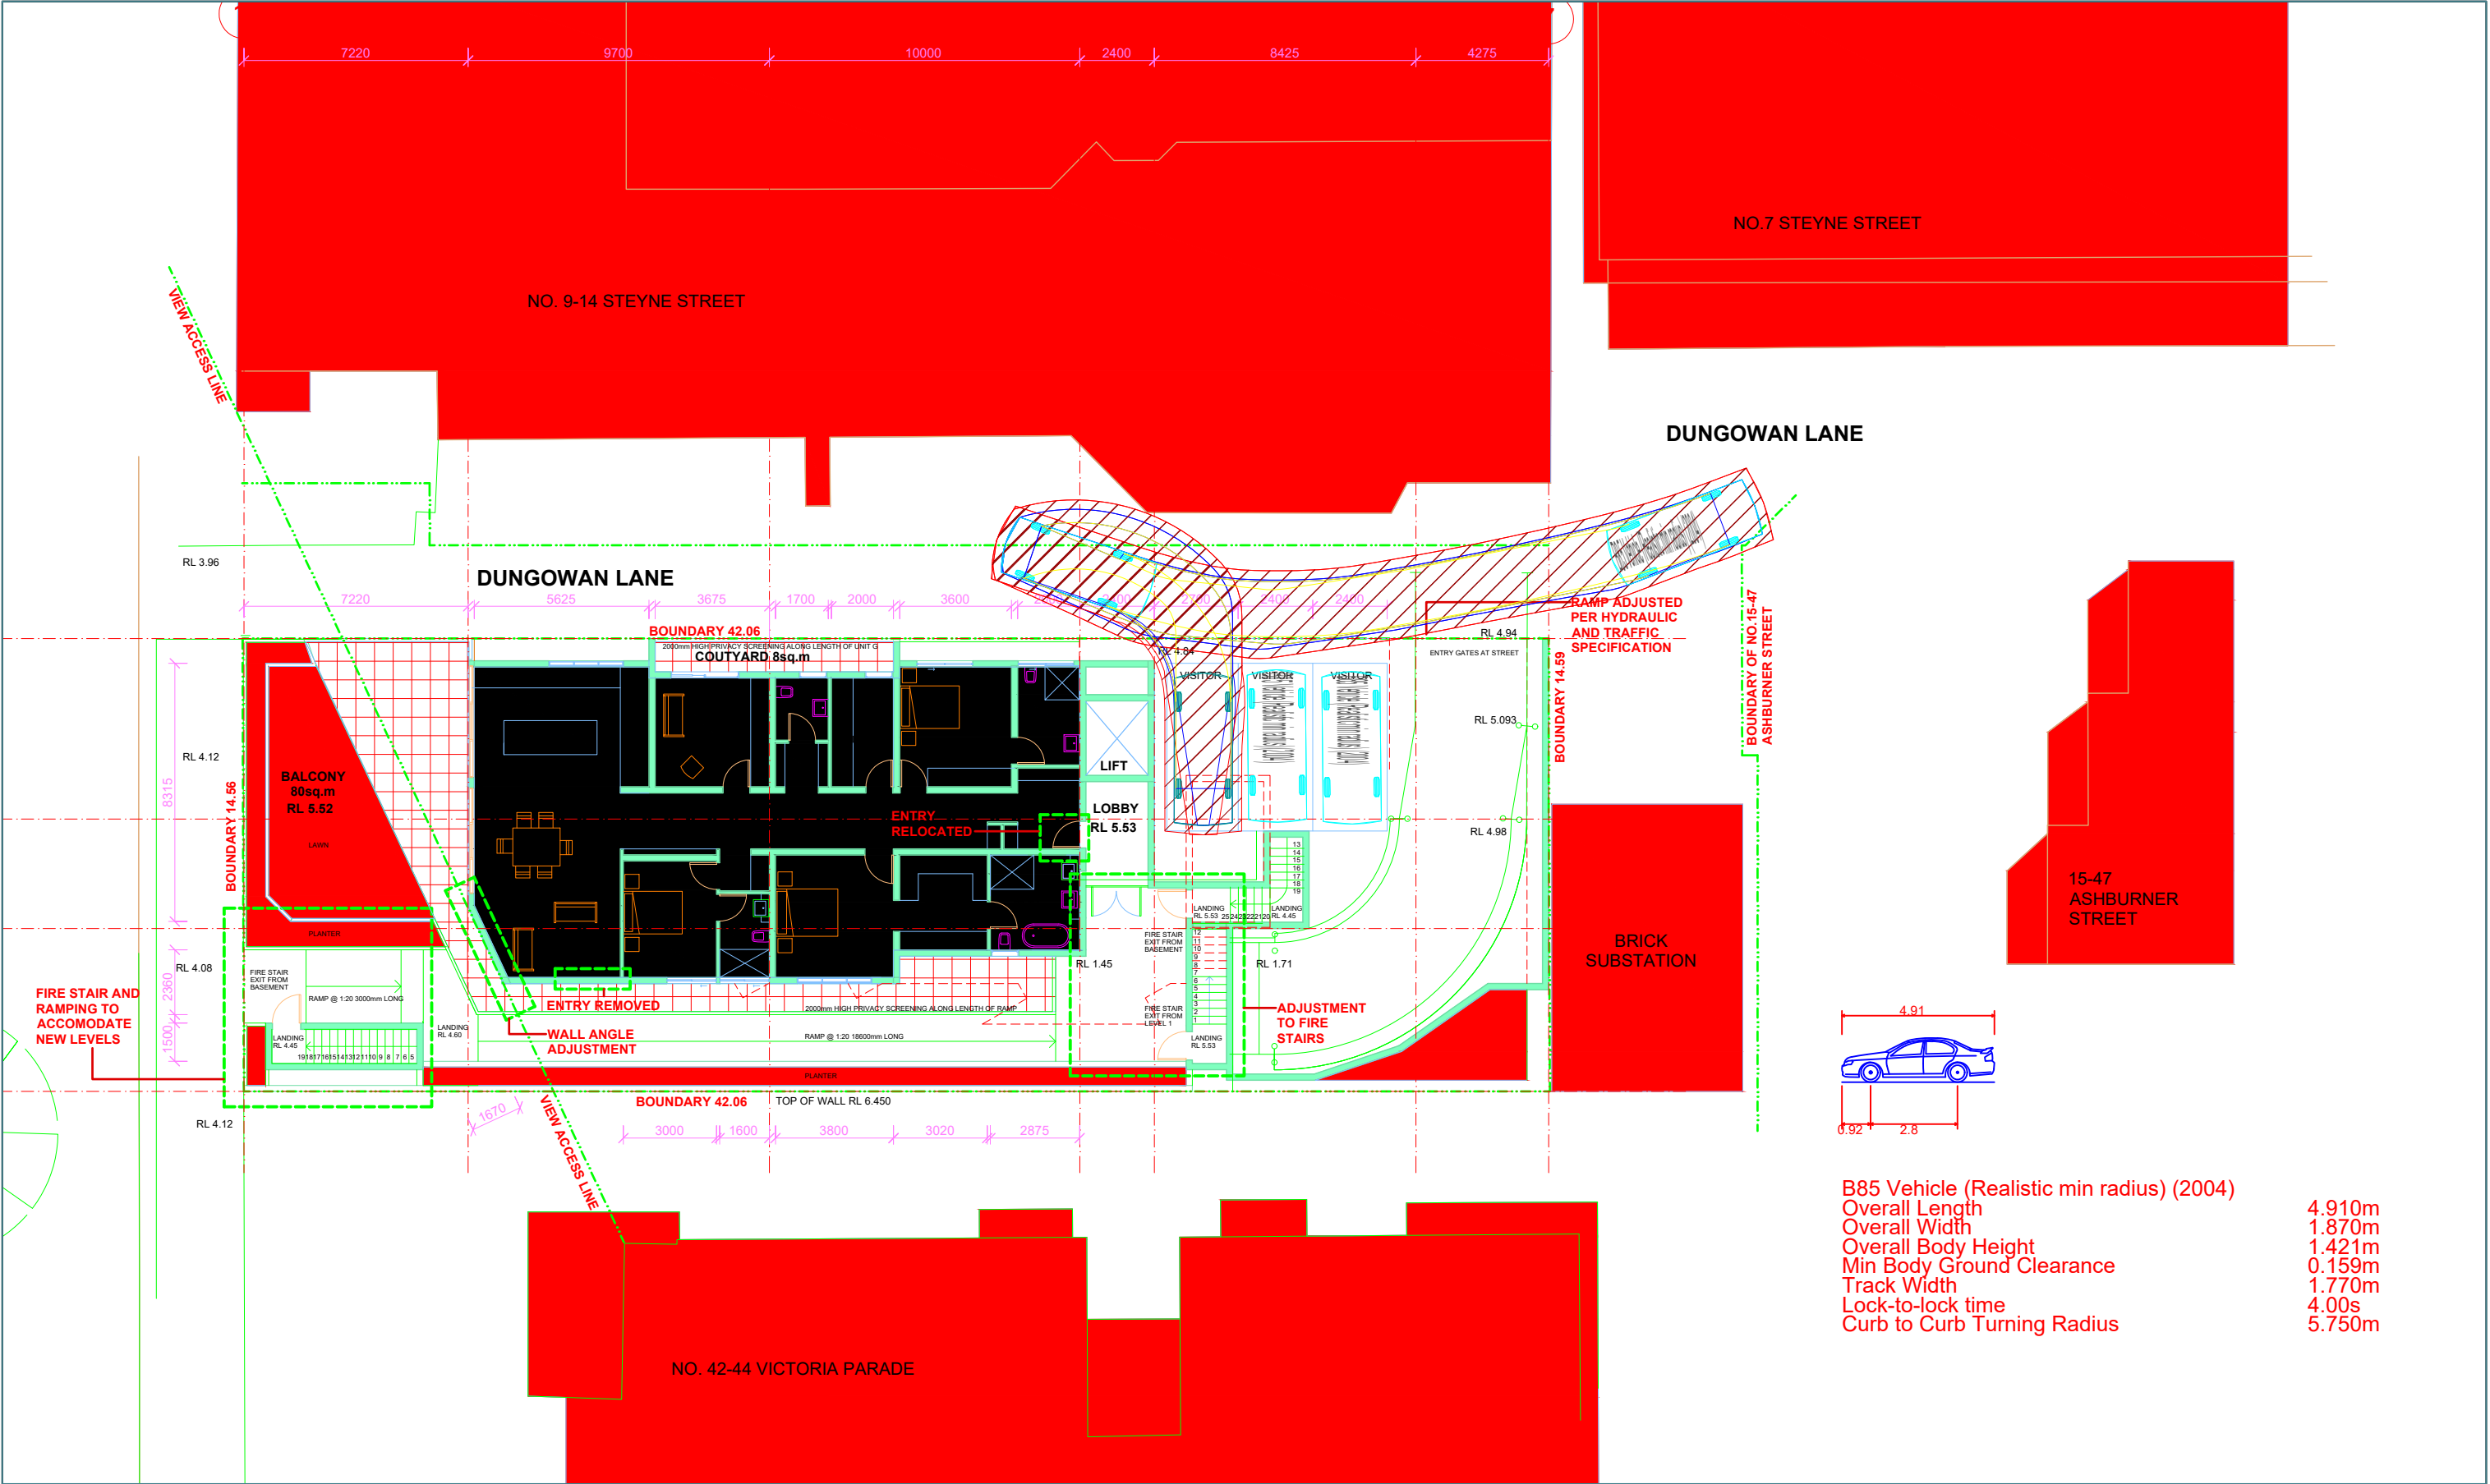

INROADS:GROUP

drawing prepared by

InRoads Group



PO Box 596
Potts Point NSW 1335
ABN: 25 608 559 897

project		46 Victoria Parade, Manly			
drawing title		Vehicle Tracking Analyses			
project no.	drawing no.	revision	date	scale	
18-014	DWG03	A	06/06/2018	1:200 @ A3	

FOR INFORMATION ONLY - NOT FOR CONSTRUCTION

InRoads Group is responsible for vehicle swept path diagrams and/or drawing mark-ups only. Base drawing prepared by others.

Vehicle swept path diagrams prepared using computer generated turning path software and associated drawing platforms. Vehicle data based upon relevant Australian Standards (AS/NZS 2890.1-2004 *Parking facilities - Off-street car parking*, and/or AS 2890.2-2002 *Parking facilities - Off-street commercial vehicle facilities*). These standards make allowance for a degree of tolerance, however the vehicle characteristics in these standards represent a suitable design vehicle and do not account for all variations in vehicle dimensions / specifications and/or driver ability or behaviour.

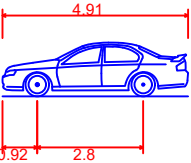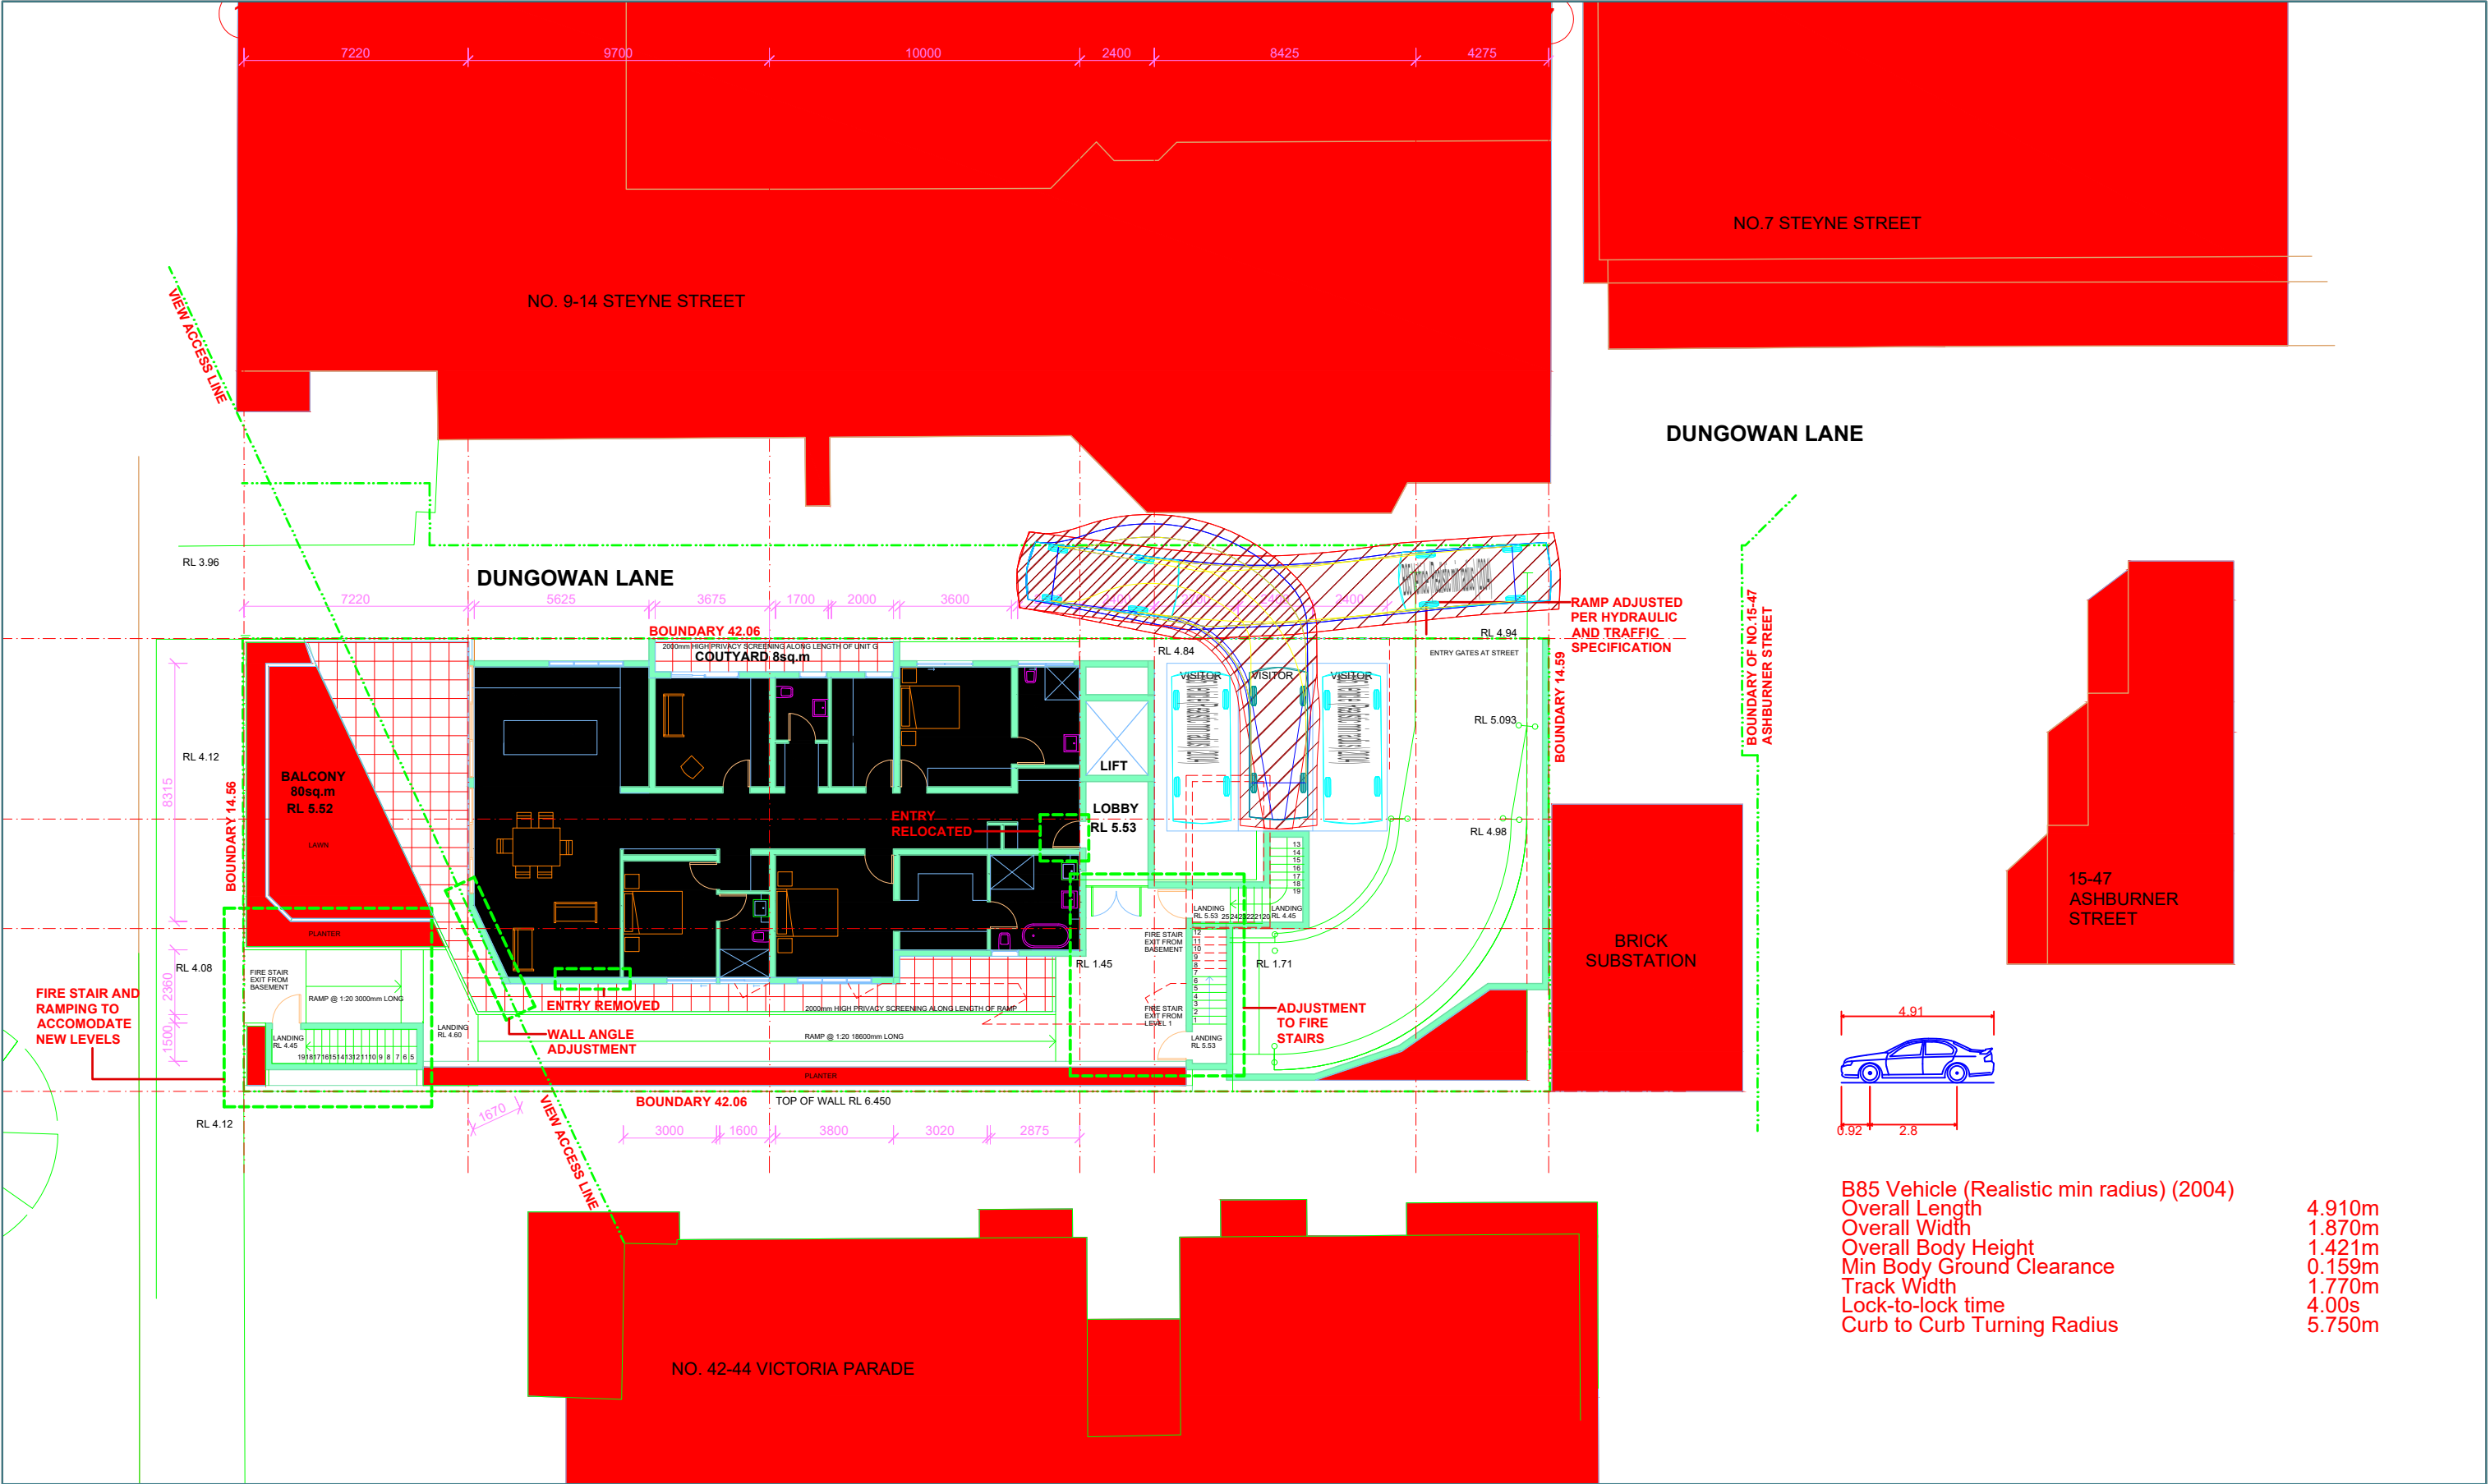

B85 Vehicle (Realistic min radius) (2004)	
Overall Length	4.910m
Overall Width	1.870m
Overall Body Height	1.421m
Min Body Ground Clearance	0.159m
Track Width	1.770m
Lock-to-lock time	4.00s
Curb to Curb Turning Radius	5.750m

INROADS:GROUP

drawing prepared by

InRoads Group


PO Box 596
Potts Point NSW 1335
ABN: 25 608 559 897

project		46 Victoria Parade, Manly			
drawing title		Vehicle Tracking Analyses			
project no.	drawing no.	revision	date	scale	
18-014	DWG04	A	06/06/2018	1:200 @ A3	

FOR INFORMATION ONLY - NOT FOR CONSTRUCTION

InRoads Group is responsible for vehicle swept path diagrams and/or drawing mark-ups only. Base drawing prepared by others.

Vehicle swept path diagrams prepared using computer generated turning path software and associated drawing platforms. Vehicle data based upon relevant Australian Standards (AS/NZS 2890.1-2004 Parking facilities - Off-street car parking, and/or AS 2890.2-2002 Parking facilities - Off-street commercial vehicle facilities). These standards make allowance for a degree of tolerance, however the vehicle characteristics in these standards represent a suitable design vehicle and do not account for all variations in vehicle dimensions / specifications and/or driver ability or behaviour.

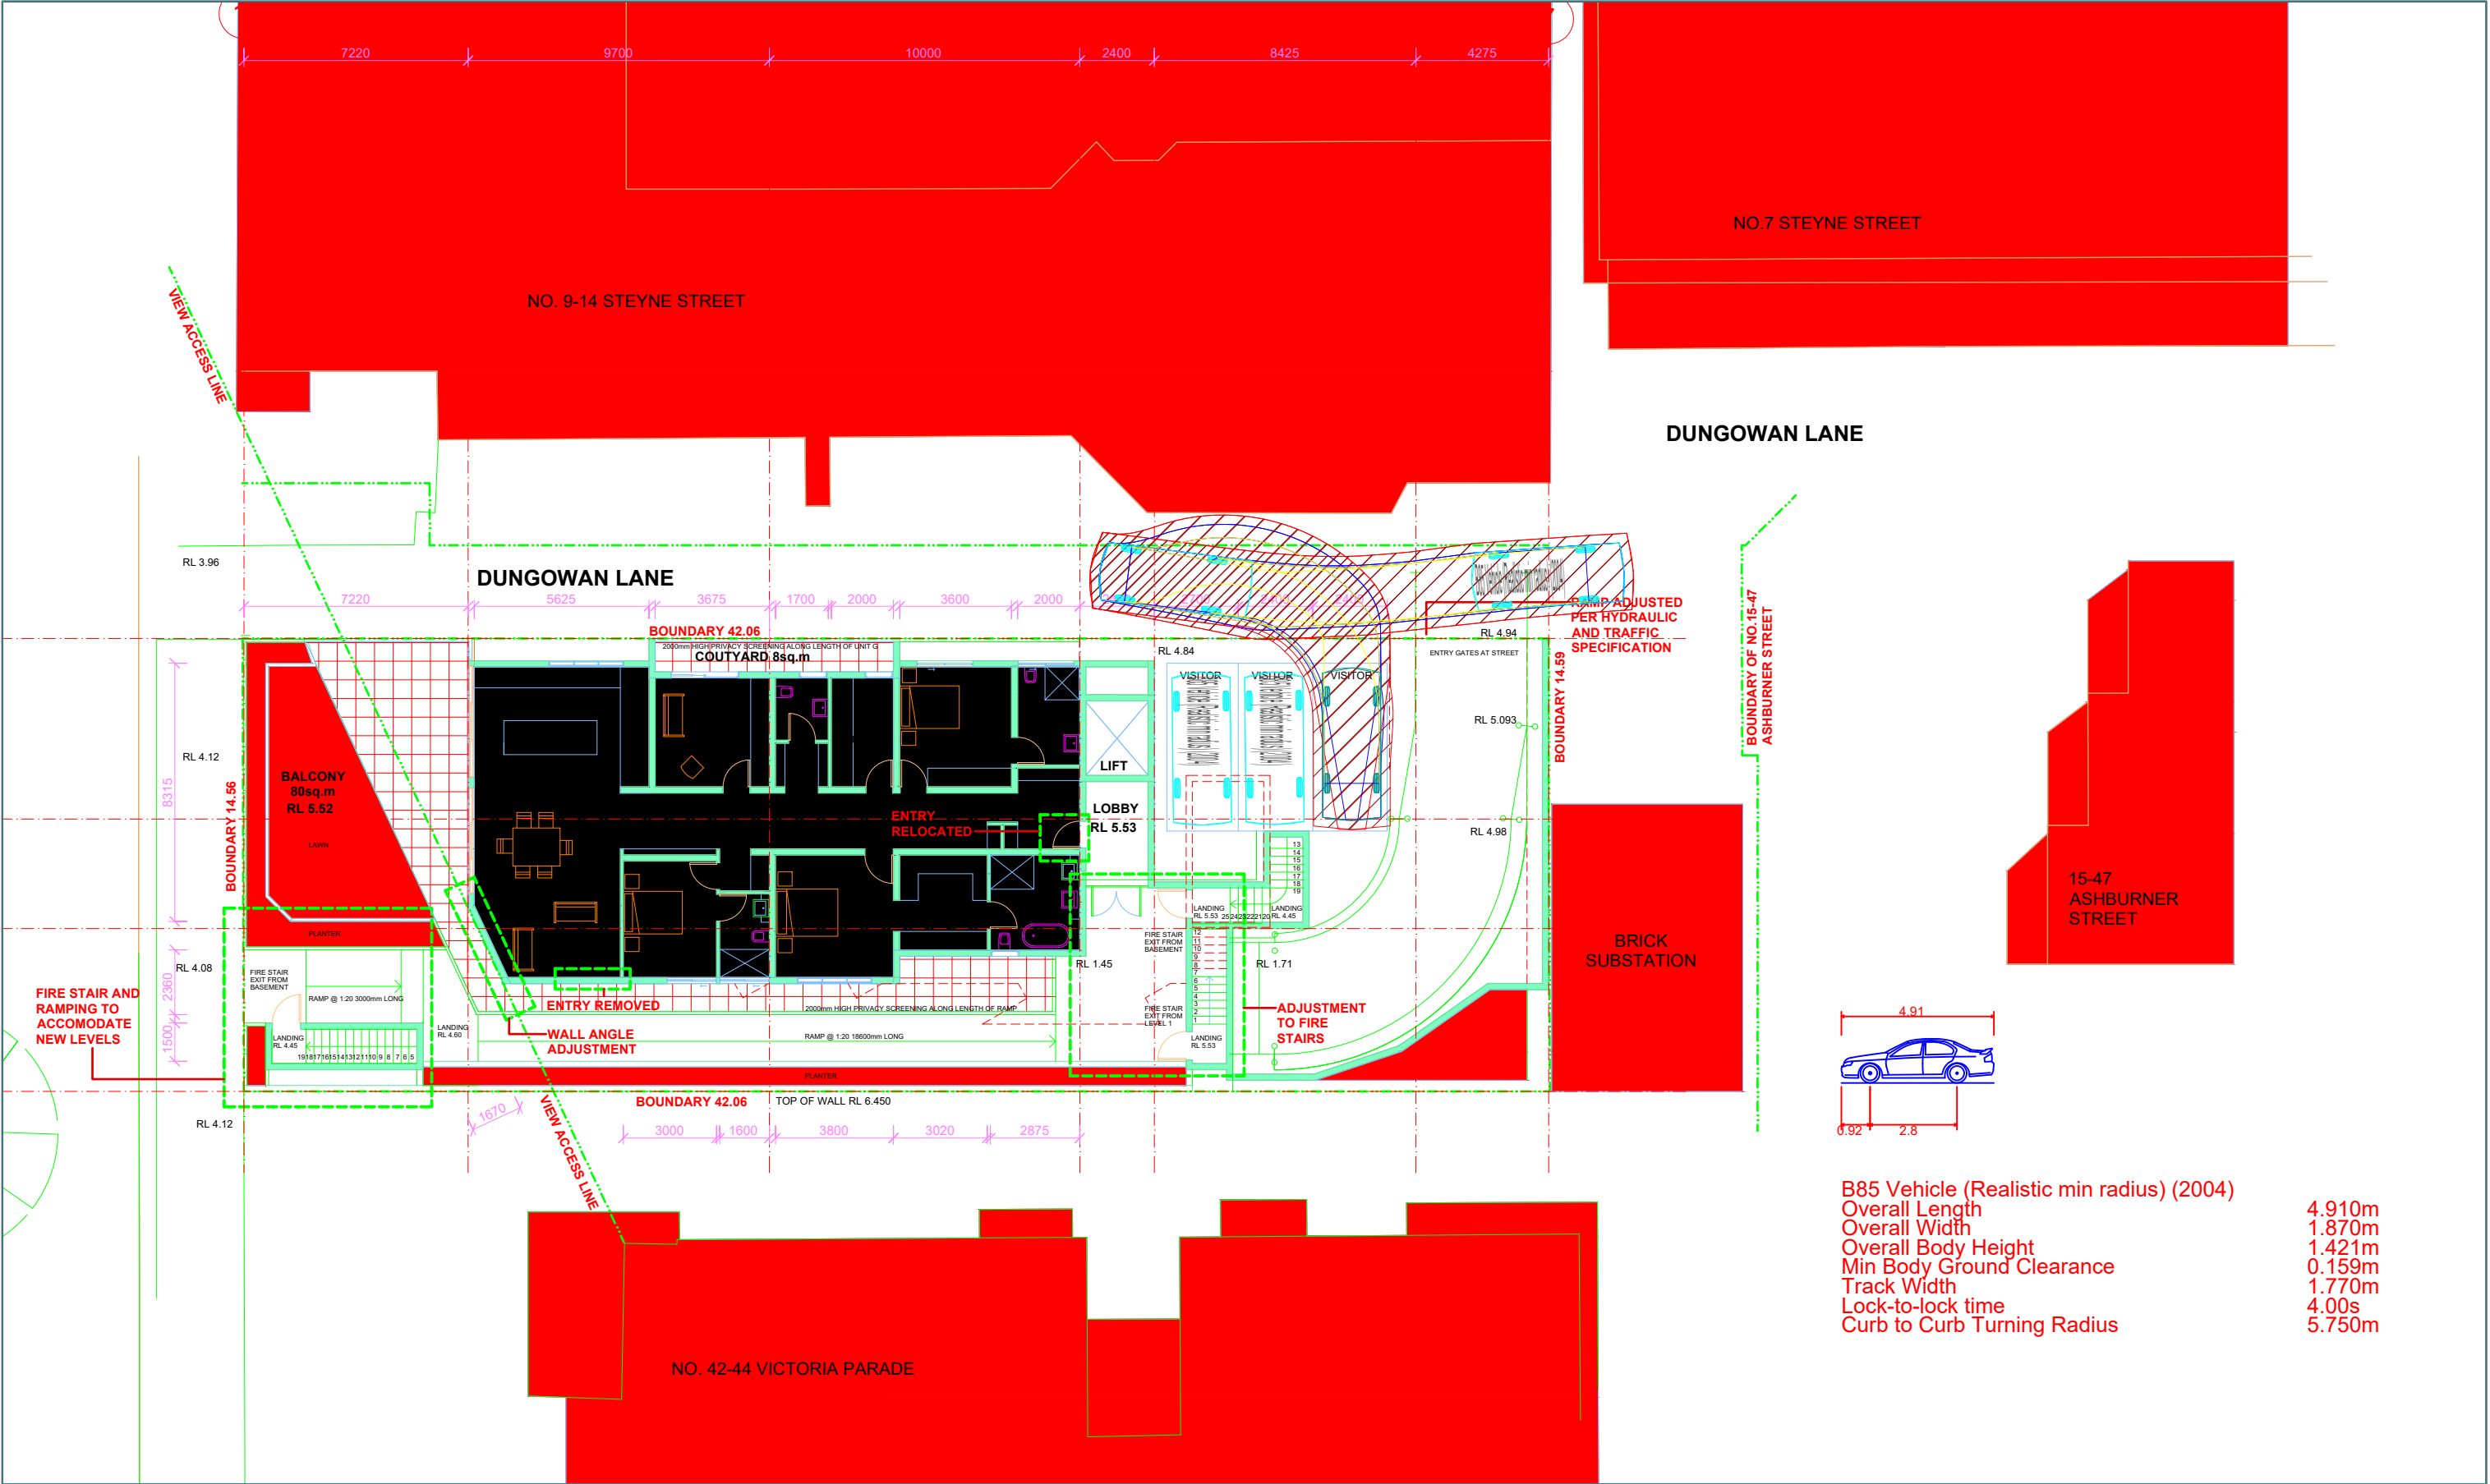

INROADS:GROUP

drawing prepared by

InRoads Group

PO Box 596
Potts Point NSW 1335
ABN: 25 608 559 897

project 46 Victoria Parade, Manly

drawing title Vehicle Tracking Analyses

project no.	drawing no.	revision	date	scale
18-014	DWG05	A	06/06/2018	1:200 @ A3


FOR INFORMATION ONLY - NOT FOR CONSTRUCTION

InRoads Group is responsible for vehicle swept path diagrams and/or drawing mark-ups only. Base drawing prepared by others.

Vehicle swept path diagrams prepared using computer generated turning path software and associated drawing platforms. Vehicle data based upon relevant Australian Standards (AS/NZS 2890.1-2004 Parking facilities - Off-street car parking, and/or AS 2890.2-2002 Parking facilities - Off-street commercial vehicle facilities). These standards make allowance for a degree of tolerance, however the vehicle characteristics in these standards represent a suitable design vehicle and do not account for all variations in vehicle dimensions / specifications and/or driver ability or behaviour.

Attachment 6

Vehicle Tracking Diagrams – Basement Parking

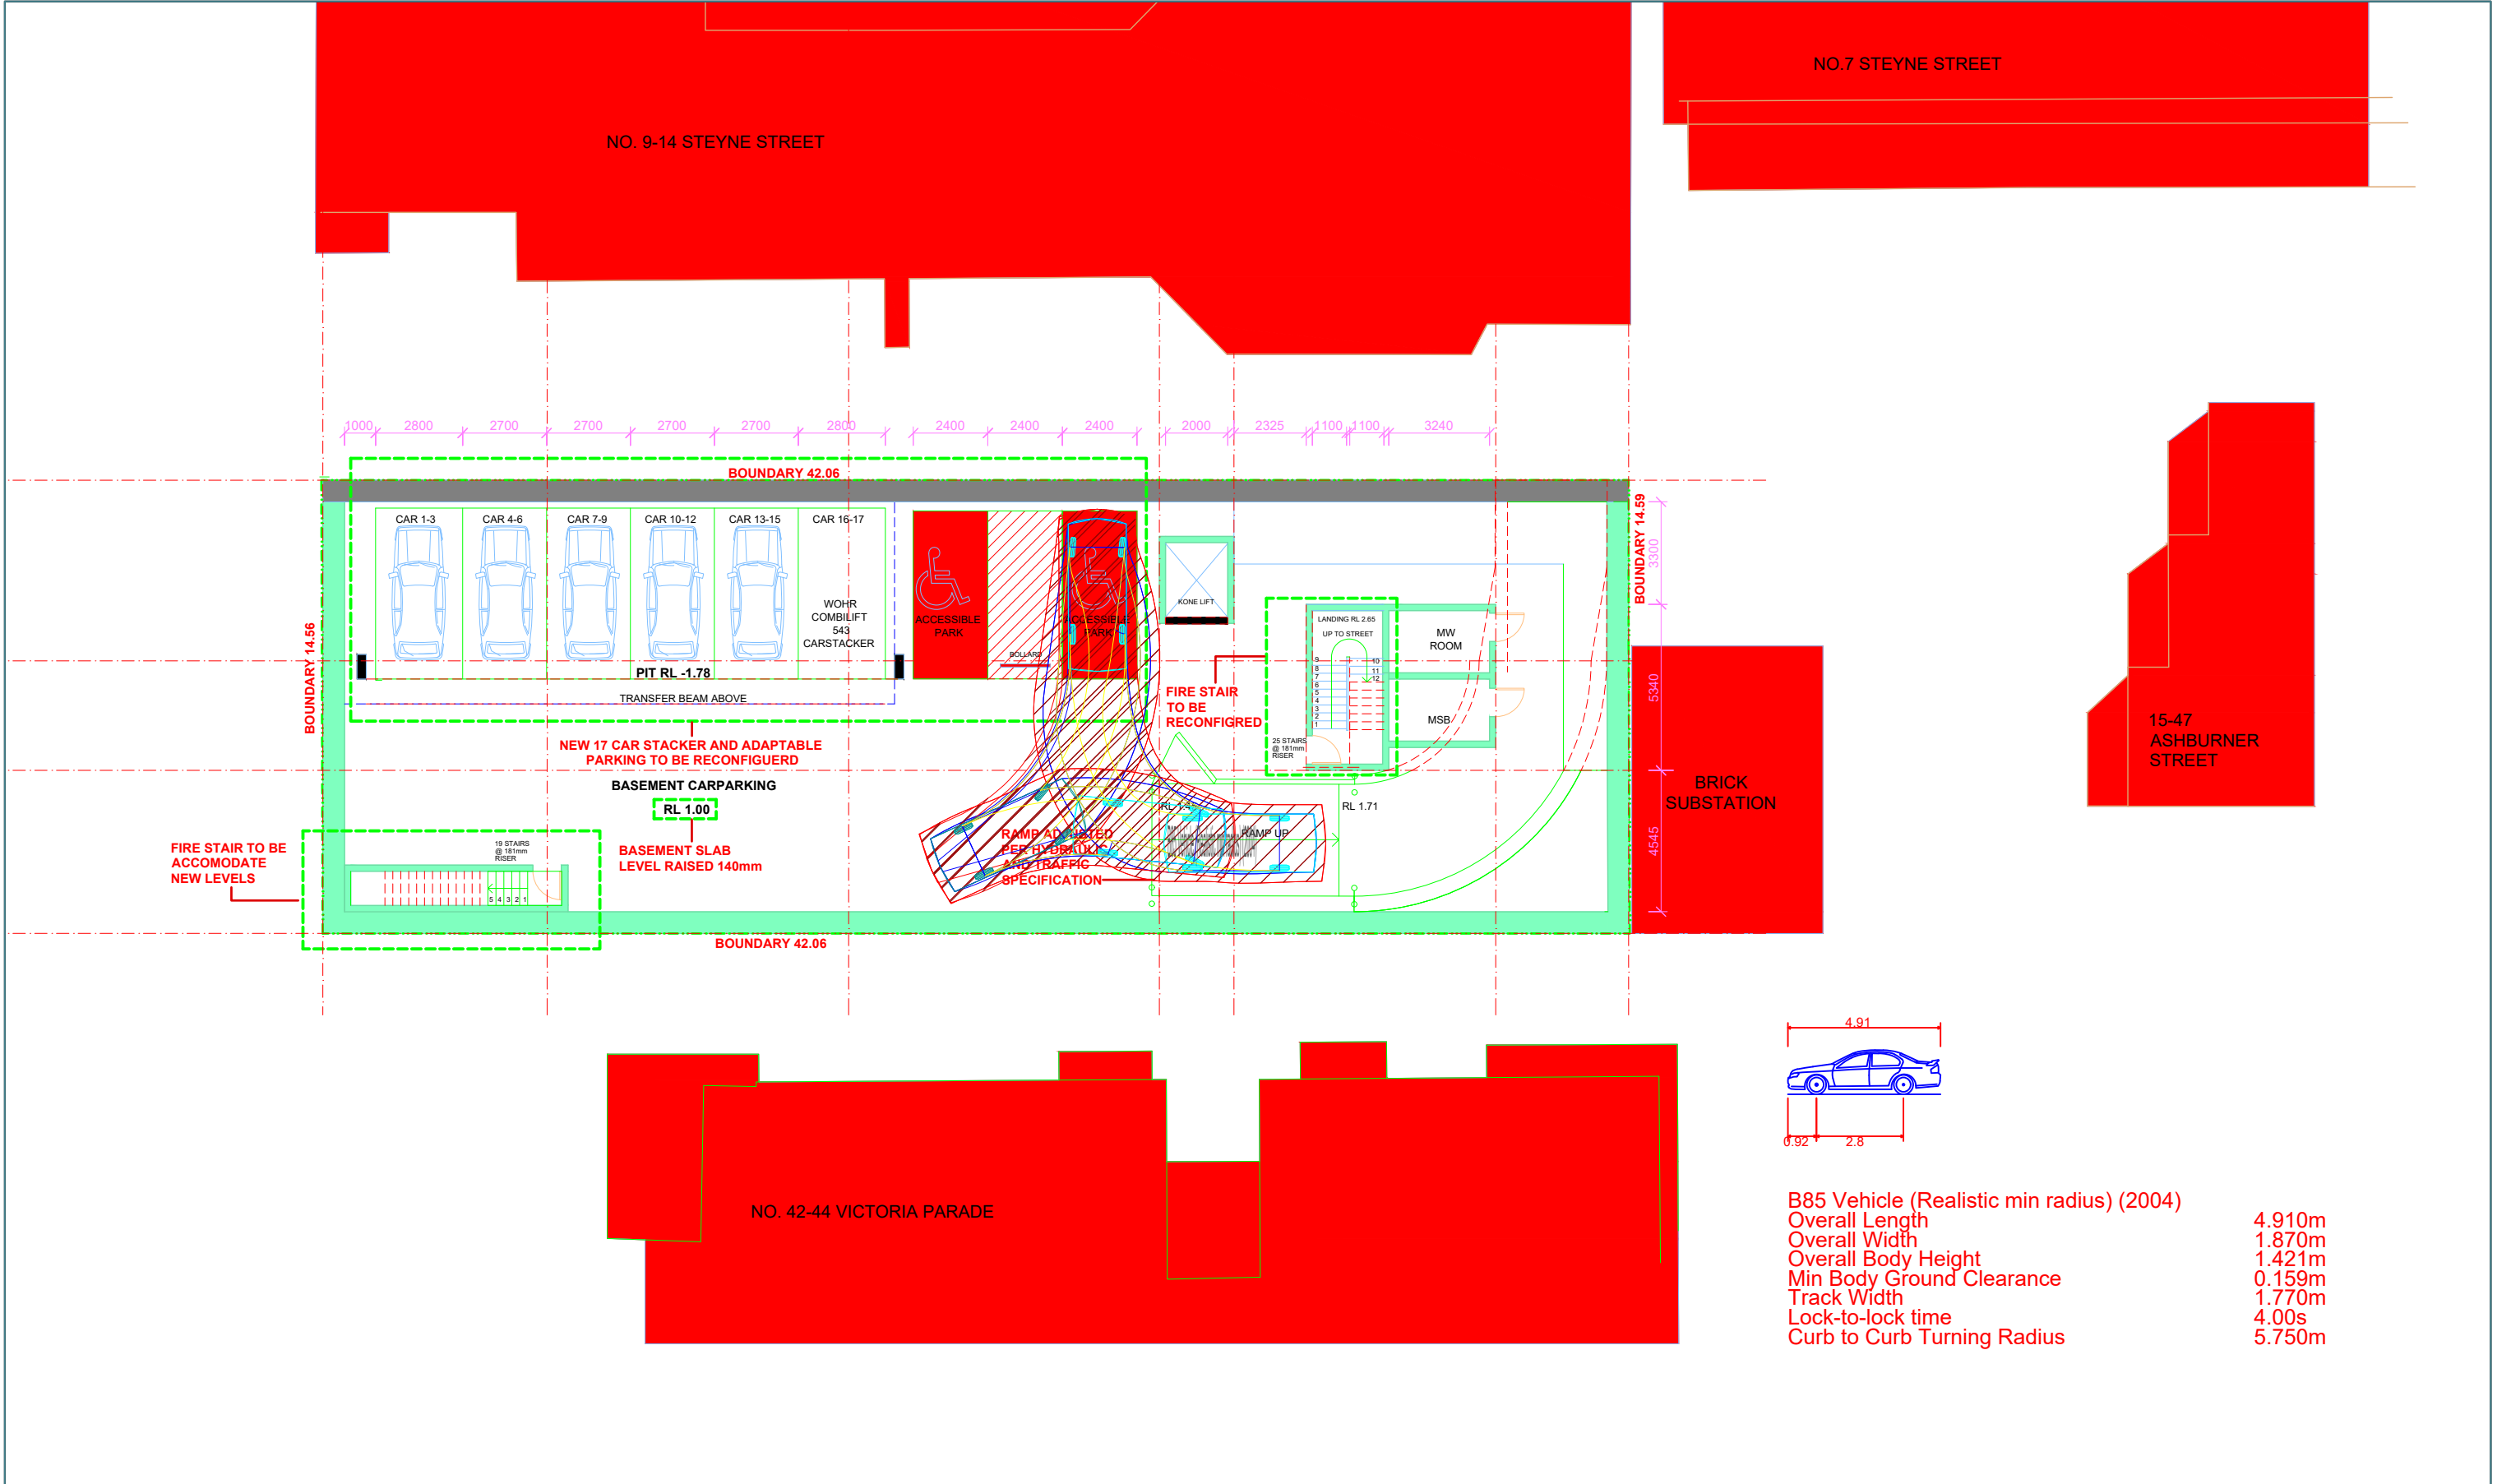

INROADS:GROUP

drawing prepared by

InRoads Group

PO Box 596
Potts Point NSW 1335
ABN: 25 608 559 897

project 46 Victoria Parade, Manly



drawing title Vehicle Tracking Analyses

project no.	drawing no.	revision	date	scale
18-014	DWG06	A	06/06/2018	1:200 @ A3

FOR INFORMATION ONLY - NOT FOR CONSTRUCTION

InRoads Group is responsible for vehicle swept path diagrams and/or drawing mark-ups only. Base drawing prepared by others.

Vehicle swept path diagrams prepared using computer generated turning path software and associated drawing platforms. Vehicle data based upon relevant Australian Standards (AS/NZS 2890.1-2004 *Parking facilities - Off-street car parking*, and/or AS 2890.2-2002 *Parking facilities - Off-street commercial vehicle facilities*). These standards make allowance for a degree of tolerance, however the vehicle characteristics in these standards represent a suitable design vehicle and do not account for all variations in vehicle dimensions / specifications and/or driver ability or behaviour.

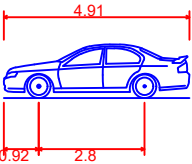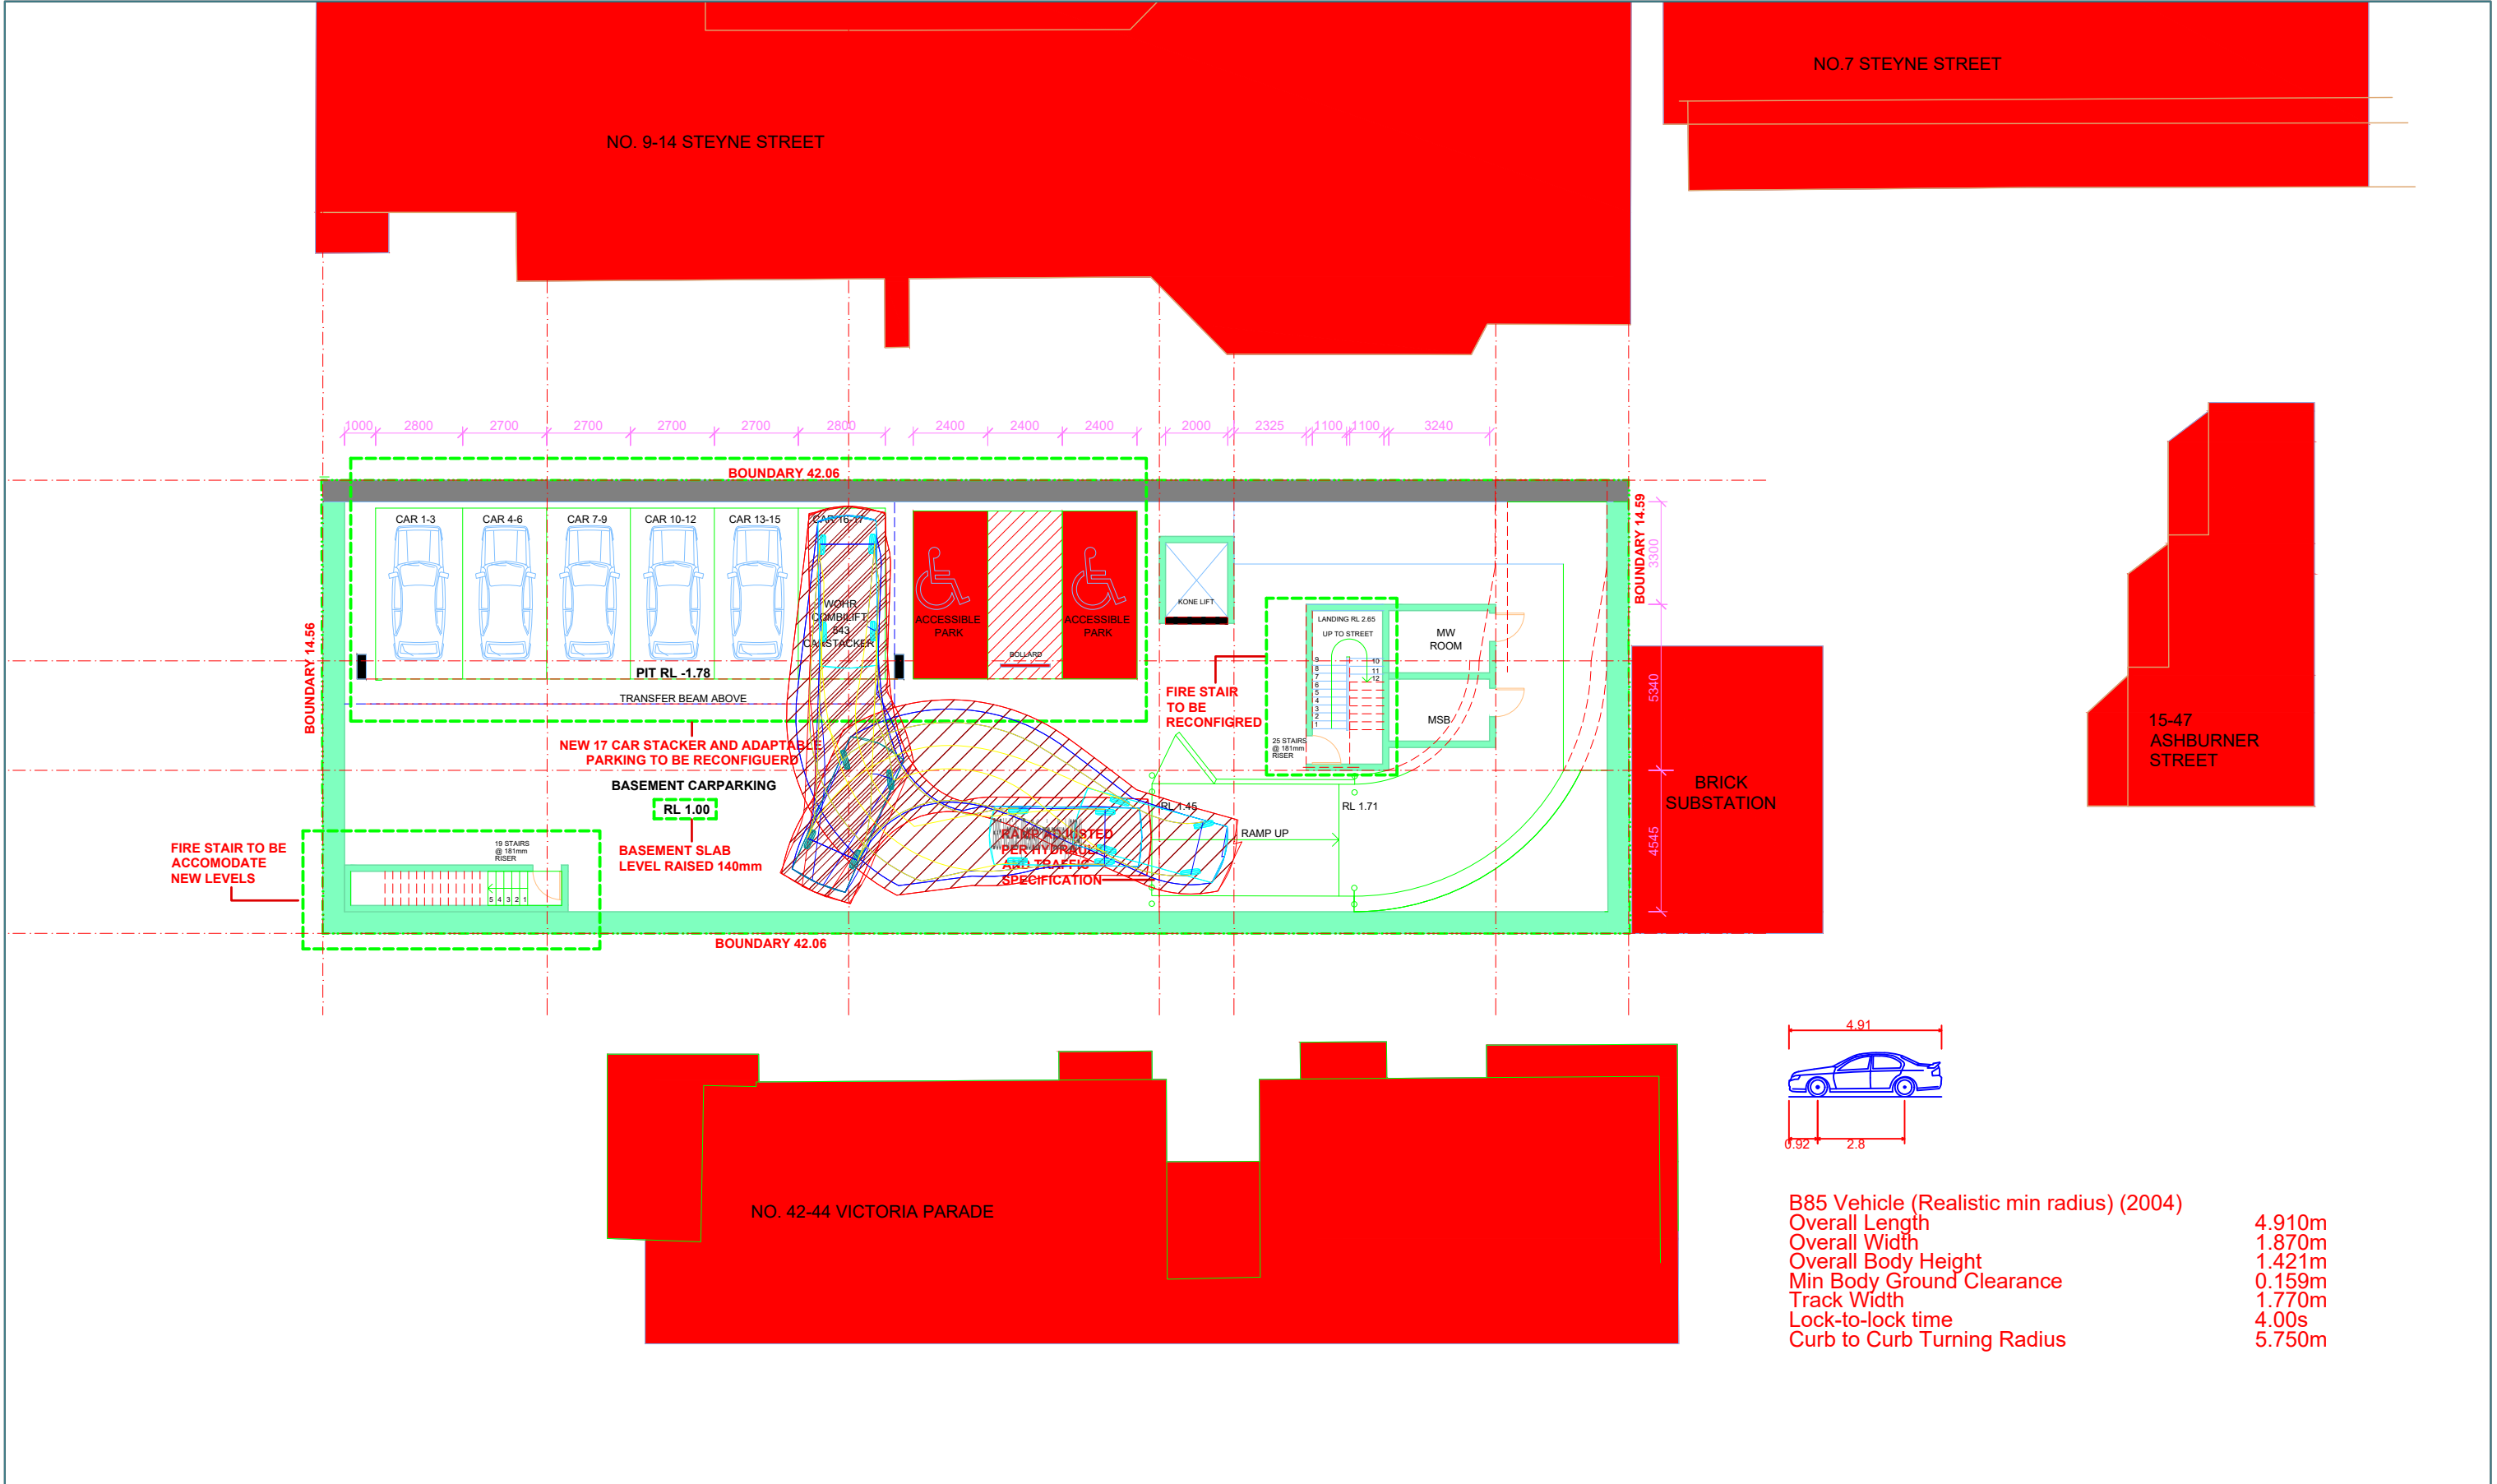

B85 Vehicle (Realistic min radius) (2004)	
Overall Length	4.910m
Overall Width	1.870m
Overall Body Height	1.421m
Min Body Ground Clearance	0.159m
Track Width	1.770m
Lock-to-lock time	4.00s
Curb to Curb Turning Radius	5.750m

INROADS:GROUP

drawing prepared by

InRoads Group


PO Box 596
Potts Point NSW 1335
ABN: 25 608 559 897

project		46 Victoria Parade, Manly			
drawing title		Vehicle Tracking Analyses			
project no.	drawing no.	revision	date	scale	
18-014	DWG07	A	06/06/2018	1:200 @ A3	

FOR INFORMATION ONLY - NOT FOR CONSTRUCTION

InRoads Group is responsible for vehicle swept path diagrams and/or drawing mark-ups only. Base drawing prepared by others.

Vehicle swept path diagrams prepared using computer generated turning path software and associated drawing platforms. Vehicle data based upon relevant Australian Standards (AS/NZS 2890.1-2004 Parking facilities - Off-street car parking, and/or AS 2890.2-2002 Parking facilities - Off-street commercial vehicle facilities). These standards make allowance for a degree of tolerance, however the vehicle characteristics in these standards represent a suitable design vehicle and do not account for all variations in vehicle dimensions / specifications and/or driver ability or behaviour.

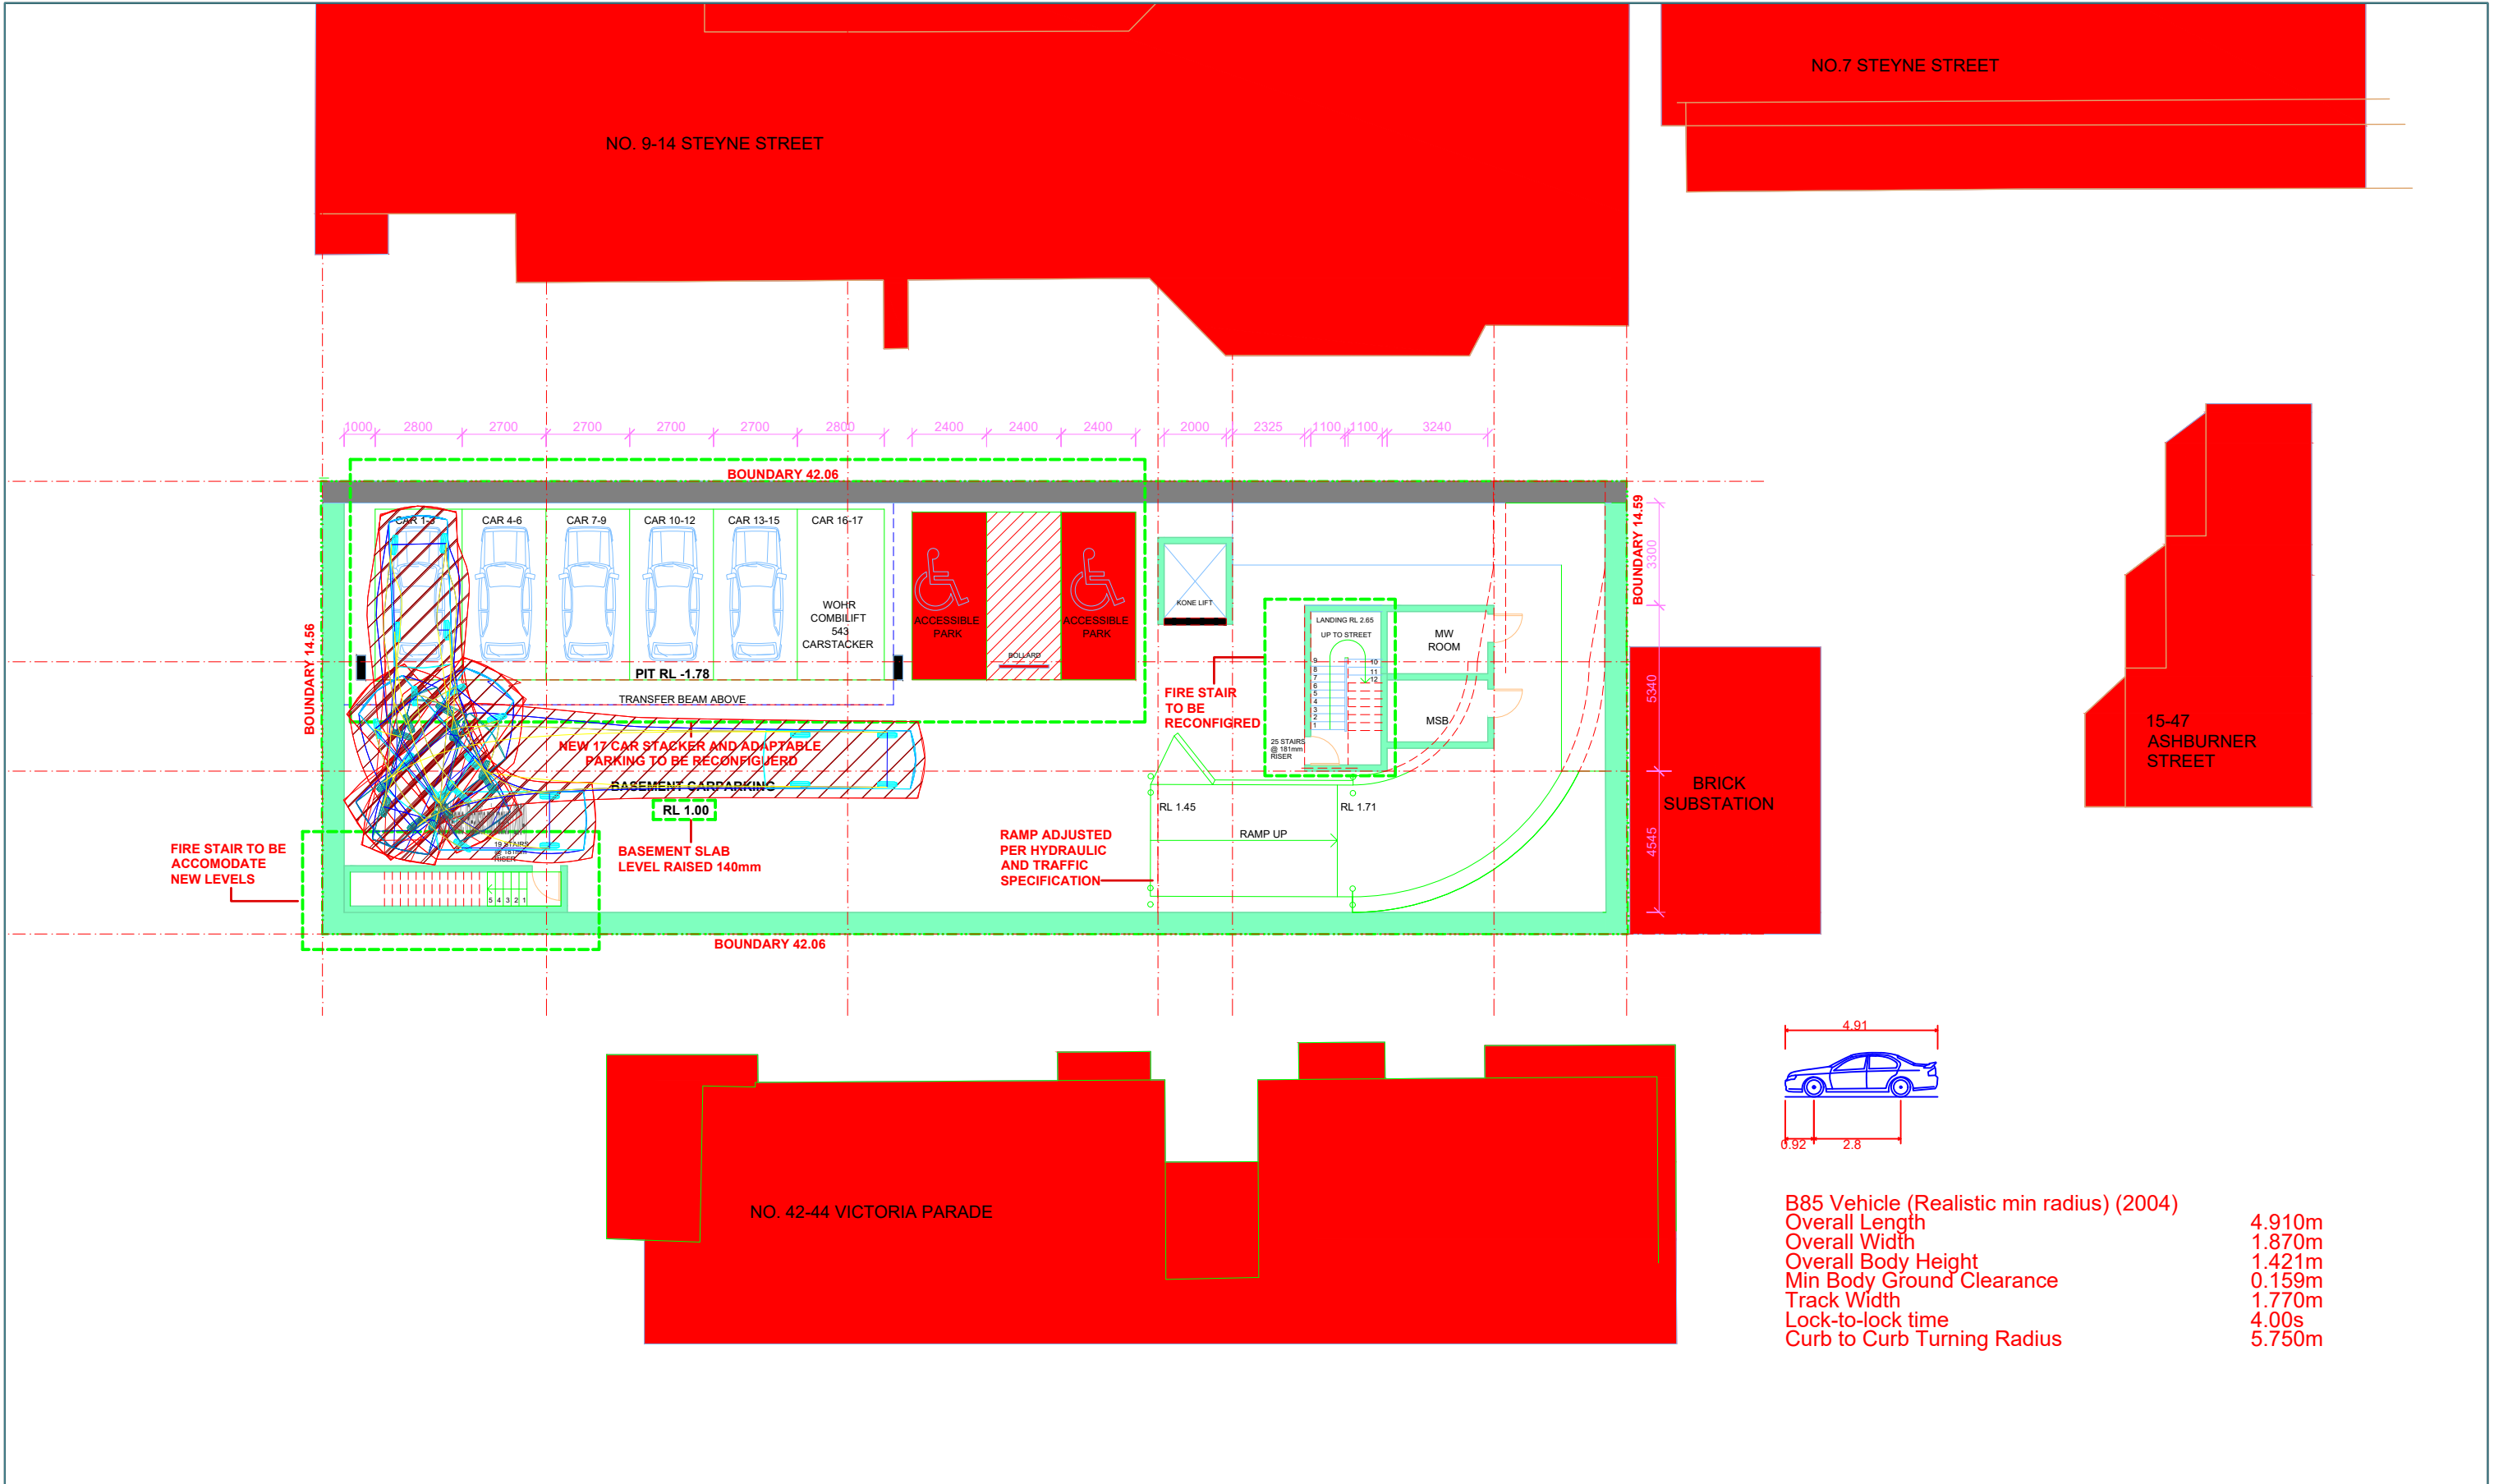

INROADS:GROUP

drawing prepared by

InRoads Group

PO Box 596
Potts Point NSW 1335
ABN: 25 608 559 897

project 46 Victoria Parade, Manly

drawing title Vehicle Tracking Analyses

project no.	drawing no.	revision	date	scale
18-014	DWG07	A	06/06/2018	1:200 @ A3

FOR INFORMATION ONLY - NOT FOR CONSTRUCTION

InRoads Group is responsible for vehicle swept path diagrams and/or drawing mark-ups only. Base drawing prepared by others.

Vehicle swept path diagrams prepared using computer generated turning path software and associated drawing platforms. Vehicle data based upon relevant Australian Standards (AS/NZS 2890.1-2004 Parking facilities - Off-street car parking, and/or AS 2890.2-2002 Parking facilities - Off-street commercial vehicle facilities). These standards make allowance for a degree of tolerance, however the vehicle characteristics in these standards represent a suitable design vehicle and do not account for all variations in vehicle dimensions / specifications and/or driver ability or behaviour.

Attachment 7

Specifications of Mechanical Parking Installation

* In case of short time user (e.g. for offices, hotels, a.s.o.) technical adjustments are required. Please contact WÖHR!


Platforms are in horizontal position to drive on.

Load per platform max. 2000 kg
(load per wheel max. 500 kg)

Special reinforced units for higher parking platform load are available (see 543-2,6).


X = Door offset
(see page 2 for details)

Dimensions in cm

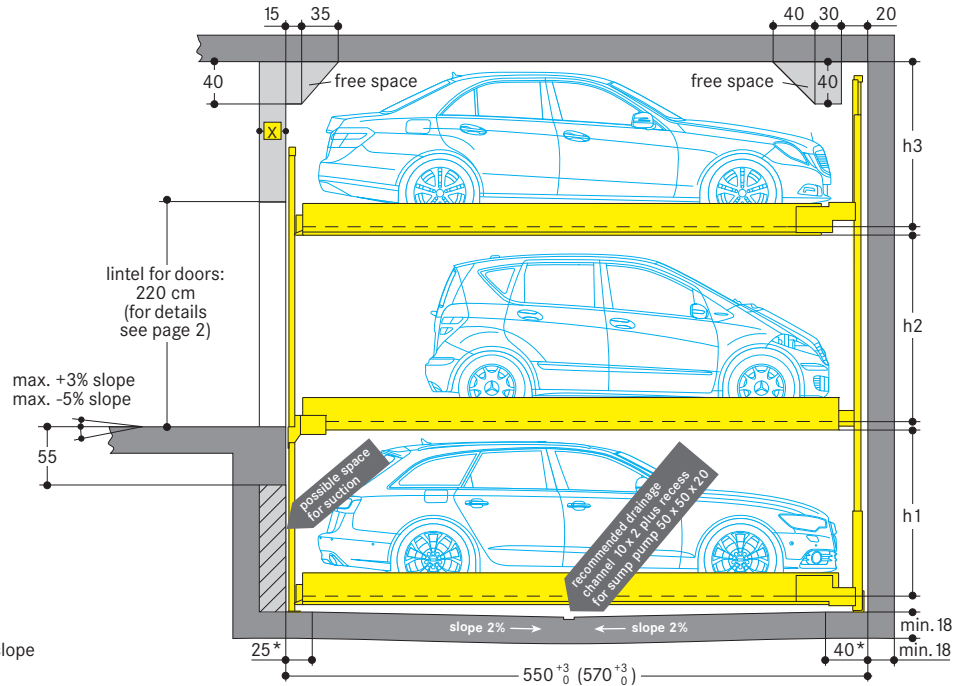

* in this zone, 0% of downward/upward slope in longitudinal and cross direction

Standard type 543 · 2000 kg

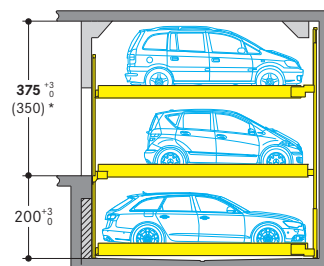


car height	distance
UL Cars/Station wagons up to 175 cm	h3 = 180
EL Cars/Station wagons up to 175 cm	h2 = 180
LL Cars/Station wagons up to 175 cm	h1 = 180

UL = upper level, EL = entrance level
LL = lower level

* If cars and station wagons with a height of up to **150 cm** are parked on the **upper level**, a clear height of **350 cm** above the entrance level is sufficient.


Comfort type 543 · 2000 kg

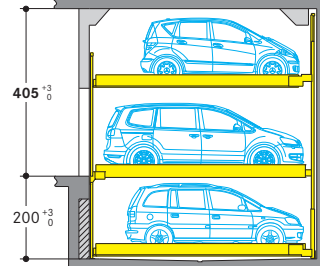

car height	distance
UL Cars/Station wagons up to 175 cm	h3 = 180
EL Cars/Vans up to 205 cm	h2 = 210
LL Cars/Station wagons up to 175 cm	h1 = 180

Cars/Vans up to 2000 kg max.
With greater h3 height-values, respectively higher cars can be parked on the upper level. Car heights cannot be greater than 205 cm.

Compact type 543 · 2000 kg

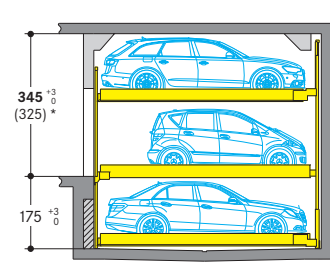


car height	distance
UL Cars/Station wagons up to 150 cm	h3 = 155
EL Cars/Station wagons up to 170 cm	h2 = 175
LL Cars/Station wagons up to 150 cm	h1 = 155

* If cars and station wagons with a height of up to **150 cm** are parked on the **entrance level**, a clear height of **325 cm** above the entrance level is sufficient.

Please attend to restricted car- and platform distance height!

Width dimensions

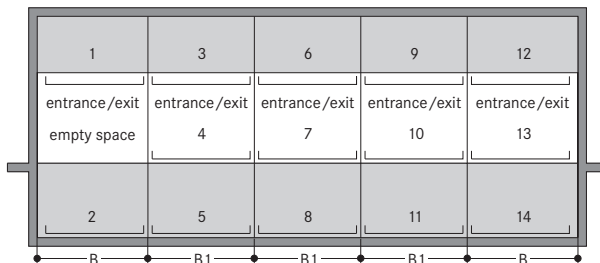

Space required	gives clear platform width
B B1	
260 250	230
270 260	240
280 270	250
290 280	260
300 290	270

One entry/exit is required on entrance level for each grid.

Notes

- Pits must always be protected by a sliding shutterdoor (even in underground garages).
- Arrangements start with 2 grids for 5 cars, 3 grids for 8 cars.
- Installation length of 550 cm for car length of a max. of 500 cm. Clear platform width of 250 cm for car widths of 190 cm. For large touring sedans we recommend a clear platform width of at least 260-270 cm.
- For large touring sedans an installation length of 570 cm is recommended. This length offers larger safety distances for potential future developments or projects with short term parkers such as hotels or similar.
- It is not possible to have channels or undercuts and/or concrete haunches along the pit floor-to-wall joints. In the event that channels or undercuts are necessary, the system width needs to be reduced or the pit needs to be wider.
- The manufacturer reserves the right to construction or model modifications and/or alterations. Furthermore, the right to any subsequent part modification and/or variations and amendments in procedures and standards due to technical and engineering progresses in the art or due to environmental regulation changes, are also hereby reserved.

Doors

According EN 14010, the Comblift 543 must be closed with shutters. The door controls are integrated in the overall system. That means:

- The doors are electro-mechanically interlocked.
- The doors can only be opened when the selected parking place has reached the entry/exit position.
- Any pits are closed in the entrance area.

Local requirements for electrical doors regarding the technology, maintenance and revision are not subject of our delivery. These matters have to be observed and carried out by the customer, according to the local regulations.

Door types:

Manually operated sliding shutters


- for underground garages with galvanized fence filling
- above ground with powder coated metal sheets (RAL 7030)

Alternatively, sliding shutters can be supplied with electrical drive.

Installation:

Behind the building pillars with door offset

Section

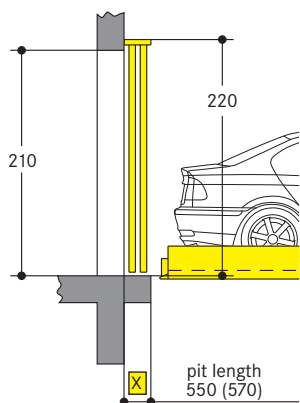


X = 25 cm for manually operated sliding shutters

X = 35 cm for automatic shutters


Installation:

Below the lintel between the building pillars

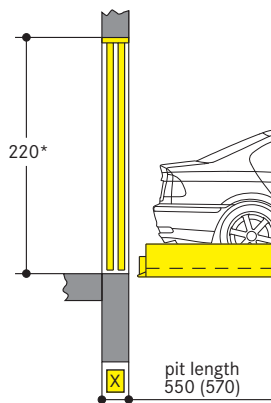


Installation:

In front of the building pillars

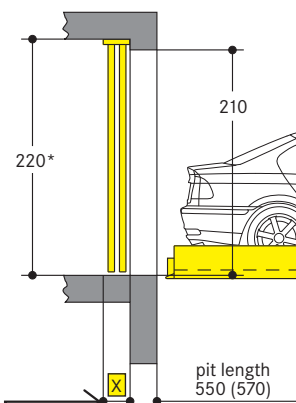

Ground plan

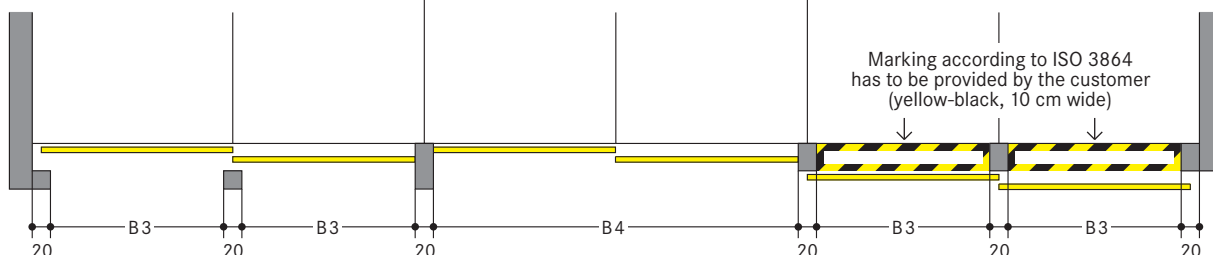

Space required	B3	B4	Gives clear platform width
230	480		230
240	500		240
250	520		250
260	540		260
270	560		270


* The lintel of 220 cm is absolutely necessary. With differing heights, additional fixings are required at a surcharge. If no lintel is provided, the gates need to be fitted onto a steel frame (subject to surcharges).

Floor guide for sliding shutters

Floor levelness in door guide range must be conformity with DIN 18202, table 3, line 3.

Hole depth for dowels approx. 8 cm.
Remark: When screed is applied in the door area to obtain floor levelness, the hole depth should be increased by screed thickness (max. 40 mm).


Finished floor acc. to DIN 18353
Floor levelness acc. to DIN 18202, table 3, line 3

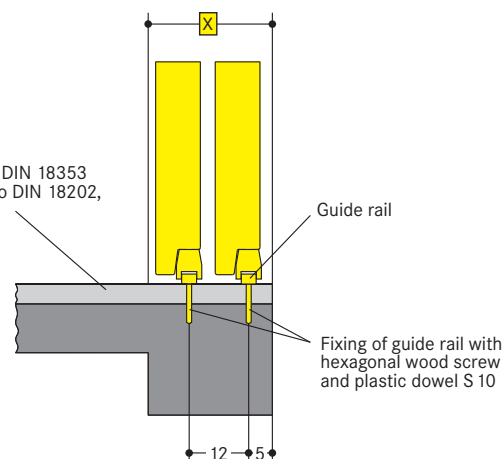

Width dimensions and statics

All dimensions shown are minimum. Constructional tolerances must be taken into consideration. All dimensions in cm.

Section

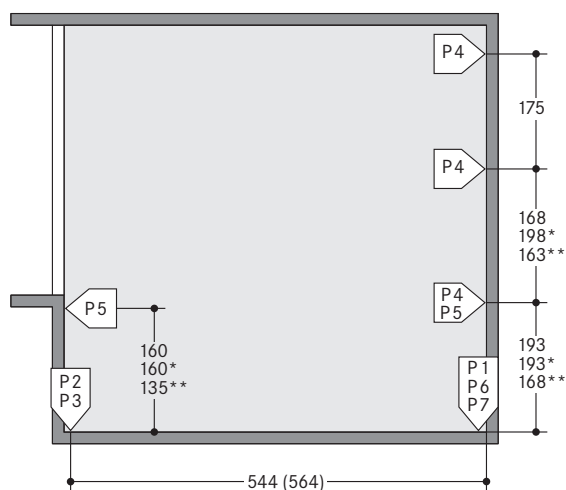

() dimensions in brackets for longer units

* dimensions for comfort type

** dimensions for compact type

P1 = +70,0 kN ¹⁾

P2 = +49,0 kN

P3 = +25,0 kN

P4 = ± 5,0 kN

P5 = ± 2,5 kN

P6 = ±30,0 kN

P7 = ±15,0 kN

¹⁾ all static loadings include the weight of the car

Bearing loads are transmitted by wall plates with min. 30 cm² surface and to the floor by base plates with min. 350 cm² surface.

Wall and base plates to be fixed by heavy duty anchor bolts to a drilling depth of 10-12 cm. When fixing to the waterproof concrete floors chemical anchors are employed (to be advised by Wöhr).


Base plate thickness min. 18 cm. Rear wall and base plate must be formed of concrete and must have a flat surface without protrusions.

Concrete quality according to the static building requirements, however for the dowel fixing concrete quality of min. C20/25 is required.

The specified lengths to the support points are mean values. Please contact Wöhr Agent for exact positions for any variations on the standard units.

Please contact Wöhr Agent for clarify the door widths/widths of columns. Grid width of 250/260/270/280/290 cm must be observed.

Ground plan

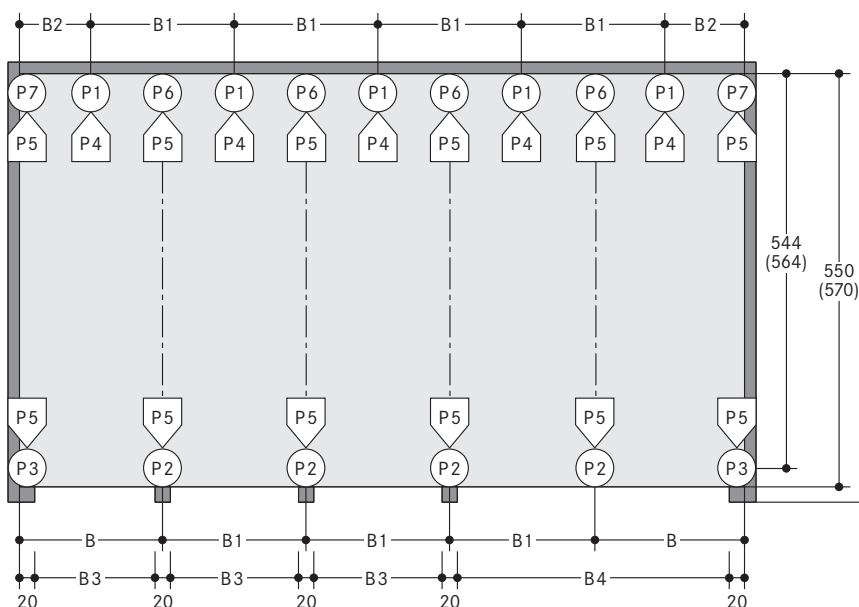

The driving aisle width to be compliant with country regulations locally in force.

Space required					gives clear platform width
B	B1	B2	B3	B4	
260	250	135	230	480	230
270	260	140	240	500	240
280	270	145	250	520	250
290	280	150	260	540	260
300	290	155	270	560	270

Notice:

If the width of the pillars is more than 20 cm, than the width of the drive through will be reduced accordingly to the above mentioned width dimensions. In order to avoid this, we recommend to extend the measures between the pillars (B3 and B4) accordingly. Please contact WÖHR.



Sam Technology

Sam Technology offers unique engineering solutions. We are a boutique company Established in 1934, having in-house solutions and associations with world expertise able to offer equipment and turn key solutions in the following fields of endeavour:

- Mining and materials handling
- Warehouse distribution
- Car Parking systems
- Rail maintenance equipment and turn key workshops
- Aircraft hangars and internal hangar maintenance systems
- Hangar and specialized door systems.
- Cranes, winches and associated equipment
- Consulting services including plant layouts, design specification and documents

Equipment and turn key installations are supported by service technicians employed at our Sydney and interstate offices.

Wohr Parking

About Wohr Parking Systems in Australia

WÖHR Autoparksysteme GmbH is a 5th generation family owned business, and has been since the opening of the WÖHR Scholesseri Metal Working shop in 1902.

Installation of the first parking system took place in 1959, and the first electromechanical parking system installation was completed in Munich for 162 car spaces in 1962.

The Parklift range was introduced in 1976 with the Parklift 412 system which is the predecessor of today's Parklift 450.

In 1988, both the first fully automatic system (Parksafe 580) and the Combilift range evolved.

Today, WÖHR Autoparksysteme GmbH has the largest range of parking systems available in the market and continue to push the envelope in terms of innovation and quality engineering.

WÖHR can also boast one of the widest distribution networks in the world with distribution in over 50 countries.

For over 20 years, WÖHR parking systems have been installed in Australia via their distributor network, however in September 2016 it was decided that a wholly owned subsidiary - Wöhr Parking Systems Australia – was to be founded.

Parking Equipment:

Designed and manufactured in Germany (EN14010:2003,MOD)

Turnkey Installation

Supplied according to AS 5124:2017

Maintenance, Every six months, by Sam Technology.

Options available for out of service calls.