


AWN - AWNING
BALC. BALCONY/DECK LEVEL
BB - BOTTOM OF BANK
BL - ROOM CENTER OF BANK
CL - ROAD CENTER LINE LEVEL
CONC - CONCRETE SURFACE LEVEL
DECK - DECK LEVEL
DHW - DRILL HOLE & WING
ELEC - ELECTRICAL PIT
ELEC - ELECTRICAL PILLAR
FD - FOUND
TPIT - TELECOM COMMUNICATION PIT
FLR - FLOOR LEVEL
GAS - GAS METER
GDN - GARDEN LEVEL
GRATE - GRATED PIT LEVEL
GUT - ROOF GUTTER LEVEL
HH - HILLS HOIST
IC - INSPECTION CAP
INV - INVERT LEVEL
KT - TOP OF KERB LEVEL
KI - KERB INVERT LEVEL
LP - LIGHT POLE
PAR - PARAPET
PAT - PATIO LEVEL
PIT - STORMWATER PIT
PINV - PIT INVERT
PP - POWER POLE
ROOF - ROOF LEVEL
SI - SIGN POLE
SIC - SEWER INSPECTION CAP
SMH - SEWER MAINTENANCE HOLE
SPHT - SPOT HEIGHT / NATURAL SURFACE LEVEL
STEP - STEP LEVEL
SVENT - SEWER VENT
TG - TOP OF BANK
TG - TOP OF GUTTER
TPIT - TELECOM PIT
TPIL - TELECOM PILLAR
VC - VEHICLE CROSSING
WALL - WALL LEVEL (TOW- TOP OF WALL, BOW- BOTTOM OF WALL)
WM - WATER METER

CONTOUR INTERVAL - 0.5m

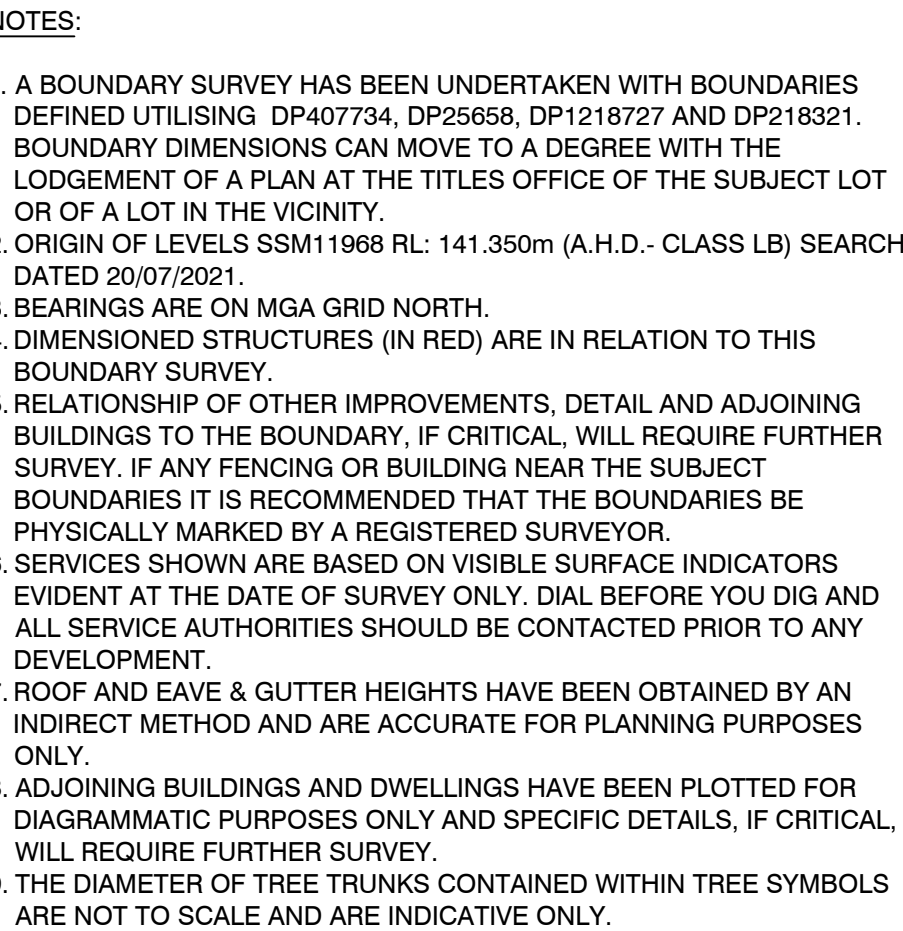

(A) - EASEMENT FOR DRAINAGE 1.83 WIDE (DP407734 - DEALING F51939)

WALL TO BOUNDARY SHOWN IN RED

ANDREW KOROMPAY ID No.SU000114
Surveyor Registered under The Surveying Act, 2002

PLAN OF DETAIL OVER
No. 6 ELLIS ROAD
BEACON HILL, NSW, 2100.



SCALE: 1:100 @ A1 : 1:200 @ A3		DATE: 28/07/2021
CLIENT: ANDREA ARRISUENO & NATHAN BEILKEN		DATUM: AHD
2292TN		SHEET 1 OF 1
DRAWN	CHECKED	APPROVED
NC	AK	AK
DRAWING No. 2292TN		REVISION 0