


NORTH

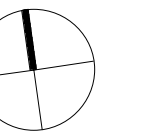


THESE DESIGNS, PLANS & SPECIFICATIONS AND THE
COPYRIGHT THEREIN ARE THE PROPERTY OF THE
ARCHITECT AND MUST NOT BE USED, REPRODUCED OR COPIED
WHOLLY OR IN PART WITHOUT THE WRITTEN PERMISSION OF
THIS OFFICE.
FIGURED DIMENSIONS TO BE USED IN PREFERENCE TO
SCALING. ALL DIMENSIONS TO BE CHECKED ON SITE.
THIS DOCUMENT NOT TO BE USED FOR CONSTRUCTION UNLESS
SIGNED & ISSUED FOR CONSTRUCTION.

MONA VALE ROAD

STAGE 3

EXISTING STAGE 1 & 2

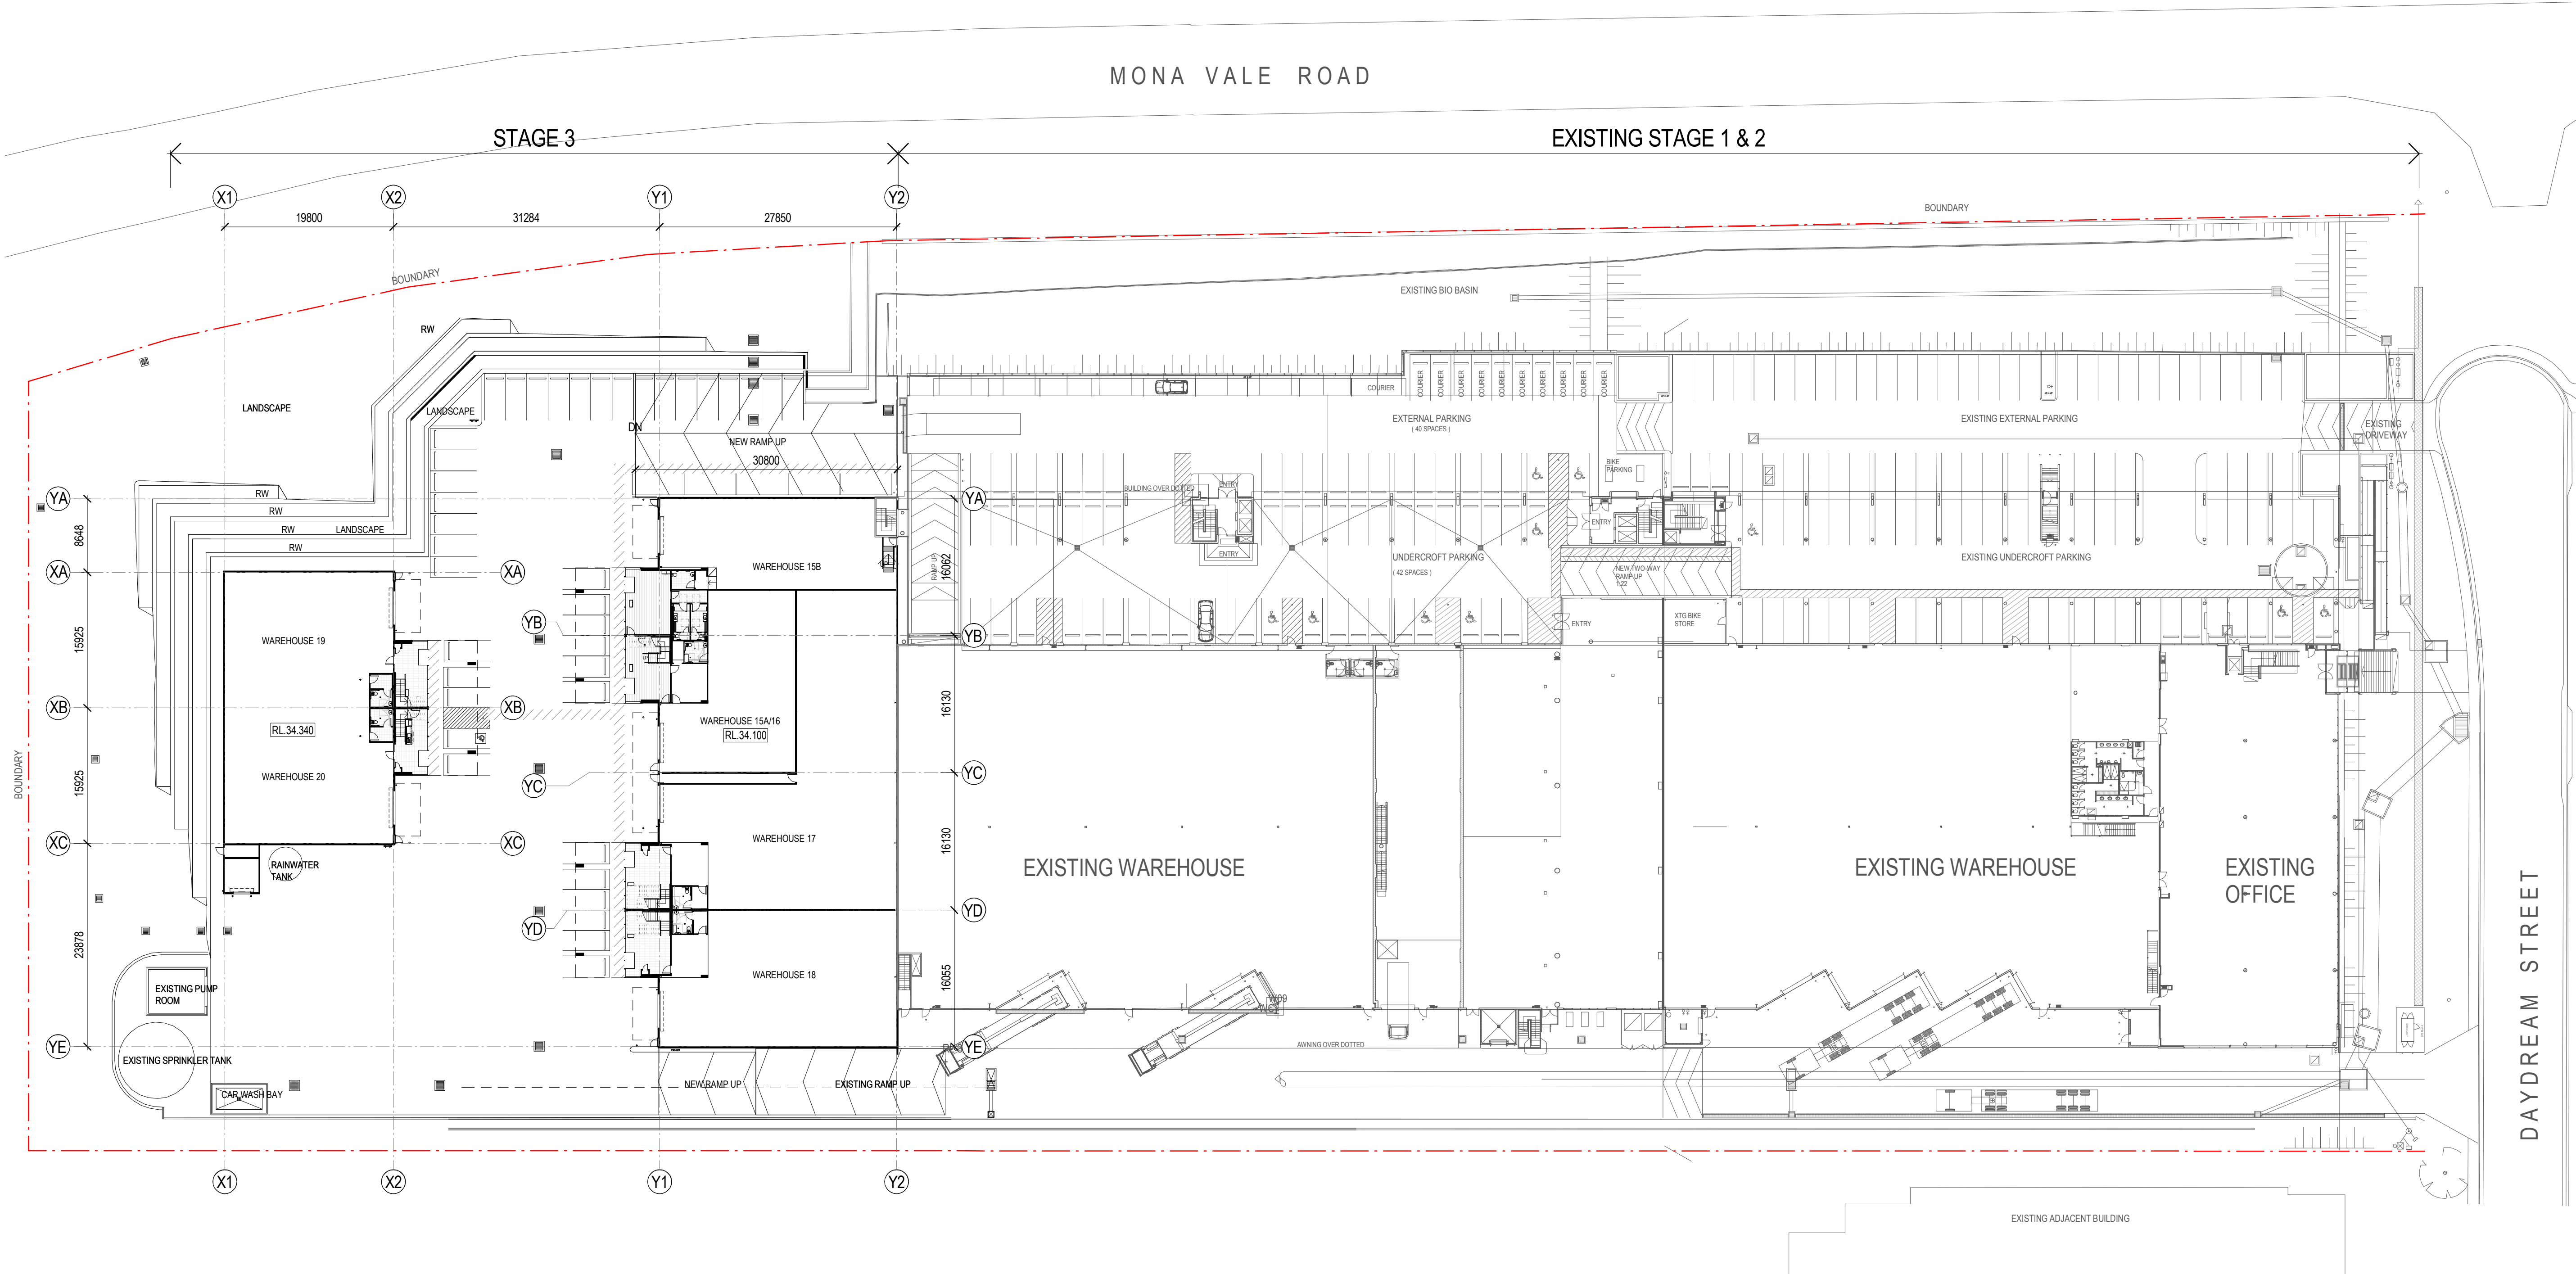

DAYDREAM STREET

1 SITE PLAN - OVERALL 1 : 400
GA301

F	Issued for As Built	26.02.19
E	Amended Issue for Construction	01.02.18
	1. Tea Area & Under Store added	
	2. Wall (PCP) & Columns deleted & Bolards added	
	3. Unisex WC & Ramp added	
D	Amended for Construction	06.07.17
	1. Line 15.8.16 amended	
C	Amended for Construction	05.06.17
B	Amended for Construction	26.04.17
	1. Window amended	
	2. Internal wall adjusted	
	3. Roller shutter and roll door amended	
A	Issue for Construction	31.01.17
P3	Issue for Construction Certificate	16.12.16
P1	Preliminary For Coordination	24.10.16
P2	Preliminary For Coordination	28.11.16
ISSUE DESCRIPTION		DATE

SBA
ARCHITECTS

Commercial Interior Design
Suite 702, 83 Mount Street, North Sydney NSW 2060
02 9529 9999 F 02 9529 9999
E info@sbaarch.com.au W www.sbaarch.com.au

CLIENT

FDC

FDC CONSTRUCTION & FITOUT PTY LTD

PROJECT
PENINSULA BUSINESS
ESTATE STAGE 3
2 DAYDREAM STREET WARRIEWOOD
TITLE
SITE PLAN

DATE	FEB 2019	PROJECT No.	
SCALE	1:400 @A1		
0 5 10 20m			
Scale			
DRAWN	SBA	DWG No.	ISSUE
CHECKED			
APPROVED			

15156

GA101 F

AS BUILT

These designs, plans & specifications and the copyright therein are the property of the Architect and must not be used, reproduced or copied wholly or in part without the written permission of this office.






FIGURED DIMENSIONS TO BE USED IN PREFERENCE TO SCALING. ALL DIMENSIONS TO BE CHECKED ON SITE.

THIS DOCUMENT NOT TO BE USED FOR CONSTRUCTION UNLESS SIGNED & ISSUED FOR CONSTRUCTION

LEGEND:

- GLAZING
- ALC - TYPE 1
- ALC - TYPE 2
- ALC - TYPE 3
- POLYCARBONATE

NOTE: REFER TO FINISHES SCHEDULE FOR DETAILS

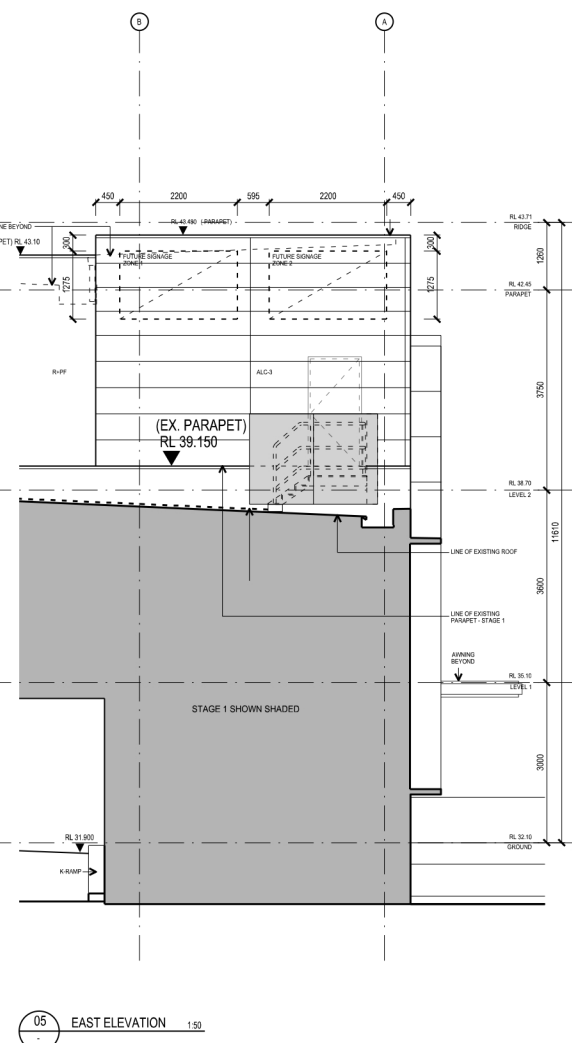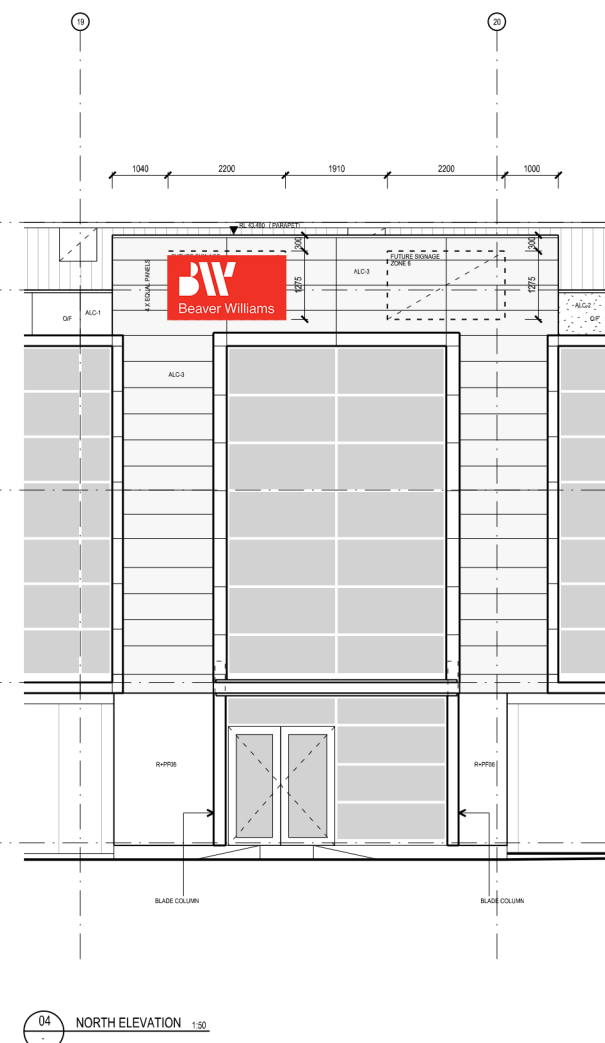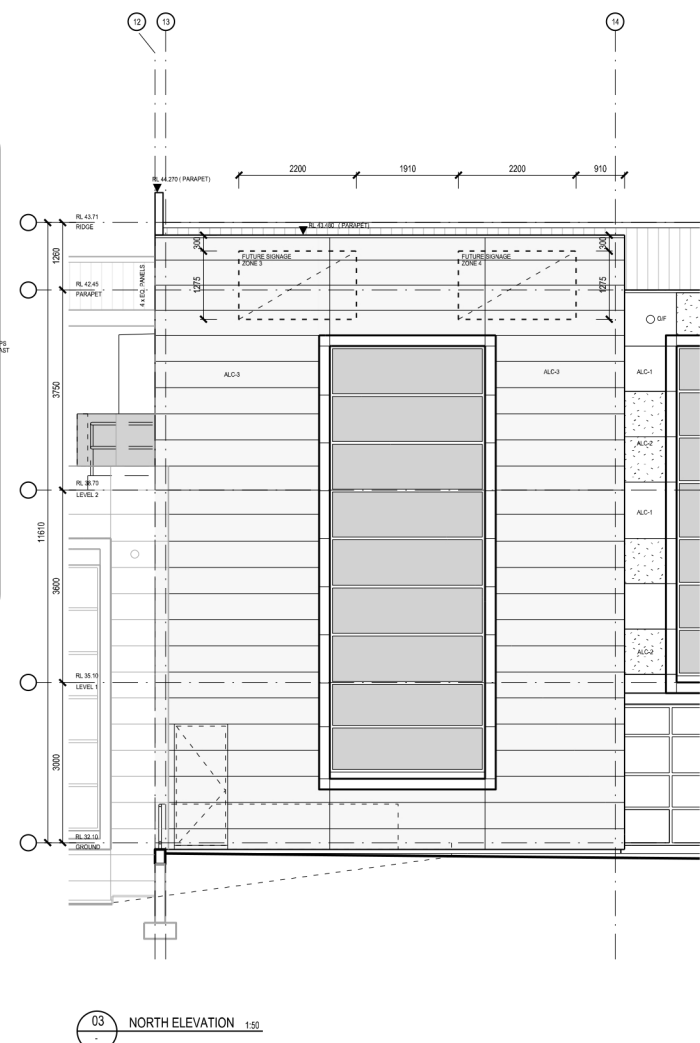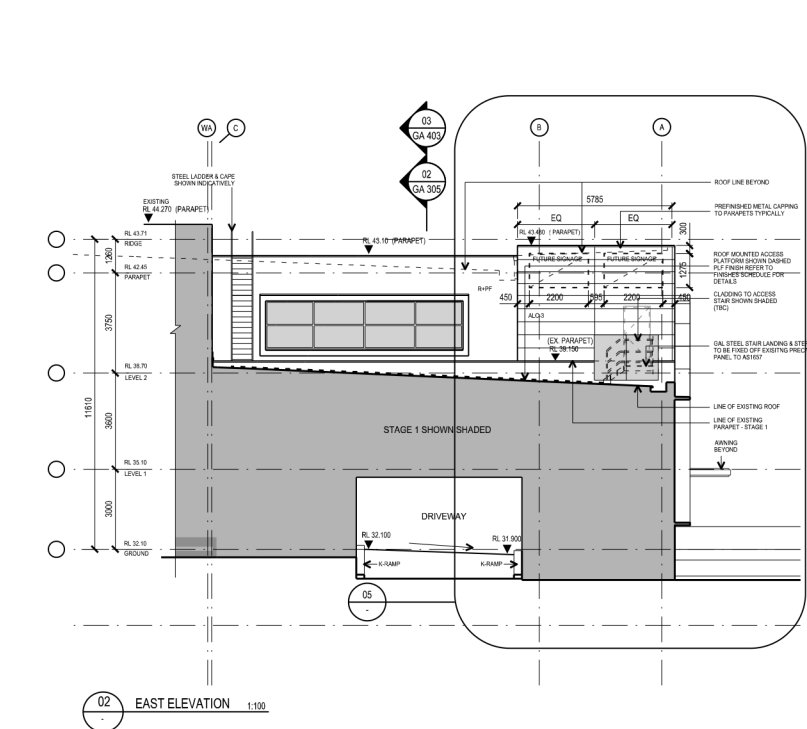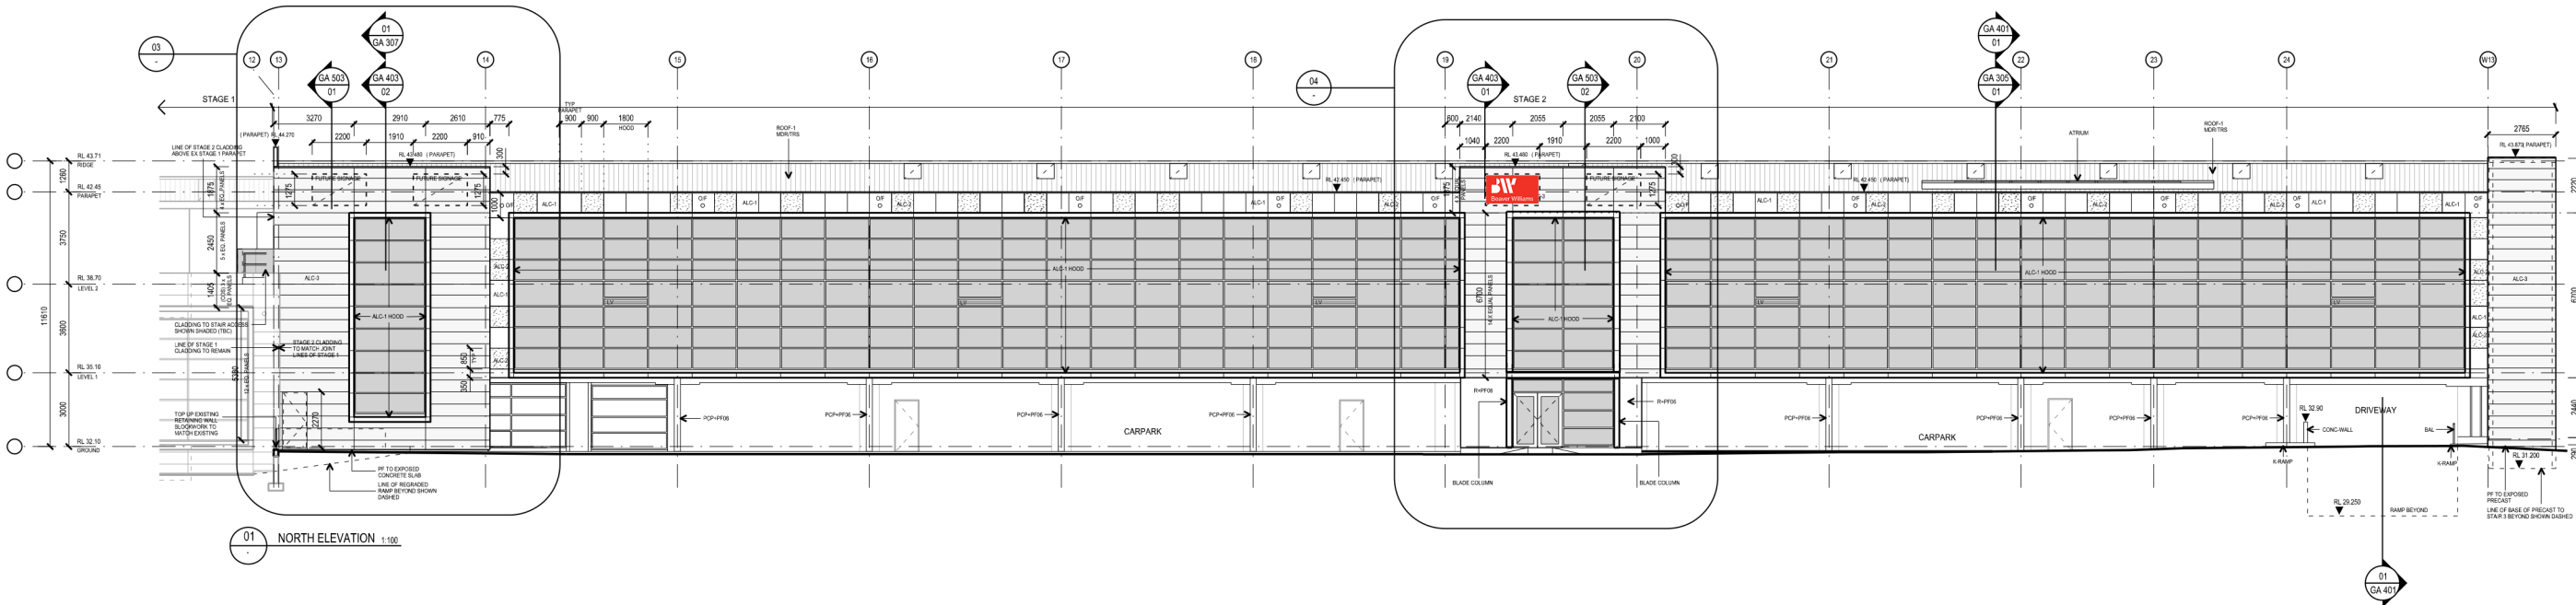

ISSUE	REV	DESCRIPTION	DATE
A	1	FOR INFORMATION	01.06.15
B	1	FOR INFORMATION	01.06.15

ARCHITECT

SBA ARCHITECTS

Commercial Industrial Residential Retail Interior Design

Suite 702, 83 Mount Street, North Sydney NSW 2060
T 02 9529 9880 F 02 9529 8869
E info@sba-arch.com.au W www.sba-arch.com.au

FDC

FDC CONSTRUCTION & FITOUT PTY LTD

PROJECT

PENINSULA BUSINESS ESTATE

DAYDREAM STREET WARRIEWOOD

TITLE

ELEVATIONS - SIGNAGE LOCATIONS

DATE	JUNE 2014	PROJECT No.	
SCALE	1:100@A0		14174
DRAWN	SBA		
CHECKED		DWG No.	SK-265
APPROVED		ISSUE	/B