

## TRUE NORTH:

NOTES (E & OE)

All structures including stormwater & drainage to engineer's details
 Do not obtain dimensions by scaling drawings.
 All dimensions are to be checked on site prior to starting work.

- These drawings are to be read in conjunction with all other consultant's drawings and
- All workmanship & materials shall be in accordance with the requirements of current editions including amendments of the National Construction Code, relevant Australian Standards & local council requirements.

  New materials are to be used throughout unless otherwise noted.

  Concrete footings, slab, structural beams or any other structural members are to be designed
- by a practicing engineer.

# JJ Drafting Division of JJ DRAFTING AUSTRALIA PTY LTD


26/90 Mona Vale Road, Mona Vale, NSW, 2103 PO Box 687, Dee Why, NSW, 2099 Mob. 0414 717 541 | Email. jjdraft@tpg.com.au www.jjdrafting.com.au ACN 651 693 346

- 1	REV:	DATE:	DESCRIPTION:
	Α	23.03.23	SECTION 4.55 UPDATED
	В	31.03.23	SECTION 4.55 UPDATED
,			
u l			

	MODIFICATION DRAWINGS TO APPROVED ALTERATIONS AND ADDITIONS
4	16 Stephen Street - Beacon Hill NSW 2100
$\dashv$	CLIENT:
	Bernie Zicat
	DRAWING TITLE:

SITE PLAN

DATE:	DRAWN BY:	SCALE:
February/23	LB	1:200 @ A3
JOB No:	CHECKED BY:	DRAWING No:
1124/23	JJ	MOD.01

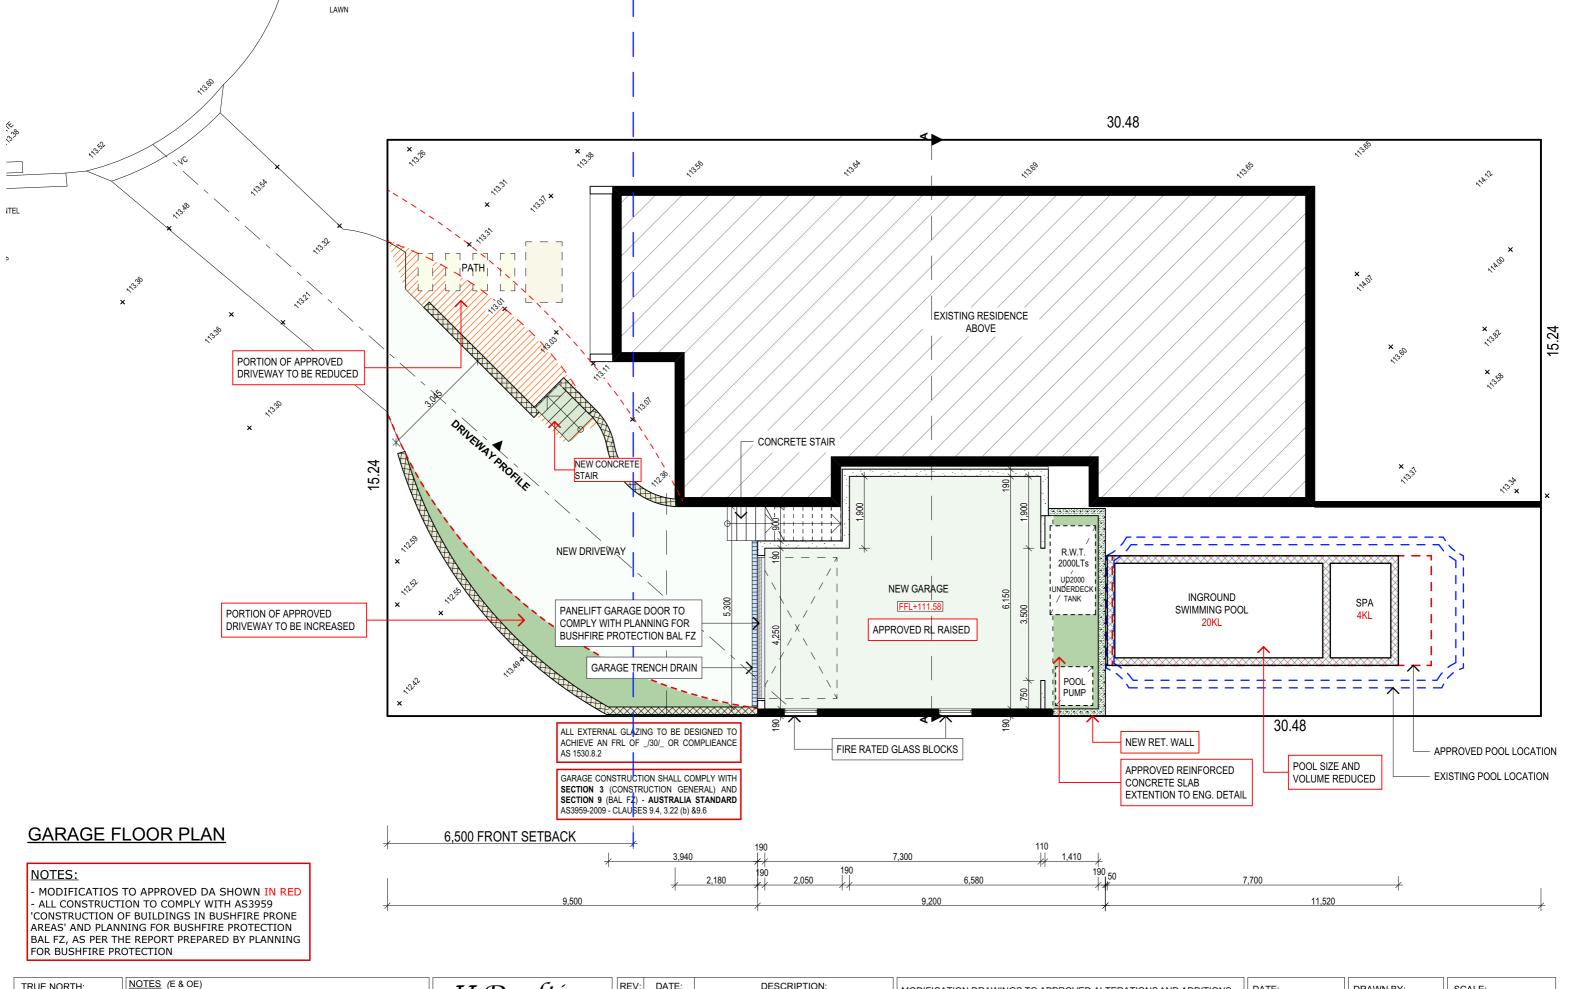

#### TRUE NORTH:

- All structures including stormwater & drainage to engineer's details.
   Do not obtain dimensions by scaling drawings.
   All dimensions are to be checked on site prior to starting work.
- specifications.

   All workmanship & materials shall be in accordance with the requirements of current editions
- New materials are to be used throughout unless otherwise noted.
   Concrete footings, slab, structural beams or any other structural members are to be designed. by a practicing engineer.


# JJ Drafting Division of JJ DRAFTING AUSTRALIA PTY LTD

26/90 Mona Vale Road, Mona Vale, NSW, 2103 PO Box 687, Dee Why, NSW, 2099 Mob. 0414 717 541 | Email. jjdraft@tpg.com.au www.jjdrafting.com.au ACN 651 693 346

- 1	REV.	DATE:	DESCRIPTION:	_    MC
	Α	23.03.23	SECTION 4.55 UPDATED	16
	В	31.03.23	SECTION 4.55 UPDATED	11
				Be
اي				
				DR
- 1				□

MODIFICATION DRAWINGS TO APPROVED ALTERATIONS AND ADDITIONS 16 Stephen Street - Beacon Hill NSW 2100 CLIENT: Bernie Zicat
DRAWING TITLE: GARAGE FLOOR PLAN

DATE:	DRAWN BY:	SCALE:
February/23	LB	1:100 @ A3
JOB No:	CHECKED BY:	DRAWING No:
1124/23	JJ	MOD.02

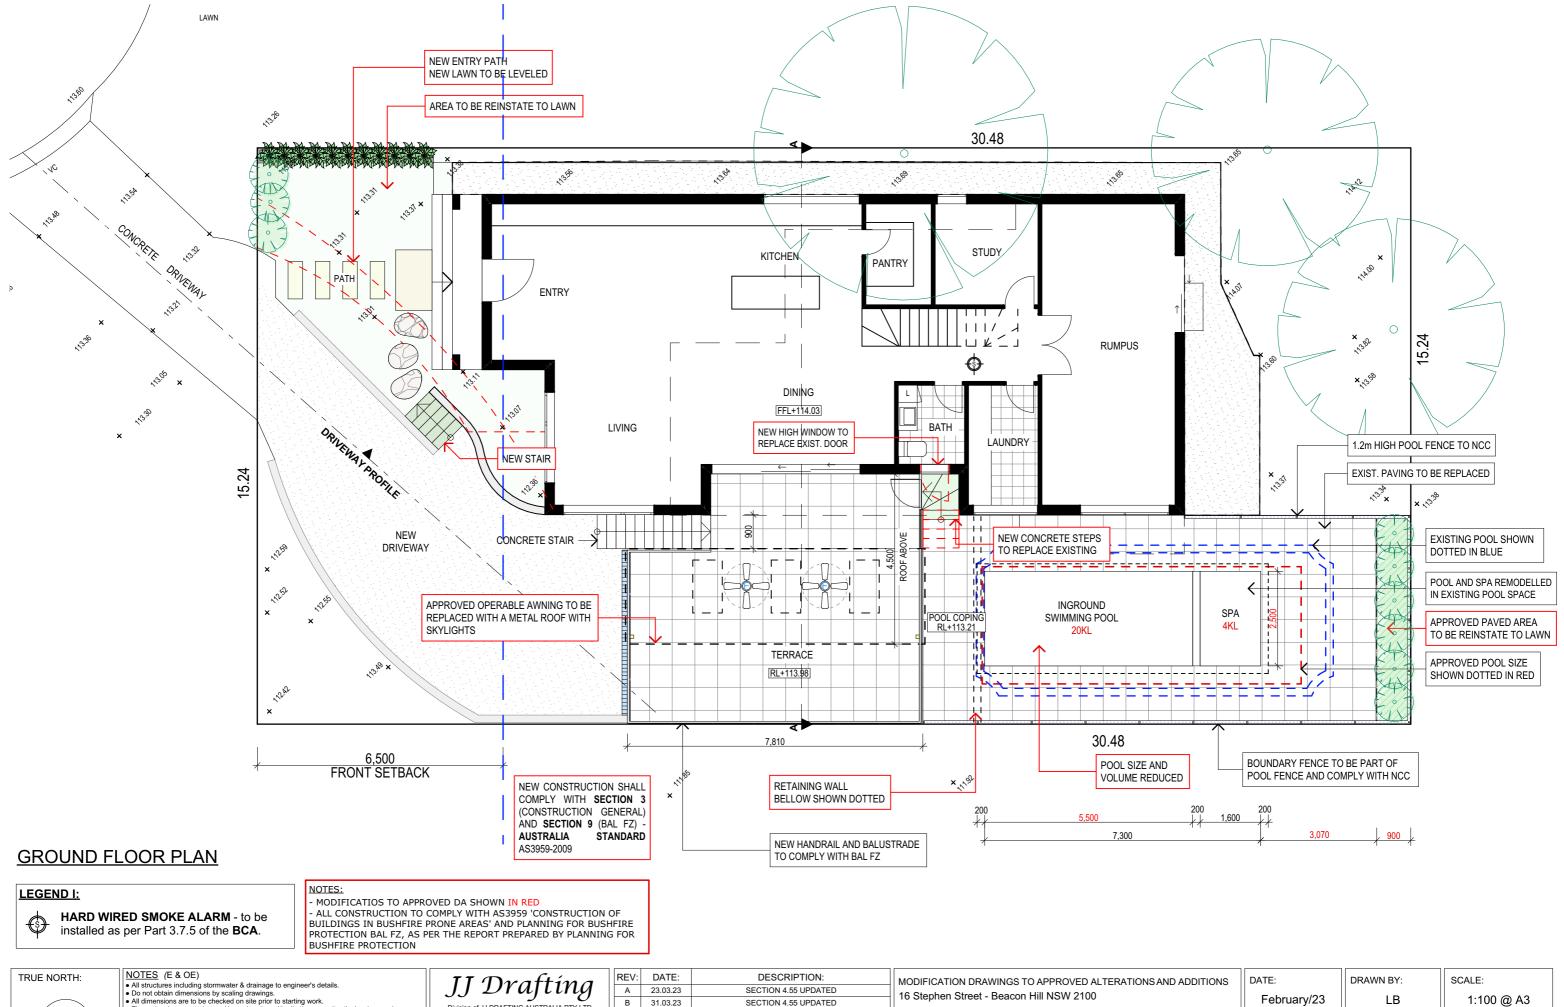



by a practicing engineer.

- These drawings are to be read in conjunction with all other consultant's drawings and specifications.

  • All workmanship & materials shall be in accordance with the requirements of current editions
- New materials are to be used throughout unless otherwise noted.
   New materials are to be used throughout unless otherwise noted.
   Concrete footings, slab, structural beams or any other structural members are to be designed.


# JJ Drafting Division of JJ DRAFTING AUSTRALIA PTY LTD

26/90 Mona Vale Road, Mona Vale, NSW, 2103 PO Box 687, Dee Why, NSW, 2099 Mob. 0414 717 541 | Email. jjdraft@tpg.com.a www.jjdrafting.com.au ACN 651 693 346

	IKEV.	DATE.	DESCRIPTION.	ı
	Α	23.03.23	SECTION 4.55 UPDATED	
	В	31.03.23	SECTION 4.55 UPDATED	
03				
				L
au				Γ
- 1	1			1

	MODIFICATION DRAWINGS TO APPROVED ALTERATIONS AND ADDITIONS 16 Stephen Street - Beacon Hill NSW 2100 CLIENT: Bernie Zicat
ı	DRAWING TITLE: GROUND FLOOR PLAN

DATE:	DRAWN BY:	SCALE:
February/23	LB	1:100 @ A3
JOB No:	CHECKED BY:	DRAWING No:
1124/23	JJ	MOD.03

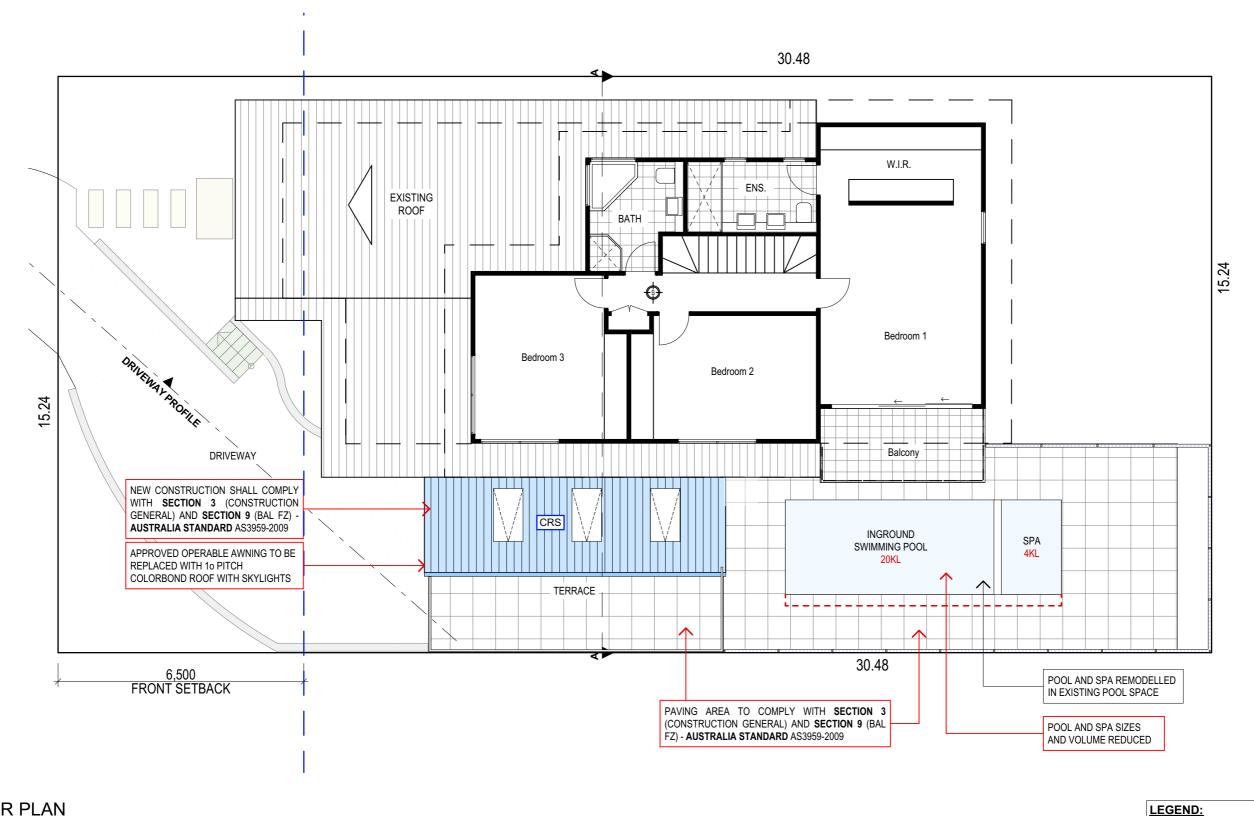

## FIRST FLOOR PLAN

## LEGEND I:



HARD WIRED SMOKE ALARM - to be installed as per Part 3.7.5 of the BCA.

#### NOTES (E & OE) TRUE NORTH:

- All structures including stormwater & drainage to engineer's details.
   Do not obtain dimensions by scaling drawings.
   All dimensions are to be checked on site prior to starting work. specifications.

  • All workmanship & materials shall be in accordance with the requirements of current editions
- New materials are to be used throughout unless otherwise noted.
   Concrete footings, slab, structural beams or any other structural members are to be designed. by a practicing engineer.

# JJ Drafting Division of JJ DRAFTING AUSTRALIA PTY LTD

26/90 Mona Vale Road, Mona Vale, NSW, 2103 PO Box 687, Dee Why, NSW, 2099 Mob. 0414 717 541 | Email. jjdraft@tpg.com.a www.jjdrafting.com.au ACN 651 693 346

	REV:	DATE:	DESCRIPTION:
	Α	23.03.23	SECTION 4.55 UPDATED
	В	31.03.23	SECTION 4.55 UPDATED
3			
1			
au			

FOR BUSHFIRE PROTECTION

NOTES:

'MEDIUM' colour to mach existing dwelling.  * BALUSTRADE - Proprietary glazed with face
pinned fixing & top 316 grade minimum, stainless stell channel (BCA requirement).
stell channel (BCA requirement).

**REW** - RENDERED EXTERNAL WALLS -

(BCA classification M and D).

CRS - COLORBOND ROOF SHEETING - external finish shall have a medium to dark range colour

MODIFICATION DRAWINGS TO APPROVED ALTERATIONS AND ADDITIONS 16 Stephen Street - Beacon Hill NSW 2100 CLIENT: Bernie Zicat	
DRAWING TITLE:	J


MODIFICATIOS TO APPROVED DA SHOWN IN RED


- ALL CONSTRUCTION TO COMPLY WITH AS3959 'CONSTRUCTION OF BUILDINGS IN BUSHFIRE PRONE

AREAS' AND PLANNING FOR BUSHFIRE PROTECTION

BAL FZ, AS PER THE REPORT PREPARED BY PLANNING

DATE:	DRAWN BY:	SCALE:	
February/23	LB	1:100 @ A3	
JOB No:	CHECKED BY:	DRAWING No:	
1124/23	JJ	MOD.04	

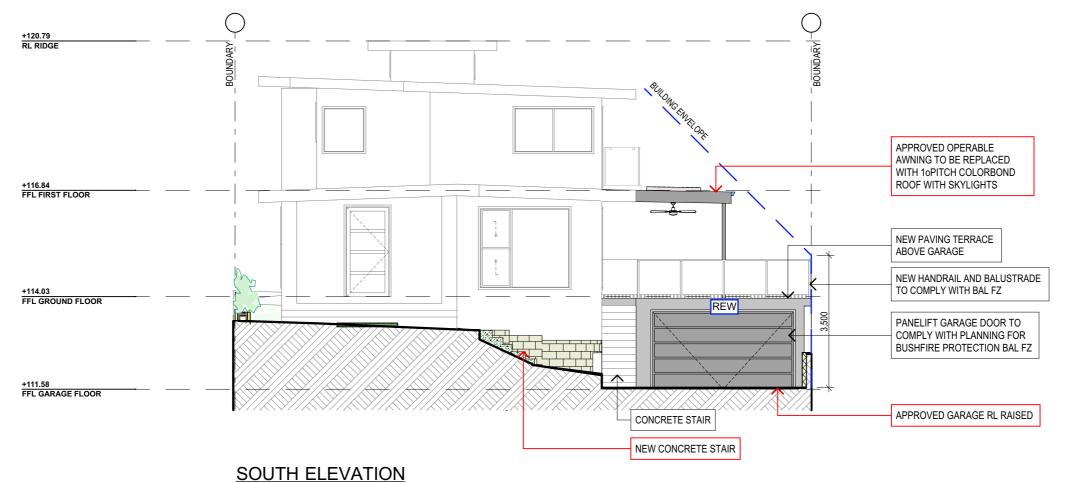

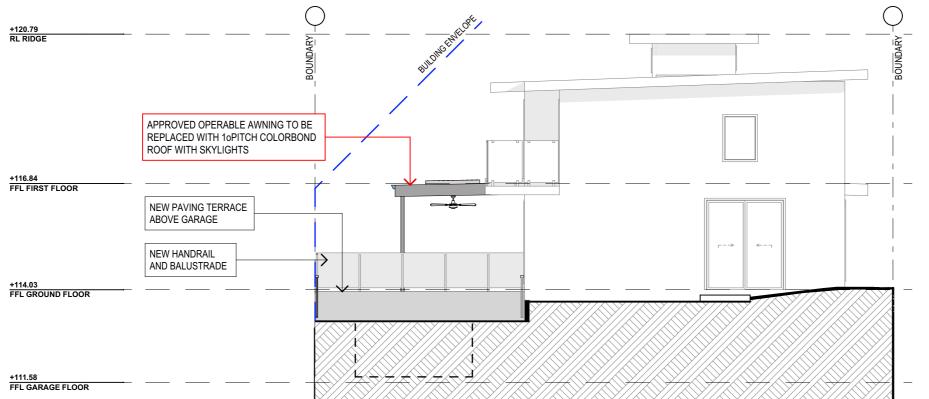

# **NORTH ELEVATION**

## NOTES:

- MODIFICATIOS TO APPROVED DA SHOWN IN RED - ALL CONSTRUCTION TO COMPLY WITH AS3959 'CONSTRUCTION OF BUILDINGS IN BUSHFIRE PRONE AREAS' AND PLANNING FOR BUSHFIRE PROTECTION BAL FZ, AS PER THE REPORT PREPARED BY PLANNING FOR BUSHFIRE PROTECTION

#### LEGEND II:

CRS - COLORBOND ROOF SHEETING - external finish shall have a medium to dark range colour (BCA classification M and D).

**REW** - RENDERED EXTERNAL WALLS -'MEDIUM' colour to mach existing dwelling. \* BALUSTRADE - Proprietary glazed with face pinned fixing & top 316 grade minimum, stainless stell channel (BCA requirement).

#### NOTES (E & OE)

- All structures including stormwater & drainage to engineer's details.
   Do not obtain dimensions by scaling drawings.
   All dimensions are to be checked on site prior to starting work.
   These drawings are to be read in conjunction with all other consultant's drawings and
- specifications.


   All workmanship & materials shall be in accordance with the requirements of current editions
- New materials are to be used throughout unless otherwise noted.
   Concrete footings, slab, structural beams or any other structural members are to be designed.
- by a practicing engineer.

# LL:

II Decaftina	REV:	DATE:	DESCRIPTION:
JJ Drafting	Α	23.03.23	SECTION 4.55 UPDATED
Division of JJ DRAFTING AUSTRALIA PTY LTD	В	31.03.23	SECTION 4.55 UPDATED
/90 Mona Vale Road, Mona Vale, NSW, 2103			
PO Box 687, Dee Why, NSW, 2099			
b. 0414 717 541   Email. jjdraft@tpg.com.au			
www.jjdrafting.com.au			
ACN 651 693 346			

MODIFICATION DRAWINGS TO APPROVED ALTERATIONS AND ADDITIONS 16 Stephen Street - Beacon Hill NSW 2100
CLIENT: Bernie Zicat
DRAWING TITLE: NORTH & SOUTH ELEVATIONS

DATE:	DRAWN BY:	SCALE:
February/23	LB	1:100 @ A3
IOB No:	CHECKED BY:	DRAWING No:
1124/23	JJ	MOD.05

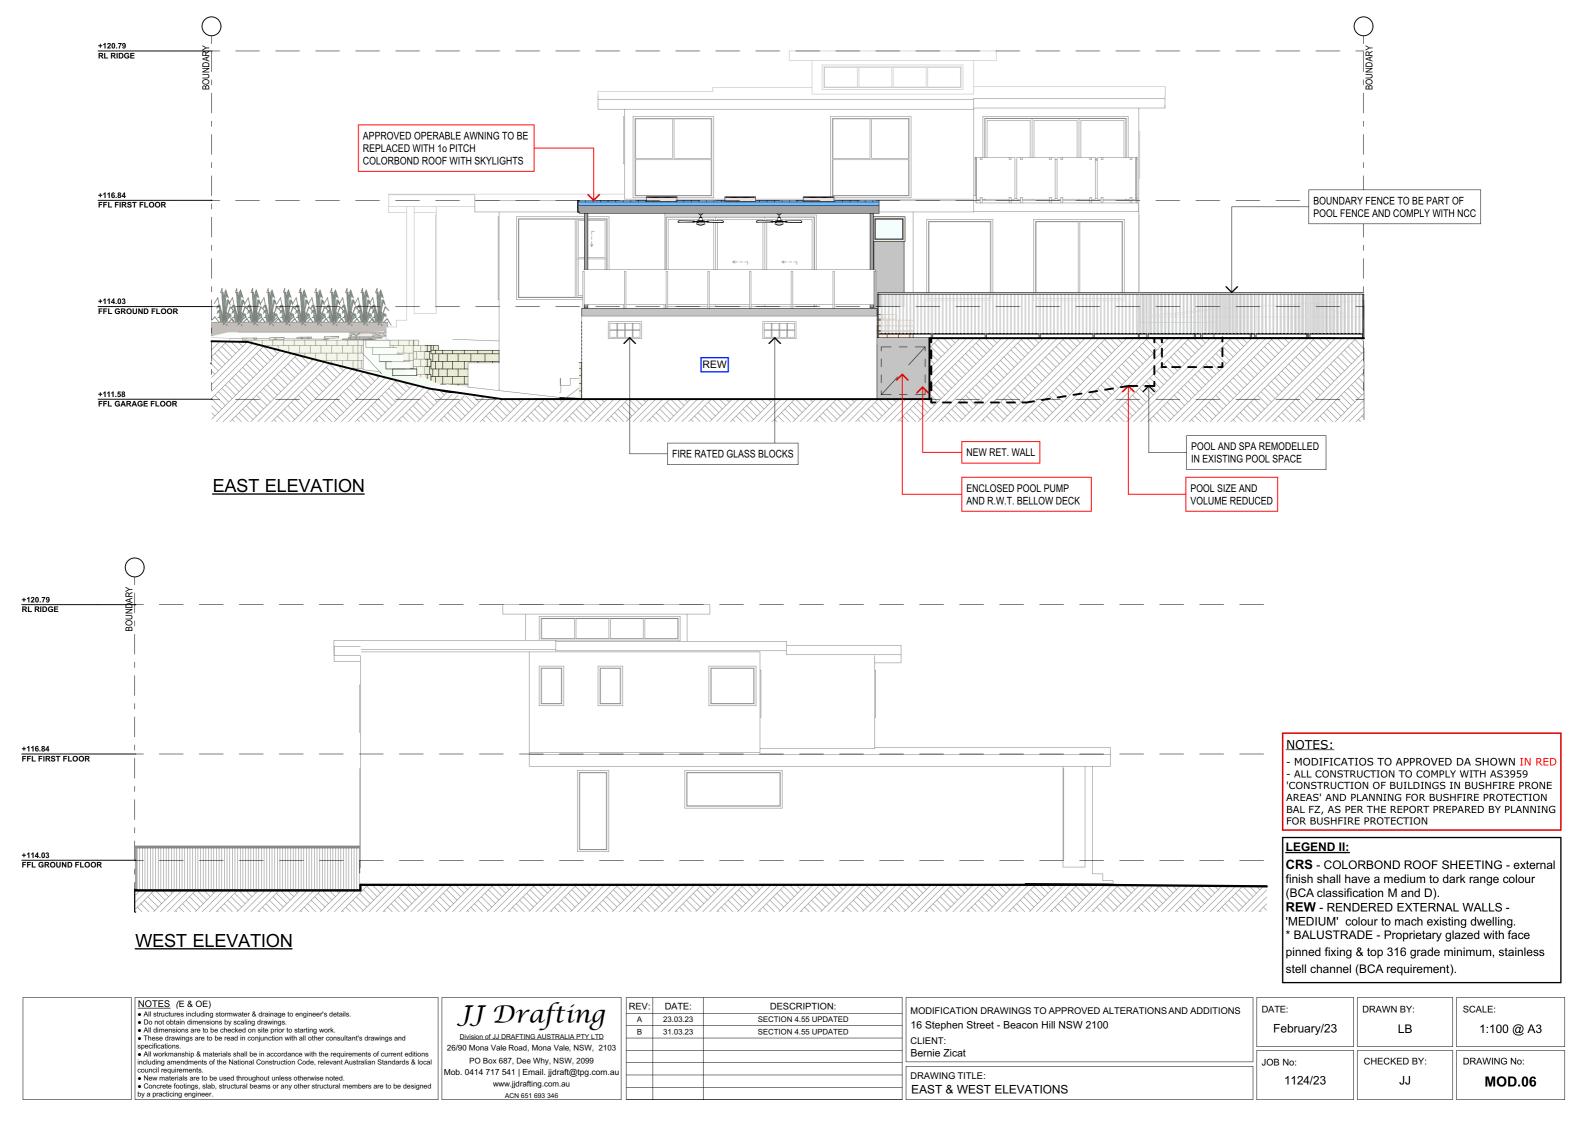

#### **BASIX REQUIREMENT:**

BASIX Inclusions for 16 Stephen Street - Beacon Hill

#### **RAINWATER TANK:**

- THE APPLICANT MUST INSTALL A RAINWATER TANK OF AT LEAST 1990 LITRES ON THE SITE. THIS RAINWATER TANK MUST MEET, AND BE INSTALLED IN ACCORDANCE WITH, THE REQUIREMENTS OF ALL APPLICABLE REGULATORY
- THE APPLICANT MUST CONFIGURE THE RAINWATER TANK TO COLLECT RAIN RUNOFF FROM AT LEAST 140 SQUARE METRES OF THE ROOF AREA OF THE DEVELOPMENT
- THE APPLICANT MUST CONNECTED THE RAINWATER TANK TO A TAP LOCATED WITHIN 10mETRES OF THE EDGE OF THE POOL.

#### **OUTDOOR SWIMMING POOL:**

- THE SWIMMING POOL MUST NOT HAVE A CAPACITY GREATER THAN 20 KILOLITRES.
- THE APPLICANT MUST INSTALL A POOL PUMP TIMER FOR THE SWIMMING POOL.
   THE APPLICANT MUST NOT INCORPORATE ANY HEATING SYSTEM FOR THE SWIMMING POOL

- THE SPA MUST NOT HAVE A CAPACITY GREATER THAN 4 KILOLITRES.
- THE APPLICANT MUST INSTALL A SPA PUMP TIMER.
- THE APPLICANT MUST INSTALL A GAS HEATING SYSTEM FOR THE SPA

40% OF NEW OR ALTERED LIGHT FIXTURES TO BE FITTED WITH FLUORESCENT, COMPACT FLUORESCENT, OR LIGHT-EMITTING-DIODE (LED) LAMPS


#### **INSULATION REQUIREMENTS - CONSTRUCTION**

FLOOR - CONCRETE SLAB

EXTERNAL WALLS: GARAGE - MASONRY - RENDERRED

WINDOWS AND DOORS:

- W1 (BATHROOM) STANDARD ALUMINIUM, SINGLE CLEAR
- (or U-value: 7.63, shqc: 0.75)
- PANEL LIFT GARAGE DOOR
- FIRE RATED GLASS BLOCKS

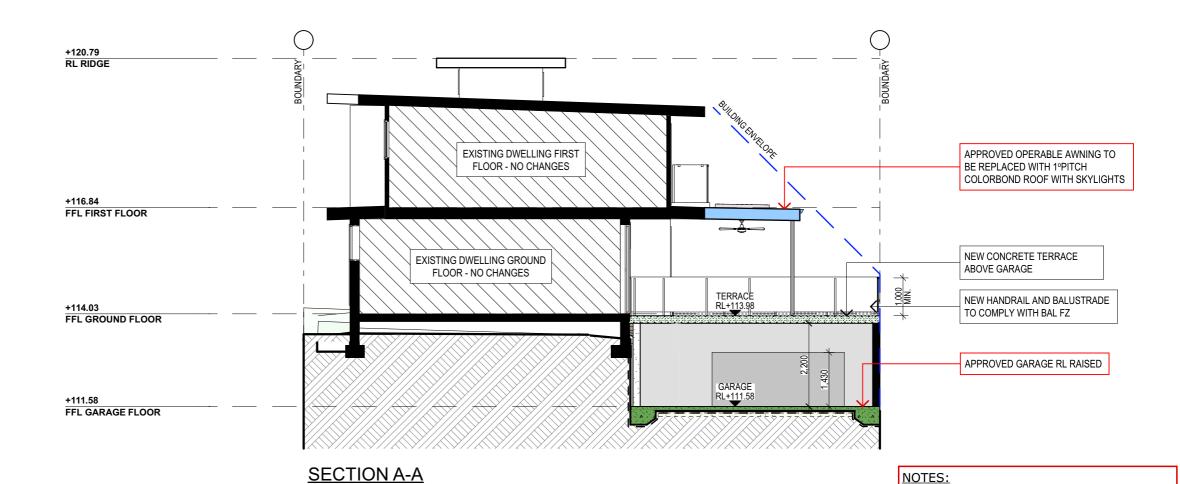

#### **BUSHFIRE REPORT FOR 16 STEPHEN STREET - BEACON HILL:**


#### **CONSTRUCTION AND DESIGN FOR BAL 19 AND BAL FZ:**

ALL NEW WORK IS TO BE UNDERTAKEN IN ACCORDANCE WITH THE RELEVANT REQUIREMENTS OF THE BCA AND AS3959 2009. THE FOLLOWING RECOMMENDATIONS ARE A MINIMUM LEVEL OF CONSTRUCTION.

1. NEW CONSTRUCTION SHALL COMPLY WITH SECTION 3 AND SECTION 9 (BAL FZ) OF AUSTRALIAN STANDARD AS3959-2009 "CONSTRUCTION OF BUILDINGS IN BUSH FIRE-PRONE AREAS"

NEW CONSTRUCTION CAN BE DESIGNED AND INSTALLED IN ACCORDANCE WITH NASH STANDARD FOR RESIDENTIAL AND LOW-RISE FRAMING, PART 1: DESIGN CRITERIA OR PART 2: DESIGN SOLUTIONS.

- 2. ELETRICITY AND GAS SUPPLIES: AS FAR AS PRACTICAL, NEW ELECTRICITY AND GAS SUPPLIES SHALL BE INSTALLED IN ACCORDANCE WITH THE REQUIREMENTS OF 4.1.3 OF PBP.
- 3. EXISTING DWELLING HAS BEEN UPGRADED TO IMPROVE EMBER PROTECTION IN ACCORDANCE WITH THE RECOMMENDATION OF THE PREVIOUS APPROVED DEVELOPMENT APPLICATION.
- 4. ASSET PROTECTION ZONES: AT THE COMMENCEMENT OF BUILDING WORKS AND IN PERPETUITY, THE ENTIRE PROPERTY SHALL BE MANAGED AS AN INNER PROTECTION AREA AS OUTLINED WITHIN PBP2006 AND THE NSW RFS DOCUMENT 'STANDARDS FOR ASSET PROTECTION ZONES'.
- 5. WATER SUPPLIES: RETICULATED WATER SUPPLY IS LOCATED ON THE ADJOINING ROAD AT REGULAR INTERVALS AND IS EASILY ACESSIBLE. ADDITIONAL WATER SUPPLIES ARE NOT RECOMMENDED AS A CONDITION OF CONSENT.
- 6. ADJACENT BUILDING (CLASS 10a): CLASS 10a BUILDINGS SHALL COMPLY WITH THE REQUIREMENTS OF AS3959, 2009 PART 3.2. CONSTRUCTION REQUIREMENTS FOR SPECIFIC STRUCTURES.
- 7. ADJACENT STRUCTURES (CLASS 10b): AT THE PLANNING STAGE, CLASS 10b BUILDINGS IN BUSHFIRE PRONE AREAS SHOULD BE NON-COMBUSTIBLE. (CLASS10b BUILDING INCLUDE A FENCE, RETAINING OR FREE-STANDING WALL, SWIMMING POOL OR THE LIKE.

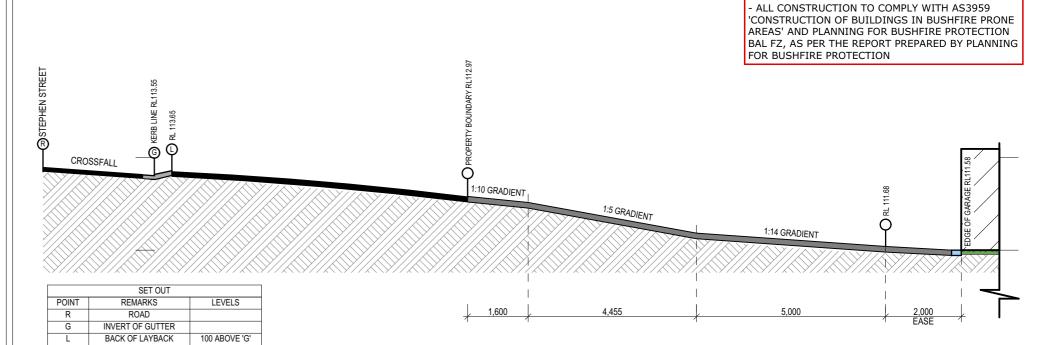

# **DRIVEWAY PROFILE**

#### NOTES (E & OE)

- All structures including stormwater & drainage to engineer's details
  Do not obtain dimensions by scaling drawings.
  All dimensions are to be checked on site prior to starting work.
- All workmanship & materials shall be in accordance with the requirements of current editions
- New materials are to be used throughout unless otherwise noted.
   Remarks are to be used throughout unless otherwise noted.
   Concrete footings, slab, structural beams or any other structural members are to be designed.

These drawings are to be read in conjunction with all other consultant's drawings and

- by a practicing engineer.

JJ Drafting 26/90 Mona Vale Road, Mona Vale, NSW, 2103 PO Box 687, Dee Why, NSW, 2099 Mob. 0414 717 541 | Email. jjdraft@tpg.com.a www.jjdrafting.com.au ACN 651 693 346

	REV:	DATE:	DESCRIPTION:	Шм
	Α	23.03.23	SECTION 4.55 UPDATED	16
	В	31.03.23	SECTION 4.55 UPDATED	
3				
				$\Box \Box \Box$
au				
				الله الله

MODIFICATION DRAWINGS TO APPROVED ALTERATIONS AND ADDITIONS 16 Stephen Street - Beacon Hill NSW 2100 CLIENT:	DATE: February/23	DRAWN BY:
Bernie Zicat	JOB No:	CHECKED BY:
DRAWING TITLE: SECTION / BASIX	1124/23	JJ

MODIFICATIOS TO APPROVED DA SHOWN IN RED

SCALE:

DRAWING No:

1:100 @ A3

**MOD.07** 

#### **NOTES**

#### DESIGNATED SITE MANAGER/BUILDER

PRIOR TO COMMENCEMENT OF WORK A SITE MANAGER OR BUILDER MUST BE NOMINATED. THE SITE MANAGER OR BUILDER WILL BE RESPONSIBLE AND LIABLE FOR ALL WORKS CARRIED OUT ON THE SITE. THIS ASSUMES THE RESPONSIBILITY FOR THE ACTIONS OF ALL SUBCONTRACTED PARTIES AS WELL AS ADVISING THEM OF COUNCIL'S REQUIREMENTS WHEN CARRYING OUT

#### TOPSOIL MANAGEMENT

PRIOR TO THE STRIPPING OF TOPSOIL, THE VEGETATIVE COVER MUST BE REDUCED BY EITHER SLASHING OR MOWING. ALL TOPSOIL IS TO BE RETAINED AND PROTECTED FOR REUSE ON SITE. SOIL STOCKPILES MUST NOT BE LOCATED ON NATURE STRIPS, FOOTPATHS, ROADWAYS, KERBS, ACCESSWAYS, WITHIN DRAINAGE LINES/FLOWS/PATHS OR AROUND OR AGAINST TREE SHRUBS. SEDIMENT CONTROL MEASURES MUST BE INCORPORATED WITH ANY RESULTING STOCKPILE. THE STOCKPILE CAN BE PROTECTED FROM EROSION BY COVERING IT WITH AN MPERVIOUS MATERIAL, IN CONJUNCTION WITH THE INSTALLATION OF A SEDIMENT FENCE AROUND IT. IF STOCKPILES ARE TO REMAIN FOR MORE THAN ONE MONTH THEY ARE TO BE GRASSED IMMEDIATELY AND STABILISED WITHIN FOURTEEN DAYS. SURPLUS TOPSOIL MUST BE REASONABLY REMOVED FROM SITE.

#### **BUILDING MATERIAL STOCKPILING**

SUFFICIENT AREA MUST BE ALLOCATED WITHIN THE SITE FOR SUCH STORAGE OF BUILDING MATERIALS, DEMOLITION WASTE, WASTE CONTAINERS, ETC. AS WILL BE REQUIRED.

A SEDIMENT FENCE SHOULD BE LOCATED ALONG THE DOWNSLOPE BOUNDARY(S) OF THE SITE. ON THE CONSTRUCTION SIDE OF THE TURF FILTER STRIP OR NATIVE VEGETATION, AND AROUND ALL STOCKPILES OF MATERIAL ON THE SITE.

#### DUST CONTROL

ALL TRUCKS/UTES MUST COVER THEIR LOADS AT ALL TIMES. APPROPRIATE METHODS ARE TO BE EMPLOYED TO PREVENT BLOWING DUST CREATING AN UNACCEPTABLE HAZARD OR NUISANCE ON THE SITE OR DOWN WIND. PRODUCTION OF DUST CAN BE MINIMISED BY LIMITING AREA OF EARTHWORKS, WATERING AND PROGRESSIVE VEGETATION. WHERE DUST IS CREATED AS A RESULT WORKS AND/OR SOIL EXPOSURE, THE BARE SOIL AREAS MUST BE WATERED, DURING AND/OR AT THE END OF EACH DAY TO LAY THE DUST. EARTH MOVING ACTIVITIES SHOULD BE AVOIDED WHERE WINDS ARE SUFFICIENTLY STRONG ENOUGH TO RAISE VISIBLE

#### **EROSION & SEDIMENT CONTROLS**

APPROPRIATE EROSION AND SEDIMENT CONTROLS MUST BE IMPLEMENTED ON ALL SITES THAT INVOLVE SOIL DISTURBANCE. THE MEASURES MUST BE IN PLACE PRIOR TO THE COMMENCEMENT OF WORK. THOSE CONTROLS ARE TO BE MONITORED AND MAINTAINED IN ORDER TO SERVE THEIR INTENDED FUNCTION FOR THE DURATION OF THE WORKS OR UNTIL SUCH TIME AS THE SITE IS FULLY STABILISED. IF ANY CONTROLS ARE DAMAGED OR BECOME INEFFECTIVE DURING THE COURSE OF THE WORKS THEY ARE TO BE REINSTATED OR REPLACED IMMEDIATELY. SUFFICIENT ACCESS TO THESE CONTROLS MUST BE PROVIDED IN CASE OF THE NEED TO REPAIR.

#### SEDIMENT TRAPS

WHERE A SEDIMENT FENCE IS NOT USED APPROPRIATE SEDIMENT TRAPS SHOULD BE LOCATED AT ALL POINTS WHERE STORMWATER LEAVES THE CONSTRUCTION SITE OR LEAVES THE GUTTER AND ENTERS THE DRAINAGE SYSTEM. A COMMON TECHNIQUE IS THE GRAVEL SAUSAGE

#### **DIVERSION CHANNELS**


A DIVERSION CHANNEL IS AN EXCAVATED EARTH DITCH OR PATH. THESE STRUCTURES ARE USED TO INTERCEPT AND DIRECT RUN-OFF TO A DESIRED LOCATION WHERE POSSIBLE. ALL STORMWATER RUN-OFF FLOWING ONTO DISTURBED AREAS, INCLUDING STOCKPILES, MUST BE INTERCEPTED, DIVERTED AND/OR SAFELY DISPOSED OF. THIS CAN BE ACHIEVED BY CONSTRUCTING A TEMPORARY EARTH BANK AROUND THE UPSLOPE EXTENT OF THE CONSTRUCTION SITE WHERE THE DIVERSION DOES NOT AFFECT THE NEIGHBOURING


### VEHICLE MOVEMENTS

TO LIMIT DISTURBANCE TO THE SITE AND TRACKING OF MATERIAL ONTO THE STREET ALL VEHICLES AND PLANT EQUIPMENT ARE TO USE A SINGLE ENTRY/EXIT POINT UNLESS COUNCIL HAS APPROVED ALTERNATIVE ARRANGEMENTS. ACCESS POINTS AND PARKING AREAS ARE TO BE STABILISED WITH COMPACTED SUB-GRADE ASAP AFTER THEIR FORMATION. IF SPILLAGE DOES OCCUR IT IS TO BE CONTAINED IMMEDIATELY AND CAREFULLY REMOVED. THE AREA AFFECTED IS TO BE RESTORED TO A STANDARD EQUAL TO OR BETTER THAN ITS PREVIOUS CONDITION. ALL VEHICLES ARE TO BE WASHED PRIOR TO EXISTING THE SITE. THIS SERVES THE PURPOSE OF REMOVING SITE MATERIAL ON THE VEHICLE AND PREVENTS IT FROM BEING DEPOSITED ON THE ROAD NETWORK ADJACENT TO THE SITE AND THUS, THE STORMWATER SYSTEM. NO VEHICLE ASSOCIATED WITH THE WORK IS TO BE PARKED ON A FOOTPATH OR PUBLIC RESERVE. ALL VEHICLES VISITING THE SITE DURING DEMOLITION, EXCAVATION AND/OR CONSTRUCTION WORKS, ARE TO COMPLY WITH THE PARKING REQUIREMENTS IN THAT AREA.

# CONCRETE LINTEL 1334 5 SEDIMENT BARRIER \_4\ 30.48 SAND/SOIL STOCK PILES BUILDING MATERIAL STOCKPILES TO BE STORED WITHIN THE SEDIMENT FENCE ENVELOPE OF THE SITE. SOURCE OF SEPARATION OF WASTE MATERIALS FOR RECYCLING

## EROSION & SEDIMENT CONTROL / WASTE MANAGEMENT PLAN

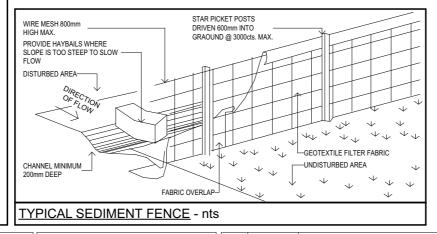

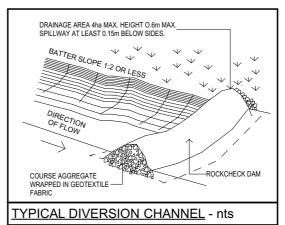

### NOTES:

MODIFICATIOS TO APPROVED DA SHOWN IN RED ALL CONSTRUCTION TO COMPLY WITH AS3959 CONSTRUCTION OF BUILDINGS IN BUSHFIRE PRONE AREAS' AND PLANNING FOR BUSHFIRE PROTECTION BAL FZ, AS PER THE REPORT PREPARED BY PLANNING FOR BUSHFIRE PROTECTION

#### TRUE NORTH:



NOTES (E & OE)

All structures including stormwater & drainage to engineer's details
Do not obtain dimensions by scaling drawings.
All dimensions are to be checked on site prior to starting work.

These drawings are to be read in conjunction with all other consultant's drawings and

 All workmanship & materials shall be in accordance with the requirements of current editions осительными со иначенных snan be in accordance with the requirements of cu-cluding amendments of the National Construction Code, relevant Australian Sta ouncil requirements.

I	Concrete footings, slab, structural beams or any other structural members are to be designed by a practicing engineer.
•	


JJ Drafting	
Division of JJ DRAFTING AUSTRALIA PTY LTD	
26/90 Mona Vale Road, Mona Vale, NSW, 2103	
PO Box 687, Dee Why, NSW, 2099	
Mob. 0414 717 541   Email. jjdraft@tpg.com.au	
www.iidrafting.com.au	

ACN 651 693 346

REV:	DATE:	DESCRIPTION:
Α	23.03.23	SECTION 4.55 UPDATED
В	31.03.23	SECTION 4.55 UPDATED
	Α	A 23.03.23

MODIFICATION DRAWINGS TO APPROVED ALTERATIONS AND ADDITIONS	DATE
16 Stephen Street - Beacon Hill NSW 2100	Fe
CLIENT:	
Bernie Zicat	JOB I
DRAWING TITLE:	JOBI
EROSION & SEDIMENT CONTROL / WASTE	
MANAGEMENT PLAN	

ATE:	DRAWN BY:	SCALE:
February/23	LB	1:200 @ A3
B No:	CHECKED BY:	DRAWING No:
1124/23	JJ	MOD.08

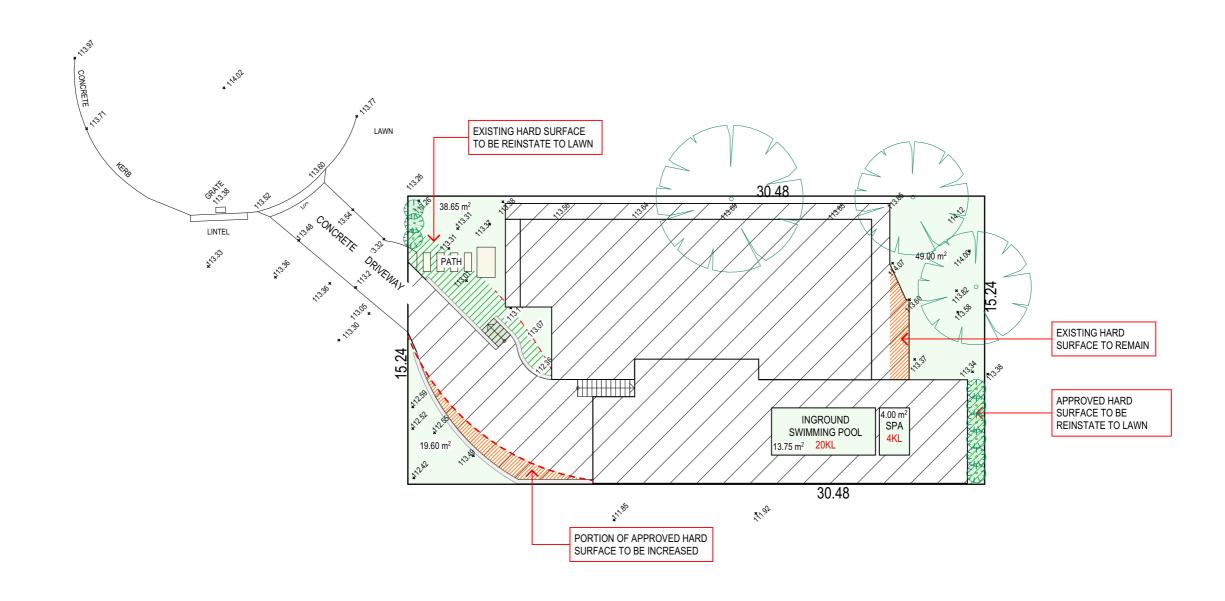

DESCRIPTION:

SECTION 4.55 UPDATED

SECTION 4.55 UPDATED

# LANDSCAPE CONCEPT PLAN

## **CALCULATIONS** SITE AREA 464.40m<sup>2</sup> EXISTING LANDSCAPED AREA 141.47m<sup>2</sup> APPROVED LANDSCAPED AREA 125m<sup>2</sup> PROPOSED NEW LANDSCAPED AREA 22.60m<sup>2</sup> TOTAL LANDSCAPED AREA 125m<sup>2</sup> HARD SURFACE AREA TO BE RETAINED NEW HARD SURFACE AREA TOTAL HARD SURFACE AREA 295.58m<sup>2</sup>

### NOTES:

- MODIFICATIOS TO APPROVED DA SHOWN IN RED - ALL CONSTRUCTION TO COMPLY WITH AS3959 'CONSTRUCTION OF BUILDINGS IN BUSHFIRE PRONE AREAS' AND PLANNING FOR BUSHFIRE PROTECTION BAL FZ, AS PER THE REPORT PREPARED BY PLANNING FOR BUSHFIRE PROTECTION

#### TRUE NORTH:



NOTES (E & OE)

- All structures including stormwater & drainage to engineer's details.
   Do not obtain dimensions by scaling drawings.
   All dimensions are to be checked on site prior to starting work.
- Insee crawings are to be read in conjunction with all other consultants drawings and specifications.
   All workmanship & materials shall be in accordance with the requirements of current editions including amendments of the National Construction Code, relevant Australian Standards & local council requirements.
   New materials are to be used throughout unless otherwise noted.
   Concrete footings, slab, structural beams or any other structural members are to be designed by a practicing penipser.
- by a practicing engineer.

# II Draftina

REV: DATE:

В

A 23.03.23

31.03.23

JJ Drujting
Division of JJ DRAFTING AUSTRALIA PTY LTD
26/90 Mona Vale Road, Mona Vale, NSW, 2103
PO Box 687, Dee Why, NSW, 2099
Mob. 0414 717 541   Email. jjdraft@tpg.com.au
www.jjdrafting.com.au
ACN 651 693 346

MODIFICATION DRAWINGS TO APPROVED ALTERATIONS AND ADDITIONS 16 Stephen Street - Beacon Hill NSW 2100	
CLIENT: Bernie Zicat	
DRAWING TITLE: LANDSCAPED AREA CALCULATION PLAN	

JOB No: 1124/23	CHECKED BY:	MOD.09
	OUEOUED DV	DD ALLAUNIO AL
February/23	LB	1:200 @ A3
DATE:	DRAWN BY:	SCALE: