



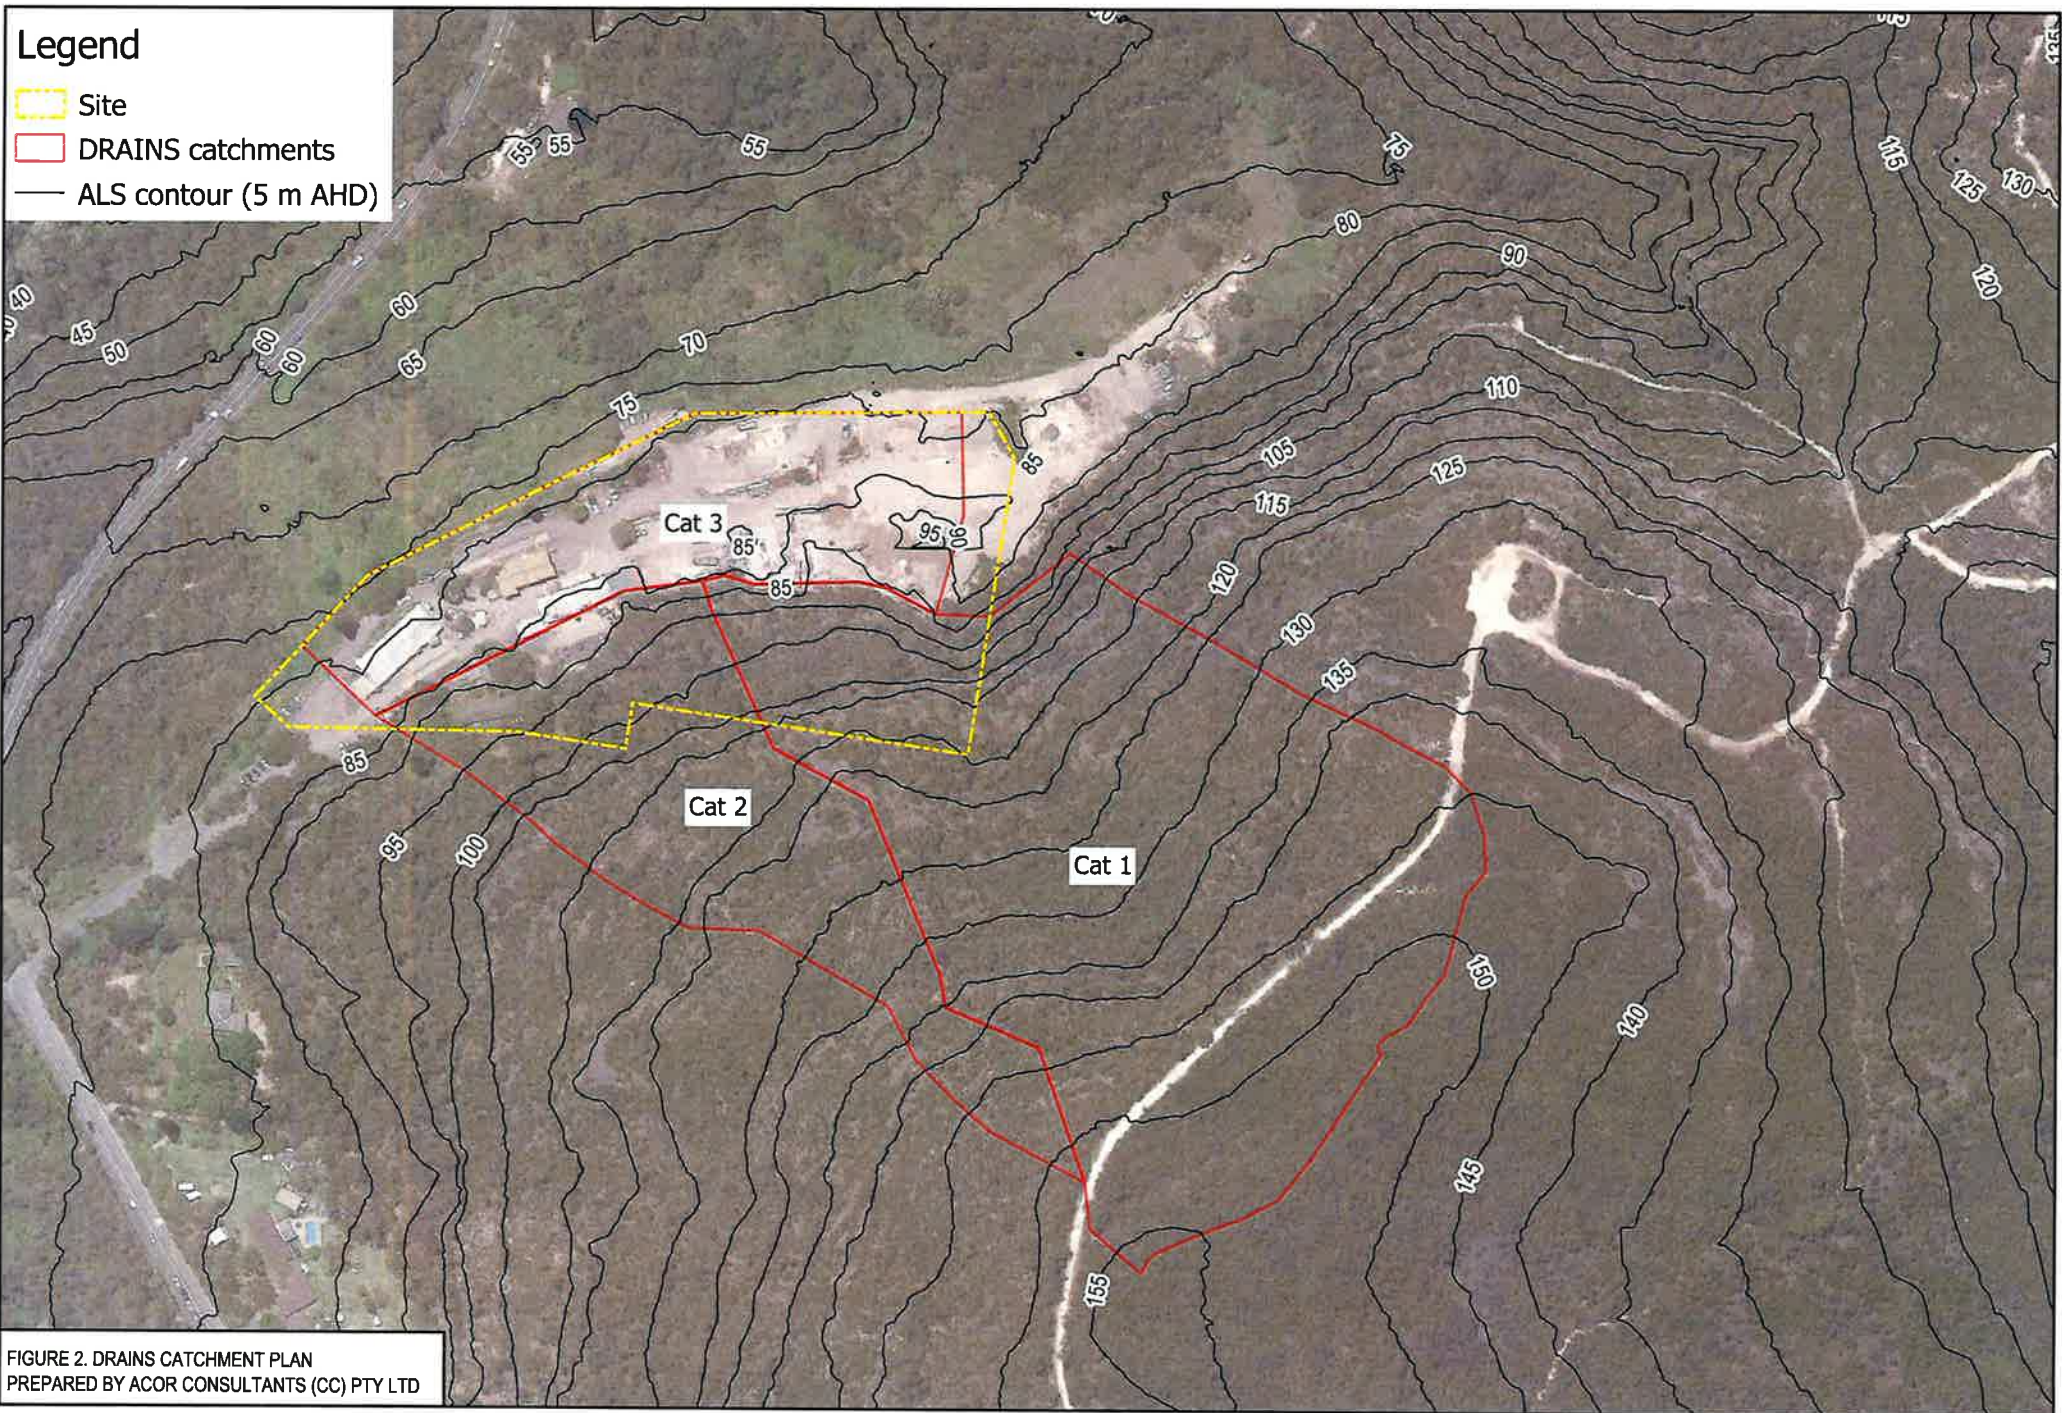


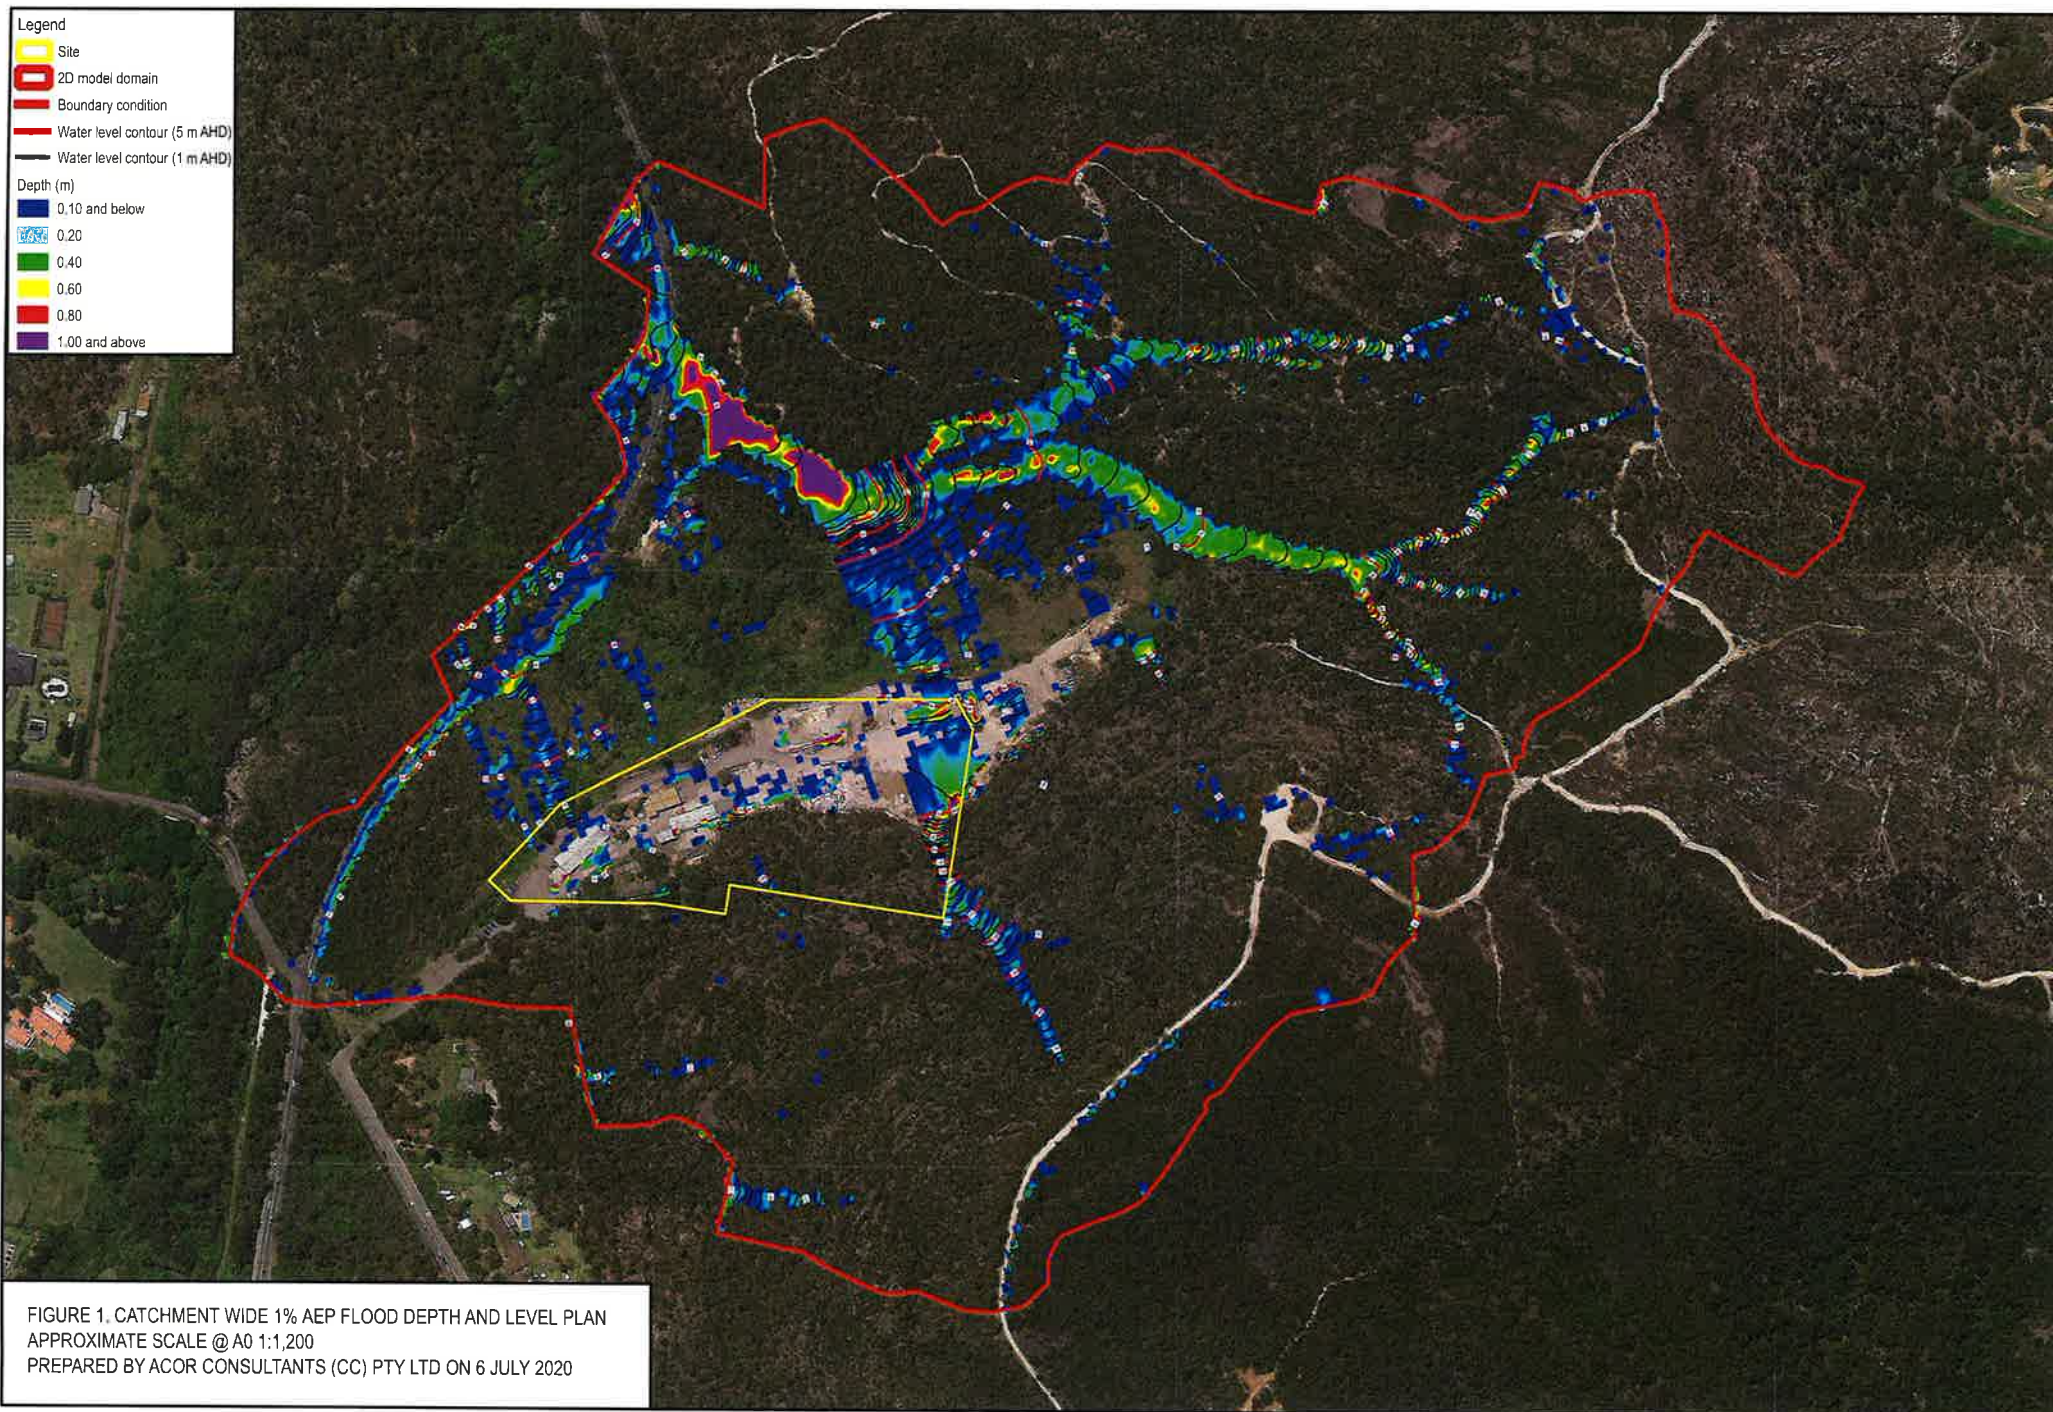

REFER SHEET G2 FOR DETAIL PLAN

REFER SHEET G3 FOR DETAIL PLAN

REFER SHEET G4 FOR DETAIL PLAN

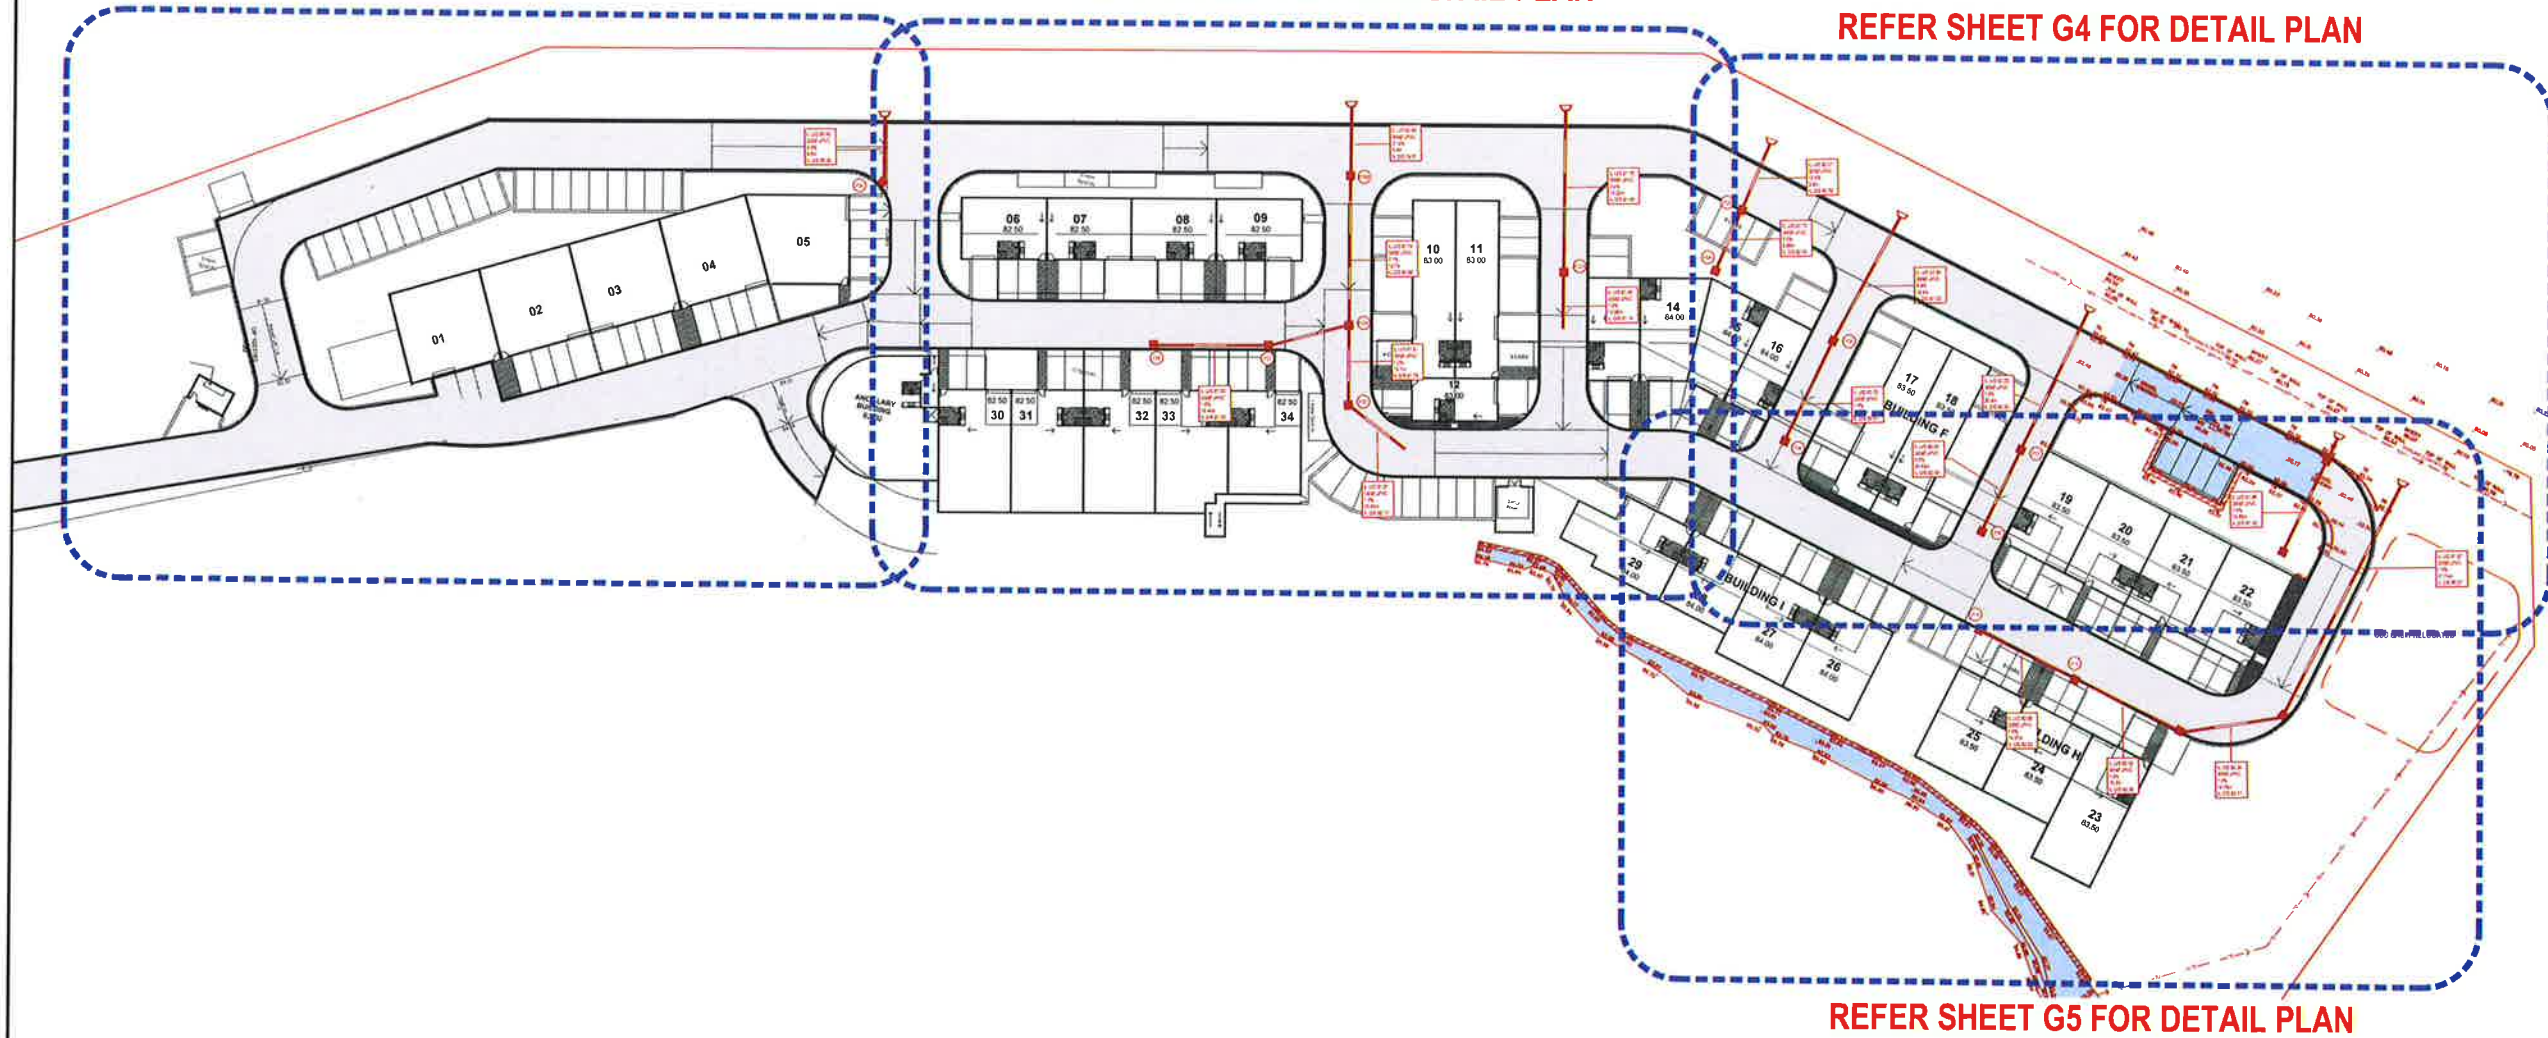


WORK AS EXECUTED GENERAL PLAN
SCALE - 1:300/A1, 1:600/A3

© COPYRIGHT of this design and plan is the property of ACOR Consultants (CC) Pty Ltd, ACN 127 012 104 ATF The ACOR (CC) Unit Trust ABN 81 392 991 647, all rights reserved. It must not be used, modified, reproduced or copied wholly or in part without written permission from ACOR Consultants (CC) Pty Ltd. ACOR Consultants is a trademark licensed to ACOR Consultants (CC) Pty Ltd by ACOR Consultants Pty Ltd.

This drawing has been assigned an electronic code that signifies the drawing has been checked and approved by: MR MICHAEL GOODWIN MIEAust CPEng NER

Issue	Description	Date	Drawn	Approved
B	WORK AS EXECUTED	05.05.21	SJ	BK
A	WORK AS EXECUTED OVERLAY	26.03.21	SJ	BK

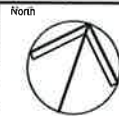

Client
MR W. EDWARDS

Architect
GELDER



ACOR Consultants (CC) Pty Ltd
Platinum Building, Suite 2.01, 4 Ilya Avenue
ERINA NSW 2250, Australia
T +61 2 4324 3499



Project
PROPOSED INDUSTRIAL
DEVELOPMENT
LOT 100 D.P. 1023183
MEATWORKS AVENUE
OXFORD FALLS

Drawing Title WORK AS EXECUTED GENERAL PLAN				
Drawn	Date	Scale	A1	Q.A. Check
SJ	26.03.21	AS NOTED	-	-
Designed	Project No.	Dwg. No.	Issue	
BK	CC180469	G1	B	



PIT SCHEDULE

PIT No.	TYPE	SIZE	TOP GRATE
P38	HD GRATED INLET	900 x 900	81.55

PROPOSED PIT SURFACE LEVELS AND INVERTS TO BE
CONFIRMED ON SITE PRIOR TO CONSTRUCTION

IL U/S 80.40
300Ø uPVC
4.0%
8.8m
IL D/S 80.05

EXISTING OUTLET

ANCILLARY
BUILDING
82.00


REFER TO SHEET G3 FOR CONTINUATION

WORK AS EXECUTED DETAIL PLAN
SCALE - 1:150/A1, 1:300/A3

©COPYRIGHT of this design and plan is the property of ACOR Consultants (CC) Pty Ltd, ACN 127 012 104 ATF The ACOR (CC) Unit Trust ABN 81 392 991 647, all rights reserved. It must not be used, modified, reproduced or copied wholly or in part without written permission from ACOR Consultants (CC) Pty Ltd. ACOR Consultants is a trademark licensed to ACOR Consultants (CC) Pty Ltd by ACOR Consultants Pty Ltd.

This drawing has been assigned an electronic code that signifies the drawing has been checked and approved by: MR MICHAEL GOODWIN MIEAust CPEng NER

Issue	Description	Date	Drawn	Approved
B	WORK AS EXECUTED	05.05.21	SJ	BK
A	WORK AS EXECUTED OVERLAY	26.03.21	SJ	BK

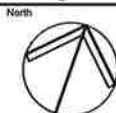

Client
MR W. EDWARDS

Architect
GELDER




ENGINEERS | MANAGERS | INFRASTRUCTURE PLANNERS | DEVELOPMENT CONSULTANTS

ACOR Consultants (CC) Pty Ltd
Platinum Building, Suite 2.01, 4 Ilya Avenue
ERINA NSW 2250, Australia
T +61 2 4324 3499

Project
**PROPOSED INDUSTRIAL
DEVELOPMENT**
LOT 100 D.P 1023183
MEATWORKS AVENUE
OXFORD FALLS

Drawing Title WORK AS EXECUTED DETAIL PLAN SHEET 1 OF 4				
Drawn SJ	Date 26.03.21	Scale AS NOTED	AT -	Q.A. Check -
Designed BK	Project No. CC180469	Dwg. No. G2	Issue B	Date -

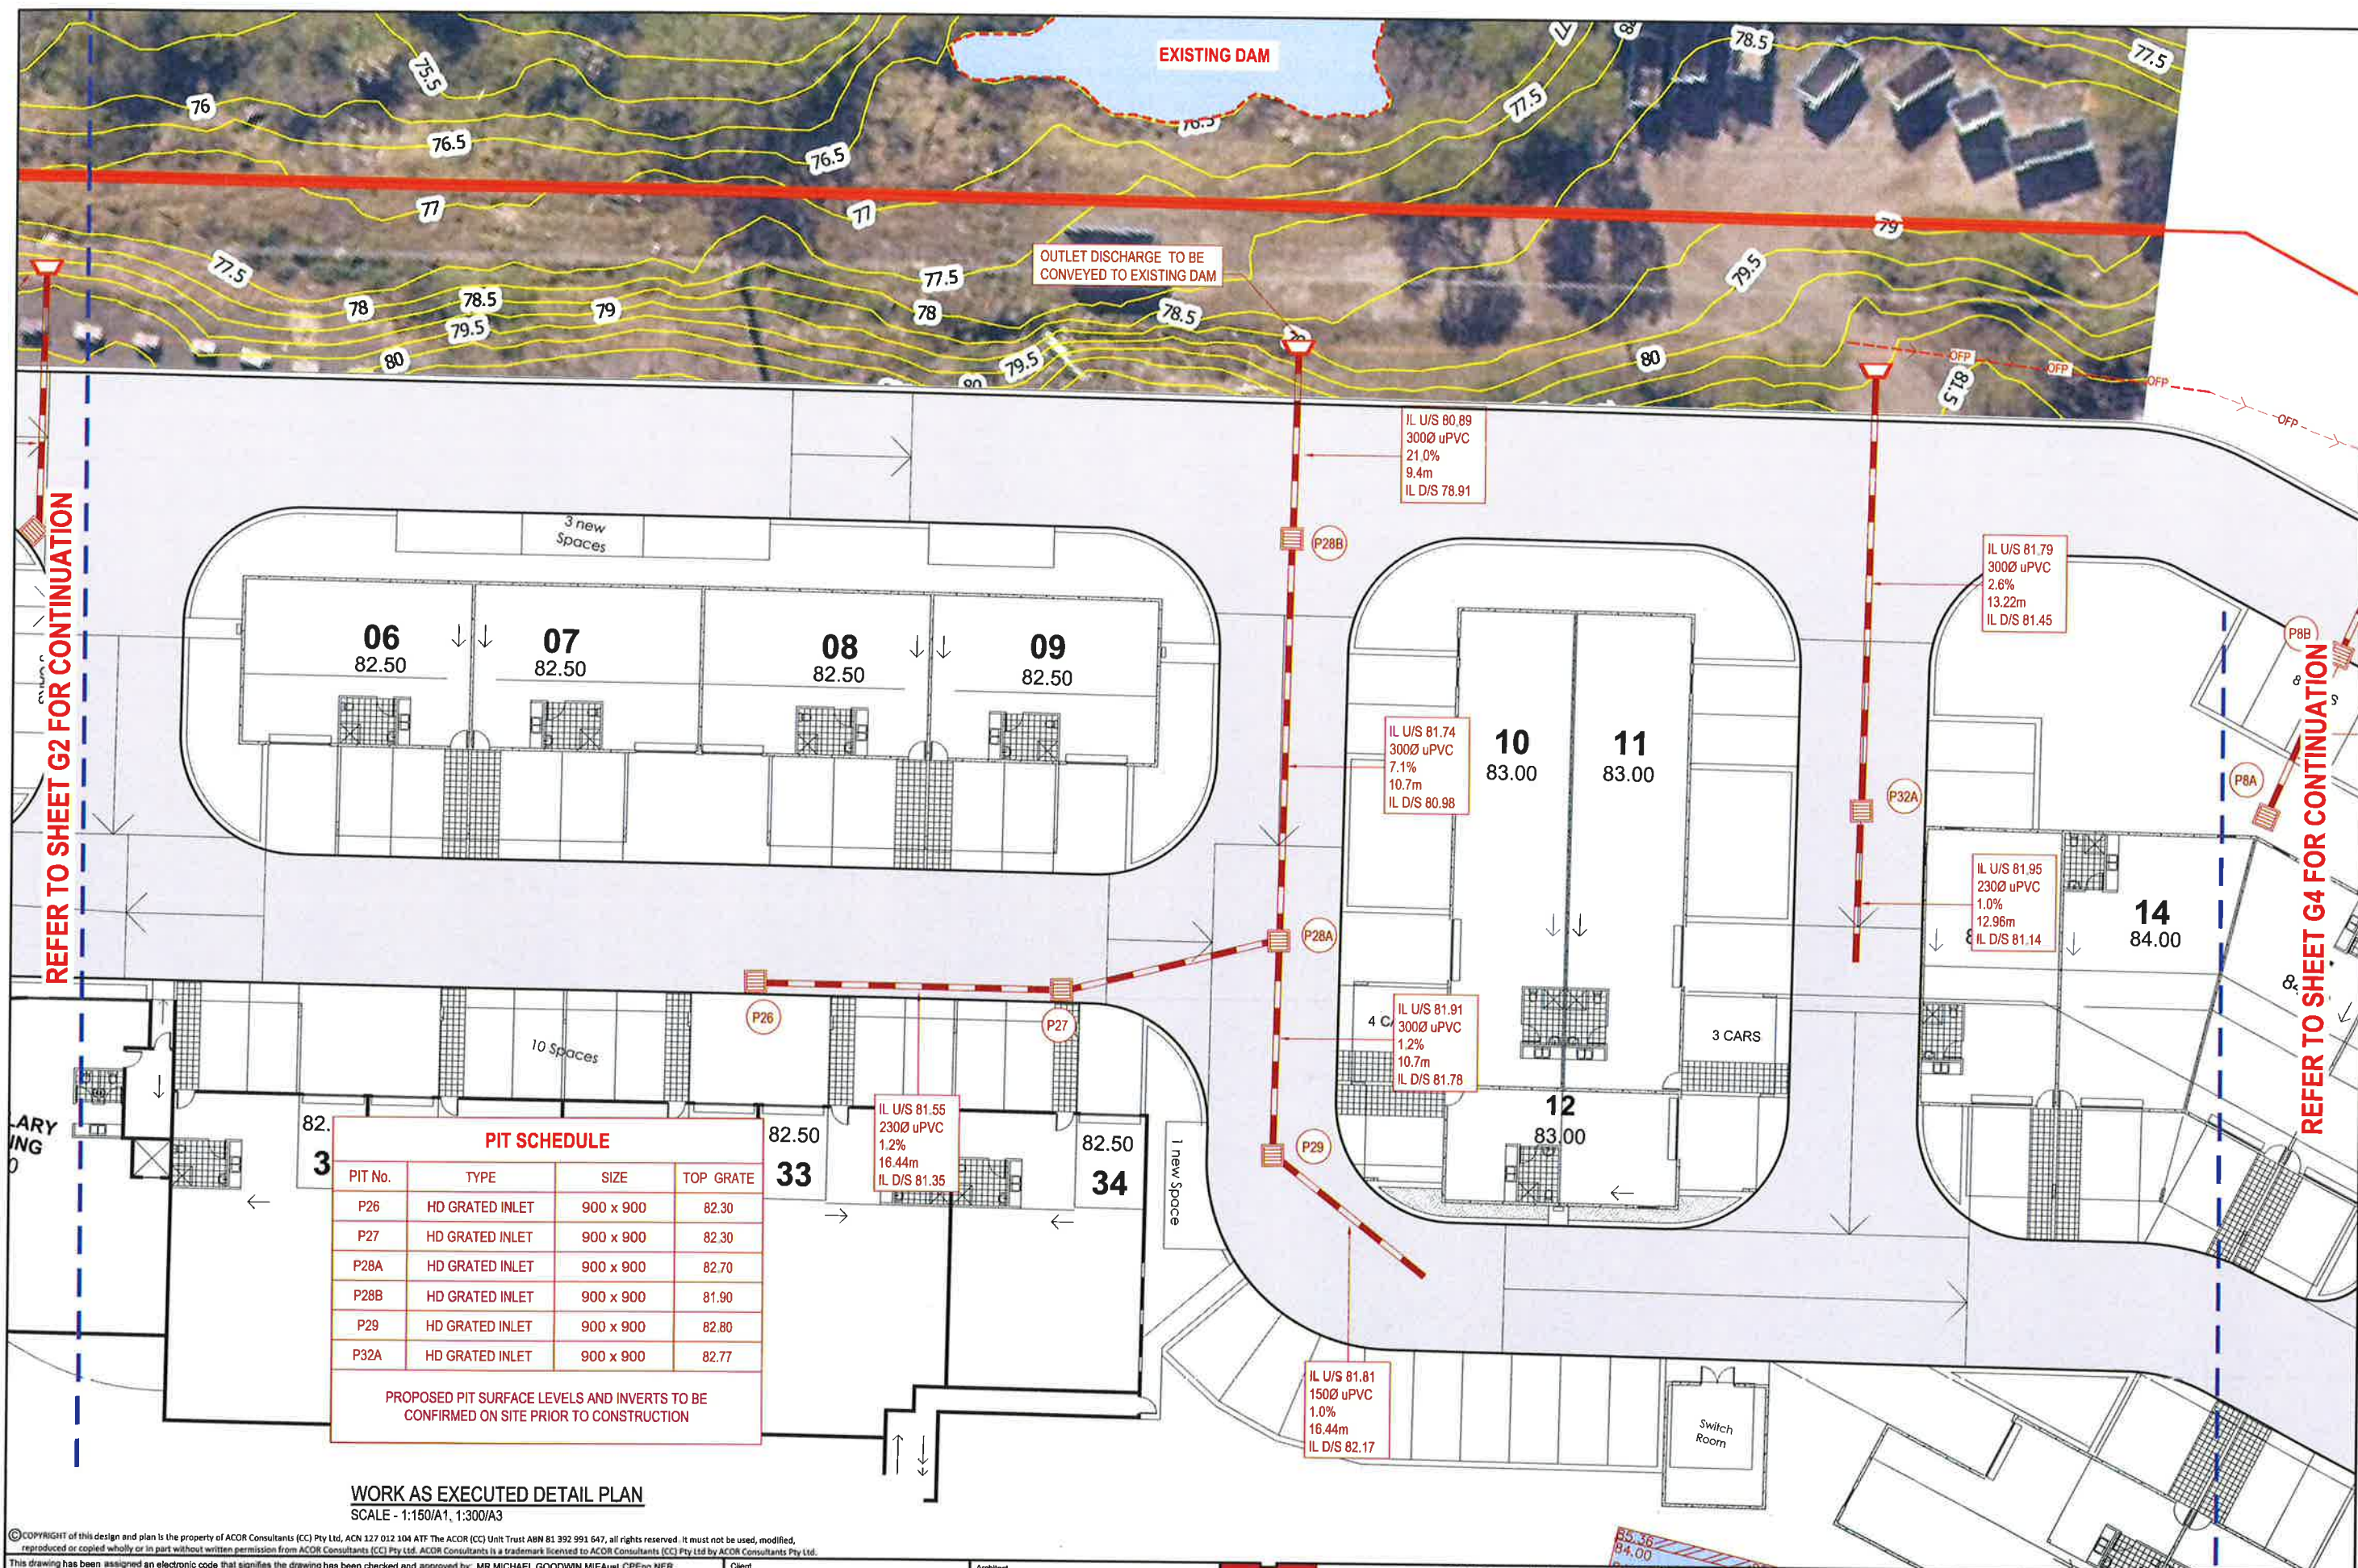

© COPYRIGHT of this design and plan is the property of ACOR Consultants (CC) Pty Ltd, ACN 127 012 104 ATF The ACOR (CC) Unit Trust AIN 81 392 991 647, all rights reserved. It must not be used, modified, reproduced or copied wholly or in part without written permission from ACOR Consultants (CC) Pty Ltd. ACOR Consultants is a trademark licensed to ACOR Consultants (CC) Pty Ltd by ACOR Consultants Pty Ltd.

This drawing has been assigned an electronic code that signifies the drawing has been checked and approved by: MR MICHAEL GOODWIN MIEAust CPENG NER

B	WORK AS EXECUTED	05.05.21	SJ	BK
A	WORK AS EXECUTED OVERLAY	26.03.21	SJ	BK
Issue	Description	Date	Drawn	Approved

Client
MR W. EDWARDS


Architect
GELDER



ACOR Consultants (CC) Pty Ltd
Platinum Building, Suite 2.01, 4 Ilya Avenue
ERINA NSW 2250, Australia
T +61 2 4324 3499

Project
PROPOSED INDUSTRIAL DEVELOPMENT
LOT 100 D.P. 1023183
MEATWORKS AVENUE
OXFORD FALLS


Drawing Title	WORK AS EXECUTED DETAIL PLAN SHEET 2 OF 4			
Drawn	Date	Scale	A1	Q.A. Check
SJ	26.03.21	AS NOTED	-	-
Designed	Project No.	Dwg. No.	Issue	
BK	CC180469	G3	B	

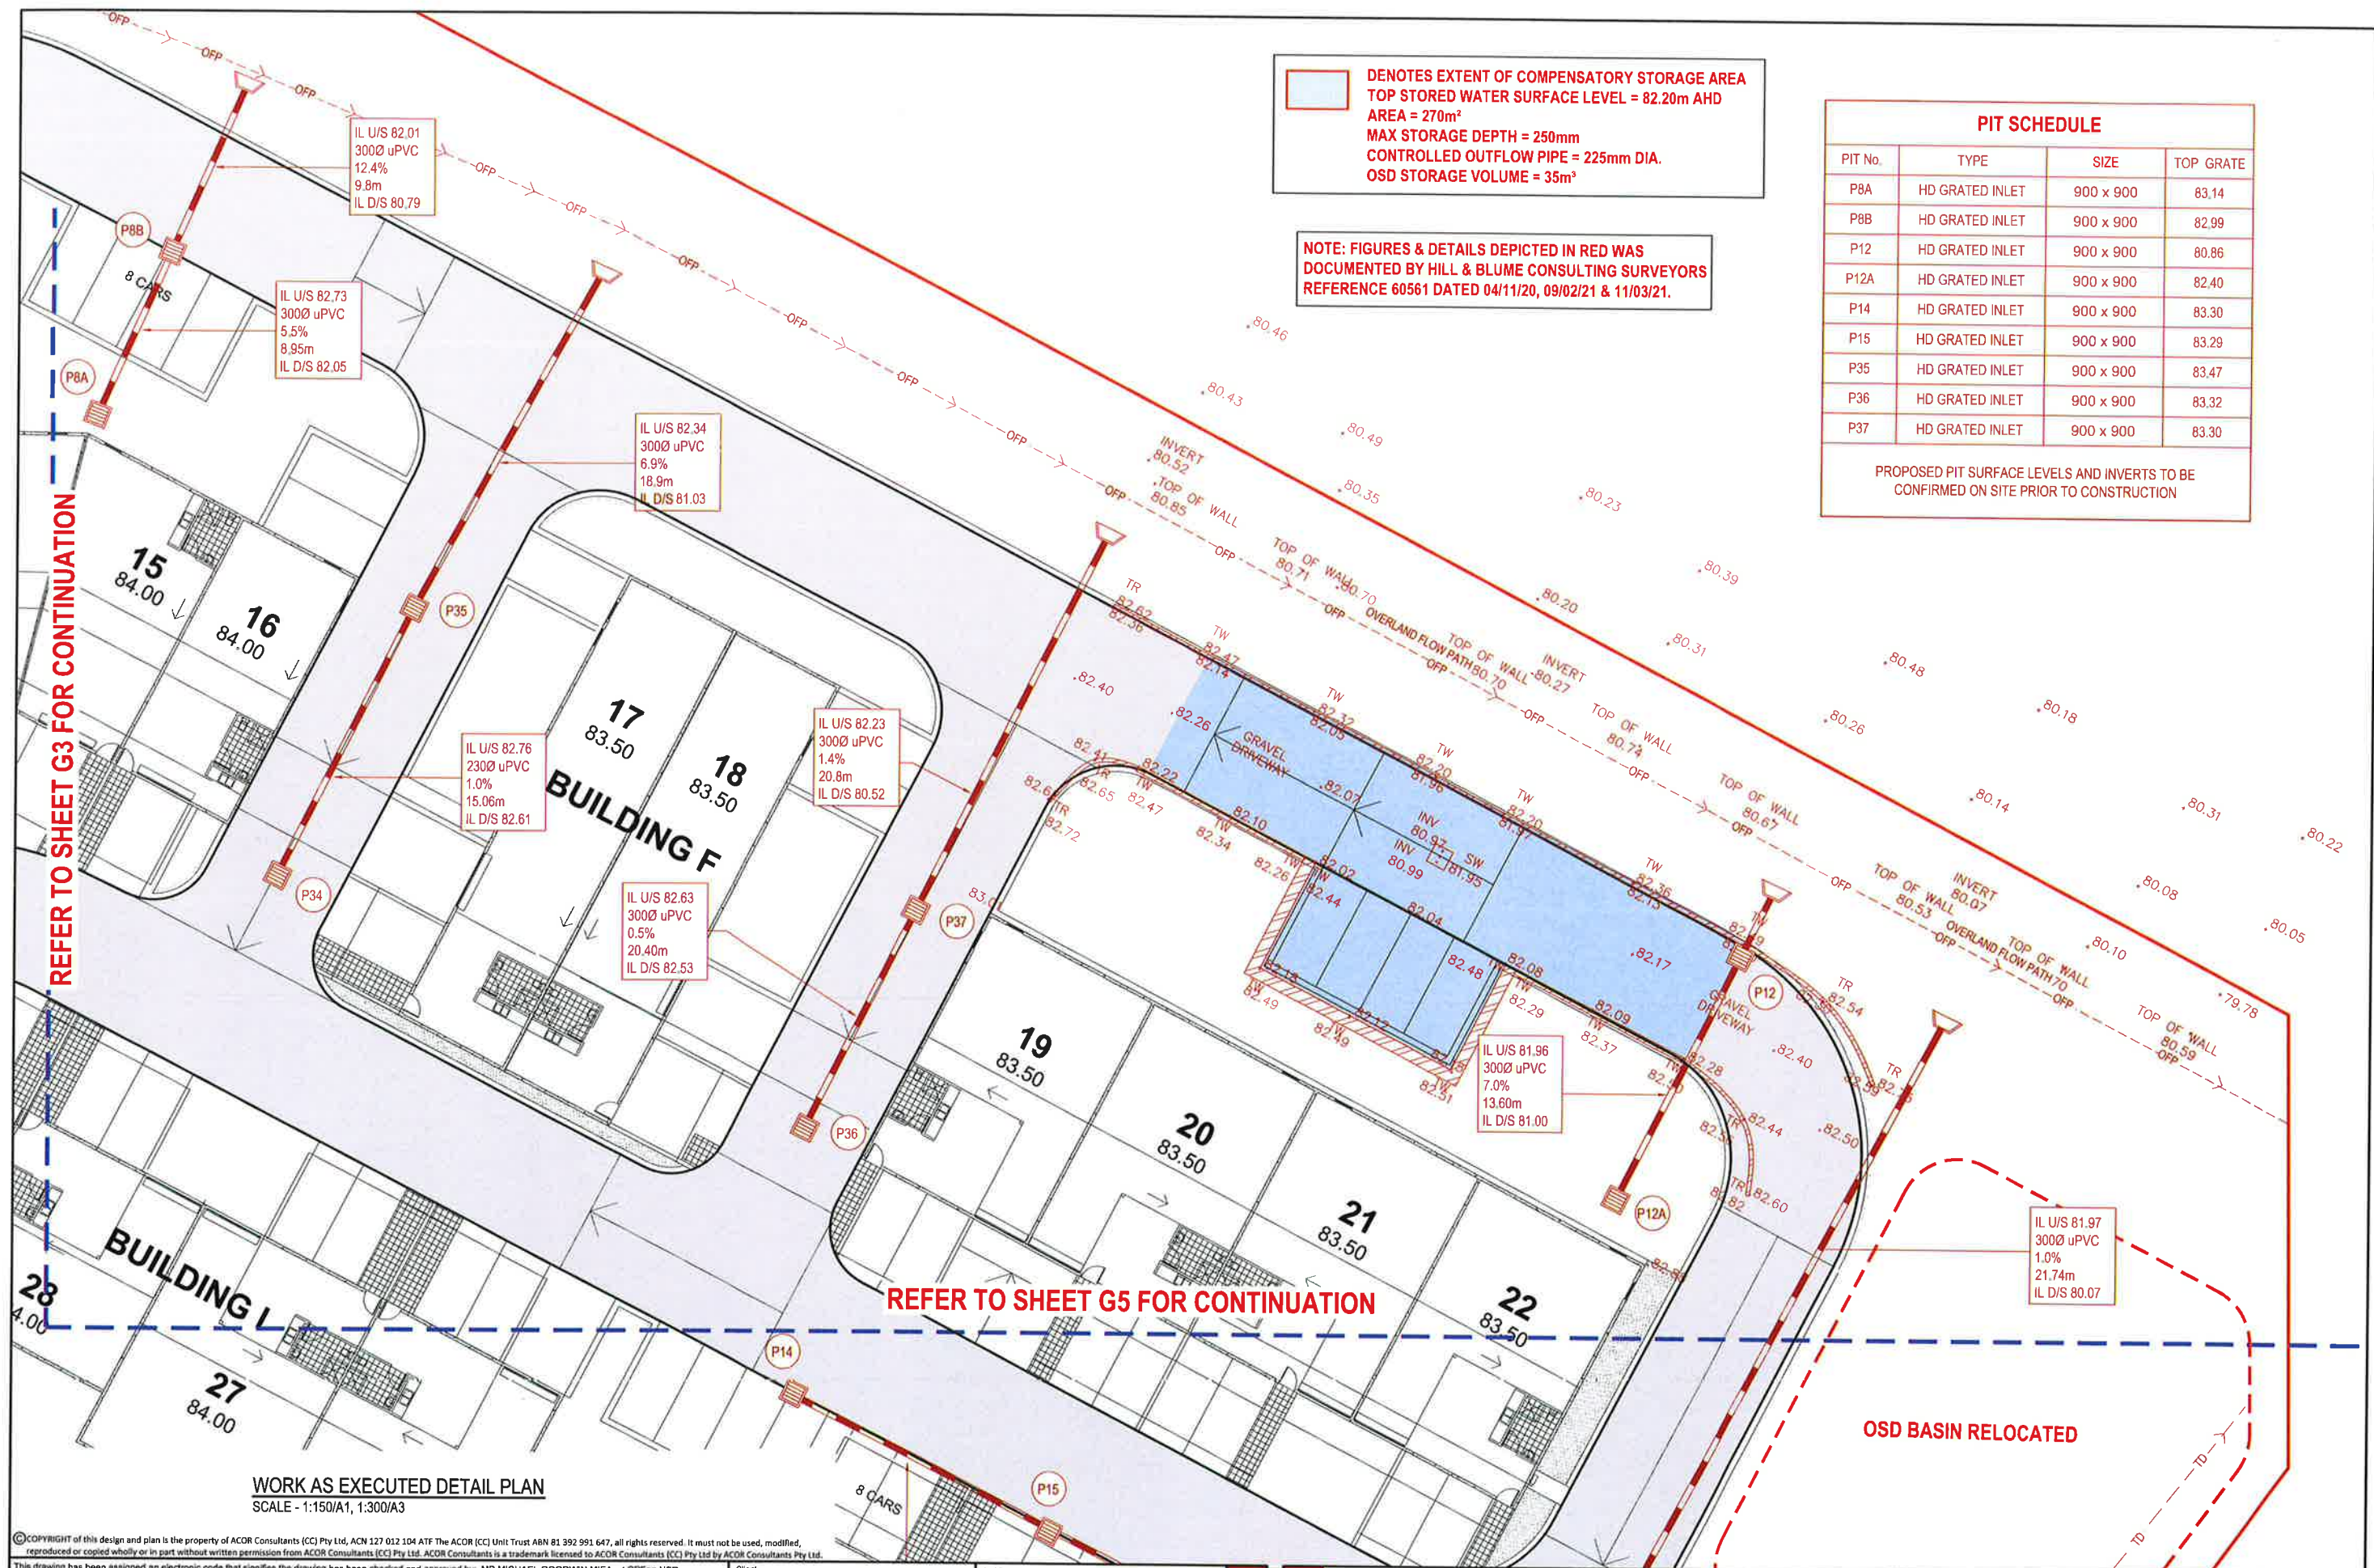

© COPYRIGHT of this design and plan is the property of ACOR Consultants (CC) Pty Ltd, ACN 127 012 104 ATF The ACOR (CC) Unit Trust ABN 81 392 991 647, all rights reserved. It must not be used, modified, reproduced or copied wholly or in part without written permission from ACOR Consultants (CC) Pty Ltd. ACOR Consultants is a trademark licensed to ACOR Consultants (CC) Pty Ltd by ACOR Consultants Pty Ltd.

This drawing has been assigned an electronic code that signifies the drawing has been checked and approved by: MR MICHAEL GOODWIN MIEAust CPEng NER

B	WORK AS EXECUTED	05.05.21	SJ	BK
A	WORK AS EXECUTED OVERLAY	26.03.21	SJ	BK
Issue	Description	Date	Drawn	Approved

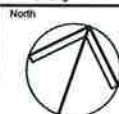

Client
MR W. EDWARDS

Architect
GELDER



ACOR Consultants (CC) Pty Ltd
Platinum Building, Suite 2.01, 4 Ilya Avenue
ERINA NSW 2250, Australia
T +61 2 4324 3499

Project
PROPOSED INDUSTRIAL DEVELOPMENT
LOT 100 D.P 1023183
MEATWORKS AVENUE
OXFORD FALLS

Drawing Title
WORK AS EXECUTED DETAIL PLAN SHEET 3 OF 4

Drawn	Date	Scale	A1	QA Check	Date
SJ	26.03.21	AS NOTED	-	-	-
Designed	Project No	Drawn	Issue		
BK	CC180469	G4	B		

REFER TO SHEET G3 FOR CONTINUATION

REFER TO SHEET G4 FOR CONTINUATION

OSD BASIN RELOCATED

PIT SCHEDULE			
PIT No.	TYPE	SIZE	TOP GRATE
P12	HD GRATED INLET	900 x 900	80.86
P12A	HD GRATED INLET	900 x 900	82.40
P14	HD GRATED INLET	900 x 900	83.30
P15	HD GRATED INLET	900 x 900	83.29
P36	HD GRATED INLET	900 x 900	83.32
P37	HD GRATED INLET	900 x 900	83.30
PROPOSED PIT SURFACE LEVELS AND INVERTS TO BE CONFIRMED ON SITE PRIOR TO CONSTRUCTION			


NOTE: FIGURES & DETAILS DEPICTED IN RED WAS
DOCUMENTED BY HILL & BLUME CONSULTING SURVEYORS
REFERENCE 60561 DATED 04/11/20, 09/02/21 & 11/03/21.

WORK AS EXECUTED DETAIL PLAN
SCALE - 1:150/A1, 1:300/A3

© COPYRIGHT of this design and plan is the property of ACOR Consultants (CC) Pty Ltd, ACN 127 012 104 ATF The ACOR (CC) Unit Trust ABN 81 392 991 647, all rights reserved. It must not be used, modified, reproduced or copied wholly or in part without written permission from ACOR Consultants (CC) Pty Ltd. ACOR Consultants is a trademark licensed to ACOR Consultants (CC) Pty Ltd by ACOR Consultants Pty Ltd.

This drawing has been assigned an electronic code that signifies the drawing has been checked and approved by: MR MICHAEL GOODWIN MIEAust CPEng NER

Issue	Description	Date	Drawn	Approved
B	WORK AS EXECUTED	05.05.21	SJ	BK
A	WORK AS EXECUTED OVERLAY	26.03.21	SJ	BK

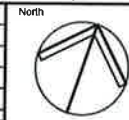

Client
MR W. EDWARDS

Architect
GELDER



ENGINEERS | MANAGERS | INFRASTRUCTURE PLANNERS | DEVELOPMENT CONSULTANTS

ACOR Consultants (CC) Pty Ltd
Platinum Building, Suite 2.01, 4 Ilya Avenue
ERINA NSW 2250, Australia
T +61 2 4324 3499

Project
PROPOSED INDUSTRIAL
DEVELOPMENT
LOT 100 D.P. 1023183
MEATWORKS AVENUE
OXFORD FALLS

Drawing Title WORK AS EXECUTED DETAIL PLAN SHEET 4 OF 4				
Drawn	Date	Scale	AT	Q.A. Check
SJ	26.03.21	AS NOTED	-	-
Designed	Project No.	Dwg. No.	Issue	
BK	CC180469	G5	B	