


D.P. 8075

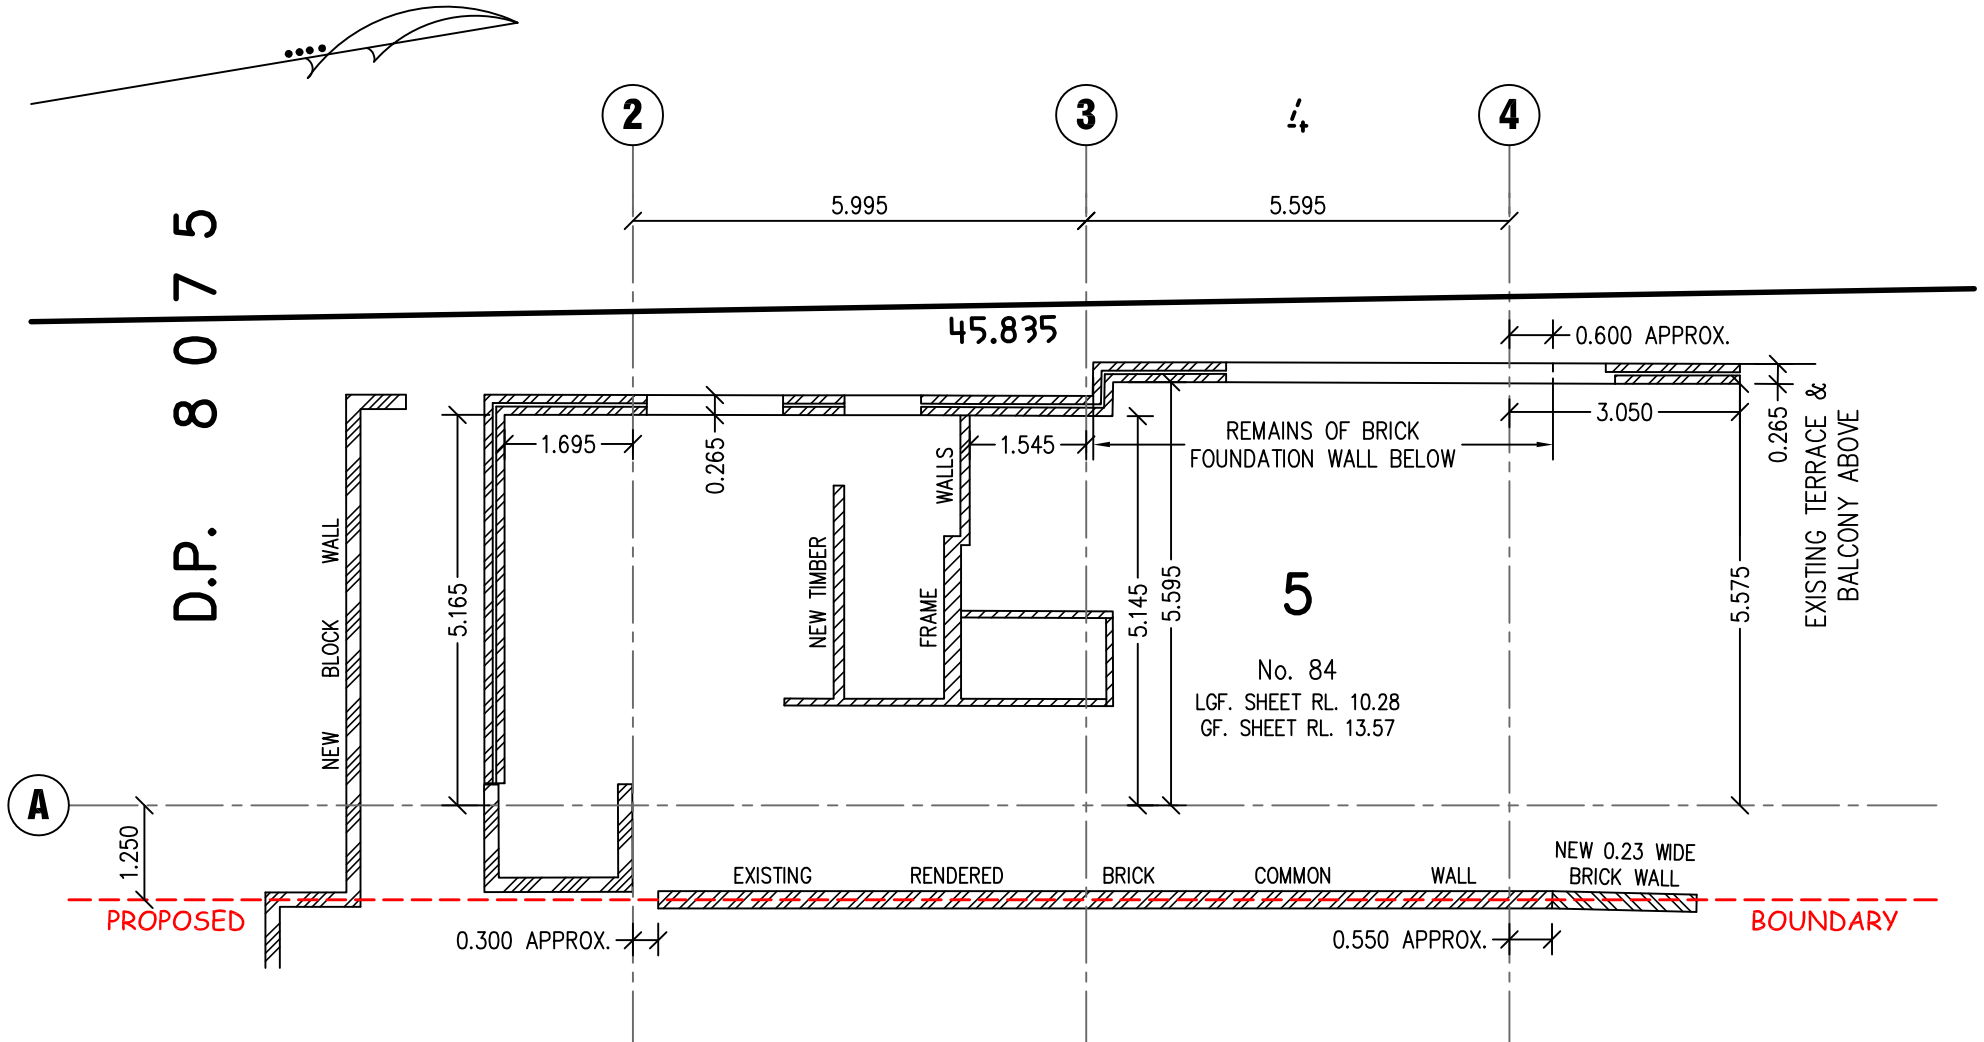

Bee & Lethbridge
Quality Surveying & Development Solutions

Bee & Lethbridge Pty Ltd
Suite 2, 14 Starkey Street,
PO Box, 330, Forestville, NSW 2087
Phone: 9451 6757 Fax: 9975 3535
Email: survey@beeeth.com.au
ABN: 13 003 194 447
www.beeeth.com.au

PLAN SHOWING PARTIAL BOUNDARIES,
AS BUILT WALLS & GRID OFFSETS AT
No. 84 BOWER STREET, MANLY

L.G.A.: NORTHERN BEACHES

DATE: 05/12/2019
REF No: **21320**
DWG No. 21320ska
SURVEYED: W.B./J.H.
DRAWN: R.M.

