

NOTES:

BOUNDARY DIMENSIONS SHOWN HEREON REFER TO PLAIN DIMENSIONS ONLY AND HAVE BEEN DETERMINED BY FIELD SURVEY.

SERVICES SHOWN HEREON HAVE BEEN LOCATED BY FIELD SURVEY.

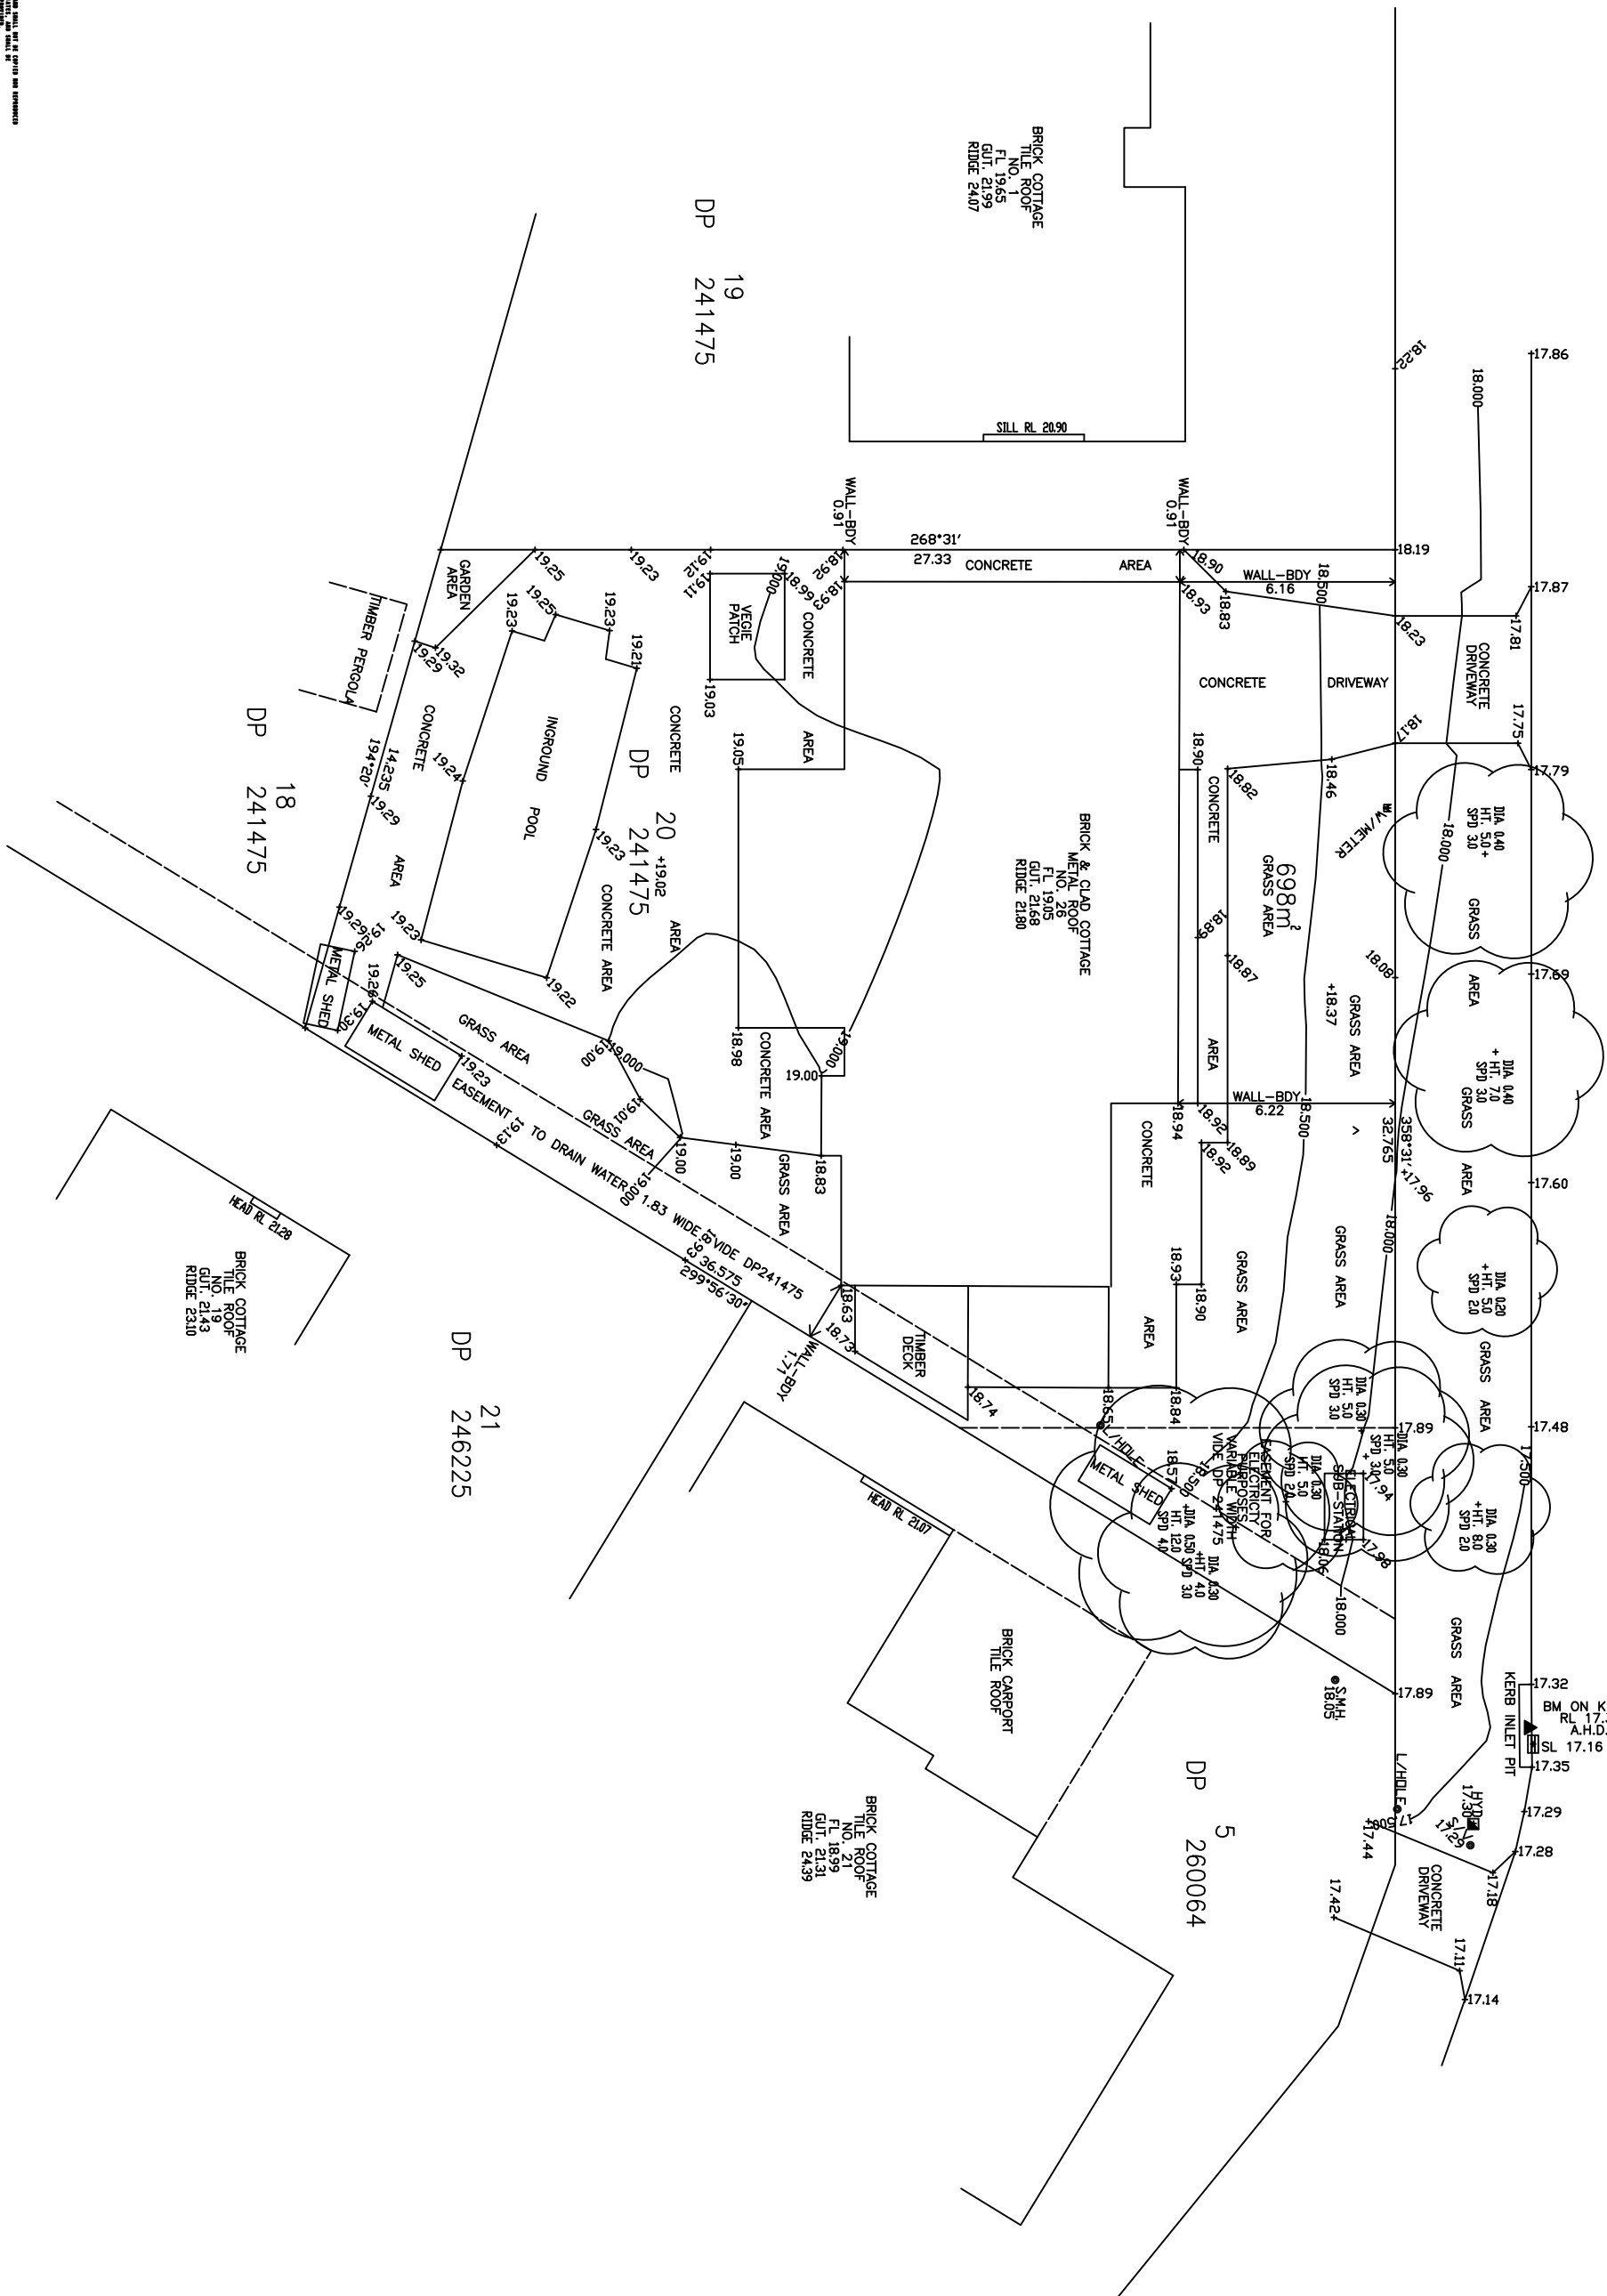
PRIOR TO ANY DEMOLITION, CONSTRUCTION OR EXCAVATION A THOROUGH SEARCH OF THE SERVICE AUTHORITIES SHOULD BE MADE TO DETERMINE THE POSSIBLE LOCATION OF FURTHER UNDERGROUND SERVICES.

CONTOURS SHOWN HEREON ARE INDICATIVE ONLY AND ARE SUITABLE FOR MAPPING AT A SCALE OF 1" = 100' OR SMALLER. PREFERENCE SHOULD BE GIVEN TO SPOT HEIGHTS AS SHOWN.

~~APPROX. TRUE NORTH~~
~~N.M.~~

JEANETTE

AVENUE

[illegible]