

PARTITION LEGEND	
CODE	DESCRIPTION
	EXISTING WALLS / COLUMNS
	NEW PLASTERBOARD PARTITION . FROM FFL TO UNDERSIDE OF SERVICES. 1 X LAYER OF 13MM PLASTERBOARD . STAGGER JOINTS EACH SIDE, TAPE, SET FLUSH, AND SAND READY FOR SELECTED PAINT FINISH. 64MM STEEL STUDS @ 600MM CENTRES.

FINISHES SCHEDULE		
PAINT COLOURS		
CODE	DESCRIPTION	QTY
P1	DULUX 2PAC BLACK 10% GLOSS FINISH	TO PAINT EXPOSED CEILING
P2	DULUX BLACK LOW SHEEN FINISH	TO PAINT EXPOSED CEILING AND ENTRY BULKHEAD
P3	DULUX CHOCOLATE GLIMMER METALLIC	TO WALL GRAPHIC & SHOPFRONT

FURNITURE		
CODE	DESCRIPTION	QTY
MIRROR A	TANTRA MIRROR PREMIUM INVERSE MIRROR SIZE: 2200 x 1200	1
MIRROR B	TANTRA MIRROR INVERSE MIRROR SIZE: 1400 x 600	1

FLOOR FINISHES		
CODE	DESCRIPTION	QTY
F1	CONCRETE ARTISANS PODDOMO FLOOR COL: TO MATCH P3 APPLY R10 SEALANT TO FLOOR
R1	ULTRA PLUSH CARPET CUSTOM MADE RUG AT 1300mm X 2200mm. COLOUR MATCHING OVERLOCKER WITH RUG LOCK APPLIED. COL: BLACK	1

NOTE : PROVIDE FLAT BAR TRANSITION STRIP AT JUNCTION OF LEASE LINE.

FINISHES		
CODE	DESCRIPTION	TO
V1	PADDED WALL MATERIAL TBC	TO PADDED WALL
WP	CUSTOM COLETTE WALL PAPER	TO ALL EXPOSED WALLS
M1	LAMINEX 'BLACK' FLINT FINISH	TO INTERNAL CUPBOARDS/DRAWERS
G1	TOUGHEN STAR FIRE GLASS COL: COLOUR BACK IN P3	TO SHOP FRONT

NOTE:

- ALL NEW ESSENTIAL FIRE AND OTHER SAFETY MEASURES WILL COMPLY WITH AS2118 & BCA
- ALL MATERIALS & FINISHES WILL COMPLY WITH SPECIFICATION OF THE BCA C1.10 - FIRE HAZARD PROPERTIES
- ALL PARTITIONS WILL BE INSTALLED IN ACCORDANCE WITH BCA CLAUSE D3.2- GENERAL BUILDING ACCESS REQUIREMENTS AND CLAUSE 3.3- PARTS OF A BUILDING TO BE ACCESSIBLE
- ALL GLAZING WILL BE INSTALLED IN ACCORDANCE WITH AS1288
- ALL DOORS TO COMPLY WITH BCA CLAUSE D2.21 - OPERATION OF LATCH
- IDENTIFICATION OF ACCESSIBLE FACILITIES, SERVICES AND FEATURES TO BE COMPLIED WITH IN ACCORDANCE TO BCA CLAUSE D3.6
- ALL EXIT SIGNS AND EMERGENCY LIGHTS WILL COMPLY WITH AS-NZS2293.1 AND CLAUSE J6 OF THE BCA - ARTIFICIAL LIGHTING AND POWER
- ALL FLUORESCENT AND HALOGEN LIGHTING WILL COMPLY WITH AS1680 AND CLAUSE J6 OF THE BCA - ARTIFICIAL LIGHTING AND POWER
- ALL MECHANICAL VENTILATIONS AND AIR VENTS WILL COMPLY WITH AS1688.2 AND AS-NZS3688.1 AND CLAUSE J6 OF THE BCA - AIRCONDITIONING AND VENTILATION SYSTEMS AS WELL AS CLAUSE J4 - AIR MOVEMENT & CLAUSE J3- BUILDING SEALING
- ALL OPENINGS FOR SERVICE INSTALLATIONS ARE TO COMPLY WITH CLAUSE C3.15 OF THE BCA

Finishes board is required to be submitted for review approval.

WARRINGAH COUNCIL
THIS PLAN TO BE READ
IN CONJUNCTION WITH
Construction
Certificate No CC2010/0094

APPROVED DESIGN CONCEPT

Date: 23/2/10 Issue: P1/100
 City: Warragul
 Site Name: Colette
 Retail Design Manager: [Signature]

Consent of the Council is granted to the lessee for the shopfront, shop layout and signage shown on these drawings. Any items noted must be addressed and if requested submitted for approval prior to manufacture.

SUBJECT TO COMMENTS

Unit 10, 54 Tennyson Rd, Gladesville NSW 2111, Australia
 EMAIL: s_nitale@bigpond.com
 IN2DESIGN (AUSTRALIA) ABN 58 959 188 181
 DESIGN | DRAFTING | PROPERTY STYLING
 RETAIL | COMMERCIAL | RESIDENTIAL

Figured dimensions shall take preference over scaling. Contractor shall verify all dimensions on site before preparing shop drawings or starting work. Any variations to Specifications and Drawings must be authorised by IN2DESIGN (AUSTRALIA). These Designs, Drawings and Specifications shall remain the copyright of IN2DESIGN (AUSTRALIA) and must not be used, reproduced or copied wholly or in part without the written permission of the owners.
NB. THIS DRAWING IS DESIGN INTENT ONLY.
 It is the responsibility of the shopfitter to ensure that his work is carried out compliant to BCA - other relevant Authorities/Codes

CLIENT	COLETTE ACCESSORIES				
PROJECT	SHOP 83 WARRINGAH MALL	A	16/02	FIRST ISSUE	SM
DRAWING	NOTES	SCALE	DATE	16/02/10	
		DRAWN BY	CHECKED	REV NO	
		SM		01	


REFLECTED CEILING LEGEND	
CODE	ITEM
	T-ART 35W METAL HALIDE ON SUSPENDED TRACK SYSTEM. WARM LIGHT FINISH: BLACK
	MUSIC PENDANT DECO PLCE-15W/83 DIMMABLE. FINISHED IN BLACK SUPPLY 3m LONG WIRE/CABLE ADJUSTABLE TO SUIT LENGTH ON SITE
	CIRCO 1012 LG + LAMINA 8W LED LAMP. FINISHED IN BLACK RECESSED TO UNDERSIDE OF BULKHEAD OF FIXTURES
	DOWN LIGHT DL507 35W METAL HALIDE. WARM LIGHT TRIM FINISHED IN BLK RECESSED TO UNDERSIDE OF BULKHEAD OF FIXTURES
	NEW EXIT SIGNS - LED EDGE LIT SIGN
	CEILING MOUNTED NEW DOUBLE GPO POWER OUTLET
	NEW THREE WAY GANS SWITCHING LOCATION
	NEW TWO WAY TWO GANS SWITCHING LOCATION
	NEW LIGHT GANS SWITCHING LOCATION
	NEW SPIT FIRE EMERGENCY LIGHT

NOTE:
- ALL AIR-CONDITIONING VENTS AND GRILLS TO BE INCORPORATED INTO LIGHTING STRIP IN CEILING BY MEANS OF BARS GRILLS IN MATCHING FINISH TO LIGHTS

WARRINGAH COUNCIL
THIS PLAN TO BE READ
IN CONJUNCTION WITH
Construction
Certificate No. CC2010/0094


APPROVED
DESIGN CONCEPT
DATE: 23/2/10
CLIENT: Warringah Council
DESIGNER: Colette
SUBJECT TO COMMENTS

Requires plaster to be removed from shop counter top and ceiling for lighting fixtures.

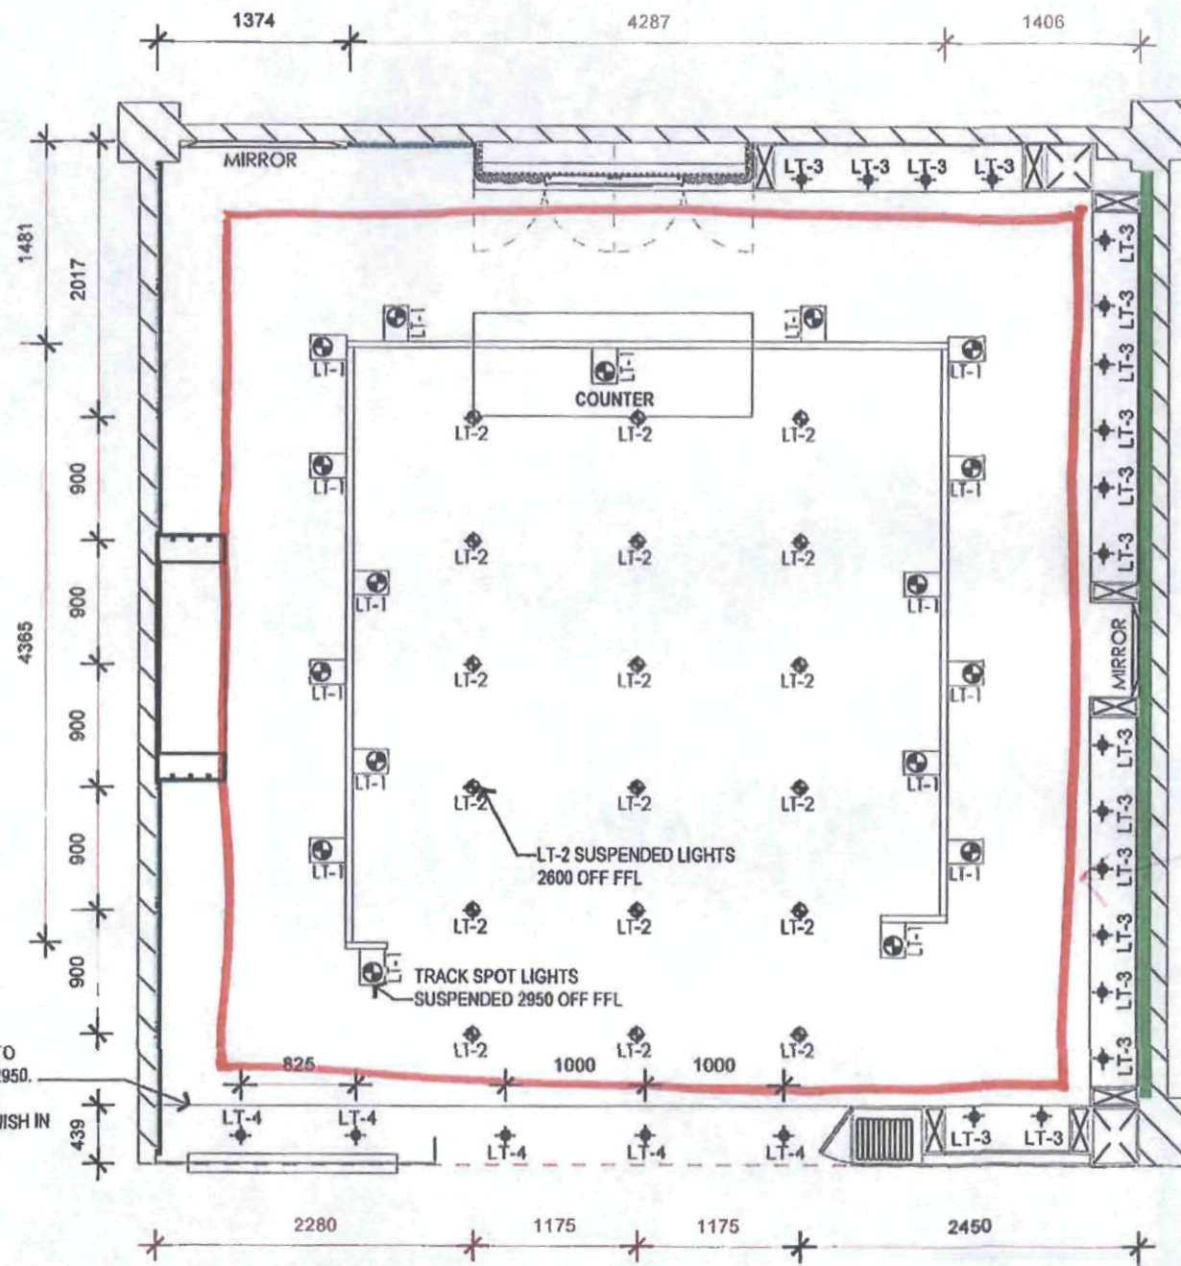

NOTE:
- TOTAL FLOOR AREA 55.1 m²
- UNDERSIDE OF EXPOSED CEILING TO BE MADE GOOD AND PAINTED IN P1 BLACK FLAT FINISH.
- WHEN REQUIRED, INTERTENANCY WALLS NEED TO BE EXTENDED.
- ALL CABLE TRAYS ARE TO BE BOXED, NO LOSE CABLING, ALL VISIBLE SERVICES TIDIED AND MADE GOOD.
- NECESSARY RIGID DUCT WORK TO BE INSTALLED.

Unit 10, 54 Tenmyson Rd, Gladsville NSW 2111, Australia EMAIL: milalis@bigpond.com IN2DESIGN (AUSTRALIA) ABN 58 950 188 181 DESIGN DRAFTING PROPERTY STYLING RETAIL COMMERCIAL RESIDENTIAL 	Figured dimensions shall take preference over scaling. Contractor shall verify all dimensions on site before preparing shop drawings or starting work. Any variations to Specification and Drawings must be authorised by IN2DESIGN (AUSTRALIA). These Designs, Drawings and Specifications shall remain the copyright of IN2DESIGN (AUSTRALIA), and must not be used, reproduced or copied wholly or in part without the written permission of the owner. NB. THIS DRAWING IS DESIGN INTENT ONLY. It is the responsibility of the shop/owner to ensure that this work is carried out compliant to BCA + other relevant Authorities/Codes.	CLIENT	COLETTE ACCESSORIES				
		PROJECT	SHOP 83 WARRINGAH MALL	SCALE	1:50	DATE	16/02/10
DRAWING	RCP PLAN	DRAWN BY	SM	CHECKED		REV. NO.	
		REV	DATE	AMENDMENTS	BY	APP	
		DESIGN REVIEW					
		REV	DATE	AMENDMENTS	BY	APP	
		SCALE	1:50	DATE	16/02/10		
		DRAWN BY	SM	CHECKED		REV. NO.	
		DESIGN NO.		DOCS NO.			03

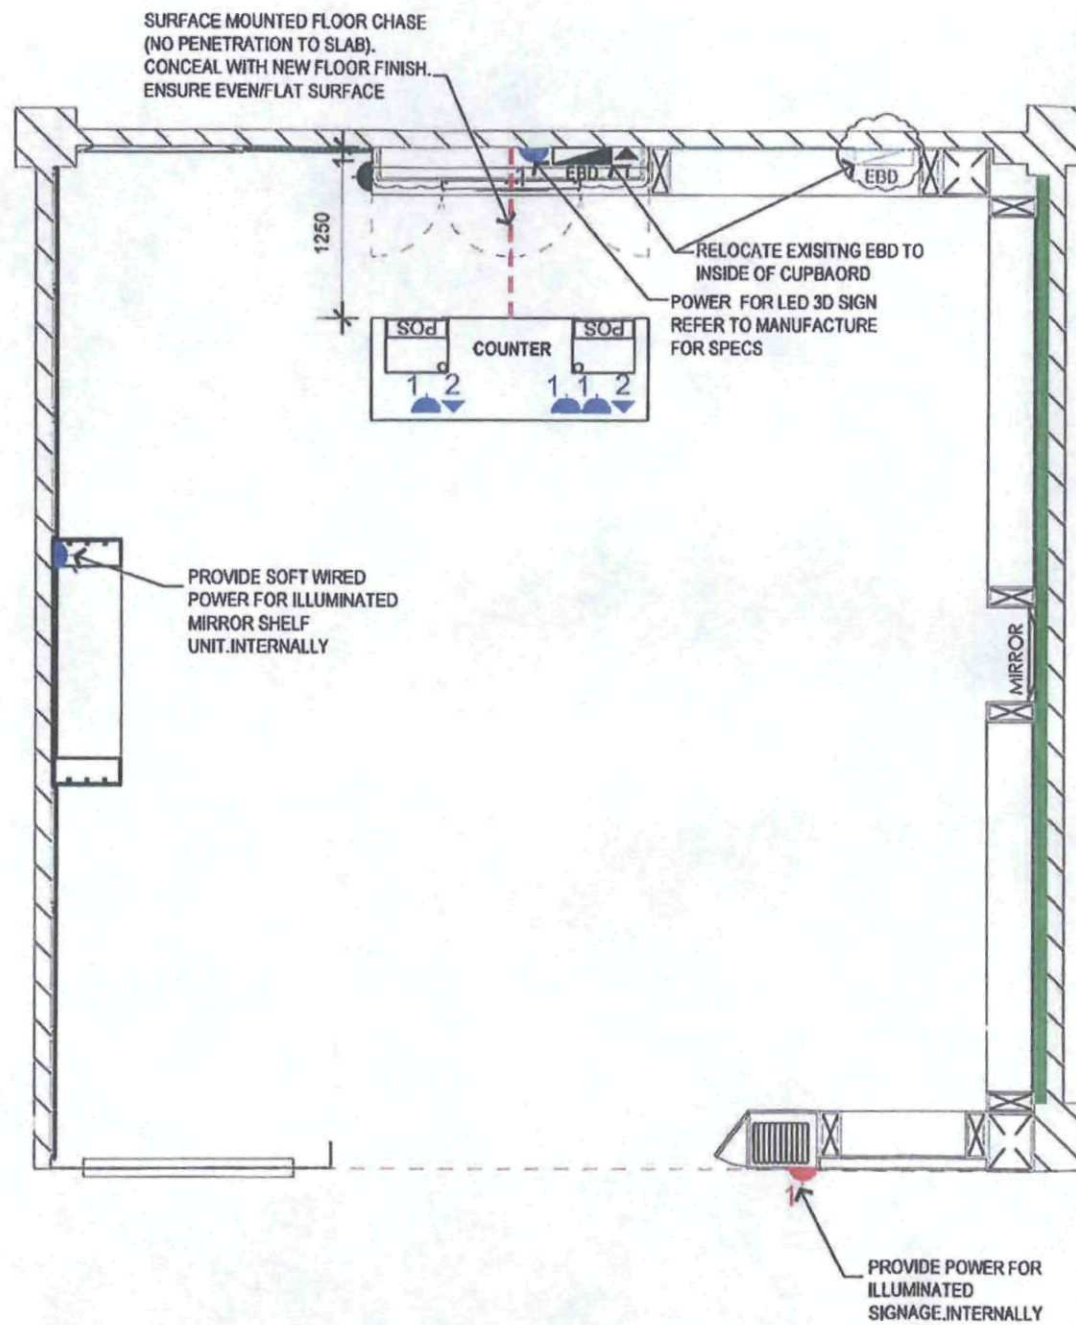

ELECTRICAL LEGEND	
CODE	ITEM
1	NEW DOUBLE GPO POWER OUTLET @ STANDARD HEIGHT. (NUMBER ABOVE OUTLETS DENOTES QUANTITY)
1	NEW DOUBLE GPO POWER OUTLET MOUNTED @ UNDER BENCH HEIGHT. (NUMBER ABOVE OUTLETS DENOTES QUANTITY)
1	NEW DOUBLE GPO POWER OUTLET SOFT WIRING (NUMBER ABOVE OUTLETS DENOTES QUANTITY)
1	NEW DOUBLE GPO POWER OUTLET @ CEILING (H) (NUMBER ABOVE OUTLETS DENOTES QUANTITY)
2	NEW DATA OUTLET MOUNTED @ STANDARD HEIGHT. (NUMBER ABOVE OUTLETS DENOTES QUANTITY)
2	NEW DATA OUTLET @ UNDER BENCH HEIGHT, CLIENT TO CONFIRM LOCATION. (NUMBER ABOVE OUTLETS DENOTES QUANTITY)
2	NEW DATA OUTLET SOFT WIRED. (NUMBER ABOVE OUTLETS DENOTES QUANTITY)


NOTE - ANY EXPOSED GPO TO HAVE BLACK COVER PLATE & SWITCHES
GPO ON WALL TO BE FIXED AT 300mm HIGH UNLESS NOTED OTHERWISE.

Handwritten notes in red ink:
 ensure operation of existing outlets of any additional services required that will be provided for this shop.
 all services must be provided to the shop front by the shop owner.
 all shop front services must be provided by the shop owner.
 all shop front services must be provided by the shop owner.


WARRINGAH COUNCIL
 THIS PLAN TO BE READ
 IN CONJUNCTION WITH
 Construction
 Certificate No CC2010/0094

APPROVED DESIGN CONCEPT
 Date: 22/2/10 Issue: P 4/20
 Centre: Warringah
 Shop name: Colette
 Retail Design
 Designer: [Signature]
 Consent of this concept is granted by the Council for the shop front, shop layout and shop signage on these drawings. Any details noted must be approved and requested subject to Council approval.
 SUBJECT TO CONDITIONS

Unit 10, 54 Tennyson Rd, Gladesville NSW 2111, Australia EMAIL: s_mitsis@bigpond.com IN2DESIGN (AUSTRALIA) ABN 58 950 188 181 DESIGN DRAFTING PROPERTY STYLING RETAIL COMMERCIAL RESIDENTIAL IN2DESIGN	Figure dimensions shall take preference over scaling. Contractor shall verify all dimensions on site before preparing shop drawings or starting work. Any variations to Specification and Drawings must be authorised by IN2DESIGN (AUSTRALIA). These Designs, Drawings and Specifications shall remain the copyright of IN2DESIGN (AUSTRALIA), and must not be used, reproduced or copied wholly or in part without the written permission of the owners. NB. THIS DRAWING IS DESIGN INTENT ONLY. It is the responsibility of the shop/fitler to ensure that this work is carried out compliant to BCA + other relevant Authorities/Codes	CLIENT COLETTE ACCESSORIES					
		PROJECT SHOP 83 WARRINGAH MALL	A 16/02 FIRST ISSUE SM				
		DRAWING ELECTRICAL/DATA PLAN	SCALE: 1:50 DATE: 16/02/10 DRAWN BY: SM CHECKED: [] DATE: [] REV. NO: 04				

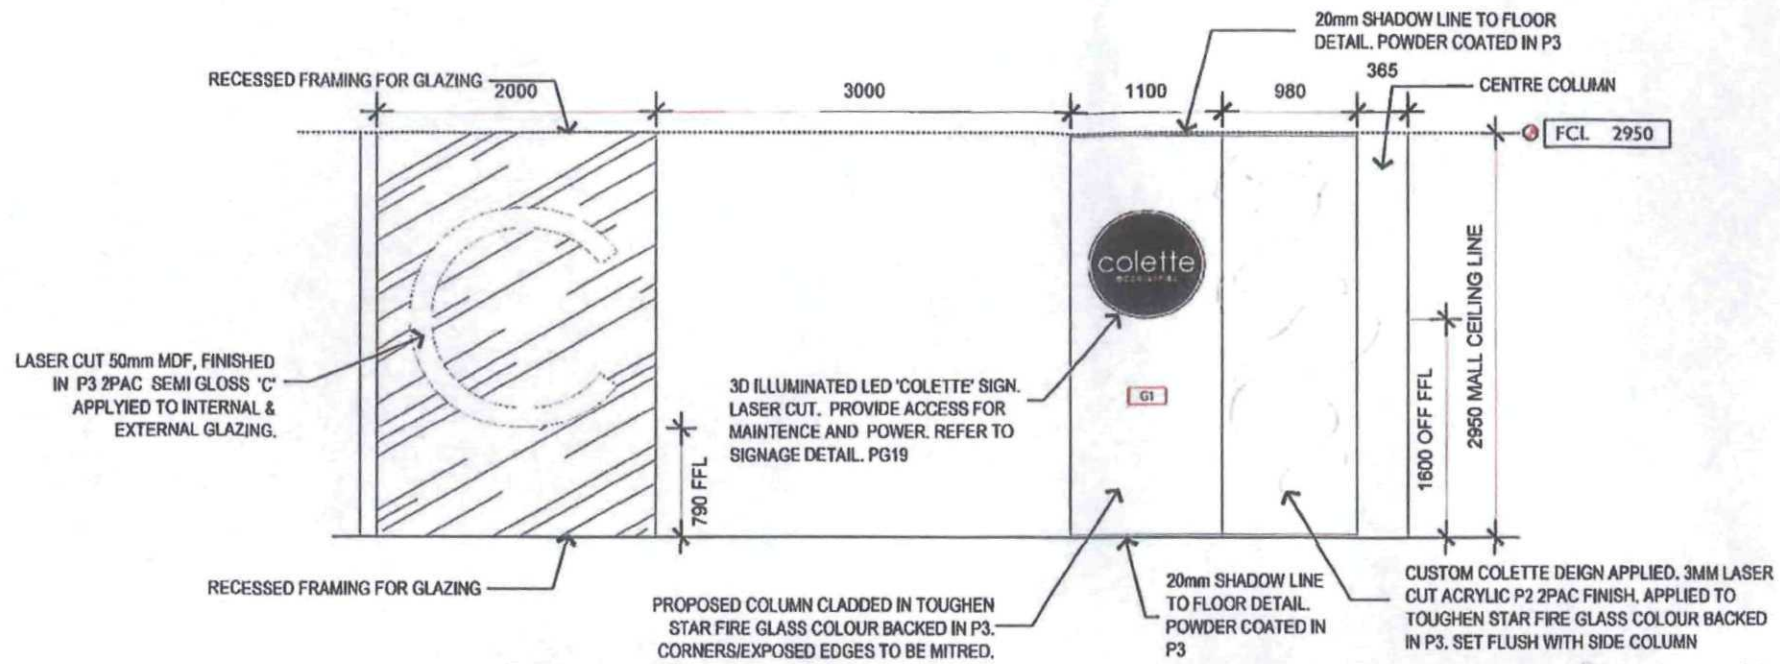

A ELEVATION A
1:50

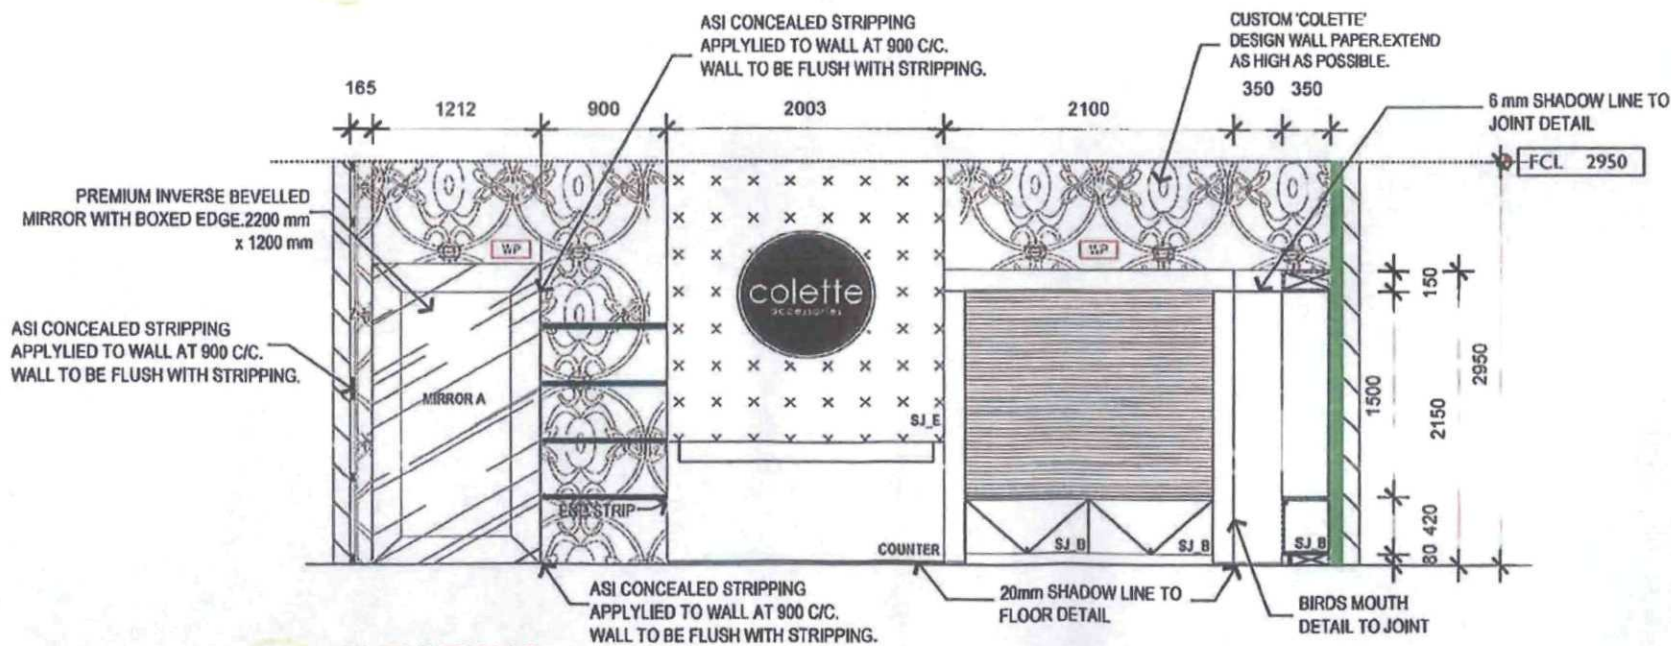

B ELEVATION B
1:50


NOTE ON CONCEALED STRIPPING WALL APPLICATION:
 - WALL TO BE SPLIT BATTEN EVERY 600C/C ON THE HORIZONTAL.
 - APPLY STRIPPING TO BATTENS EVERY 900C/C ON THE VERTICAL.
 SET GYPBROCK FLUSH WITH STRIPPING AND PREP FOR WALL PAPER APPLICATION

Require a detail of the brickwork?


WARRINGAH COUNCIL
 THIS PLAN TO BE READ IN CONJUNCTION WITH
 Construction Certificate No. **CC2010/0094**

APPROVED DESIGN CONCEPT
 Date: 22/2/10
 Cont: Warringham
 Sign: Colette
 Subject: WARRINGAH MALL

Unit 10, 54 Tennyson Rd, Gladesville NSW 2111, Australia EMAIL: s_misis@bigpond.com IN2DESIGN (AUSTRALIA) ABN 58 959 188 181 DESIGN DRAFTING PROPERTY STYLING RETAIL COMMERCIAL RESIDENTIAL	CLIENT COLETTE ACCESSORIES													
	PROJECT SHOP 83 WARRINGAH MALL													
	DRAWING ELEVATION A & B													
	Figured dimensions shall take preference over scaling. Contractor shall verify all dimensions on site before preparing shop drawings or starting work. Any variations to Specification and Drawings must be authorised by IN2DESIGN (AUSTRALIA). These Designs, Drawings and Specifications shall remain the copyright of IN2DESIGN (AUSTRALIA), and must not be used, reproduced or copied wholly or in part without the written permission of the owners. NB. THIS DRAWING IS DESIGN INTENT ONLY. It is the responsibility of the shopfitter to ensure that this work is carried out compliant to BCA & other relevant Authorities' Codes													
	SCALE: 1:50 CHECKED BY: SM	DATE: 16/02/10 CHECKED:	REV. NO. 05	<table border="1"> <tr> <td>REV</td> <td>DATE</td> <td>AMENDMENTS</td> <td>BY</td> <td>APP</td> </tr> <tr> <td>A</td> <td>16/02</td> <td>FIRST ISSUE</td> <td>SM</td> <td></td> </tr> </table>	REV	DATE	AMENDMENTS	BY	APP	A	16/02	FIRST ISSUE	SM	
REV	DATE	AMENDMENTS	BY	APP										
A	16/02	FIRST ISSUE	SM											

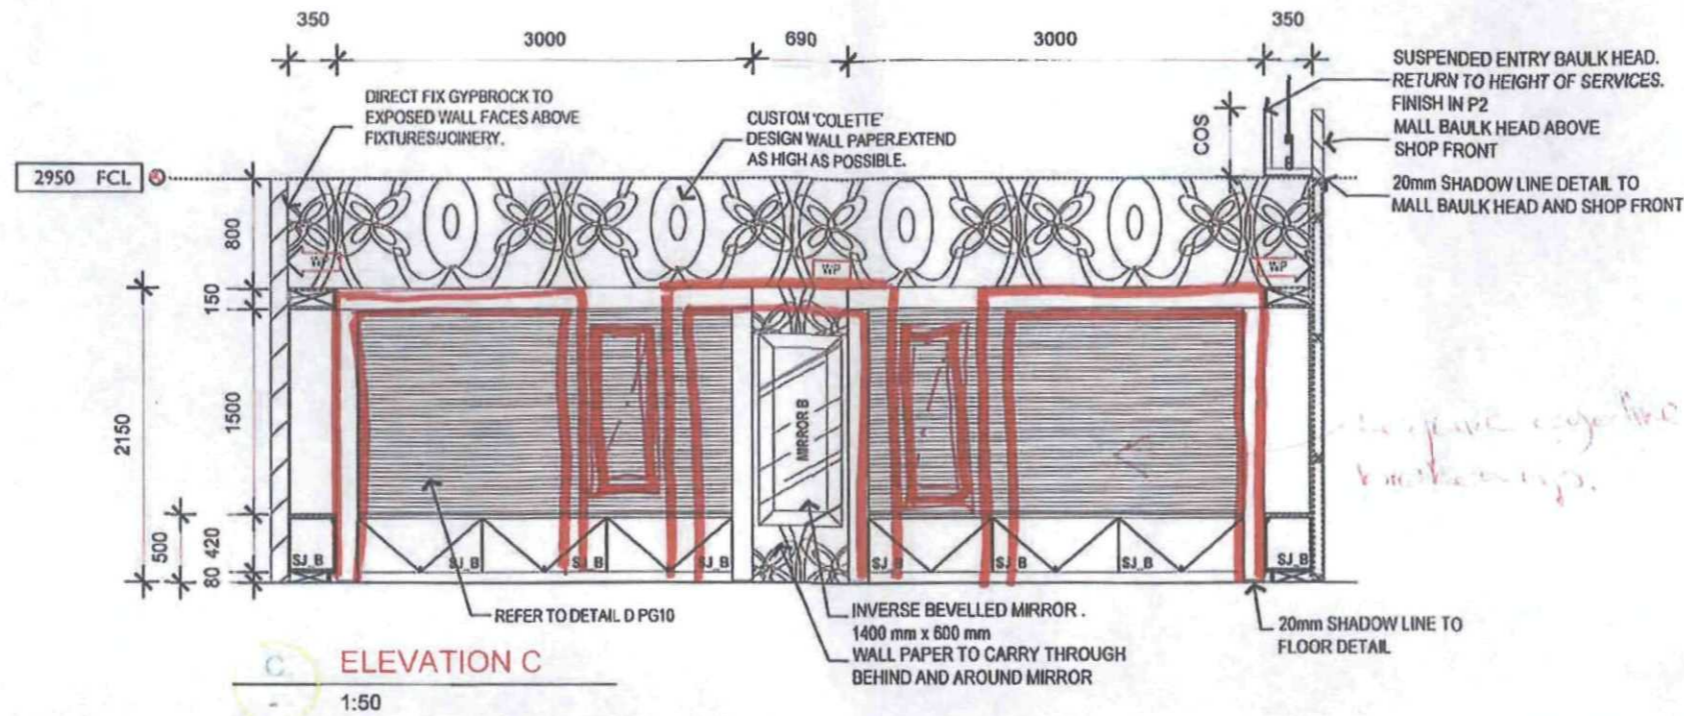

require eye line will be broken up.

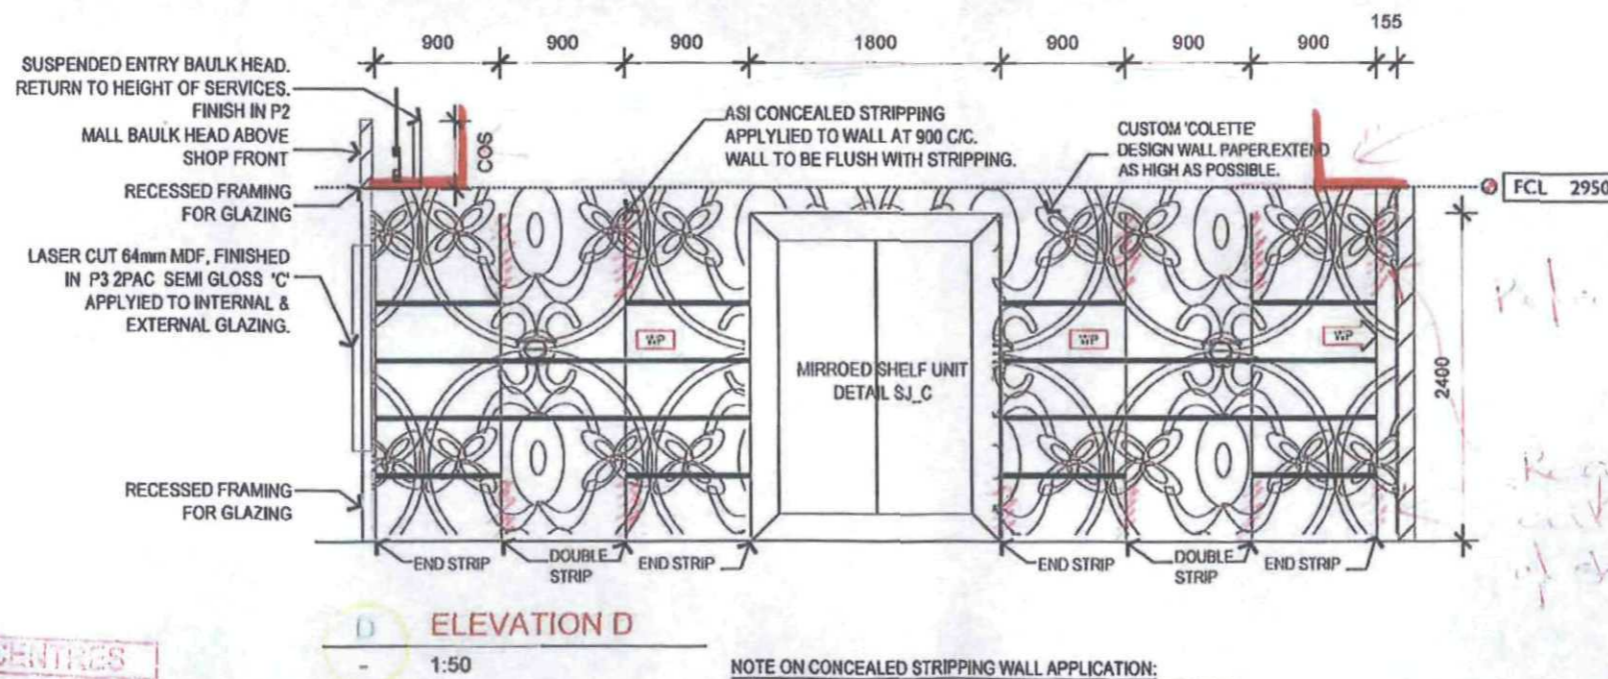

Refer to main layout plan


Require concealed stripping to be cut off top and bottom edge of shelving unit shown.

NOTE ON CONCEALED STRIPPING WALL APPLICATION:
- WALL TO BE SPLIT BATTEN EVERY 600C/C ON THE HORIZONTAL.
- APPLY STRIPPING TO BATTENS EVERY 900C/C ON THE VERTICAL.
SET GYPBROCK FLUSH WITH STRIPPING AND PREP FOR WALL PAPER APPLICATION

AMM CAPITAL SHOPPING CENTRES
APPROVED DESIGN CONCEPT
Date: 22/2/10 Issue: 1 P2/20
Centre: Warringah
Shop name: Colette
Item: Design
Comments: All the work is needed for the design for the shop front. See also drawings on these drawings for details of the shop front.

WARRINGAH COUNCIL
THIS PLAN TO BE READ IN CONJUNCTION WITH
Construction
Certificate No: EC2010/0094

Unit 10, 64 Tennyson Rd, Gladesville NSW 2111, Australia EMAIL: a_mitsis@bigpond.com IN2DESIGN (AUSTRALIA) ABN 58 959 188 181 DESIGN DRAFTING PROPERTY STYLING RETAIL COMMERCIAL RESIDENTIAL 	Figured dimensions shall take preference over scaling. Contractor shall verify all dimensions on site before preparing shop drawings or starting work. Any variations to Specification and Drawings must be authorized by IN2DESIGN (AUSTRALIA). These Designs, Drawings and Specifications shall remain the copyright of IN2DESIGN (AUSTRALIA), and must not be used, reproduced or copied wholly or in part without the written permission of the owners. NB. THIS DRAWING IS DESIGN INTENT ONLY. It is the responsibility of the shopfitter to ensure that this work is carried out compliant to BCA + other relevant Authorities/Codes.	CLIENT COLETTE ACCESSORIES			
		PROJECT SHOP 83 WARRINGAH MALL	A 16/02 FIRST ISSUE REV DATE AMENDMENTS BY APP	SM	
		DRAWING ELEVATION C & D	SCALE 1:50 DRAWN BY SM DES NO.	DATE 16/02/10 CHECKED REV NO.	06

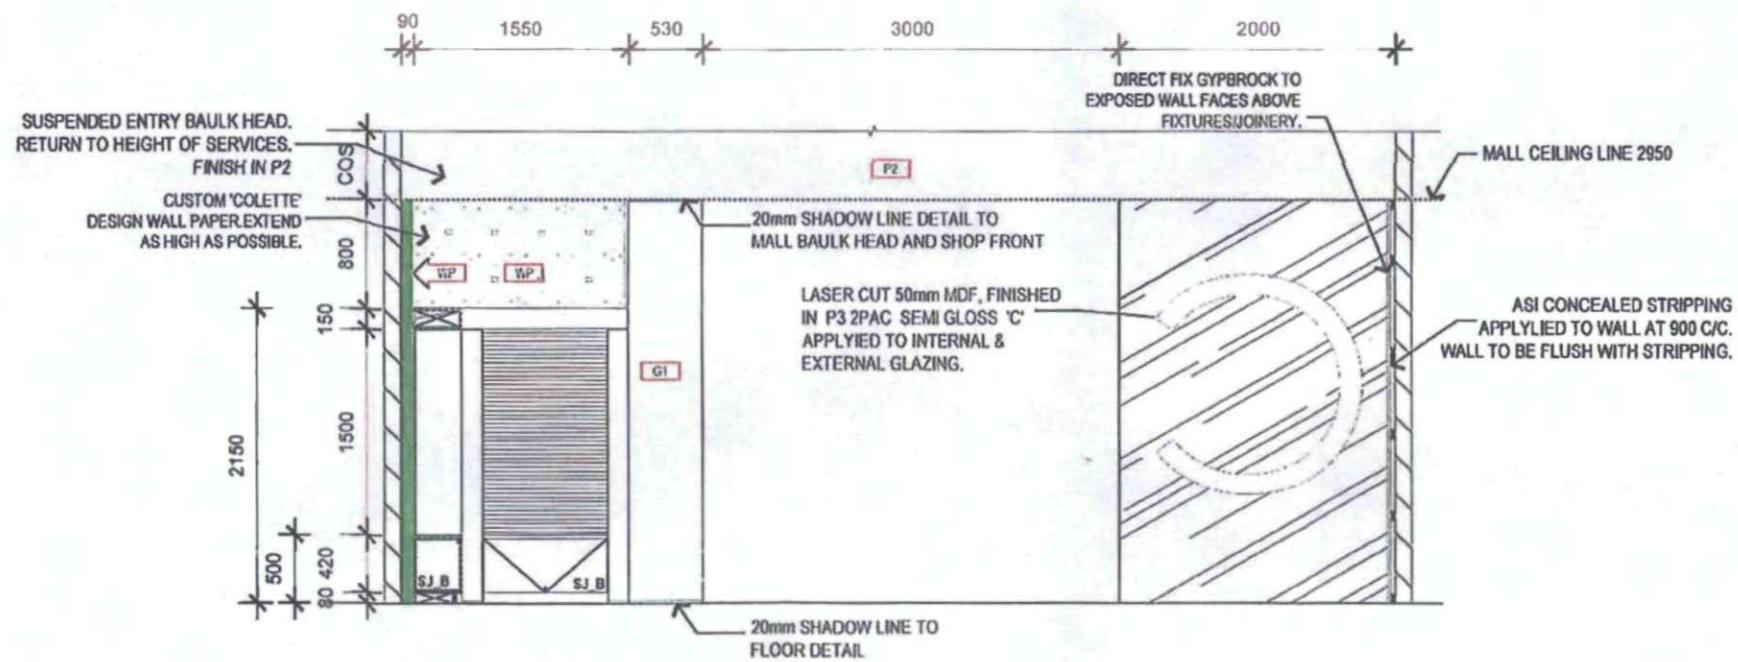

ELEVATION E
1:50


WARRINGAH COUNCIL
THIS PLAN TO BE READ
IN CONJUNCTION WITH
Construction
Contract No. C20010094

WARRINGAH CENTRES
APPROVED
DESIGN CONCEPT
2/2/10
Warrimar
Colette
is granted to the issuer for the
purpose shown on these drawings
and if requested submitted


Unit 10, 54 Tennyson Rd, Gladstone NSW 2111, Australia EMAIL: s_misis@bigpond.com IN2DESIGN (AUSTRALIA) ABN 58 959 188 181 DESIGN DRAFTING PROPERTY STYLING RETAIL COMMERCIAL RESIDENTIAL IN2DESIGN AUSTRALIA	Figured dimensions shall take precedence over scaling. Contractor shall verify all dimensions on site before preparing shop drawings or starting work. Any variations to Specification and Drawings must be authorised by IN2DESIGN (AUSTRALIA). These Designs, Drawings and Specifications shall remain the copyright of IN2DESIGN (AUSTRALIA), and must not be used, reproduced or copied wholly or in part without the written permission of the owners. NB: THIS DRAWING IS DESIGN INTENT ONLY. It is the responsibility of the shopfitter to ensure that this work is carried out compliant to BCA + other relevant Authorities/Codes		CLIENT COLETTE ACCESSORIES			
	PROJECT SHOP 83 WARRINGAH MALL	A 16/02 FIRST ISSUE REV DATE AMENDMENTS BY APP	SM			
	DRAWING ELEVATION E	SCALE 1:50 DRAWN BY SM CHECKED DATE 16/02/10 REV. NO. 07				

COUNTER TO HAVE CONCEALED FIXED HINGED FLAP RECESSED INTO SIDE OF COUNTER @ 850 (H) FOR WHEEL CHAIR ACCESS IN ACCORDANCE WITH AS 1428.2. ALL EDGES FINISHED IN V1. INSTALL PUSH BUTTON RELEASE TO FLAP AND SPRING LOADED AKA 'BLUM'


COUNTER TO HAVE CONCEALED FIXED HINGED FLAP, RECESSED INTO COUNTER @ 850 (H) FOR WHEEL CHAIR ACCESS IN ACCORDANCE WITH AS 1428.2. ALL EDGES FINISHED IN P1. INSTALL PUSH BUTTON RELEASE TO FLAP AND SPRING LOADED AKA 'BLUM'

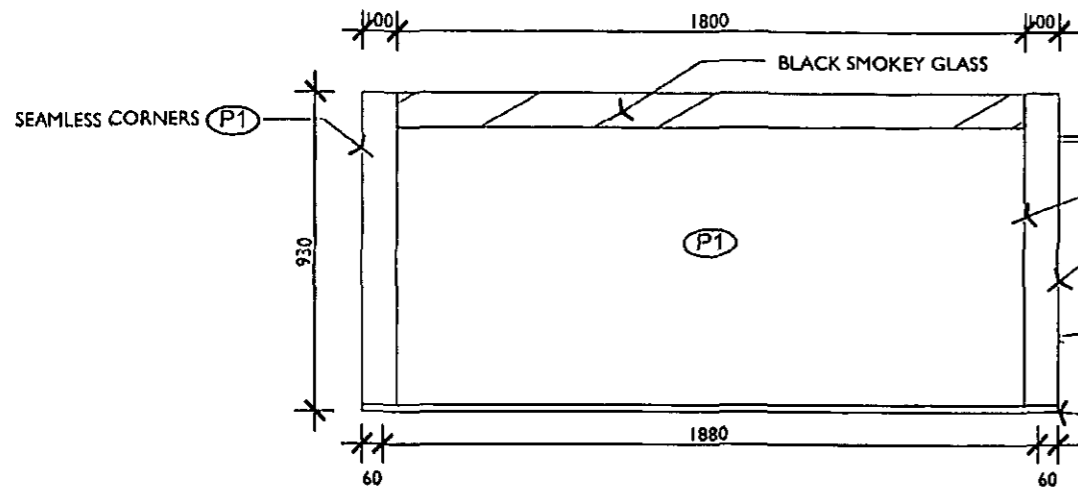


02 ELEVATION C
1:20

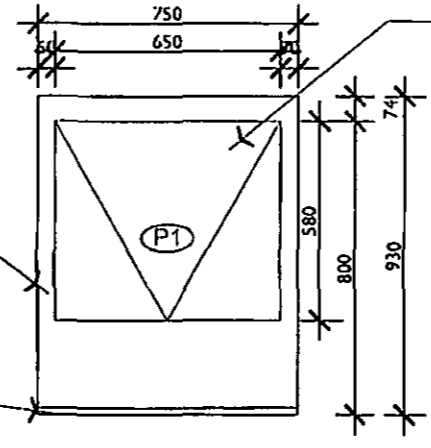

03 ELEVATION B
1:20

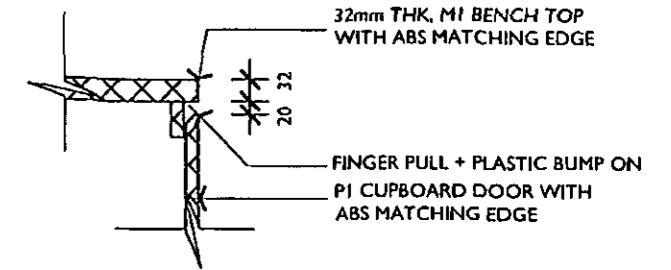


A DETAIL
1:10

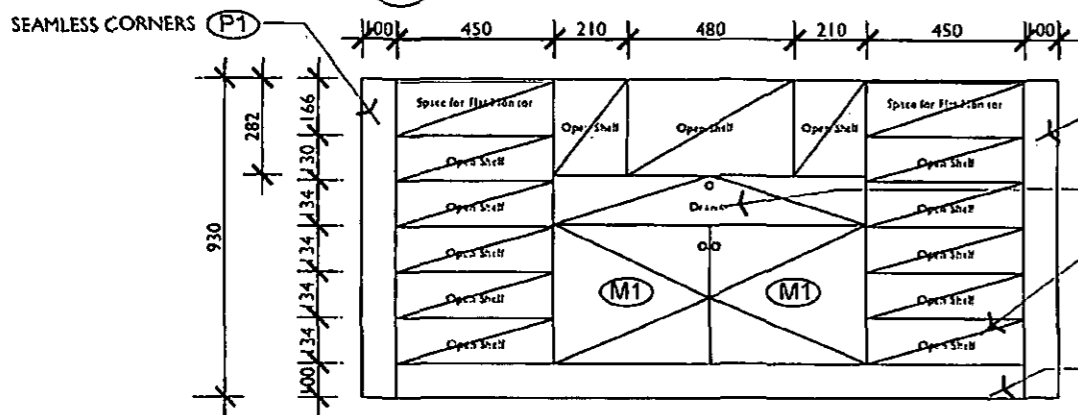

03 ELEVATION A
1:20


(P1) SEAMLESS CORNERS
MI to ALL C/DOORS and DRAWERS with standard black internals. Figure Pull Handle. SEE DETAIL A
MI to all internals & back of counter
180mm Kicker at back of counter only, finished in M1

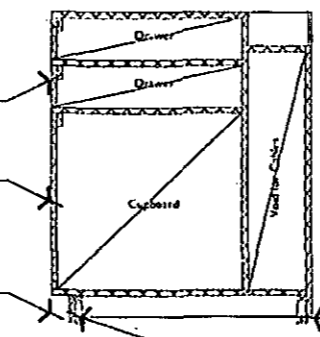

03 SECTION E
1:20

20mm X 20mm BLACK ALUMINIUM SHADOW ANGLE TO BOTTOM OF COUNTER
35 x 35 x 2MM THICK TUBE ERW SEMI BRIGHT MILD STEEL TUBE LEGS WITH ADJUSTABLE PLASTIC GLIDES

APPROVED CONCEPT
22/2/10
Warrimoo
C. Collette
I am guided to the issues for the design and submit drawings on these drawings. I am not responsible for any errors and if requested submitted
CONTRACTOR'S SIGNATURE

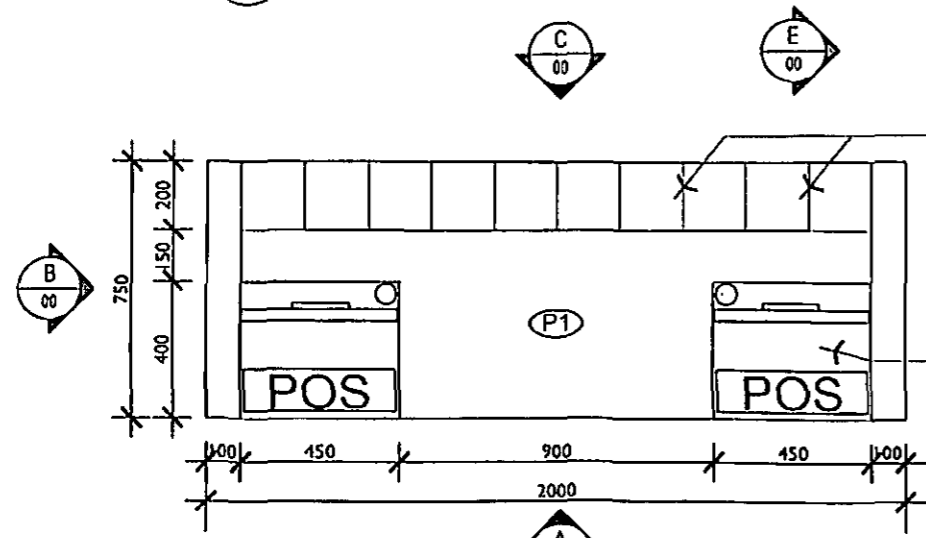

01 PLAN
1:20

4mm (W) GROVES EVERY 180mm C/C, ON INNER SIDES OF RECESS. MAKE ALLOWANCE FOR 3mm CLEAR PERSPEX DIVIDER, QTY 9

RECESSED GLASS TOPS TO MONITOR SECTIONS


LEGEND

- FINISHES
P1 - 2PAC BLACK + 2 Coats of Non Yellowing Polyurethane - Finish to match ASI powder coat
M1 - Black - Flint Finish - Laminex
- NOTE:
-ALL CORNERS TO BE MITERED
-FINGER PULL HANDLE TO ALL DRAWERS & C/DOORS. SEE DETAIL A
-ALL CUPBOARDS/OPEN SHELVES TO THE BACK OF COUNTER TO BE FINISHED IN M1. INTERNAL & EXTERNAL
-PROVIDE SUFFICIENT SPACE AT BACK OF COUNTER FOR CABLES

TOTAL QTY TBC


WARRINGAH COUNCIL
THIS PLAN TO BE READ IN CONJUNCTION WITH
Construction Certificate No. CCL2010/0094

Unit 10, 54 Tennyson Rd, Gladesville NSW 2111, Australia EMAIL: s_mists@bigpond.com INZDESIGN (AUSTRALIA) ABN 58 959 188 181 DESIGN DRAFTING PROPERTY STYLING RETAIL COMMERCIAL RESIDENTIAL INZDESIGN (AUSTRALIA)	Figured dimensions shall take preference over scaling. Contractor shall verify all dimensions on site before preparing shop drawings or starting work. Any variations to Specification and Drawings must be authorised by INZDESIGN (AUSTRALIA). These Design, Drawings and Specifications shall remain the copyright of INZDESIGN (AUSTRALIA), and must not be used, reproduced or copied in whole or in part without the written permission of the owner. NB. THIS DRAWING IS DESIGN INTENT ONLY. It is the responsibility of the shopfitter to ensure that this work is carried out compliant to BCA - other relevant Authority Codes	CLIENT	COLETTE ACCESSORIES						
		PROJECT	SHOP 83 WARRINGAH MALL	REV	A	DATE	16/02/10		
		DRAWING	COUNTER	SCALE	1:50	DATE	16/02/10	BY	SM
				CREATED	SM	REV. NO		08	

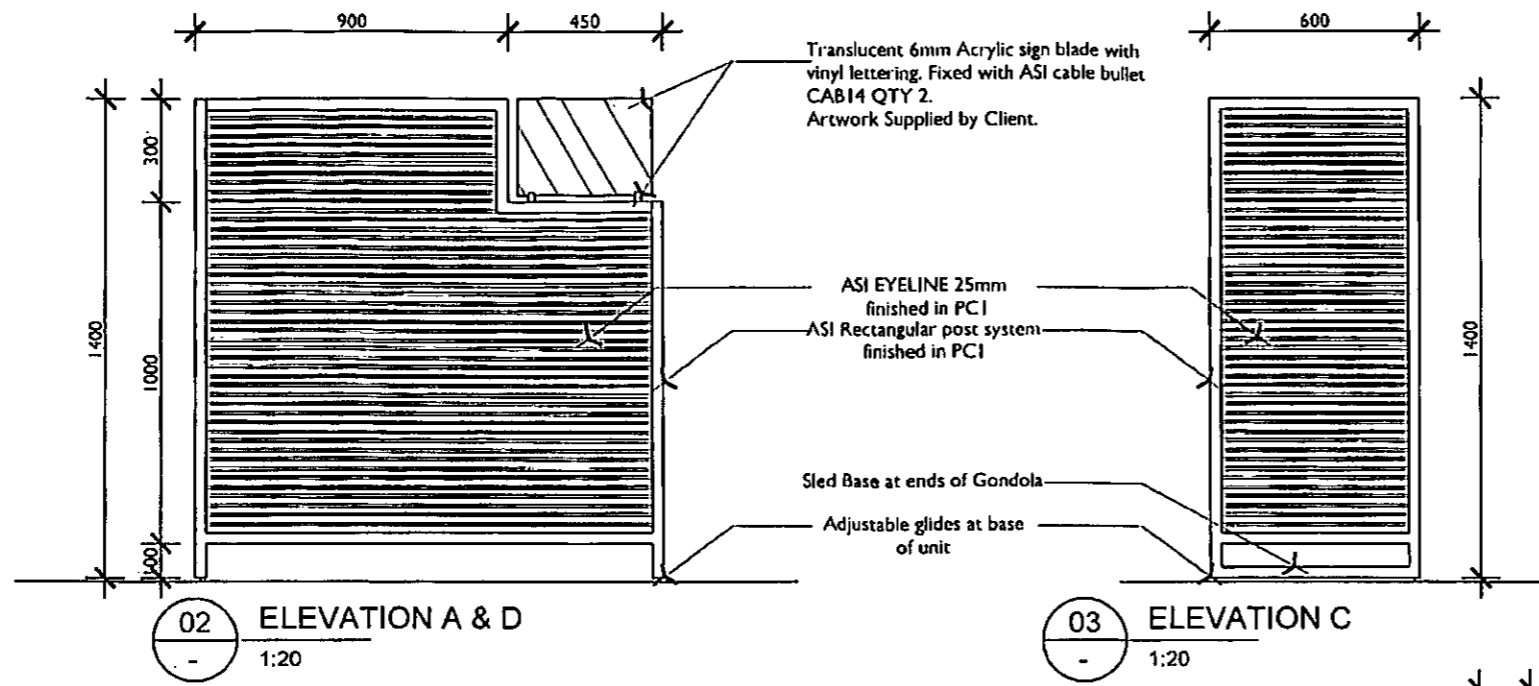


02 ELEVATION A & D
1:20


03 ELEVATION C
1:20

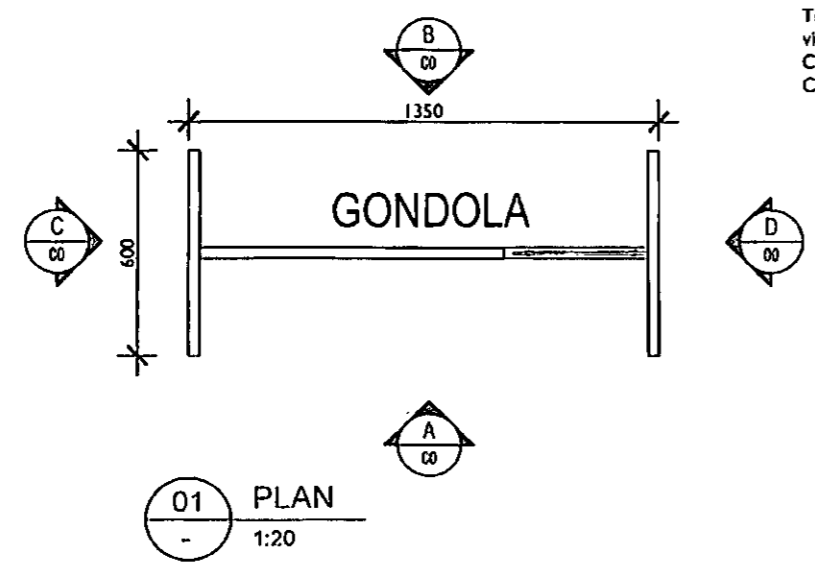

01 PLAN
1:20

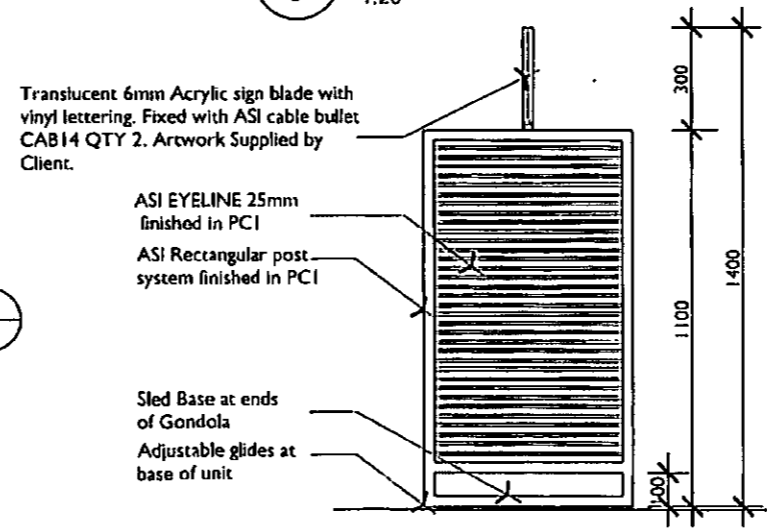

03 ELEVATION D
1:20

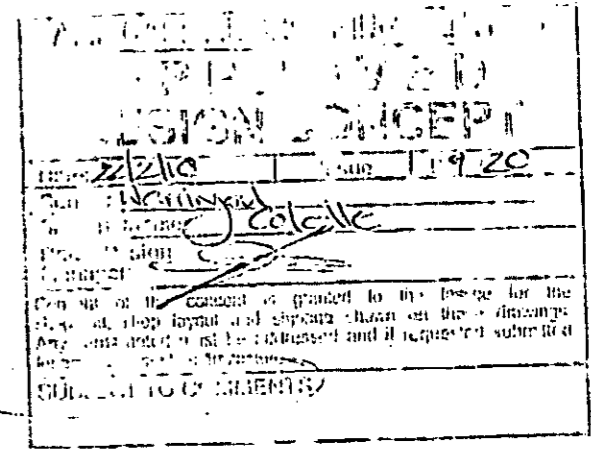

LEGEND

FINISHES


PC1 - Matt Black Powder Coat (As per ASI sample)

FIXTURES - SUPPLIED BY ASI



ASI Eyeline 25mm
ASI rectangular post system (ASI to confirm size of profile), finished in PC1

NOTE: ALL CORNERS TO BE MITERED

TOTAL QTY TBC

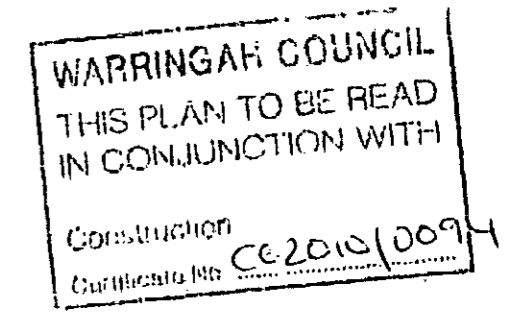

Unit 10, 54 Tennyson Rd, Gladesville NSW 2111, Australia EMAIL: a_mitsis@bigpond.com IN2DESIGN (AUSTRALIA) ABN 56 959 188 181 DESIGN DRAFTING PROPERTY STYLING RETAIL COMMERCIAL RESIDENTIAL 	Figured dimensions shall take preference over scaling. Contractor shall verify all dimensions on site before preparing shop drawings or starting work. Any variations to Specification and Drawings must be authorised by IN2DESIGN (AUSTRALIA). These Designs, Drawings and Specifications shall remain the copyright of IN2DESIGN (AUSTRALIA), and must not be used, reproduced or copied wholly or in part without the written permission of the owners. THIS DRAWING IS DESIGNER'S ONLY. It is the responsibility of the shopfitter to ensure that this work is carried out compliant to BCA + other relevant Authorities/Codes.	CLIENT COLETTE ACCESSORIES					
		PROJECT SHOP 83 WARRINGAH MALL	A 16/02 FIRST ISSUE	SM			
		DRAWING GONDOLA	SCALE 1:50	DATE 16/02/10	CHECKED 	REV. NO 	
							09

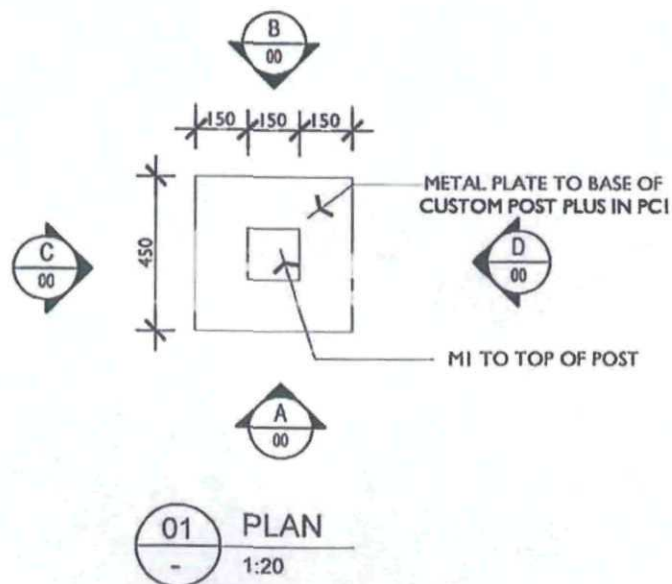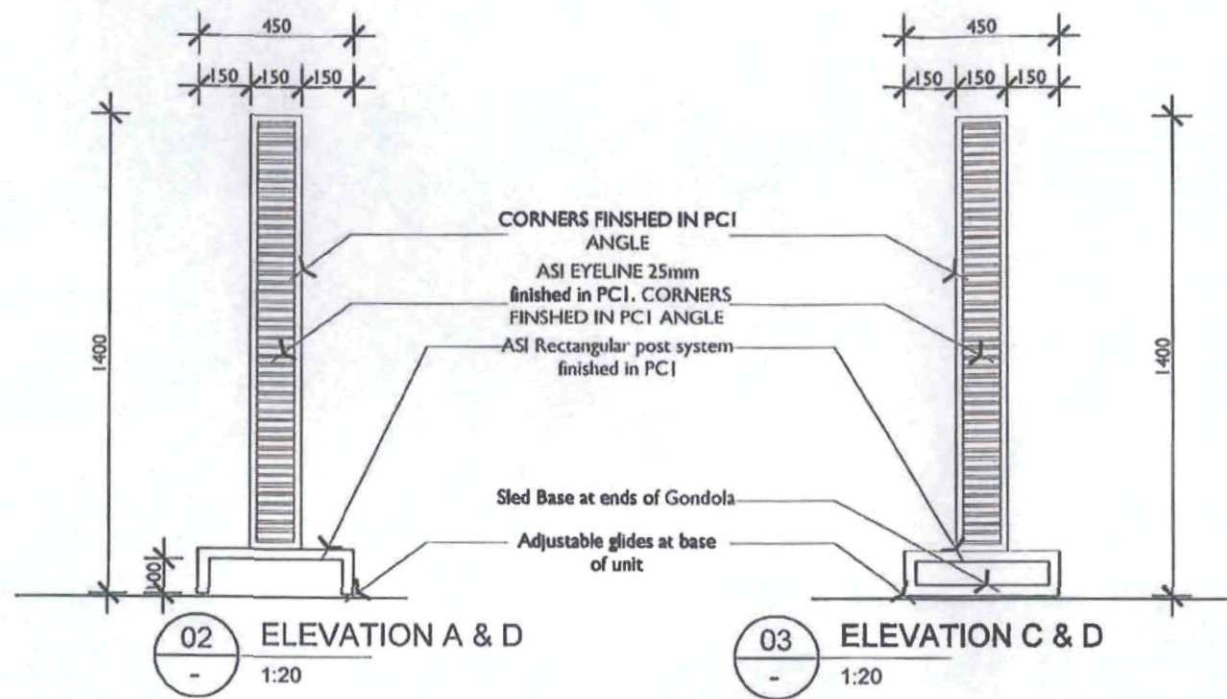

LEGEND

FINISHES

- PC1 - Matt Black Powder Coat (As per ASI sample)
- M1 - Black - Flint Finish - Laminex

FIXTURES - SUPPLIED BY ASI


- ASI Eyeline 25mm
- ASI rectangular post system (ASI to confirm size of profile), finished in PC1

NOTE: ALL CORNERS TO BE MITERED

TOTAL QTY TBC




Unit 10, 54 Tennyson Rd, Gladstone NSW 2111, Australia EMAIL: a_mitaliv@bigpond.com IN2DESIGN (AUSTRALIA) ABN 58 959 189 181 DESIGN DRAFTING PROPERTY STYLING RETAIL COMMERCIAL RESIDENTIAL 	Figured dimensions shall take precedence over scaling. Contractor shall verify all dimensions on site before preparing shop drawings or starting work. Any variations to Specification and Drawings must be authorized by IN2DESIGN (AUSTRALIA). These Designs, Drawings and Specifications shall remain the copyright of IN2DESIGN (AUSTRALIA), and must not be used, reproduced or copied wholly or in part without the written permission of the owners. NB. THIS DRAWING IS DESIGN INTENT ONLY. It is the responsibility of the shopfitter to ensure that this work is carried out compliant to BCA + other relevant Authorities/Codes.		CLIENT COLETTE ACCESSORIES			
	PROJECT SHOP 83 WARRINGAH MALL	A 16/02 FIRST ISSUE SM				
	DRAWING POST PLUS	SCALE 1:50 DRAWN BY SM CHECKED DATE 16/02/10 DESIGNED 10	DESIGN REVIEW REV DATE AMENDMENTS BY APP			

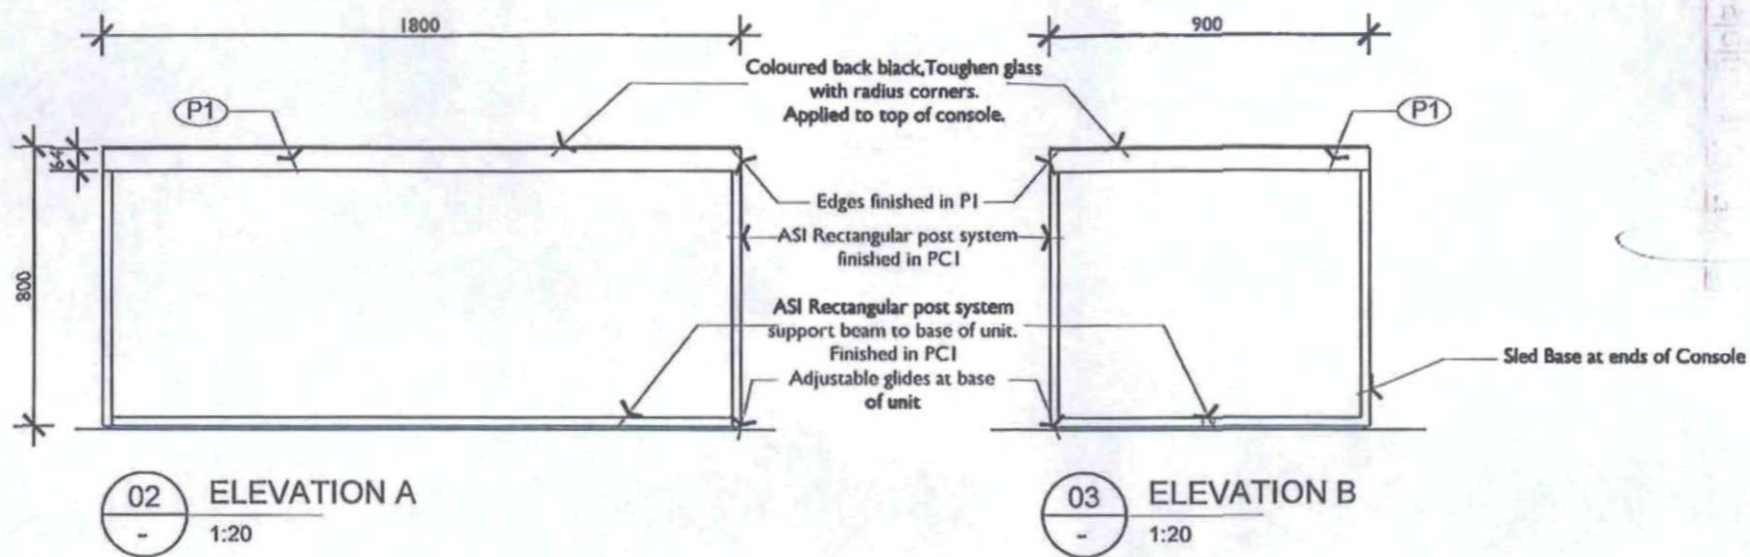

02 ELEVATION A
- 1:20


03 ELEVATION B
- 1:20

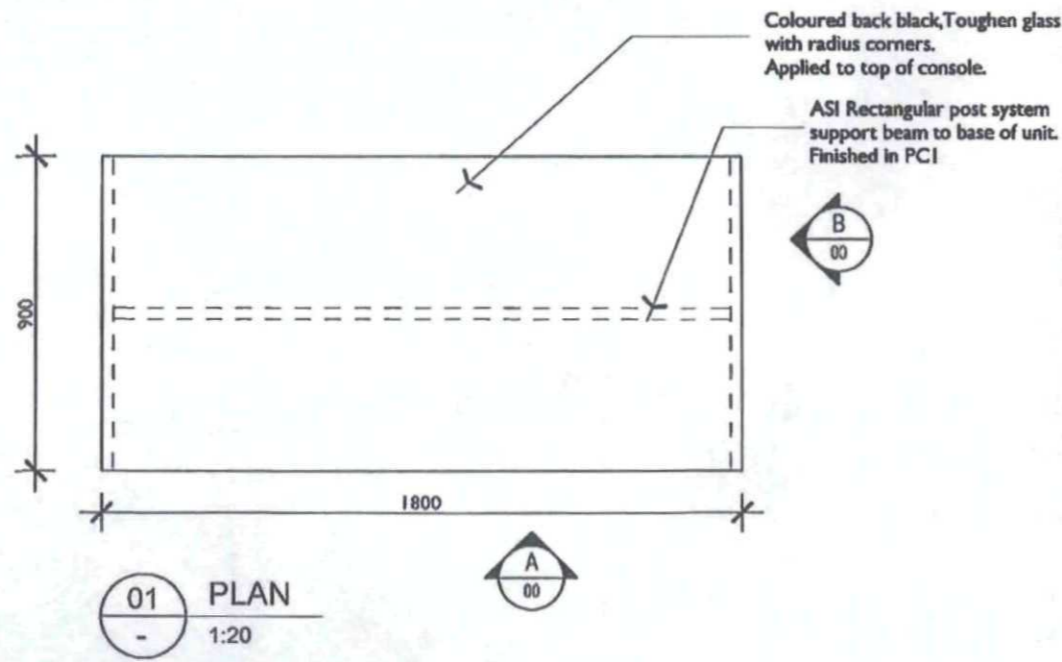



01 PLAN
- 1:20

LEGEND

- FINISHES**
 P1 - 2PAC BLACK + 2 Coats of Non Yellowing Polurethane - Finish to match ASI powder coat
 PC1 - Matt Black Powder Coat (As per ASI sample)
- FIXTURES - SUPPLIED BY ASI**
 ASI 25mm rectangular post system, Finished in PCI
- NOTE: ALL CORNERS TO BE MITERED**
- TOTAL QTY TBC**

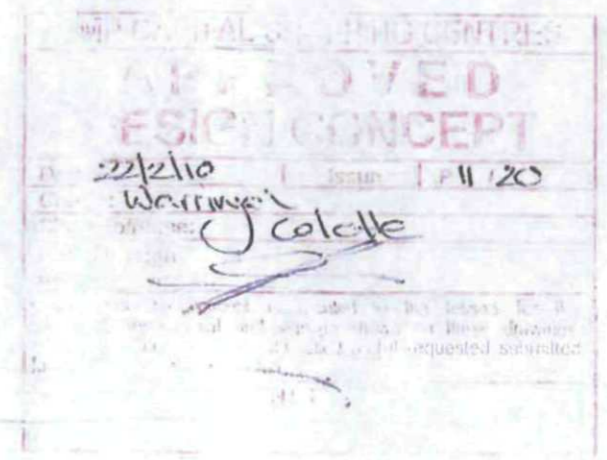

Unit 10, 54 Tennyson Rd, Gladesville NSW 2111, Australia EMAIL: s_mitsis@bigpond.com IN2DESIGN (AUSTRALIA) ABN 58 959 188 181 DESIGN DRAFTING PROPERTY STYLING RETAIL COMMERCIAL RESIDENTIAL	Figured dimensions shall take preference over scaling. Contractor shall verify all dimensions on site before preparing shop drawings or starting work. Any variations to Specification and Drawings must be authorised by IN2DESIGN (AUSTRALIA). These Designs, Drawings and Specifications shall remain the copyright of IN2DESIGN (AUSTRALIA), and must not be used, reproduced or copied wholly or in part without the written permission of the authors. NB, THIS DRAWING IS DESIGN INTENT ONLY. It is the responsibility of the shopfitter to ensure that it's work is carried out compliant to BCA + other relevant Authorities/Codes		CLIENT COLETTE ACCESSORIES				
	PROJECT SHOP 83 WARRINGAH MALL	A 16/02 FIRST ISSUE SM					
	DRAWING DISPLAY TABLE	SCALE 1:50 DRAWN BY SM CHECKED DATE 16/02/10 DWG NO. 11	DESIGN REVIEW DATE 16/02/10 CHECKED REV. NO.				

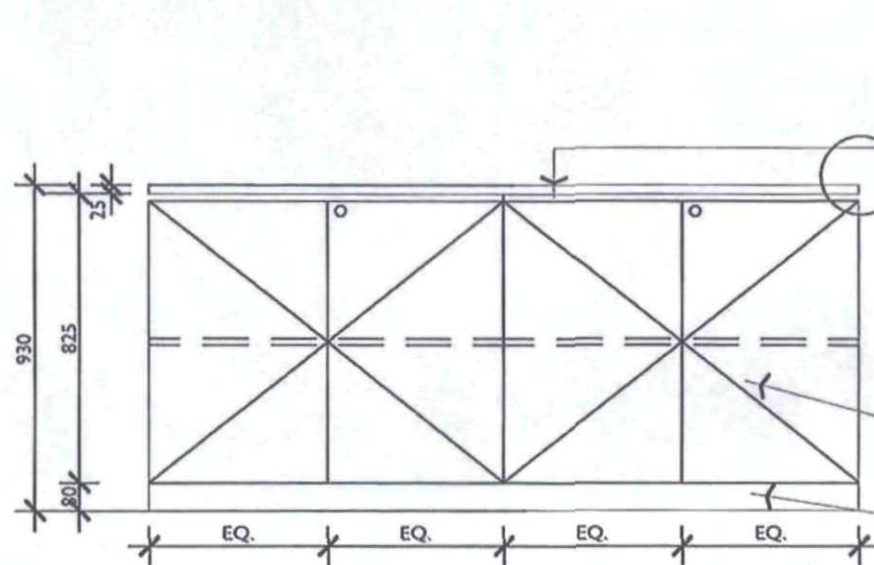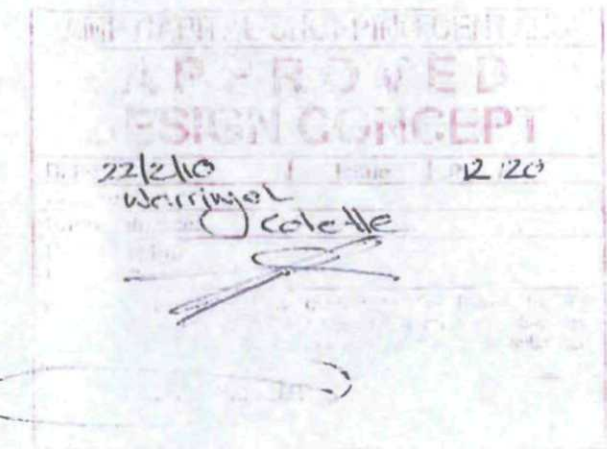


02 ELEVATION
1:20

PI 2PAC
930mm(h)x350mm(d)
WALL MOUNTED
CUPBOARD WITH
TOUGHEN GLASS TOP PI
EDGE TO MATCH.


CUPBOARDS FINISHED
IN PI 2PAC WITH
SHADOW LINE FINGER
PULLS. LOCKABLE WITH
BI LOCKS.
NOTE: M1 MELAMINE TO
ALL INTERNALS

80mm(H) M1
SKIRTING WITH
ADJUSTABLE GLIDES
AT BASE OF UNIT


PI TO C/DOORS WITH STANDARD
BLACK INTERNALS. FINGER PULL
HANDLE. SEE DETAIL A.

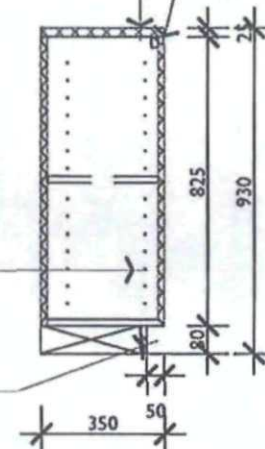

03 SECTION
1:20

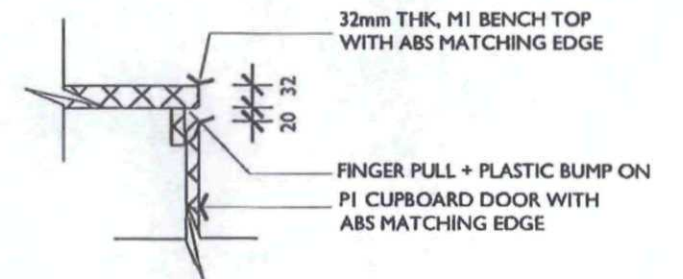

A DETAIL
1:10

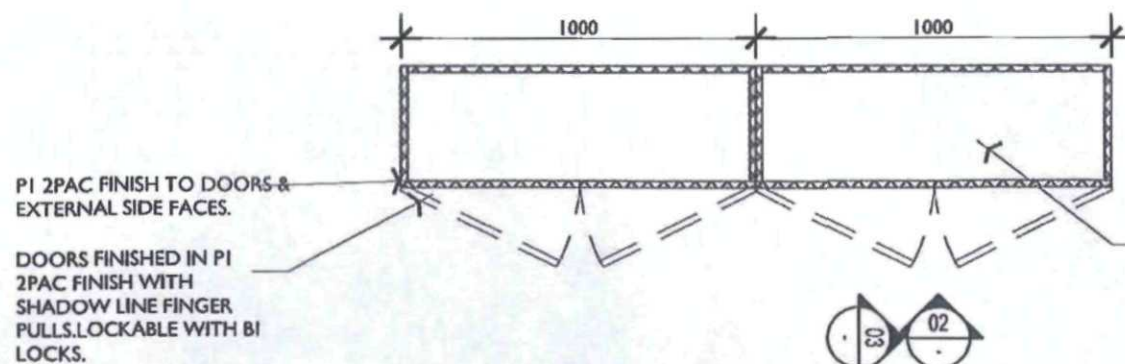

01 PLAN
1:20

PI 2PAC FINISH TO DOORS &
EXTERNAL SIDE FACES.

DOORS FINISHED IN PI
2PAC FINISH WITH
SHADOW LINE FINGER
PULLS. LOCKABLE WITH BI
LOCKS.

18mm THK MDF BOARD ADJUSTABLE
SHELVES WITH WHITE MELAMINE
FINISH
M1 MELAMINE TO INTERNAL FACES OF
CUPBOARDS

LEGEND

FINISHES

- P1 - 2PAC BLACK + 2 Coats of Non Yellowing Polyurethane - Finish to match ASI powder coat
- M1 - Black - Flint Finish - Laminex



FIXTURES - SUPPLIED BY ASI

NOTE: ALL CORNERS TO BE MITERED
TOUGHEN COLOUR BACK GLASS TO TOPS


TOTAL QTY TBC



Unit 10, 54 Tennyson Rd, Gladsville NSW 2111, Australia EMAIL: s_misis@bigpond.com I12DESIGN (AUSTRALIA) ABN 58 958 186 181 DESIGN DRAFTING PROPERTY STYLING RETAIL COMMERCIAL RESIDENTIAL	Figured dimensions shall take preference over ceiling. Contractor shall verify all dimensions on site before preparing shop drawings or starting work. Any variations to Specifications and Drawings must be authorised by I12DESIGN (AUSTRALIA). These Designs, Drawings and Specifications shall remain the copyright of I12DESIGN (AUSTRALIA), and must not be used, reproduced or copied wholly or in part without the written permission of the owners. NB. THIS DRAWING IS DESIGN INTENT ONLY.		CLIENT COLETTE ACCESSORIES	
	PROJECT SHOP 83 WARRINGAH MALL		SCALE: 1:50 DATE: 16/02/10	
	DRAWING SJ_A REAR COUNTER CUPBOARDS		CHECKED: SM REV. NO: 12	
	It is the responsibility of the shop/owner to ensure that this work is carried out compliant to BCA & other relevant Authorities/Codes		DESIGN REVIEW A 16/02 FIRST ISSUE SM REV DATE AMENDMENTS BY APP	

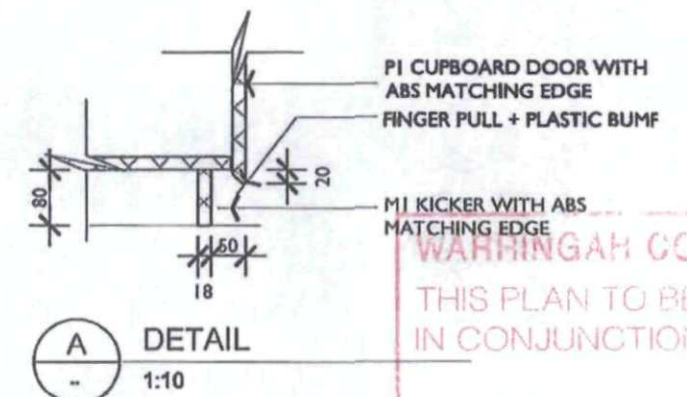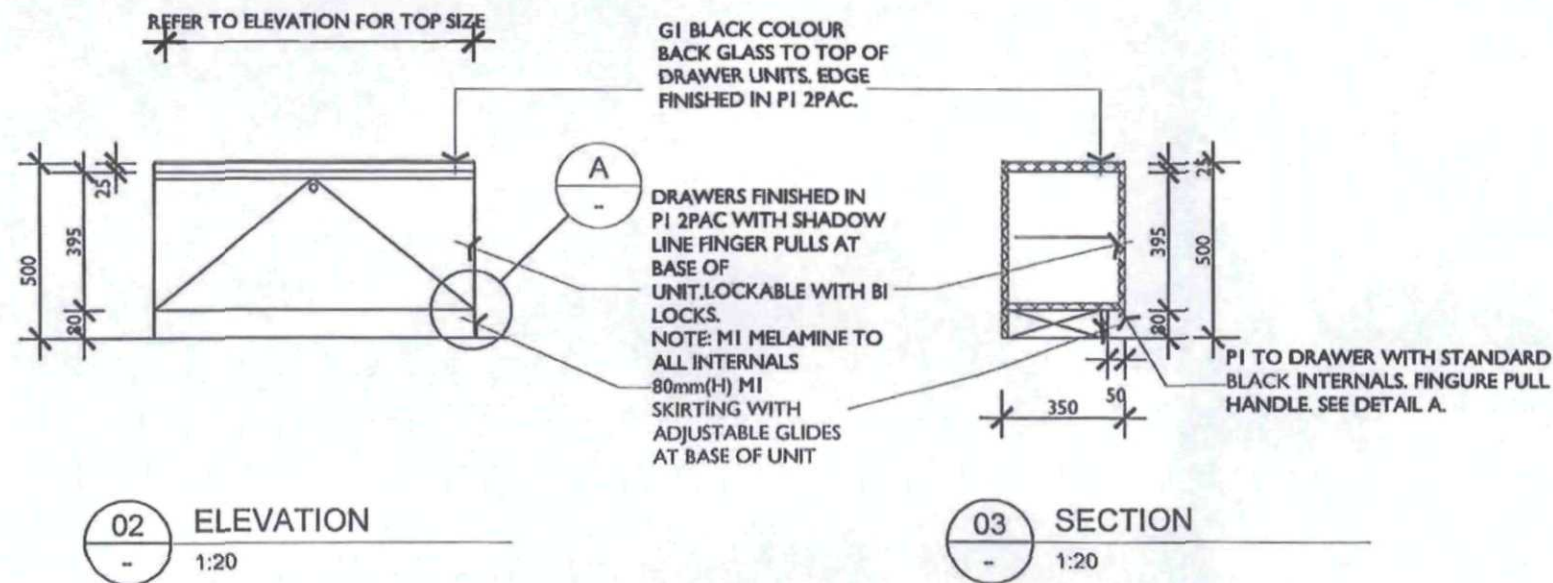

WARRINGAH COUNCIL
THIS PLAN TO BE READ
IN CONJUNCTION WITH
Construction
Certificate No CC2010/0094

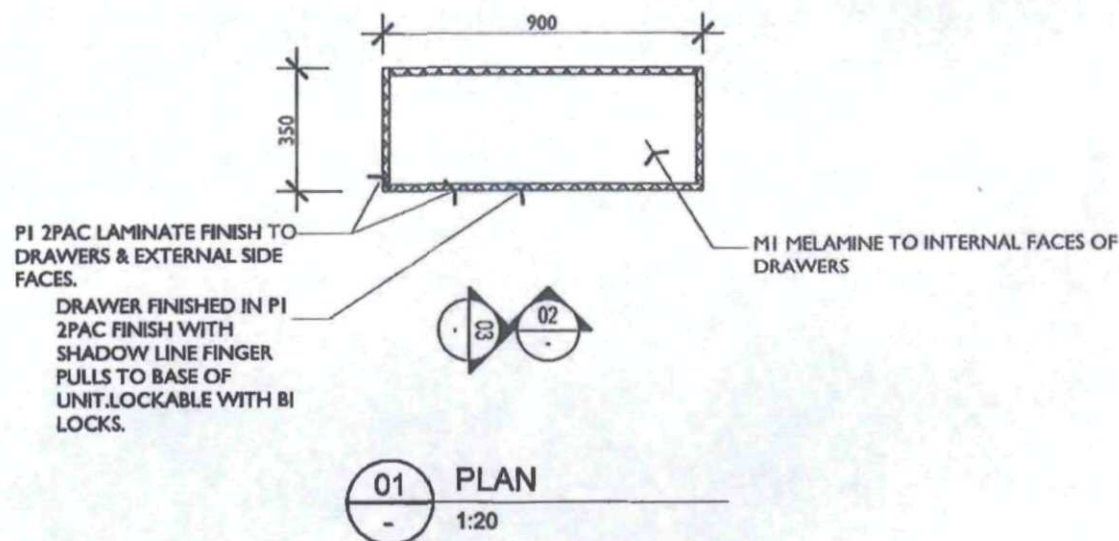

LEGEND

FINISHES

- G1 - Black colour back toughen glass
- P1 - 2PAC BLACK + 2 Coats of Non Yellowing Polyurethane - Finish to match ASI powder coat
- M1 - Black - Flint Finish - Laminex


FIXTURES - SUPPLIED BY ASI

**NOTE: ALL CORNERS TO BE MITERED
MASTER TO KEY TO SUPPLIED WITH BILOCKS**


TOTAL QTY TBC

AMERICAN DESIGN CO. (Pty) Ltd
APPROVED
DESIGN CO. (Pty) Ltd
Date: 22/2/10 Issue: 13/20
By: Warrimah Colette
Checked: [Signature]
I hereby certify that the design concept is granted to the lessee for the shop layout and signage shown on these drawings. Any notes must be addressed and if requested submitted to the relevant authorities.


Unit 10, 54 Tennyson Rd, Gladesville NSW 2111, Australia EMAIL: a_mitsie@hdponed.com INDESIGN (AUSTRALIA) ABN 66 959 188 181 DESIGN DRAFTING PROPERTY STYLING RETAIL COMMERCIAL RESIDENTIAL	Figured dimensions shall take preference over scaling. Contractor shall verify all dimensions on site before preparing shop drawings or starting work. Any variations to Specifications and Drawings must be authorized by INDESIGN (AUSTRALIA). These Designs, Drawings and Specifications shall remain the copyright of INDESIGN (AUSTRALIA) and must not be used, reproduced or copied wholly or in part without the written permission of the owners. NB. THIS DRAWING IS DESIGN INTENT ONLY.		CLIENT COLETTE ACCESSORIES	
	PROJECT SHOP 83 WARRINGAH MALL		A 16/02 FIRST ISSUE SM	
	DRAWING SJ_B EYELINE WALL DRAWERS		SCALE: 1:50 DATE: 16/02/10	
	It is the responsibility of the shopfitter to ensure that this work is carried out compliant to BCA + other relevant Authorities/Codes		CHECKED: [Signature] REV. NO. DATE: 16/02/10	

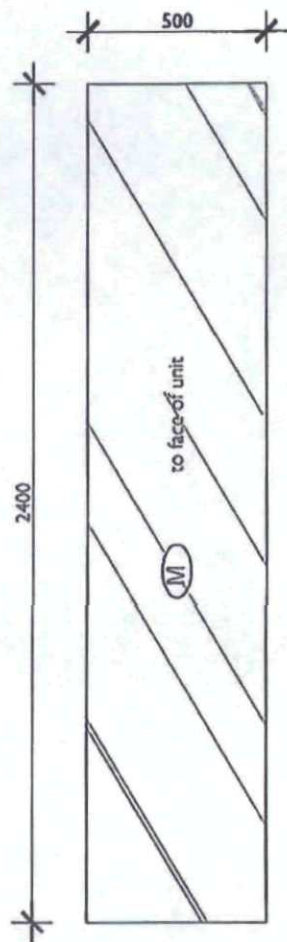

02 ELEVATION C & D
1:20

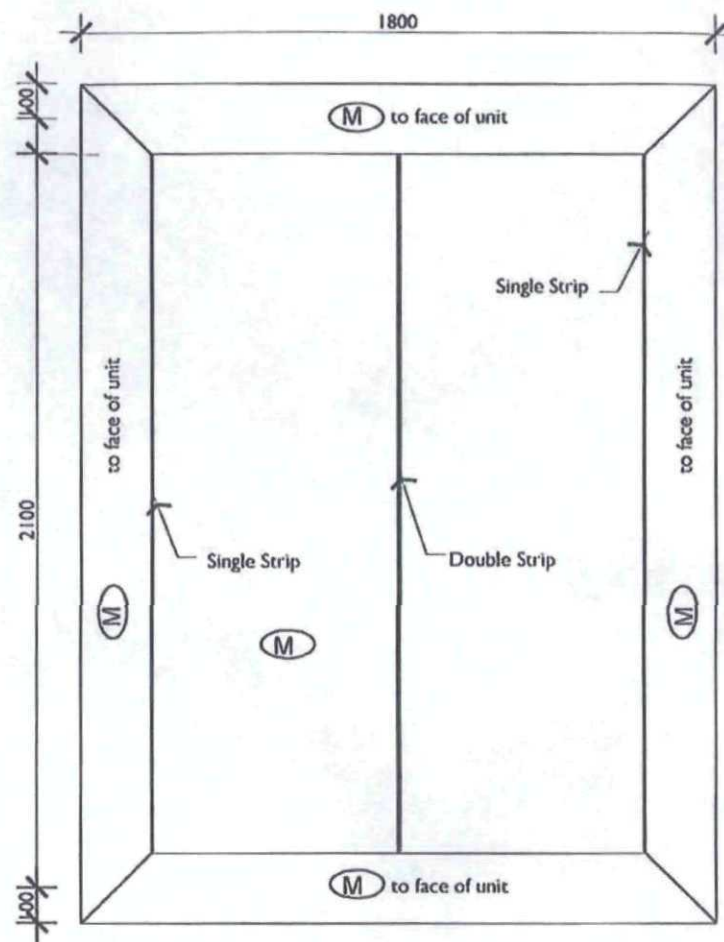

02 ELEVATION B
1:20

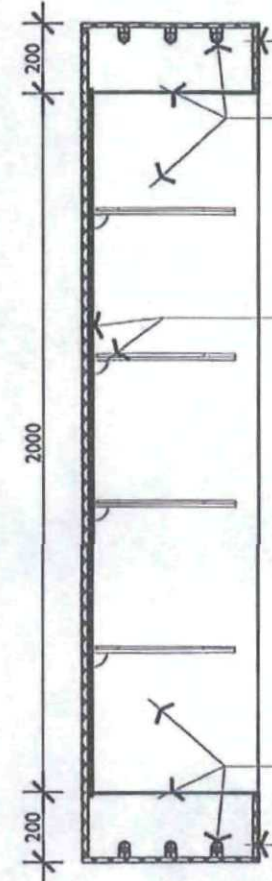



02 SECTION A
1:20

(M) to face of unit
White opal acrylic cover, with concealed fixing.
Note: Provide access for servicing lights.

ASI concealed stripping to back of shelving unit. SHELF BRACKETS TO HOLD 400mm LAMINATED GLASS SHELVES WITH RADIUS CORNERS.
SUPPLIER - ASI

White opal acrylic cover, with concealed fixing.
Note: Provide access for servicing lights.

(M) to face of unit

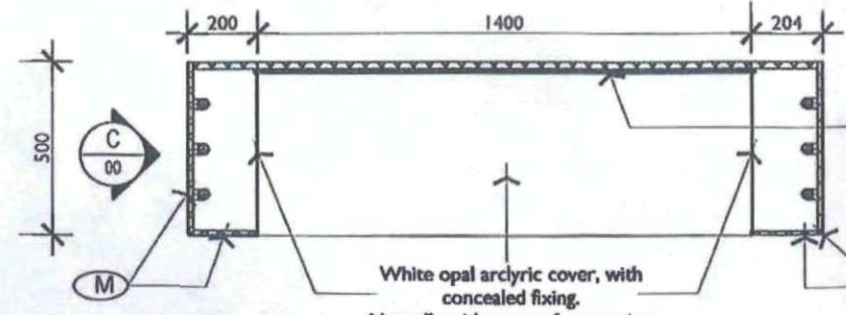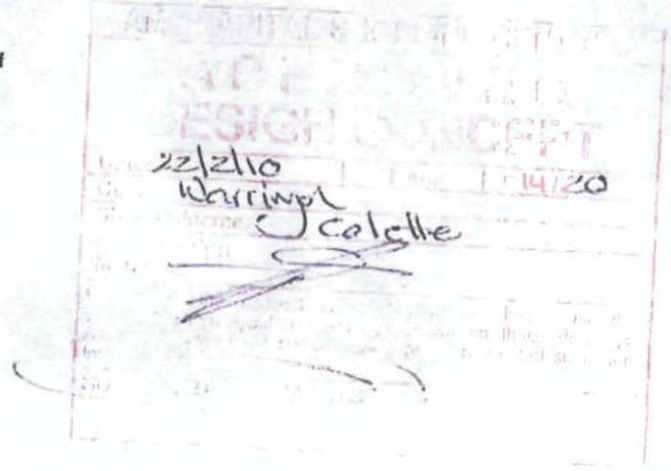

01 PLAN
1:20

ASI concealed stripping to back of shelving unit. SHELF BRACKETS TO HOLD 400mm LAMINATED GLASS SHELVES WITH RADIUS CORNERS.
SUPPLIER - ASI

White opal acrylic cover, with concealed fixing.
Note: Provide access for servicing lights.

LEGEND

FINISHES
M - Mirror with beveled edges at ends

FIXTURES - SUPPLIED BY ASI
ASI Concealed Stripping - 1 x Double centre strip and 1 x side strip
ASI Shelving toughen glass to suit



NOTE: ALL CORNERS TO BE MITERED
TOTAL QTY TBC

WARRINGAH COUNCIL
THIS PLAN TO BE READ
IN CONJUNCTION WITH
Construction
Certificate No CC20P510094

Unit 10, 54 Tennyson Rd, Gladesville NSW 2111, Australia
EMAIL: a_rntis@bigpond.com
IN2DESIGN (AUSTRALIA) ABN 58 859 188 181
DESIGN | DRAFTING | PROPERTY STYLING
RETAIL | COMMERCIAL | RESIDENTIAL

Figured dimensions shall take preference over scaling. Contractor shall verify all dimensions on site before preparing shop drawings or starting work. Any variations to Specification and Drawings must be authorized by IN2DESIGN (AUSTRALIA). These Designs, Drawings and Specifications shall remain the copyright of IN2DESIGN (AUSTRALIA), and must not be used, reproduced or copied wholly or in part without the written permission of the owners.
NB: THIS DRAWING IS DESIGN INTENT ONLY.
It is the responsibility of the shopfitter to ensure that this work is carried out compliant to BCA + other relevant Authorities/Codes

CLIENT COLETTE ACCESSORIES				
PROJECT SHOP 83 WARRINGAH MALL		A	16/02	FIRST ISSUE
REV	DATE	AMENDMENTS		BY APP
DESIGN REVIEW				
DRAWING SJ_C MIRROED SHELF UNIT	SCALE: 1:50	DATE: 16/02/10	CHECKED	REV NO
	CRAV BY: SM			
	JOB NO.	EVG NO.	14	

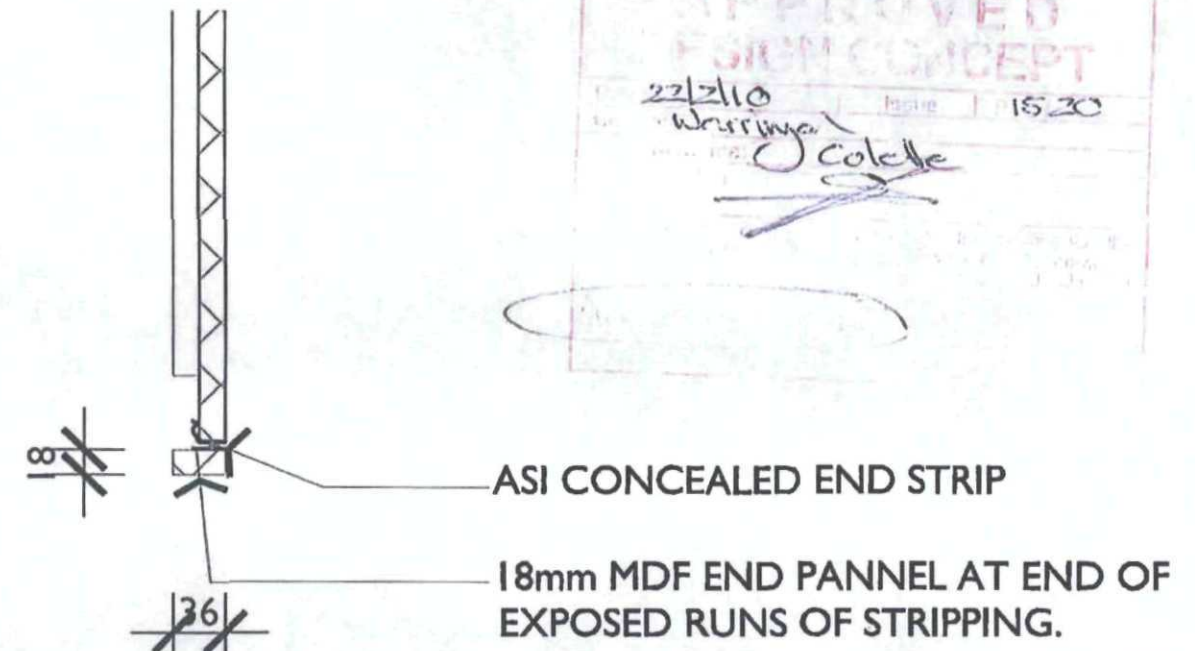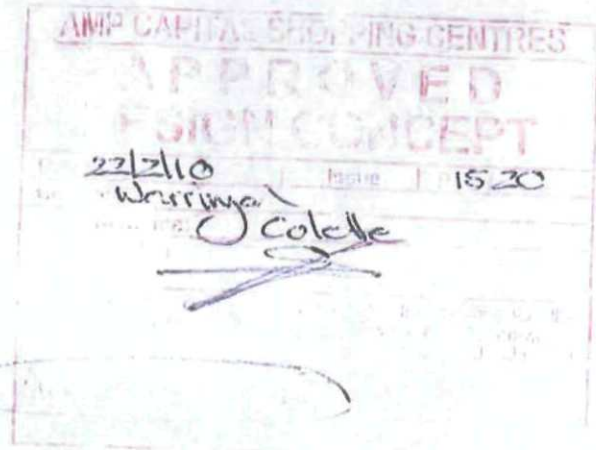


A
-
DETAIL
1:5

WARRINGAH COUNCIL
THIS PLAN TO BE READ
IN CONJUNCTION WITH
Construction
Certificate No. CC2009/0094

Unit 10, 64 Tennyson Rd, Gladesville NSW 2111, Australia EMAIL a_mitrie@bigpond.com IN2DESIGN (AUSTRALIA) ABN 58 050 188 181 DESIGN DRAFTING PROPERTY STYLING RETAIL COMMERCIAL RESIDENTIAL 	Figured dimensions shall take preference over scaling. Contractor shall verify all dimensions on site before preparing shop drawings or starting work. Any variations to specification and Drawings must be authorized by IN2DESIGN (AUSTRALIA). These Designs, Drawings and Specifications shall remain the copyright of IN2DESIGN (AUSTRALIA), and must not be used, reproduced or copied wholly or in part without the written permission of the owners. NB. THIS DRAWING IS DESIGN INTENT ONLY. It is the responsibility of the shopfitter to ensure that this work is carried out compliant to BCA + other relevant Authorities Codes	CLIENT	COLETTE				
		ACCESSORIES					
		PROJECT	SHOP 83	A	16/02	FIRST ISSUE	SM
		WARRINGAH MALL		REV	DATE	AMENDMENTS	BY APP
		DESIGN REVIEW					
		DRAWING	SCALE 1:50	DATE	16/02/10	CHECKED	REV. NO
		DETAIL C - END CAP FOR STRIPPING	CREATED BY SM				
			JOB NO.		ISSUE NO.	15	

Refer to comments on elevations.

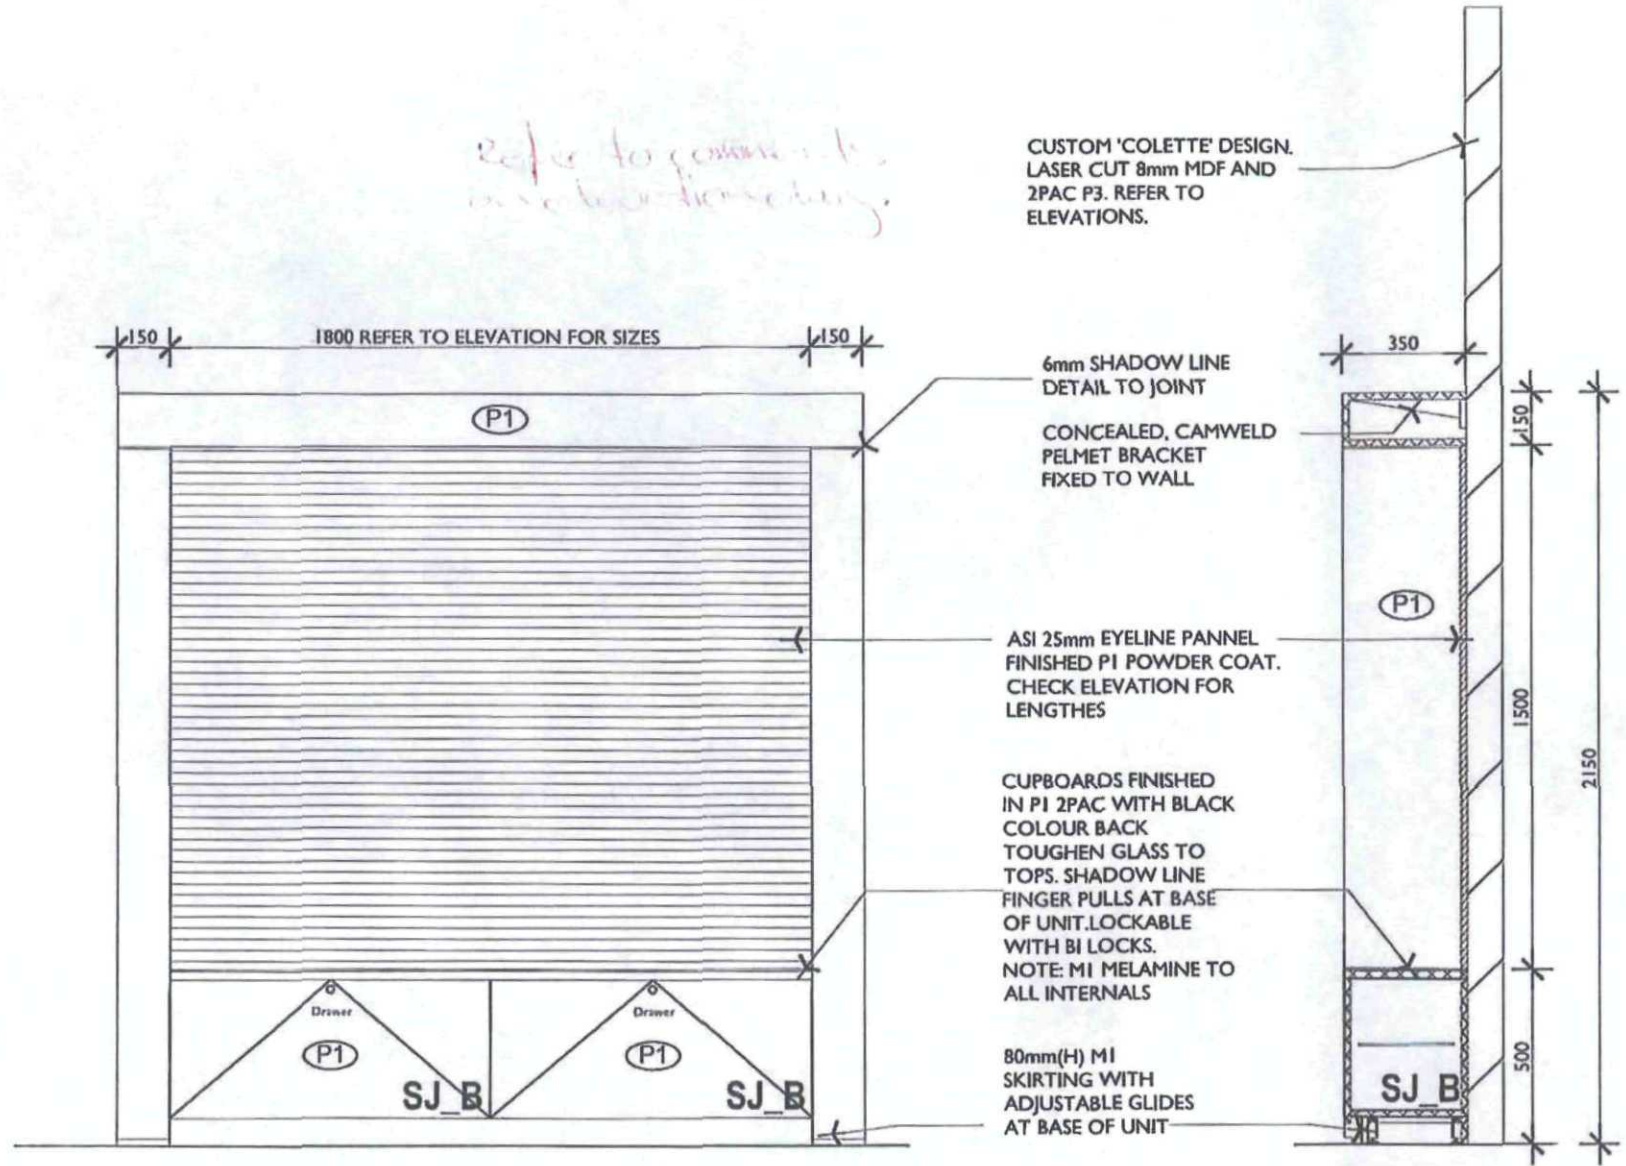

D TYPICAL WALL DETAIL
1:20

D TYPICAL WALL DETAIL SECTION
1:20




LEGEND

- FINISHES**
- P1 - 2PAC BLACK + 2 Coats of Non Yellowing Polyurethane - Finish to match ASI powder coat
 - M1 - Black - Flint Finish - Laminex


FIXTURES - SUPPLIED BY ASI
ASI Eyeline 25mm- BLACK POWDER COAT

NOTE: APPLY 6mm SHADOW LINES TO JOINTS

TOTAL QTY TBC

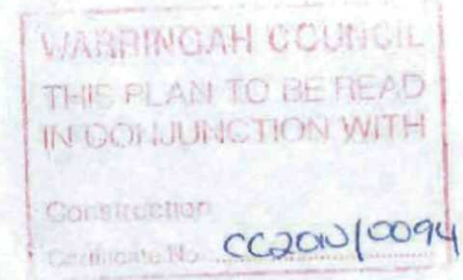

Unit 10, 54 Tennyson Rd, Gladesville NSW 2111, Australia EMAIL: a_mitsis@bigpond.com IN2DESIGN (AUSTRALIA) ABN 58 959 188 181 DESIGN DRAFTING PROPERTY STYLING RETAIL COMMERCIAL RESIDENTIAL 	Figured dimensions shall take preference over scaling. Contractor shall verify all dimensions on site before preparing shop drawings or starting work. Any variations to Specification and Drawings must be authorised by IN2DESIGN (AUSTRALIA). These Designs, Drawings and Specifications shall remain the copyright of IN2DESIGN (AUSTRALIA), and must not be used, reproduced or copied wholly or in part without the written permission of the owners. NB. THIS DRAWING IS DESIGN INTENT ONLY. It is the responsibility of the shopfitter to ensure that this work is carried out compliant to BCA + other relevant Authorities/Codes.	CLIENT COLETTE ACCESSORIES					
		PROJECT SHOP 83 WARRINGAH MALL	A 16/02 FIRST ISSUE SM				
		DRAWING DETAIL D - EYELINE WALL DETAIL	SCALE 1:50 DATE 16/02/10 DRAWN BY SM CHECKED BY JOB NO. 16				
			DESIGN REVIEW REV DATE AMENDMENTS BY APP				

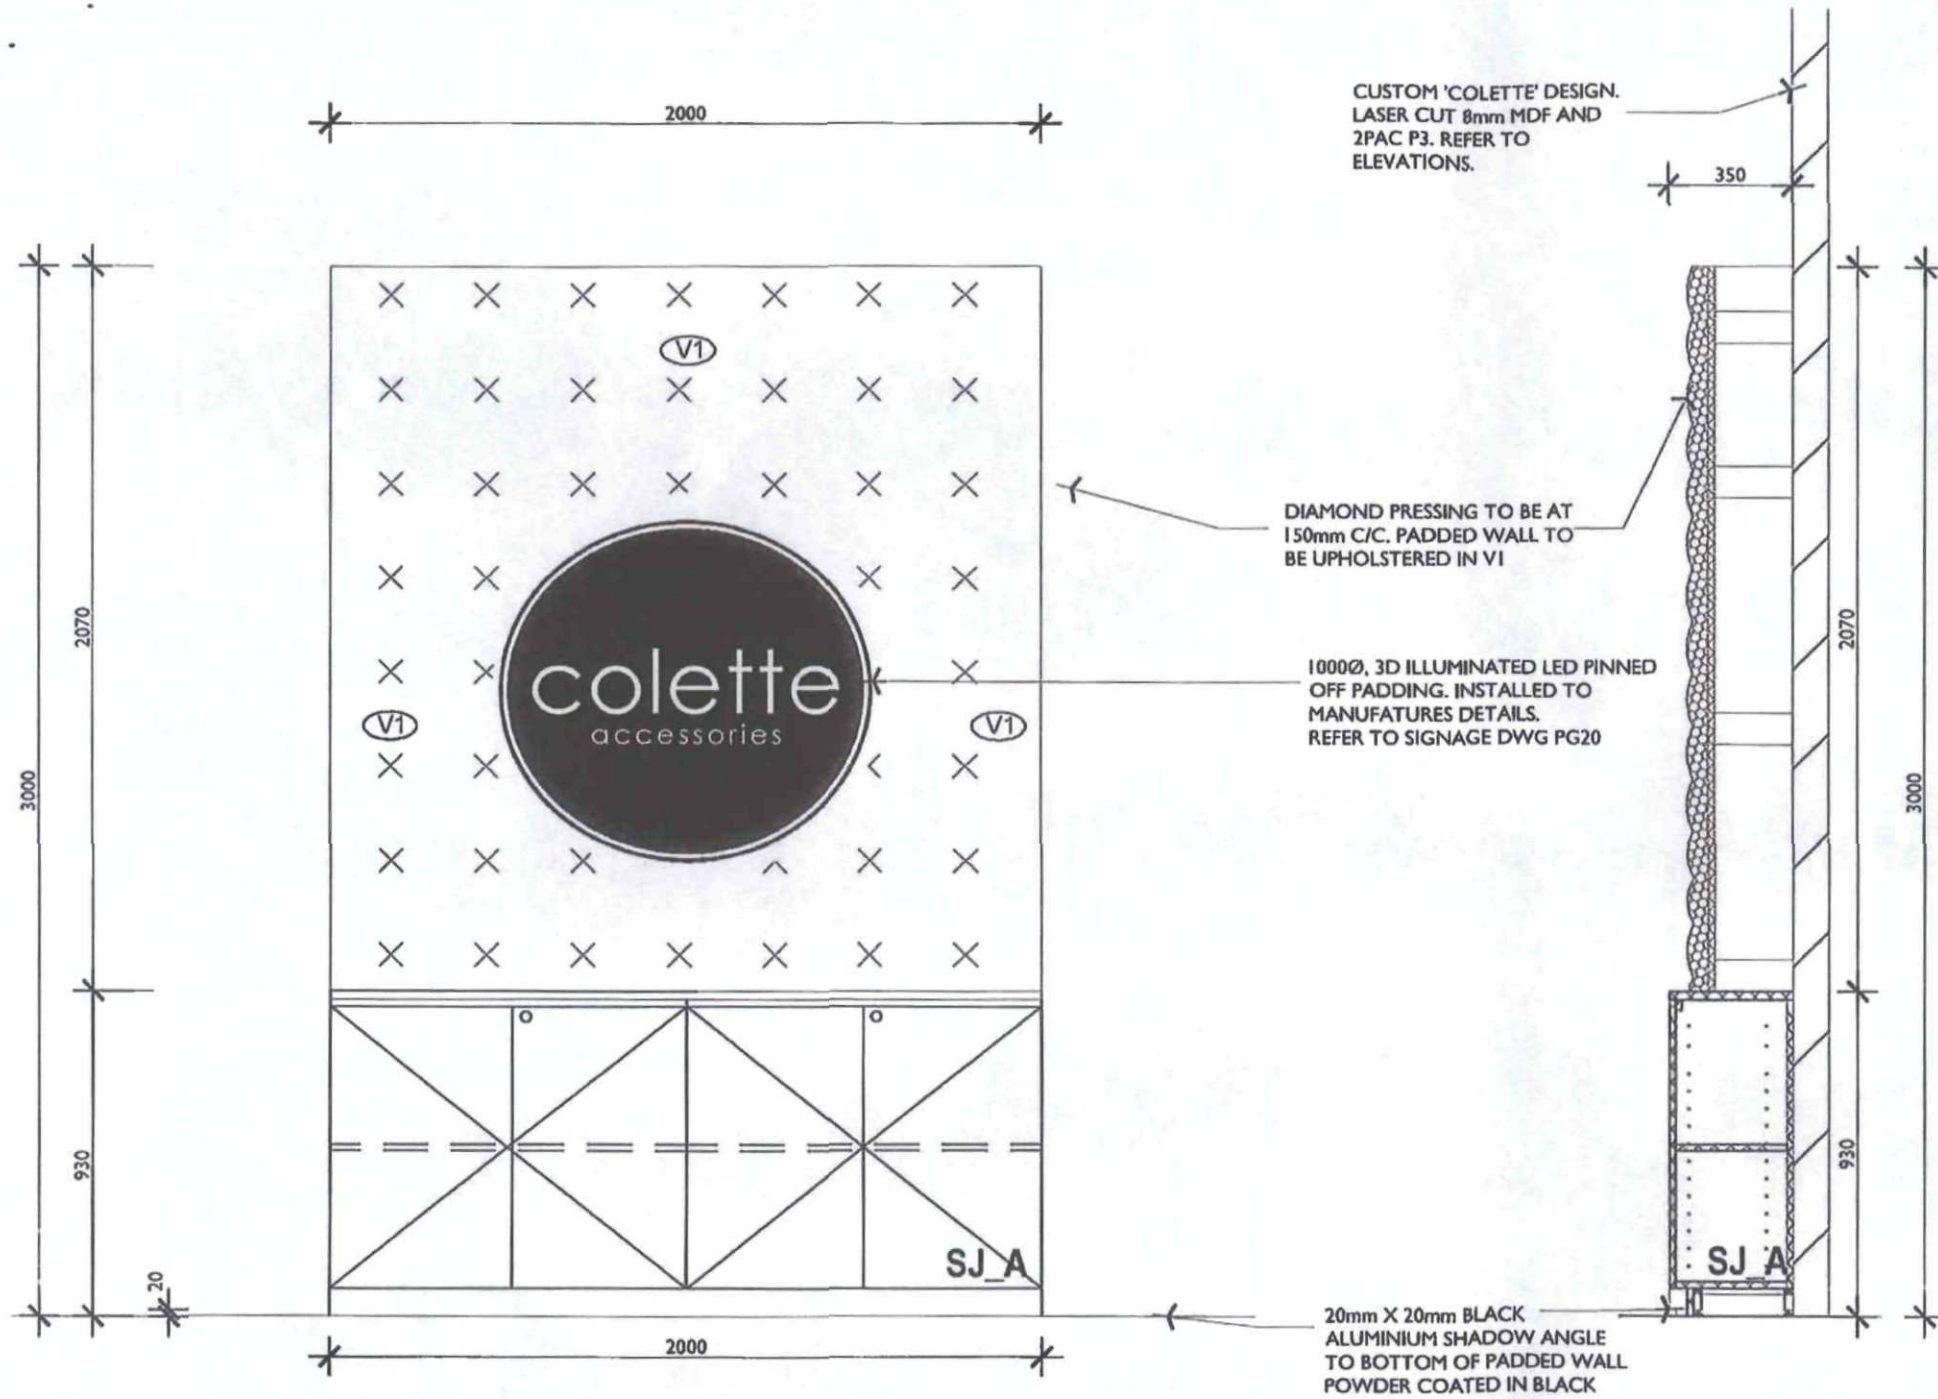


CUSTOM 'COLETTE' DESIGN.
LASER CUT 8mm MDF AND
2PAC P3. REFER TO
ELEVATIONS.

DIAMOND PRESSING TO BE AT
150mm C/C. PADDED WALL TO
BE UPHOLSTERED IN V1

10000, 3D ILLUMINATED LED PINNED
OFF PADDING. INSTALLED TO
MANUFACTURES DETAILS.
REFER TO SIGNAGE DWG PG20

20mm X 20mm BLACK
ALUMINIUM SHADOW ANGLE
TO BOTTOM OF PADDED WALL
POWDER COATED IN BLACK

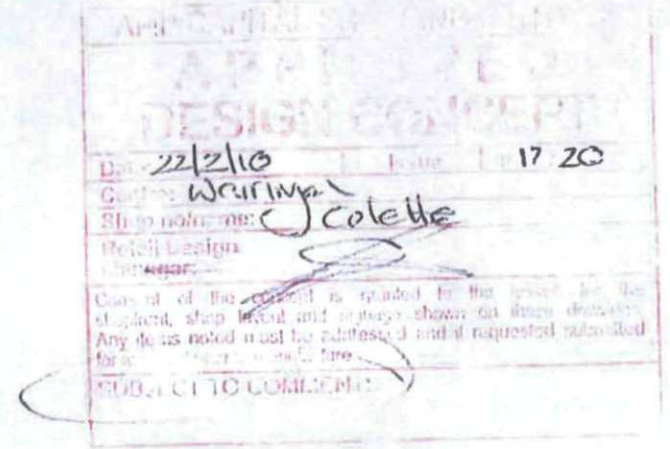

LEGEND

FINISHES

V1 - COLETTE CUSTOM VINYL METALLIC - COL: TBC

FIXTURES - SUPPLIED BY ASI


PADDED WALL SUPPLIED BY:
DL DESIGNER FURNITURE
CONTACT: BARRY 9521 2400

NOTE: ALL CORNERS TO BE MITERED
FRAMING OF LED TO BE CONCEALED


TOTAL QTY TBC

02 ELEVATION
1:20

03 SECTION
1:20

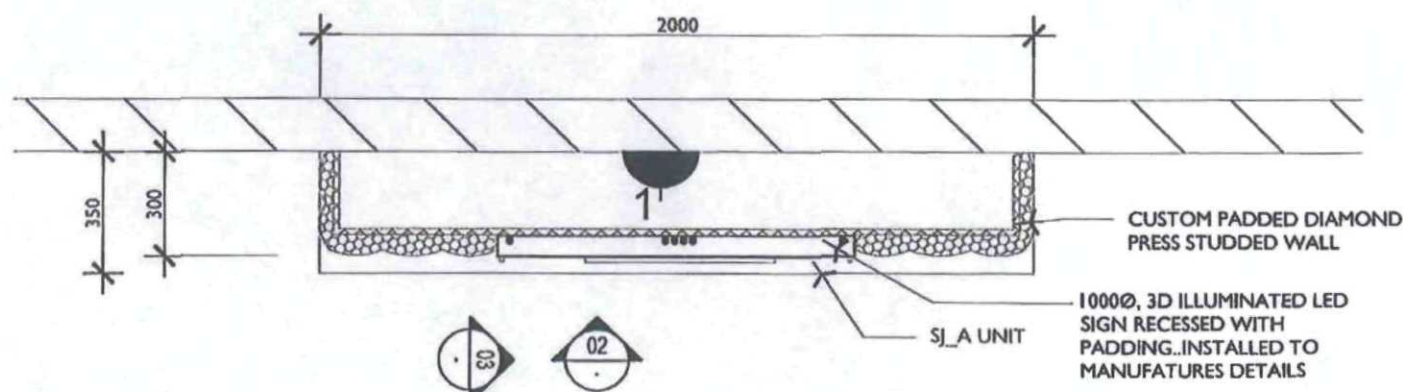


01 PLAN
1:20

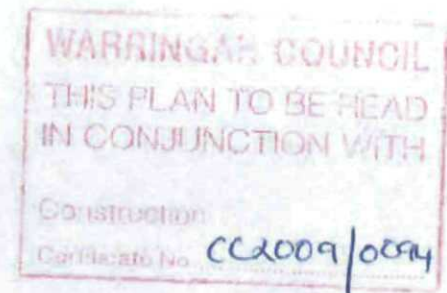

Unit 10, 54 Tennyson Rd, Gladesville NSW 2111, Australia EMAIL: s_mitola@bigpond.com IN2DESIGN (AUSTRALIA) ABN 58 959 188 181 DESIGN DRAFTING PROPERTY STYLING RETAIL COMMERCIAL RESIDENTIAL	Figured dimensions shall take preference over scaling. Contractor shall verify all dimensions on site before preparing shop drawings or starting work. Any variations to Specifications and Drawings must be authorised by IN2DESIGN (AUSTRALIA). These Designs, Drawings and Specifications shall remain the copyright of IN2DESIGN (AUSTRALIA) and must not be used, reproduced or copied wholly or in part without the written permission of the owners. NB. THIS DRAWING IS DESIGN INTENT ONLY. It is the responsibility of the shopfitter to ensure that this work is carried out compliant to BCA + other relevant Australian Codes		CLIENT COLETTE ACCESSORIES			
	PROJECT SHOP 83 WARRINGAH MALL	A 16/02 FIRST ISSUE SM				
	DRAWING SJ_E REAR COUNTER DETAIL	SCALE 1:50 DATE 16/02/10 DRAWN BY SM CHECKED JOB NO.	DESIGN REVIEW DATE 16/02/10 CHECKED BY APP DATE 17			

22/2/10
Warrimah
Colette
15/20

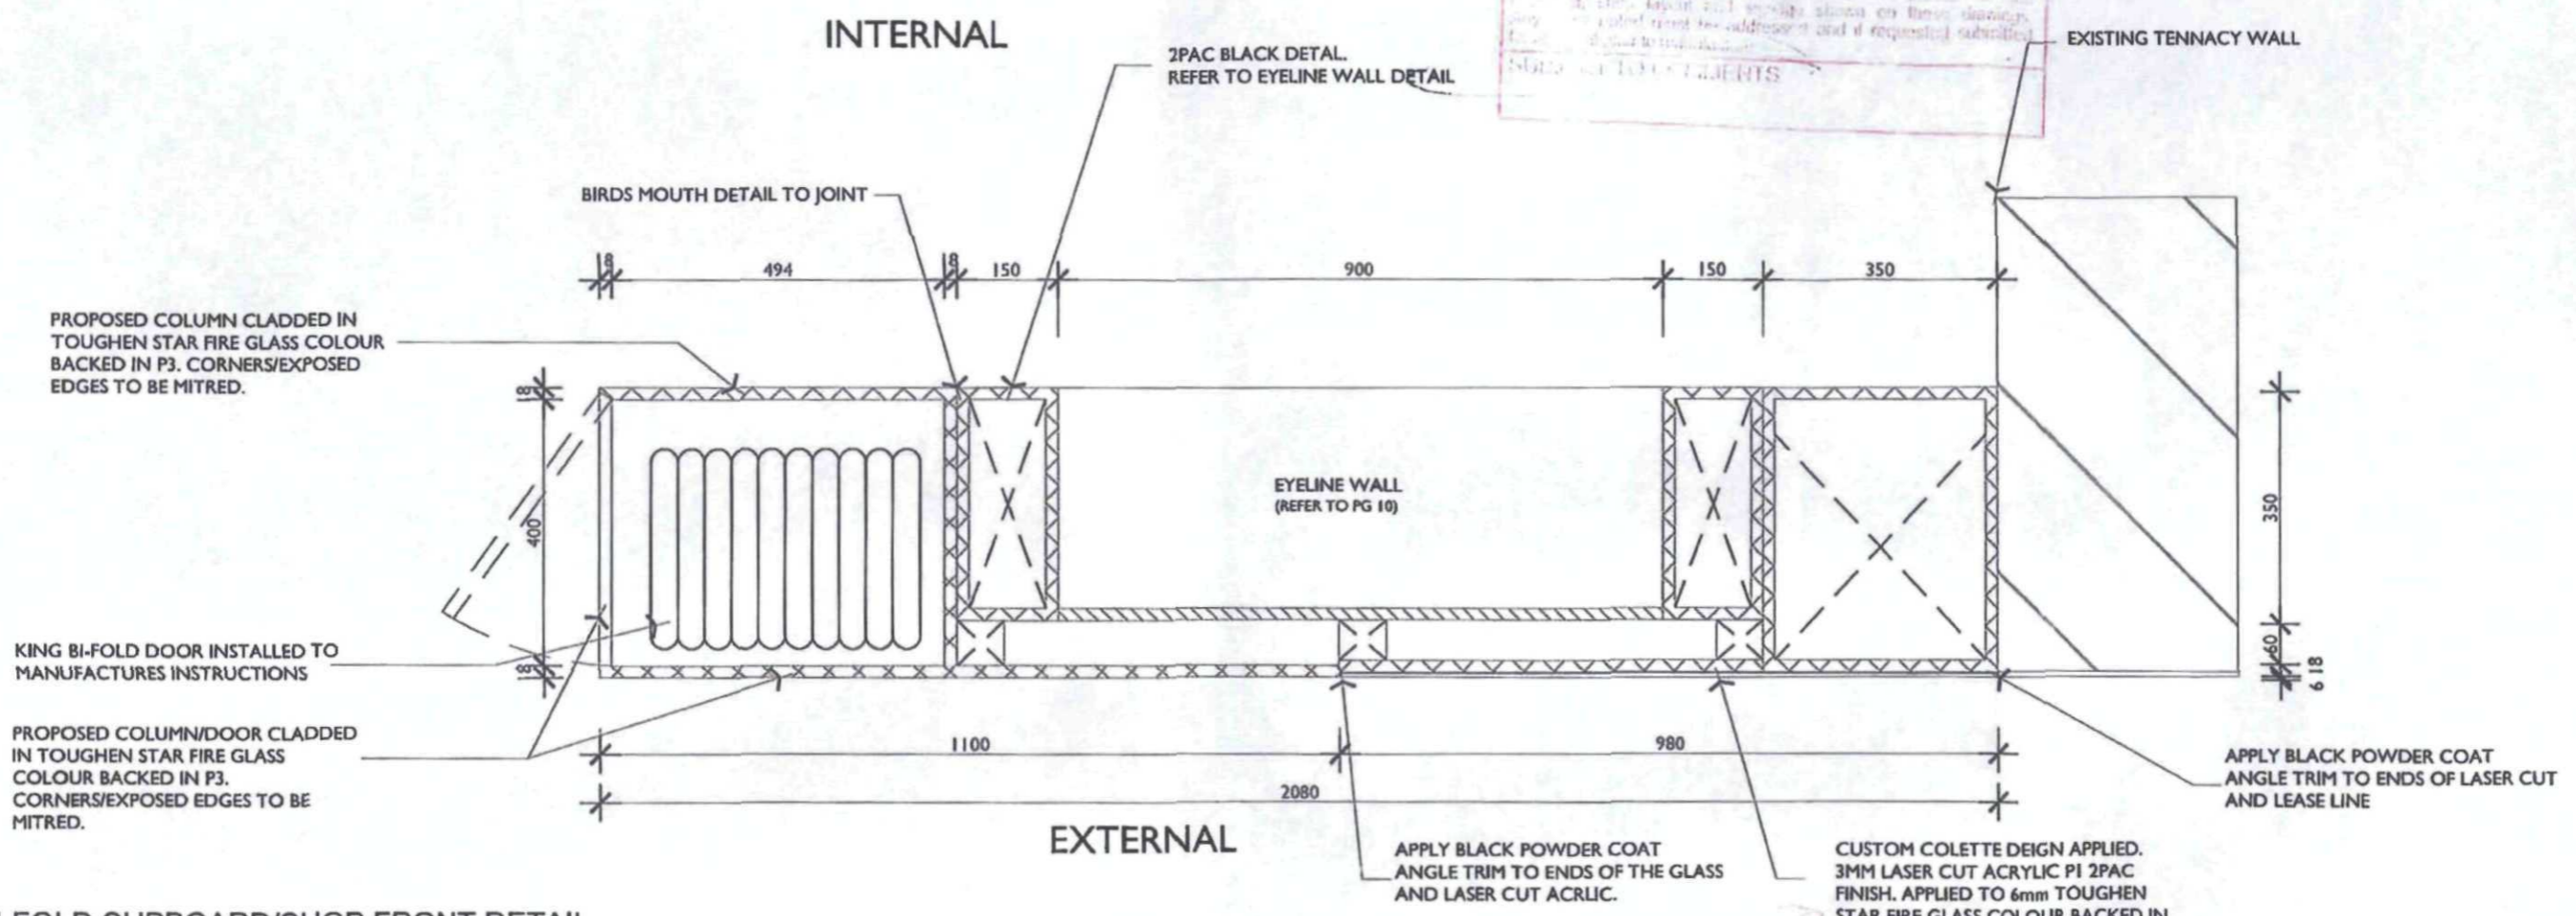

F BI-FOLD CUPBOARD/SHOP FRONT DETAIL
1:10

LEGEND

- FINISHES**
- P1 - 2PAC BLACK + 2 Coats of Non Yellowing Polurethane - Finish to match ASI powder coat 10% GLOSS
 - P3 - DULUX CHOCOLATE GLIMMER METALLIC

BI - FOLDING CLOSURE DOORS SUPPLIED BY :
KRGs
CONTACT: CLAYTON BLACKMAN 0424 170 180

TOTAL QTY TBC


WARRINGAH COUNCIL
THIS PLAN TO BE READ
IN CONJUNCTION WITH
Construction
Certificate No. 162010/0094

Unit 10, 54 Tennyson Rd, Gladesville NSW 2111, Australia EMAIL: a_mitels@bigpond.com IN2DESIGN (AUSTRALIA) ABN 58 959 188 181 DESIGN DRAFTING PROPERTY STYLING RETAIL COMMERCIAL RESIDENTIAL IN2DESIGN AUSTRALIA	Figured dimensions shall take preference over scaling. Contractor shall verify all dimensions on site before preparing shop drawings or starting work. Any variations to Specification and Drawings must be authorised by IN2DESIGN (AUSTRALIA). These Designs, Drawings and Specifications shall remain the copyright of IN2DESIGN (AUSTRALIA), and must not be used, reproduced or copied wholly or in part without the written permission of the owner. NB: THIS DRAWING IS DESIGN INTENT ONLY. It is the responsibility of the shopfitter to ensure that their work is carried out compliant to BCA + other relevant Authorities/Codes		CLIENT COLETTE ACCESSORIES			
	PROJECT SHOP 83 WARRINGAH MALL	A 16/02 FIRST ISSUE SM				
	DRAWING DETAIL F SHOP FRONT DETAIL	SCALE: 1:50 DATE: 16/02/10 CHECKED: SM REV. NO: 18	DESIGN REVIEW DATE: 16/02/10 CHECKED: [] REV. NO: []			




01 ELEVATION
- 1:20


NOTE: 3D ILLUMINATED SIGN TO BE FIXED AND INSTALLED AS PER MANUFACTURE AND CENTER GUIDELINES. PROVIDE POWER.

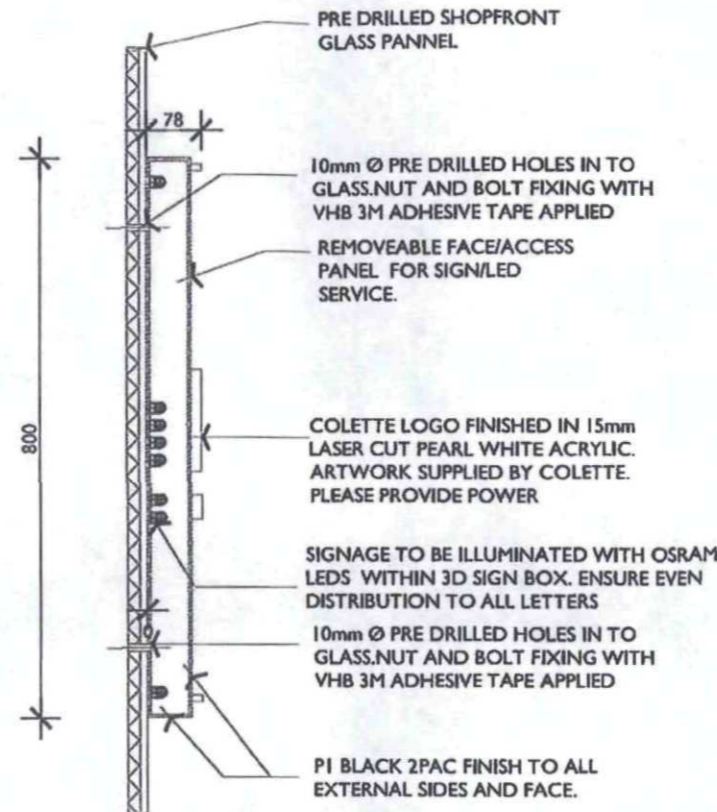

2 SECTION
- 1:10

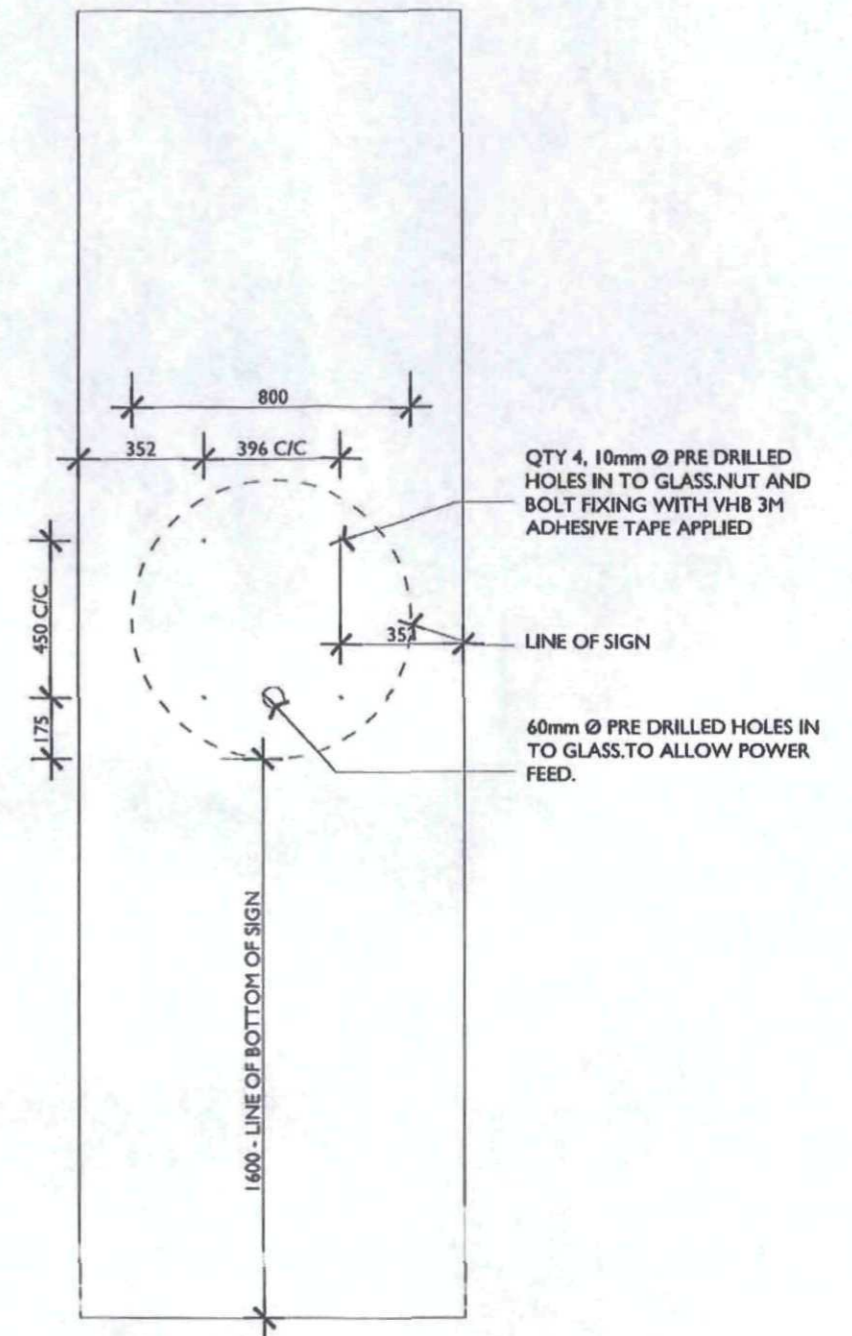

01 GLASS PANNEL ELEVATION
- 1:20

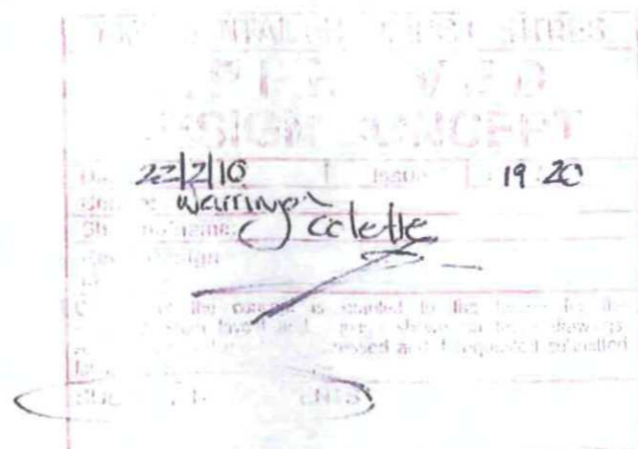

LEGEND

FINISHES

P1 - 2PAC BLACK + 2 Coats of Non Yellowing Polurethane - Finish to match ASI powder coat 10% GLOSS

SIGN SUPPLIED BY:
EXPRESSIVE SIGNS

CONTACT: FRANK CHOI 0412 211 305

NOTE: ALL CORNERS TO BE SEAMLESS

PLEASE CONTACT COLETTE GRAPHIC DESIGNER FOR ARTWORK - (02) 9938 3861


TOTAL QTY TBC

Unit 10, 54 Tennyson Rd, Gladesville NSW2111, Australia EMAIL: a_mitls@bigpond.com IN2DESIGN (AUSTRALIA) ABN 68 950 188 181 DESIGN DRAFTING PROPERTY STYLING RETAIL COMMERCIAL RESIDENTIAL	Figured dimensions shall take preference over scaling. Contractor shall verify all dimensions on site before preparing shop drawings or starting work. Any variations to Specification and Drawings must be authorised by IN2DESIGN (AUSTRALIA). These Designs, Drawings and Specifications shall remain the copyright of IN2DESIGN (AUSTRALIA), and must not be used, reproduced or copied wholly or in part without the written permission of the owners. NB. THIS DRAWING IS DESIGN INTENT ONLY. It is the responsibility of the shopfitter to ensure that this work is carried out compliant to BCA + other relevant Authorities/Codes	CLIENT	COLETTE ACCESSORIES					
		PROJECT	SHOP 83 WARRINGAH MALL					
		DRAWING	SHOP FRONT SIGNAGE DETAIL	SCALE	1:10	DATE	16/02/10	
				DRAWN BY	SM	CHECKED		
				JOB NO.		DWG NO.	19	
				REV	DATE	AMENDMENTS	BY	APP
				A	16/02	FIRST ISSUE	SM	




01 ELEVATION
- 1:20

NOTE: 3D ILLUMINATED SIGN TO BE SCREW FIXED AND GLUED TO SHOP FRONT AS PER MANUFACTURE AND CENTER GUIDELINES. PROVIDE POWER.

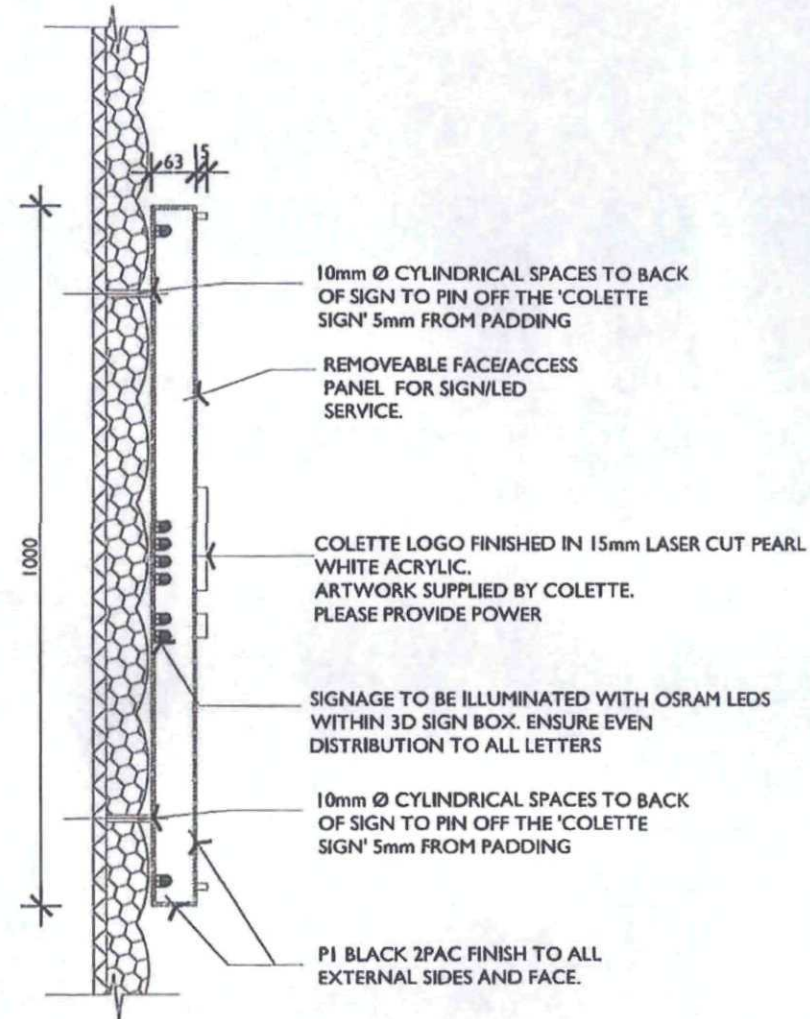

2 SECTION
- 1:10

WARRINGAH COUNCIL
THIS PLAN TO BE READ
IN CONJUNCTION WITH
Construction
Certificate No. cc2010/0094

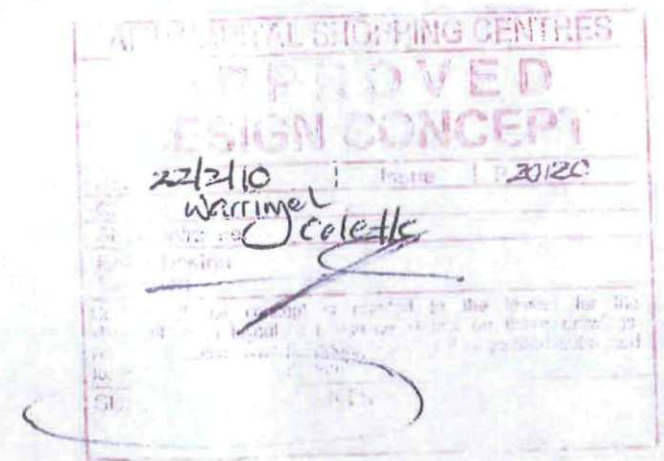

LEGEND

FINISHES

P1 - 2PAC BLACK + 2 Coats of Non Yellowing Polurethane - Finish to match ASI powder coat 10% GLOSS

SIGN SUPPLIED BY:
EXPRESSIVE SIGNS
CONTACT: FRANK CHOI 0412 211 305

NOTE: ALL CORNERS TO BE SEAMLESS
PLEASE CONTACT COLETTE GRAPHIC DESIGNER FOR ARTWORK - (02) 9938 3861

TOTAL QTY TBC

Unit 10, 54 Tennyson Rd, Gladesville NSW 2111, Australia EMAIL <u>s_mitsis@bigpond.com</u> IN2DESIGN (AUSTRALIA) ABN 58 958 188 181 DESIGN DRAFTING PROPERTY STYLING RETAIL COMMERCIAL RESIDENTIAL 	Figured dimensions shall take preference over scaling. Contractor shall verify all dimensions on site before preparing shop drawings or starting work. Any variations to Specification and Drawings must be authorised by IN2DESIGN (AUSTRALIA). These Designs, Drawings and Specifications shall remain the copyright of IN2DESIGN (AUSTRALIA) and must not be used, reproduced or copied wholly or in part without the written permission of the owners. NB. THIS DRAWING IS DESIGN INTENT ONLY. It is the responsibility of the shopfitter to ensure that this work is carried out compliant to BCA + other relevant Authorities/Codes		CLIENT COLETTE ACCESSORIES			
	PROJECT SHOP 83 WARRINGAH MALL	SCALE 1:10	DATE 16/02/10			
	DRAWING REAR COUNTER SIGNAGE DETAIL	DRAWN BY SM	CHECKED 	REV. 50 		
		JOB NO. 	SOG NO. 20			
			A 16/02 FIRST ISSUE SM			
			REV DATE AMENDMENTS BY APP			
			DESIGN REVIEW			