

01 DEMOLITION PLAN  
- NAB Manly  
Scale 1:100

#### NOTES :

1. Base plan and all dimensions noted are referenced from Warren and Mahoney's As Built drawing number ID 2.01 rev 2, provided to PMDL by Lendlease.
2. Existing tenancy fit-out to be removed entirely to leave a cold shell prior to construction.
3. Refer to DA004 for proposed demolition works to elevation.




For Approval

**PMDL** ARCHITECTURE  
INTERIORS  
MASTERPLANNING


#### Demolition Plan

© PMDL pmdl.com.au Project 2997 Scale 1:100 @ A3 Date 30.08.21 Dwg DA002 C

**NAB Manly NSW**

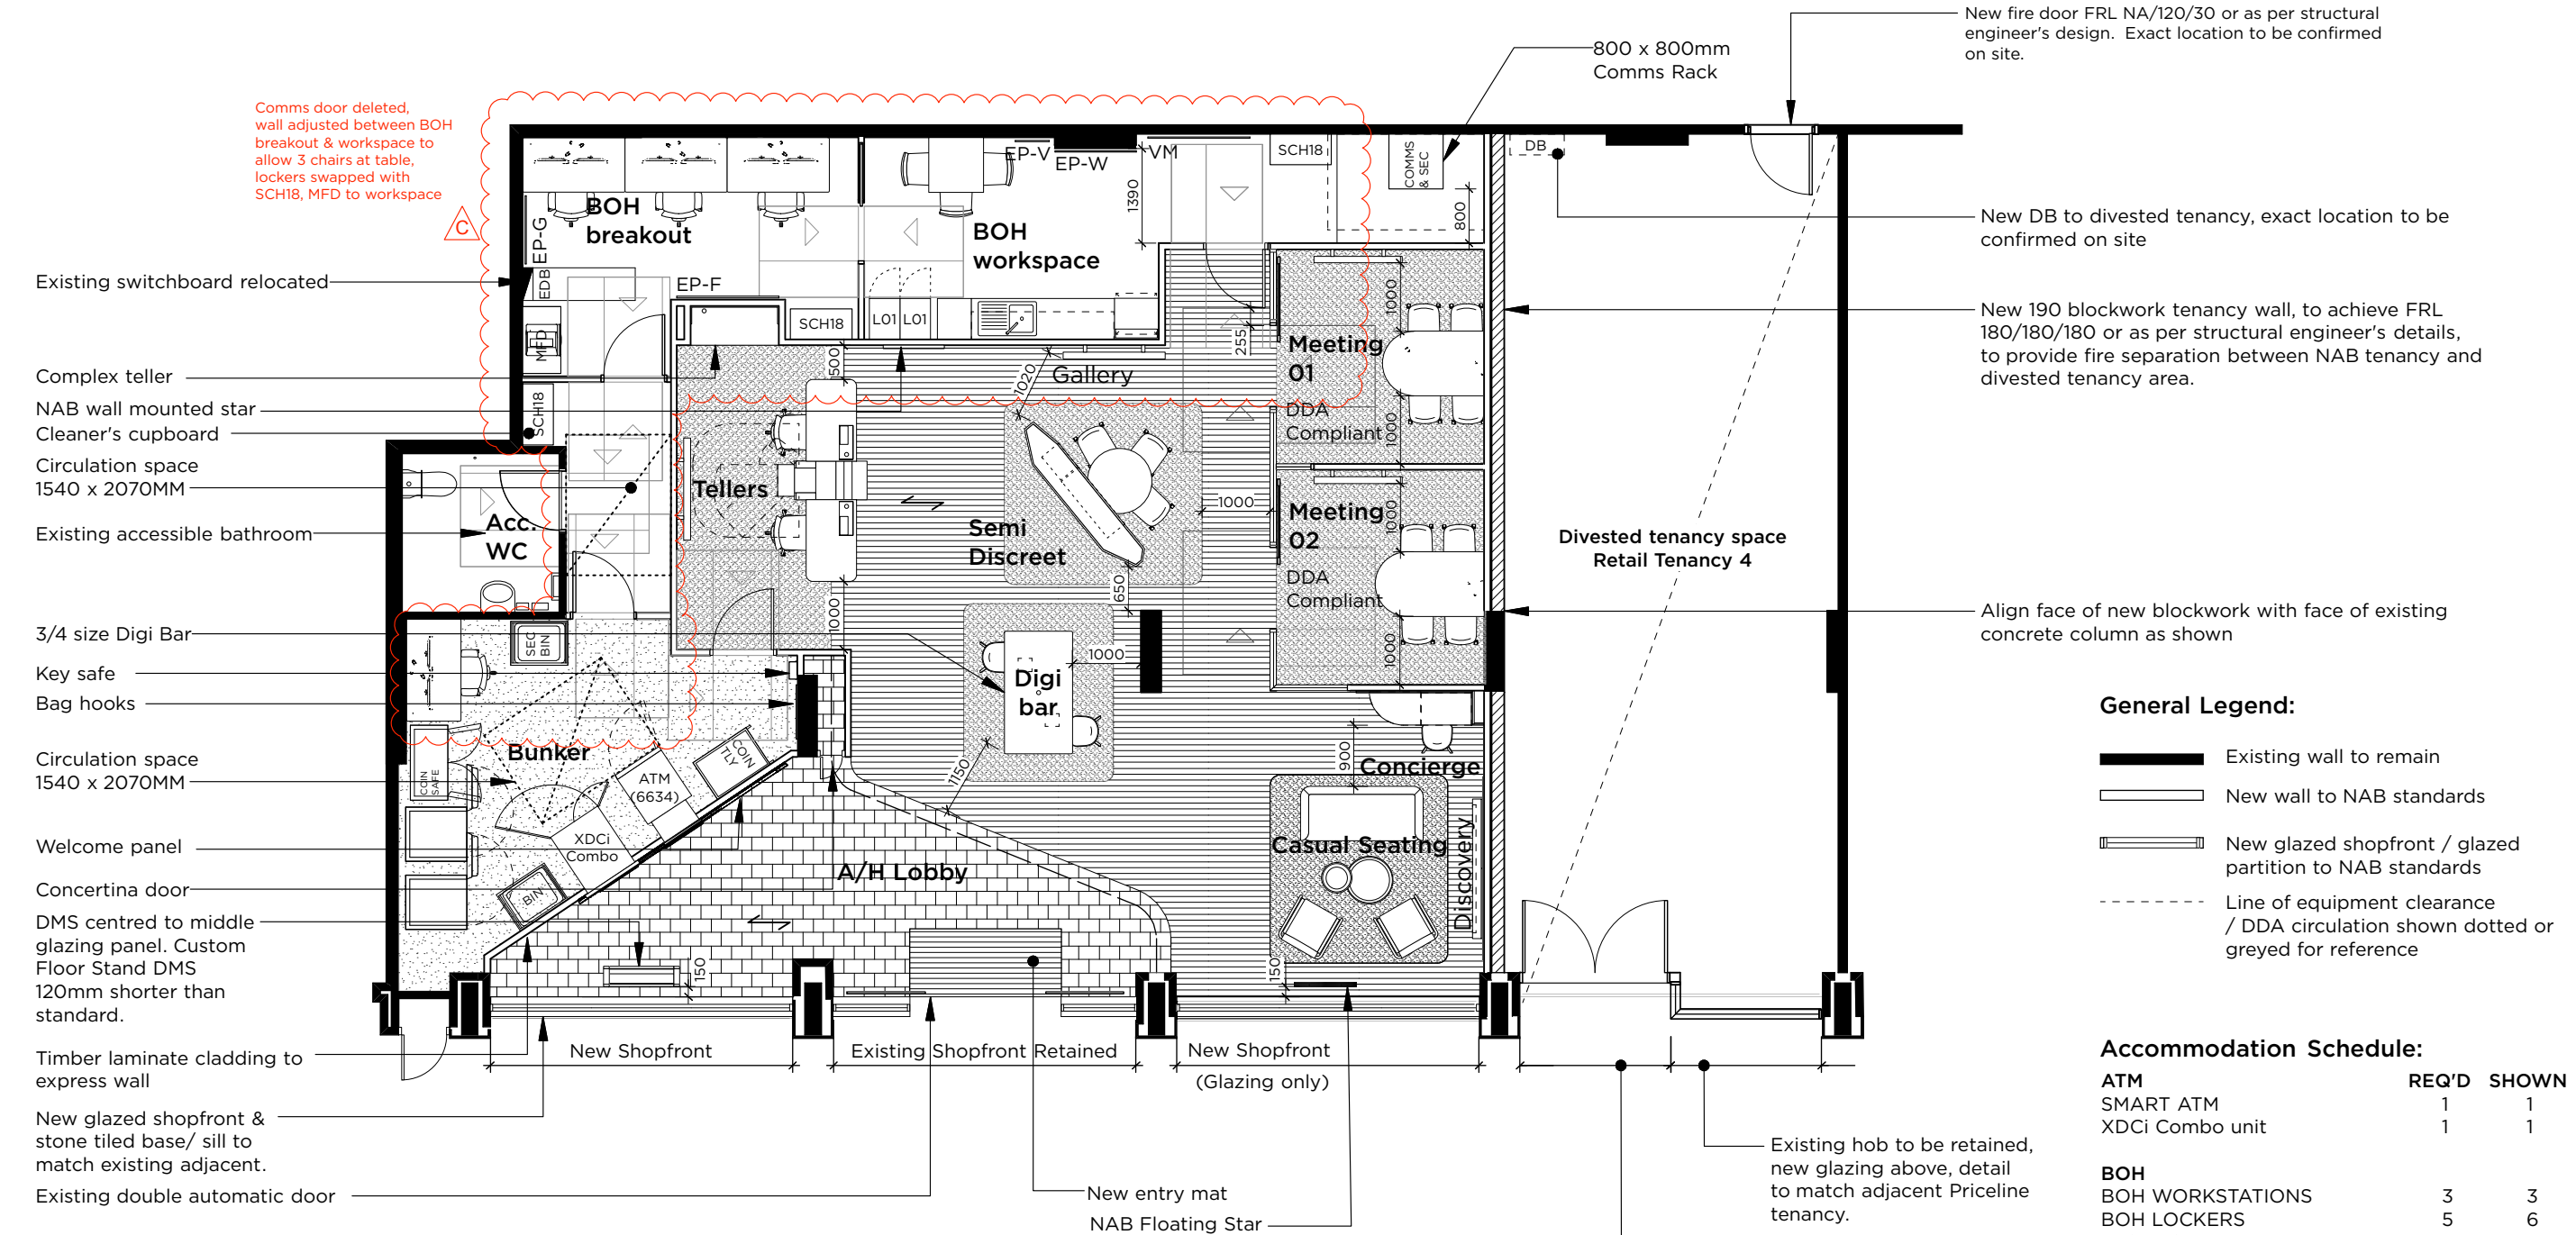

01 PROPOSED FLOOR PLAN  
- NAB Manly  
Scale 1:100

 **THIS PLAN IS TO BE READ IN CONJUNCTION WITH THE CONDITIONS OF DEVELOPMENT CONSENT**  
**DA2021/1574**


- NOTES:**
- 1. Base plan and all dimensions noted are referenced from Warren and Mahoney's As Built drawing number ID 2.01 rev 2, provided to PMDL by Lendlease. All dimensions to be confirmed on site prior to commencement of works.
  - 2. Refer to DA005 for proposed new works to elevation.

- General Legend:**
- Existing wall to remain
  - New wall to NAB standards
  - New glazed shopfront / glazed partition to NAB standards
  - Line of equipment clearance / DDA circulation shown dotted or greyed for reference

**Accommodation Schedule:**

	REQ'D	SHOWN
<b>ATM</b>		
SMART ATM	1	1
XDCi Combo unit	1	1
<b>BOH</b>		
BOH WORKSTATIONS	3	3
BOH LOCKERS	5	6
STORAGE	3	3
<b>TOUCHPOINTS - RETAIL</b>		
SEMI DISCREET	1	1
MEETING ROOMS	1	2

- NAB Signage Schedule:**
- VM - Visual Management Board
  - EP-G - Engagement Panel - Graphic
  - EP-F - Engagement Panel - Felt Board
  - EP-V - Engagement Panel - Values
  - EP-W - Whiteboard

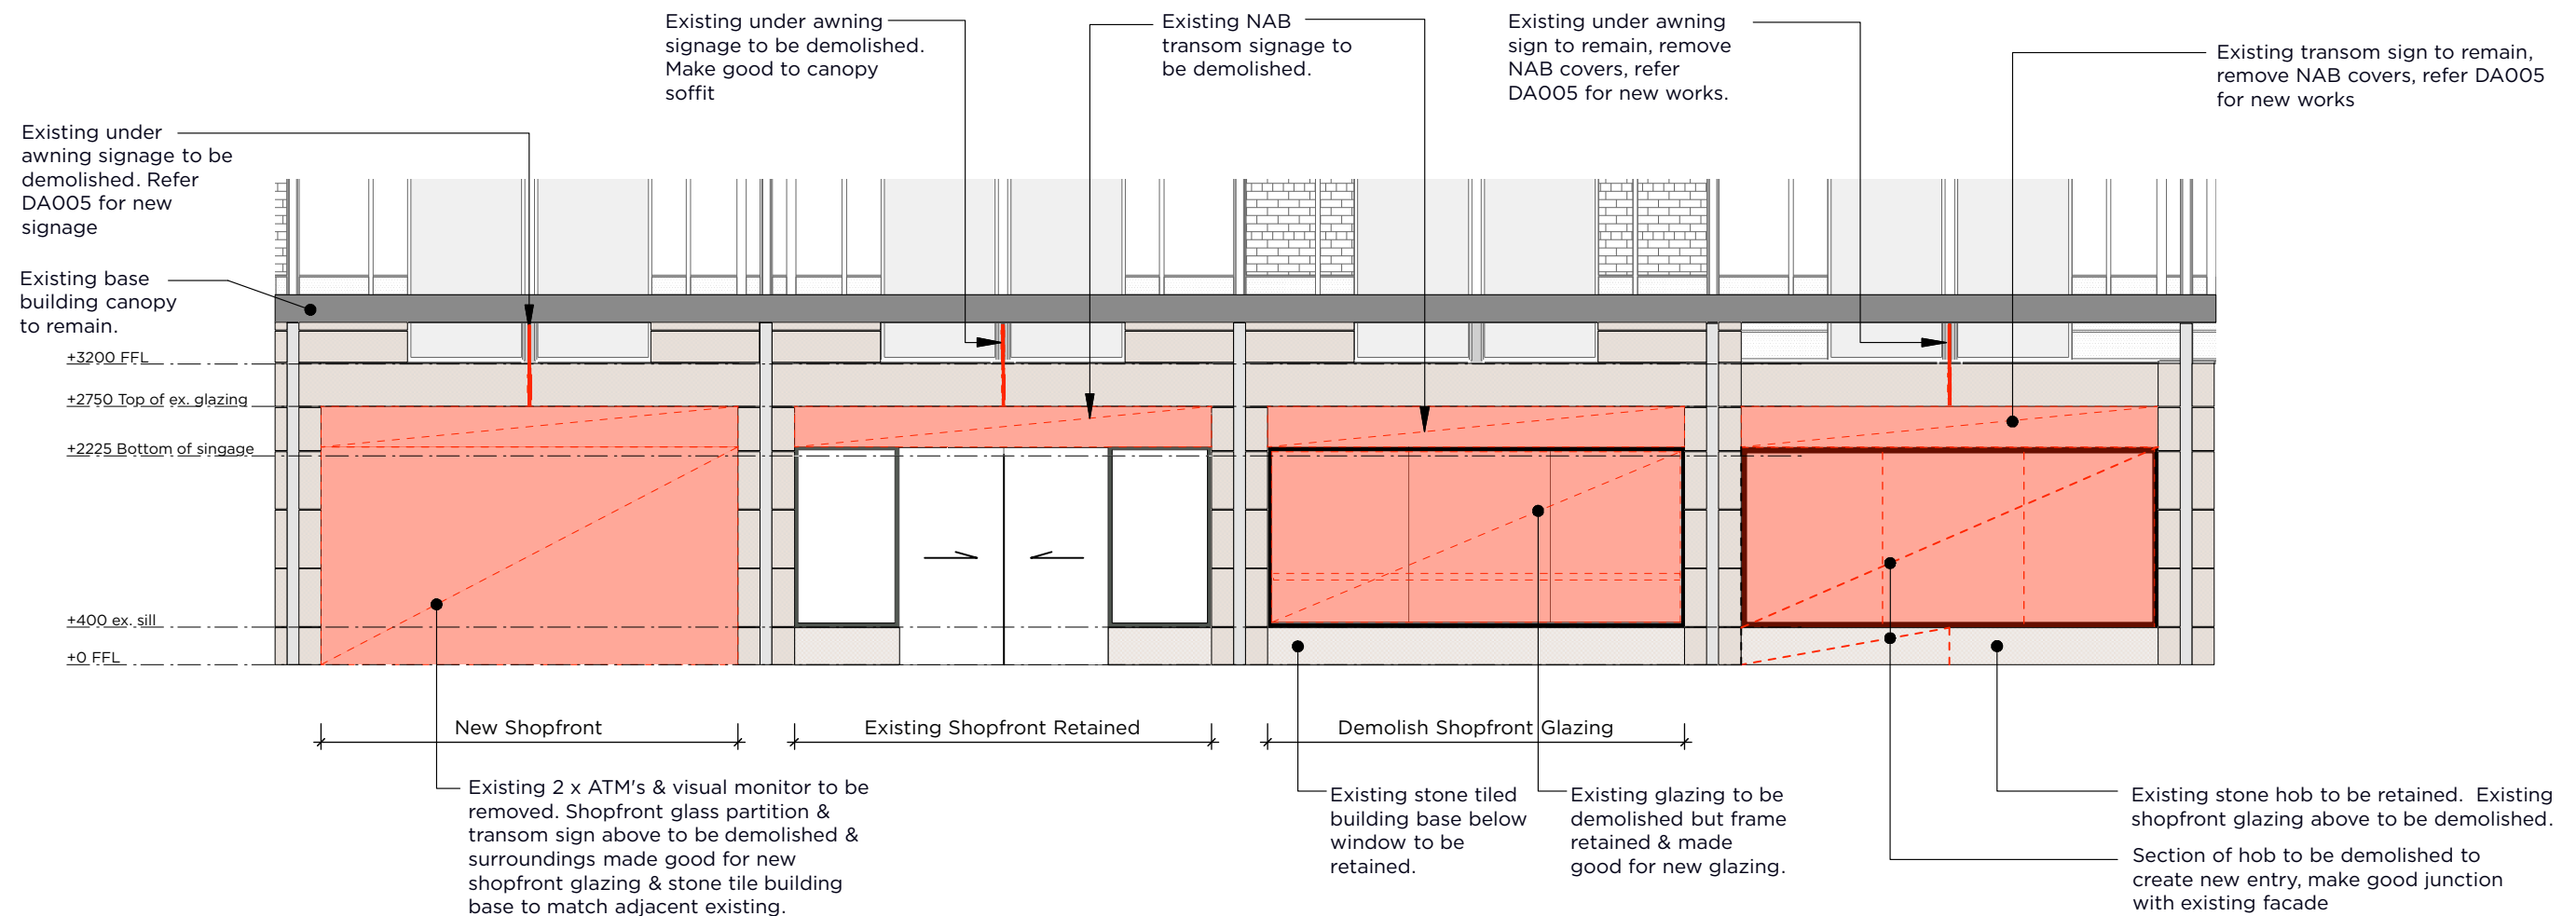

01 DEMOLITION EXTERNAL ELEVATION  
- NAB Manly  
Scale 1: 75

 northern beaches council

**THIS PLAN IS TO BE READ IN  
CONJUNCTION WITH  
THE CONDITIONS OF DEVELOPMENT  
CONSENT**

**DA2021/1574**



#### DEMOLITION NOTES:

1. Existing base building canopy to be retained & protected throughout the demolition process.
2. Make good to any base building structure impacted by demolition.


For Approval

**PMDL**  ARCHITECTURE  
INTERIORS  
MASTERPLANNING

**NAB Manly NSW**

**Demolition Elevation**

© PMDL pmdl.com.au Project 2997 Scale 1:75 @ A3 Date 26.08.21 Dwg DA004 B

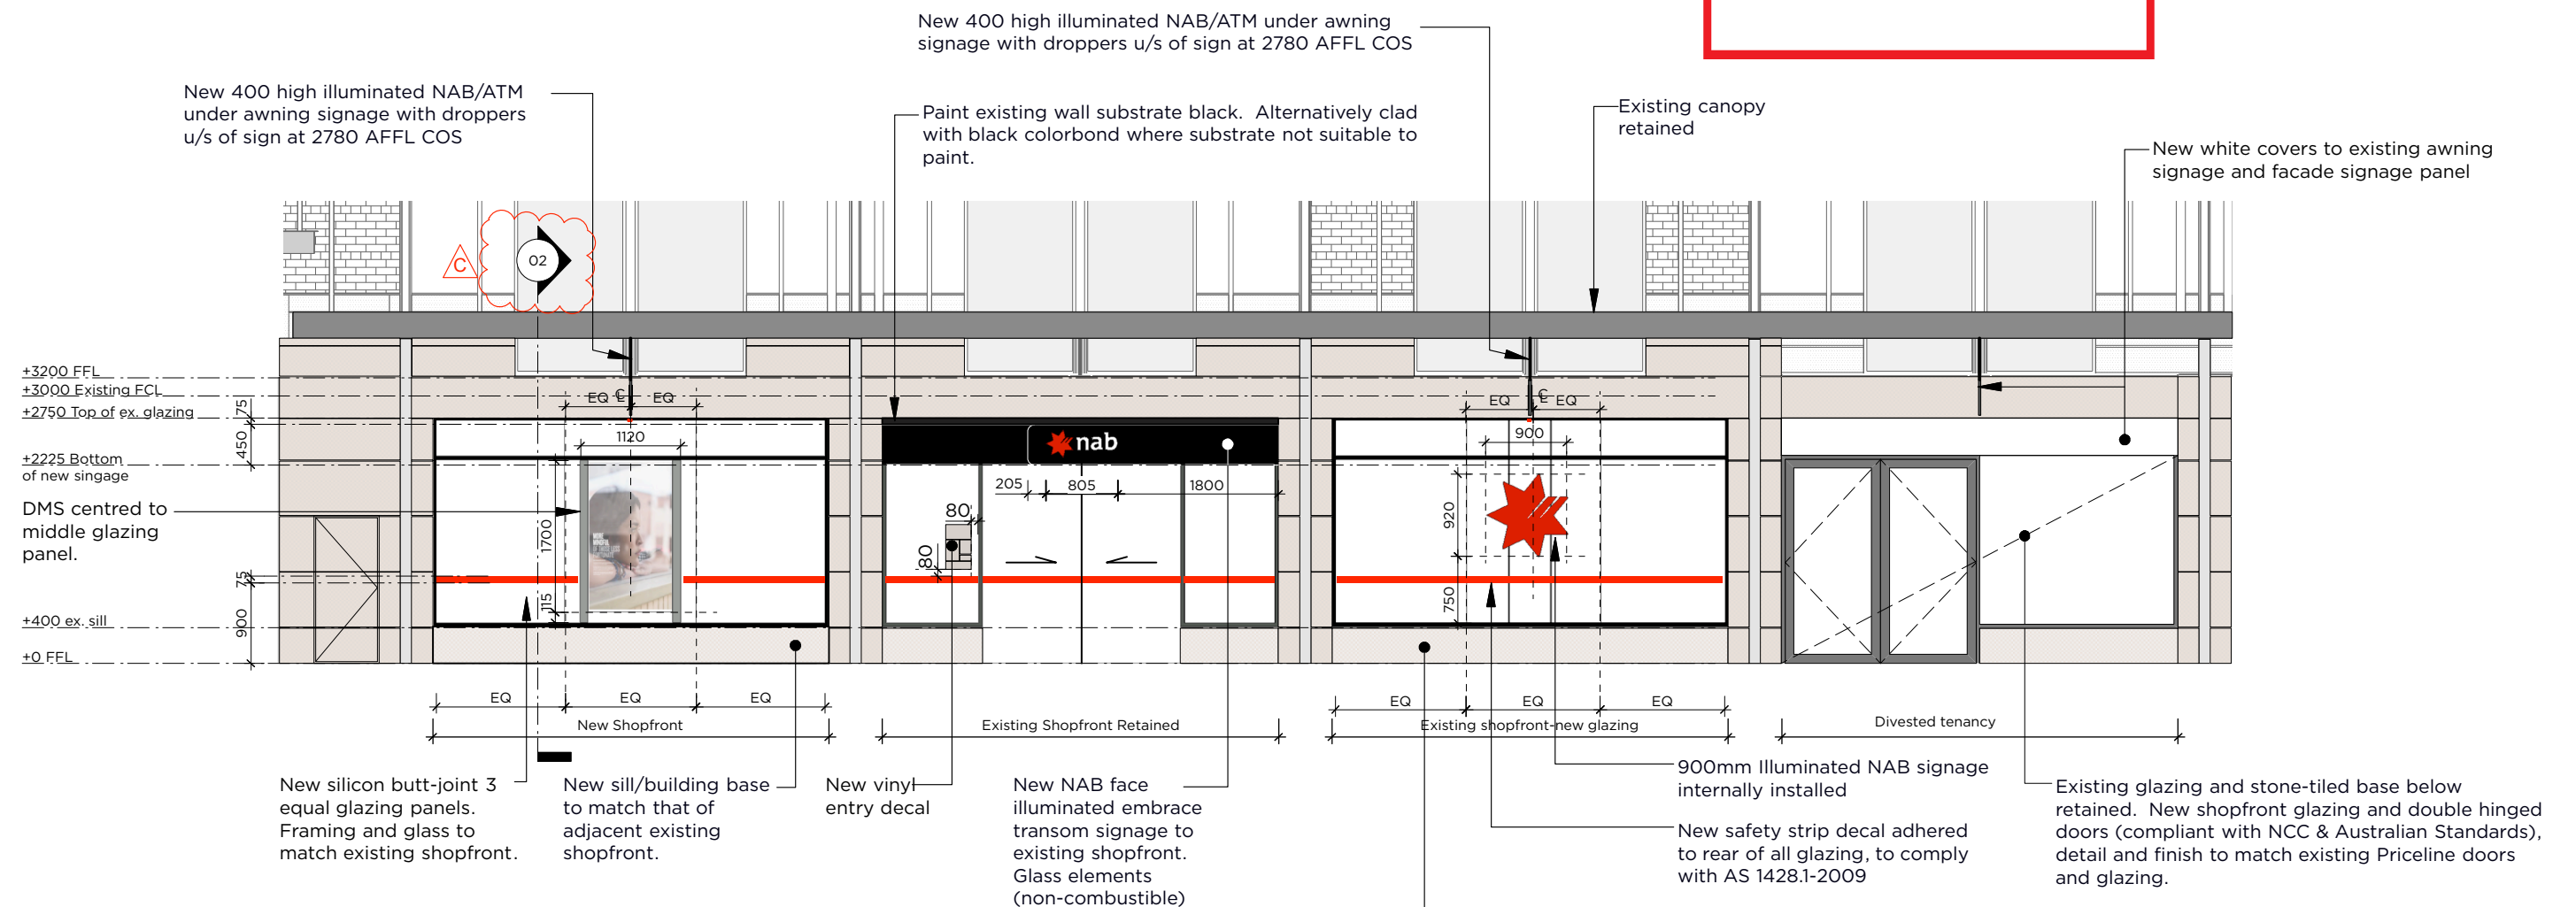

01

PROPOSED EXTERNAL ELEVATION


-

NAB Manly

Scale 1: 75

General Legend:

COS Confirm on site  
FFL Finished Floor Level  
EQ Equal  
DMS Digital Marketing Screen

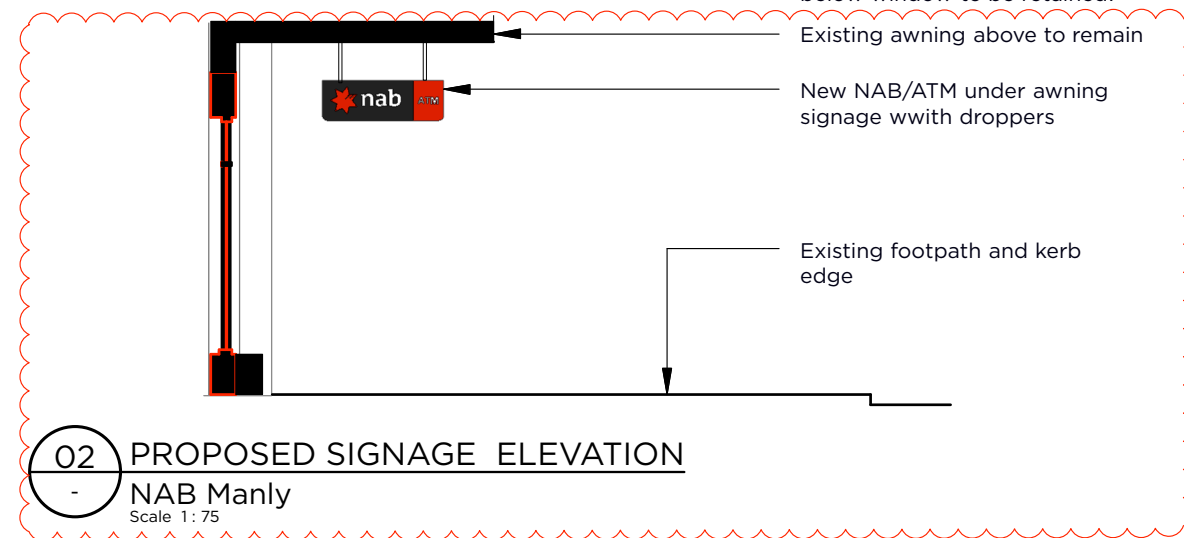

02

PROPOSED SIGNAGE ELEVATION

-

NAB Manly

Scale 1: 75

NOTES:

1. Base plan and all dimensions noted are referenced from Warren and Mahoney's As Built drawing number ID 7.01 rev 1, provided to PMDL by Lendlease. All dimenisons to be confirmed on site prior to commencement of works.

For Approval

PMDL ARCHITECTURE  
INTERIORS  
MASTERPLANNING

NAB Manly NSW

Proposed Elevation

© PMDL pmdl.com.au Project 2997 Scale 1:75 @ A3 Date 1.10.21 Dwg DA005 C