










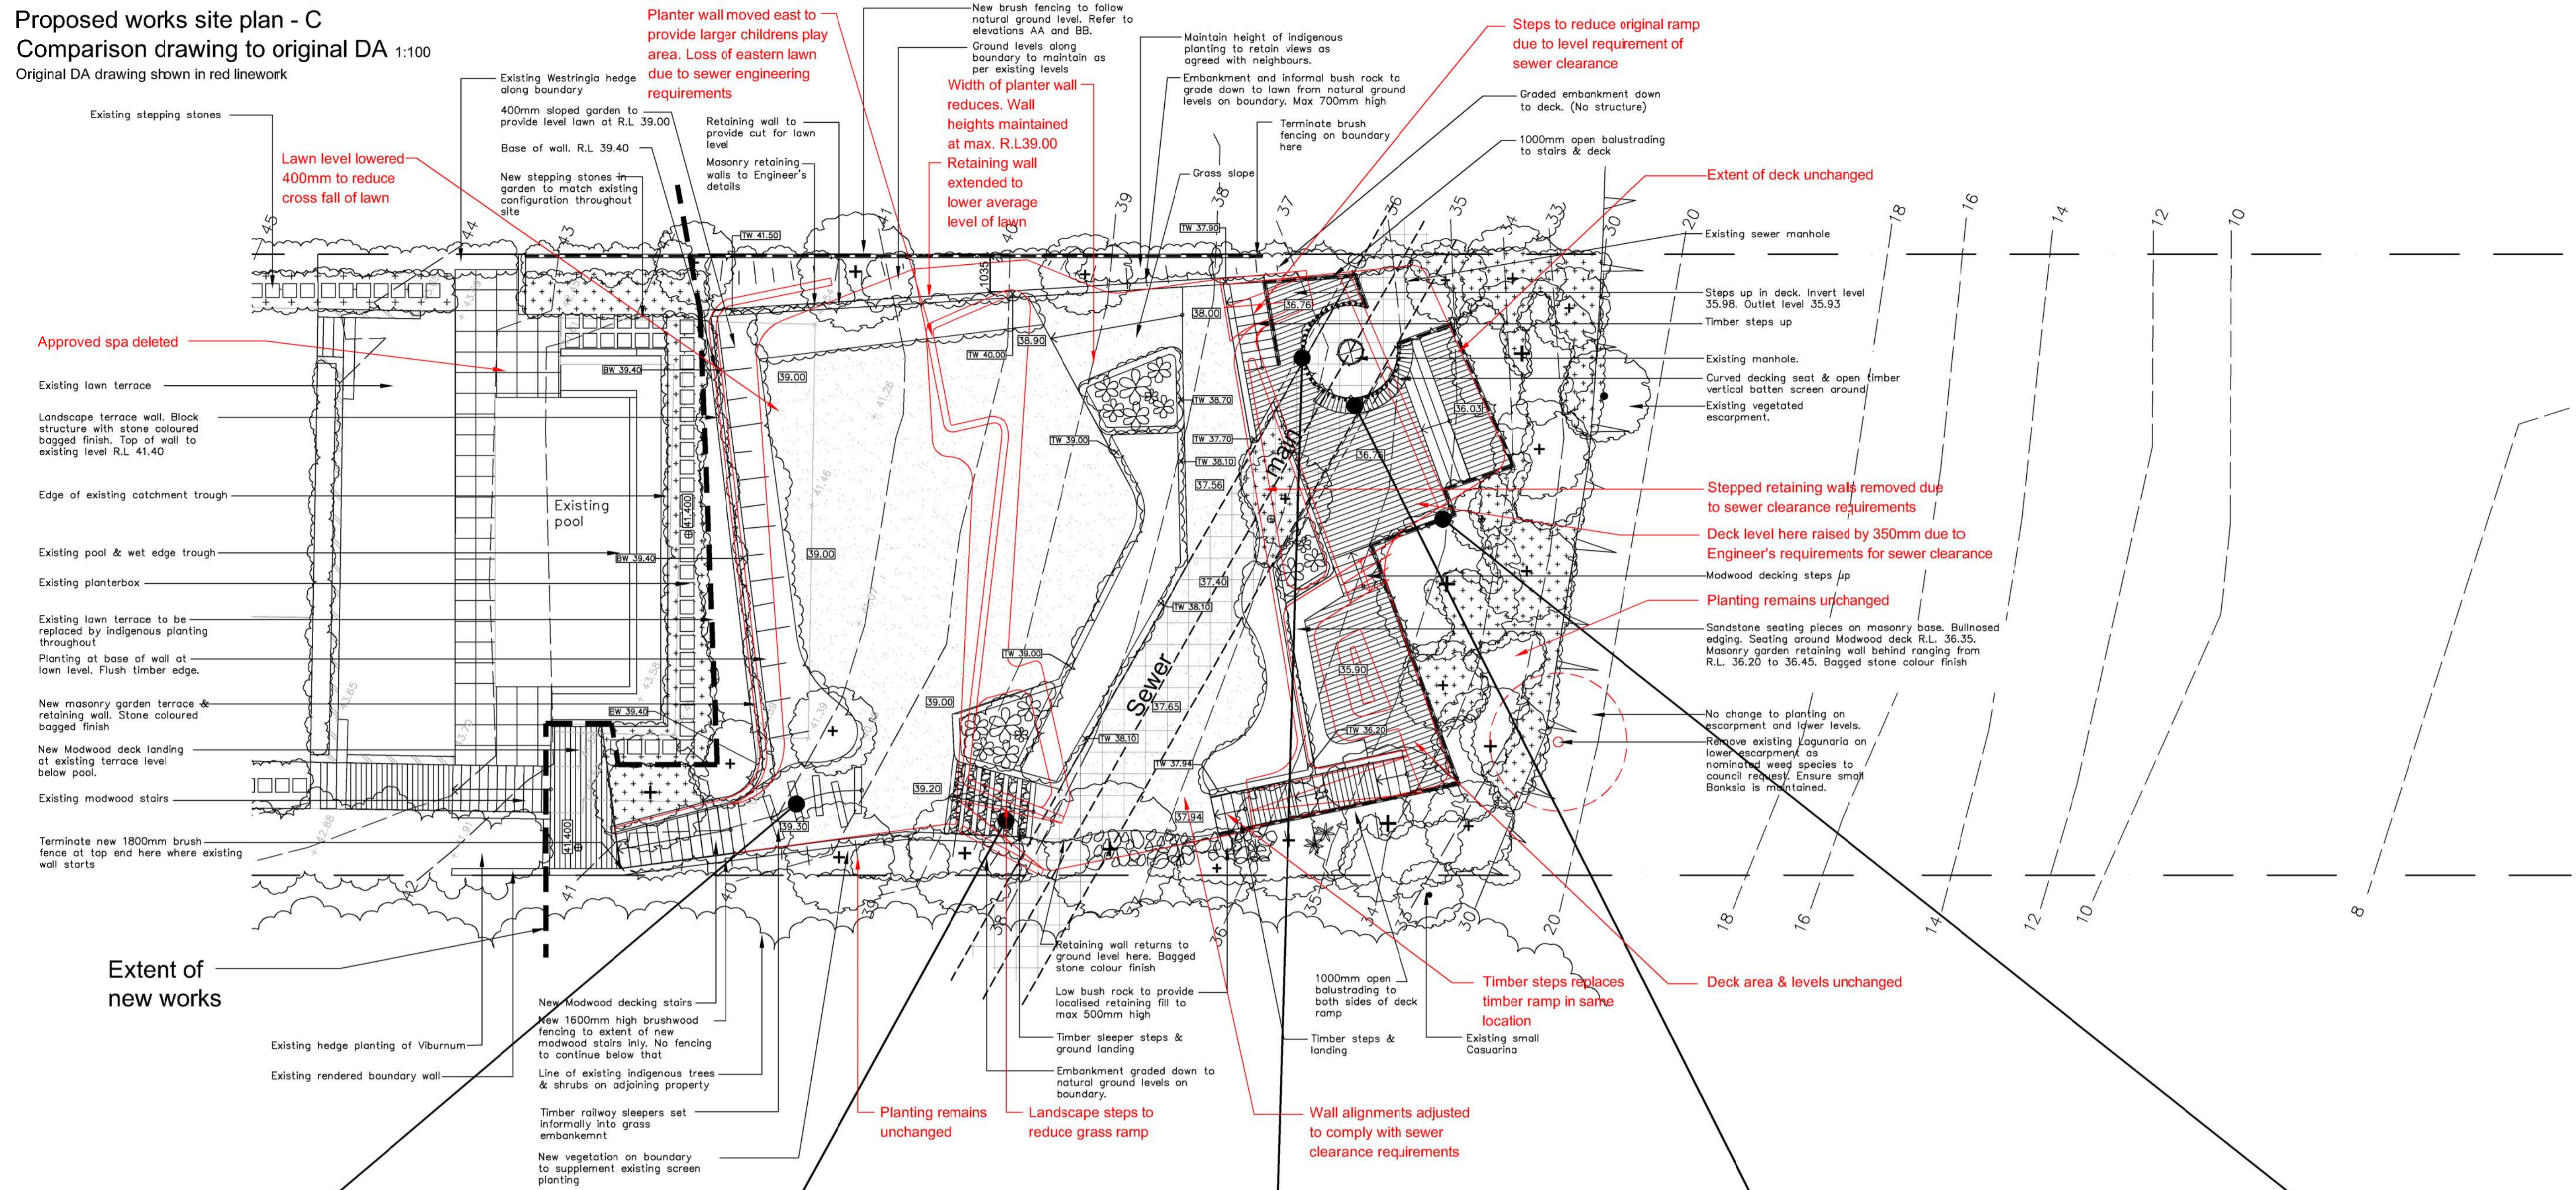









Proposed works site plan - C
Comparison drawing to original DA 1:100
Original DA drawing shown in red linework



Note: Red linework indicates
DA approved layout
Red text indicates
elements of current
proposal

Legend

| | | | | | | | | | |
|---|------------------------------|---|--------------|---|-------------------------------|---|----------------------|---|-------------------|
|  | Existing trees to be removed |  | Succulents |  | Stepping stones in garden bed |  | Balustrading/fence |  | Retaining walls |
|  | Existing trees |  | Shrubs |  | Steps up |  | Strip drainage grate |  | Existing contours |
|  | Proposed trees |  | Lawn areas |  | Tiles/pavers on concrete slab |  | Drainage pit |  | Proposed levels |
| | |  | Groundcovers |  | Modwood decking |  | Informal boulders | | |


Drawing schedule

Sheet 1: Site plan variation assessment



Sheet 2: Landscape site plan

Sheet 3: Planting plan

Scale 1:100



|  | PO Box 813 Newport NSW 2106 ABN: 18 283 821 389 | Date: 2.3.18 Job Ref: 17/64/L506 Issue: B | SCALE: 1:100 @ A1 SHEET NO: 1 OF 3 | | | | |
|---|---|--|---|-------|------------|---|------------------|
| | Phone: 02 9907 8011 Fax: 02 9948 9547 www.scrivener-design.com Email: paul@scrivener-design.com | | | | | | |
| PROJECT: MILLER RESIDENCE 190 BARRENDEY ROAD NEWPORT | DWG: SITE PLAN VARIATIONS ASSESSMENT | <p>Notes must comply with conditions of the easement no alterations. Figure dimensions should be used in preference to the value of Copyright is the property of Paul Scrivener AS, at all times. The copyright, design, artwork and information herein, are the property of copyright, other than. No part/patentable matter can/cannot be copied or it may be any matter in this document be used or reproduced without written permission.</p> <table border="1"><thead><tr><th>North</th><th>AMENDMENTS</th></tr></thead><tbody><tr><td></td><td> </td></tr></tbody></table> | | North | AMENDMENTS |  | |
| North | AMENDMENTS | | | | | | |
|  | | | | | | | |
| PAUL SCRIVENER LANDSCAPE ARCHITECT | | | | | | | |

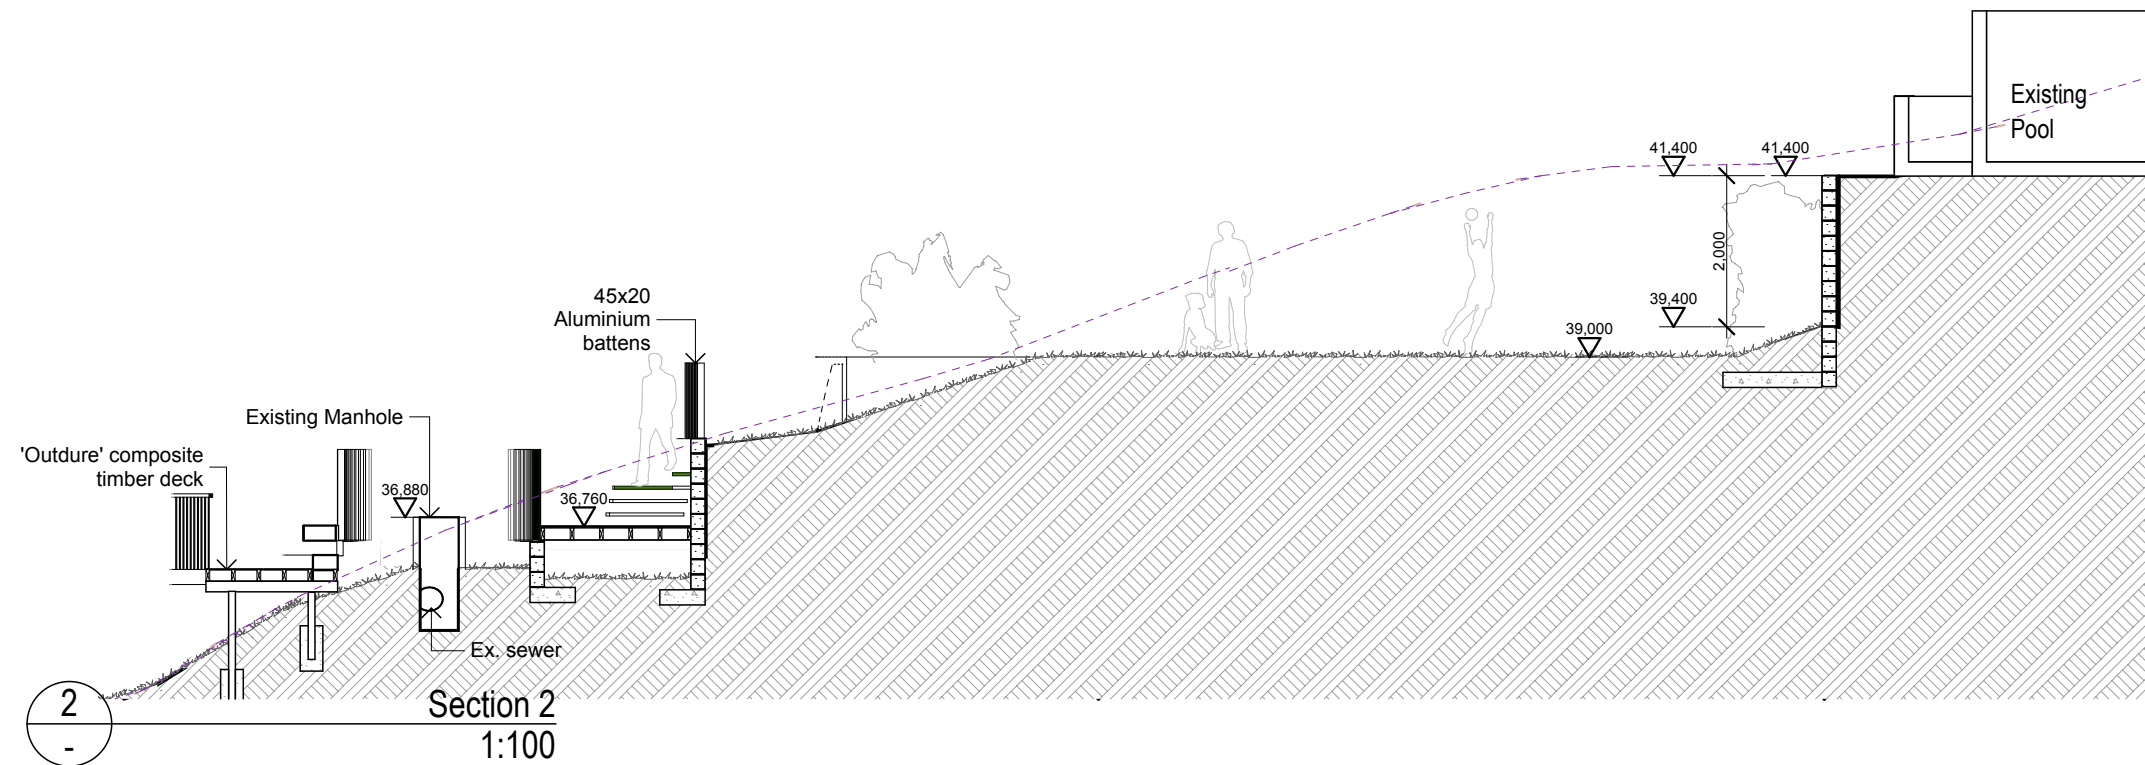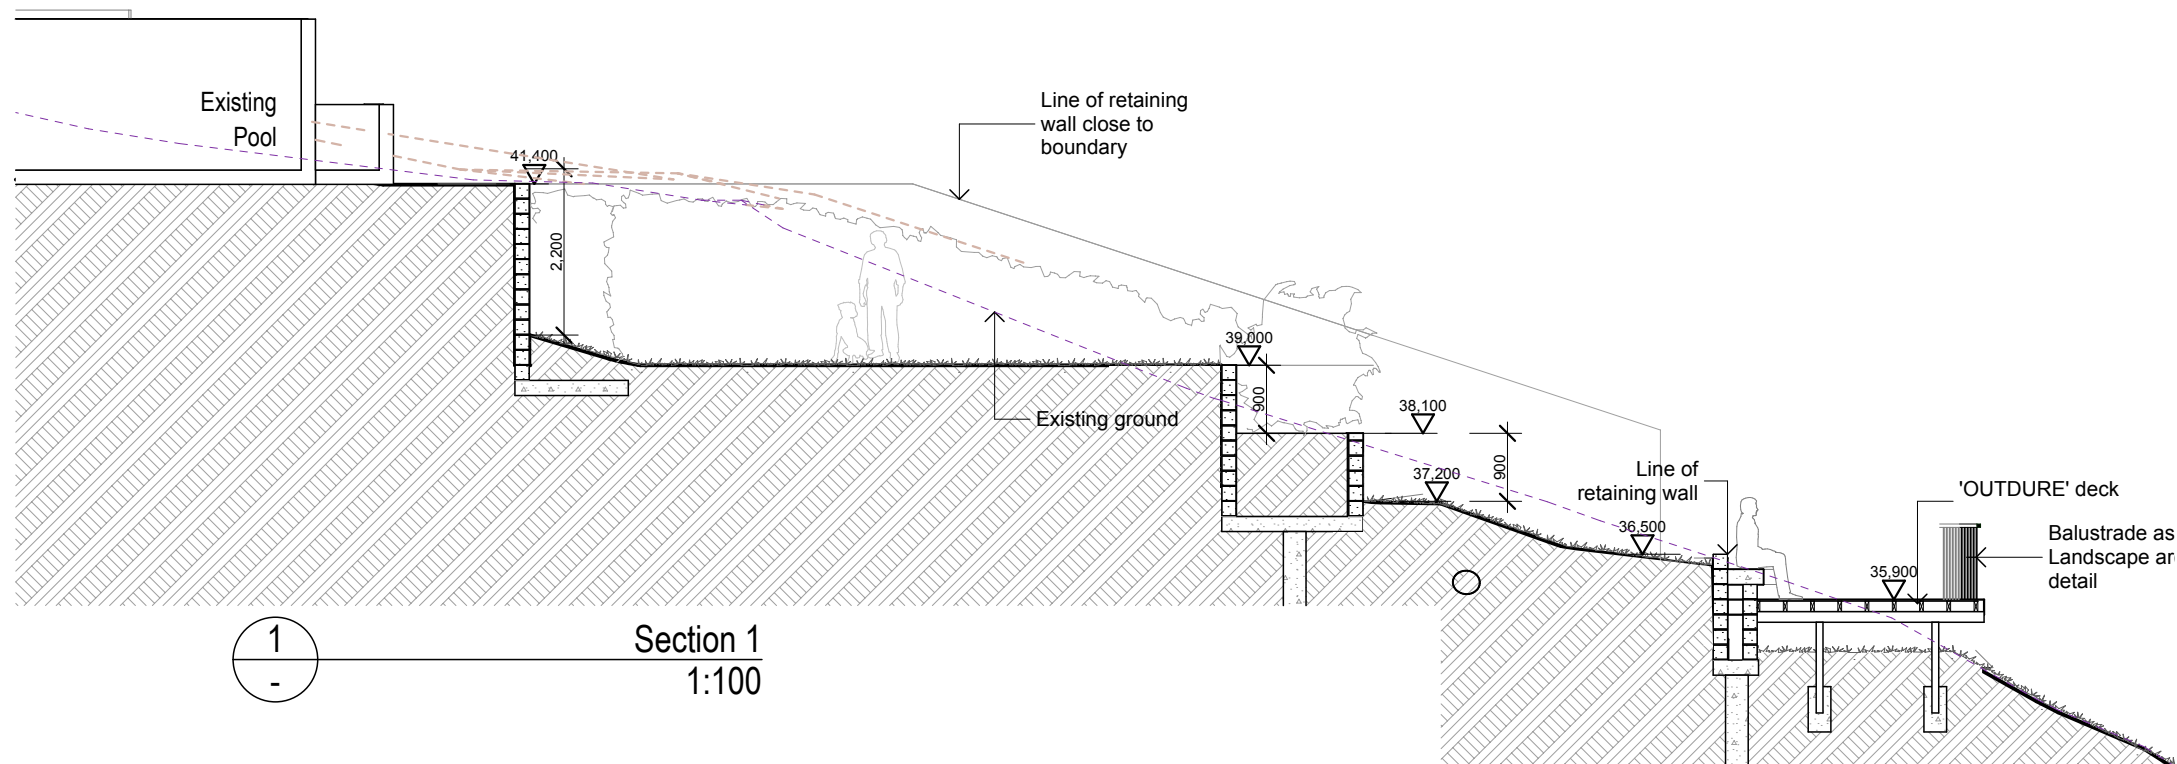

gvarchitecture

Gordon + Valich Pty Ltd
Level 3 Suite 315 30-40 Harcourt Parade
Rosebery NSW 2018 T: + 61 2 8338 9004

www.gordonvalich.com.au

AMENDMENTS:
NOT FOR CONSTRUCTION

| REV | DESCRIPTION | DATE |
|-----|-----------------------|----------|
| a | S96 Application Issue | 01-03/17 |

**SECTION 96
ONLY**
NOT FOR CONSTRUCTION

Project Name

NEW LANDSCAPE

Site Address

**190 BARRENJOEY ROAD
NEWPORT
NSW 2106**

DRAWN BY:
AS

APPROVED BY
Nominated Architect Furio Valich ARBN 3317

/Volumes/acadodd/1709_190Barrenjoey Road_Landscape IA/S96/1709_190BarrenjoeyRd_S96.pln
PLOT: Thursday, 1 March 2018 5:42 pm

The builder will check and verify all dimensions and report all errors and omissions to the Architect. Drawings not to be used for construction purposes until issued marked "For Construction". Do not scale the drawings use figured dimensions. Drawings Copyright 2016 Gordon Valich Architecture Pty.Ltd.

Date:
1/3/18

Scale:
as noted

Status:
Amended Design


DRAWING TITLE:
BACKYARD LANDSCAPE - Sections

Project No:
1511

Drawing No.:

S96-3.1

ISSUE:
AS NOTED

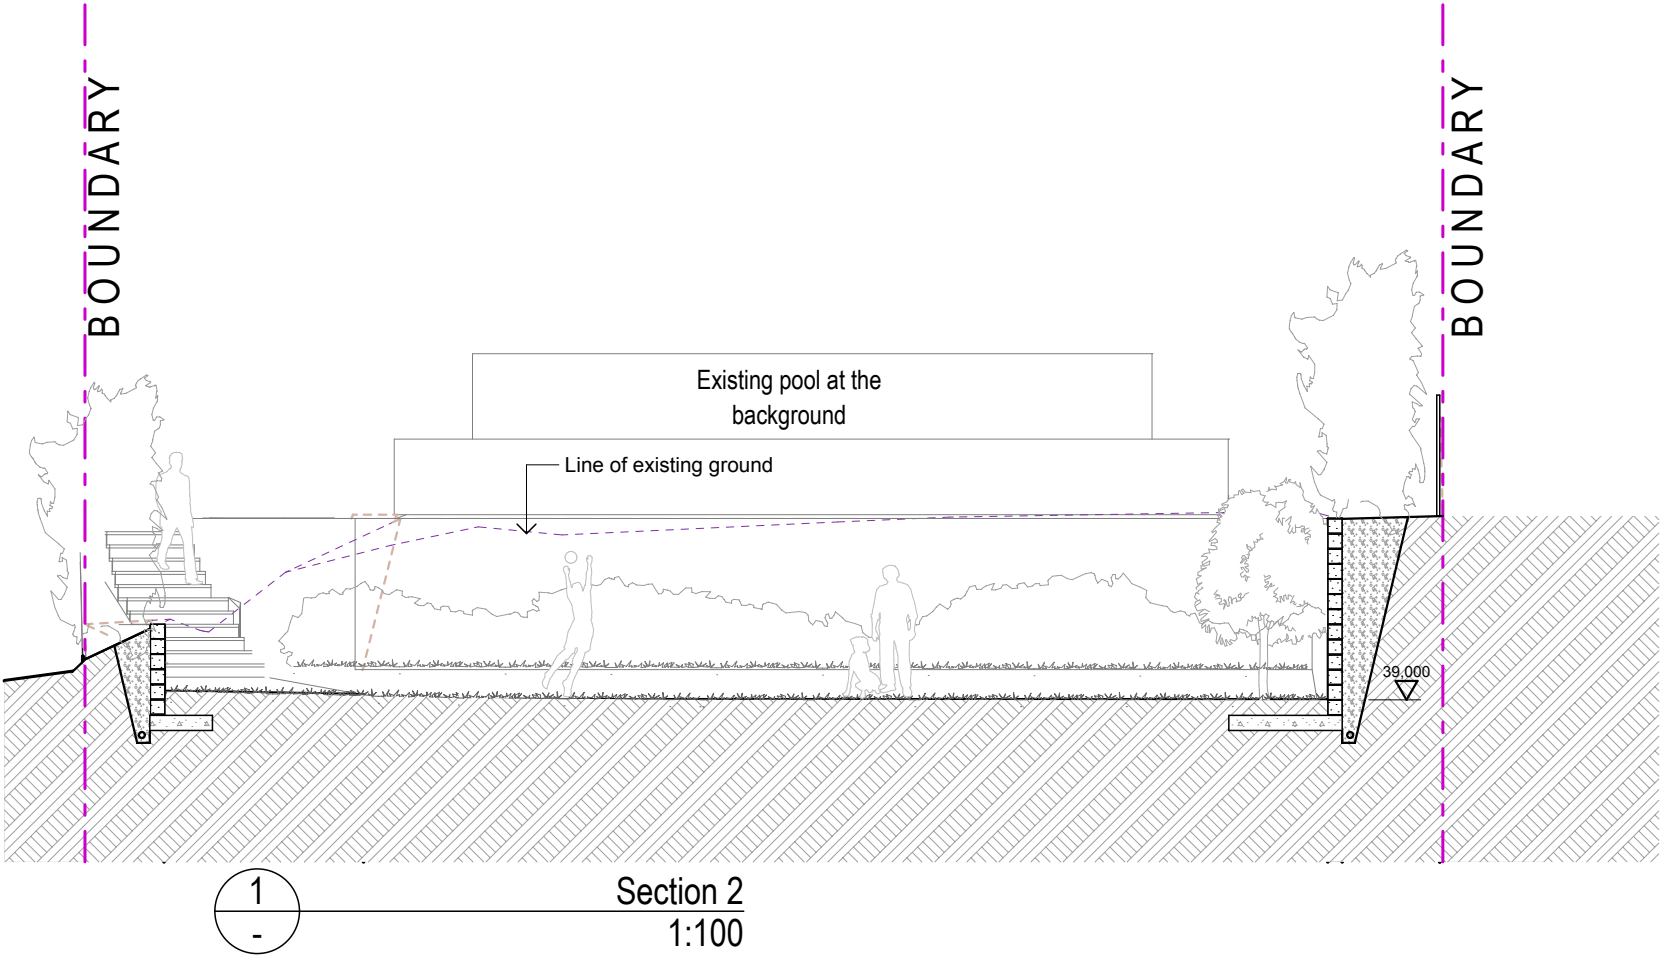

gv architecture

Gordon + Valich Pty Ltd
Level 3 Suite 315 30-40 Harcourt Parade
Rosebery NSW 2018 T: + 61 2 8338 9004

www.gordonvalich.com.au

AMENDMENTS:
NOT FOR CONSTRUCTION

a S96 Application Issue 01-03/17
REV DESCRIPTION DATE

SECTION 96
ONLY
NOT FOR CONSTRUCTION

Project Name

NEW LANDSCAPE

Site Address

190 BARRENJOEY ROAD
NEWPORT
NSW 2106

DRAWN BY:
AS

Date:

1/3/18

Scale:

as noted

Status:

Amended Design

APPROVED BY

Nominated Architect Furio Valich ARBN 3317

/Volumes/acadodd/17/09_190Barrenjoey Road_Landscape IA/S96/1709_190BarrenjoeyRd_S96.pln
PLOT: Thursday, 1 March 2018 5:42 pm

The builder will check and verify all dimensions and report all errors and omissions to the Architect. Drawings not to be used for construction purposes until issued marked "For Construction" Do not scale the drawings use figured dimensions. Drawings Copyright 2016 Gordon Valich Architecture Pty.Ltd.

DRAWING TITLE:

BACKYARD LANDSCAPE - Section

Project No:

1511

Drawing No.:

S96-3.2

ISSUE:

AS NOTED