

PROPOSED SENIORS HOUSING

6 DWELLINGS, BASEMENT CARPARKING & ASSOCIATED LANDSCAPING

54 BARDO RD, NEWPORT, NSW 2106

DRAWING LIST

Drawing No.	Drawing Name	Current Revision	Current Revision Date
DA001	COVER PAGE	N	11/02/22
DA002	DEMOLITION PLAN	H	11/02/22
DA003	SITE ANALYSIS	J	11/02/22
DA005	SITE PLAN	J	11/02/22
DA006	BASEMENT PLAN	R	11/02/22
DA007	GROUND FLOOR PLAN	T	11/02/22
DA008	LEVEL 1 PLAN	Q	11/02/22
DA009	ROOF PLAN	K	11/02/22
DA010	NORTH & WEST ELEVATIONS	L	11/02/22
DA011	SOUTH & EAST ELEVATIONS	K	11/02/22
DA012	SECTION AA & BB	J	11/02/22
DA013	SECTION CC & DD	J	11/02/22
DA014	LANDSCAPE CALCULATION PLAN	M	11/02/22
DA015	DEEP SOIL PLAN	L	11/02/22
DA016	GFA CALCULATIONS	K	11/02/22
DA017	SHADOW DIAGRAMS	I	11/02/22
DA018	SOLAR DIAGRAMS	I	11/02/22
DA019	WINDOW SCHEDULE	G	11/02/22


UNIT NUMBER	ROOM TYPE	AREA	EXTERNAL/POS /BALCONY AREA (m ²)
G01	2 BED	93.3 m ²	50.6
G02	3 BED	113.7 m ²	143.6
G03	3 BED	111.4 m ²	86.1
G04	2 BED	93.8 m ²	88.6
101	2 BED	97.5 m ²	10.4
102	3 BED	118.4 m ²	12.8

YIELD

GROUND FLOOR GFA	448.78m ²
LEVEL 1 GFA	239.29m ²
TOTAL GFA	688.07m ²
SITE AREA	1226.32m ²
FSR	0.561:1

No.	Date	Description
N	11/02/22	ISSUED FOR S4.56(1) APPROVAL
M	08/10/21	ISSUED FOR S4.56(1) APPROVAL
L	01/04/21	ISSUED FOR APPROVAL
K	16/03/21	ISSUED FOR APPROVAL
J	03/09/20	ISSUED FOR APPROVAL
I	01/09/20	ISSUED FOR COORDINATION
H	31/08/20	ISSUED FOR COORDINATION
G	24/08/20	ISSUED FOR COORDINATION
F	21/08/20	ISSUED FOR COORDINATION; ACCESS COMMENTS INCORPORATED, BASEMENT AMENDED, WINDOW TAGS ADDED
E	20/08/20	ISSUED FOR COORDINATION; REVISED PLANNING ITEMS
D	18/08/20	ISSUED FOR COORDINATION
C	29/07/20	ISSUED FOR PRE-DA MEETING
B	24/07/20	ISSUED FOR INFORMATION
A	23/06/20	ISSUED FOR INFORMATION

Amendments



Level 1, 1 Chandos Street
ST LEONARDS NSW 2066
P 61 2 9254 5005
E gtr@gilestribe.com.au
Giles Tribe Pty Ltd ABN 50 001259 507
Mark G Broadley (3823) Stuart D Hill (6459)

Verify all dimensions on site prior to commencement of work.
Refer all discrepancies to the Architect for determination.
Use figured dimensions in preference to scaling.
This drawing is copyright and must not be retained, copied or used without the written consent of Giles Tribe Architects.

Client:
Built Property


Project:
**54 BARDO ROAD
NEWPORT 2106
NSW**

Drawing:
COVER PAGE


Status:
FOR S4.56(1) APPROVAL

Scale: Job No. Drawing No. Rev.
Sheet Size: A1
Date: 01/25/07 **20055 DA001 N**
Drawn: YL Reviewed: VY

G:\GILES\TRIBE-3\Drawings\01\2020\005501 - Rev054_Bardo Rd, Newport, NSW\02_09_24_S4.56(1).rvt

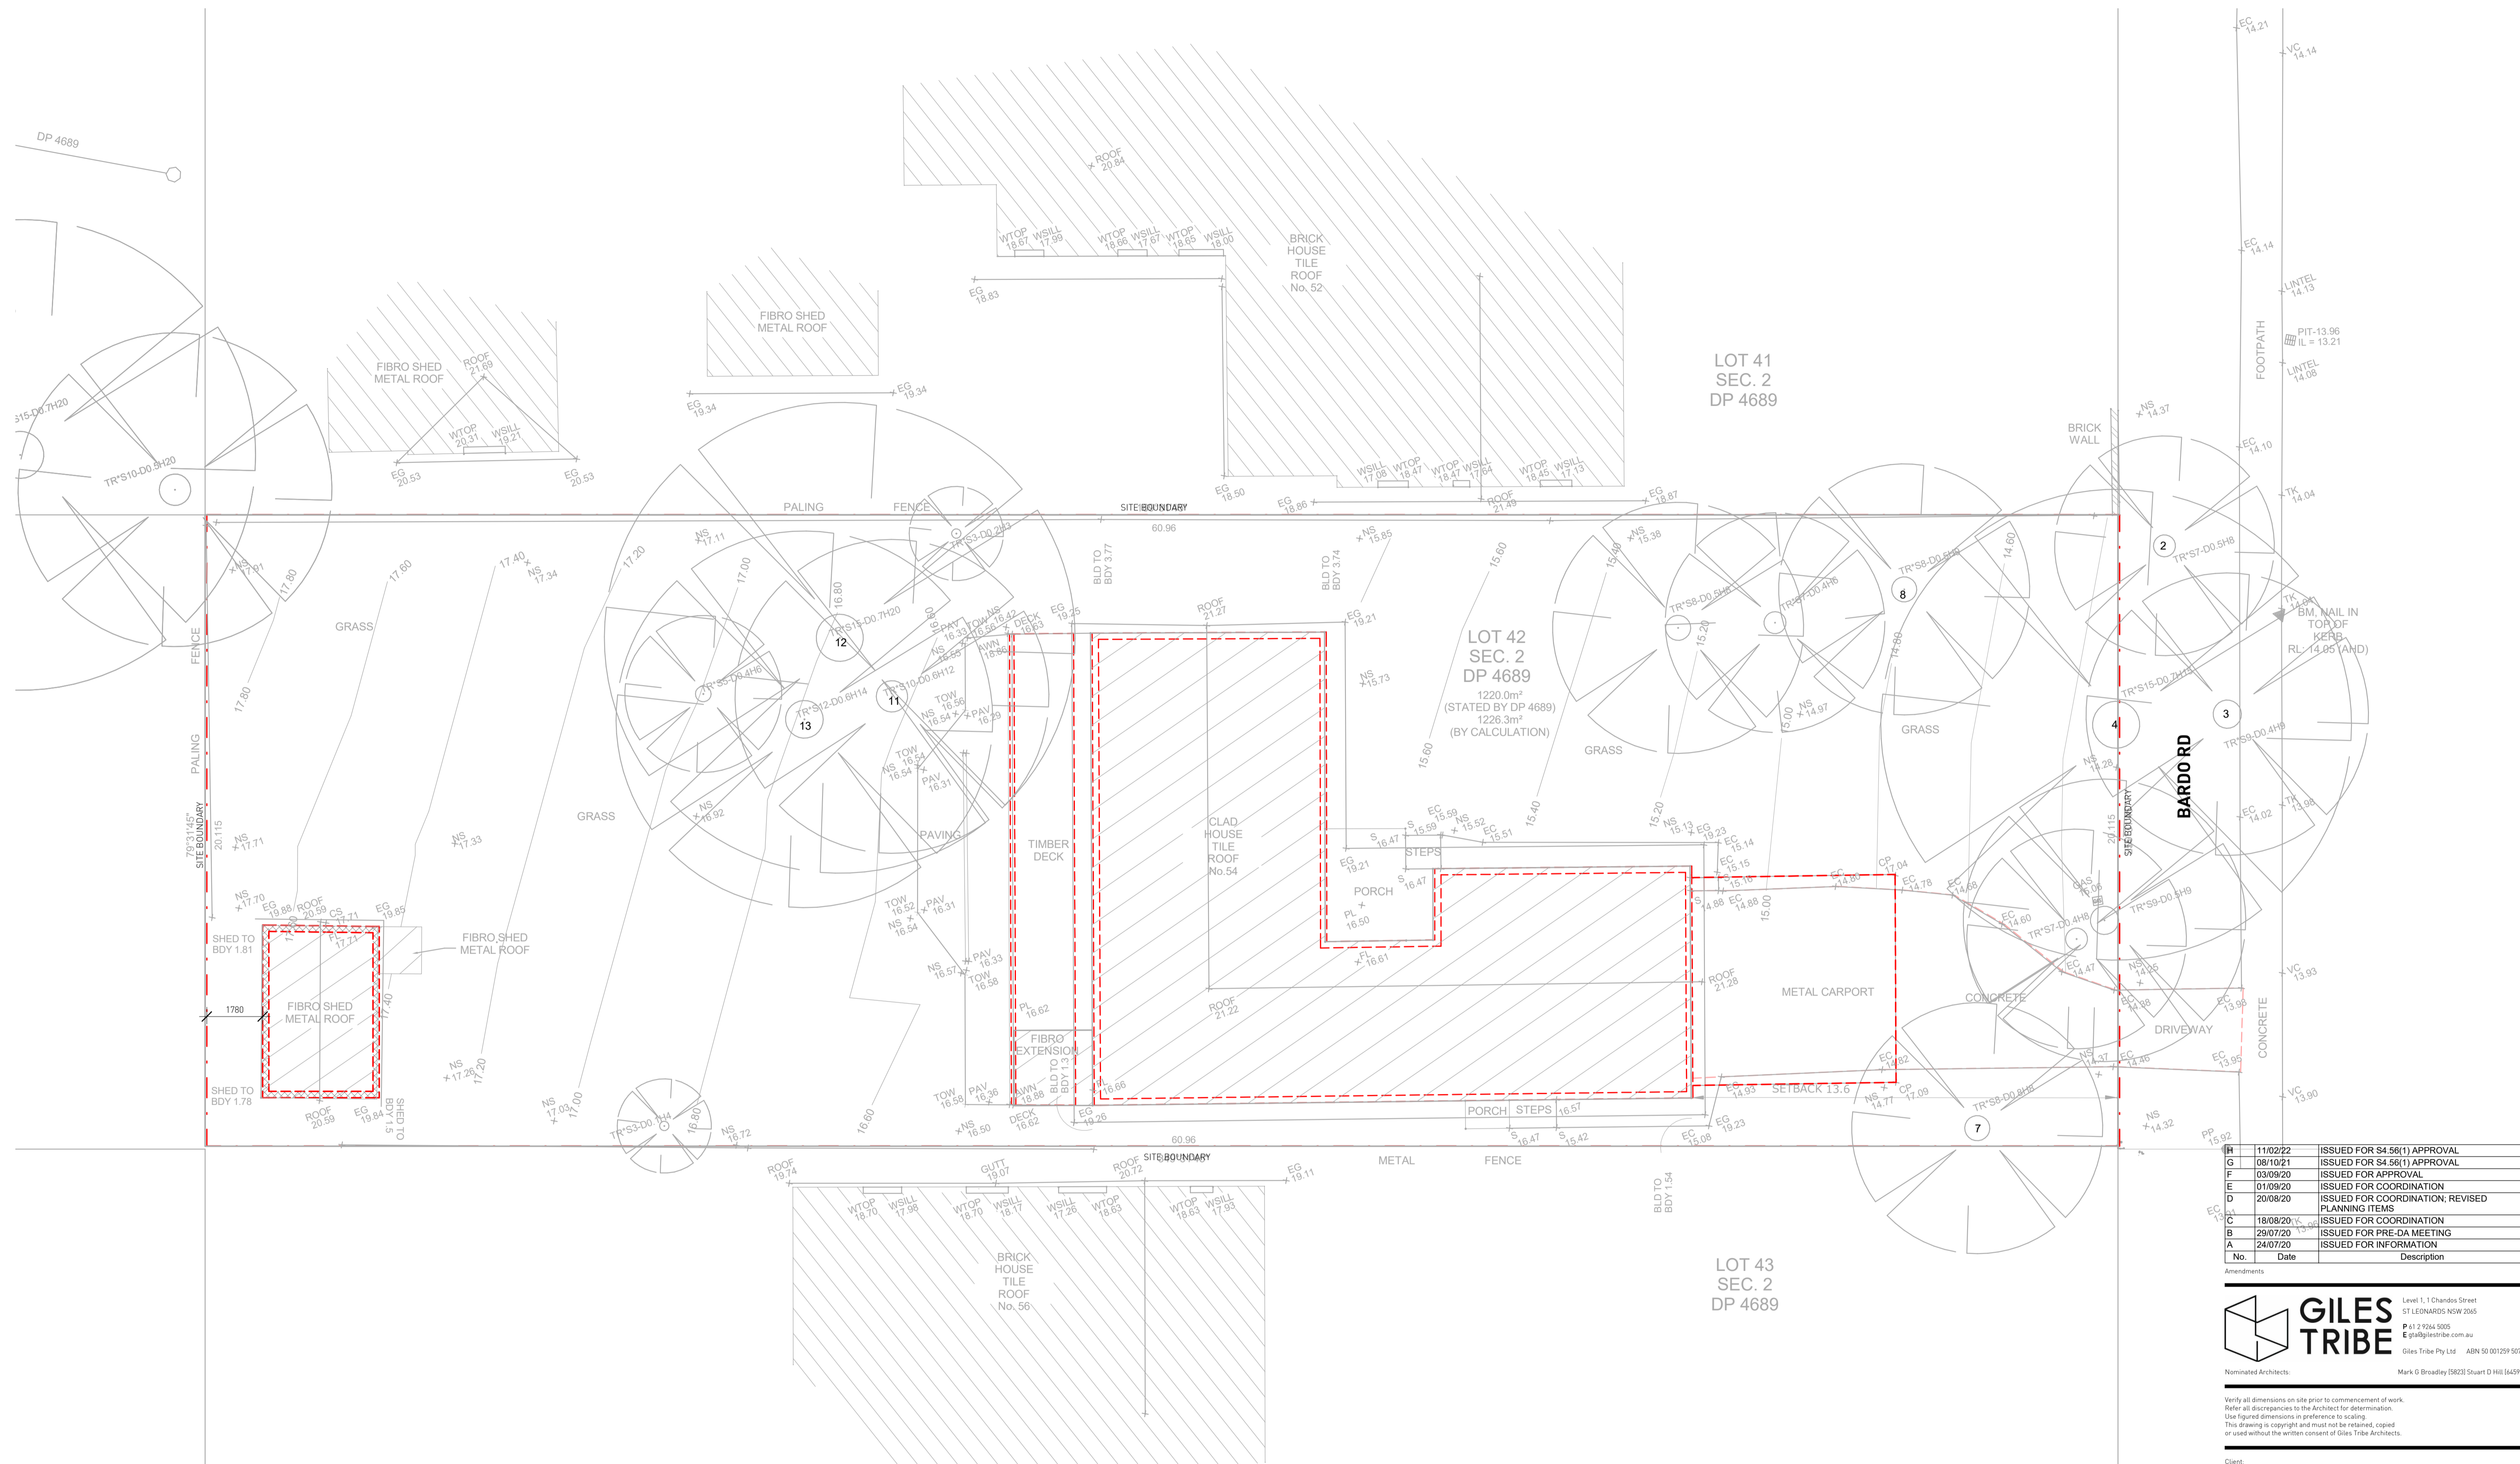

1 DEMOLITION PLAN
DA002 1 : 100

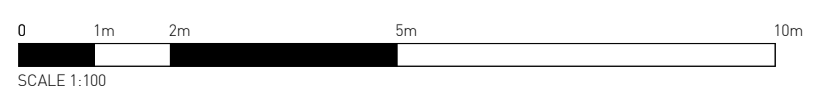

No.	Date	Description
H	11/02/22	ISSUED FOR S4.56(1) APPROVAL
G	08/10/21	ISSUED FOR S4.56(1) APPROVAL
F	03/09/20	ISSUED FOR APPROVAL
E	01/09/20	ISSUED FOR COORDINATION
D	20/08/20	ISSUED FOR COORDINATION, REVISED PLANNING ITEMS
C	18/08/20	ISSUED FOR COORDINATION
B	29/07/20	ISSUED FOR PRE-DA MEETING
A	24/07/20	ISSUED FOR INFORMATION

GILES TRIBE Level 1, 1 Chandos Street
ST LEONARDS NSW 2065
P 61 2 9254 5005
E gtr@gilestribe.com.au
Giles Tribe Pty Ltd ABN 50 001259 507
Nominated Architects: Mark G Broadley (3823) Stuart D Hill (6459)

Verify all dimensions on site prior to commencement of work.
Refer all discrepancies to the Architect for determination.
Use figured dimensions in preference to scaling.
This drawing is copyright and must not be retained, copied, or used without the written consent of Giles Tribe Architects.


Built Property
Project
**54 BARDO ROAD
NEWPORT 2106
NSW**

DEMOLITION PLAN

Status: **FOR S4.56(1) APPROVAL**

Scale: 1 : 100 Job No. Drawing No. Rev.
Sheet Size: A1 **20055 DA002 H**
Date: 06/19/20 Drawn: YL Reviewed: VY

V:\GILES\TRIBE\Drawings\2020\2005501_2\Rev054_Bardo_Rd_Newport_NSW\019_54_56(1).rvt

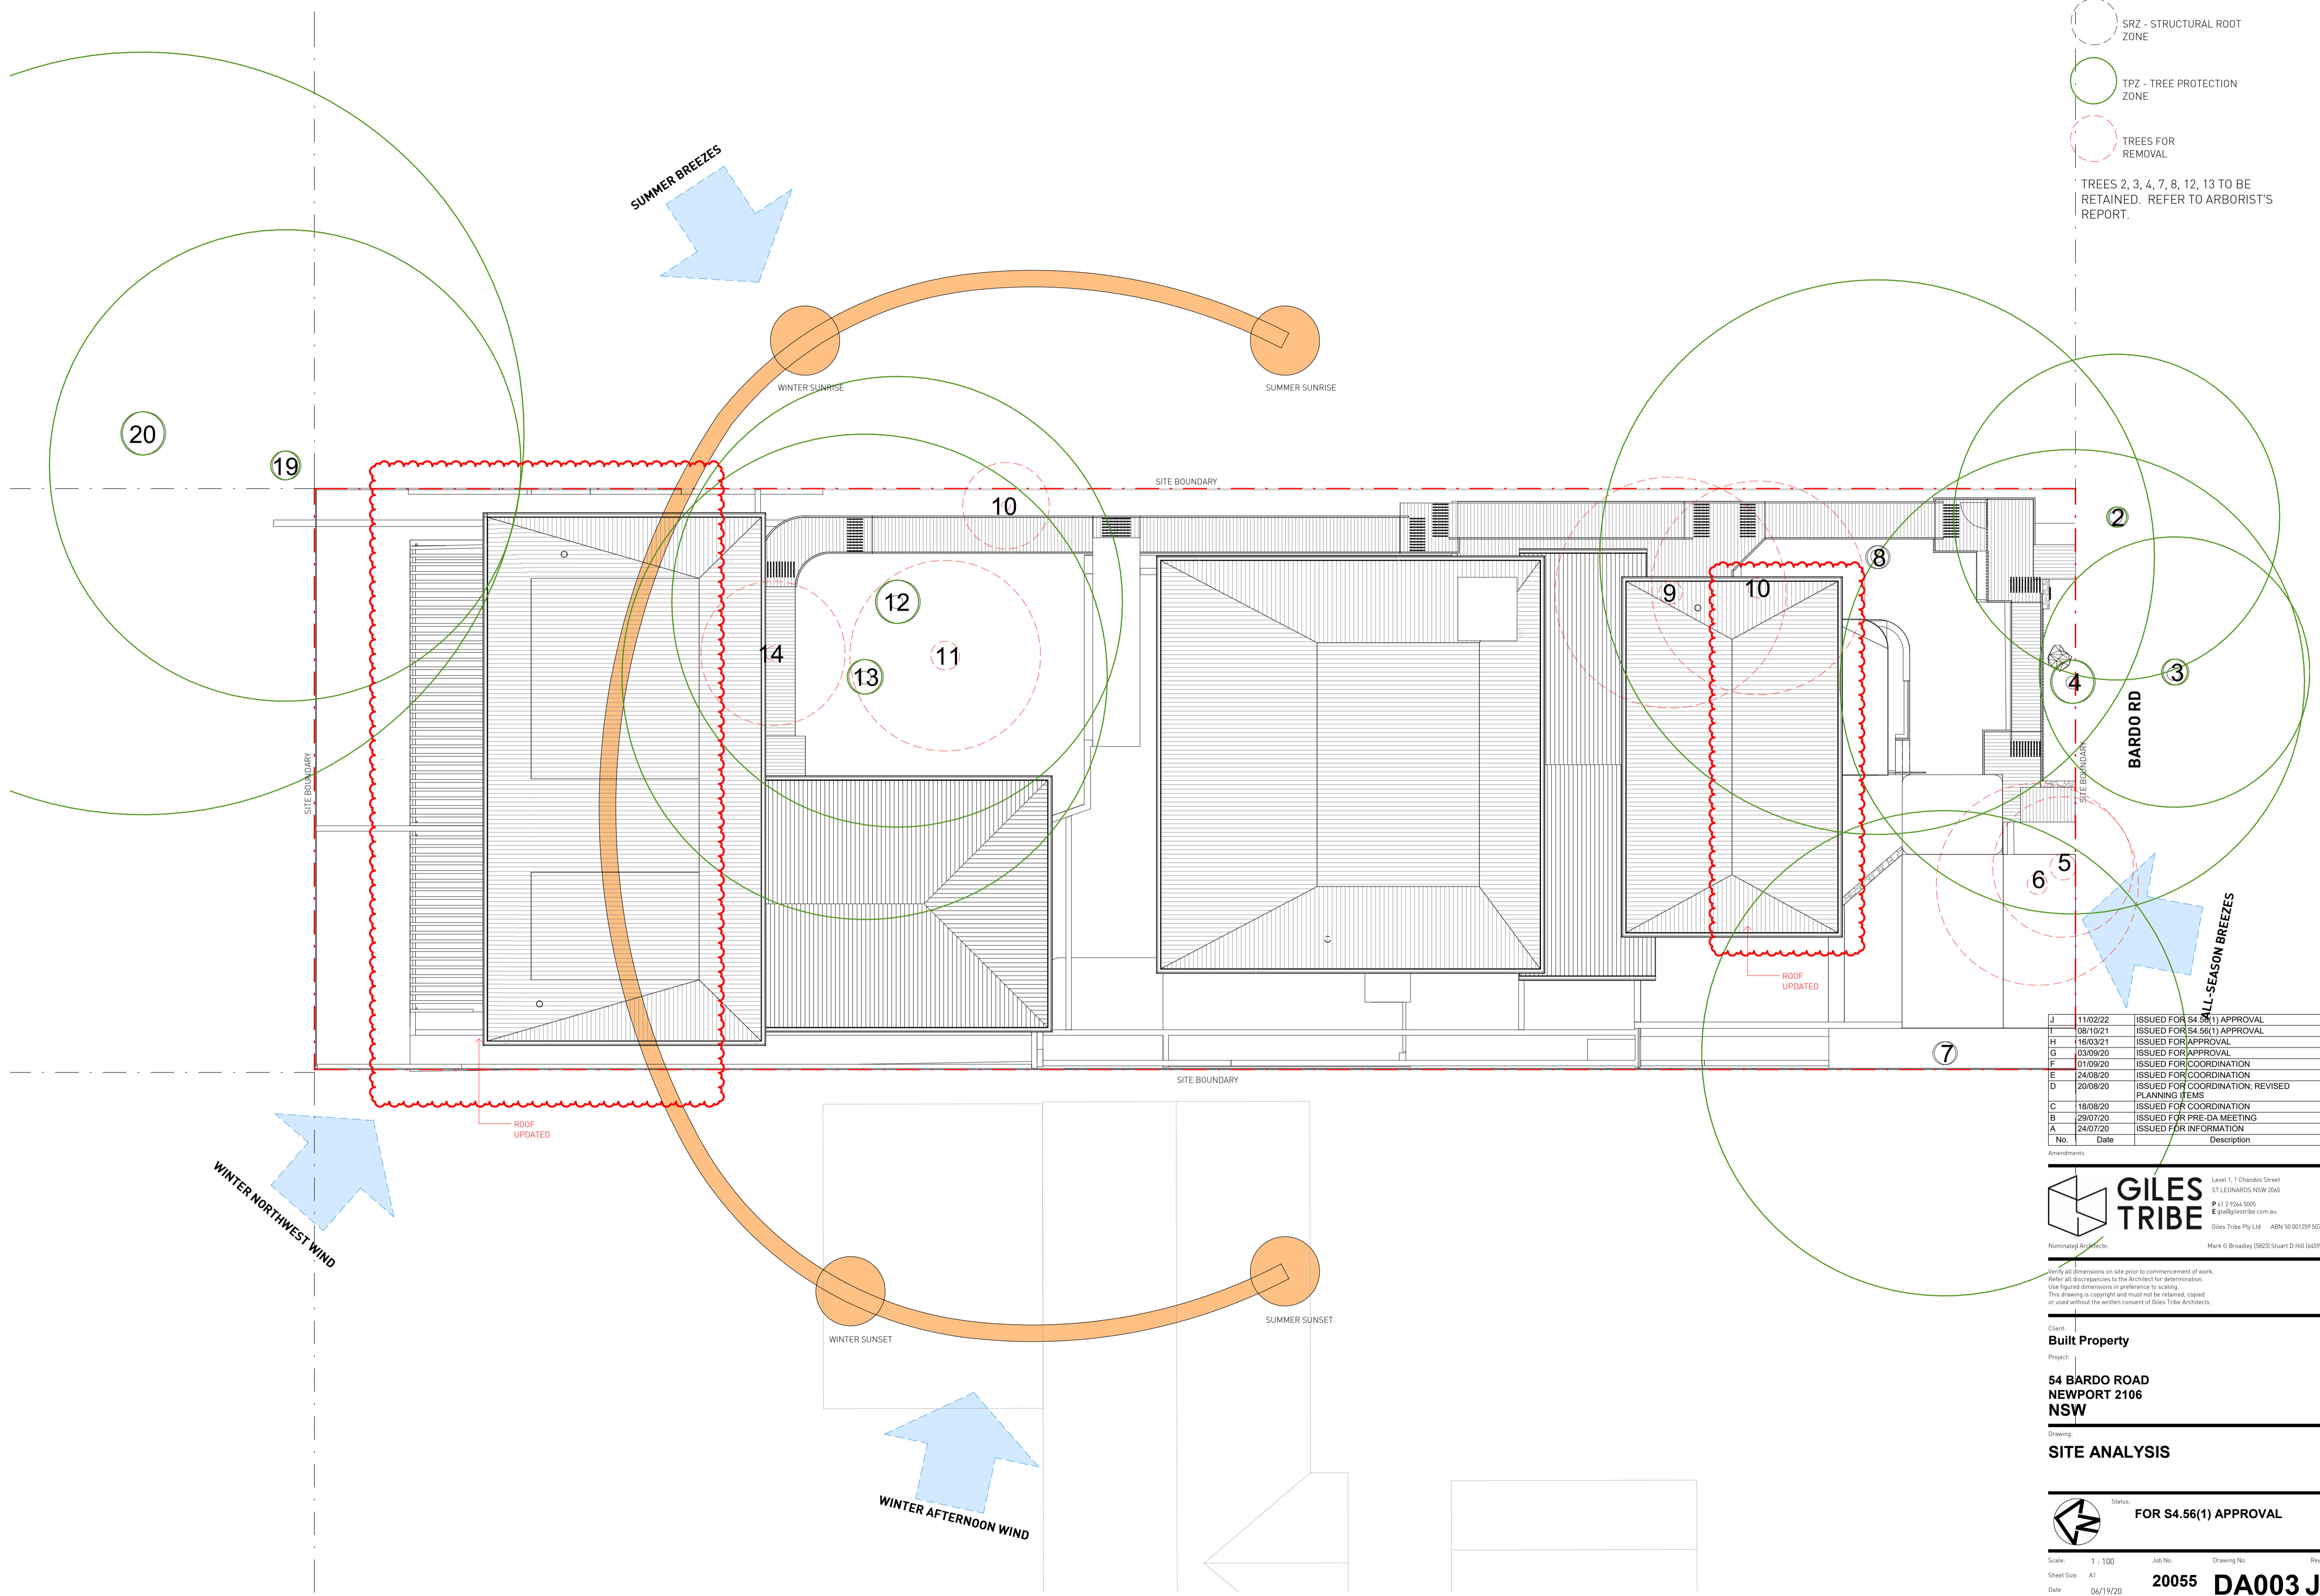

SRZ - STRUCTURAL ROOT ZONE
 TPZ - TREE PROTECTION ZONE
 TREES FOR REMOVAL
 TREES 2, 3, 4, 7, 8, 12, 13 TO BE RETAINED. REFER TO ARBORIST'S REPORT.

No.	Date	Description
J	11/03/22	ISSUED FOR S4.56(1) APPROVAL
I	08/10/21	ISSUED FOR S4.56(1) APPROVAL
H	16/03/21	ISSUED FOR APPROVAL
G	03/09/20	ISSUED FOR APPROVAL
F	01/09/20	ISSUED FOR COORDINATION
E	24/08/20	ISSUED FOR COORDINATION
D	20/08/20	ISSUED FOR COORDINATION, REVISED PLANNING ITEMS
C	18/08/20	ISSUED FOR COORDINATION
B	29/07/20	ISSUED FOR PRE-DA MEETING
A	24/07/20	ISSUED FOR INFORMATION

GILES TRIBE Level 1, 1 Chandos Street
 ST LEONARDS NSW 2065
 P 61 2 9254 5005
 E gtr@gilestribe.com.au
 Giles Tribe Pty Ltd ABN 50 801259 507

Nominating Architects: Mark G Broadley (3623) Stuart D Hill (6459)


Verify all dimensions on site prior to commencement of work.
 Refer all discrepancies to the Architect for determination.
 Use figured dimensions in preference to scaling.
 This drawing is copyright and must not be retained, copied or used without the written consent of Giles Tribe Architects.

Client: **Built Property**
 Project: **54 BARDO ROAD NEWPORT 2106 NSW**




SITE ANALYSIS


Status: **FOR S4.56(1) APPROVAL**

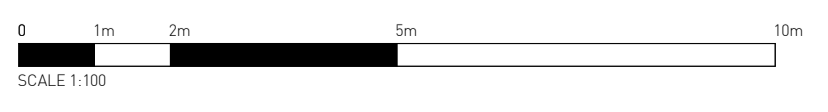Scale: 1 : 100 Job No. Drawing No. Rev.
 Sheet Size: A1 **20055 DA003 J**
 Date: 06/19/20 Drawn: YL Reviewed: VY



V:\GILES\TRIBE - 3\Drawings\19\20055\061920\061920_Rev004_Bardo Rd, Newport, NSW\019_54_56(1).rvt

-  SRZ - STRUCTURAL ROOT ZONE
 -  TPZ - TREE PROTECTION ZONE
 -  TREES FOR REMOVAL
- TREES 2, 3, 4, 7, 8, 12, 13 TO BE RETAINED. REFER TO ARBORIST'S REPORT.

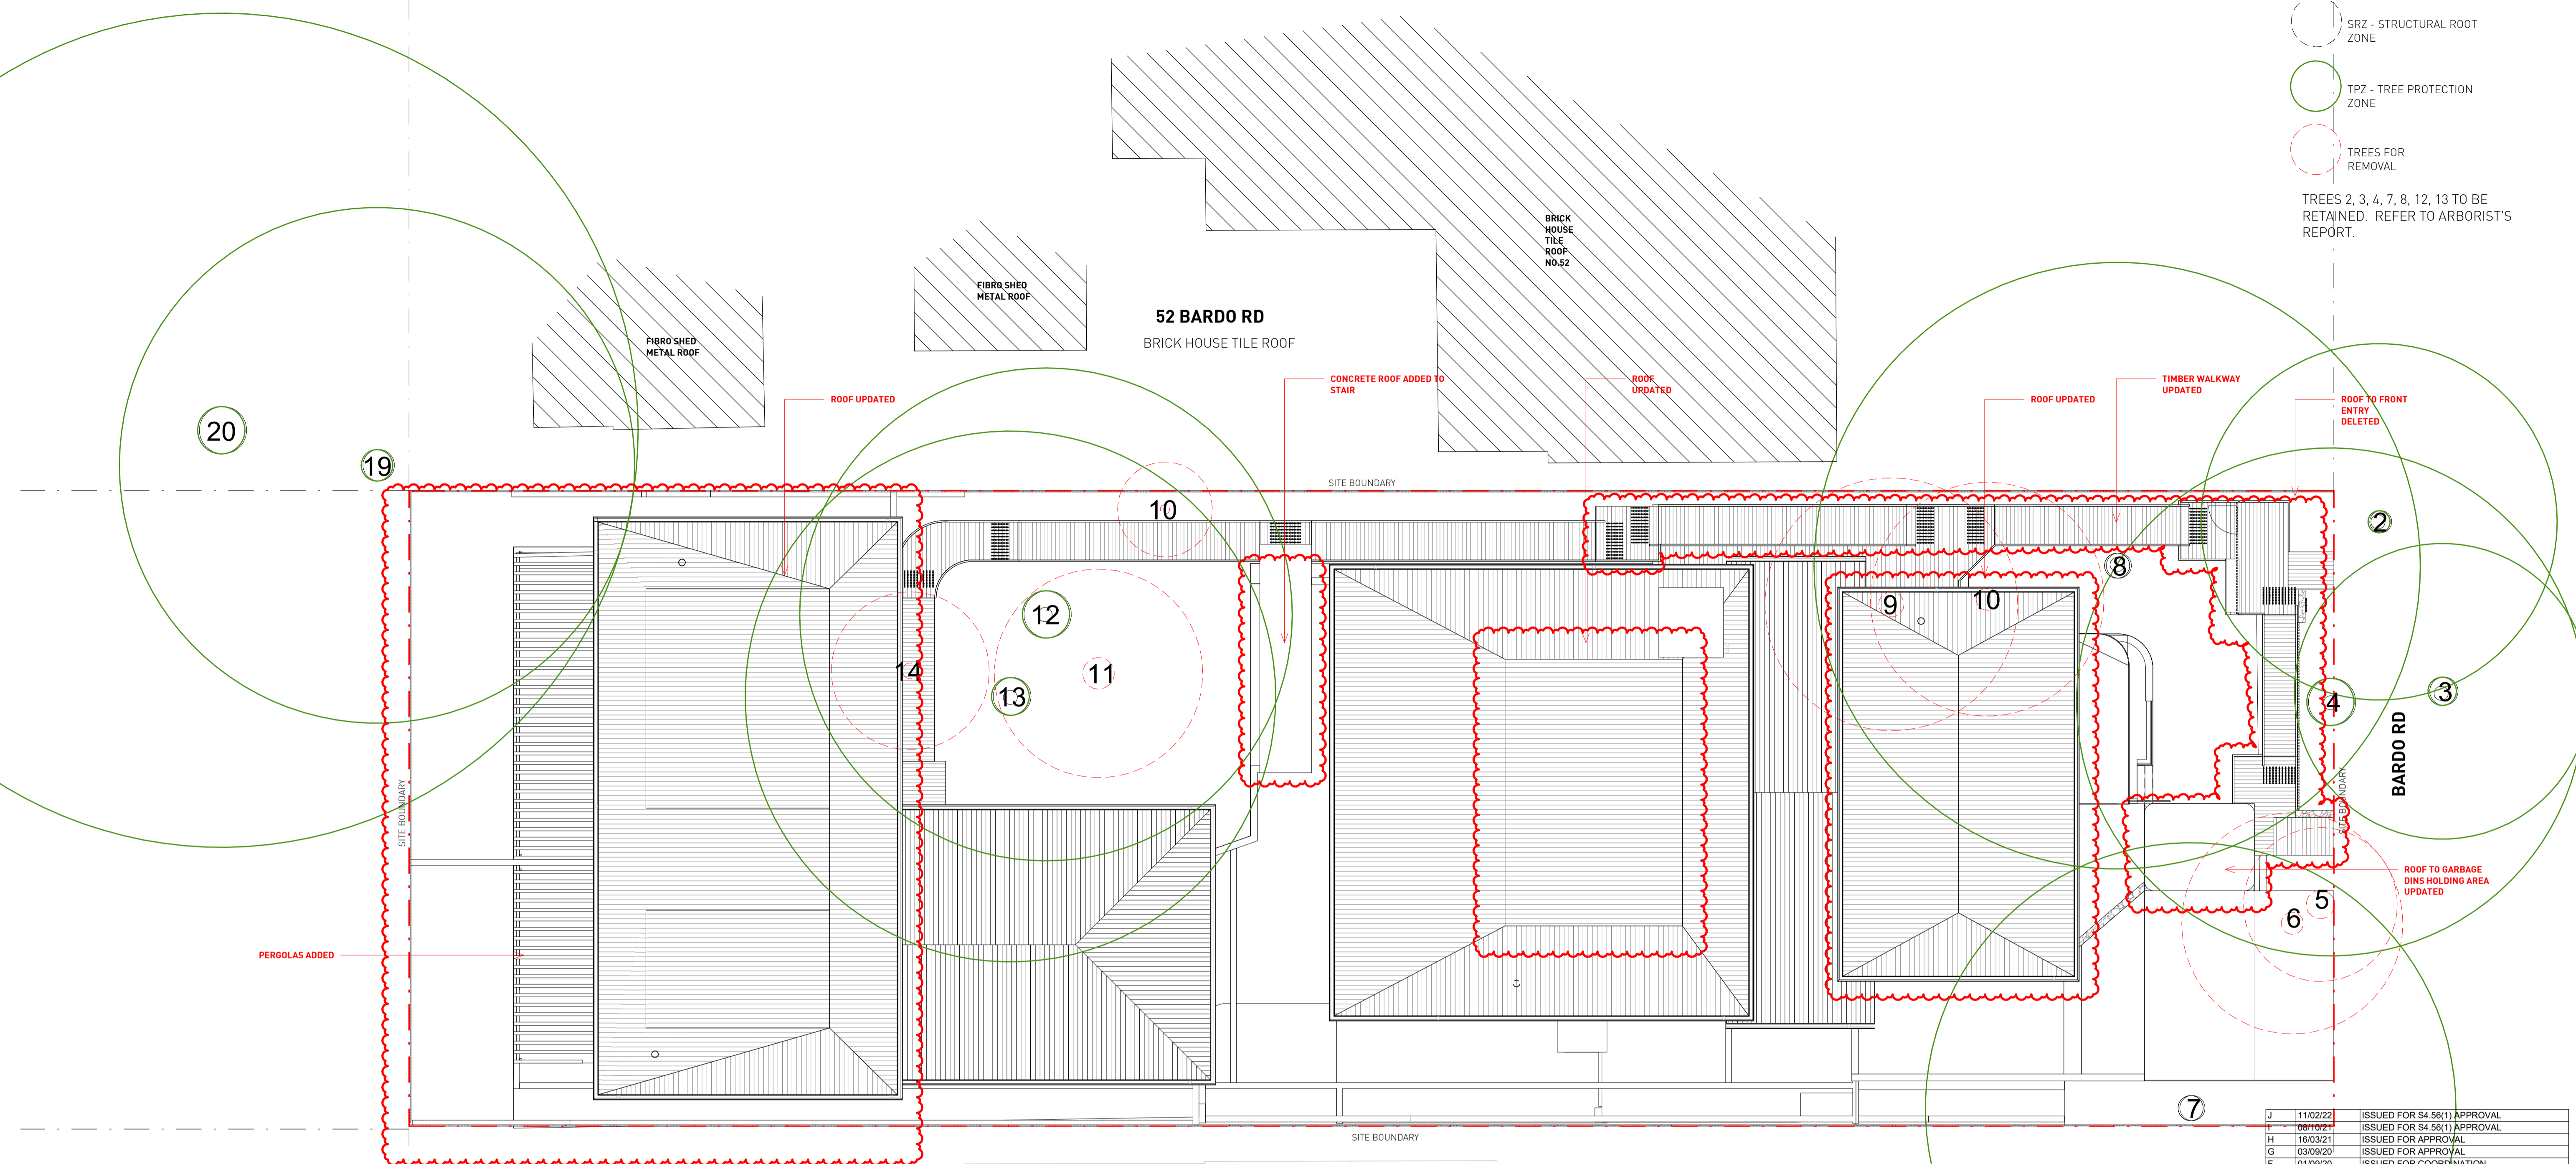

No.	Date	Description
J	11/03/22	ISSUED FOR S4.56(1) APPROVAL
I	08/10/21	ISSUED FOR S4.56(1) APPROVAL
H	16/03/21	ISSUED FOR APPROVAL
G	03/09/20	ISSUED FOR APPROVAL
F	01/09/20	ISSUED FOR COORDINATION
E	20/08/20	ISSUED FOR COORDINATION, REVISED PLANNING ITEMS
D	18/08/20	ISSUED FOR COORDINATION
C	29/07/20	ISSUED FOR PRE-DA MEETING
B	24/07/20	ISSUED FOR INFORMATION
A	21/07/20	ISSUED FOR INFORMATION


GILES TRIBE Level 1, 1 Chandos Street
ST LEONARDS NSW 2065
P 61 2 9254 5055
E gtr@gilestribe.com.au
Giles Tribe Pty Ltd ABN 50 801259 507
Mark G Broadley (3823) Stuart D Hill (6459)
Nominated Architects

Verify all dimensions on site prior to commencement of work.
Refer all discrepancies to the Architect for determination.
Use figured dimensions in preference to scaling.
This drawing is copyright and must not be retained, copied, or used without the written consent of Giles Tribe Architects.




Built Property
Project:
**54 BARDO ROAD
NEWPORT 2106
NSW**

Status:
FOR S4.56(1) APPROVAL

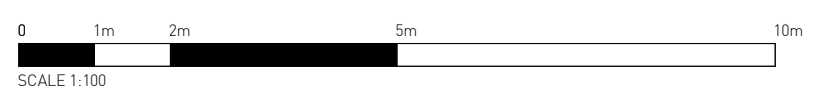
Scale: 1 : 100 Job No. Drawing No. Rev.
Sheet Size: A1 **20055 DA005 J**
Date: 06/19/20 Drawn: YL Reviewed: VY

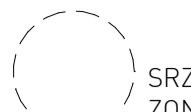

V:\GILES\2020\2005501 - Rev004_Bardo Rd, Newport, NSW\019_54_56(1).rvt

-  SRZ - STRUCTURAL ROOT ZONE
-  TPZ - TREE PROTECTION ZONE
-  TREES FOR REMOVAL

TREES 2, 3, 4, 7, 8, 12, 13 TO BE RETAINED. REFER TO ARBORIST'S REPORT.

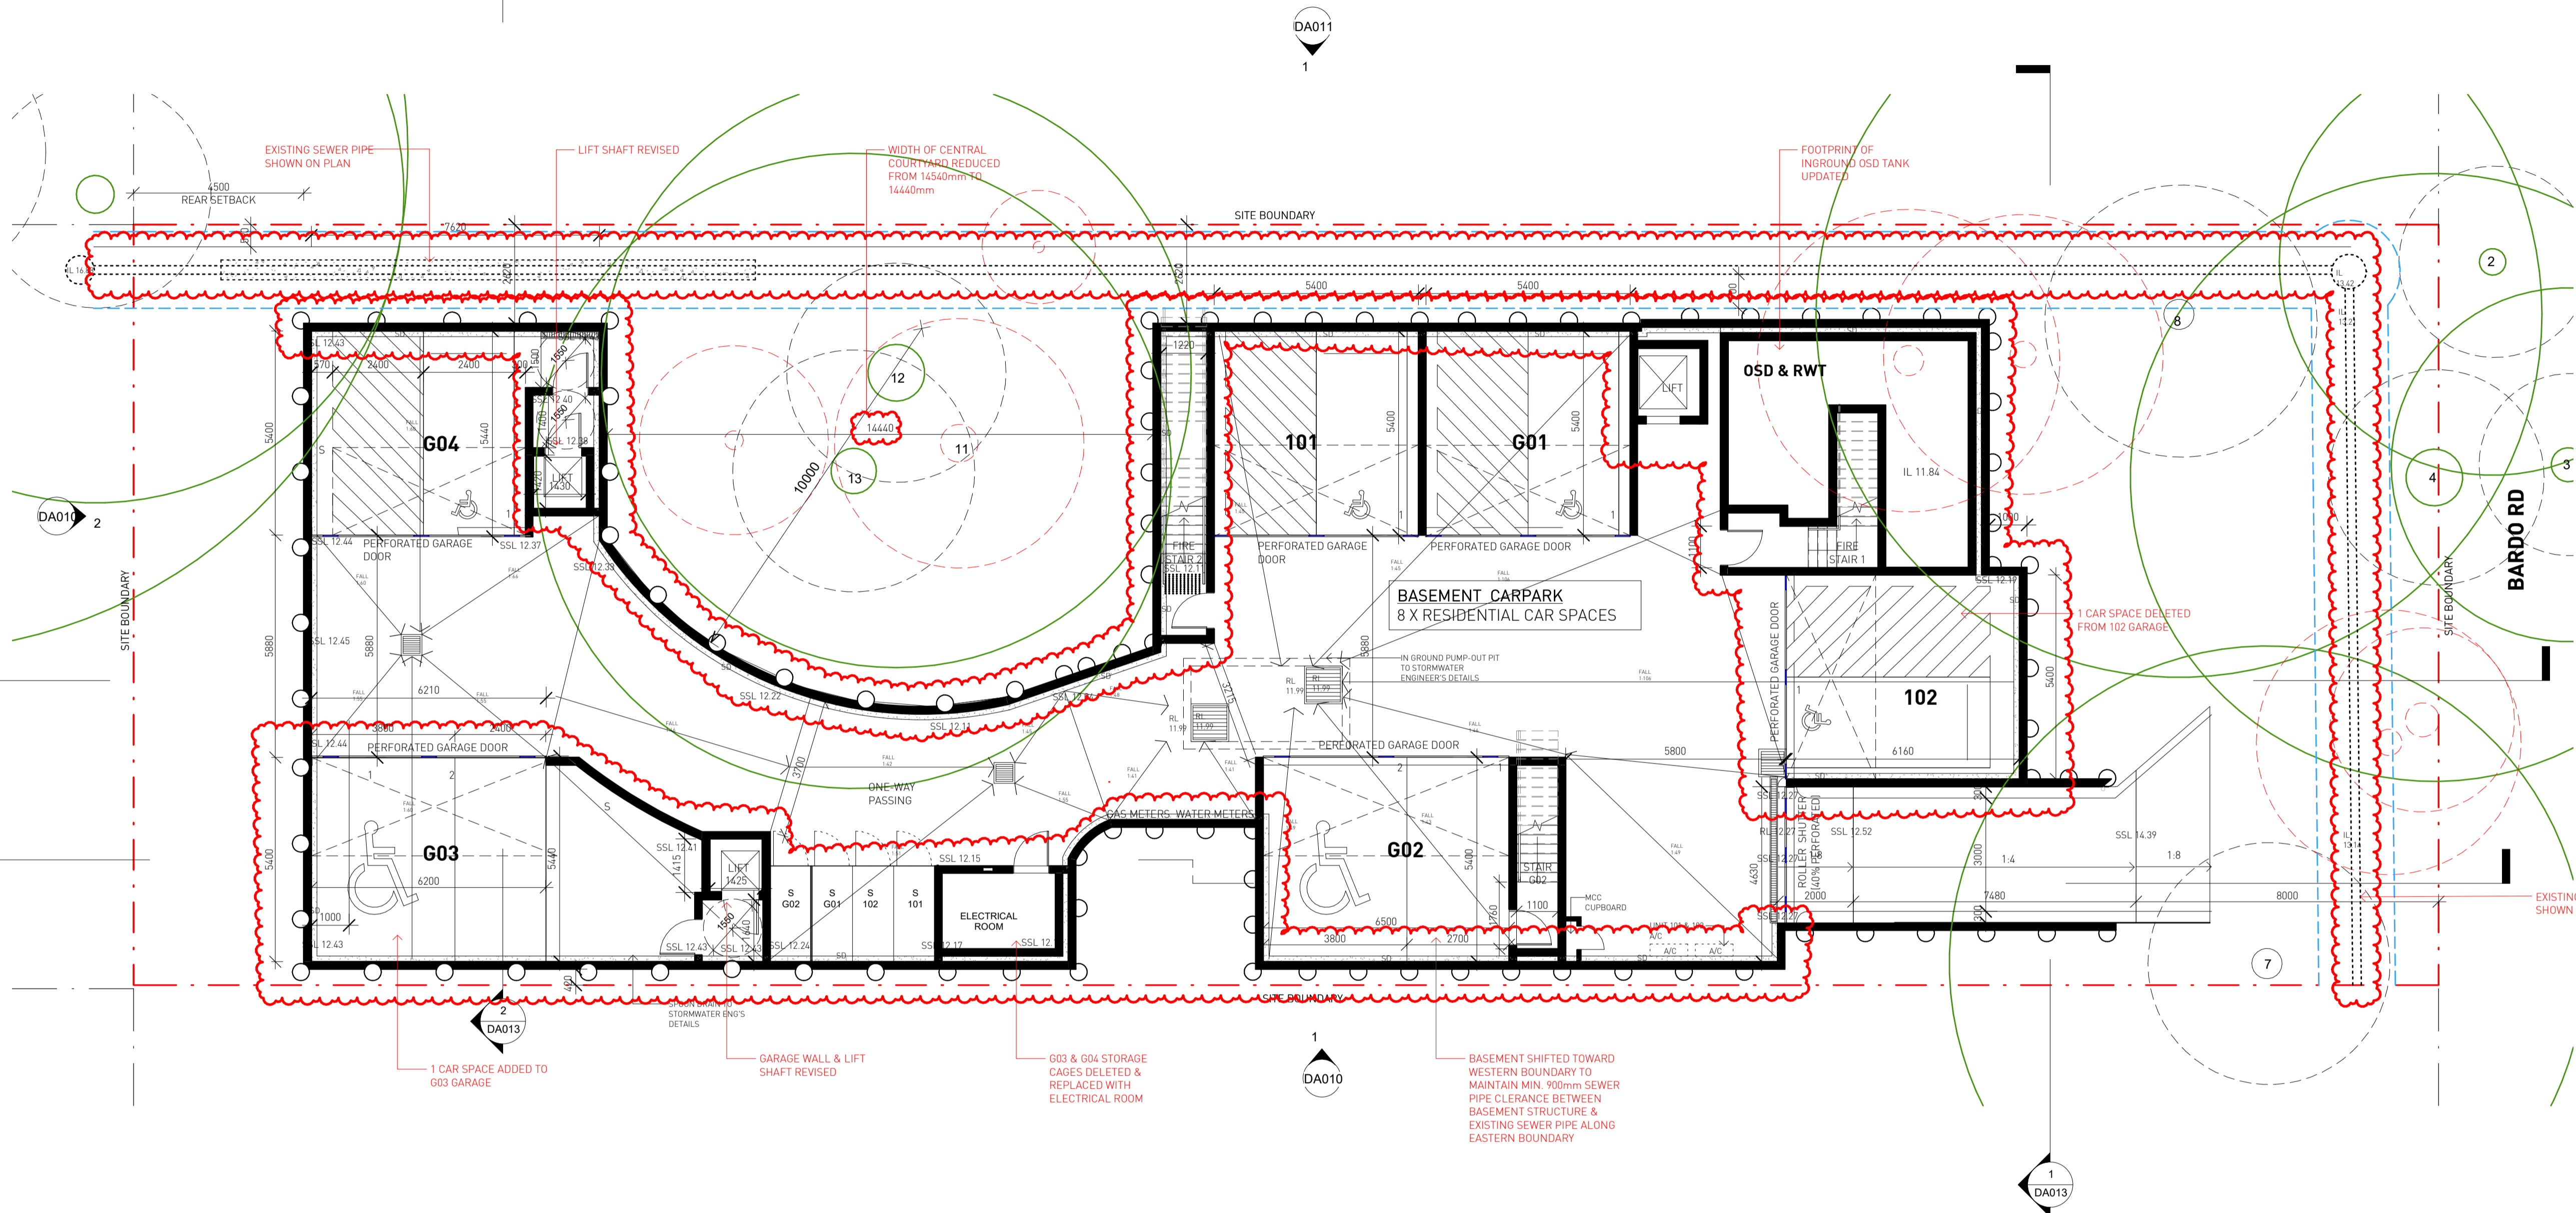

1 BASEMENT PLAN
1 : 100

No.	Date	Description
R	11/02/22	ISSUED FOR S4.56(1) APPROVAL
Q	08/10/21	ISSUED FOR S4.56(1) APPROVAL
P	01/04/21	ISSUED FOR APPROVAL
O	15/03/21	ISSUED FOR APPROVAL
N	03/09/20	ISSUED FOR APPROVAL
M	01/09/20	ISSUED FOR COORDINATION
L	31/08/20	ISSUED FOR COORDINATION
K	24/08/20	ISSUED FOR COORDINATION; BASEMENT AMENDED
J	24/08/20	ISSUED FOR COORDINATION
I	21/08/20	ISSUED FOR COORDINATION; ACCESS COMMENTS INCORPORATED; BASEMENT AMENDED; WINDOW TAGS ADDED
H	20/08/20	ISSUED FOR COORDINATION; REVISED PLANNING ITEMS
G	18/08/20	ISSUED FOR COORDINATION
F	29/07/20	ISSUED FOR PRE-DA MEETING
E	24/07/20	ISSUED FOR INFORMATION
D	21/07/20	ISSUED FOR INFORMATION
C	03/07/20	ISSUED FOR INFORMATION; INTERNAL LIFT ADDED TO REAR UNITS
B	26/06/20	ISSUED FOR INFORMATION
A	23/06/20	ISSUED FOR INFORMATION

GILES TRIBE Level 1, 1 Chandos Street
ST LEONARDS NSW 2065
P 61 2 9254 5005
E gtr@gilestribe.com.au
Giles Tribe Pty Ltd ABN 50 801259 507
Mark G Broadley (3823) Stuart D Hill (6459)

Verify all dimensions on site prior to commencement of work.
Refer all discrepancies to the Architect for determination.
Use figured dimensions in preference to scaling.
This drawing is copyright and must not be retained, copied, or used without the written consent of Giles Tribe Architects.

Built Property
Project:
**54 BARDO ROAD
NEWPORT 2106**


BASEMENT PLAN

Status: **FOR S4.56(1) APPROVAL**

Scale: 1 : 100 Job No. Drawing No. Rev.
Sheet Size: A1
Date: 08/04/21 **20055 DA006 R**
Drawn: Author Reviewed: Checker



V:\ESTRIBES\Drawings\2020\2005501 - Rev054_Bardo Rd, Newport, NSW\019_54_56(1) rvt

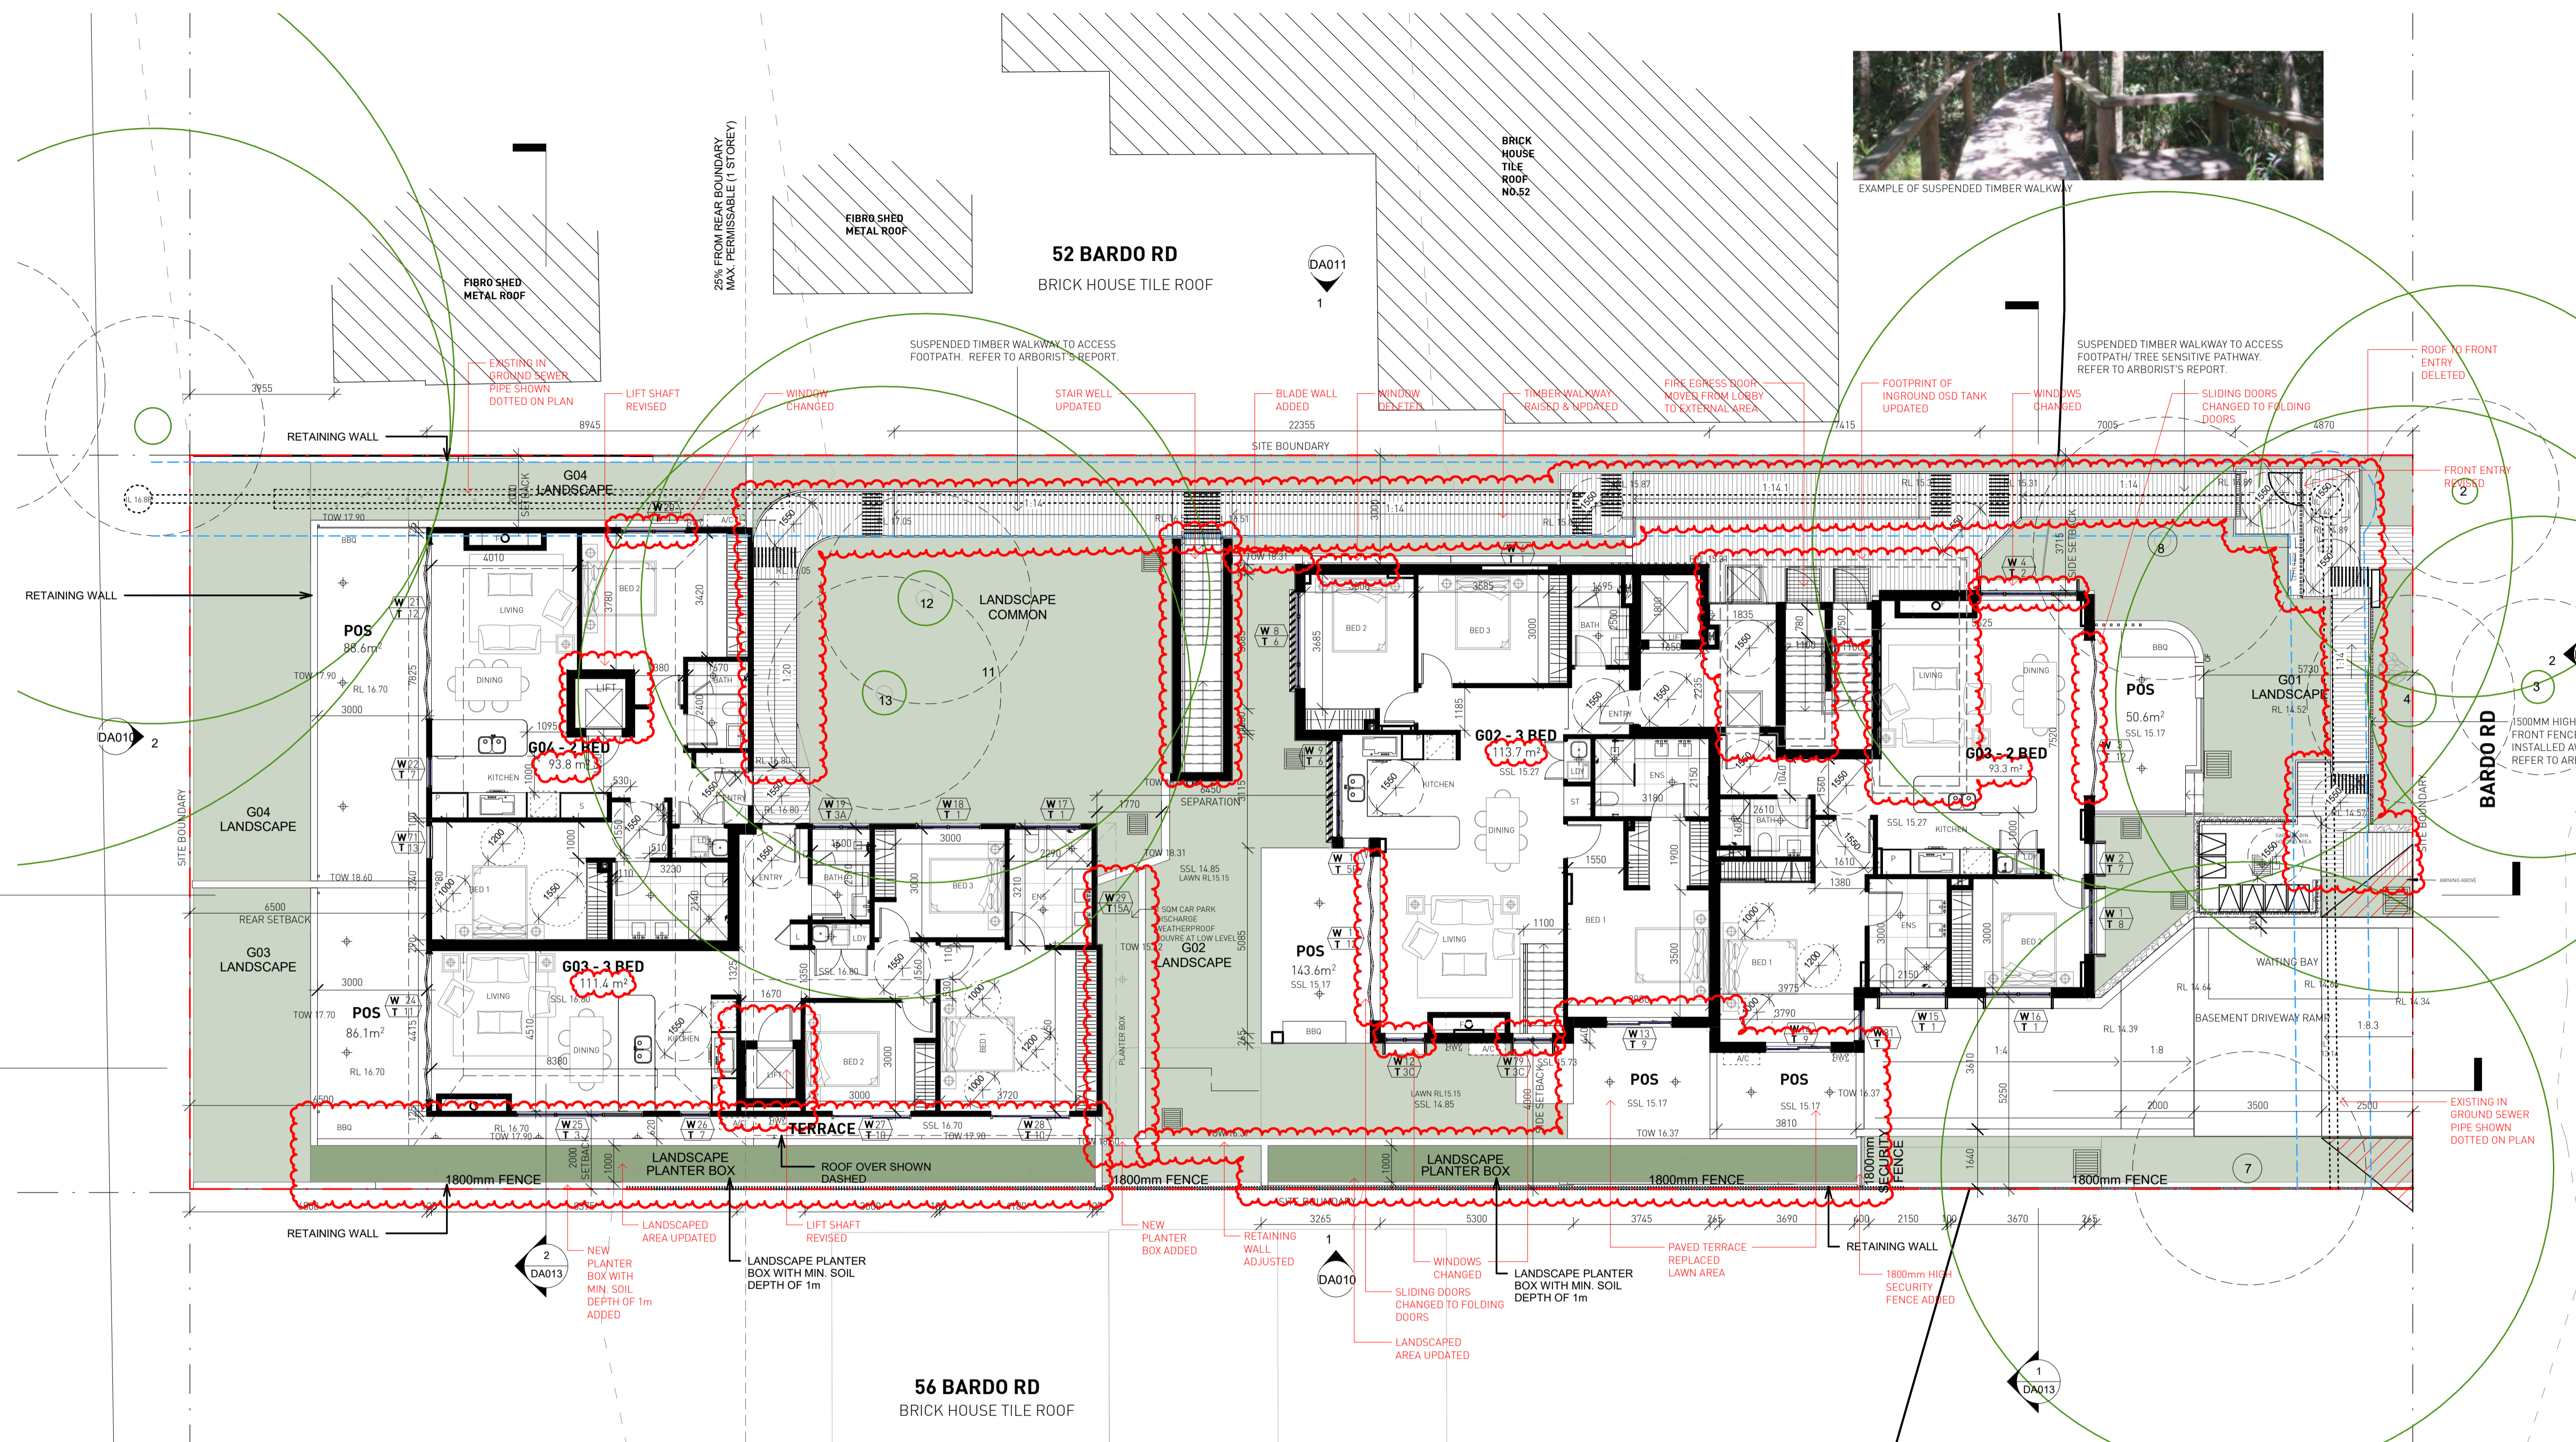

- SRZ - STRUCTURAL ROOT ZONE
 - TPZ - TREE PROTECTION ZONE
 - TREES FOR REMOVAL
- TREES 2, 3, 4, 7, 8, 12, 13 TO BE RETAINED. REFER TO ARBORIST'S REPORT.

1 GROUND FLOOR PLAN
1 : 100

2 DRIVEWAY DETAIL SECTION
1 : 20

No.	Date	Description
T	11/02/22	ISSUED FOR S4.56(1) APPROVAL
S	08/10/21	ISSUED FOR S4.56(1) APPROVAL
R	14/05/21	ISSUED FOR APPROVAL
Q	01/04/21	ISSUED FOR APPROVAL
P	11/03/21	ISSUED FOR APPROVAL
O	03/09/20	ISSUED FOR APPROVAL
N	02/09/20	ISSUED FOR COORDINATION; ARBORIST INPUT
M	01/09/20	ISSUED FOR COORDINATION
L	31/08/20	ISSUED FOR COORDINATION
K	24/08/20	ISSUED FOR COORDINATION; BASEMENT AMENDED
J	24/08/20	ISSUED FOR COORDINATION
I	21/08/20	ISSUED FOR COORDINATION; ACCESS COMMENTS INCORPORATED; BASEMENT AMENDED; WINDOW TAGS ADDED
H	20/08/20	ISSUED FOR COORDINATION; REVISED PLANNING ITEMS
G	18/08/20	ISSUED FOR COORDINATION
F	29/07/20	ISSUED FOR PRE-DA MEETING
E	24/07/20	ISSUED FOR INFORMATION
D	21/07/20	ISSUED FOR INFORMATION
C	03/07/20	ISSUED FOR INFORMATION; INTERNAL LIFT ADDED TO REAR UNITS
B	26/06/20	ISSUED FOR INFORMATION
A	23/06/20	ISSUED FOR INFORMATION

GILES TRIBE Level 1, 1 Chandos Street
ST LEONARDS NSW 2066
P 41 2 9254 5005
E gtr@gilestribe.com.au
Giles Tribe Pty Ltd ABN 50 001259 507

Nominated Architects: Mark G Broadley (3823) Stuart D Hill (6459)


Verify all dimensions on site prior to commencement of work.
Refer all discrepancies to the Architect for determination.
Use figured dimensions in preference to scaling.
This drawing is copyright and must not be retained, copied, or used without the written consent of Giles Tribe Architects.

Built Property
Project:
54 BARDO ROAD NEWPORT 2106

GROUND FLOOR PLAN


Status: **FOR S4.56(1) APPROVAL**

Scale: As indicated Job No: Drawing No: Rev:
Sheet Size: A1
Date: 08/04/21 **20055 DA007 T**
Drawn: Author Reviewed: Checker

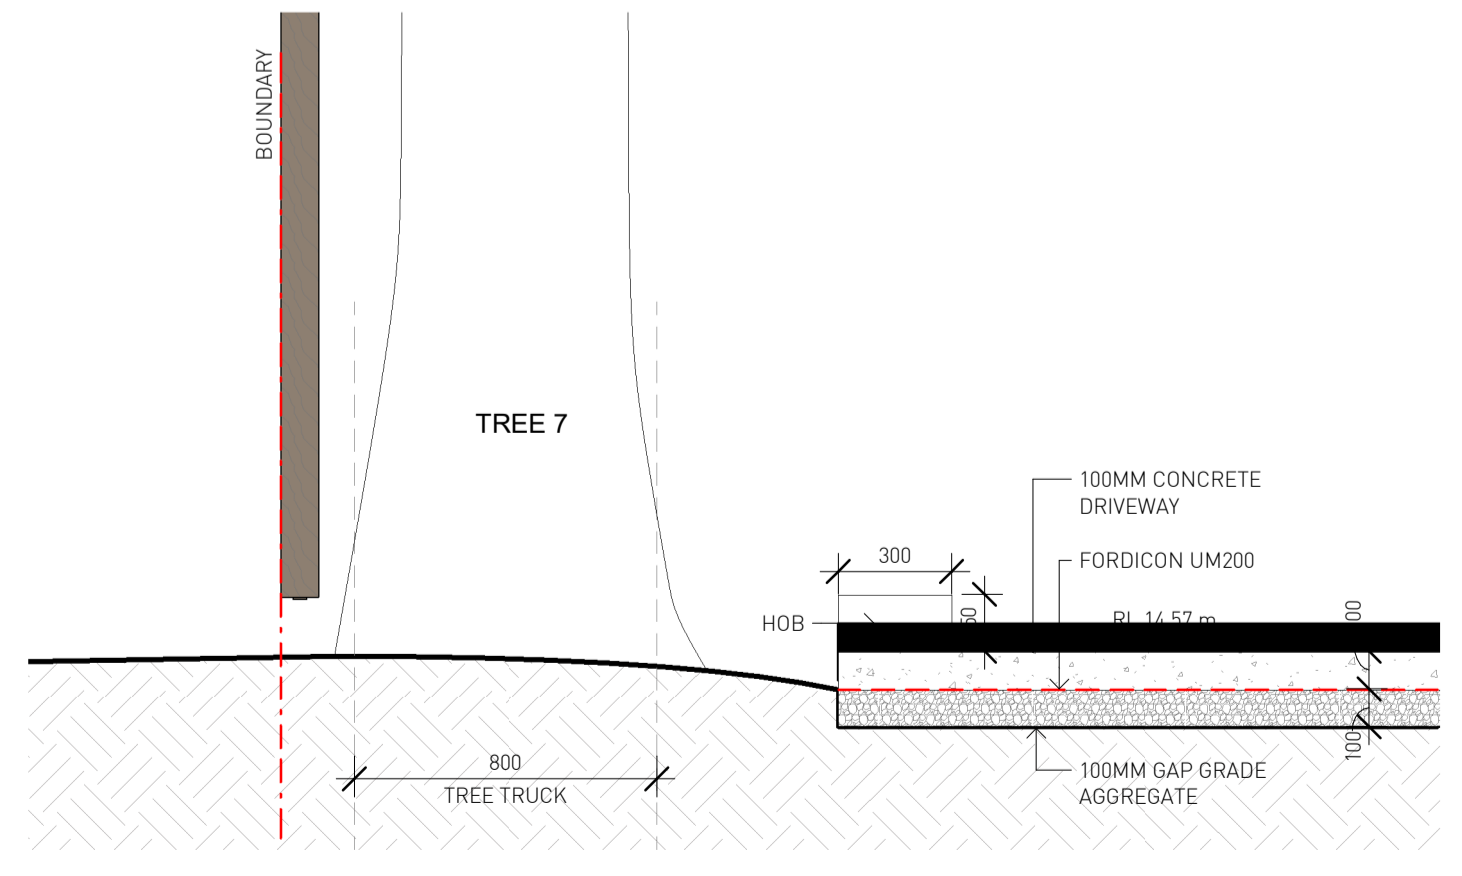

V:\GILES TRIBE - 3\Drawings\2020\2005501 - 2\Rev004_Bardo Rd Newport NSW\2005501_08_04_21.rvt

SRZ - STRUCTURAL ROOT ZONE
 TPZ - TREE PROTECTION ZONE
 TREES FOR REMOVAL
 TREES 2, 3, 4, 7, 8, 12, 13 TO BE RETAINED. REFER TO ARBORIST'S REPORT.

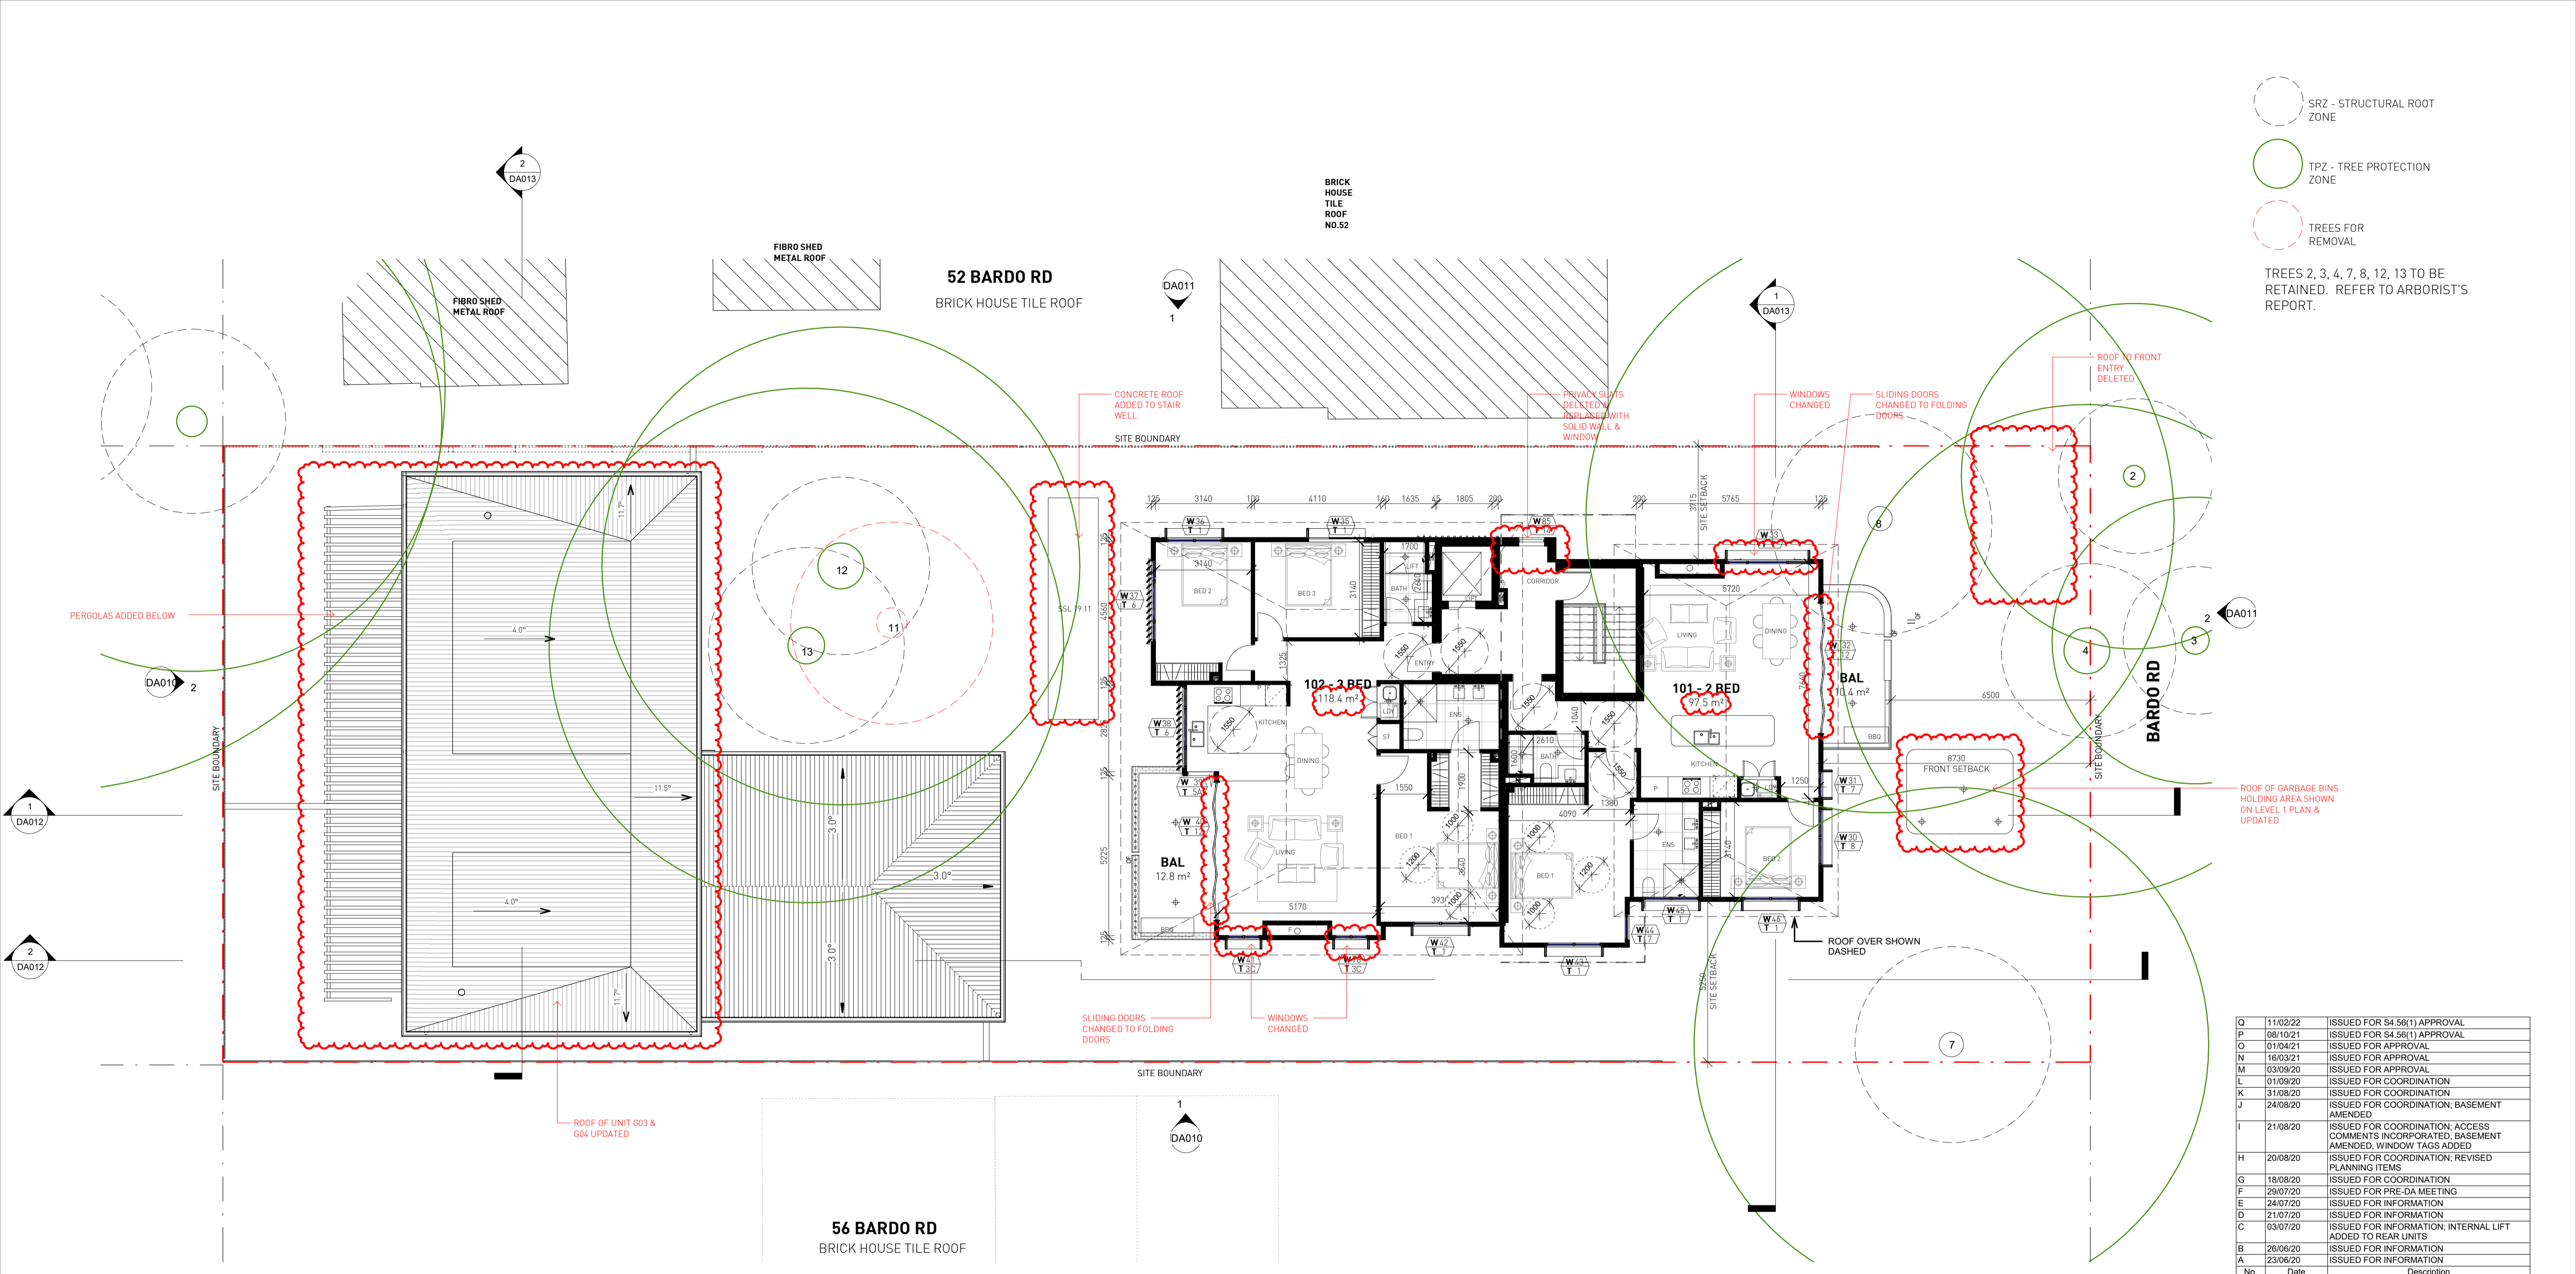

1 LEVEL 1 PLAN
 1 : 100

No.	Date	Description
Q	11/02/22	ISSUED FOR S4.56(1) APPROVAL
P	08/10/21	ISSUED FOR S4.56(1) APPROVAL
O	01/04/21	ISSUED FOR APPROVAL
N	16/03/21	ISSUED FOR APPROVAL
M	03/09/20	ISSUED FOR APPROVAL
L	01/09/20	ISSUED FOR COORDINATION
K	31/08/20	ISSUED FOR COORDINATION
J	24/08/20	ISSUED FOR COORDINATION, BASEMENT AMENDED
I	21/08/20	ISSUED FOR COORDINATION, ACCESS COMMENTS INCORPORATED, BASEMENT AMENDED, WINDOW TAGS ADDED
H	20/08/20	ISSUED FOR COORDINATION, REVISED PLANNING ITEMS
G	18/08/20	ISSUED FOR COORDINATION
F	29/07/20	ISSUED FOR PRE-DA MEETING
E	24/07/20	ISSUED FOR INFORMATION
D	21/07/20	ISSUED FOR INFORMATION
C	03/07/20	ISSUED FOR INFORMATION, INTERNAL LIFT ADDED TO REAR UNITS
B	26/06/20	ISSUED FOR INFORMATION
A	23/06/20	ISSUED FOR INFORMATION

GILES TRIBE Level 1, 1 Chandos Street
 ST LEONARDS NSW 2065
 P 61 2 9254 5005
 E gtr@gilestribe.com.au
 Giles Tribe Pty Ltd ABN 50 801259 507
 Mark G Broadley (3823) Stuart D Hill (6459)
 Nominated Architects


Verify all dimensions on site prior to commencement of work.
 Refer all discrepancies to the Architect for determination.
 Use figured dimensions in preference to scaling.
 This drawing is copyright and must not be retained, copied, or used without the written consent of Giles Tribe Architects.

Built Property
 Project:
54 BARDO ROAD
NEWPORT 2106




Drawing:
LEVEL 1 PLAN

Status:
FOR S4.56(1) APPROVAL

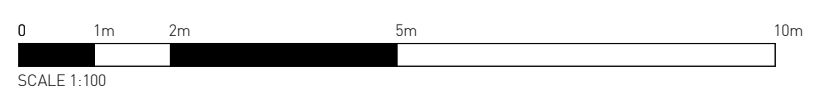
Scale: 1 : 100 Job No. Drawing No. Rev.
 Sheet Size: A1
 Date: 08/04/21 **20055 DA008 Q**
 Drawn: Author Reviewed: Checker



V:\GILES\TRIBE - 3\Drawings\W\2020\080500 - 2\Rev004_Bardo Rd, Newport, NSW\019_54_56(1) rvt

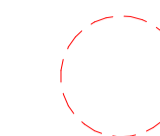-  SRZ - STRUCTURAL ROOT ZONE
-  TPZ - TREE PROTECTION ZONE
-  TREES FOR REMOVAL

TREES 2, 3, 4, 7, 8, 12, 13 TO BE RETAINED. REFER TO ARBORIST'S REPORT.

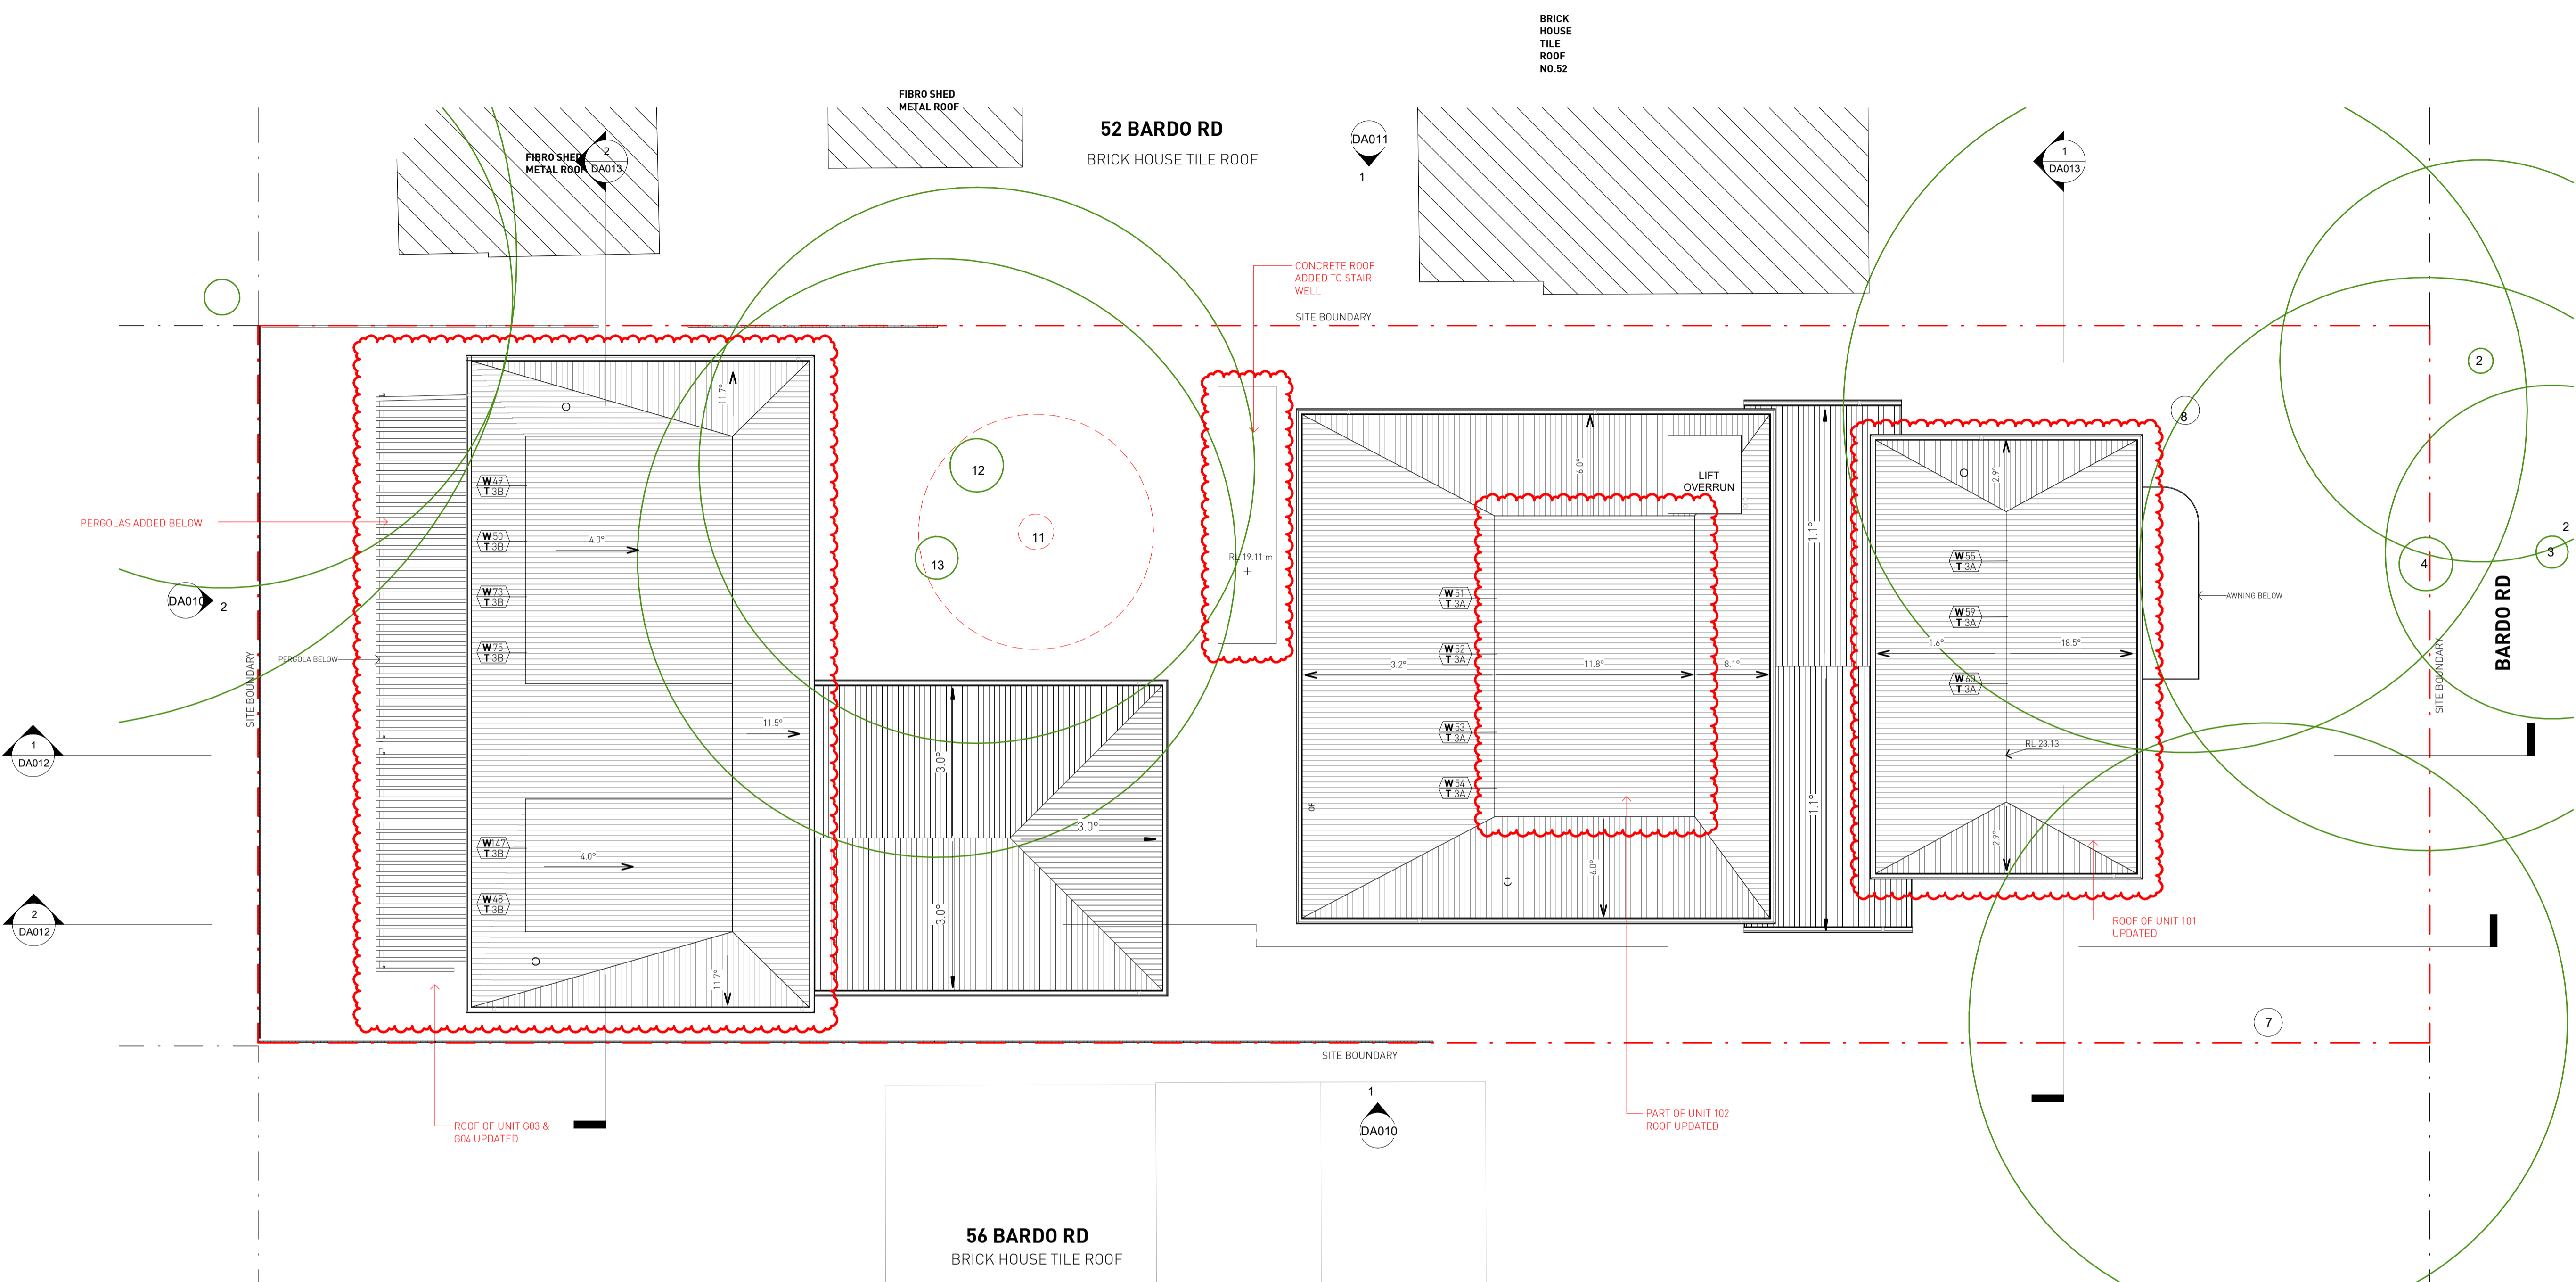

1 ROOF PLAN
1 : 100

No.	Date	Description
K	11/02/22	ISSUED FOR S4.56(1) APPROVAL
J	08/10/21	ISSUED FOR S4.56(1) APPROVAL
I	16/03/21	ISSUED FOR APPROVAL
H	03/09/20	ISSUED FOR APPROVAL
G	01/09/20	ISSUED FOR COORDINATION
F	31/08/20	ISSUED FOR COORDINATION
E	21/08/20	ISSUED FOR COORDINATION; ACCESS COMMENTS INCORPORATED; BASEMENT AMENDED; WINDOW TAGS ADDED
D	20/08/20	ISSUED FOR COORDINATION; REVISED PLANNING ITEMS
C	18/08/20	ISSUED FOR COORDINATION
B	29/07/20	ISSUED FOR PRE-DA MEETING
A	24/07/20	ISSUED FOR INFORMATION

GILES TRIBE Level 1, 1 Chandos Street
ST LEONARDS NSW 2065
P 61 2 9244 5005
E gtr@gilestribe.com.au
Giles Tribe Pty Ltd ABN 50 001259 507
Mark G Broadley (3823) Stuart D Hill (6459)


Verify all dimensions on site prior to commencement of work.
Refer all discrepancies to the Architect for determination.
Use figured dimensions in preference to scaling.
This drawing is copyright and must not be retained, copied, or used without the written consent of Giles Tribe Architects.

Built Property
Project:
**54 BARDO ROAD
NEWPORT 2106**

ROOF PLAN

Status: **FOR S4.56(1) APPROVAL**

Scale: 1 : 100 Job No. Drawing No. Rev.
Sheet Size: A1
Date: 08/04/21 **20055 DA009 K**
Drawn: Author Reviewed: Checker

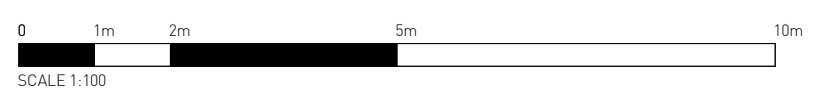


V:\GILES\TRIBE\Drawings\2020\0805001_2\Rev004_Bardo_Rd_Newport_NS00106_S4_56(1).rvt



- 1 ALUMINIUM WINDOW & SLIDING DOOR FRAMES, LOUVRES, HOODS POWDERCOATED
DURALLOY ANOTEC - SILVER GREY MATT [27251272] OR SIMILAR
- 2 METAL DECK ROOF, GUTTER, DOWNPIPE
COLORBOND SURFMIST OR SIMILAR
- 3 ALUMINIUM PRIVACY SLATS
FIXED ALUMINIUM PRIVACY SCREENS
- 4 INTERPON POWDERCOAT
COLOUR - ANODIC BRONZE [GY114A] OR SIMILAR
- 5 PGH BRICKS -
-MORADA CENIZA KINEAR 287X90X48MM
- 6 ENTRANCE DOOR
DULUX PAINT RENDER COLOUR - PIPE CLAY [S16A1] OR SIMILAR
- 7 PLANTER BOX, RETAINING WALL
SANDSTONE




- 8 FENCE
EXTERNAL TIMBER-LOOK FENCING
- 9 SOFFIT
TIMBER-LOOK PANEL- URBANLINE SELEKTA CLAD (DARK CEDAR) OR SIMILAR
- 10 ENTRANCE PAVERS
BLUESTONE TILES
- 11 FRAMELESS GLASS BALUSTRADE
- 12 SCYON AXON CLADDING

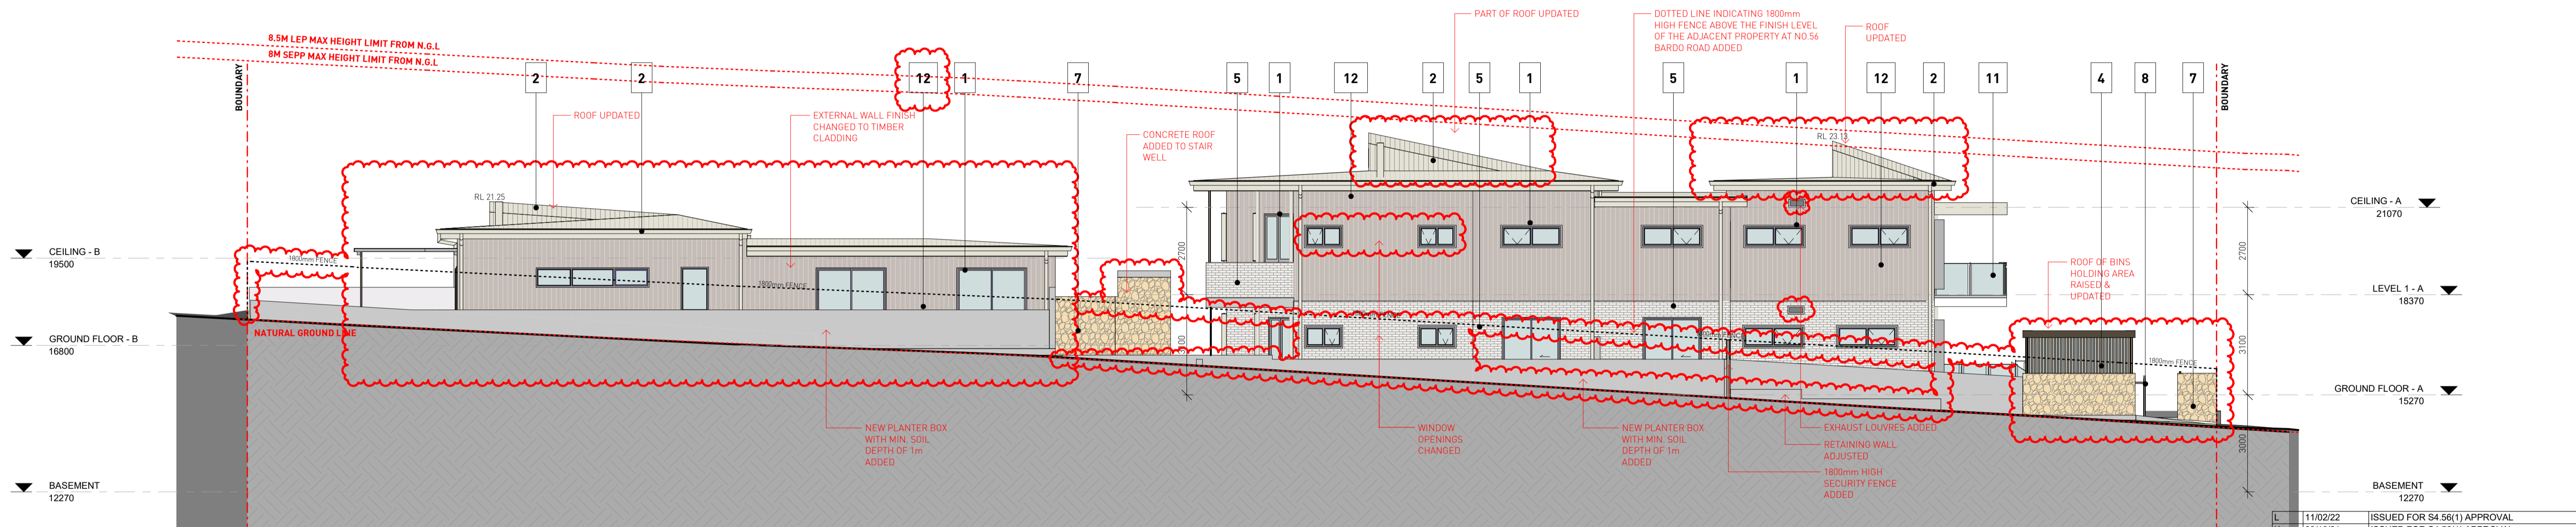

1 WEST ELEVATION
DA010 1:100

No.	Date	Description
L	11/02/22	ISSUED FOR S4.56(1) APPROVAL
K	08/10/21	ISSUED FOR S4.56(1) APPROVAL
J	16/03/21	ISSUED FOR APPROVAL
I	03/09/20	ISSUED FOR APPROVAL
H	01/09/20	ISSUED FOR COORDINATION
G	31/08/20	ISSUED FOR COORDINATION
F	24/08/20	ISSUED FOR COORDINATION
E	21/08/20	ISSUED FOR COORDINATION; ACCESS COMMENTS INCORPORATED; BASEMENT AMENDED; WINDOW TAGS ADDED
D	20/08/20	ISSUED FOR COORDINATION; REVISED PLANNING ITEMS
C	18/08/20	ISSUED FOR COORDINATION
B	29/07/20	ISSUED FOR PRE-DA MEETING
A	24/07/20	ISSUED FOR INFORMATION

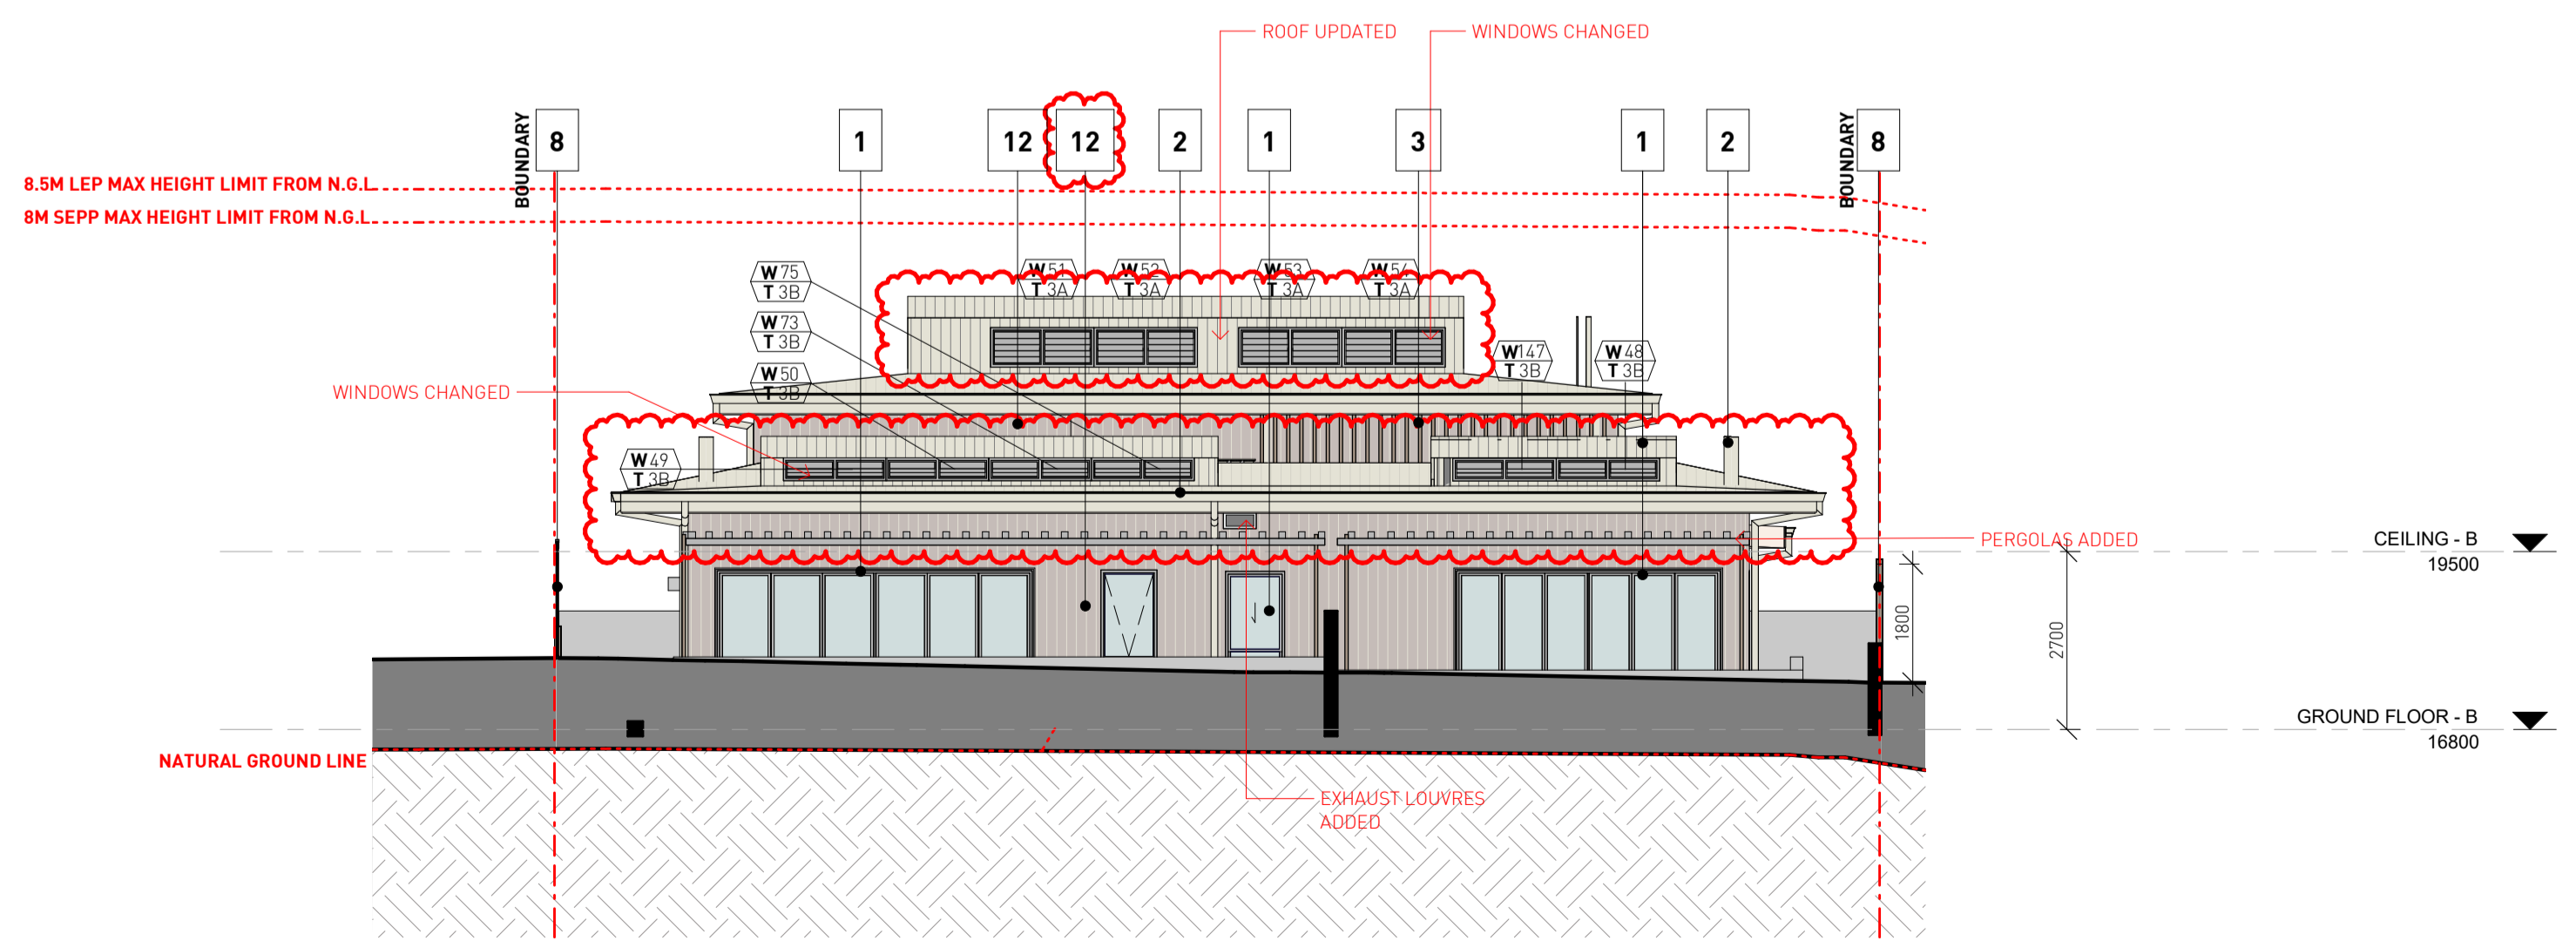

2 NORTH ELEVATION
DA010 1:100

GILES TRIBE Level 1, 1 Chandos Street
ST LEONARDS NSW 2065
P 61 2 9254 5005
E gtr@gilestribe.com.au
Giles Tribe Pty Ltd ABN 50 801259 507
Mark G Broadley (3623) Stuart D Hill (6459)


Verify all dimensions on site prior to commencement of work. Refer all discrepancies to the Architect for determination. Use figured dimensions in preference to scaling. This drawing is copyright and must not be retained, copied or used without the written consent of Giles Tribe Architects.

Built Property
Project
**54 BARDO ROAD
NEWPORT 2106
NSW**

NORTH & WEST ELEVATIONS


Status: **FOR S4.56(1) APPROVAL**

Scale: 1:100 Job No. Drawing No. Rev.
Sheet Size: A1 **20055 DA010 L**
Date: 06/19/20 Drawn: YL Reviewed: VY

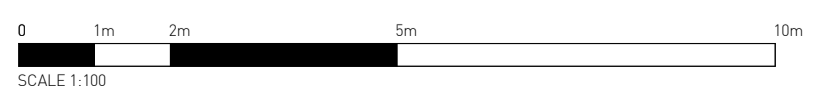


V:\GILES\TRIBE - 3\Drawings\W20055\005501 - Rev004_Bardo Rd, Newport, NSW\019_54_56(1).rvt

- 1 ALUMINIUM WINDOW & SLIDING DOOR FRAMES, LOUVRES, HOODS POWDERCOATED
DURALLOY ANOTEC
- SILVER GREY MATT [27251272] OR SIMILAR
- 2 METAL DECK ROOF, GUTTER, DOWNPIPE
COLORBOND SURFMIST OR SIMILAR
- 3 ALUMINIUM PRIVACY SLATS
FIXED ALUMINIUM PRIVACY SCREENS
- 4 INTERPON POWDERCOAT
COLOUR - ANODIC BRONZE (GY114A) OR SIMILAR
- 5 PGH BRICKS -
-MORADA CENIZA KINEAR 287X90X48MM
- 6 ENTRANCE DOOR
DULUX PAINT RENDER COLOUR - PIPE CLAY [S16A1] OR SIMILAR
- 7 PLANTER BOX, RETAINING WALL
SANDSTONE
- 8 FENCE
EXTERNAL TIMBER-LOOK FENCING
- 9 SOFFIT
TIMBER-LOOK PANEL- URBANLINE SELEKTA CLAD (DARK CEDAR) OR SIMILAR
- 10 ENTRANCE PAVERS
BLUESTONE TILES
- 11 FRAMELESS GLASS BALUSTRADE
- 12 SCYON AXON CLADDING

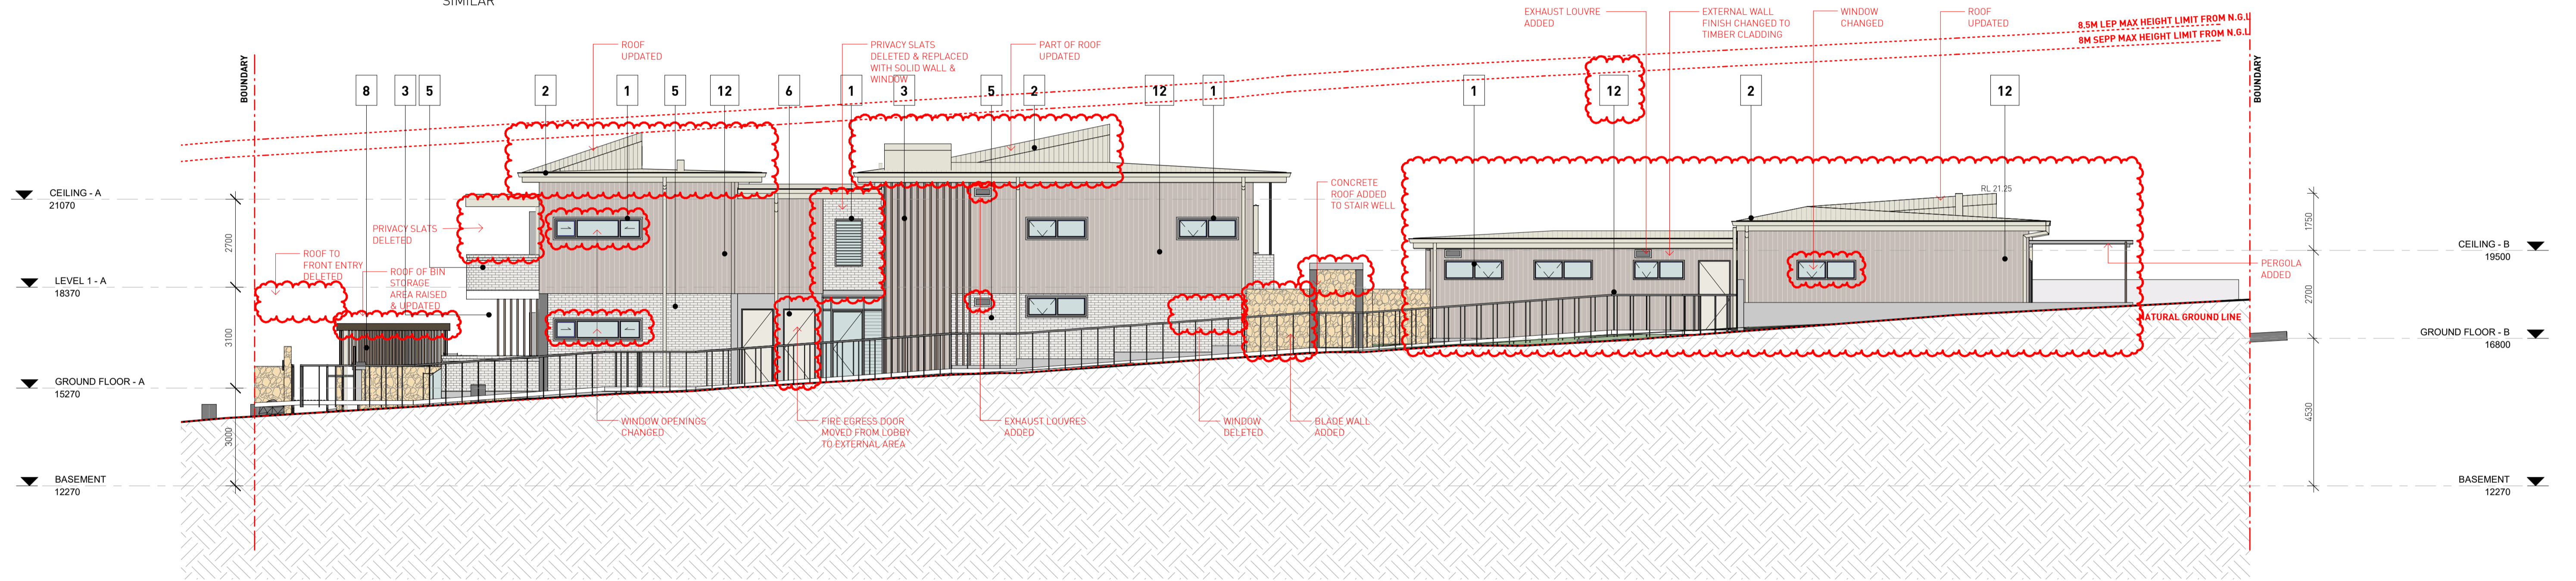

1 EAST ELEVATION
DA011 1:100

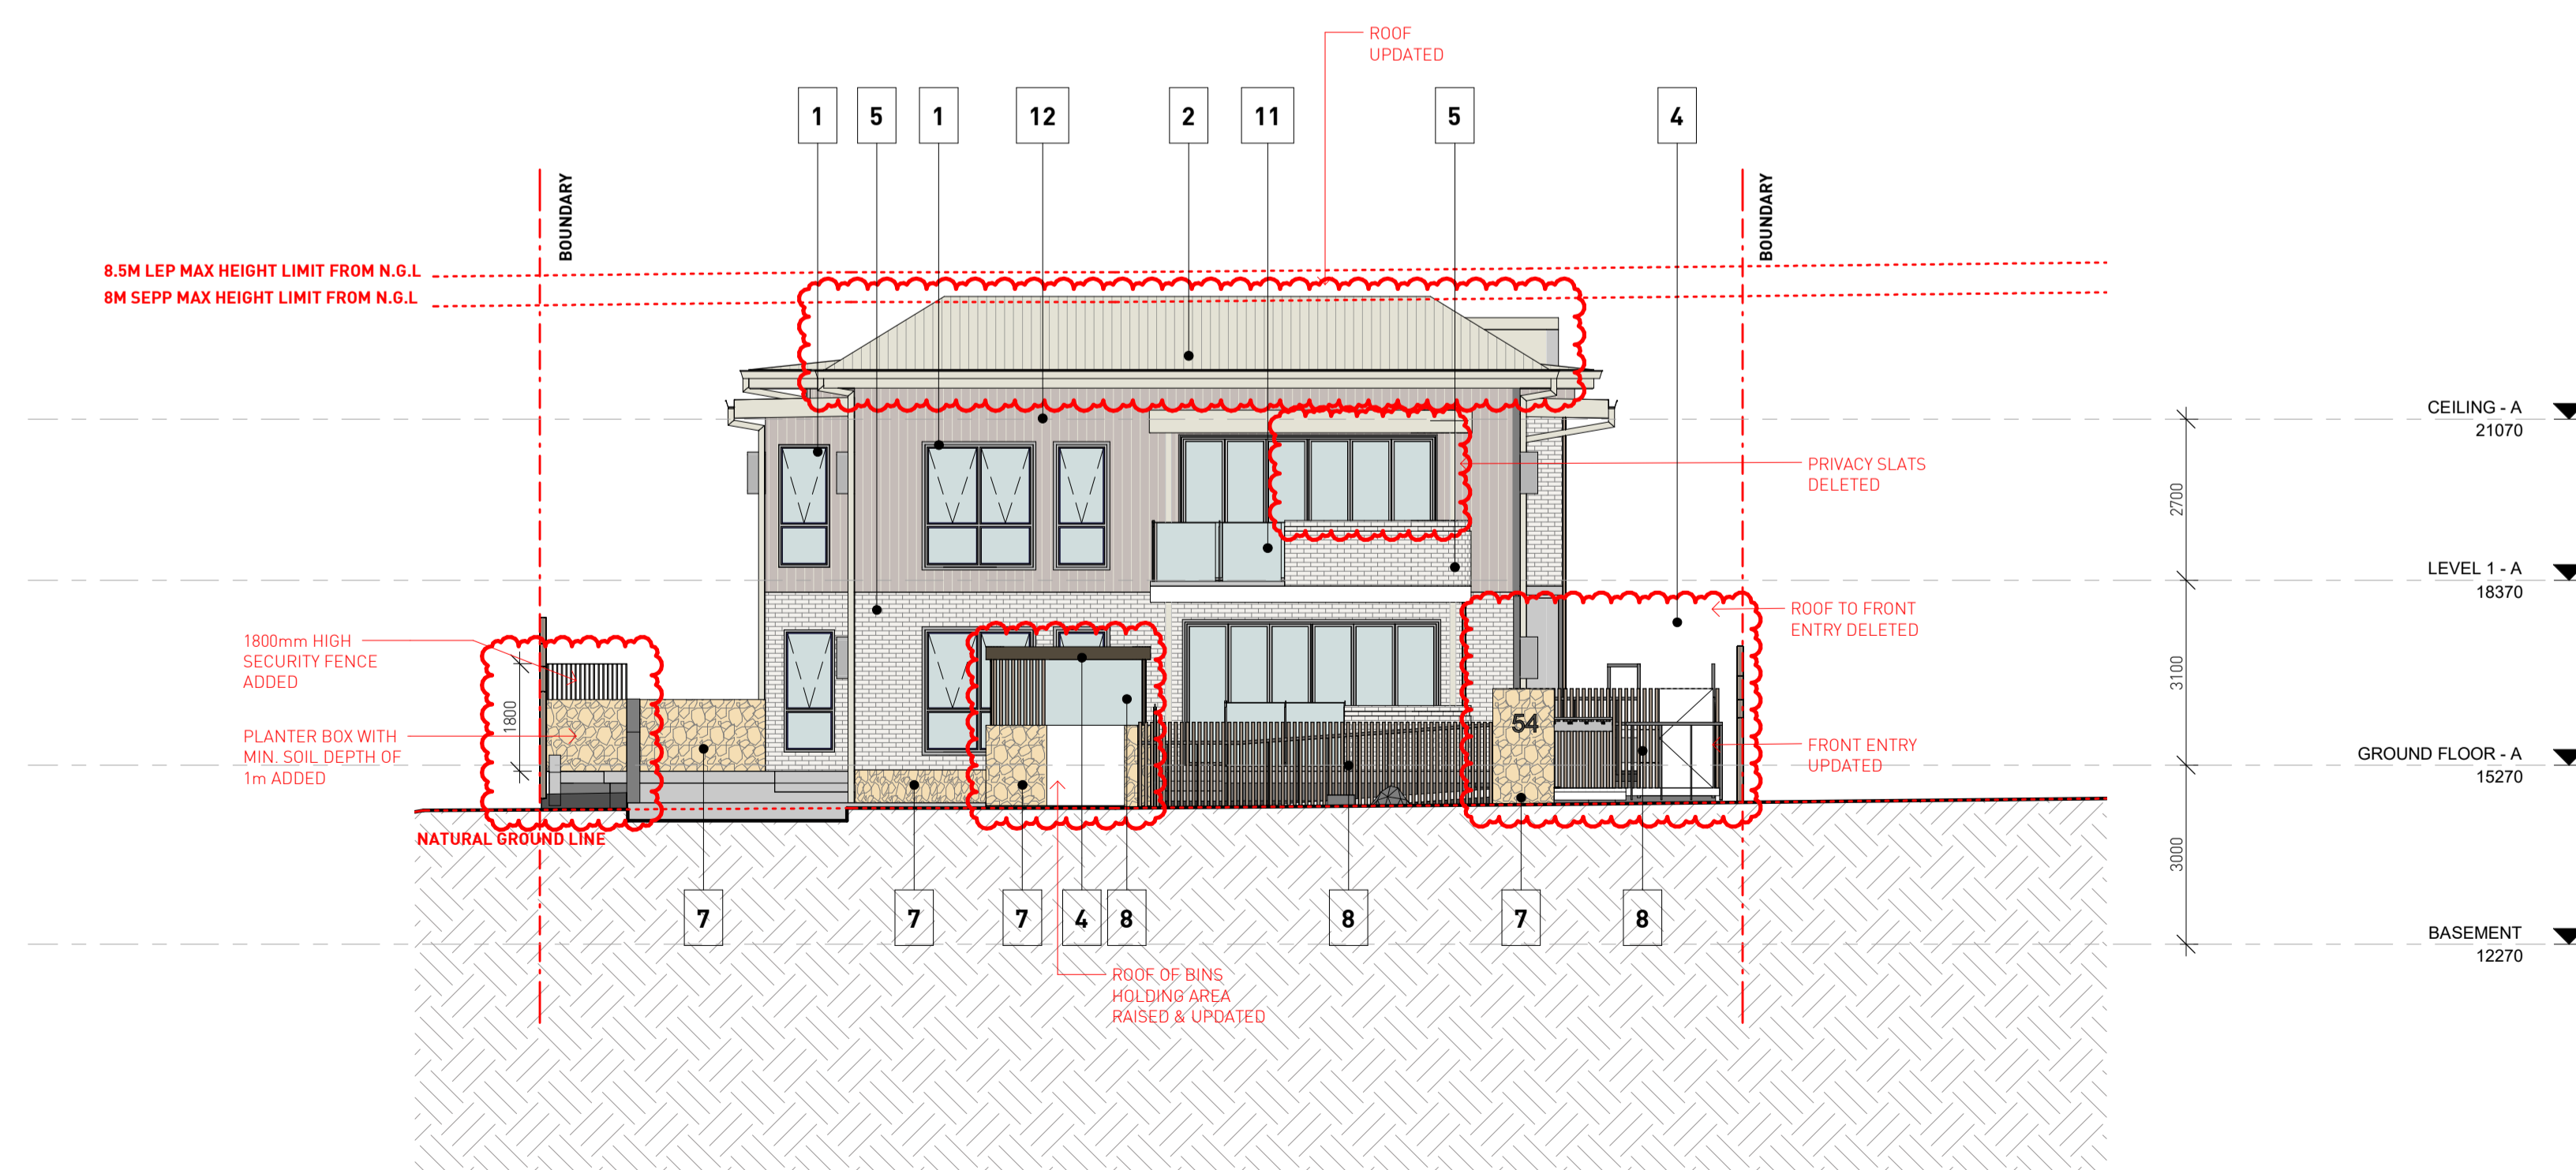

2 SOUTH ELEVATION
DA011 1:100

No.	Date	Description
K	11/02/22	ISSUED FOR S4.56(1) APPROVAL
J	08/10/21	ISSUED FOR S4.56(1) APPROVAL
I	16/03/21	ISSUED FOR APPROVAL
H	03/09/20	ISSUED FOR APPROVAL
G	01/09/20	ISSUED FOR COORDINATION
F	31/08/20	ISSUED FOR COORDINATION
E	21/08/20	ISSUED FOR COORDINATION; ACCESS COMMENTS INCORPORATED; BASEMENT AMENDED; WINDOW TAGS ADDED
D	20/08/20	ISSUED FOR COORDINATION; REVISED PLANNING ITEMS
C	18/08/20	ISSUED FOR COORDINATION
B	29/07/20	ISSUED FOR PRE-DA MEETING
A	24/07/20	ISSUED FOR INFORMATION

Amendments

GILES TRIBE
Level 1, 1 Chandos Street
ST LEONARDS NSW 2065
P 61 2 9254 5005
E gtr@gilestribe.com.au
Giles Tribe Pty Ltd ABN 50 801259 507
Mark G Broadley (3823) Stuart D Hill (6459)

Nominated Architects: Mark G Broadley (3823) Stuart D Hill (6459)


Verify all dimensions on site prior to commencement of work.
Refer all discrepancies to the Architect for determination.
Use figured dimensions in preference to scaling.
This drawing is copyright and must not be retained, copied, or used without the written consent of Giles Tribe Architects.

Client: **Built Property**
Project: **54 BARDO ROAD NEWPORT 2106 NSW**


Drawn: **SOUTH & EAST ELEVATIONS**

Status: **FOR S4.56(1) APPROVAL**


Scale: 1:100 Job No. Drawing No. Rev.
Sheet Size: A1 **20055 DA011 K**
Date: 06/19/20 Drawn: YL Reviewed: VY

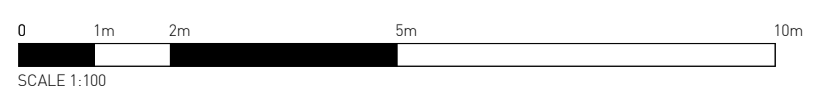

V:\GILES\TRIBE - 3\Drawings\W20055\005501 - Rev004_Bardo Rd, Newport, NSW\019_54_56(1).rvt

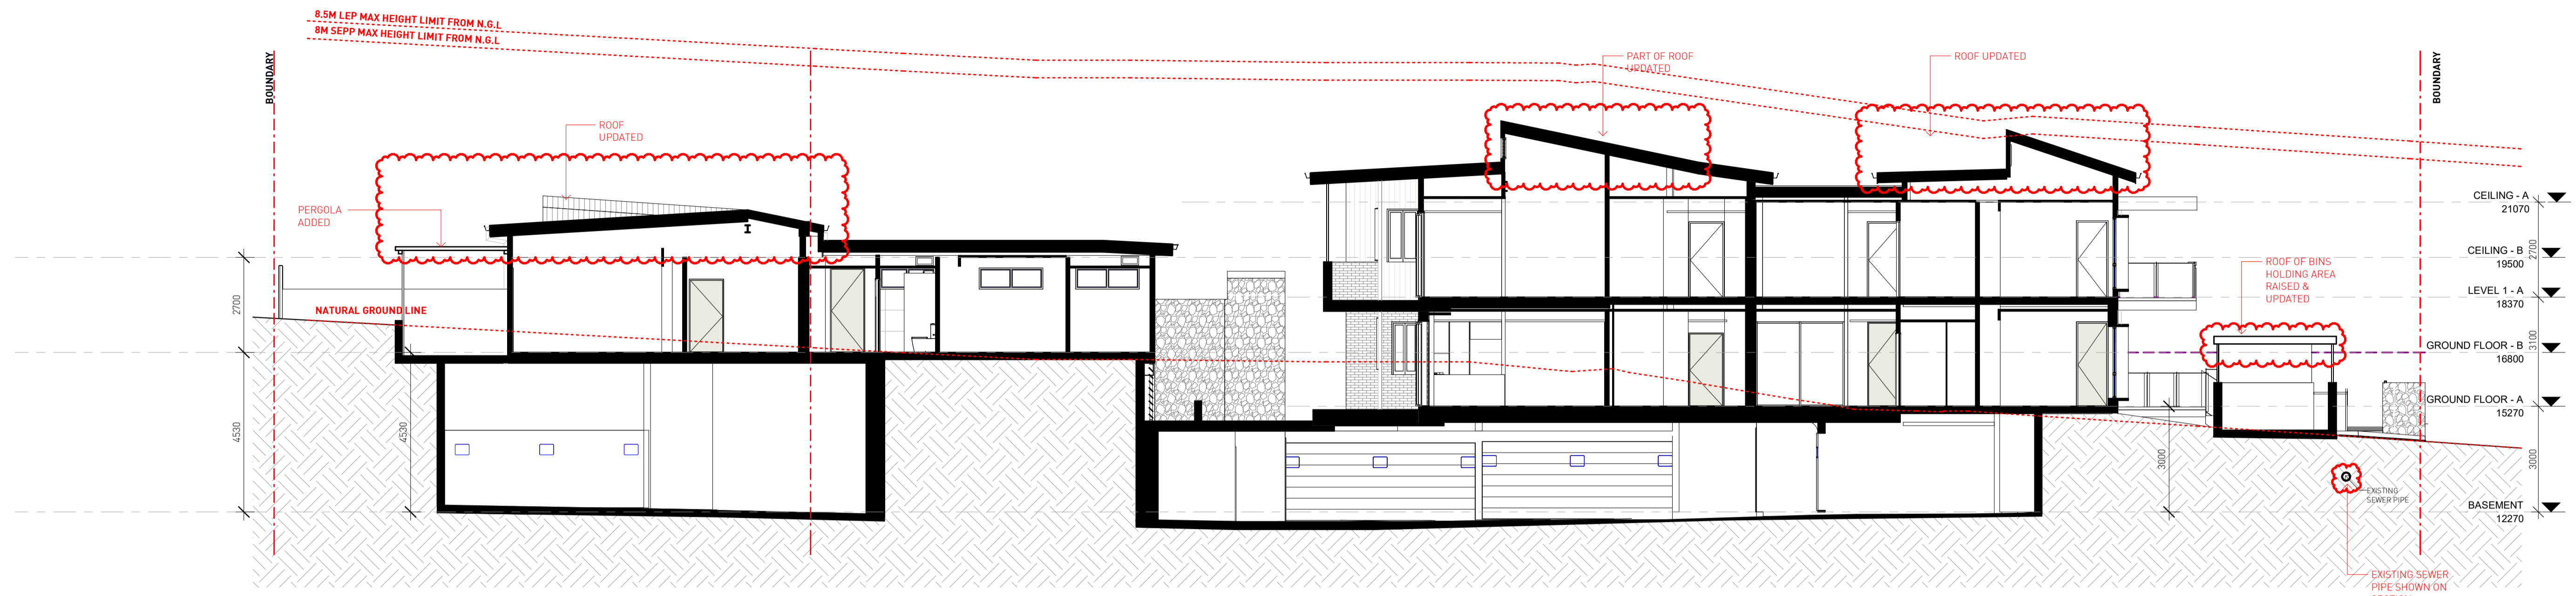

1 SECTION AA
DA012
1:100

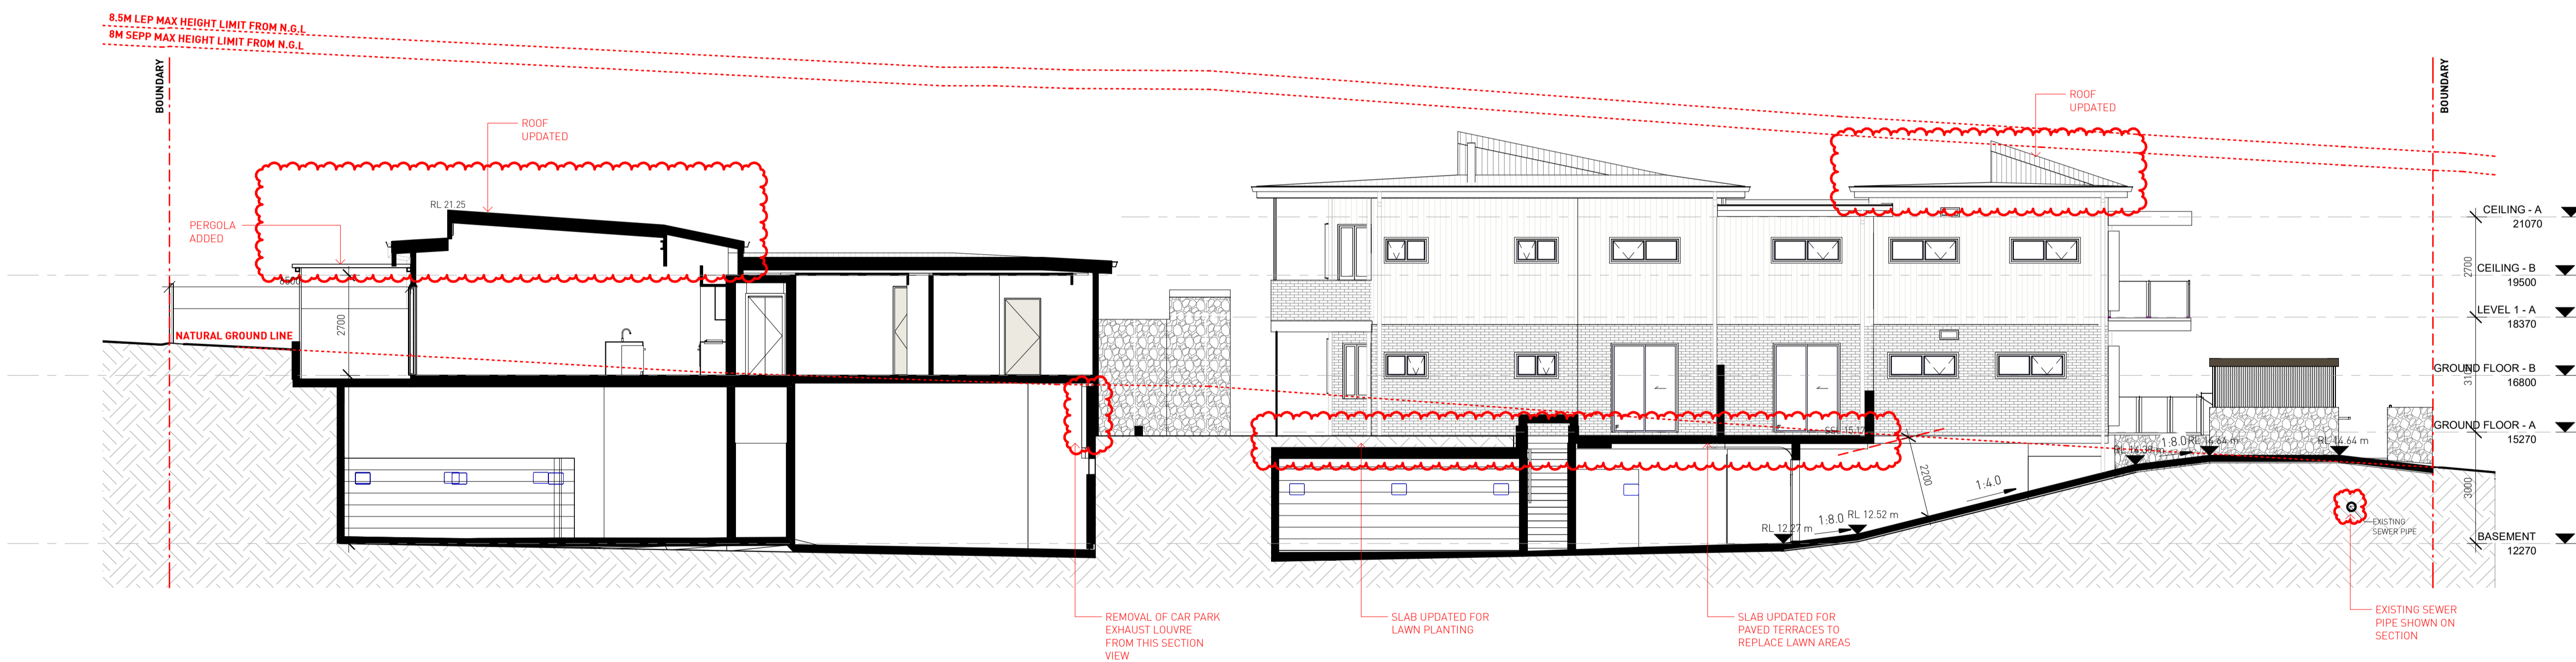

2 SECTION BB
DA012
1:100

No.	Date	Description
J	11/02/22	ISSUED FOR S4.56(1) APPROVAL
I	08/10/21	ISSUED FOR S4.56(1) APPROVAL
H	16/03/21	ISSUED FOR APPROVAL
G	03/09/20	ISSUED FOR APPROVAL
F	01/09/20	ISSUED FOR COORDINATION
E	31/08/20	ISSUED FOR COORDINATION
D	21/08/20	ISSUED FOR COORDINATION; ACCESS COMMENTS INCORPORATED; BASEMENT AMENDED; WINDOW TAGS ADDED
C	20/08/20	ISSUED FOR COORDINATION; REVISED PLANNING ITEMS
B	18/08/20	ISSUED FOR COORDINATION
A	24/07/20	ISSUED FOR INFORMATION

GILES TRIBE Level 1, 1 Chandos Street
ST LEONARDS NSW 2065
P 61 2 9244 5005
E gtr@gilestribe.com.au
Giles Tribe Pty Ltd ABN 50 601259 507
Mark G Broadley (3823) Stuart D Hill (6459)


Verify all dimensions on site prior to commencement of work.
Refer all discrepancies to the Architect for determination.
Use figured dimensions in preference to scaling.
This drawing is copyright and must not be retained, copied or used without the written consent of Giles Tribe Architects.

Built Property
Project
**54 BARDO ROAD
NEWPORT 2106
NSW**


SECTION AA & BB

Status: **FOR S4.56(1) APPROVAL**


Scale: 1:100 Job No. Drawing No. Rev.
Sheet Size: A1 **20055 DA012 J**
Date: 06/19/20 Drawn: YL Reviewed: VY

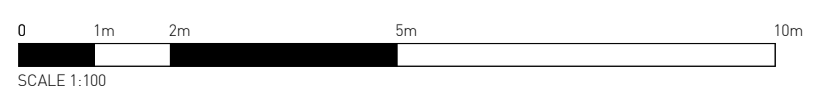

V:\GILES\TRIBE - 3\Drawings\19\20055\01 - Rev004_Bardo_Rd_Newport_NSW\019_54_56(1).rvt

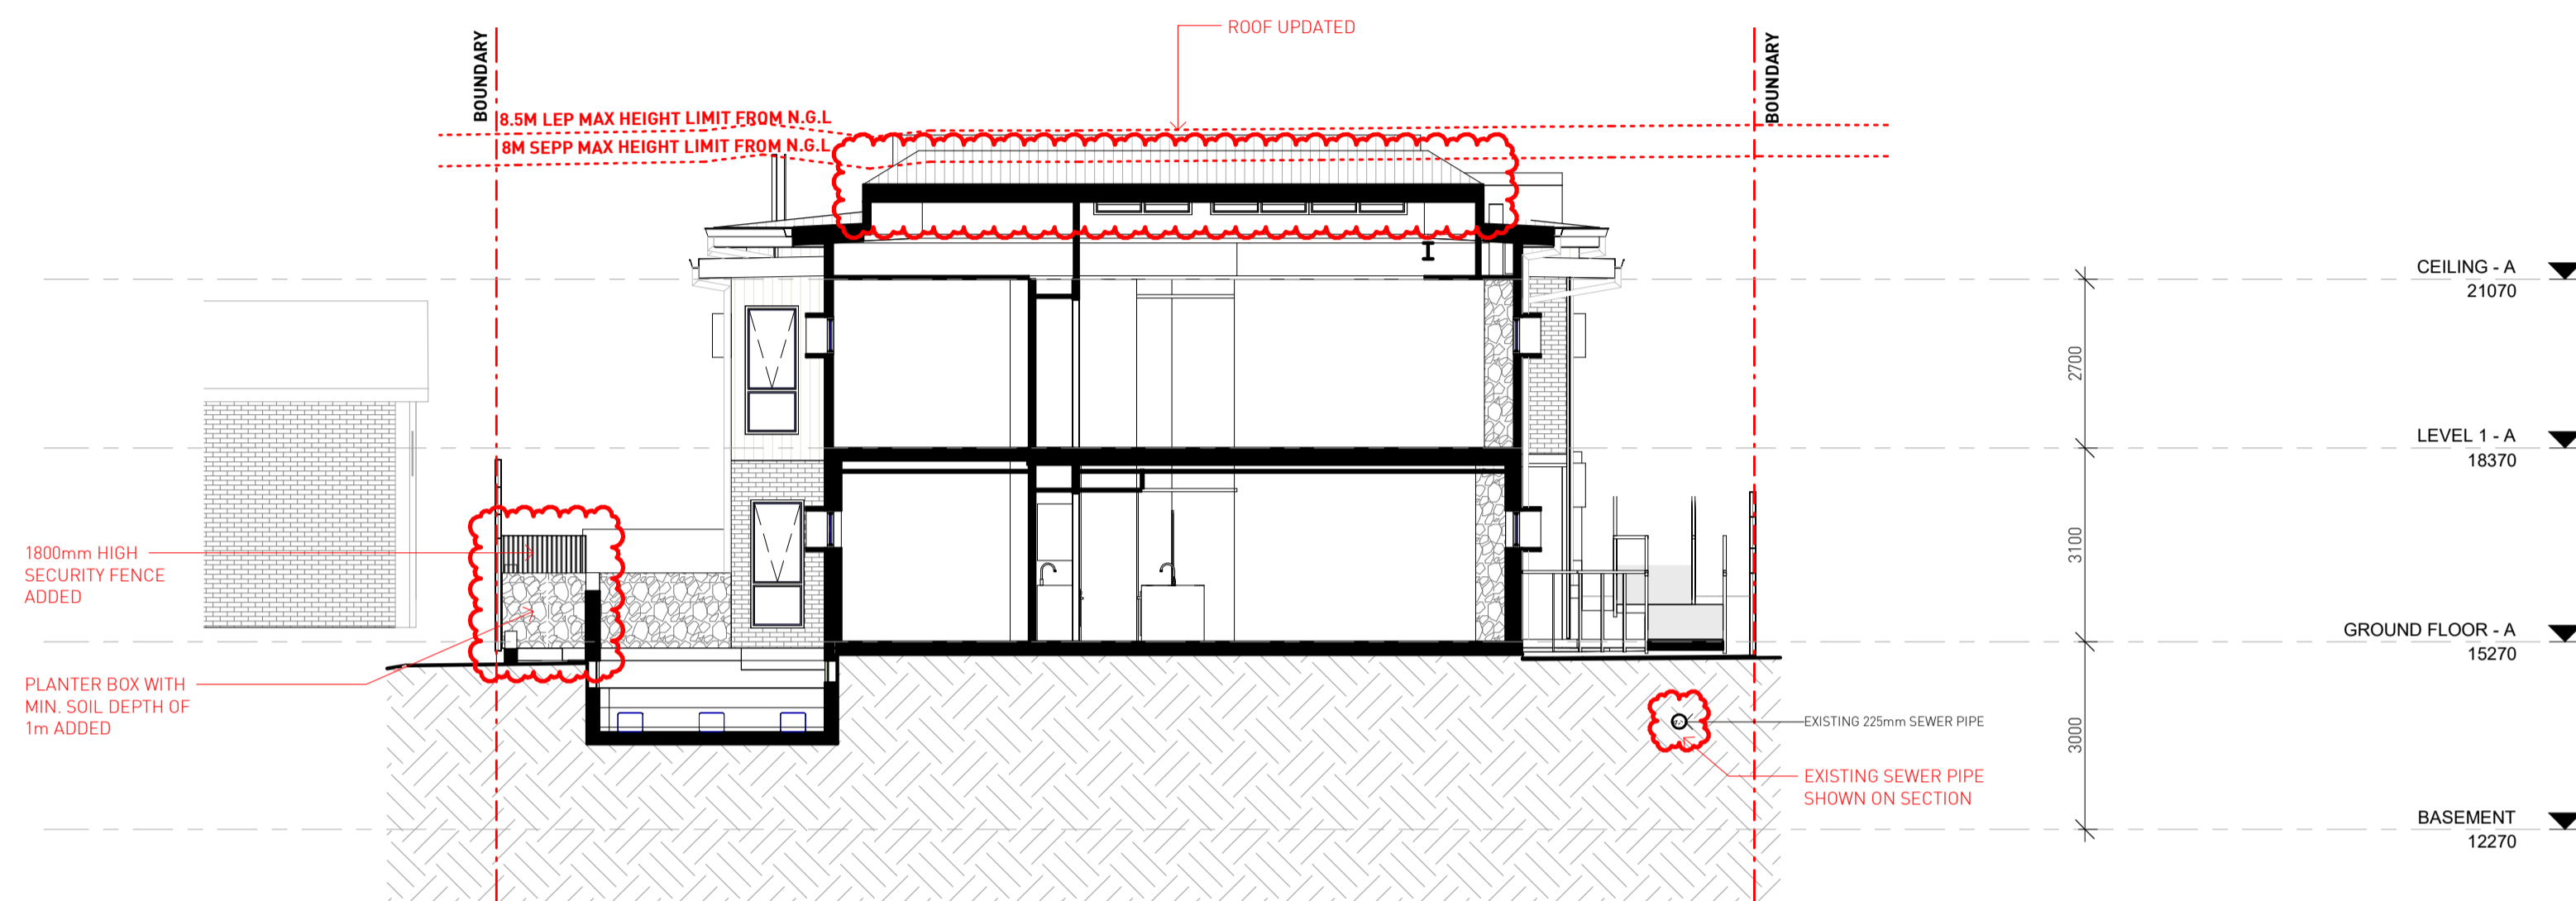

1 SECTION CC
DA013 1 : 100

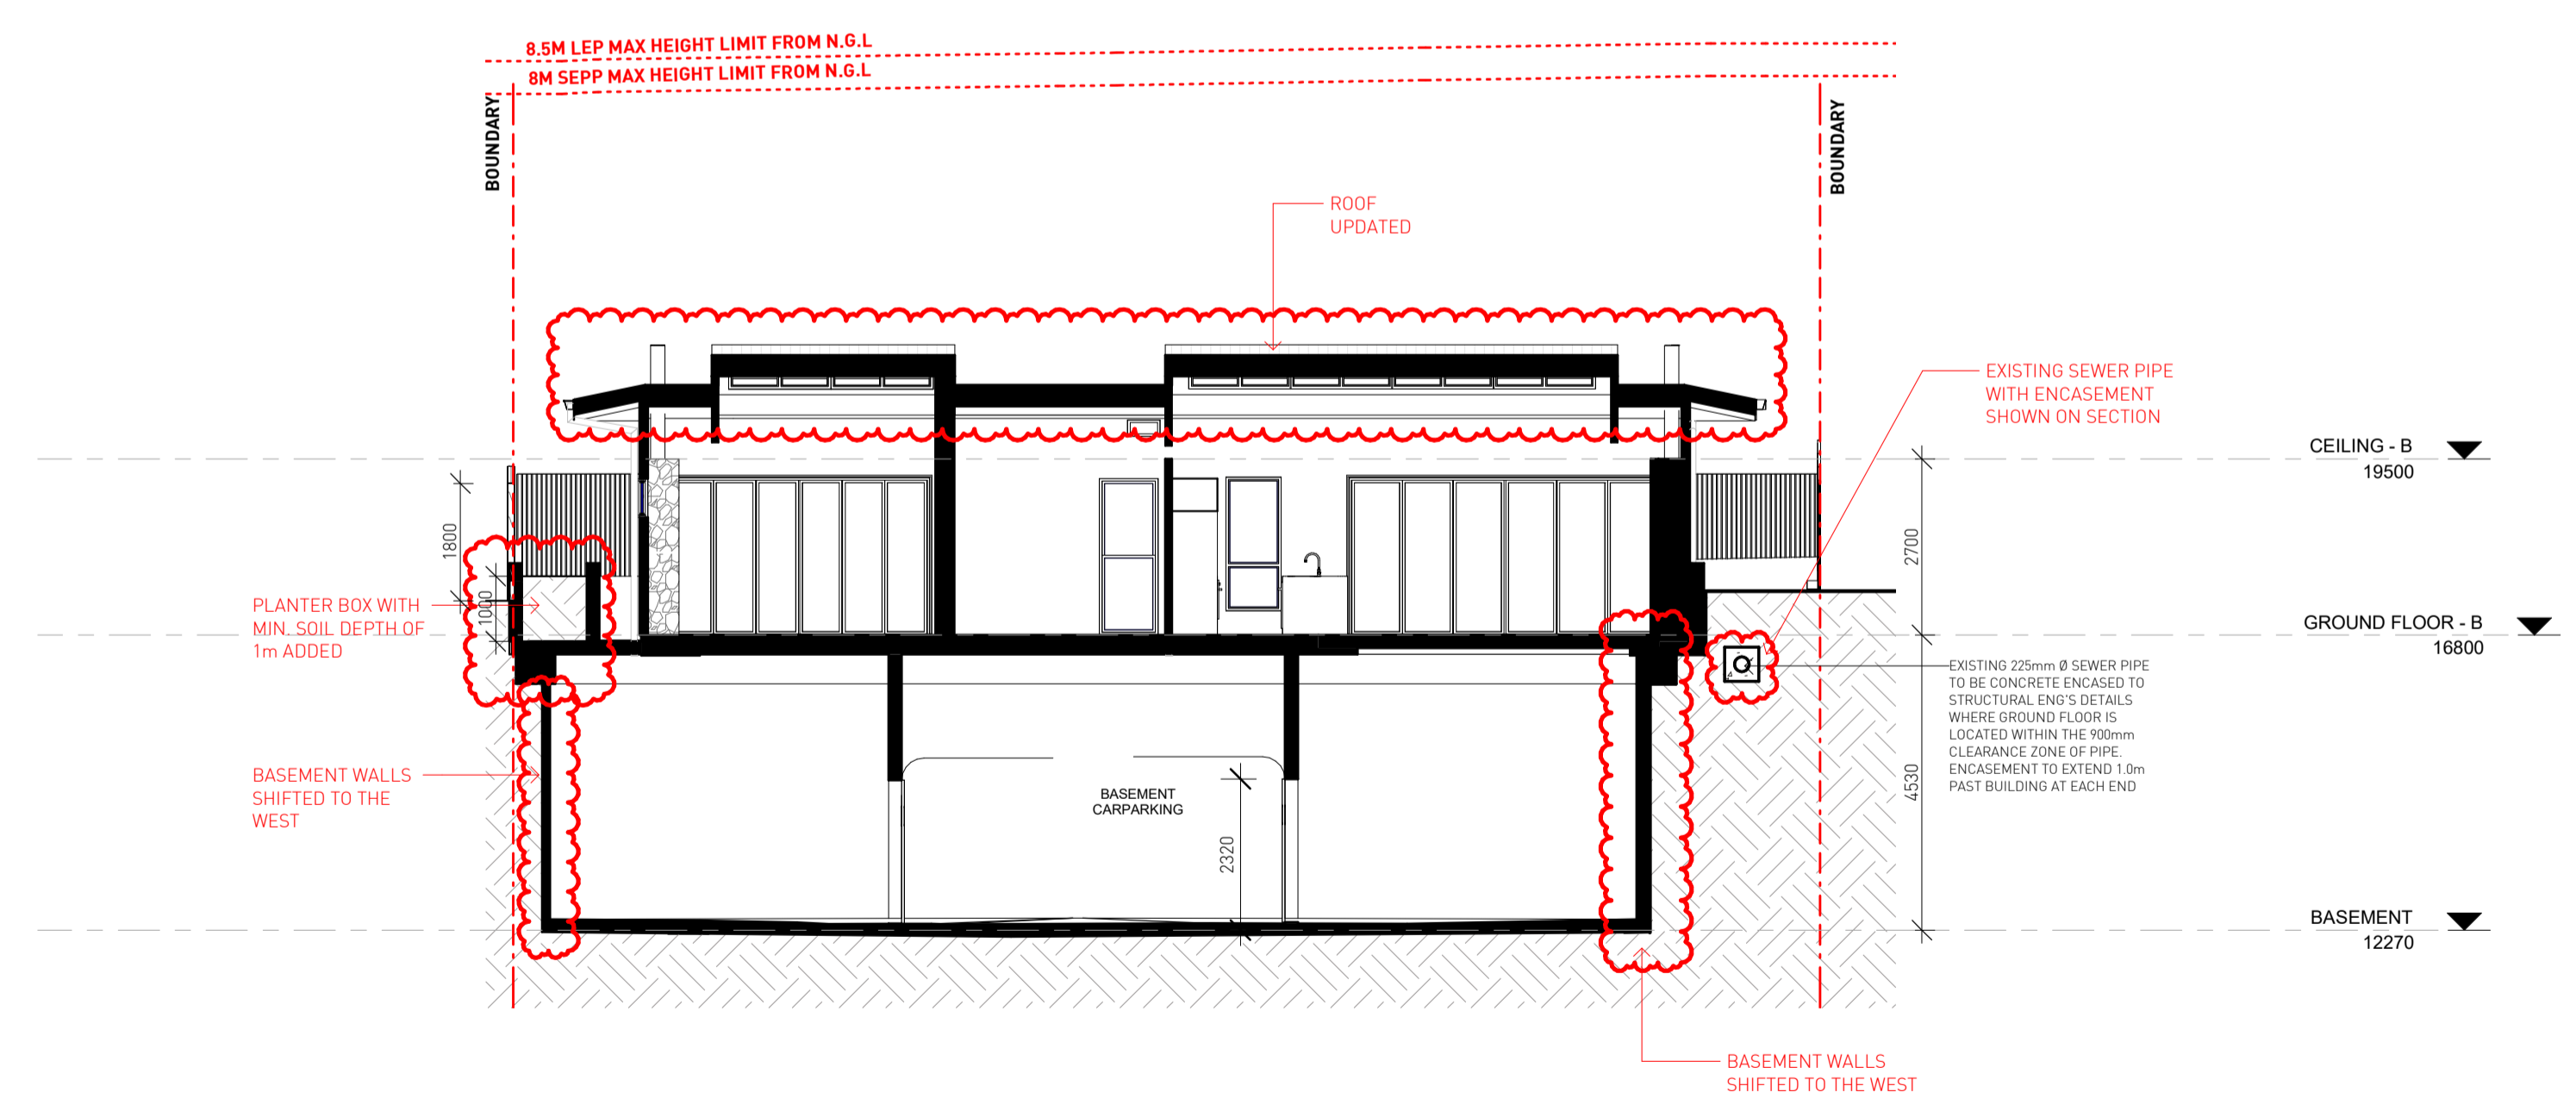

2 SECTION DD
DA013 1 : 100

No.	Date	Description
J	11/02/22	ISSUED FOR S4.56(1) APPROVAL
I	08/10/21	ISSUED FOR S4.56(1) APPROVAL
H	16/03/21	ISSUED FOR APPROVAL
G	03/09/20	ISSUED FOR APPROVAL
F	01/09/20	ISSUED FOR COORDINATION
E	31/08/20	ISSUED FOR COORDINATION
D	20/08/20	ISSUED FOR COORDINATION, REVISED PLANNING ITEMS
C	18/08/20	ISSUED FOR COORDINATION
B	29/07/20	ISSUED FOR PRE-DA MEETING
A	24/07/20	ISSUED FOR INFORMATION

Amendments

GILES TRIBE Level 1, 1 Chandos Street
ST LEONARDS NSW 2065
P 61 2 9254 5055
E gtr@gilestribe.com.au
Giles Tribe Pty Ltd ABN 50 001259 507

Nominated Architects: Mark G Broadley (3823) Stuart D Hill (6459)


Verify all dimensions on site prior to commencement of work.
Refer all discrepancies to the Architect for determination.
Use figured dimensions in preference to scaling.
This drawing is copyright and must not be retained, copied, or used without the written consent of Giles Tribe Architects.

Client: **Built Property**
Project: **54 BARDO ROAD NEWPORT 2106 NSW**

Drawn: **SECTION CC & DD**

Status: **FOR S4.56(1) APPROVAL**

Scale: 1 : 100 Job No. Drawing No. Rev.
Sheet Size: A1 **20055 DA013 J**
Date: 06/19/20 Drawn: YL Reviewed: VY

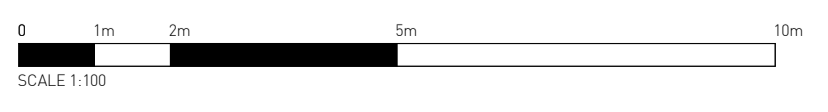

V:\GILES\TRIBE - Drawings\2020\2005501 - Rev004_Bardo Rd, Newport, NSW\019_54_5611.rvt

LANDSCAPING AREA FIGURE
UPDATED

LANDSCAPING AREA
(407.45 m² = 33.23%)


REQUIREMENT: 30% OF SITE
AREA
(1226.32m² X 0.3 = 367.90 m²)

SRZ - STRUCTURAL ROOT
ZONE

TPZ - TREE PROTECTION
ZONE

TREES FOR
REMOVAL

TREES 2, 3, 4, 7, 8, 12, 13 TO BE
RETAINED. REFER TO ARBORIST'S
REPORT.

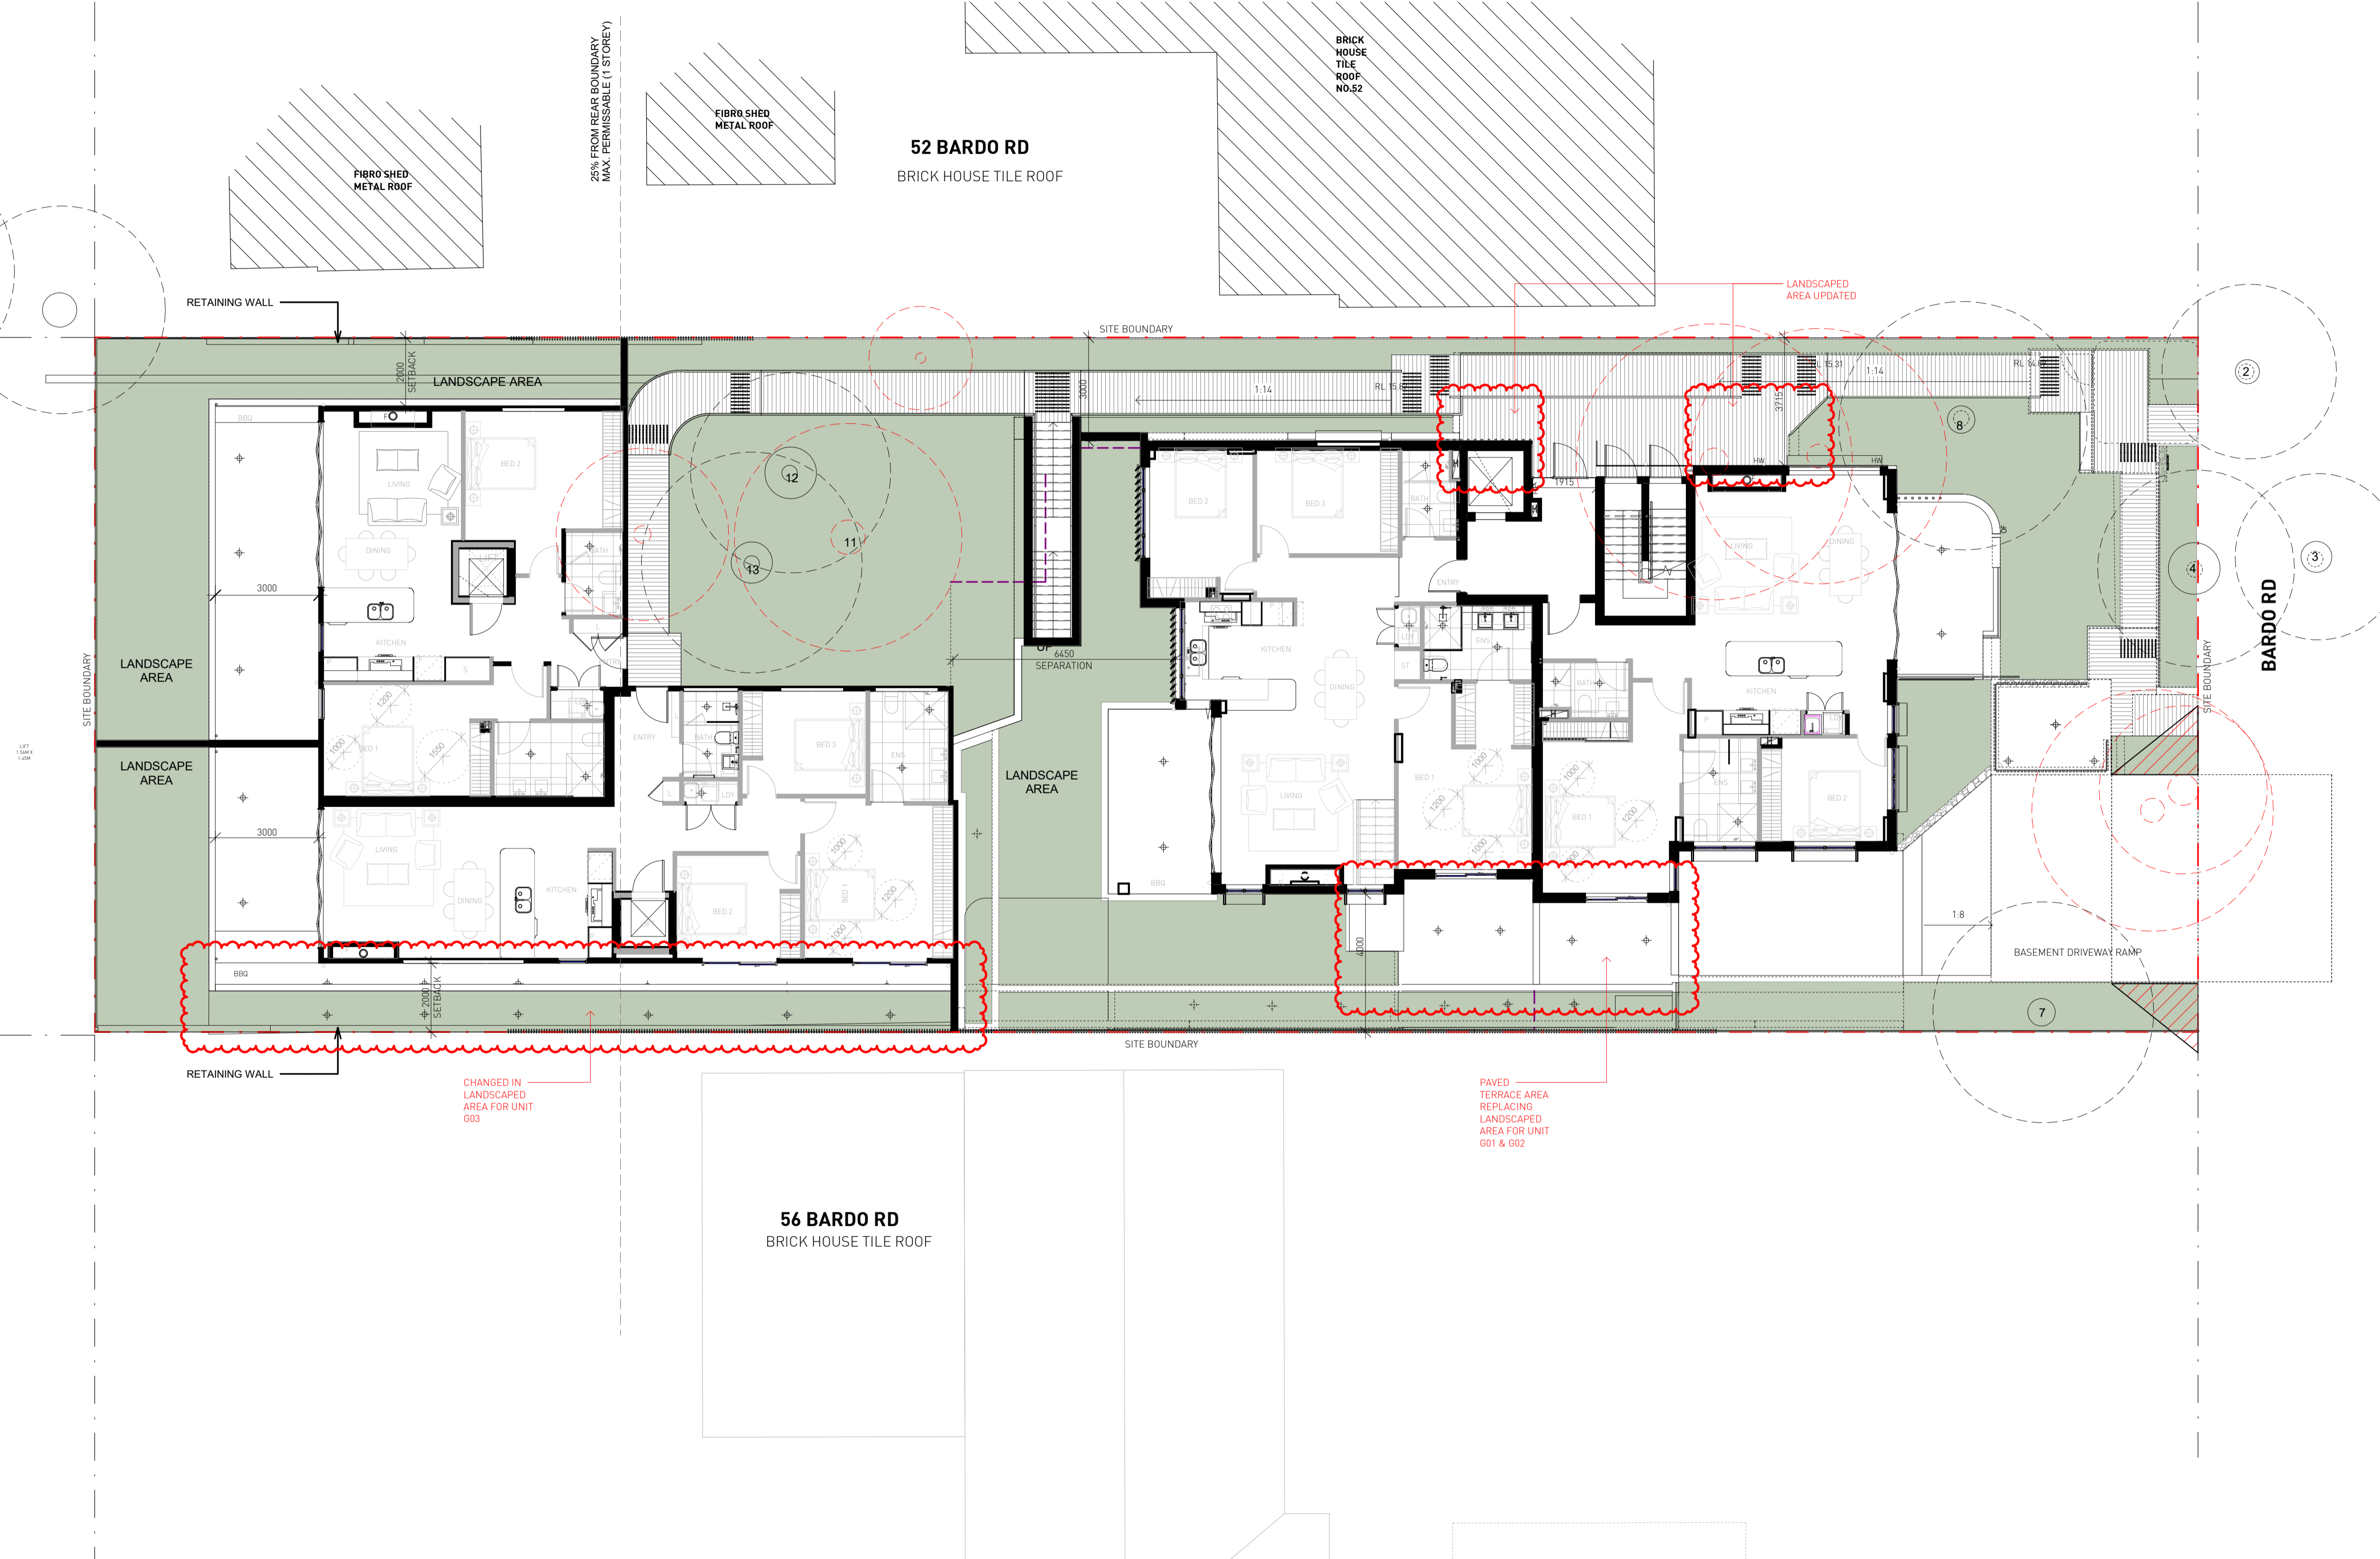

No.	Date	Description
M	11/02/22	ISSUED FOR S4.56(1) APPROVAL
L	08/10/21	ISSUED FOR S4.56(1) APPROVAL
K	11/03/21	ISSUED FOR APPROVAL
J	03/09/20	ISSUED FOR APPROVAL
I	01/09/20	ISSUED FOR COORDINATION
H	31/08/20	ISSUED FOR COORDINATION
G	24/08/20	ISSUED FOR COORDINATION, BASEMENT AMENDED
F	24/08/20	ISSUED FOR COORDINATION
E	21/08/20	ISSUED FOR COORDINATION, ACCESS COMMENTS INCORPORATED, BASEMENT AMENDED, WINDOW TAGS ADDED
D	20/08/20	ISSUED FOR COORDINATION, REVISED PLANNING ITEMS
C	18/08/20	ISSUED FOR COORDINATION
B	29/07/20	ISSUED FOR PRE-DA MEETING
A	24/07/20	ISSUED FOR INFORMATION

GILES TRIBE Level 1, 1 Chandos Street
ST LEONARDS NSW 2065
P 61 2 9254 5005
E gtr@gilestribe.com.au
Giles Tribe Pty Ltd ABN 50 801259 507
Nominated Architects: Mark G Broadley (3823) Stuart D Hill (6459)


Verify all dimensions on site prior to commencement of work.
Refer all discrepancies to the Architect for determination.
Use figured dimensions in preference to scaling.
This drawing is copyright and must not be retained, copied,
or used without the written consent of Giles Tribe Architects.

Client: **Built Property**
Project: **54 BARDO ROAD
NEWPORT 2106
NSW**

LANDSCAPE CALCULATION PLAN

Status: **FOR S4.56(1) APPROVAL**


Scale: 1 : 100 Job No. Drawing No. Rev.
Sheet Size: A1 **20055 DA014 M**
Date: 06/19/20
Drawn: Author Reviewed: Checker

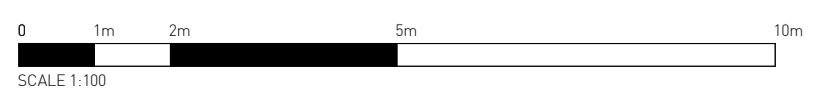

V:\GILES\TRIBE\Drawings\2020\20055\01 - Rev004_Bardo Rd, Newport, NSW\0106_S4_56(1).rvt

DEEP SOIL AREA
 FRONT: 56.79m² (22.54%)
 REAR: 195.16m² (77.46%)
 TOTAL: 251.95m² = 20.55% OF SITE AREA
 REQUIREMENT: 15% OF SITE AREA
 1226.32m² X 0.15 = 183.94m²

FIGURE
 UPDATED

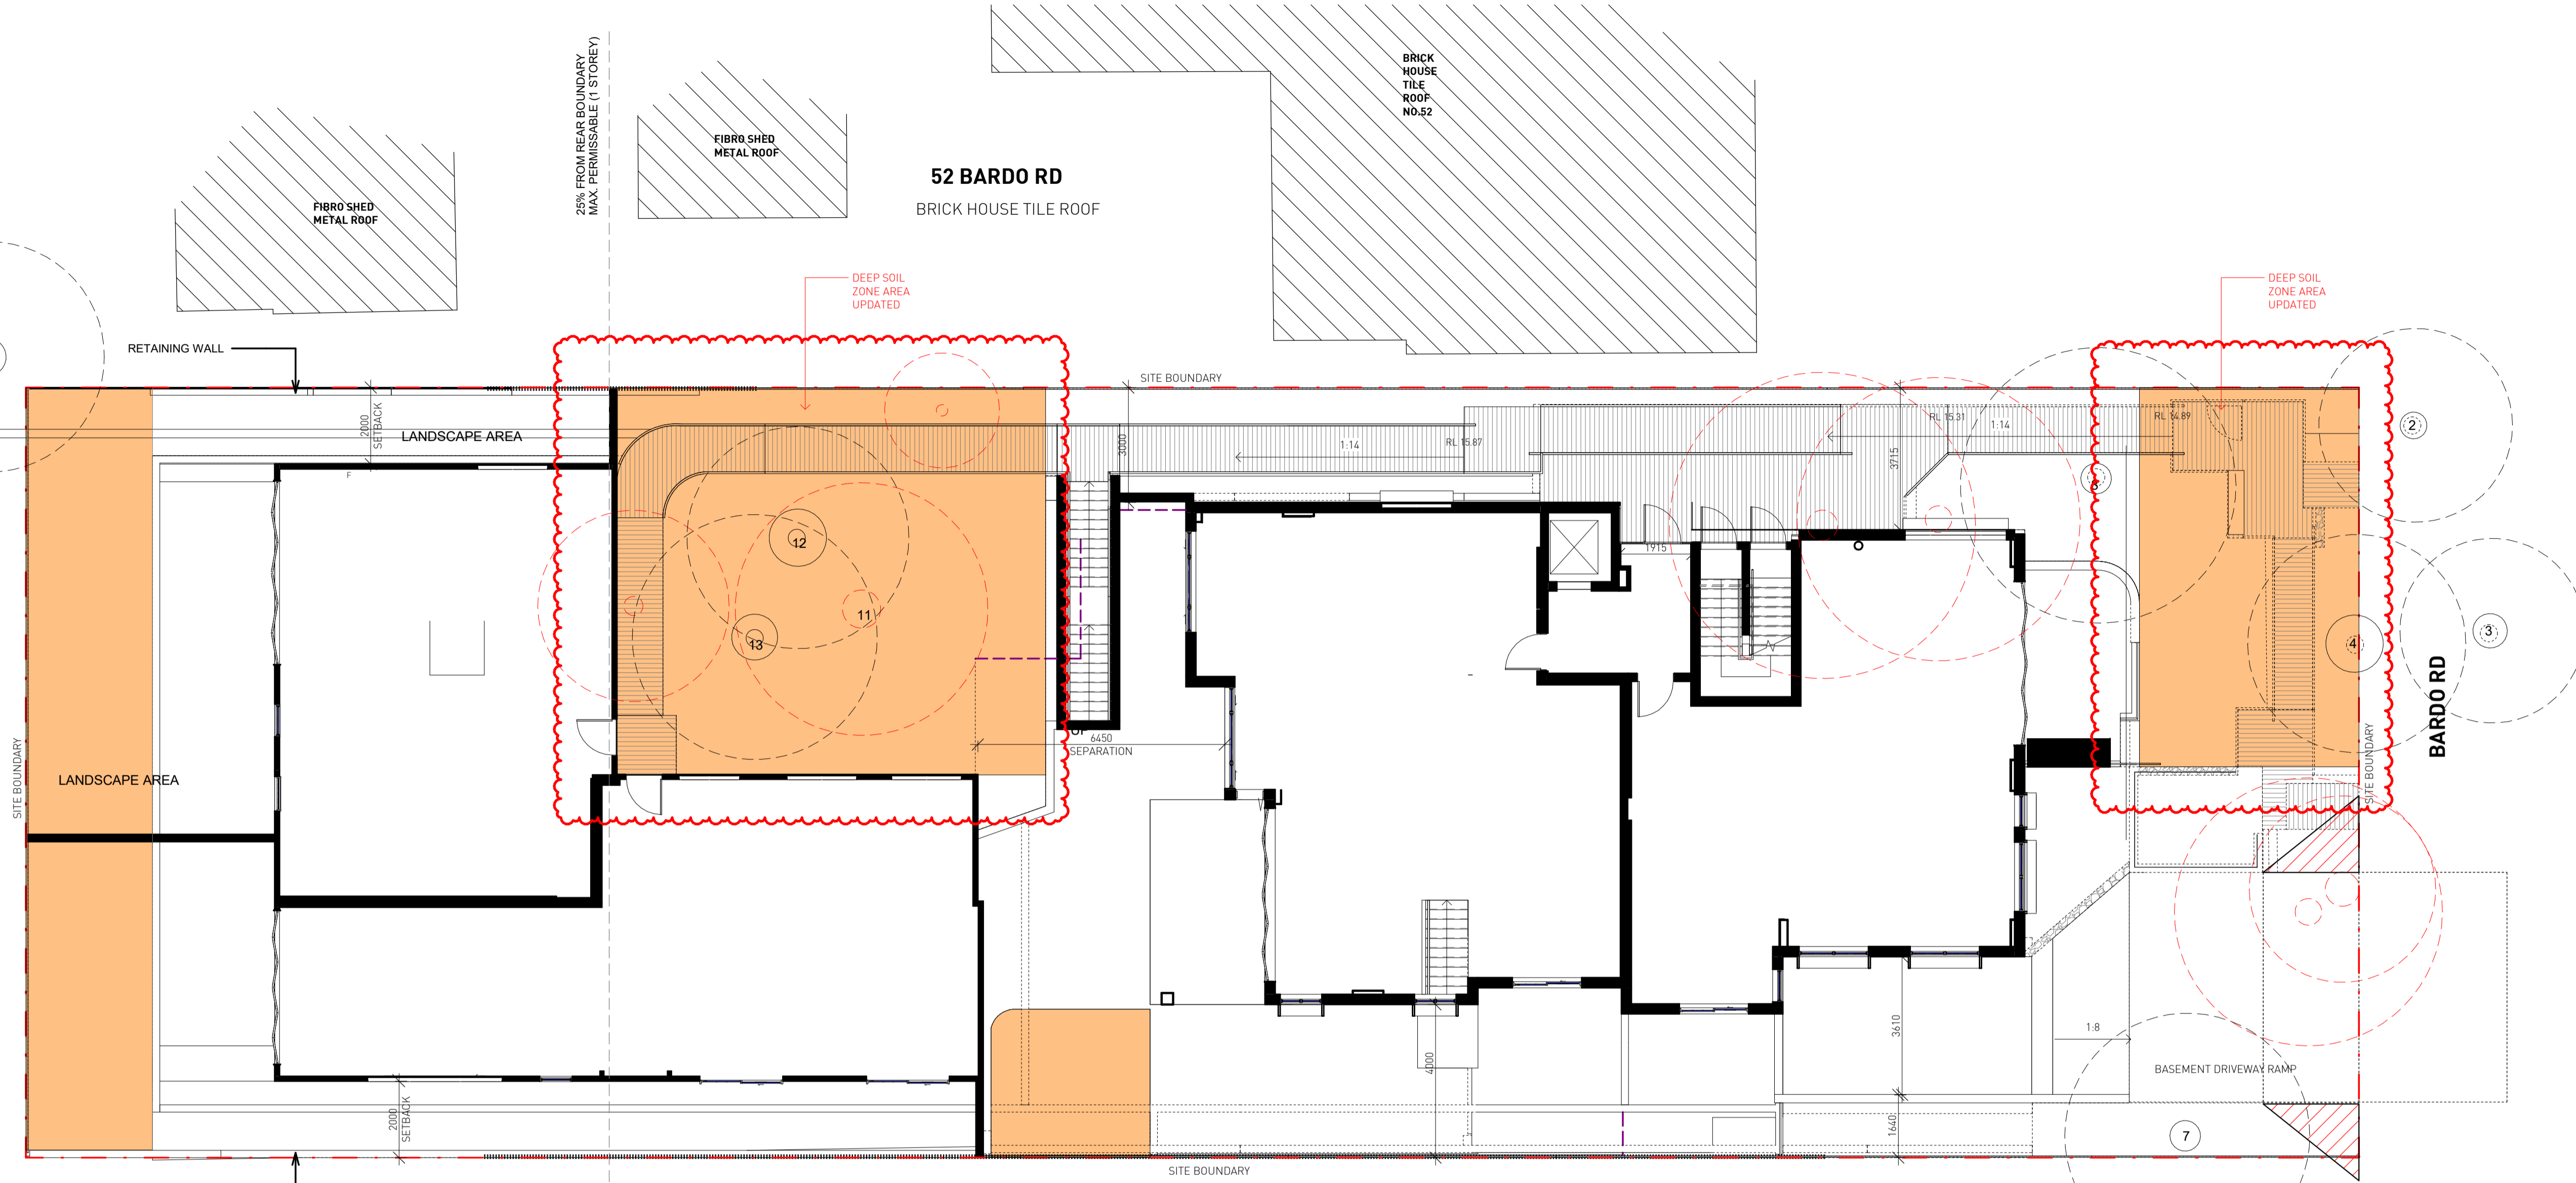

L	11/02/22	ISSUED FOR S4.56(1) APPROVAL
K	08/10/21	ISSUED FOR S4.56(1) APPROVAL
J	16/03/21	ISSUED FOR APPROVAL
I	03/09/20	ISSUED FOR APPROVAL
H	01/09/20	ISSUED FOR COORDINATION
G	31/08/20	ISSUED FOR COORDINATION
F	24/08/20	ISSUED FOR COORDINATION
E	21/08/20	ISSUED FOR COORDINATION; ACCESS COMMENTS INCORPORATED; BASEMENT AMENDED; WINDOW TAGS ADDED
D	20/08/20	ISSUED FOR COORDINATION; REVISED PLANNING ITEMS
C	18/08/20	ISSUED FOR COORDINATION
B	29/07/20	ISSUED FOR PRE-DA MEETING
A	24/07/20	ISSUED FOR INFORMATION
No.	Date	Description

GILES TRIBE Level 1, 1 Chandos Street
 ST LEONARDS NSW 2066
 P 61 2 9254 5005
 E gtr@gilestribe.com.au
 Giles Tribe Pty Ltd ABN 50 001259 507
 Nominated Architects: Mark G Broadley (3823) Stuart D Hill (6459)


Verify all dimensions on site prior to commencement of work.
 Refer all discrepancies to the Architect for determination.
 Use figured dimensions in preference to scaling.
 This drawing is copyright and must not be retained, copied, or used without the written consent of Giles Tribe Architects.

Built Property
 Project:
54 BARDO ROAD
NEWPORT 2106
NSW


Drawn:
DEEP SOIL PLAN

Status: **FOR S4.56(1) APPROVAL**

Scale: 1 : 100 Job No. Drawing No. Rev.
 Sheet Size: A1
 Date: 07/22/20 **20055 DA015 L**
 Drawn: Author Reviewed: Checker

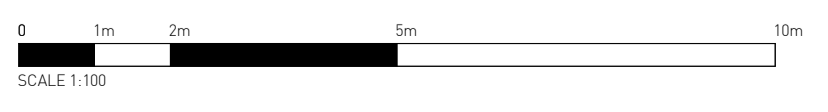

V:\GILES\TRIBE\Drawings\2020\2005501 - Rev004 - Bardos Rd, Newport, NSW\015 - S4.56(1).rvt

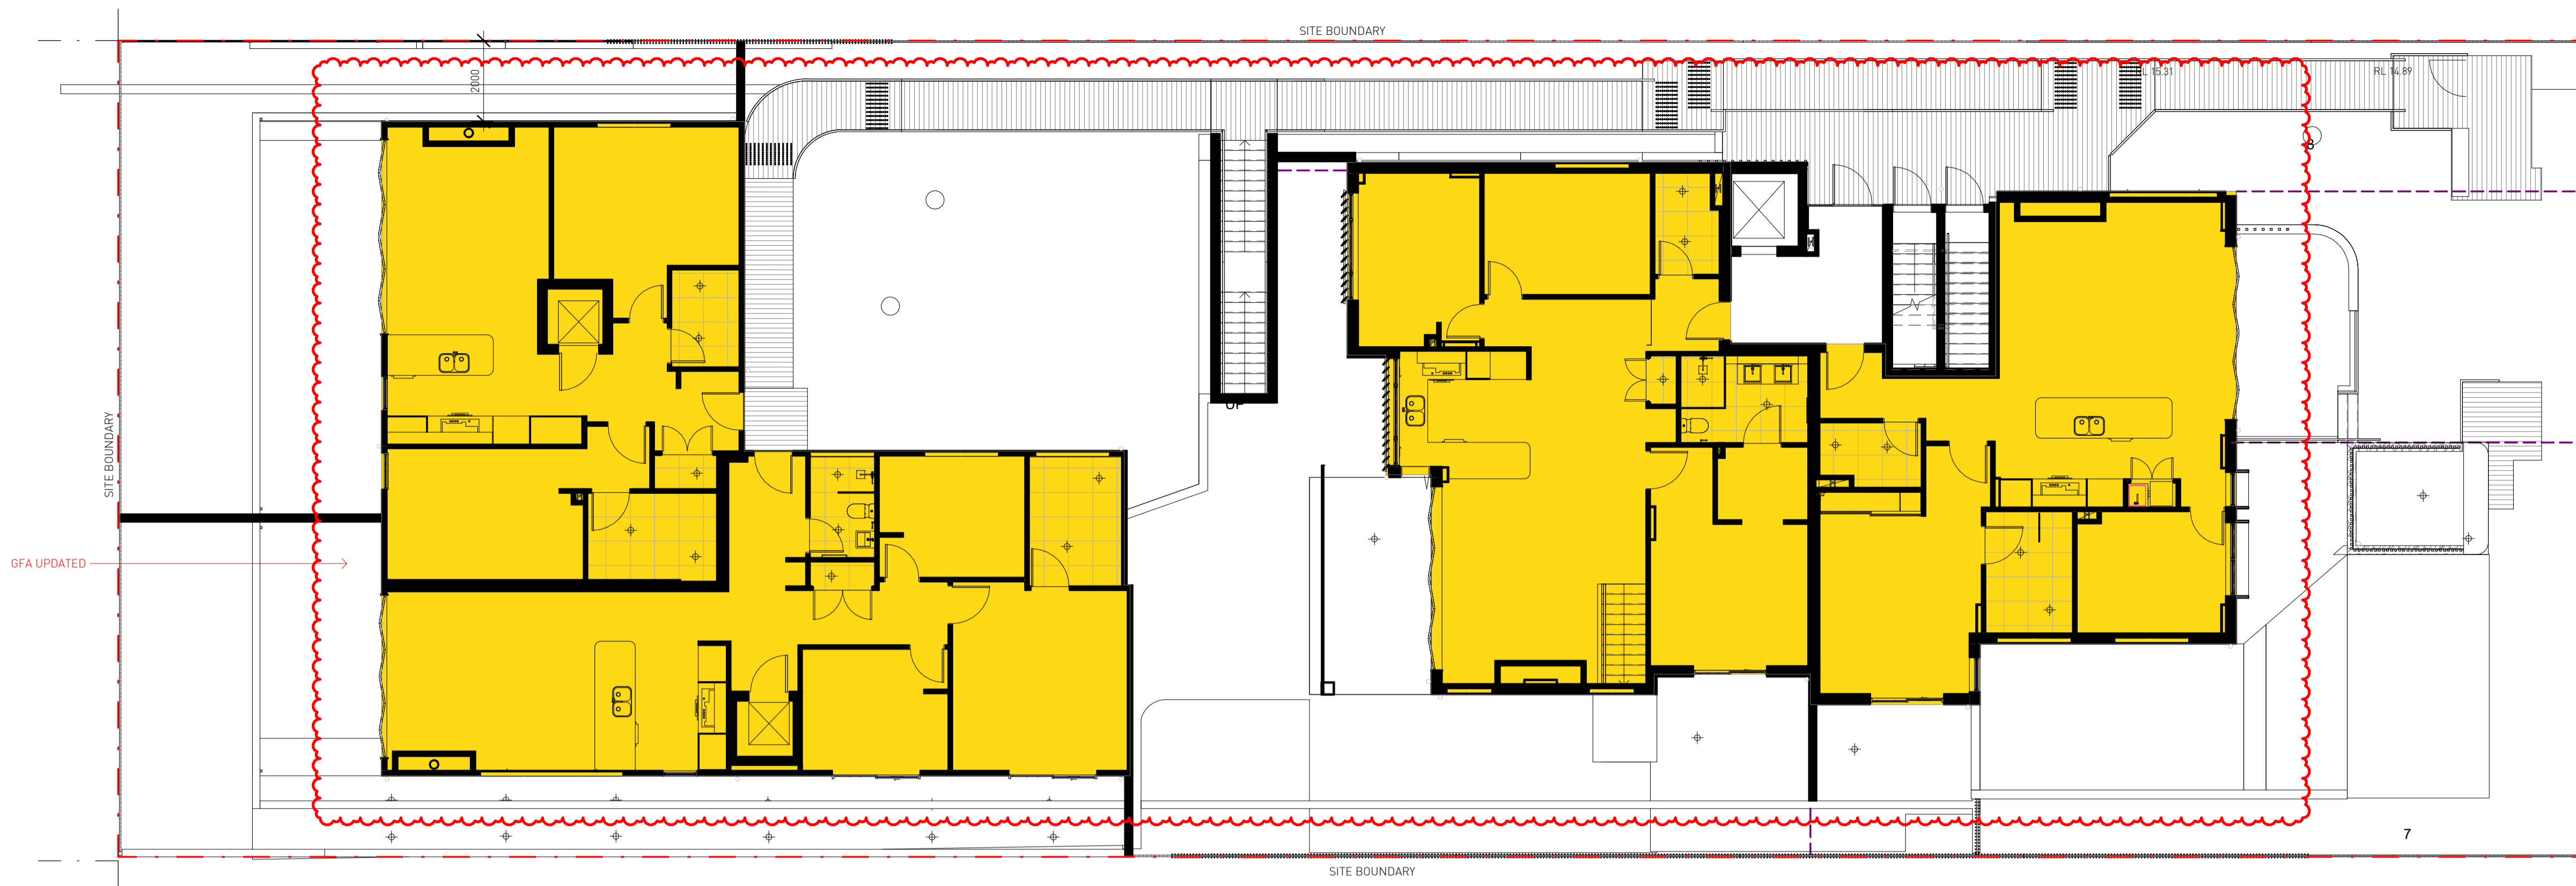


1 GFA - GROUND FLOOR
DA016 1:100

GROUND FLOOR GFA	448.78m ²
LEVEL 1 GFA	239.29m ²
TOTAL GFA	688.07m ²
SITE AREA	1226.32m ²
FSR	0.561:1

GFA CALCULATION
UPDATED

BARDO RD

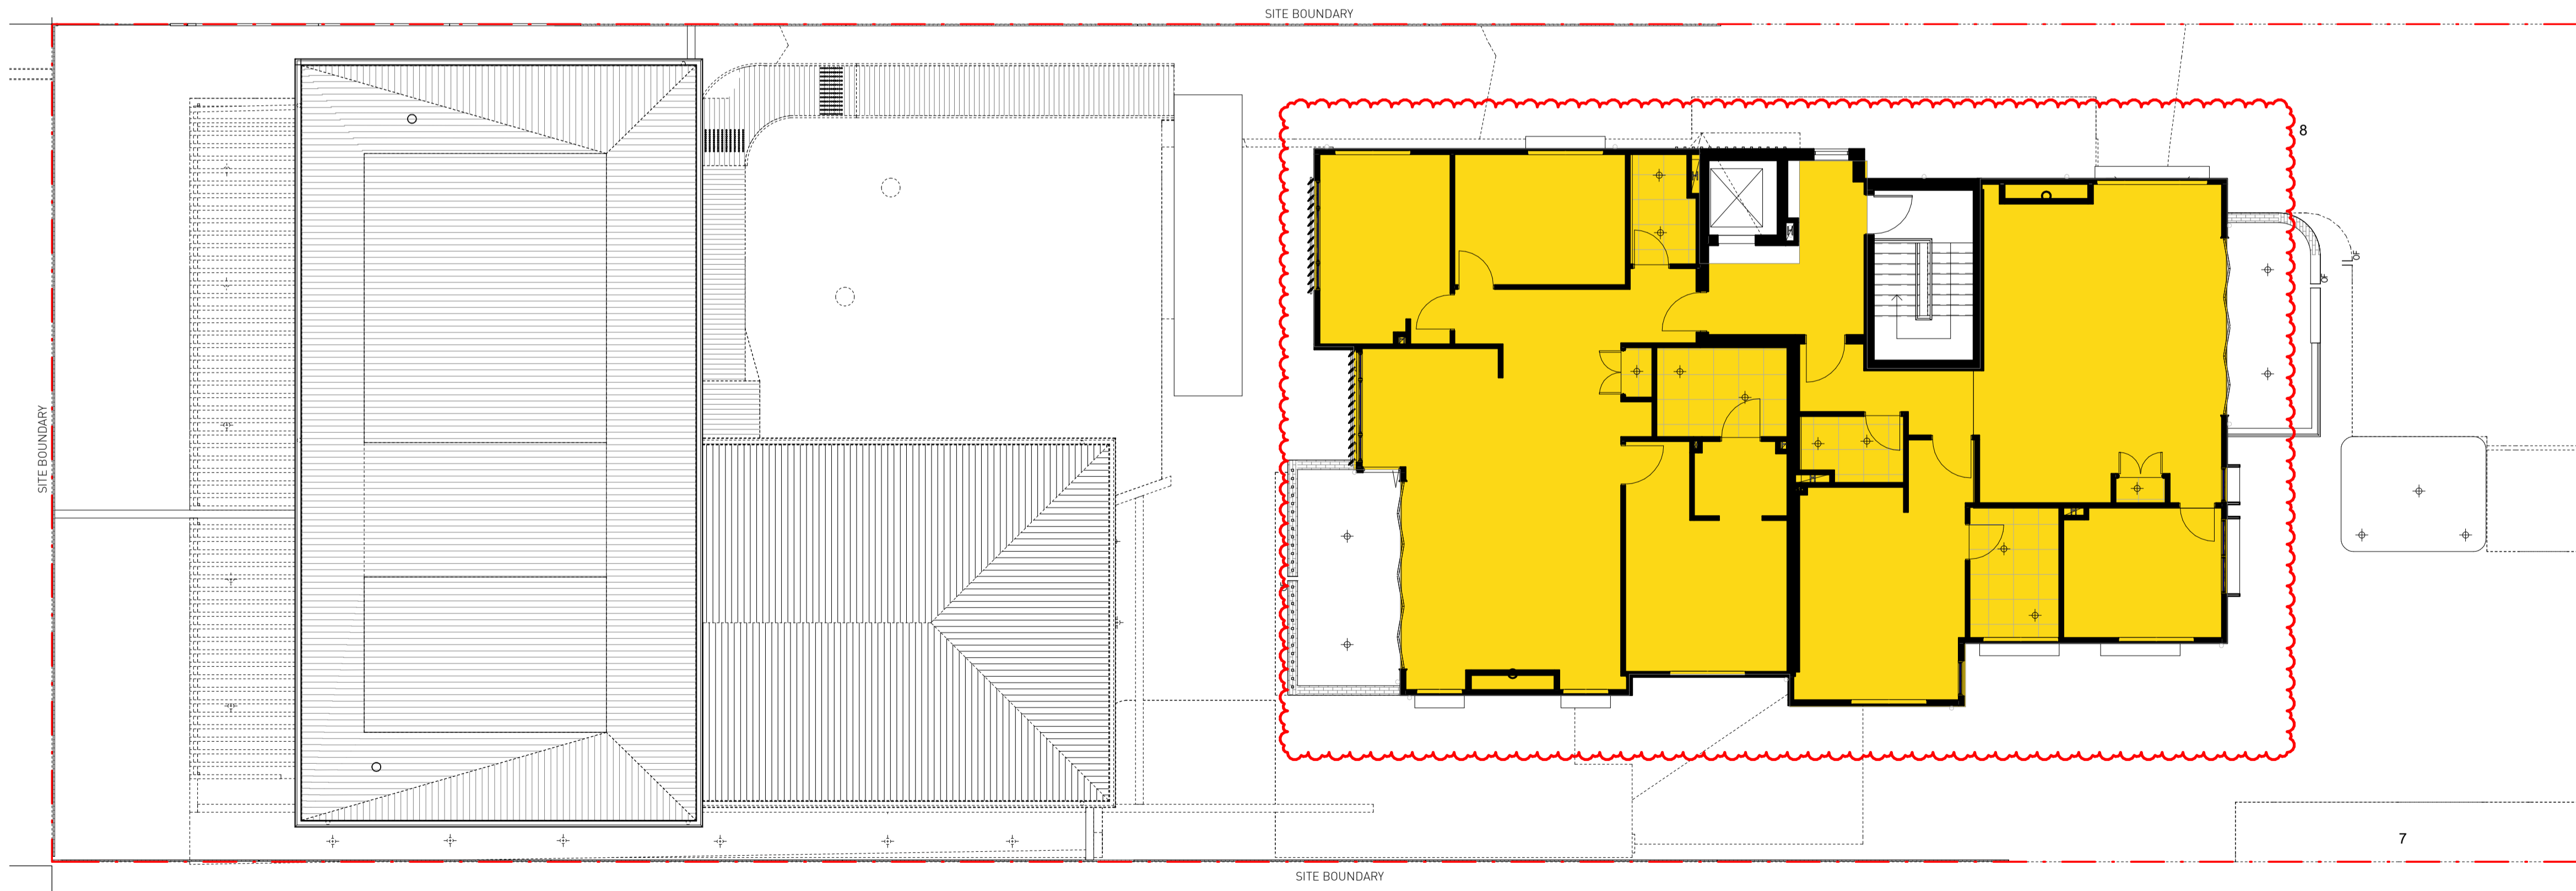

2 GFA - LEVEL 1
DA016 1:100

No.	Date	Description
K	11/02/22	ISSUED FOR S4.56(1) APPROVAL
J	08/10/21	ISSUED FOR S4.56(1) APPROVAL
I	16/03/21	ISSUED FOR APPROVAL
H	03/09/20	ISSUED FOR APPROVAL
G	01/09/20	ISSUED FOR COORDINATION
F	31/08/20	ISSUED FOR COORDINATION
E	21/08/20	ISSUED FOR COORDINATION; ACCESS COMMENTS INCORPORATED; BASEMENT AMENDED; WINDOW TAGS ADDED
D	20/08/20	ISSUED FOR COORDINATION; REVISED PLANNING ITEMS
C	18/08/20	ISSUED FOR COORDINATION
B	29/07/20	ISSUED FOR PRE-DA MEETING
A	24/07/20	ISSUED FOR INFORMATION

GILES TRIBE Level 1, 1 Chandos Street
ST LEONARDS NSW 2865
P 61 2 9294 5005
E gtr@gilestribe.com.au
Giles Tribe Pty Ltd ABN 50 801259 507
Nominated Architects: Mark G Broadley (3823) Stuart D Hill (6459)

Verify all dimensions on site prior to commencement of work.
Refer all discrepancies to the Architect for determination.
Use figured dimensions in preference to scaling.
This drawing is copyright and must not be retained, copied, or used without the written consent of Giles Tribe Architects.

Built Property
Client:
Project:
**54 BARDO ROAD
NEWPORT 2106
NSW**

GFA CALCULATIONS

Status: **FOR S4.56(1) APPROVAL**

Scale:	1:100	Job No.	20055	Drawing No.	DA016 K	Rev.	
Sheet Size:	A1	Author	Reviewed	Checked			
Date:	06/19/20						



V:\GILES\2020\20055\1 - Rev004 - BarDO RD - Newport - NSW\019 - SA - 5611.rvt

ADDITIONAL OVERSHADOW CAUSED BY HEIGHT EXCEEDANCE

SHADOW DIAGRAMS REVISED DUE TO ROOF UPDATED


ADDITIONAL OVERSHADOW CAUSED BY HEIGHT EXCEEDANCE SHOWN IN RED ADDED



1 SHADOW - JUNE 21 9AM
DA017 1:500




2 SHADOW - JUNE 21 10AM
DA017 1:500

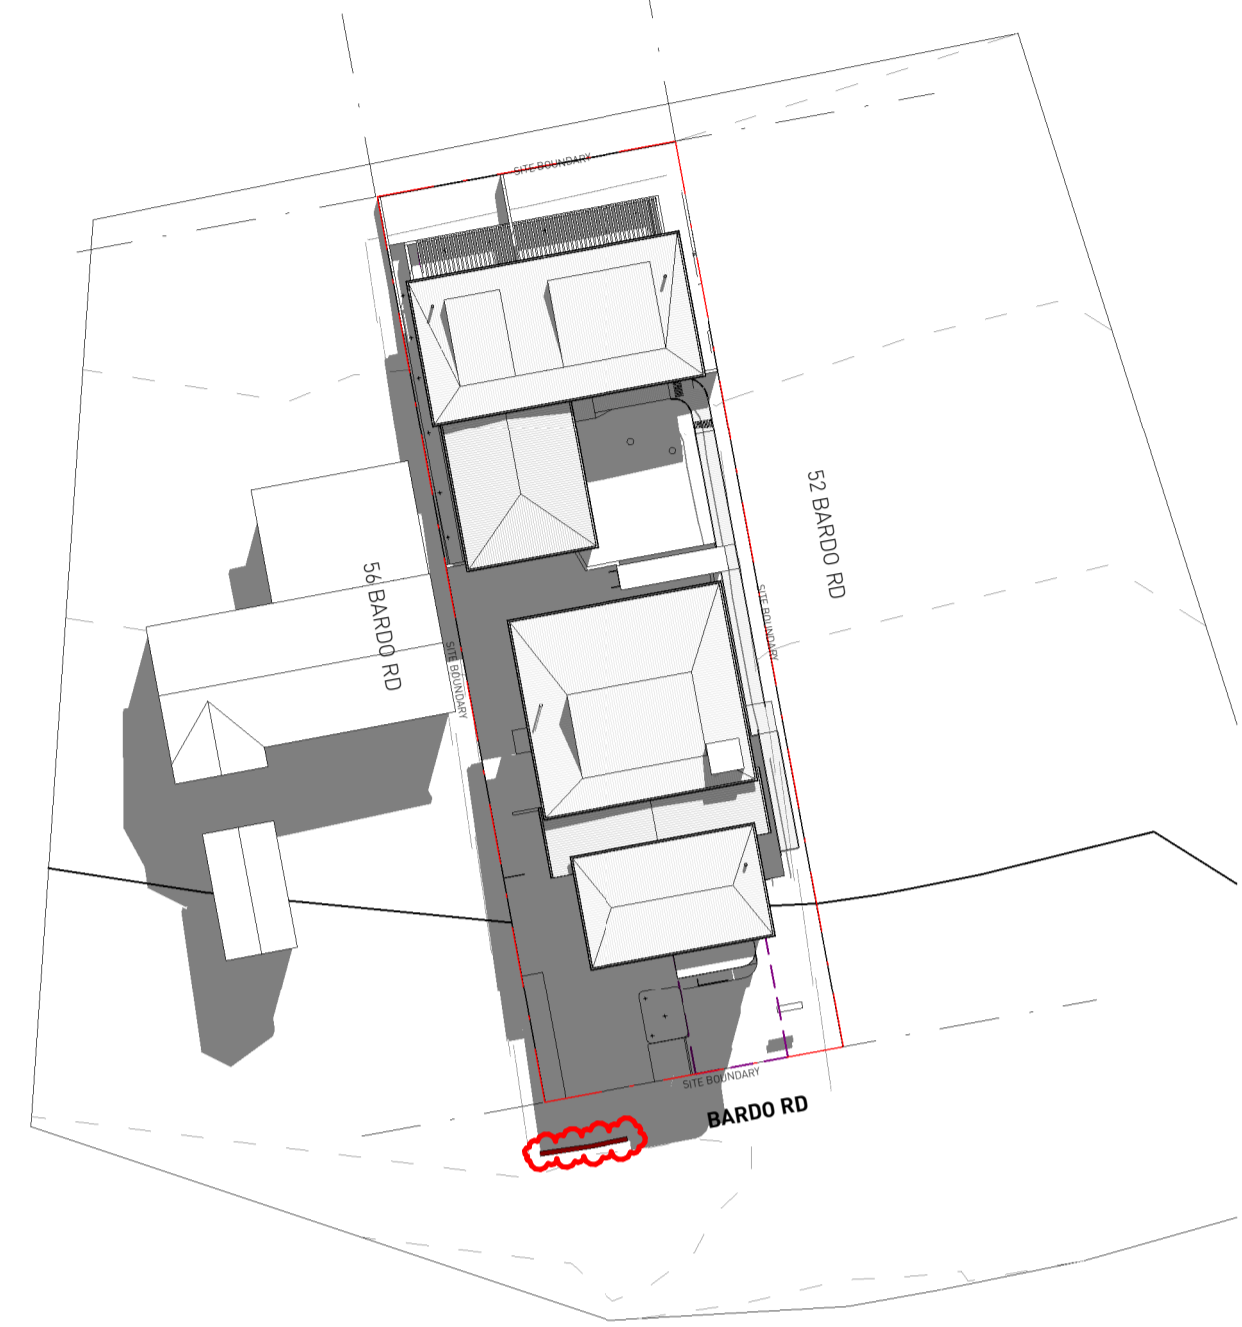


3 SHADOW - JUNE 21 11AM
DA017 1:500




4 SHADOW - JUNE 21 12PM
DA017 1:500

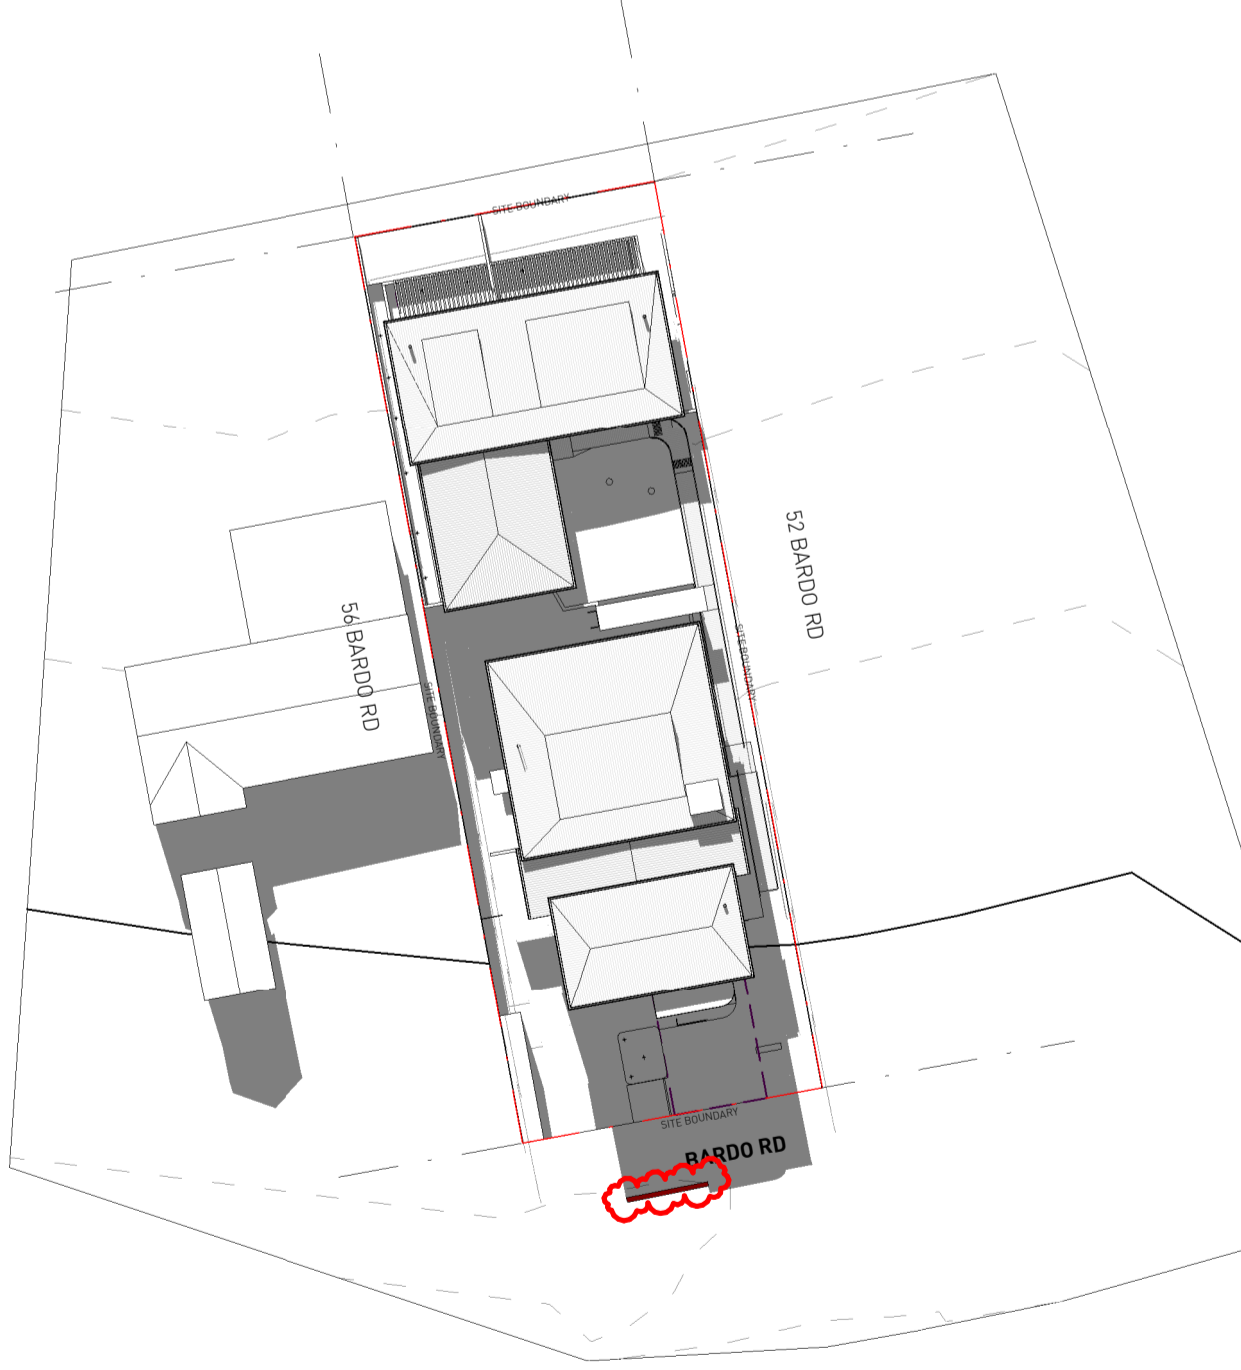

5 SHADOW - JUNE 21 1PM
DA017 1:500

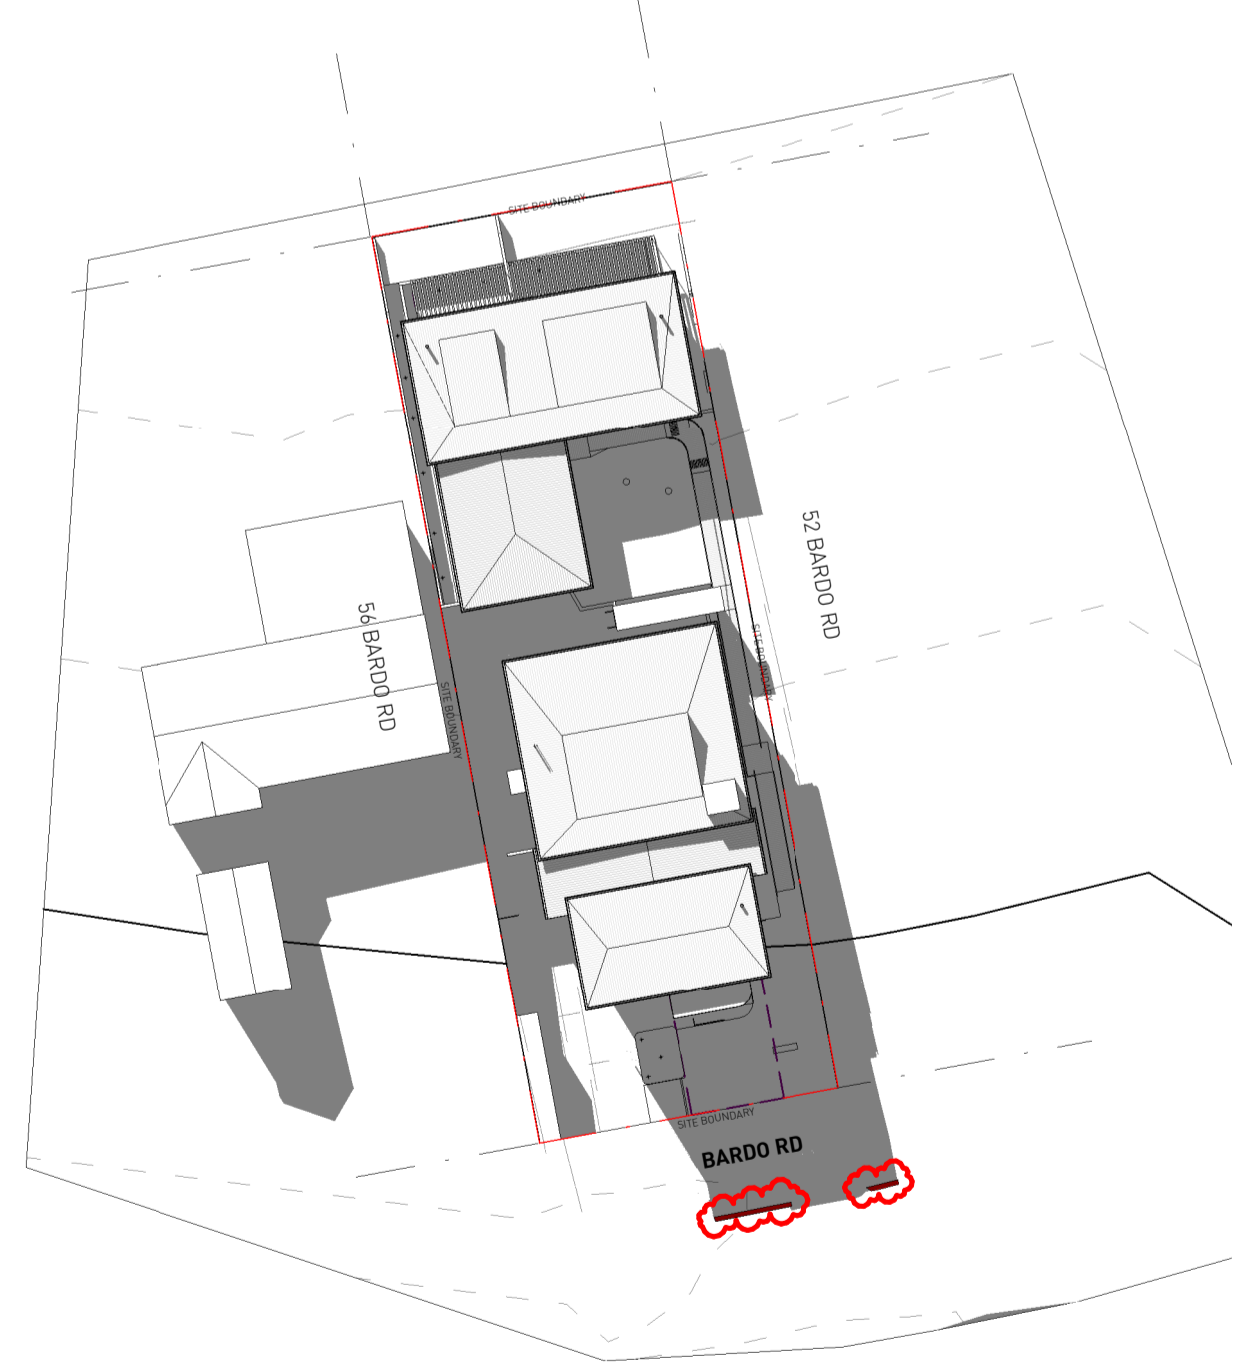

6 SHADOW - JUNE 21 2PM
DA017 1:500

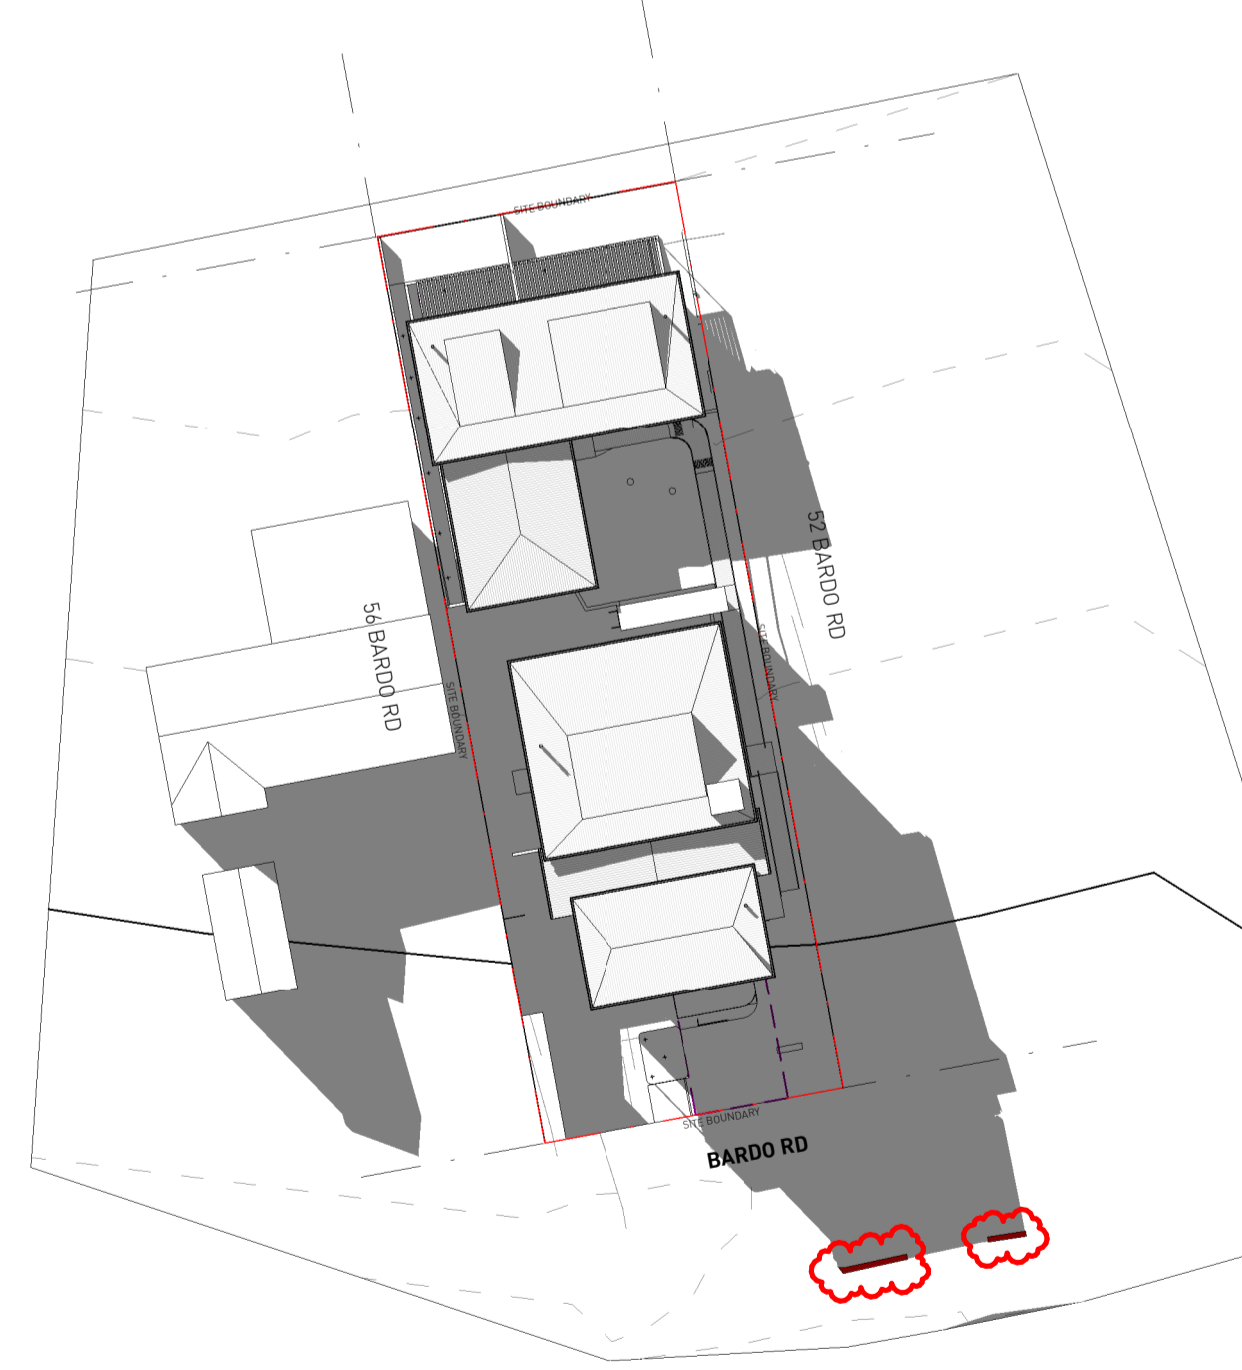

7 SHADOW - JUNE 21 3PM
DA017 1:500

No.	Date	Description
I	11/02/22	ISSUED FOR S4.56(1) APPROVAL
H	08/10/21	ISSUED FOR S4.56(1) APPROVAL
G	16/03/21	ISSUED FOR APPROVAL
F	03/09/20	ISSUED FOR APPROVAL
E	01/09/20	ISSUED FOR COORDINATION
D	20/08/20	ISSUED FOR COORDINATION, REVISED PLANNING ITEMS
C	18/08/20	ISSUED FOR COORDINATION
B	29/07/20	ISSUED FOR PRE-DA MEETING
A	24/07/20	ISSUED FOR INFORMATION

GILES TRIBE
Level 1, 1 Chandos Street
ST LEONARDS NSW 2065
P 61 2 9254 5005
E gtr@gilestribe.com.au
Giles Tribe Pty Ltd ABN 50 801259 507
Nominated Architects: Mark G Broadley (3623) Stuart D Hill (6459)


Verify all dimensions on site prior to commencement of work.
Refer all discrepancies to the Architect for determination.
Use figured dimensions in preference to scaling.
This drawing is copyright and must not be retained, copied, or used without the written consent of Giles Tribe Architects.

Built Property
Project:
**54 BARDO ROAD
NEWPORT 2106
NSW**


SHADOW DIAGRAMS

Status: **FOR S4.56(1) APPROVAL**


Scale: As indicated Job No. Drawing No. Rev.
Sheet Size: A1 **20055 DA0171**
Date: 06/19/20 Drawn: YL Reviewed: VY

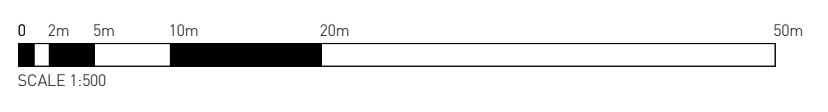

V:\GILES\TRIBE - 3\Drawings\2020\2005501 - Rev004 - Bardo Rd, Newport, NSW\019_54_56(1).rvt

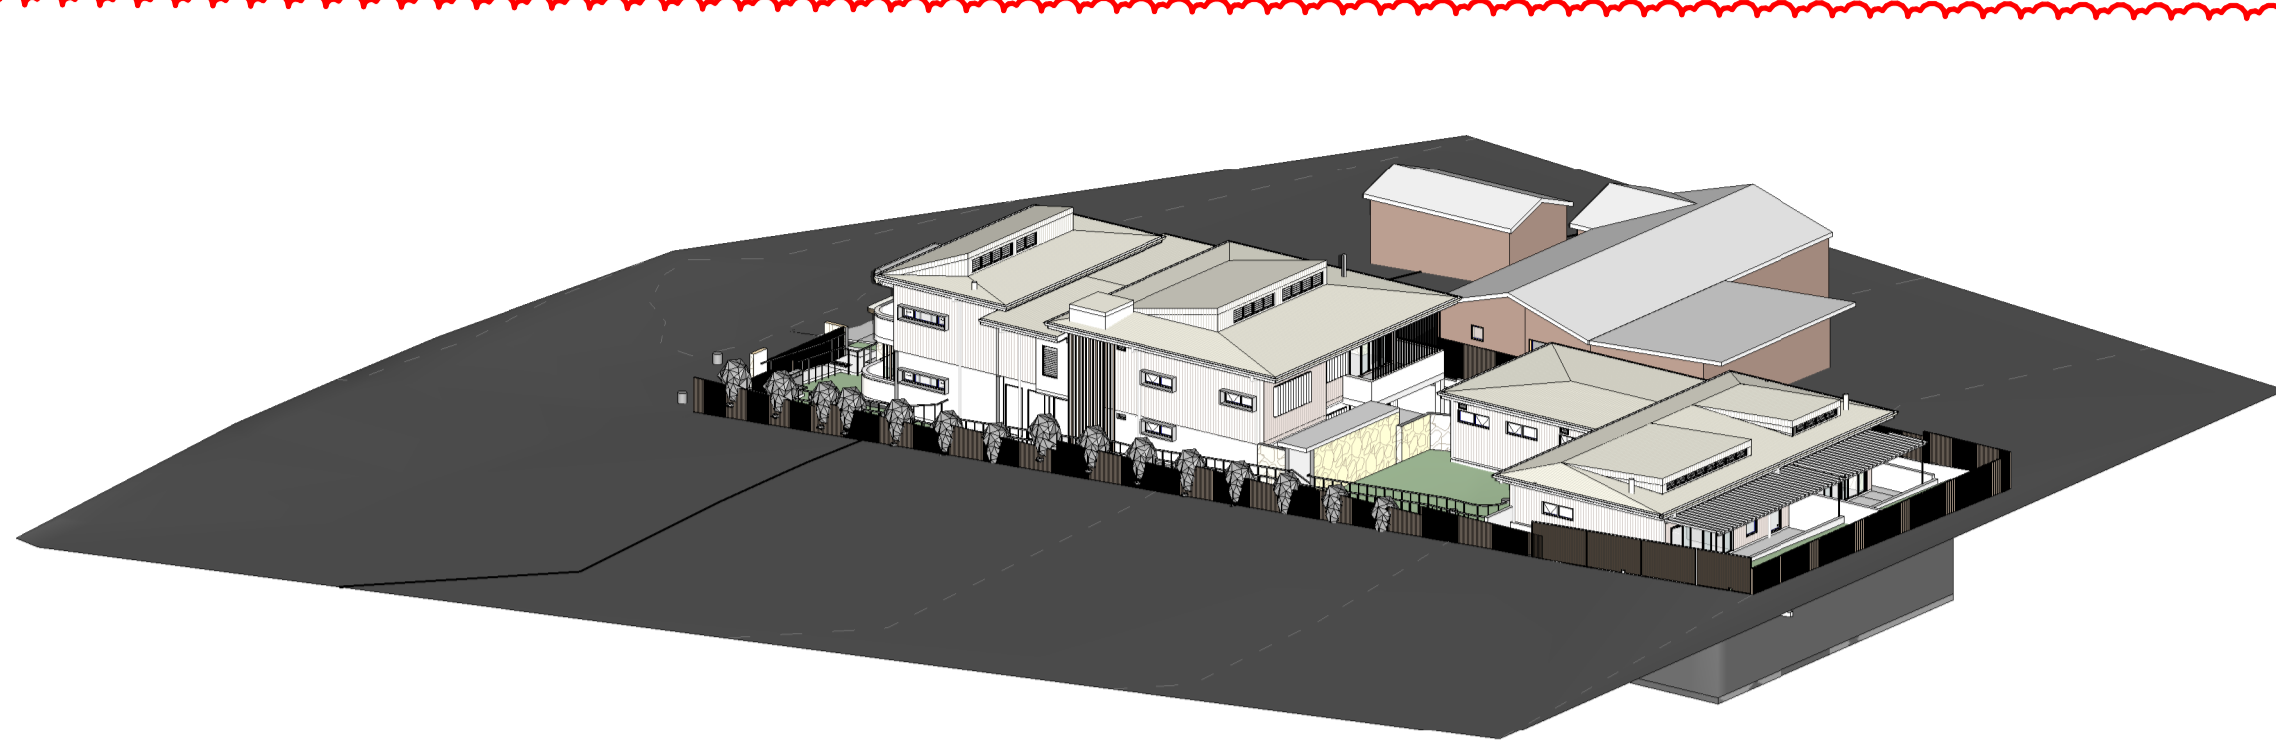


1 SOLAR - JUNE 21 9AM
DA018

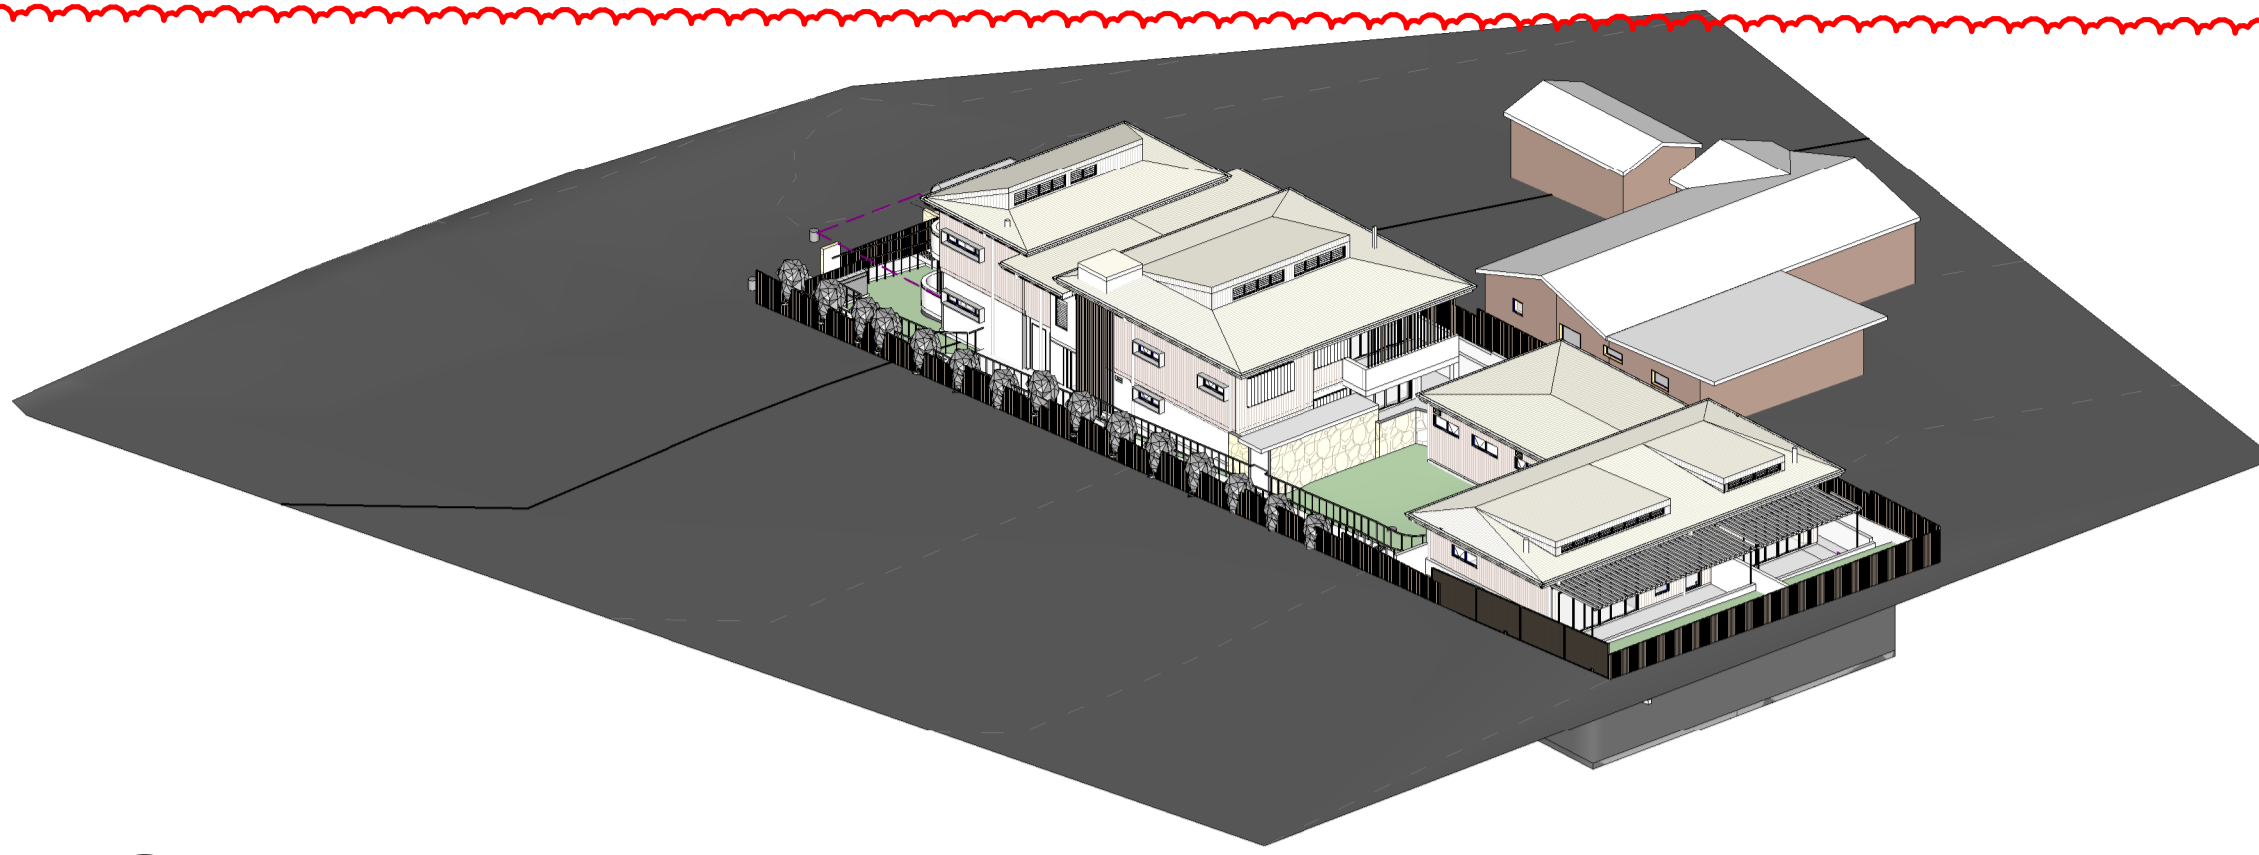


2 SOLAR - JUNE 21 10AM
DA018




3 SOLAR - JUNE 21 11AM
DA018

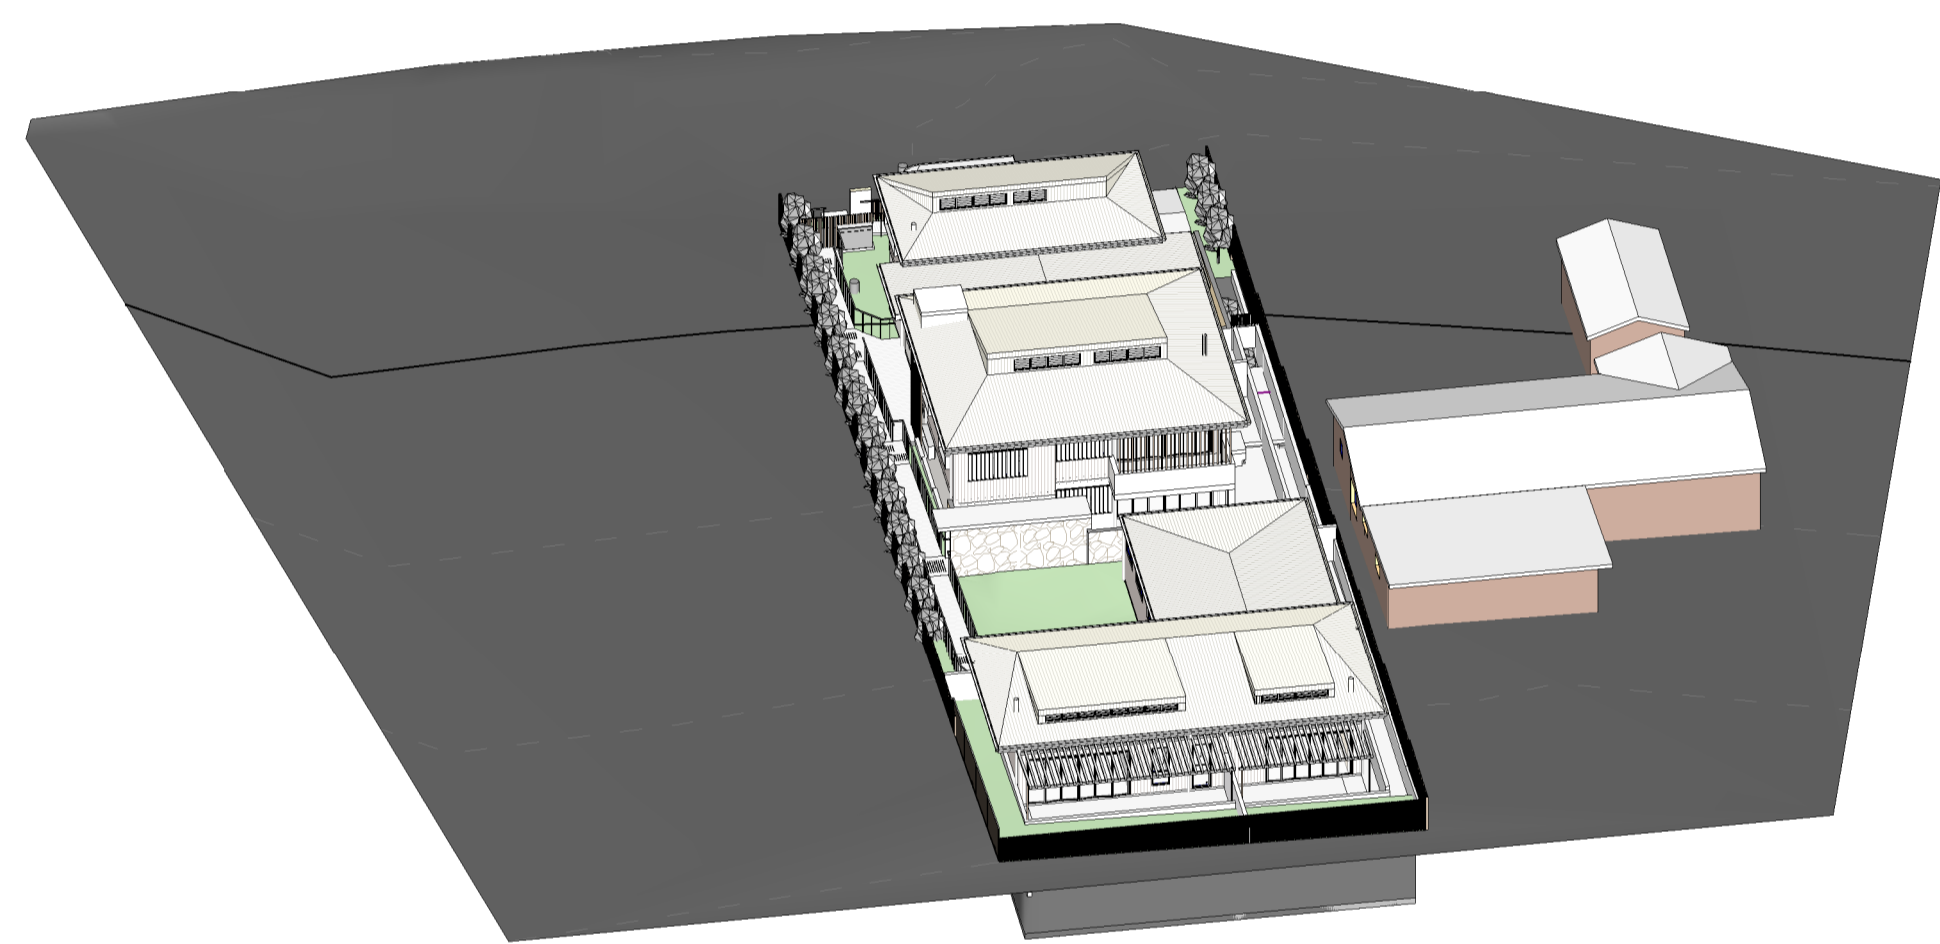


4 SOLAR - JUNE 21 12PM
DA018

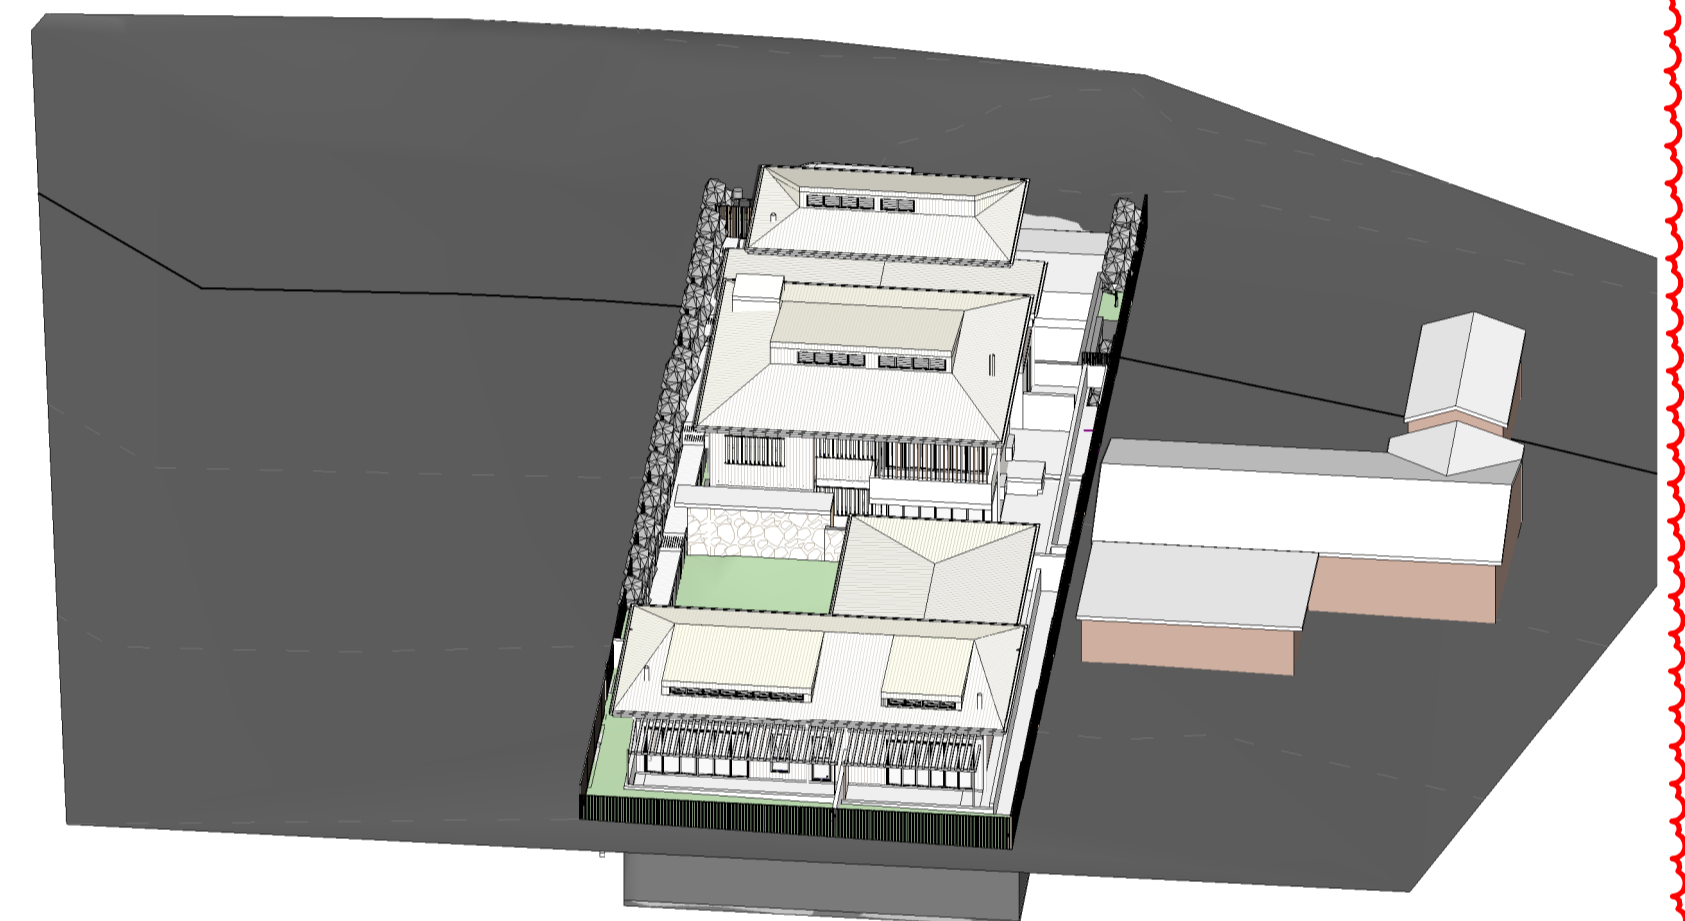

5 SOLAR - JUNE 21 1PM
DA018

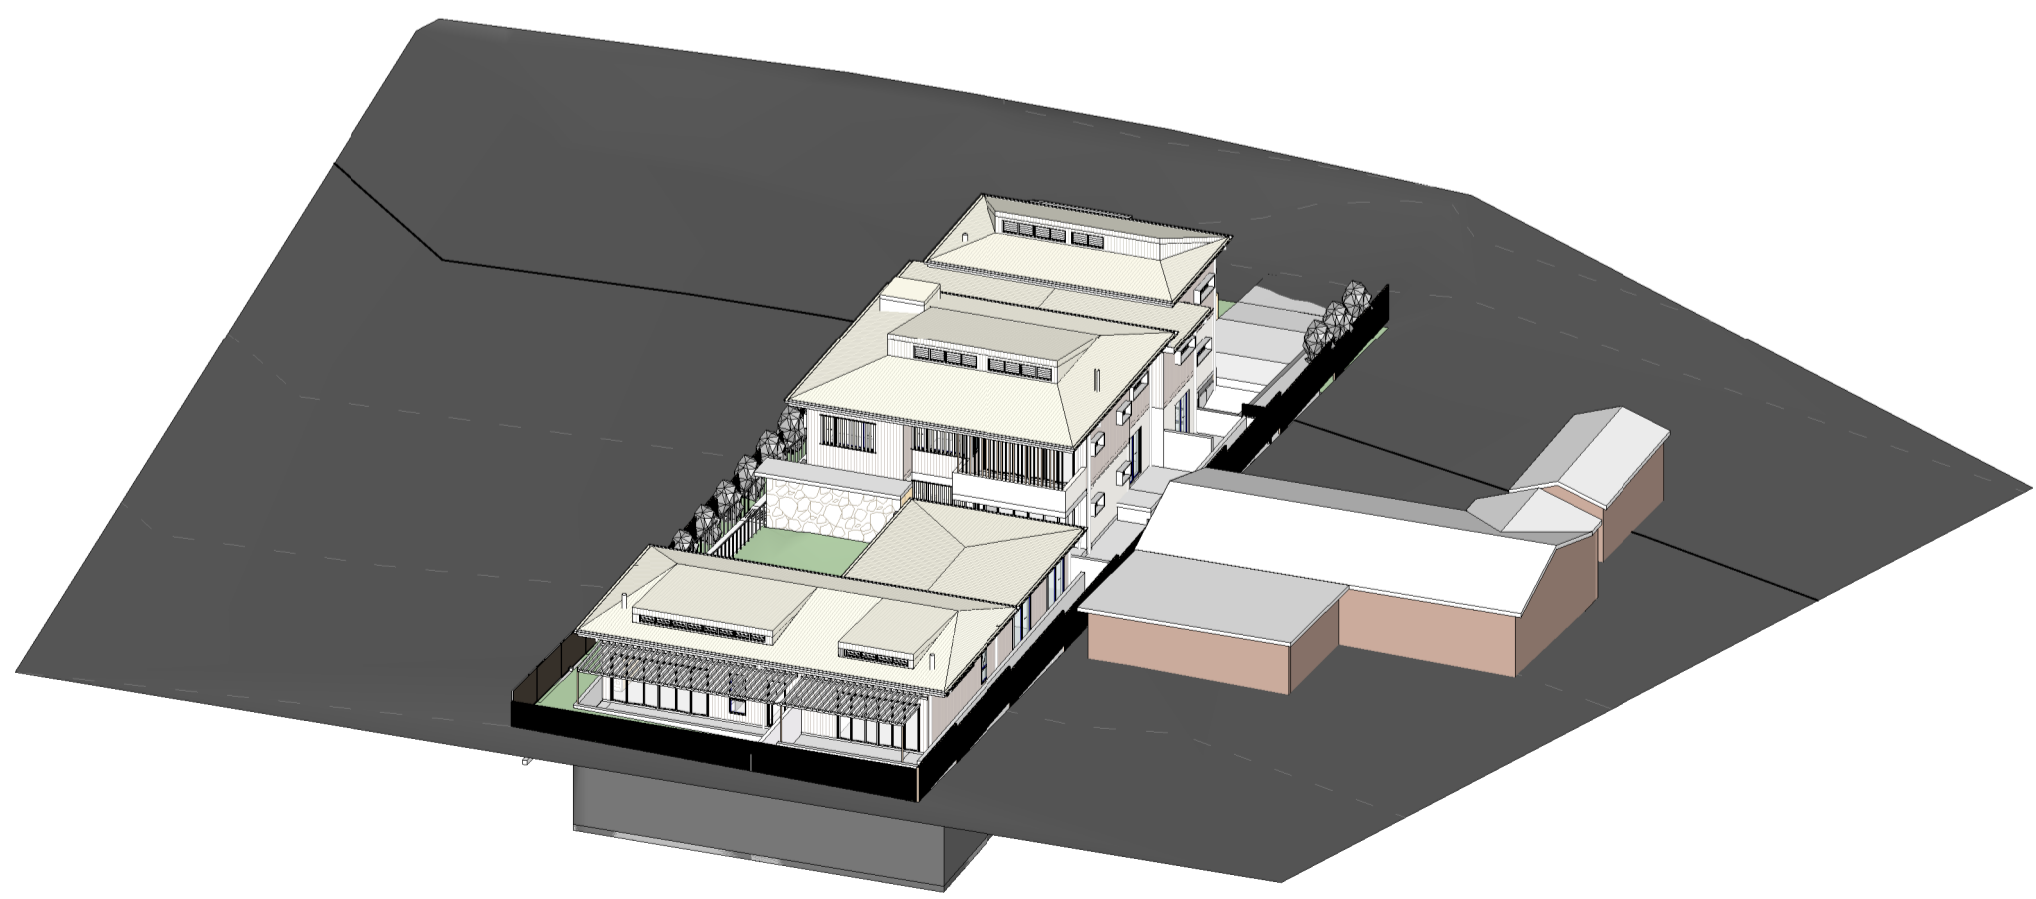

6 SOLAR - JUNE 21 2PM
DA018

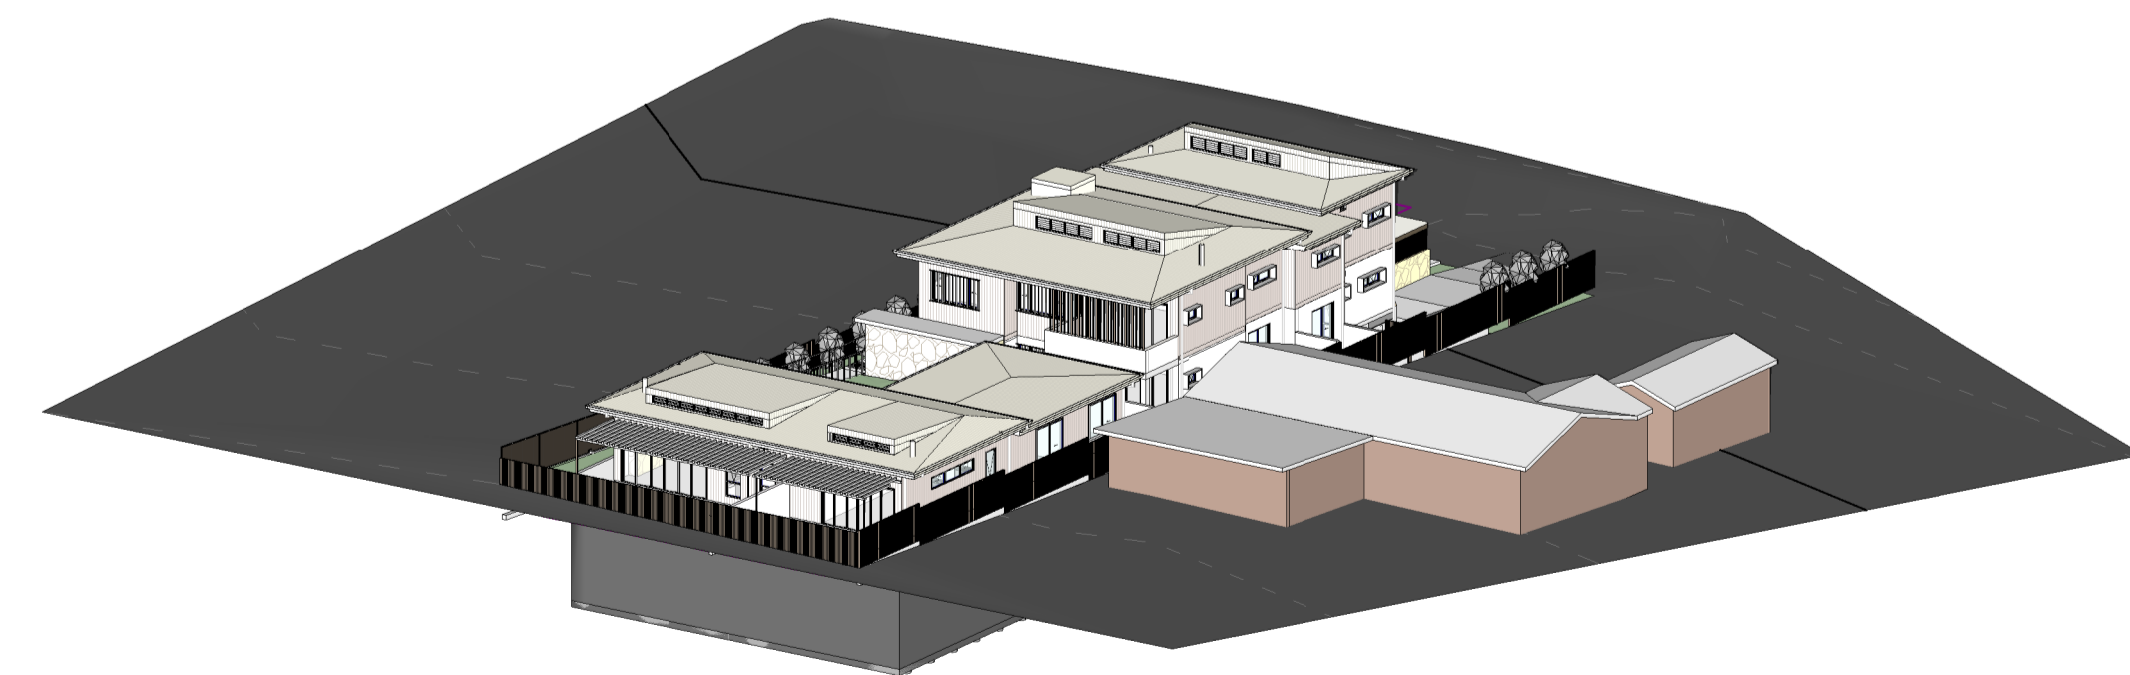

7 SOLAR - JUNE 21 3PM
DA018

SOLAR DIAGRAMS REVISED DUE TO ROOF UPDATED

No.	Date	Description
I	11/02/22	ISSUED FOR S4.56(1) APPROVAL
H	08/10/21	ISSUED FOR S4.56(1) APPROVAL
G	16/03/21	ISSUED FOR APPROVAL
F	03/09/20	ISSUED FOR APPROVAL
E	01/09/20	ISSUED FOR COORDINATION
D	20/08/20	ISSUED FOR COORDINATION, REVISED PLANNING ITEMS
C	18/08/20	ISSUED FOR COORDINATION
B	29/07/20	ISSUED FOR PRE-DA MEETING
A	24/07/20	ISSUED FOR INFORMATION

Amendments

GILES TRIBE Level 1, 1 Chandos Street
ST LEONARDS NSW 2065
P 61 2 9254 5005
E gtr@gilestribe.com.au
Giles Tribe Pty Ltd ABN 50 801259 507
Mark G Broadley (3623) Stuart D Hill (6459)


Client: **Built Property**
Project: **54 BARDO ROAD NEWPORT 2106 NSW**

Drawn: **SOLAR DIAGRAMS**

Status: **FOR S4.56(1) APPROVAL**

Scale: Job No. Drawing No. Rev.
Sheet Size: A1
Date: 06/19/20 **20055 DA0181**
Drawn: YL Reviewed: VY

VOLLESTRIEBE - 3:Drawings\1920\2005501 - Rev004_Bardo Rd, Newport, NSW\0181_06_19_20.rvt

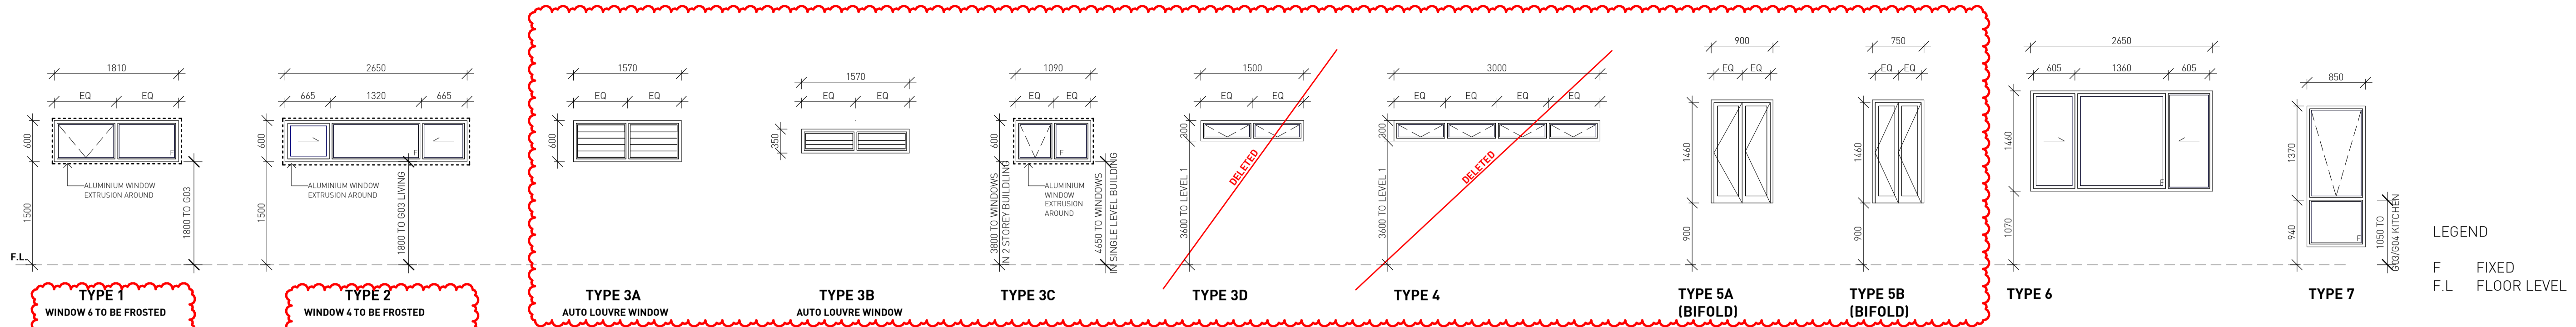


TYPE 1
WINDOW 6 TO BE FROSTED
WINDOW 6, 15, 16, 35, 36, 42, 43, 45 & 46 TO HAVE ALUMINIUM EXTRUSION AROUND WINDOW FRAMES REFER TO ELEVATIONS & DETAILS BELOW

TYPE 2
WINDOW 4 TO BE FROSTED
WINDOW 4 & 33 TO HAVE ALUMINIUM EXTRUSION AROUND WINDOW FRAMES REFER TO ELEVATIONS & DETAILS BELOW

WINDOW 12, 41, 78 & 79 TO HAVE ALUMINIUM EXTRUSION AROUND WINDOW FRAMES REFER TO ELEVATIONS & DETAILS BELOW


LEGEND
F FIXED
F.L FLOOR LEVEL

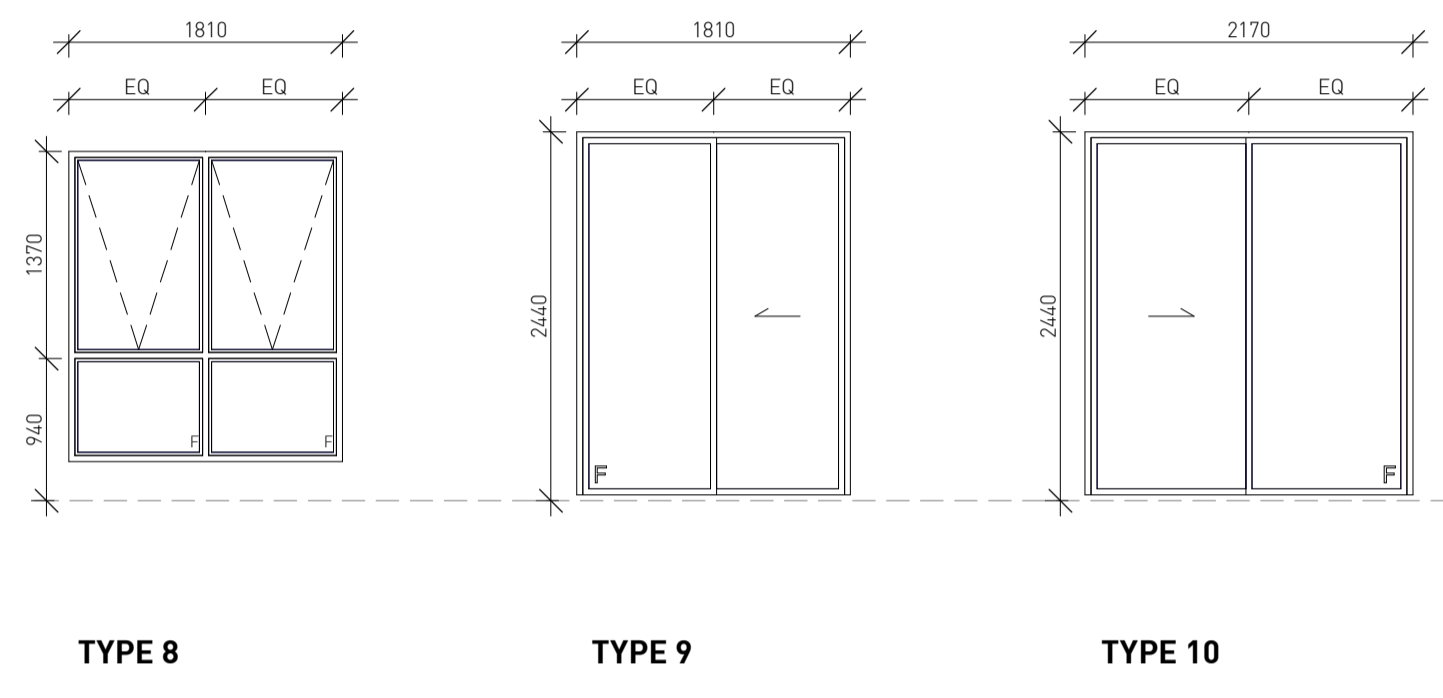

TYPE 8


TYPE 9

TYPE 10

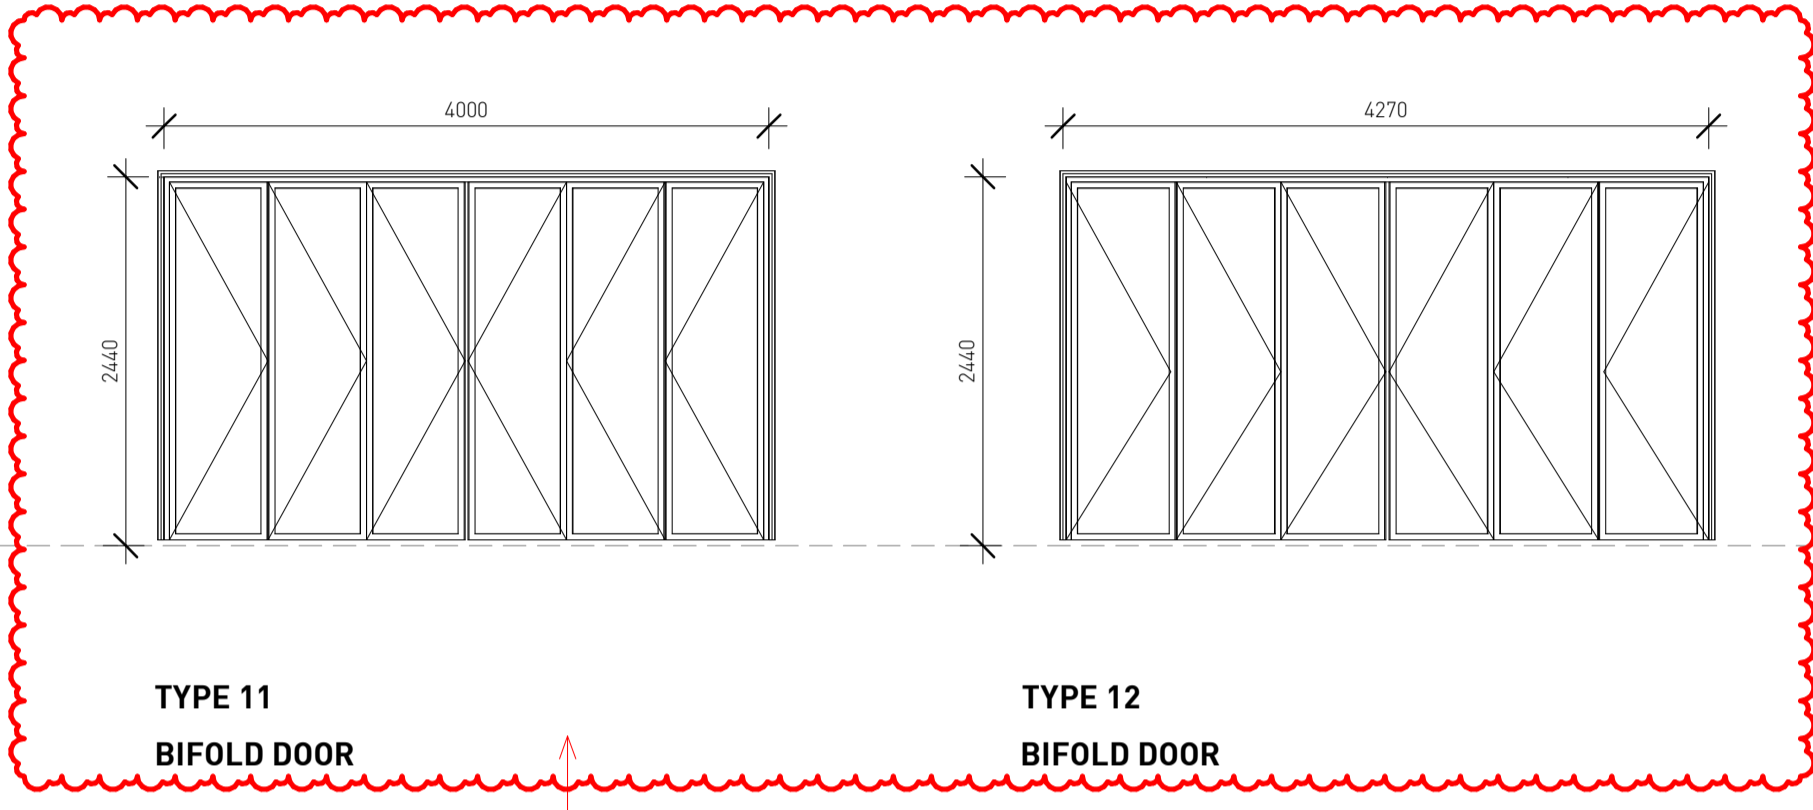

TYPE 11
BIFOLD DOOR

TYPE 12
BIFOLD DOOR

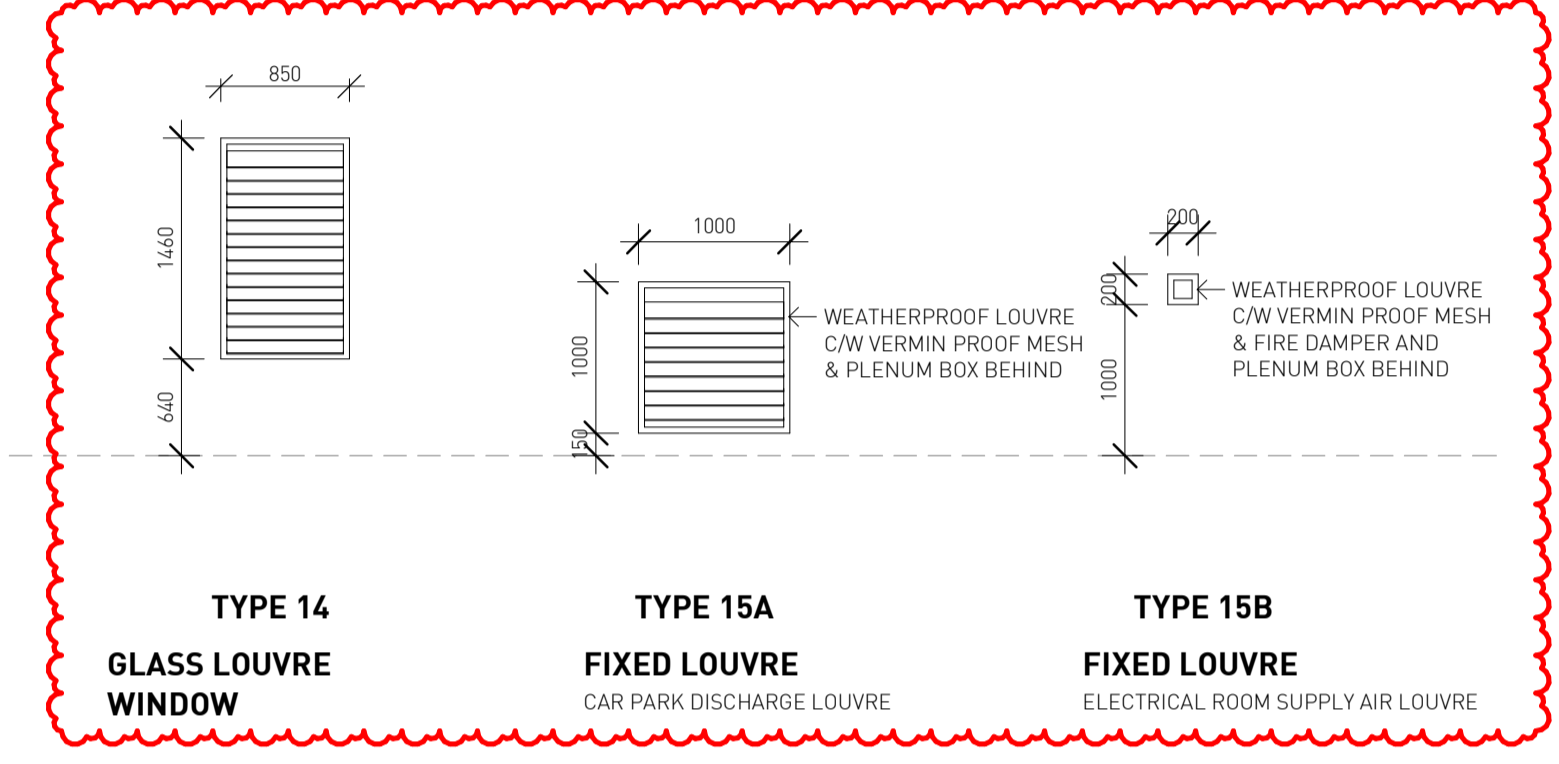


TYPE 13

TYPE 14
GLASS LOUVRE WINDOW


TYPE 15A
FIXED LOUVRE
CAR PARK DISCHARGE LOUVRE

TYPE 15B
FIXED LOUVRE
ELECTRICAL ROOM SUPPLY AIR LOUVRE

WINDOW SCHEDULE REVISED

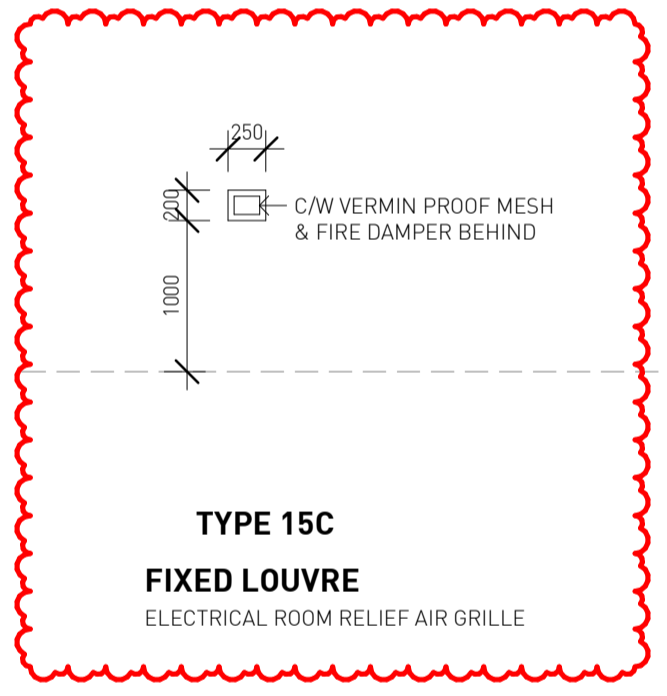

TYPE 15C
FIXED LOUVRE
ELECTRICAL ROOM RELIEF AIR GRILLE

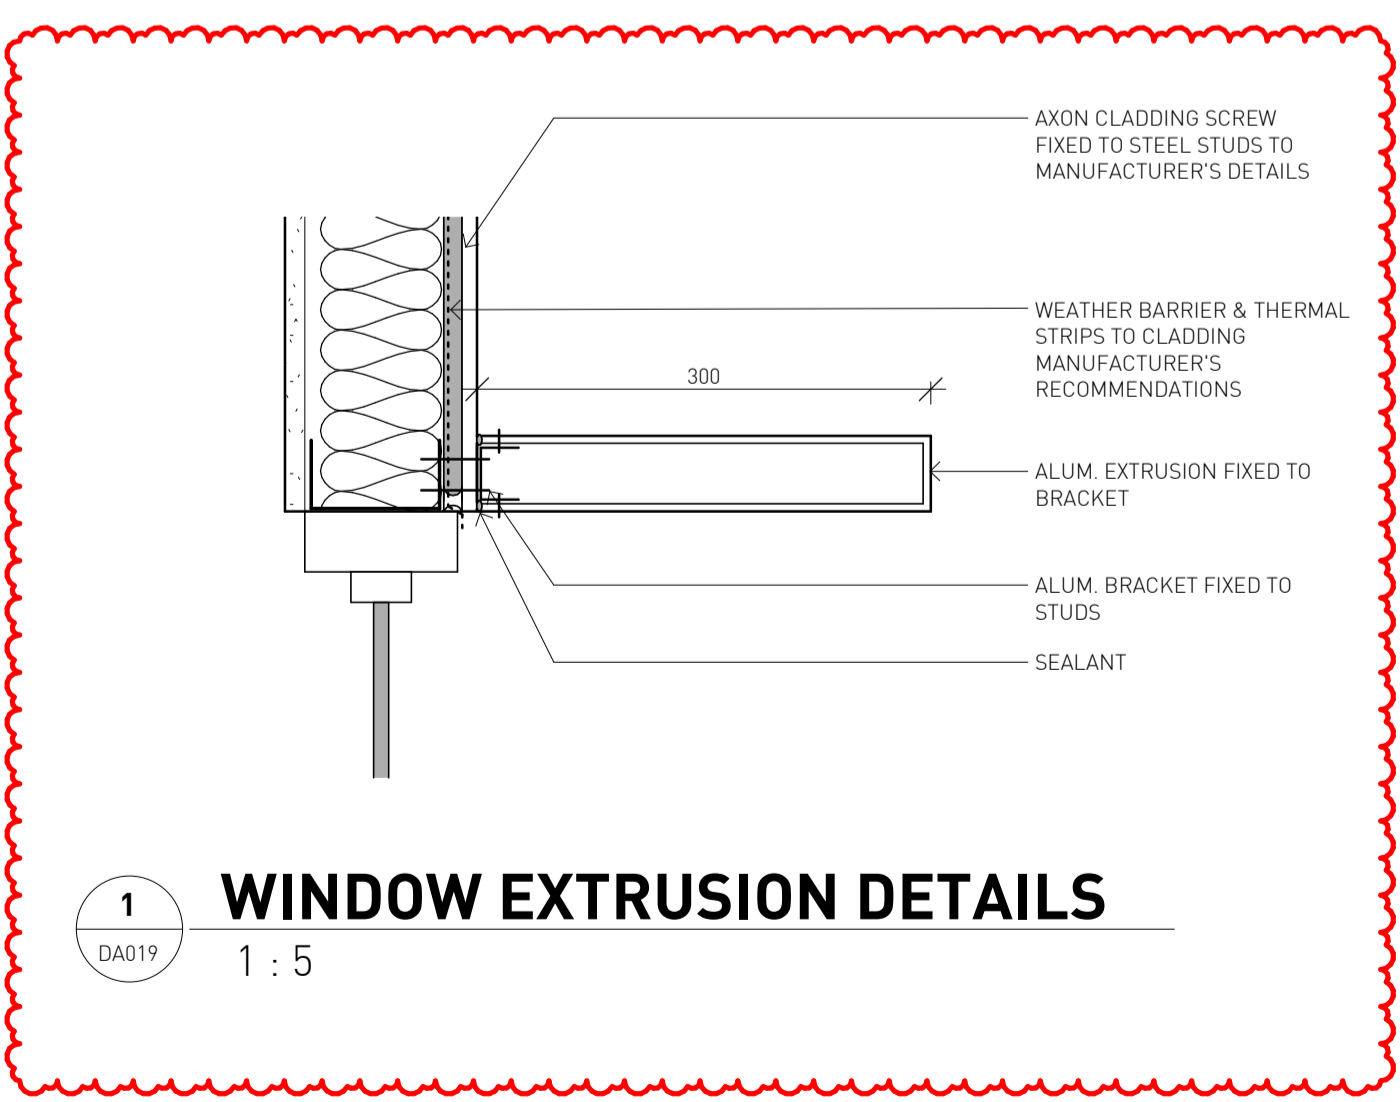

1 WINDOW EXTRUSION DETAILS
DA019 1 : 5

No.	Date	Description
G	11/02/22	ISSUED FOR S4.56(1) APPROVAL
F	08/10/21	ISSUED FOR S4.56(1) APPROVAL
E	16/03/21	ISSUED FOR APPROVAL
D	03/09/20	ISSUED FOR APPROVAL
C	01/09/20	ISSUED FOR COORDINATION
B	24/08/20	ISSUED FOR COORDINATION
A	21/08/20	ISSUED FOR COORDINATION, ACCESS COMMENTS INCORPORATED, BASEMENT AMENDED, WINDOW TAGS ADDED

GILES TRIBE Level 1, 1 Chandos Street
ST LEONARDS NSW 2065
P 61 2 9254 5005
E gtr@gilestribe.com.au
Giles Tribe Pty Ltd ABN 50 001259 507
Mark G Broadley (3823) Stuart D Hill (6459)

Verify all dimensions on site prior to commencement of work. Refer all discrepancies to the Architect for determination. Use figured dimensions in preference to scaling. This drawing is copyright and must not be retained, copied or used without the written consent of Giles Tribe Architects.

Client: Built Property
Project: 54 BARDO ROAD NEWPORT 2106 NSW

WINDOW SCHEDULE

Status: **FOR S4.56(1) APPROVAL**

Scale: As indicated Job No. Drawing No. Rev.
Sheet Size: A1 **20055 DA019 G**
Date: 08/20/20 Drawn: YL Reviewed: VY

V:\GILES\TRIBE\3\Drawings\W\2020\080520_1_Rev054_Bardo Rd Newport NSW 2106_S4_56(1).rvt