

A	30/04/08	TENDER ADDENDUM
PS	19/03/08	GENERAL UPDATE - PRELIMINARY ISSUE
PA	14/03/08	PRELIMINARY ISSUE
P3	13/03/08	PRELIMINARY ISSUE
P2	12/03/08	PRELIMINARY ISSUE
P1	11/03/08	PRELIMINARY ISSUE
No.	DATE	REVISION / ISSUE DETAILS

J	08/12/08	AS-BUILT ISSUE
H	08/10/08	DESIGN STATEMENT ADDED
G	08/10/08	ACCESSIBLE TOILET ADDED
F	01/10/08	TENANCY SIGNAGE HIGHLIGHTED
E	21/08/08	CONSTRUCTION ISSUE
D	31/07/08	CONSTRUCTION ISSUE
C	22/05/08	CONSTRUCTION ISSUE
B	20/05/08	TENDER ADDENDUM
No.	DATE	REVISION / ISSUE DETAILS



PROJECT MANAGER  
**TRICO CONSTRUCTIONS**  
 L2, 118 DEVONSHIRE STREET  
 SURRY HILLS NSW 2010  
 P: 02 9698 6133  
 F: 02 9698 6699  
 www.tricoconstructions.com.au


CLIENT  
**THE GEORGE GROUP**  
 Level 10, 66 King Street  
 SYDNEY NSW 2000  
 GPO Box 3843  
 SYDNEY NSW 2001  
 P: 02 9299 3805

ARCHITECTS  
**RICE DAUBNEY**  
 ANALYSING CREATING AND  
 IMPLEMENTING ARCHITECTURE  
 110 WALKER STREET | NORTH SYDNEY 2060  
 T: 02 9556 2666 | F: 02 9556 3215  
 rd@ricedaubney.com.au | www.ricedaubney.com.au  
 the rice daubney group (pvt) Pty Ltd - abn: 77 001 350 769  
 rice daubney trading trust - abn: 58 880 248 993

PROJECT  
**DEE WHY CENTRE**  
 27 - 33 OAKS AVENUE  
 DEE WHY NSW 2099

DRAWING TITLE  
**LEVEL 1 FLOOR PLAN**

SCALE:	DATE:	CHECKED:
1:200 @A1	13/06/08	
PROJECT NUMBER:	DRAWING NUMBER:	ISSUE:
07025	AR 1301	J
THIS DOCUMENT IS THE COPYRIGHT OF RICE DAUBNEY AND/OR ITS PARTNERS. ALL INFORMATION ILLUSTRATED ON THIS DOCUMENT IS TO BE CHECKED AND VERIFIED ON SITE. IN THE EVENT OF DISCREPANCIES REFER TO ARCHITECT PRIOR TO COMMENCEMENT OF WORK. DO NOT SCALE DRAWINGS MANUALLY OR ELECTRONICALLY.		

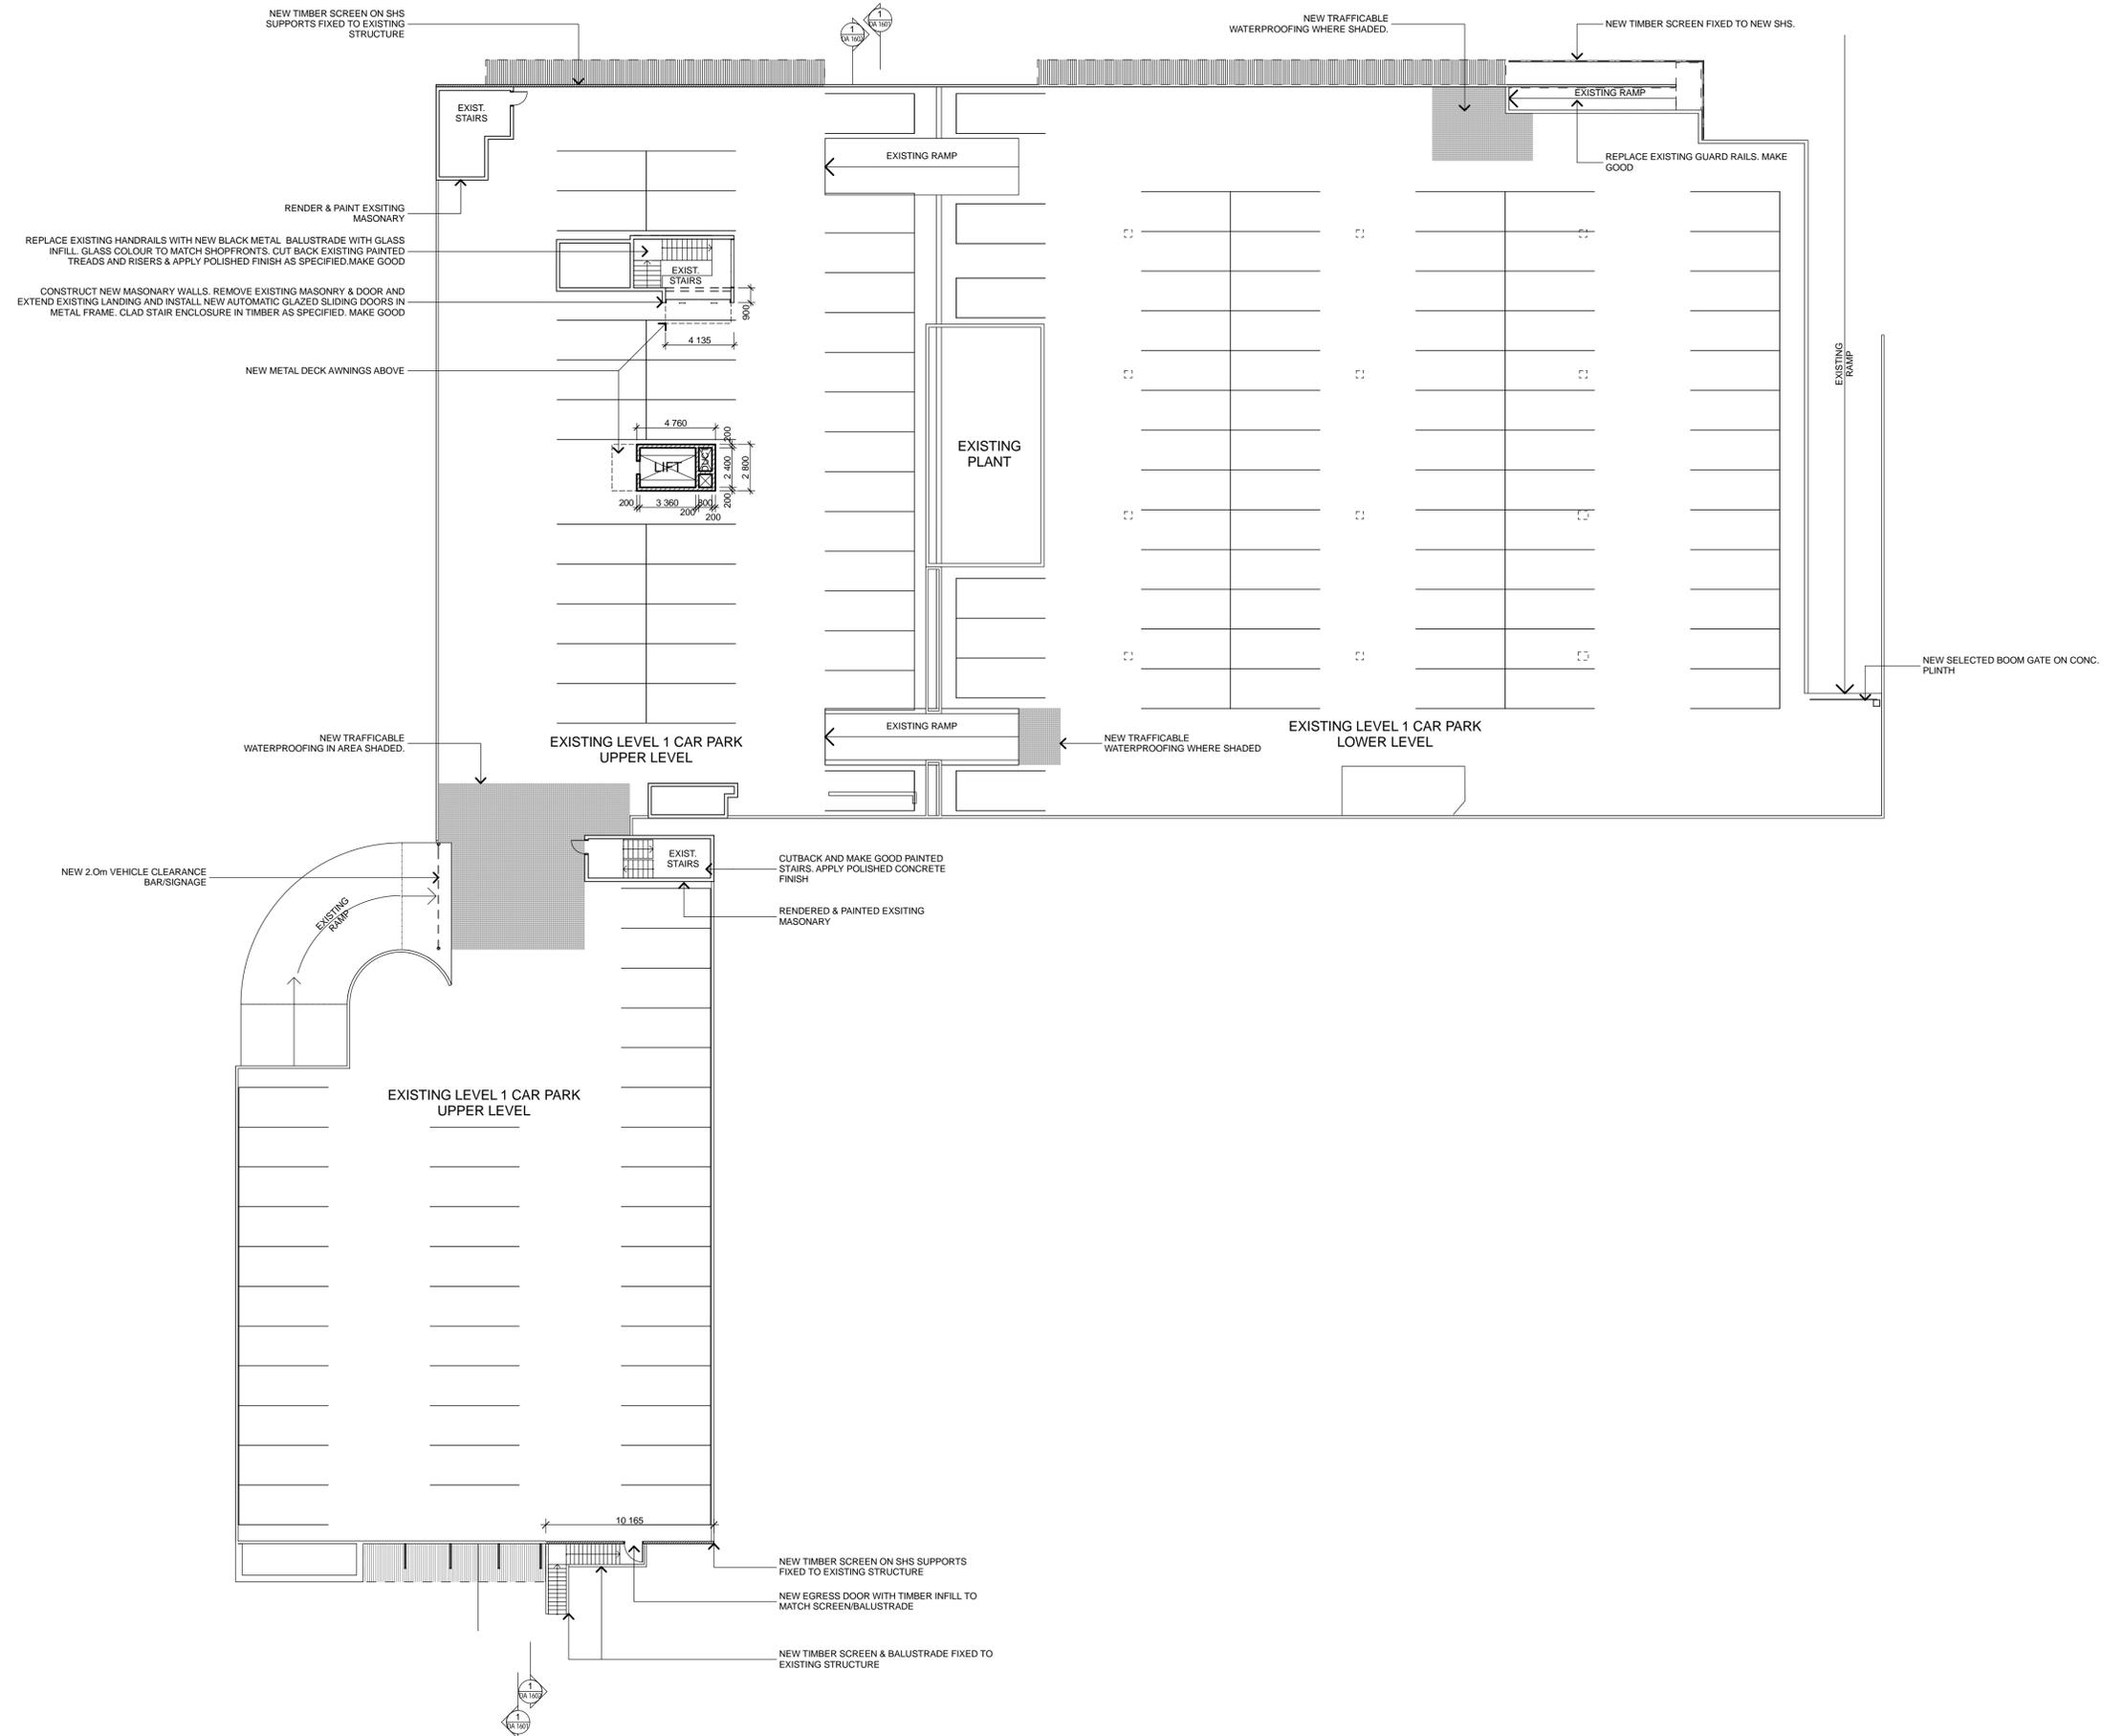

No.	DATE	REVISION / ISSUE DETAILS	No.	DATE	REVISION / ISSUE DETAILS
A	30/04/08	TENDER ADDENDUM			
P5	19/03/08	GENERAL UPDATE - PRELIMINARY ISSUE			
P4	14/03/08	PRELIMINARY ISSUE	E	08/12/08	AS-BUILT ISSUE
P3	13/03/08	PRELIMINARY ISSUE	D	21/08/08	CONSTRUCTION ISSUE
P2	12/03/08	PRELIMINARY ISSUE	C	22/05/08	CONSTRUCTION ISSUE
P1	11/03/08	PRELIMINARY ISSUE	B	20/05/08	TENDER ADDENDUM



PROJECT MANAGER  
**TRICO CONSTRUCTIONS**  
 L2, 118 DEVONSHIRE STREET  
 SURRY HILLS NSW 2010  
 P: 02 9698 6133  
 F: 02 9698 6699  
 www.tricoconstructions.com.au

CLIENT  
**THE GEORGE GROUP**  
 Level 10, 66 King Street  
 SYDNEY NSW 2000  
 GPO Box 3843  
 SYDNEY NSW 2001  
 P: 02 9299 3805


ARCHITECTS  
**RICE DAUBNEY**  
 ANALYSING CREATING AND  
 IMPLEMENTING ARCHITECTURE  
 110 WALKER STREET | NORTH SYDNEY 2060  
 T: 02 9556 2666 | F: 02 9556 3215  
 rd@ricedaubney.com.au | www.ricedaubney.com.au  
 the rice daubney group (pvt) Pty Ltd - abn: 77 001 350 769  
 rice daubney trading trust - abn: 58 880 248 993  
 P: 02 9299 3805

PROJECT  
**DEE WHY CENTRE**  
 27 - 33 OAKS AVENUE  
 DEE WHY NSW 2099

DRAWING TITLE  
**ROOF PLAN**


SCALE: 1:200 @A1  
 DATE: 13/06/08  
 CHECKED:  
 PROJECT NUMBER: 07025  
 DRAWING NUMBER: AR 1401  
 ISSUE: E

THIS DOCUMENT IS THE COPYRIGHT OF RICE DAUBNEY AND/OR ITS ASSOCIATES.  
 ALL INFORMATION ILLUSTRATED ON THIS DOCUMENT IS TO BE CHECKED AND VERIFIED ON SITE  
 AT THE POINT OF DISCREPANCIES REFER TO ARCHITECT PRIOR TO COMMENCEMENT OF THE WORK.  
 DO NOT SCALE DRAWINGS MANUALLY OR ELECTRONICALLY.

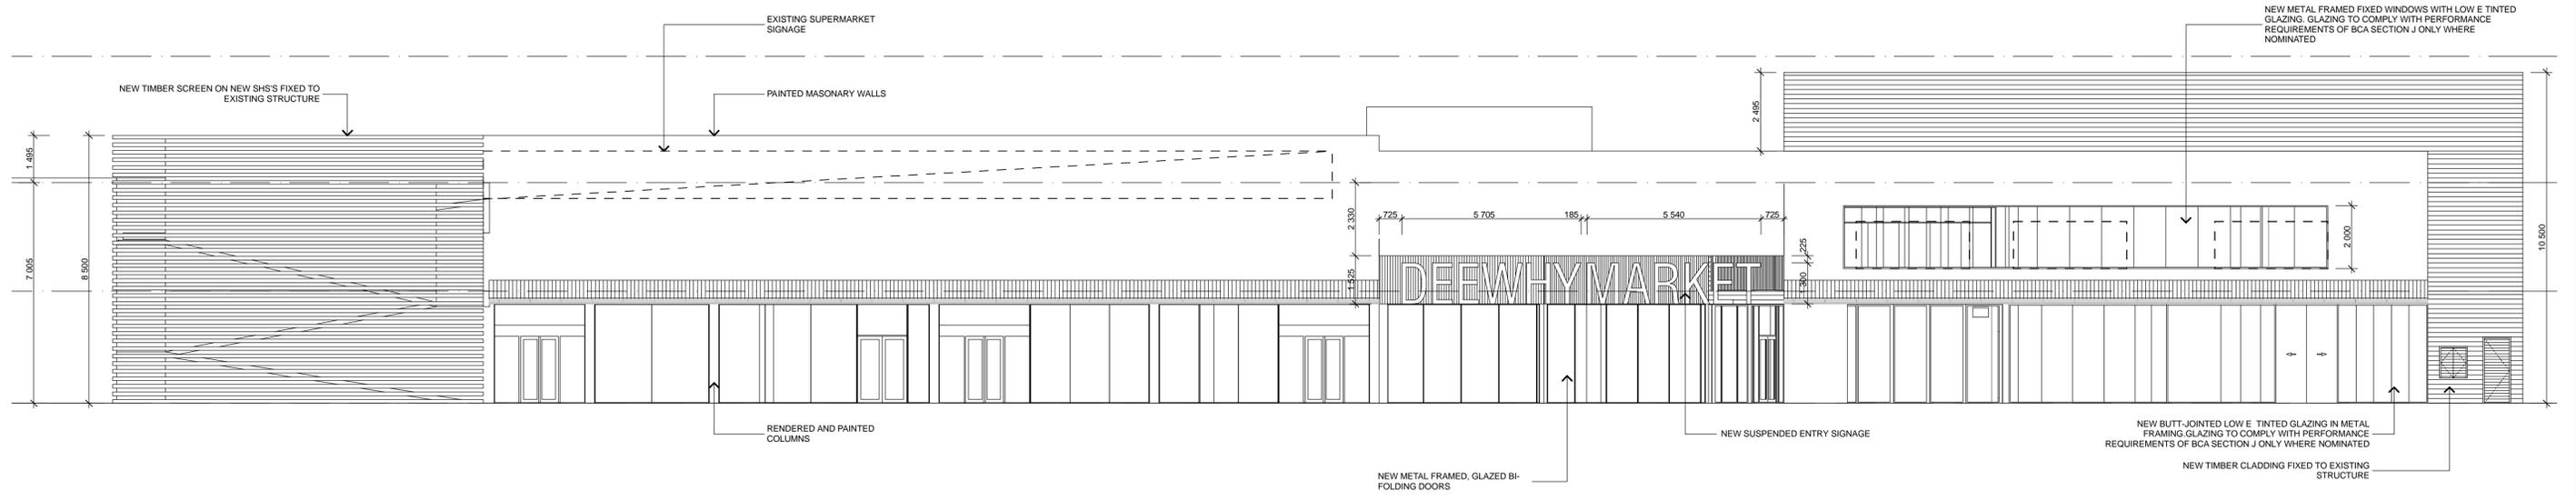


1 ELEVATION  
NORTH ELEVATION

REF: 07025\_MASTER\_AS BUILT  
1:100

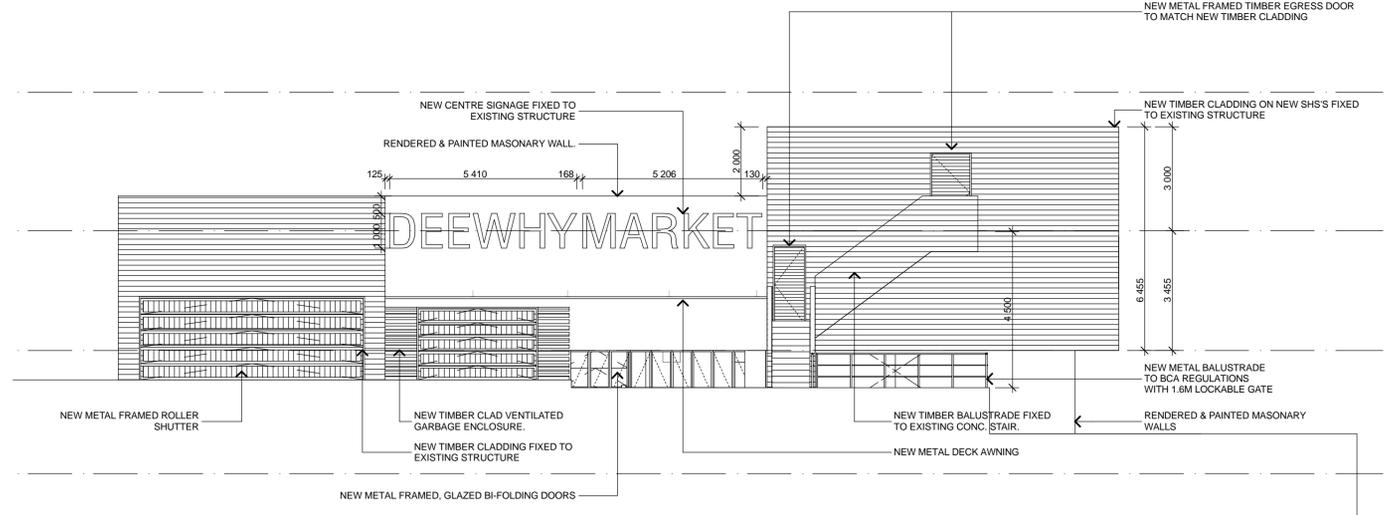

2 ELEVATION  
SOUTH ELEVATION

REF: 07025\_MASTER\_AS BUILT  
1:100

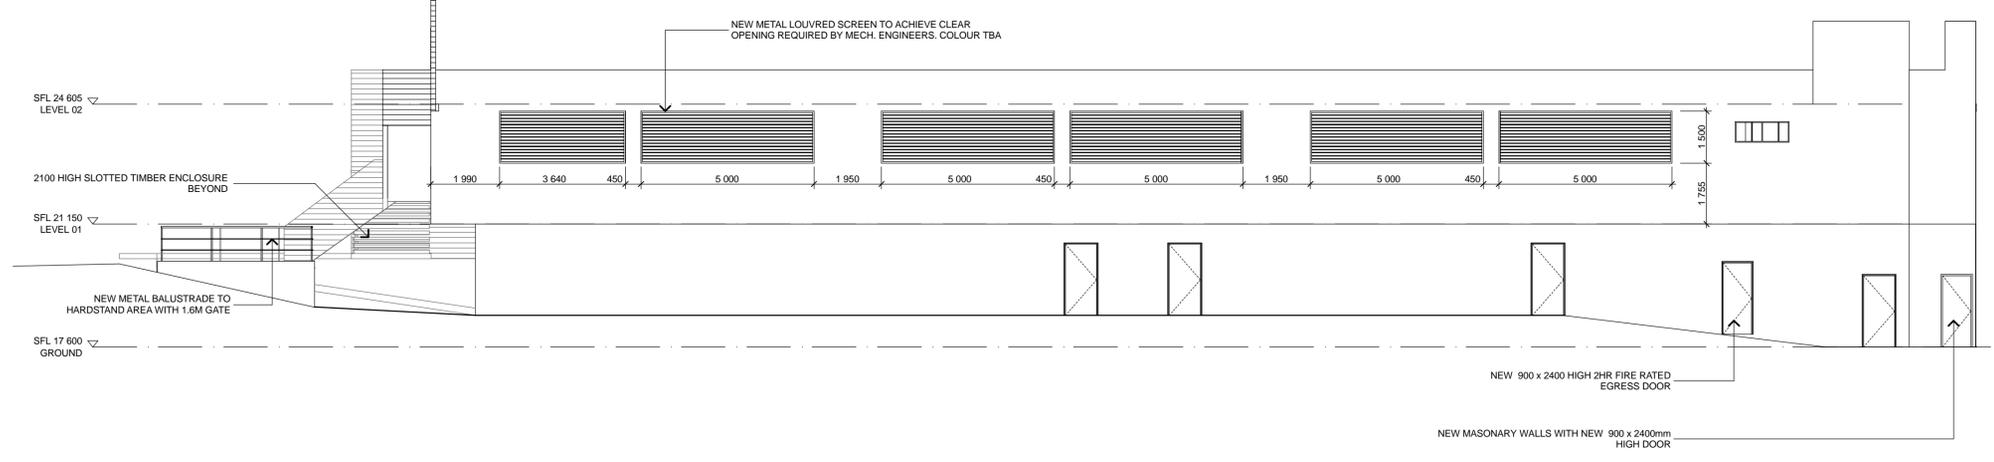

3 ELEVATION  
EAST ELEVATION

REF: 07025\_MASTER\_AS BUILT  
1:100

No	DATE	REVISION / ISSUE DETAILS	No	DATE	REVISION / ISSUE DETAILS
A	30/04/08	TENDER ADDENDUM	F	08/12/08	AS-BUILT ISSUE
P5	19/03/08	GENERAL UPDATE - PRELIMINARY ISSUE	E	21/08/08	CONSTRUCTION ISSUE
P4	14/03/08	PRELIMINARY ISSUE	D	31/07/08	CONSTRUCTION ISSUE
P3	13/03/08	PRELIMINARY ISSUE	C	22/05/08	CONSTRUCTION ISSUE
P2	12/03/08	PRELIMINARY ISSUE	B	20/05/08	TENDER ADDENDUM
P1	11/03/08	PRELIMINARY ISSUE			



PROJECT MANAGER  
**TRICO CONSTRUCTIONS**  
L2, 118 DEVONSHIRE STREET  
SURRY HILLS NSW 2010  
P: 02 9698 6133  
F: 02 9698 6699  
www.tricoconstructions.com.au

CLIENT  
**george**  
THE GEORGE GROUP  
Level 10, 66 King Street  
SYDNEY NSW 2000  
GPO Box 3841  
SYDNEY NSW 2001  
P: 02 9299 3855


ARCHITECTS  
**RICE DAUBNEY**  
ANALYSING CREATING AND  
IMPLEMENTING ARCHITECTURE  
110 WALKER STREET | NORTH SYDNEY 2060  
T: 02 9556 2666 | F: 02 9556 3015  
rd@ricedaubney.com.au | www.ricedaubney.com.au  
the rice daubney group (trading as) - abn: 77 001 350 769  
rice daubney trading trust - abn: 58 880 324 993  
P: 02 9299 3855

PROJECT  
**DEE WHY CENTRE**  
27 - 33 OAKS AVENUE  
DEE WHY NSW 2099

DRAWING TITLE  
**ELEVATIONS**


SCALE:	DATE:	CHECKED:
1:100 @A1	13/06/08	
PROJECT NUMBER:	DRAWING NUMBER:	ISSUE:
07025	AR 1501	F

THIS DOCUMENT IS THE COPYRIGHT OF RICE DAUBNEY AND/OR PH. LEE.  
ALL INFORMATION ILLUSTRATED ON THIS DOCUMENT IS TO BE CHECKED AND VERIFIED ON SITE.  
AT THE POINT OF DISCREPANCIES REFER TO ARCHITECT PRIOR TO COMMENCEMENT OF THE WORK.  
DO NOT SCALE DRAWINGS MANUALLY OR ELECTRONICALLY.

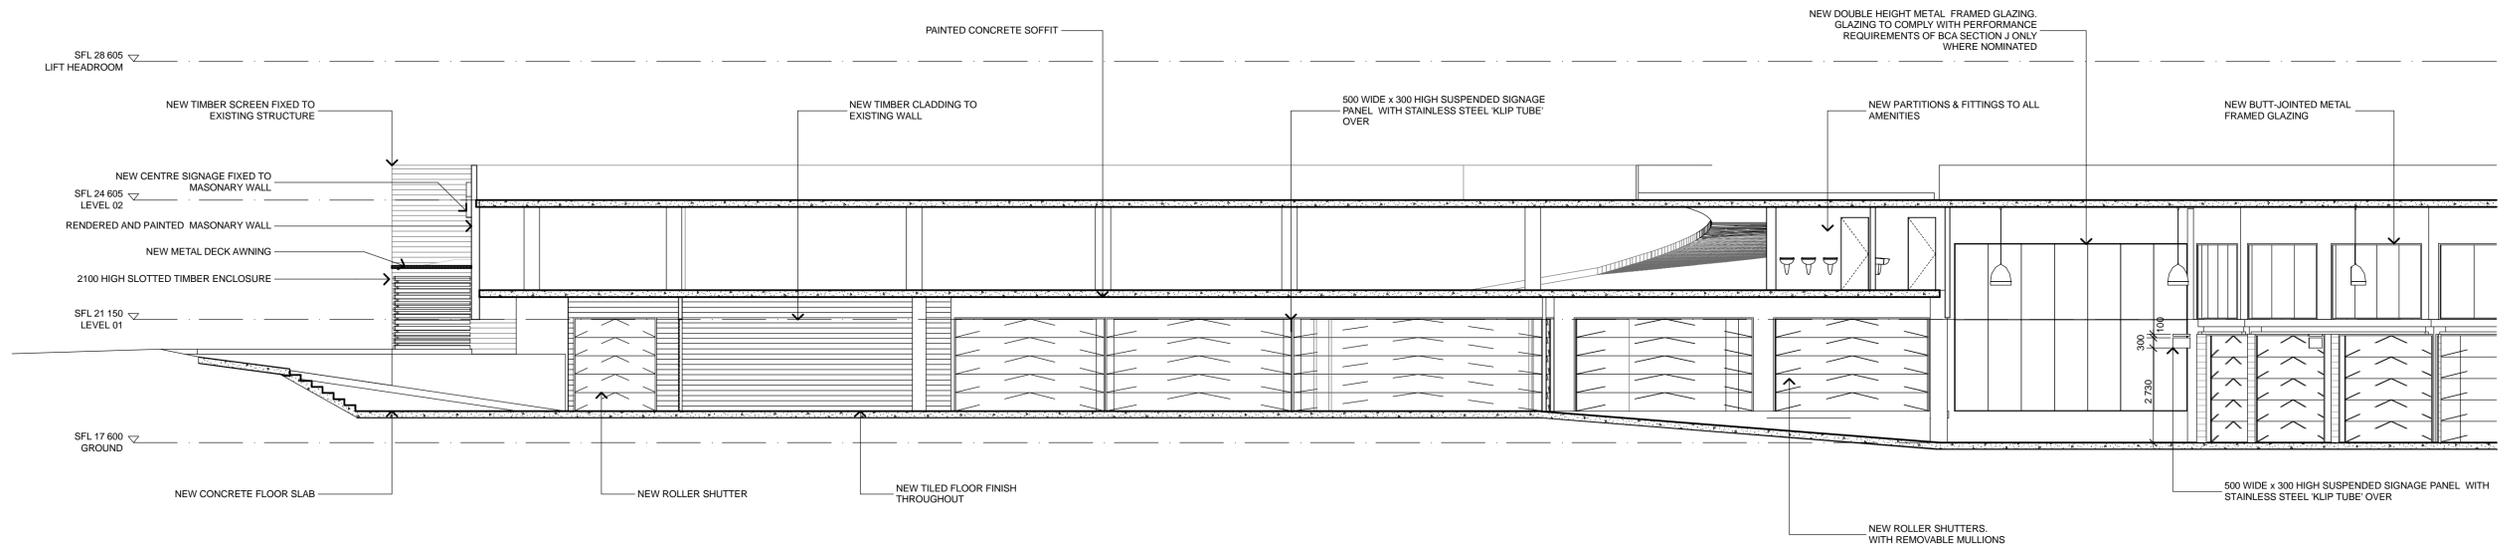

2 SECTION SECTION A

REF: 07025\_MASTER\_AS\_BUILT  
1:100

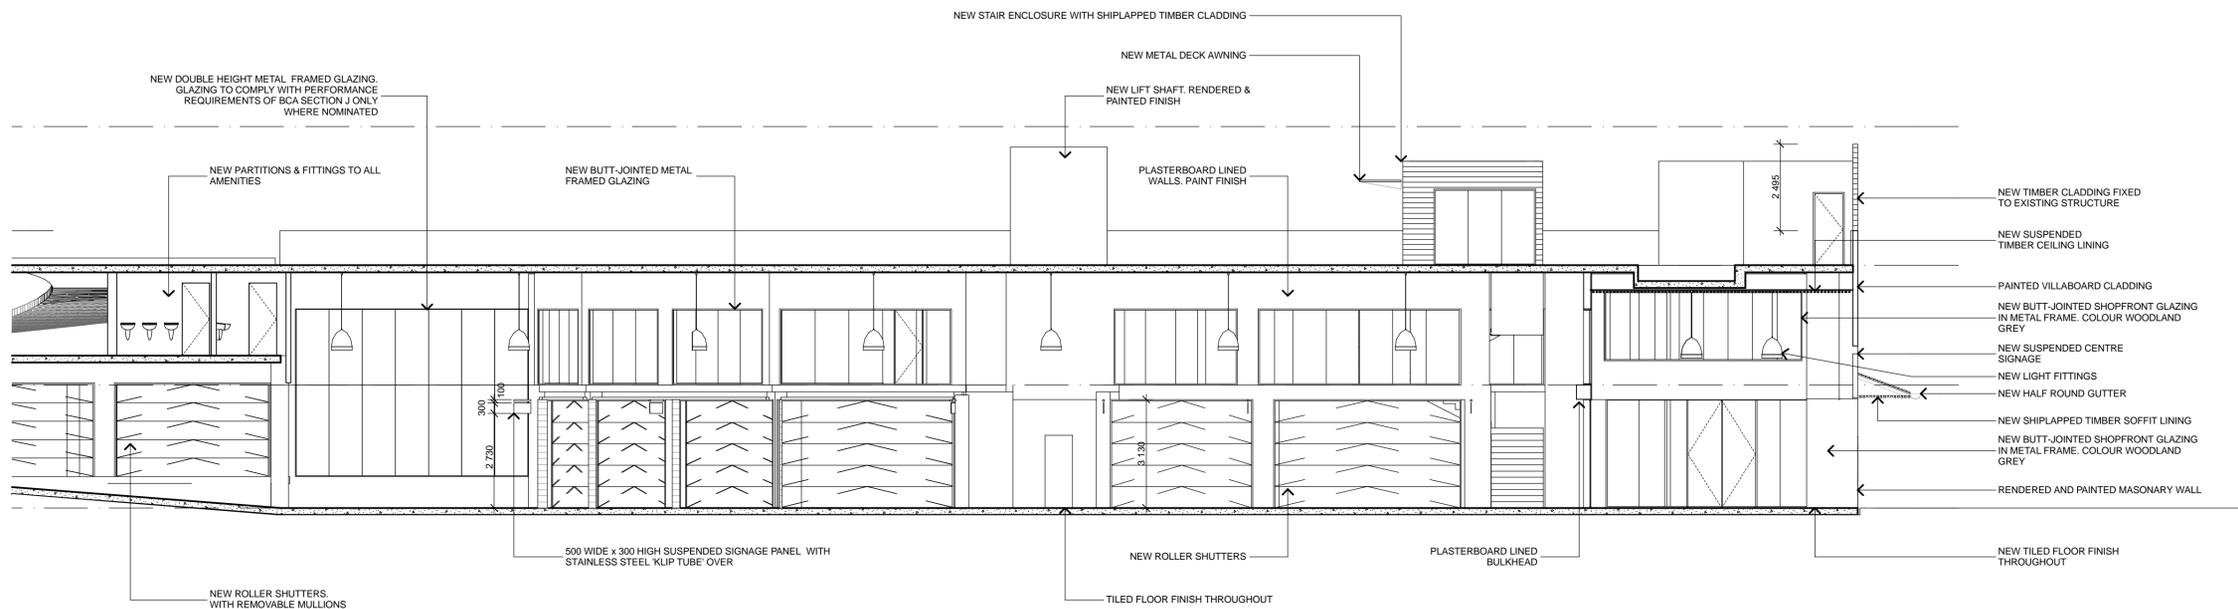

1 SECTION SECTION A

REF: 07025\_MASTER\_AS\_BUILT  
1:100

B	22/05/08	CONSTRUCTION ISSUE			
A	30/04/08	TENDER ADDENDUM			
P4	14/03/08	PRELIMINARY ISSUE	E	08/12/08	AS-BUILT ISSUE
P3	13/03/08	PRELIMINARY ISSUE	D	21/08/08	CONSTRUCTION ISSUE
P2	12/03/08	PRELIMINARY ISSUE	C	31/07/08	MINOR CHANGES
P1	11/03/08	PRELIMINARY ISSUE	B	20/05/08	TENDER ADDENDUM
No	DATE	REVISION / ISSUE DETAILS	No	DATE	REVISION / ISSUE DETAILS



PROJECT MANAGER  
**TRICO CONSTRUCTIONS**  
L2, 118 DEVONSHIRE STREET  
SURRY HILLS NSW 2010  
P: 02 9698 6133  
F: 02 9698 6699  
www.tricoconstructions.com.au


CLIENT  
**george**  
THE GEORGE GROUP  
Level 10, 66 King Street  
SYDNEY NSW 2000  
GPO Box 3843  
SYDNEY NSW 2001  
P: 02 9299 3805

ARCHITECTS  
**RICE DAUBNEY**  
ANALYSING CREATING AND  
IMPLEMENTING ARCHITECTURE  
110 WALKER STREET | NORTH SYDNEY 2060  
T: 02 9556 2666 | F: 02 9556 3215  
rd@ricedaubney.com.au | www.ricedaubney.com.au  
the rice daubney group (trading) Pty Ltd - abn: 77 001 350 769  
rice daubney trading trust - abn: 58 802 324 993

PROJECT  
**DEE WHY CENTRE**  
27 - 33 OAKS AVENUE  
DEE WHY NSW 2099


DRAWING TITLE  
**SECTION A**

SCALE:	DATE:	CHECKED:
1:100 #A1	13/06/08	
PROJECT NUMBER:	DRAWING NUMBER:	ISSUE:
07025	AR 1601	E
THIS DOCUMENT IS THE COPYRIGHT OF RICE DAUBNEY AND/OR ITS PARTNERS. ALL INFORMATION ILLUSTRATED ON THIS DOCUMENT IS TO BE CHECKED AND VERIFIED ON SITE. ALL THE VIEWS OF DISCREPANCIES REFER TO ARCHITECT PRIOR TO COMMENCEMENT OF THE WORK. DO NOT SCALE DRAWINGS MANUALLY OR ELECTRONICALLY.		

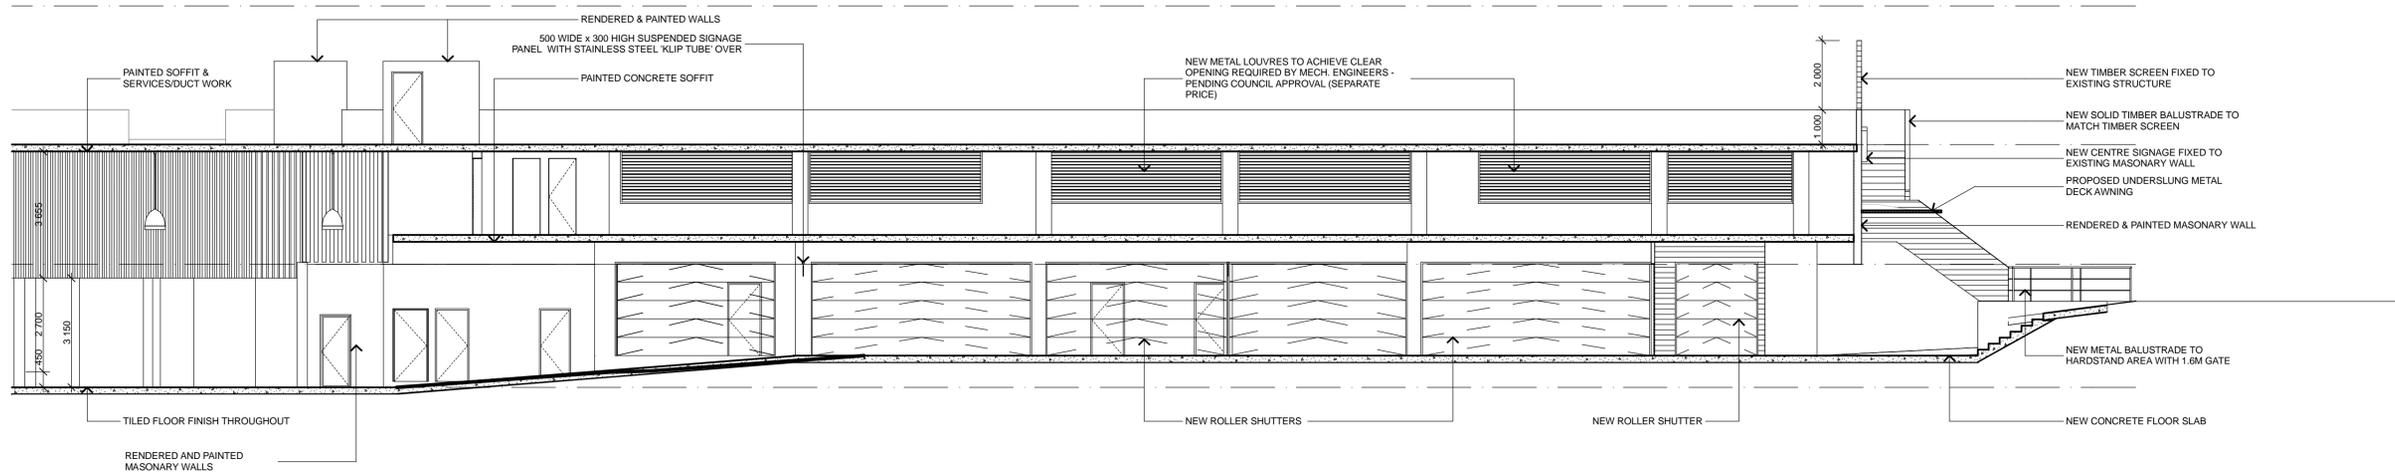

2 SECTION SECTION B

REF: 07025\_MASTER\_AS\_BUILT  
1:100

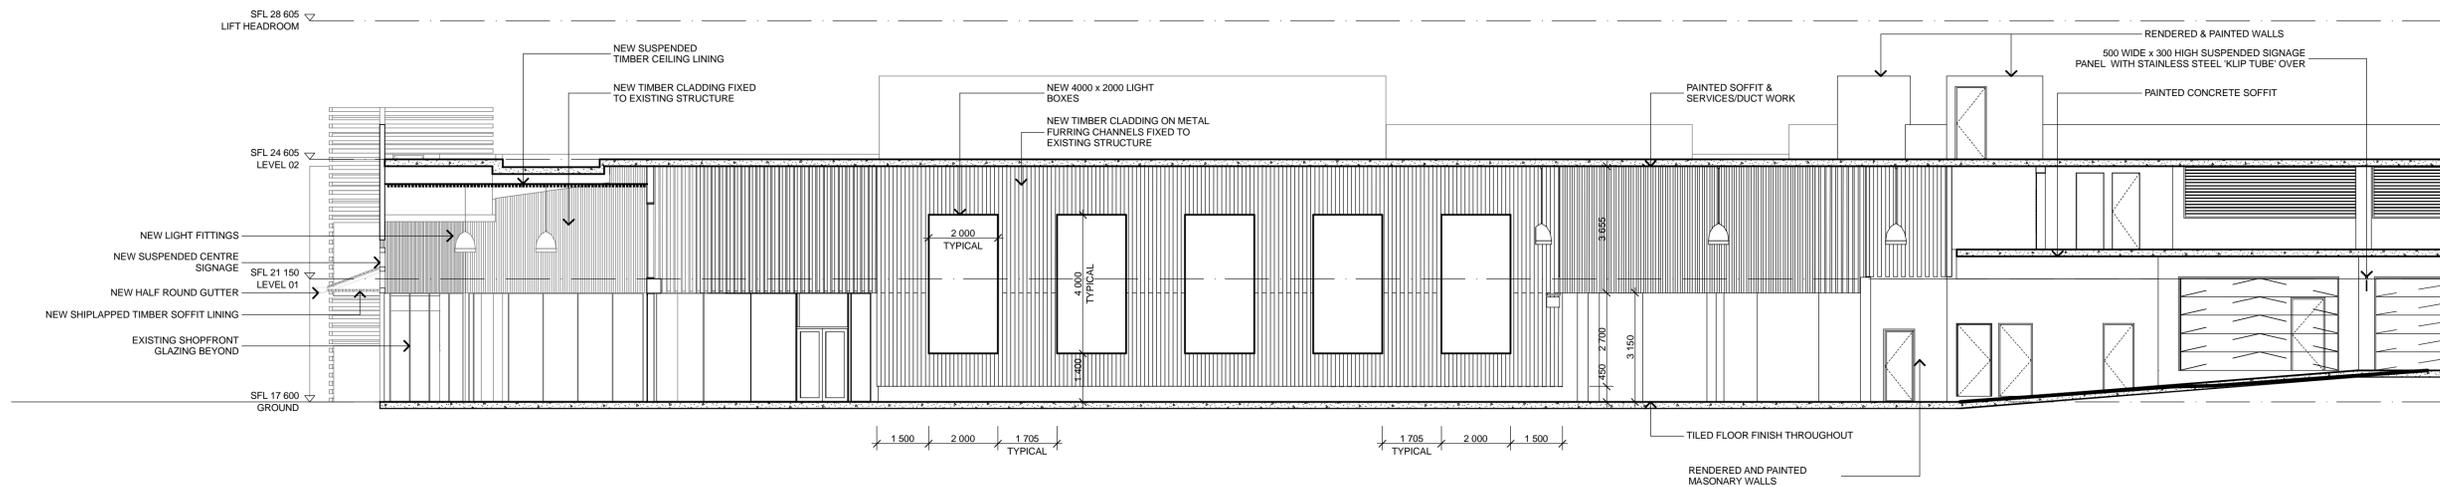

1 SECTION SECTION B

REF: 07025\_MASTER\_AS\_BUILT  
1:100

C	31/07/08	CONSTRUCTION ISSUE			
B	22/05/08	CONSTRUCTION ISSUE			
A	30/04/08	TENDER ADDENDUM			
P4	19/03/08	GENERAL UPDATE - PRELIMINARY ISSUE			
P3	14/03/08	PRELIMINARY ISSUE			
P2	13/03/08	PRELIMINARY ISSUE			
P1	12/03/08	PRELIMINARY ISSUE			
No.	DATE	REVISION / ISSUE DETAILS	No.	DATE	REVISION / ISSUE DETAILS



PROJECT MANAGER  
**TRICO CONSTRUCTIONS**  
L2, 118 DEVONSHIRE STREET  
SURRY HILLS NSW 2010  
P: 02 9698 6133  
F: 02 9698 6699  
www.tricoconstructions.com.au

CLIENT  
**george**  
THE GEORGE GROUP  
Level 10, 66 King Street  
SYDNEY NSW 2000  
GPO Box 3843  
SYDNEY NSW 2001  
P: 02 9299 3805

ARCHITECTS  
**RICE DAUBNEY**  
ANALYSING CREATING AND  
IMPLEMENTING ARCHITECTURE  
110 WALKER STREET | NORTH SYDNEY 2060  
T: 02 9556 2666 | F: 02 9556 3215  
rd@ricedaubney.com.au | www.ricedaubney.com.au  
the rice daubney group (trading as) rice daubney 77 001 350 769  
rice daubney trading (trading) as) rice daubney 58 800 248 993



PROJECT  
**DEE WHY CENTRE**  
27 - 33 OAKS AVENUE  
DEE WHY NSW 2099

DRAWING TITLE  
**SECTION B**

SCALE:	DATE:	CHECKED:
1:100 @A1	11/03/08	
PROJECT NUMBER:	DRAWING NUMBER:	ISSUE:
07025	AR 1602	D
THIS DOCUMENT IS THE COPYRIGHT OF RICE DAUBNEY ARCHITECTS. ALL INFORMATION ILLUSTRATED ON THIS DOCUMENT IS TO BE CHECKED AND VERIFIED ON SITE. ALL THE DIMENSIONS AND DIMENSIONS REFER TO ARCHITECT PRIOR TO COMMENCEMENT OF THE WORK. DO NOT SCALE DRAWINGS MANUALLY OR ELECTRONICALLY.		