


NO A B C D E F G H	REVISION FOR DA SUBMISSION FOR AMENDED DA SUBMISSION FOR AMENDED DA SUBMISSION DRAFT S34 PACKAGE FOR S34 LODGEMENT FOR FINAL S34 REVIEW S34 AMENDMENT S34 AMENDMENT	BY DK DK DK DK DK DK	SL RPW RPW RPW RPW	DATE 16.12.21 25.07.23 24.08.23 26.06.24 03.07.24 31.07.24 15.08.24 23.09.24	REVISION NOTES:	CLOUD LEGEND	NOTES: KOICHI TAKADA ARCHITECTS (KTA)RETAIN ALL COMMOI STATUTORY RIGHTS INCLUDING COPYRIGHT © AND INT PROPERTY RIGHTS TO THIS DOCUMENT. THIS DOCUMENT MUST NOT BE EDITED, PARTIALLY EXT REPRODUCED OR DISTRIBUTED IN ANY MANNER WITHO EXPRESS WRITTEN CONSENT AND UNDER NO CIRCUMS THE TRANSFER OF THIS DOCUMENT BE DEEMED A SALL CONSTITUTE A TRANSFER OF ANY LICENCE TO USE THE WITHOUT KTA'S KNOWLEDGE OR CONSENT. THE POF DOCUMENT STAMPED BY KTA AS A 'QA CONTR DOCUMENT IS THE ONLY OFFICIAL VERSION OF THIS D IS STRICTLY SUBJECT TO COPYRIGHT ©. THE CONTENT AND ACCURACY OF THE DOCUMENT IS S LIMITED TO THAT DEPICTED IN THE QA CONTROLLED PI DO NOT MEASURE FROM THE ELECTRONIC OR HARD C' OF THIS DOCUMENT. VERIFY ALL DIMENSIONS ON SITE BEFORE COMMENCIN DRAWINGS, FABRICATION, CONSTRUCTION OR INSTALL




	PROJECT 1112-1116 BARRENJOEY RD 1112 - 1116 BARRENJOEY ROAD, PALM BEACH	SITE PLAN	
PPROVED FOR CONSTRUCTION	STATUS	DWG NO.	REVISION
ED THE STATUS TITLE AS 'FOR ICE OF 'WIP', 'DRAFT' OR ANY IE DOCUMENT.	DEVELOPMENT APPLICATION	A0012	Н
	0 10 m	SCALE	DATE
		1:200@A1, 1:400@A3	23.09.24

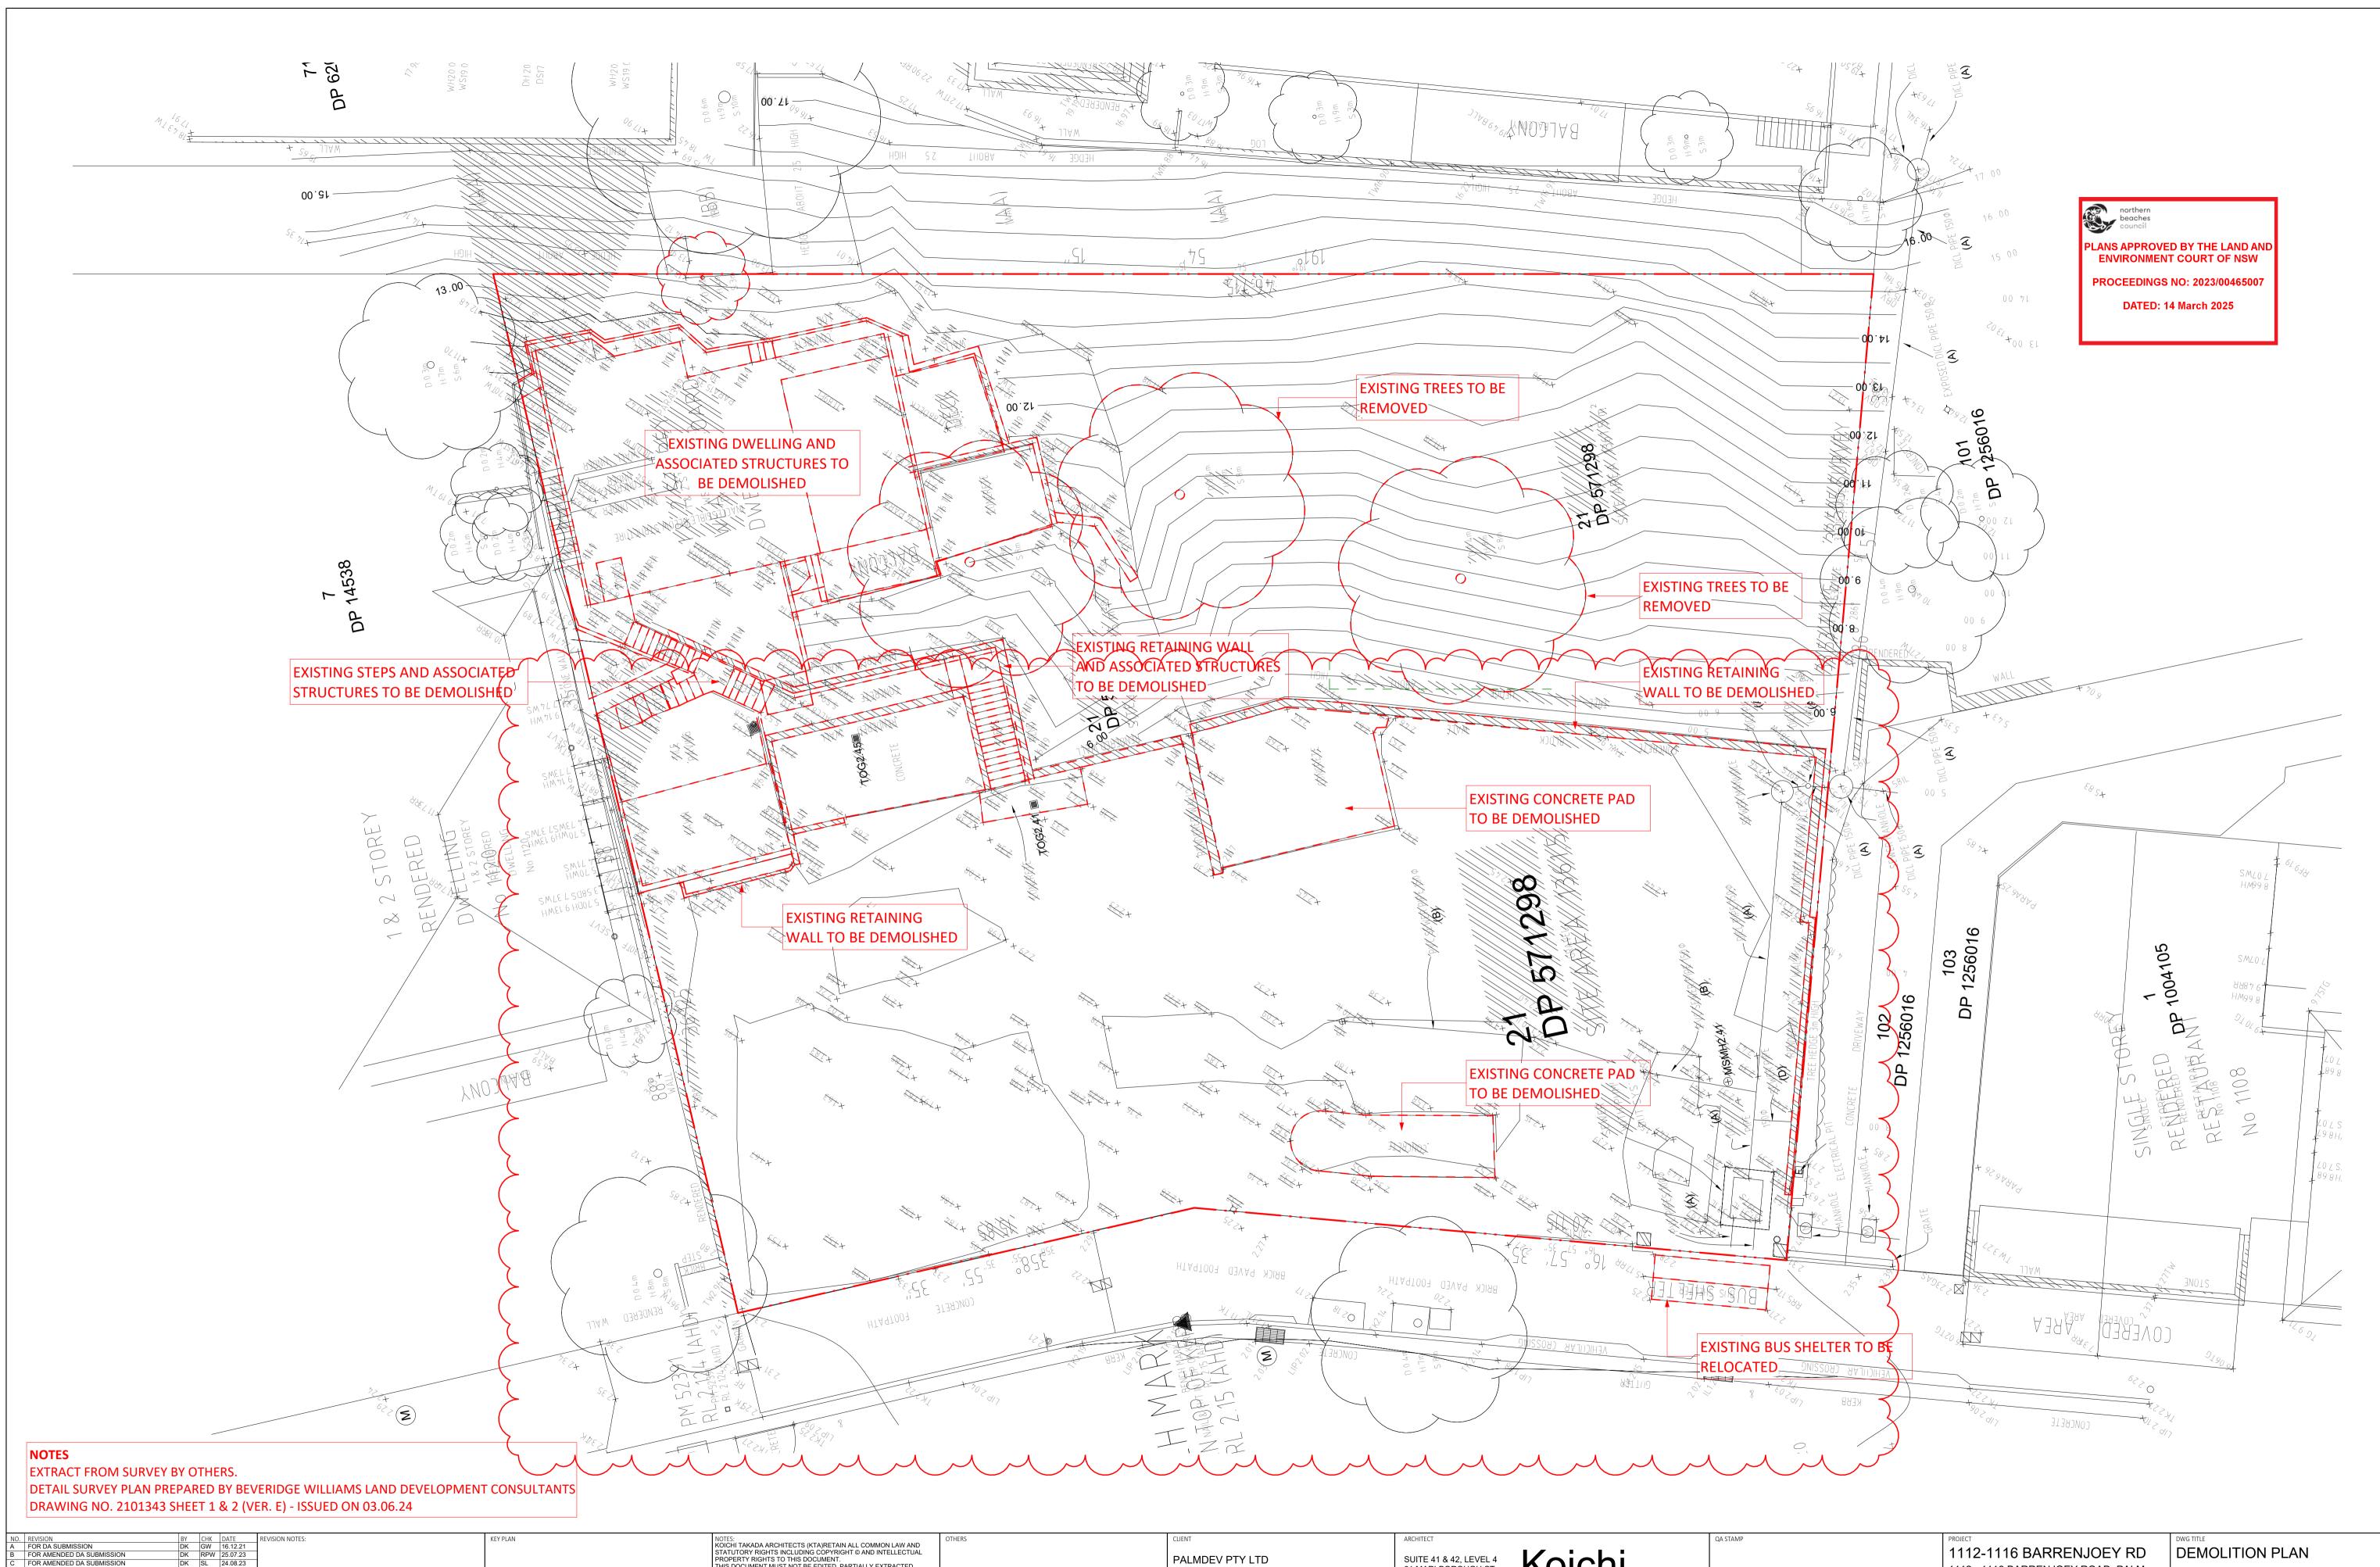


NO. REVISION	N	BY CHK DAT	REVISION NOTES:	KEY PLAN	NOTES:	OTHERS	CLIENT	ARCHITECT		QA STAMP
BFOR AMICFOR AMIDDRAFT SEFOR S34	A SUBMISSION MENDED DA SUBMISSION MENDED DA SUBMISSION S34 PACKAGE 44 LODGEMENT NAL S34 REVIEW	DK GW 16. DK RPW 25.0 DK SL 24.0 DK RPW 26.0 DK RPW 31.0	21 23 23 24 24	CLOUD LEGEND	KOICHI TAKADA ARCHITECTS (KTA)RETAIN ALL COMMON LAW AND STATUTORY RIGHTS INCLUDING COPYRIGHT © AND INTELLECTUAL PROPERTY RIGHTS TO THIS DOCUMENT. THIS DOCUMENT MUST NOT BE EDITED, PARTIALLY EXTRACTED, REPRODUCED OR DISTRIBUTED IN ANY MANNER WITHOUT KTA'S EXPRESS WRITTEN CONSENT AND UNDER NO CIRCUMSTANCES SHALI THE TRANSFER OF THIS DOCUMENT BE DEEMED A SALE OR CONSTITUTE A TRANSFER OF ANY LICENCE TO USE THE DOCUMENT WITHOUT KTA'S KNOWLEDGE OR CONSENT. THE PDF DOCUMENT STAMPED BY KTA AS A 'QA CONTROLLED DOCUMENT' IS THE ONLY OFFICIAL VERSION OF THIS DOCUMENT AND IS STRICTLY SUBJECT TO COPYRIGHT ©. THE CONTENT AND ACCURACY OF THE DOCUMENT IS STRICTLY LIMITED TO THAT DEPICTED IN THE QA CONTROLLED PDF. DO NOT MEASURE FROM THE ELECTRONIC OR HARD COPY VERSIONS		PALMDEV PTY LTD LEVEL 1, 600 DARLING STREET ROZELLE NSW 2039	SUITE 41 & 42, LEVEL 4 61 MARLBOROUGH ST SURRY HILLS, NSW 2010 T 02 9698 8510 ABN 63 131 365 896 NOMINATED ARCHITECT: KOICHI TAKADA NSW ARCHITECTS 6901 VIC ARCHITECTS 16179 QLD ARCHITECTS 5590	Koichi Takada Architects	THIS DOCUMENT IS NOT SUITABLE OR A AT ANY TIME UNLESS KTA HAVE NOTATI CONSTRUCTION WITHOUT THE PRESEN OTHER FORM OF QUALIFICATION ON TH
				REVISION ON HOLD	OF THIS DOCUMENT. VERIFY ALL DIMENSIONS ON SITE BEFORE COMMENCING SHOP DRAWINGS, FABRICATION, CONSTRUCTION OR INSTALLATION.			KOICHITAKADA.COM	AIGHIEGIS	

	PROJECT 1112-1116 BARRENJOEY RD 1112 - 1116 BARRENJOEY ROAD, PALM BEACH			
OR APPROVED FOR CONSTRUCTION DTATED THE STATUS TITLE AS 'FOR ESENCE OF 'WIP', 'DRAFT' OR ANY IN THE DOCUMENT.	STATUS DEVELOPMENT APPLICATION	DWG NO. A0013	revision F	
	0 5 m	scale 1:100@A1, 1:200@A3	DATE 31.07.24	

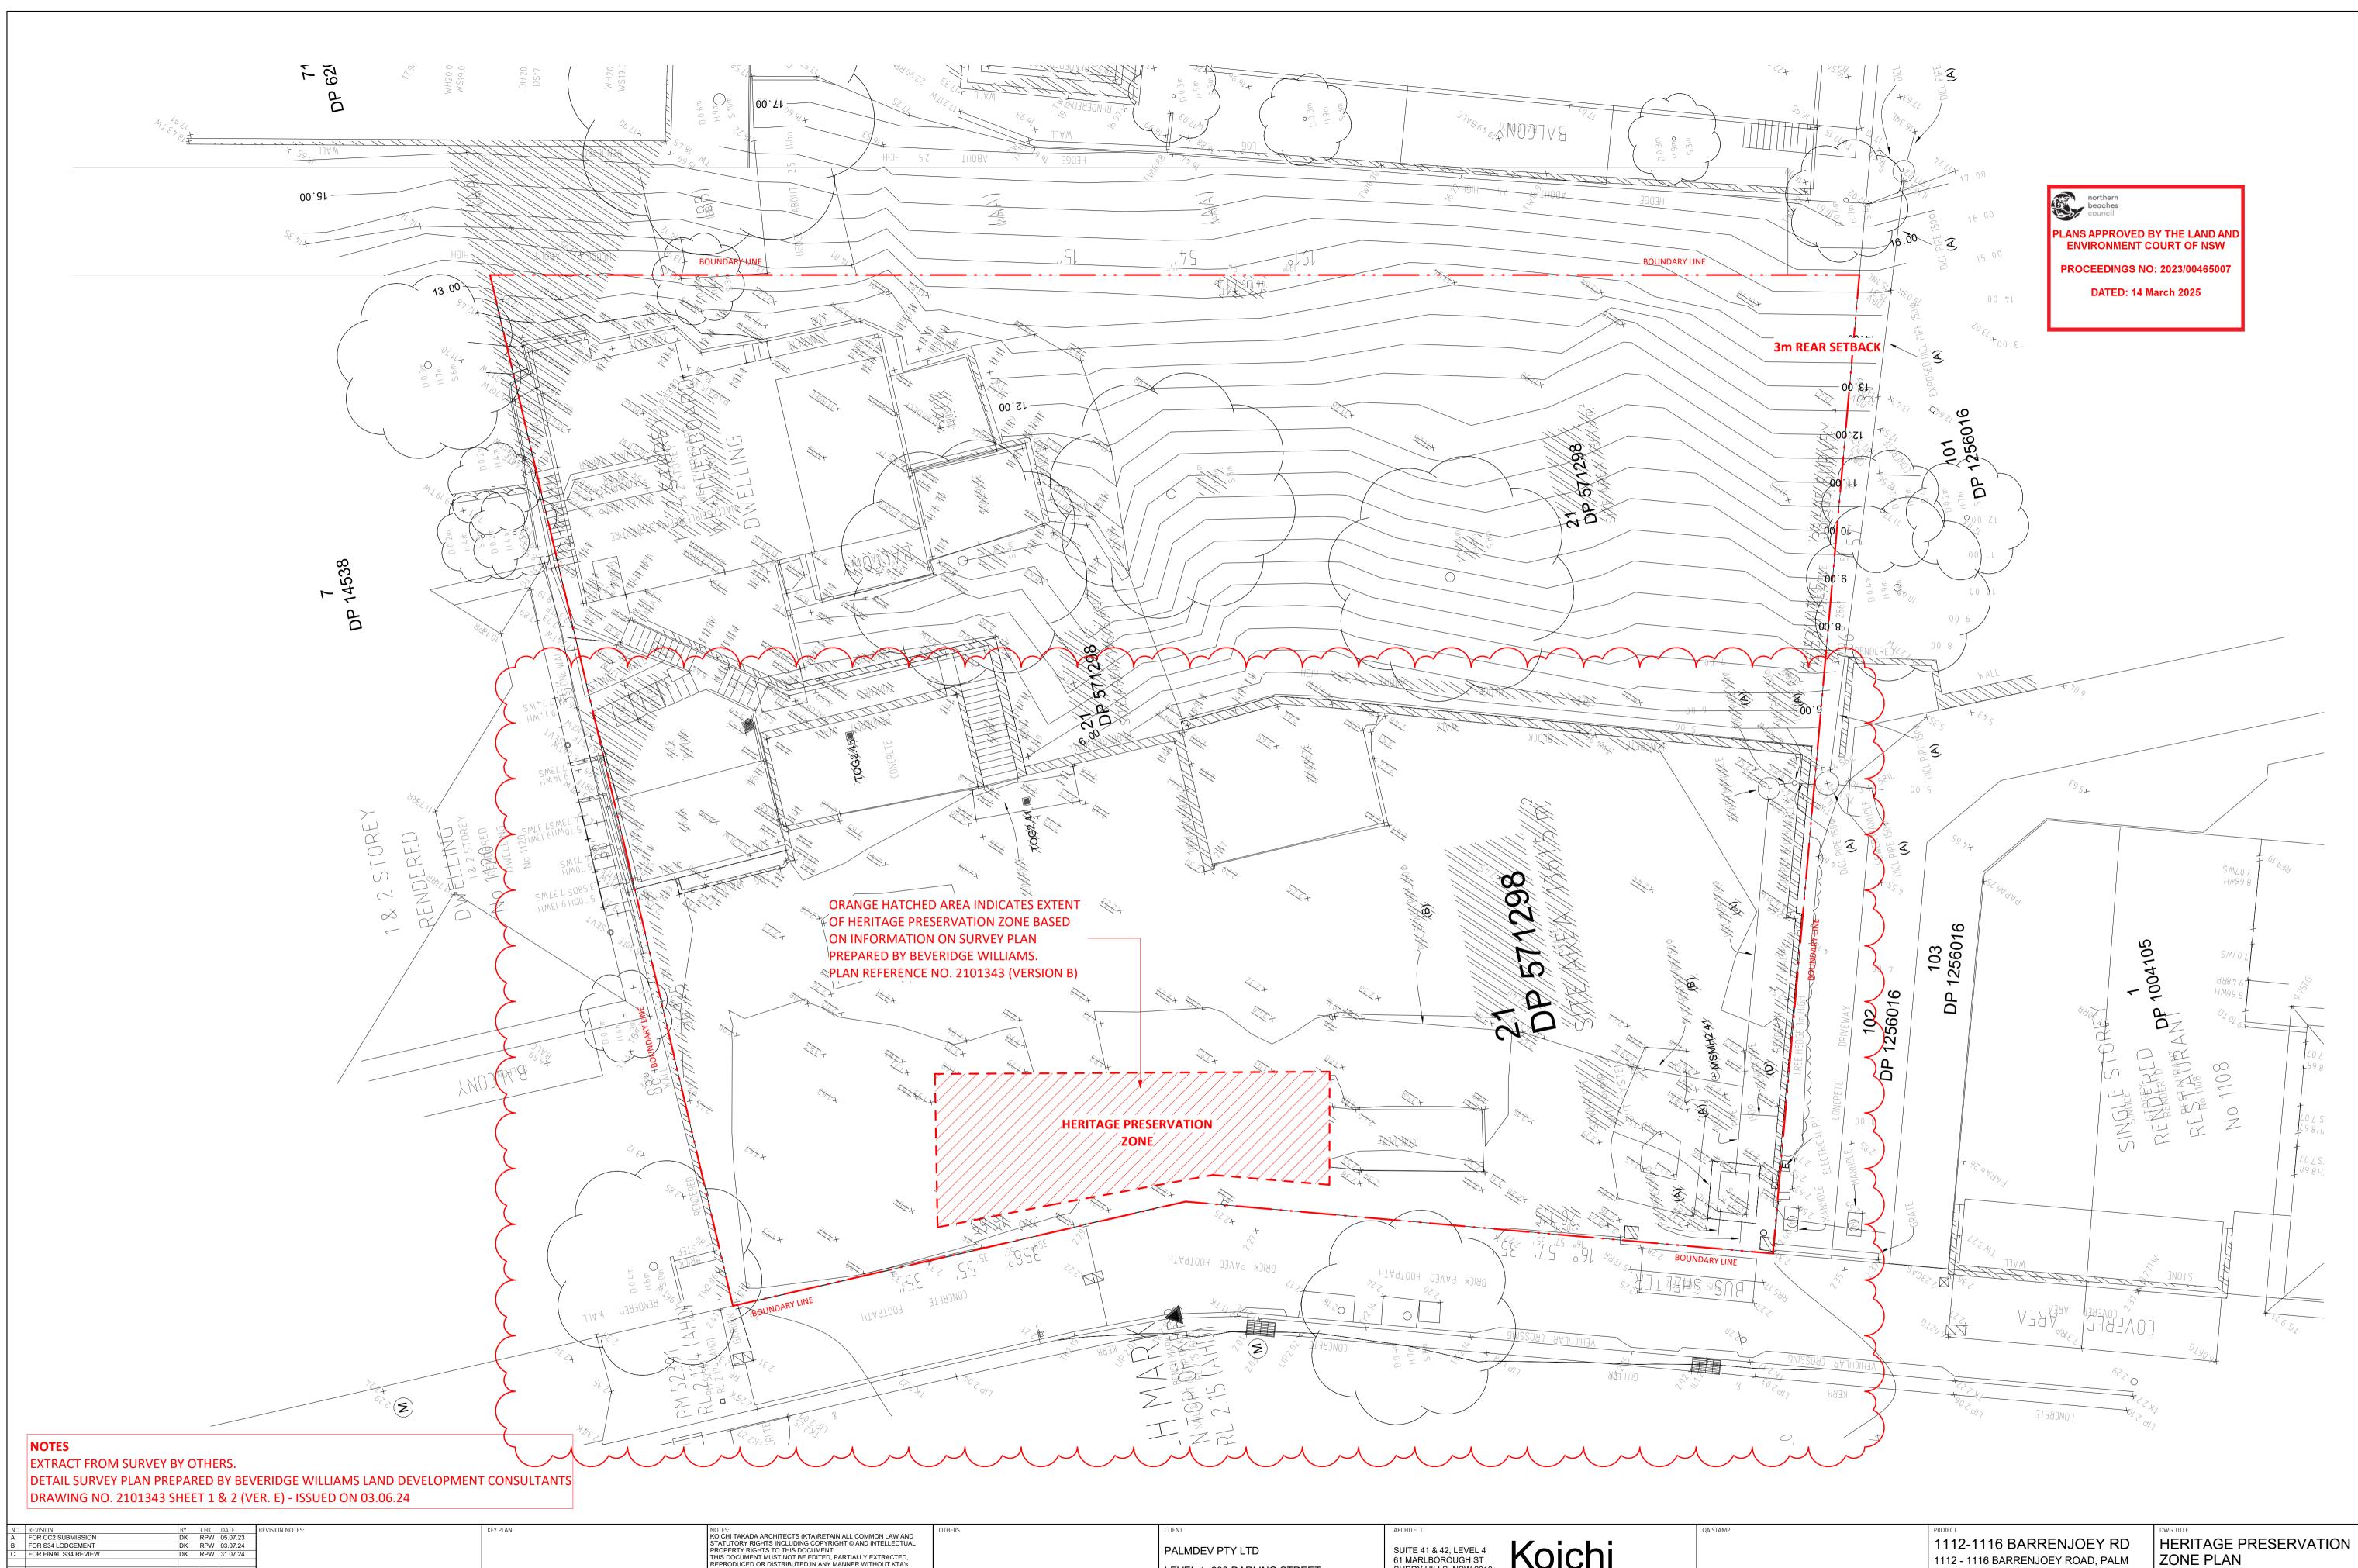


٦.	101002 300101331014	DR		05.07.25
3	FOR S34 LODGEMENT	DK	RPW	03.07.24
2	FOR FINAL S34 REVIEW	DK	RPW	31.07.24
		-	-	
		-	-	-
		_		
			-	-
		-	+	+
		+	+	+

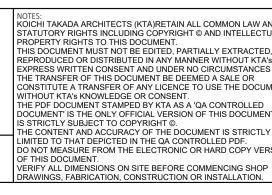

	PROJECT 1112-1116 BARRENJOEY RD 1112 - 1116 BARRENJOEY ROAD, PALM BEACH	HERITAGE PRESERVATION ZONE PLAN		
OR APPROVED FOR CONSTRUCTION DTATED THE STATUS TITLE AS 'FOR ESENCE OF 'WIP', 'DRAFT' OR ANY IN THE DOCUMENT.	STATUS DEVELOPMENT APPLICATION	dwg NO. A0022	REVISION C	
	0 5 m	scale 1:100@A1, 1:200@A3	DATE 31.07.24	


NO.	REVISION	BY	СНК	DATE	REVISION NOTES:	KEY PLAN		NOTES:
А	FOR DA SUBMISSION	DK		16.12.21	1			KOICHI TAKADA ARCHITECTS (KTA)RETAIN ALL COMMON L
В	FOR AMENDED DA SUBMISSION	DK	RPW	25.07.23	1			STATUTORY RIGHTS INCLUDING COPYRIGHT © AND INTEL
С	FOR AMENDED DA SUBMISSION	DK	SL	24.08.23	1			PROPERTY RIGHTS TO THIS DOCUMENT. THIS DOCUMENT MUST NOT BE EDITED. PARTIALLY EXTRA
1	CONCEPT PLAN AMENDMENT	DK	RPW	04.04.24	1			REPRODUCED OR DISTRIBUTED IN ANY MANNER WITHOUT
2	FOR COUNCIL DISCUSSION	DK	RPW	29.04.24	1			EXPRESS WRITTEN CONSENT AND UNDER NO CIRCUMSTA
D	FOR COUNCIL RFI (AMENDED)	DK	RPW	13.06.24	1			THE TRANSFER OF THIS DOCUMENT BE DEEMED A SALE O
Е	DRAFT S34 PACKAGE	DK	RPW	26.06.24	1			CONSTITUTE A TRANSFER OF ANY LICENCE TO USE THE D
F	FOR S34 LODGEMENT	DK	RPW	03.07.24	1			WITHOUT KTA'S KNOWLEDGE OR CONSENT. THE PDF DOCUMENT STAMPED BY KTA AS A 'QA CONTROL
G	FOR FINAL S34 REVIEW	DK	RPW	31.07.24]			DOCUMENT' IS THE ONLY OFFICIAL VERSION OF THIS DOC
Н	S34 AMENDMENT	DK	RPW	11.09.24]			IS STRICTLY SUBJECT TO COPYRIGHT ©.
]			THE CONTENT AND ACCURACY OF THE DOCUMENT IS STR
						CLOUD LEGEND		LIMITED TO THAT DEPICTED IN THE QA CONTROLLED PDF. DO NOT MEASURE FROM THE ELECTRONIC OR HARD COP
								OF THIS DOCUMENT.
						REVISION	ON HOLD	VERIFY ALL DIMENSIONS ON SITE BEFORE COMMENCING
							• • •	DRAWINGS, FABRICATION, CONSTRUCTION OR INSTALLAT

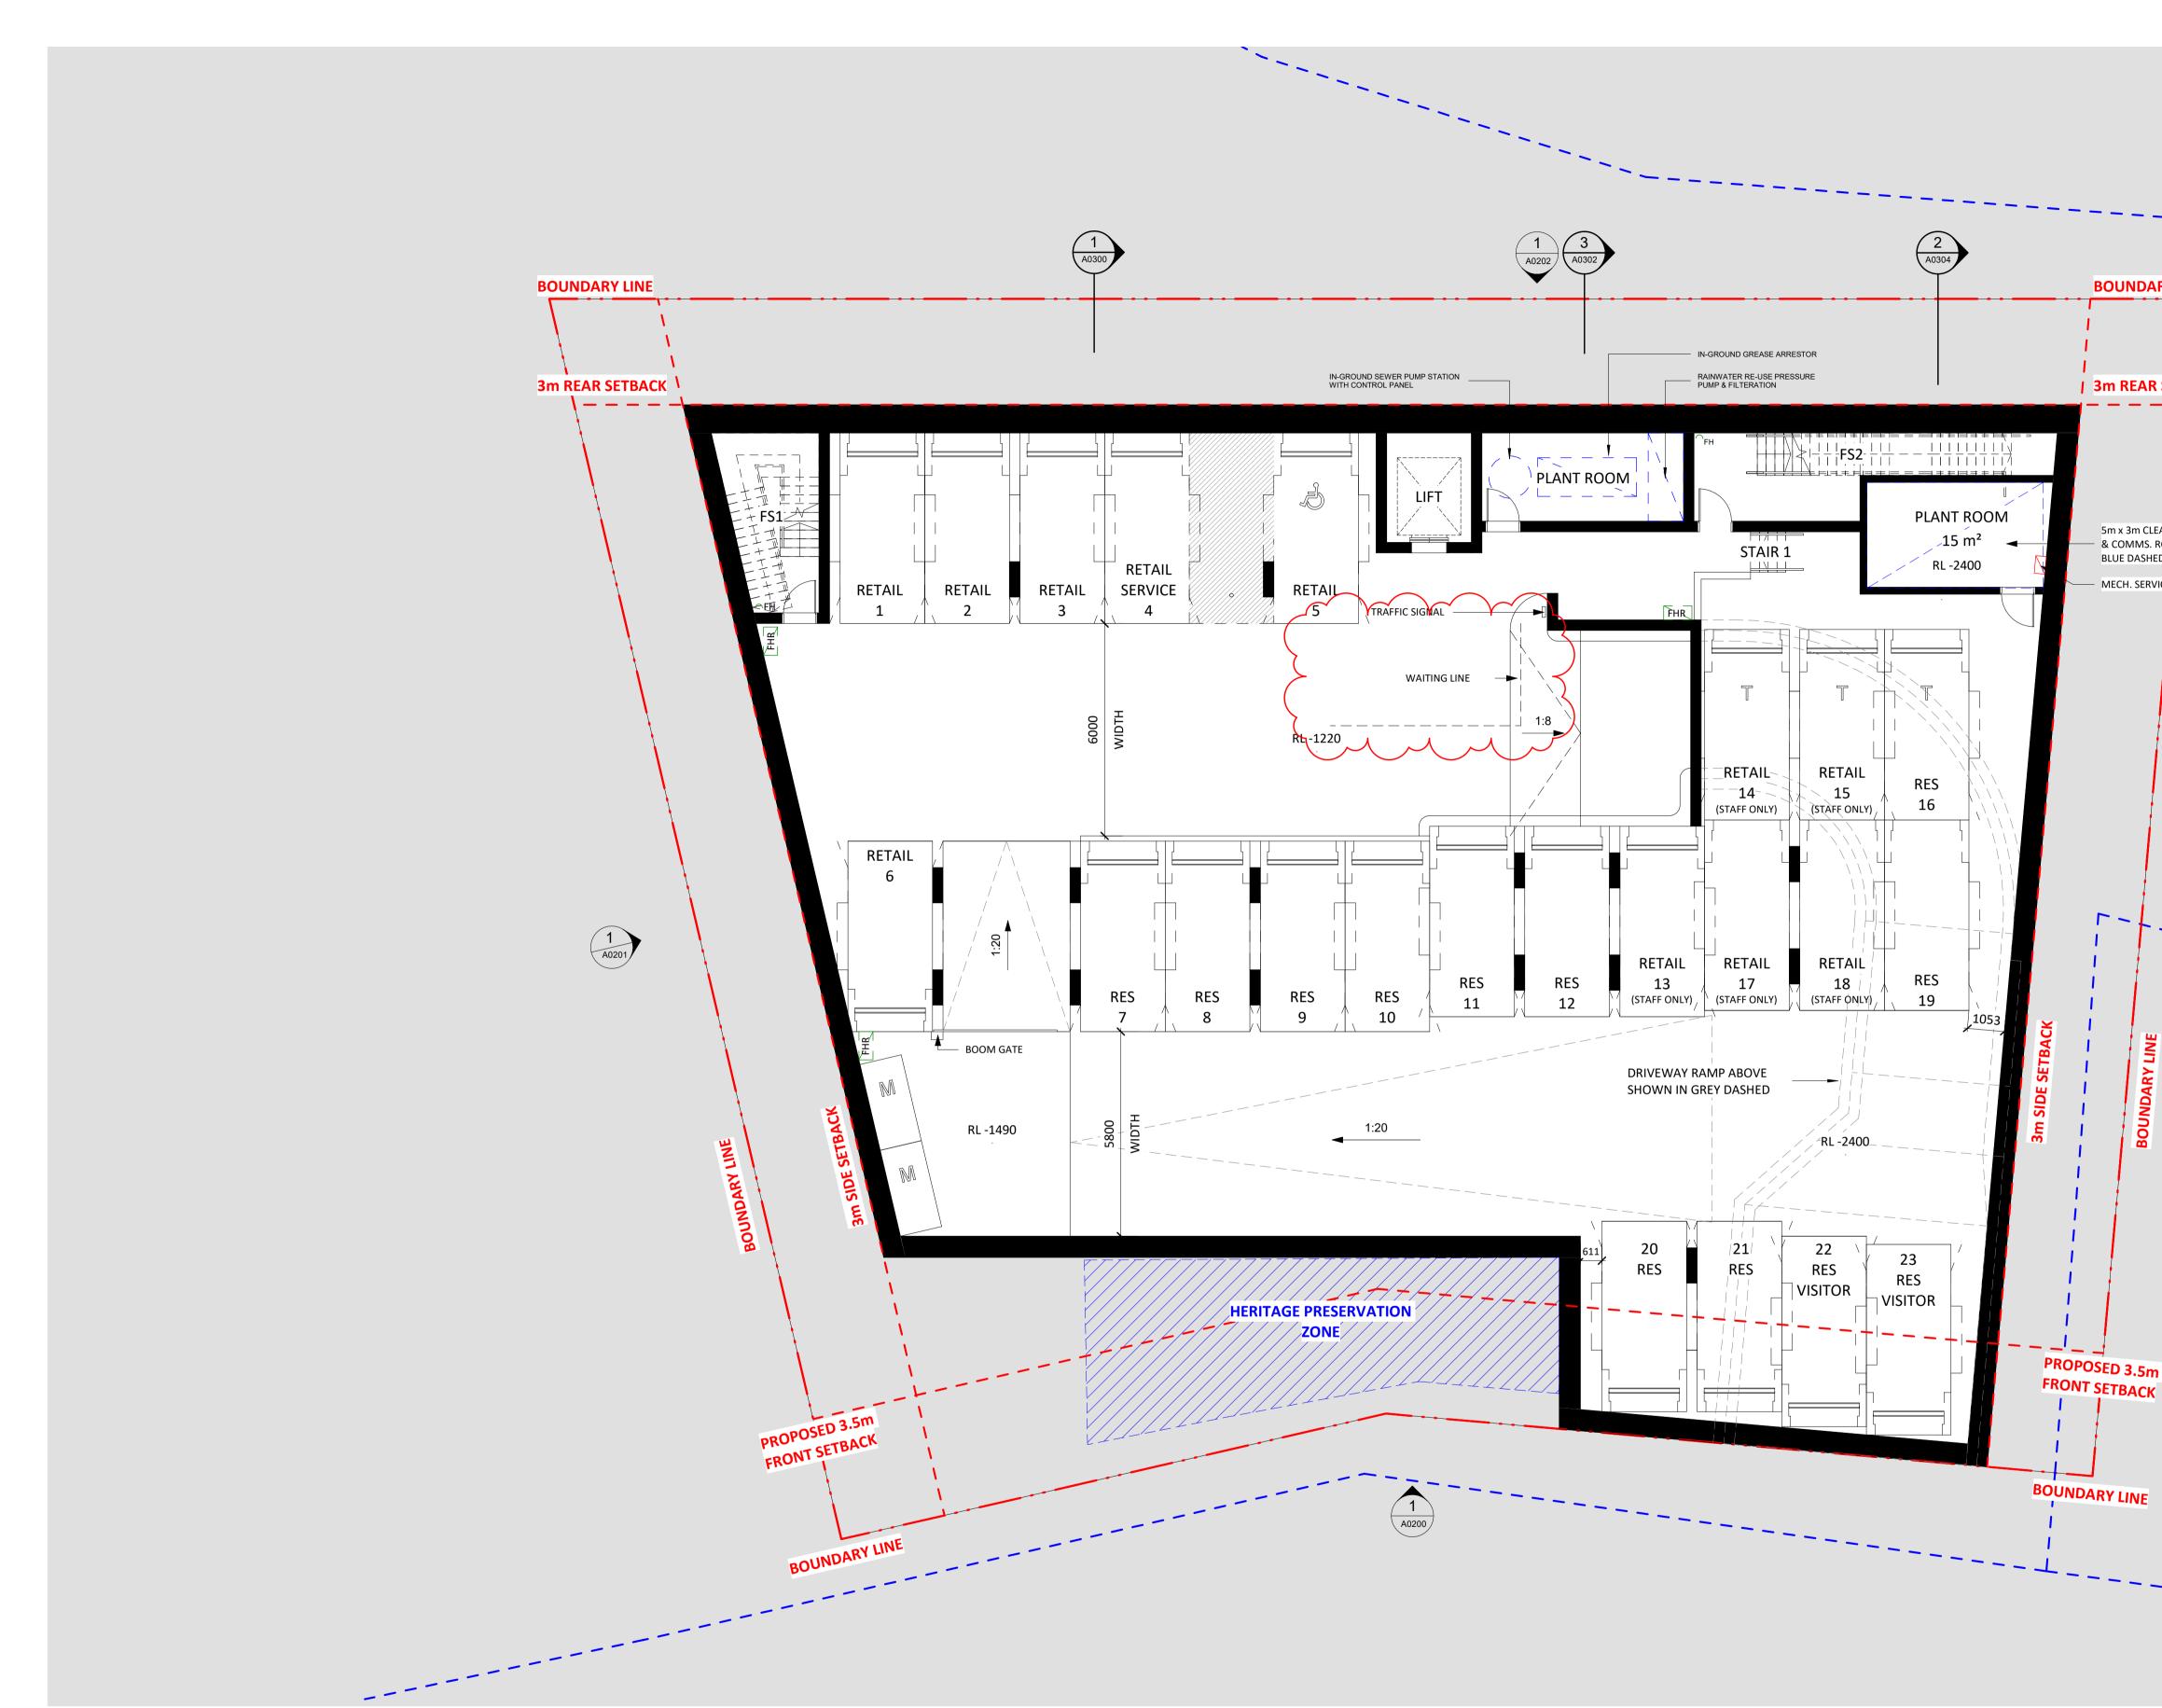


	OTHERS	CLIENT	ARCHITECT		QA STAMP
W AND ECTUAL CTED, KTA's VCES SHALL COLMENT ED JMENT AND CTLY VERSIONS HOP ON.		PALMDEV PTY LTD LEVEL 1, 600 DARLING STREET ROZELLE NSW 2039	SUITE 41 & 42, LEVEL 4 61 MARLBOROUGH ST SURRY HILLS, NSW 2010 T 02 9698 8510 ABN 63 131 365 896 NOMINATED ARCHITECT: KOICHI TAKADA NSW ARCHITECTS 6901 VIC ARCHITECTS 16179 QLD ARCHITECTS 5590 KOICHITAKADA.COM	Koichi Takada Architects	THIS DOCUMENT IS NOT SUITABLE OR AF AT ANY TIME UNLESS KTA HAVE NOTATE CONSTRUCTION' WITHOUT THE PRESENC OTHER FORM OF QUALIFICATION ON THE


	CAR	PARKING	
i	Descrip		:
	Accessible Bay (AS289) Car Bay (T) Tandem 54		
1	Motorbike Bay (2500 x 2	200) 2	
	Standard Car Bay 5400 Total Cars & Motorbikes		_
AR SETBACK			
.5m ACK VE			
OR APPROVED FOR CONSTRUCTION	PROJECT 1112-1116 BARRENJOEY RD 1112 - 1116 BARRENJOEY ROAD, PALM BEACH STATUS	DWG TITLE BASEMENT 1 - FLOOF	
TATED THE STATUS TITLE AS 'FOR ESENCE OF 'WIP', 'DRAFT' OR ANY N THE DOCUMENT.	DEVELOPMENT APPLICATION	A0099 SCALE	H


	BEACH		
OR CONSTRUCTION	STATUS	DWG NO.	REVISION
TUS TITLE AS 'FOR '', 'DRAFT' OR ANY NT.	DEVELOPMENT APPLICATION	A0099	Н
	0 5 m	scale 1:100@A1, 1:200@A3	DATE 11.09.24

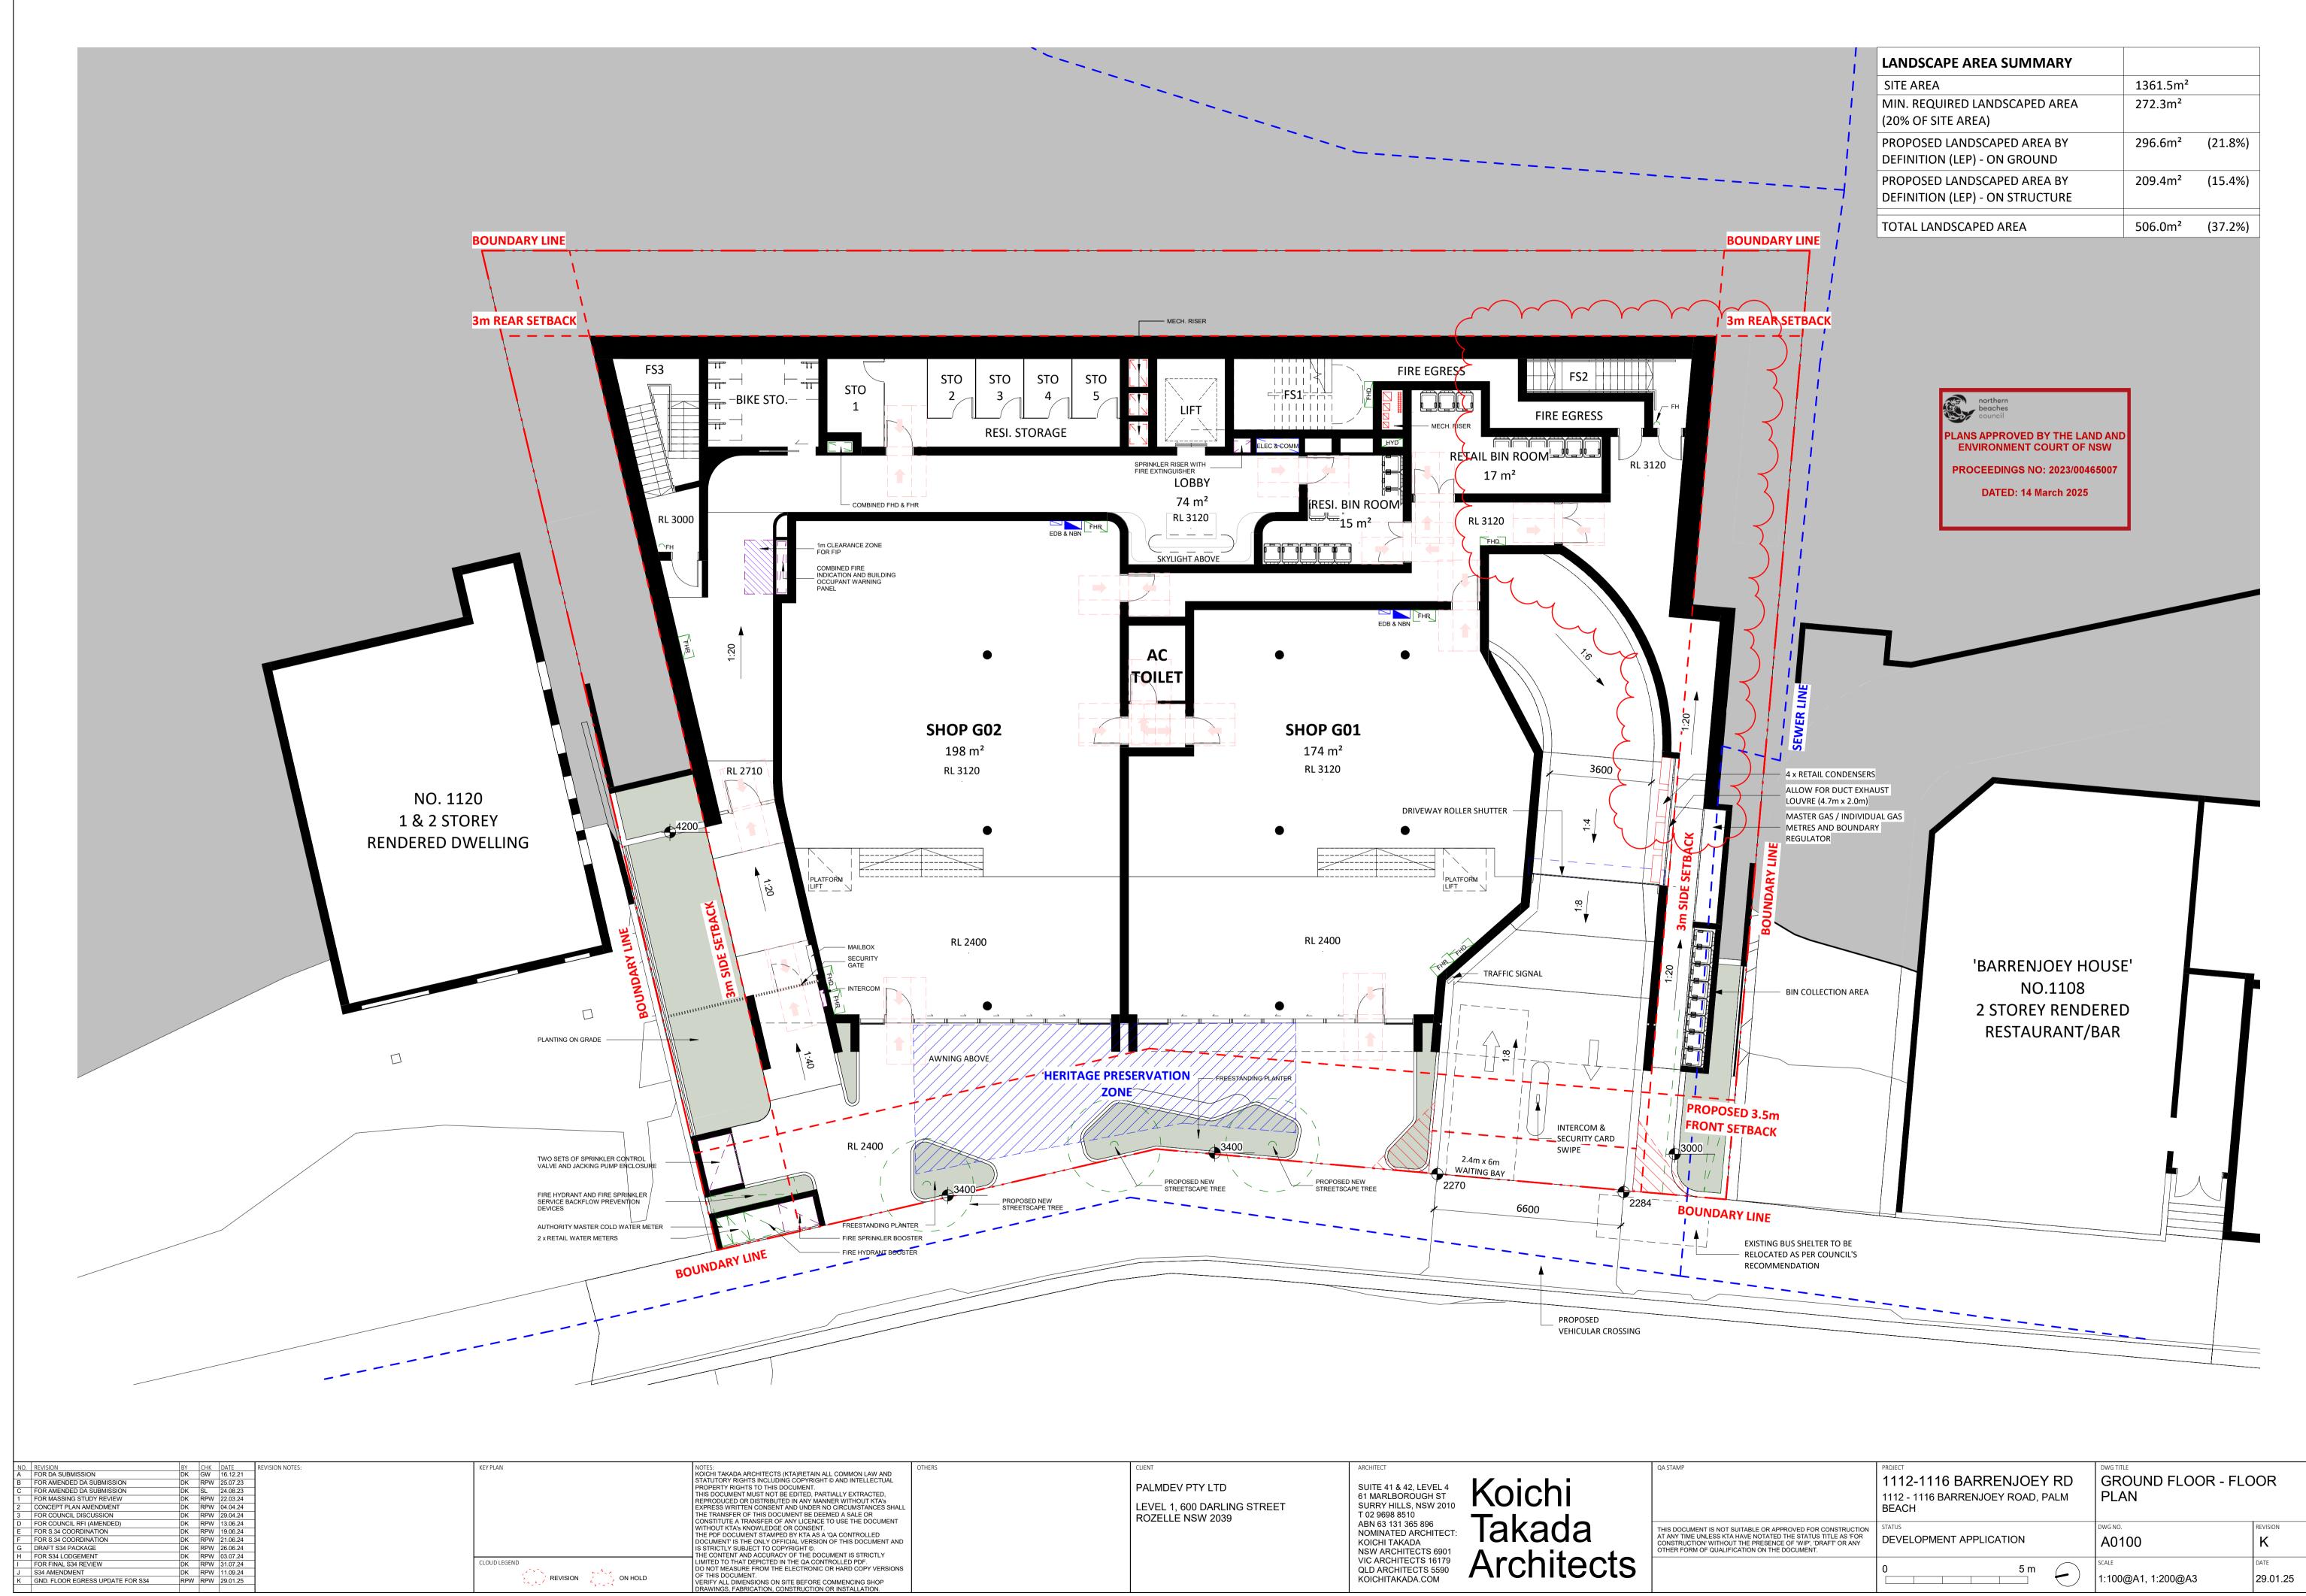


	OTHERS	CLIENT	ARCHITECT	QA STAMP
AND TUAL ED, A's ES SHALL JMENT ENT AND -Y ERSIONS -P		PALMDEV PTY LTD LEVEL 1, 600 DARLING STREET ROZELLE NSW 2039	SUITE 41 & 42, LEVEL 4 61 MARLBOROUGH ST SURRY HILLS, NSW 2010 T 02 9698 8510 ABN 63 131 365 896 NOMINATED ARCHITECT: KOICHI TAKADA NSW ARCHITECTS 6901 VIC ARCHITECTS 16179 QLD ARCHITECTS 5590 KOICHITAKADA.COM	THIS DOCUMENT IS NOT SUITABLE OR AF AT ANY TIME UNLESS KTA HAVE NOTATE CONSTRUCTION' WITHOUT THE PRESENT OTHER FORM OF QUALIFICATION ON THE

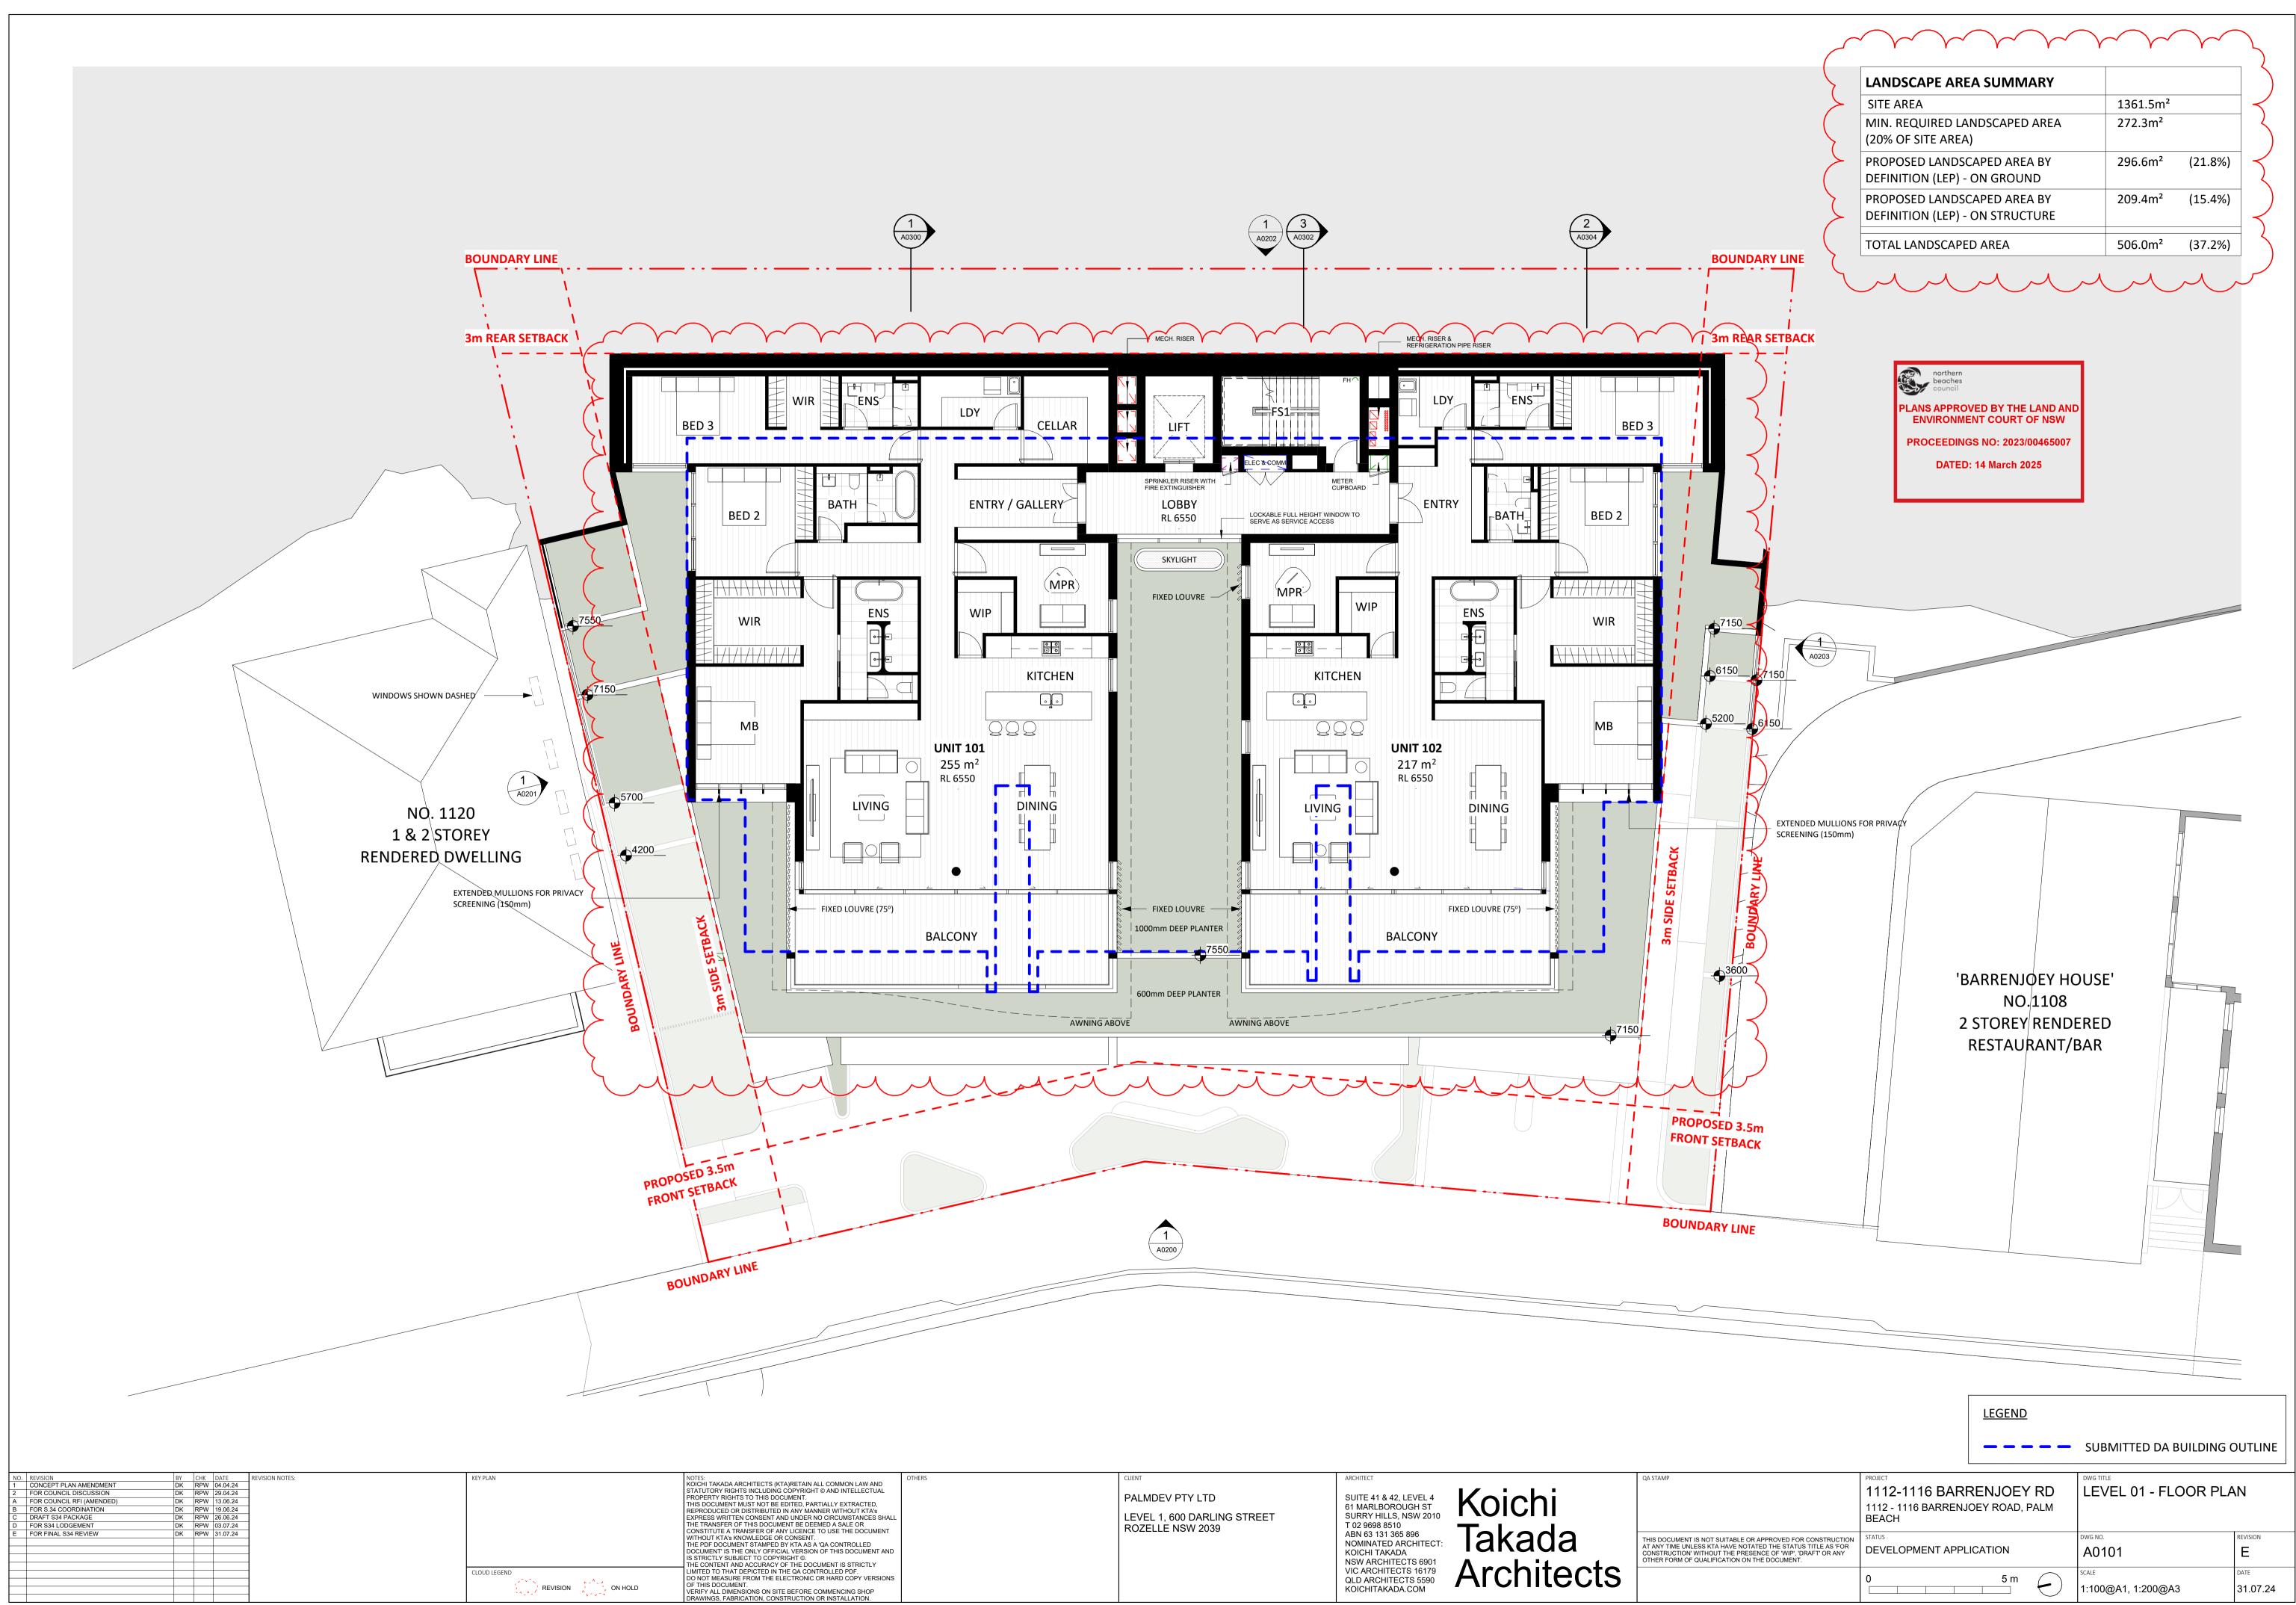


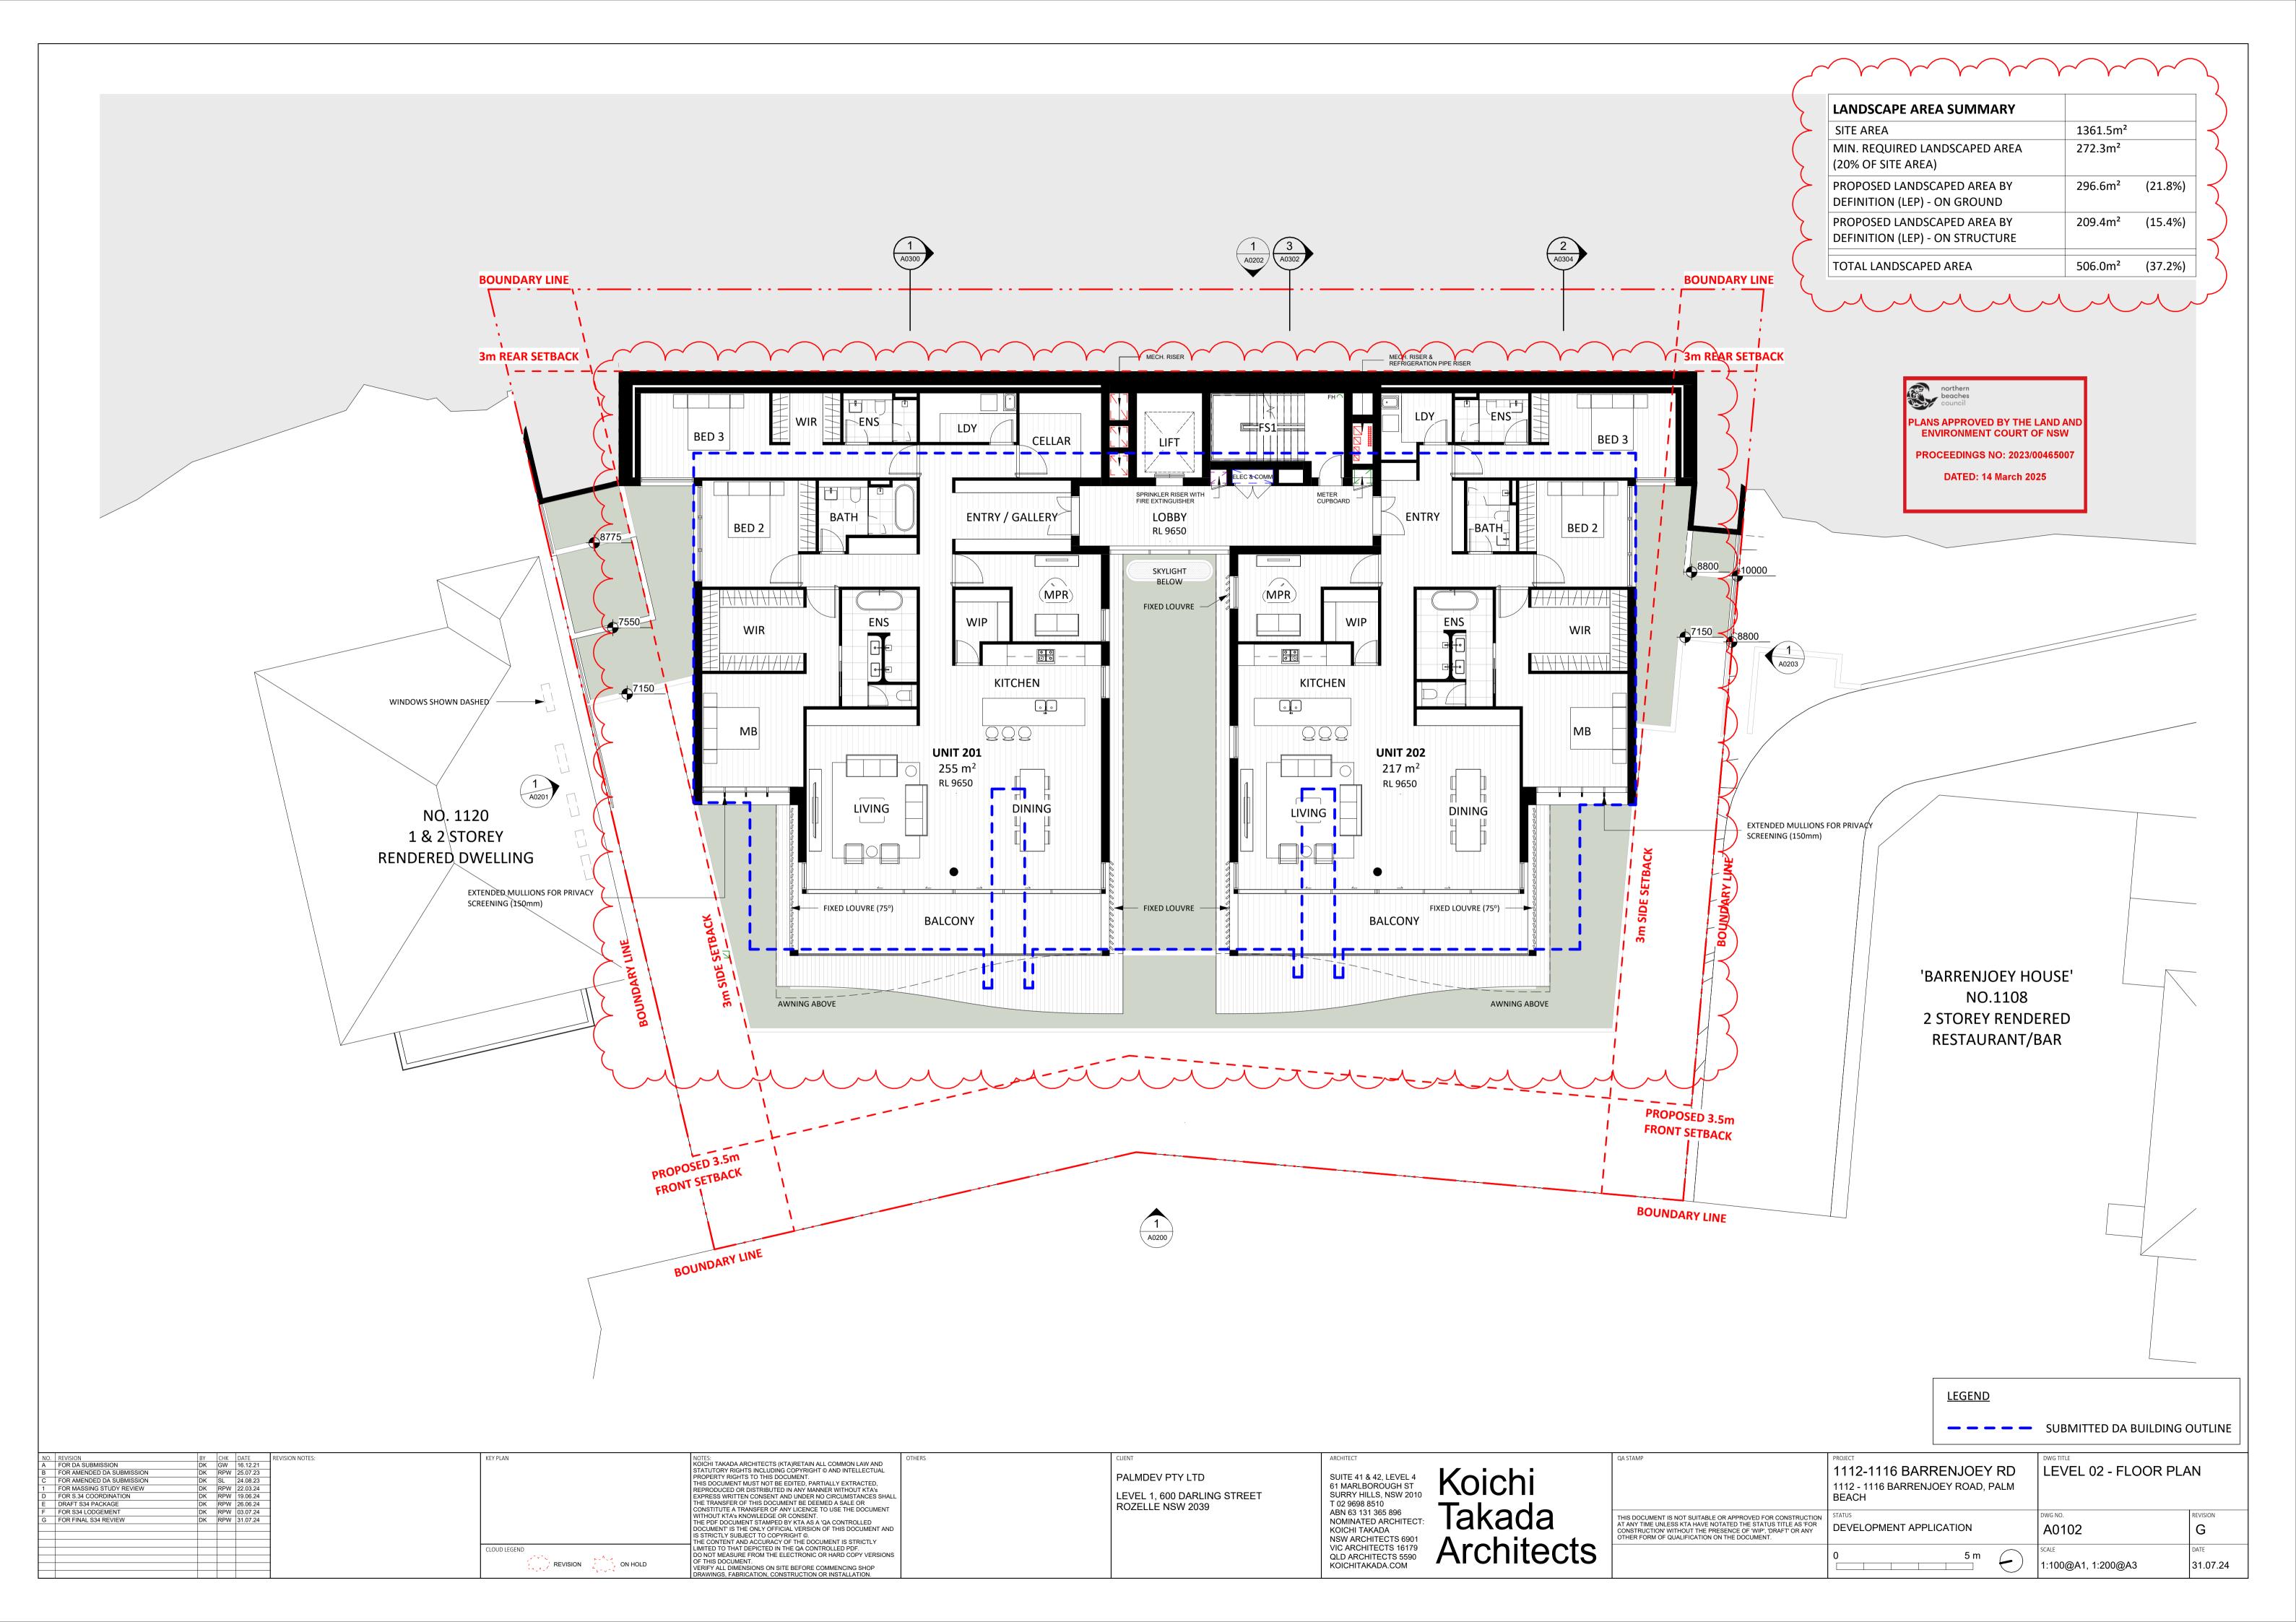

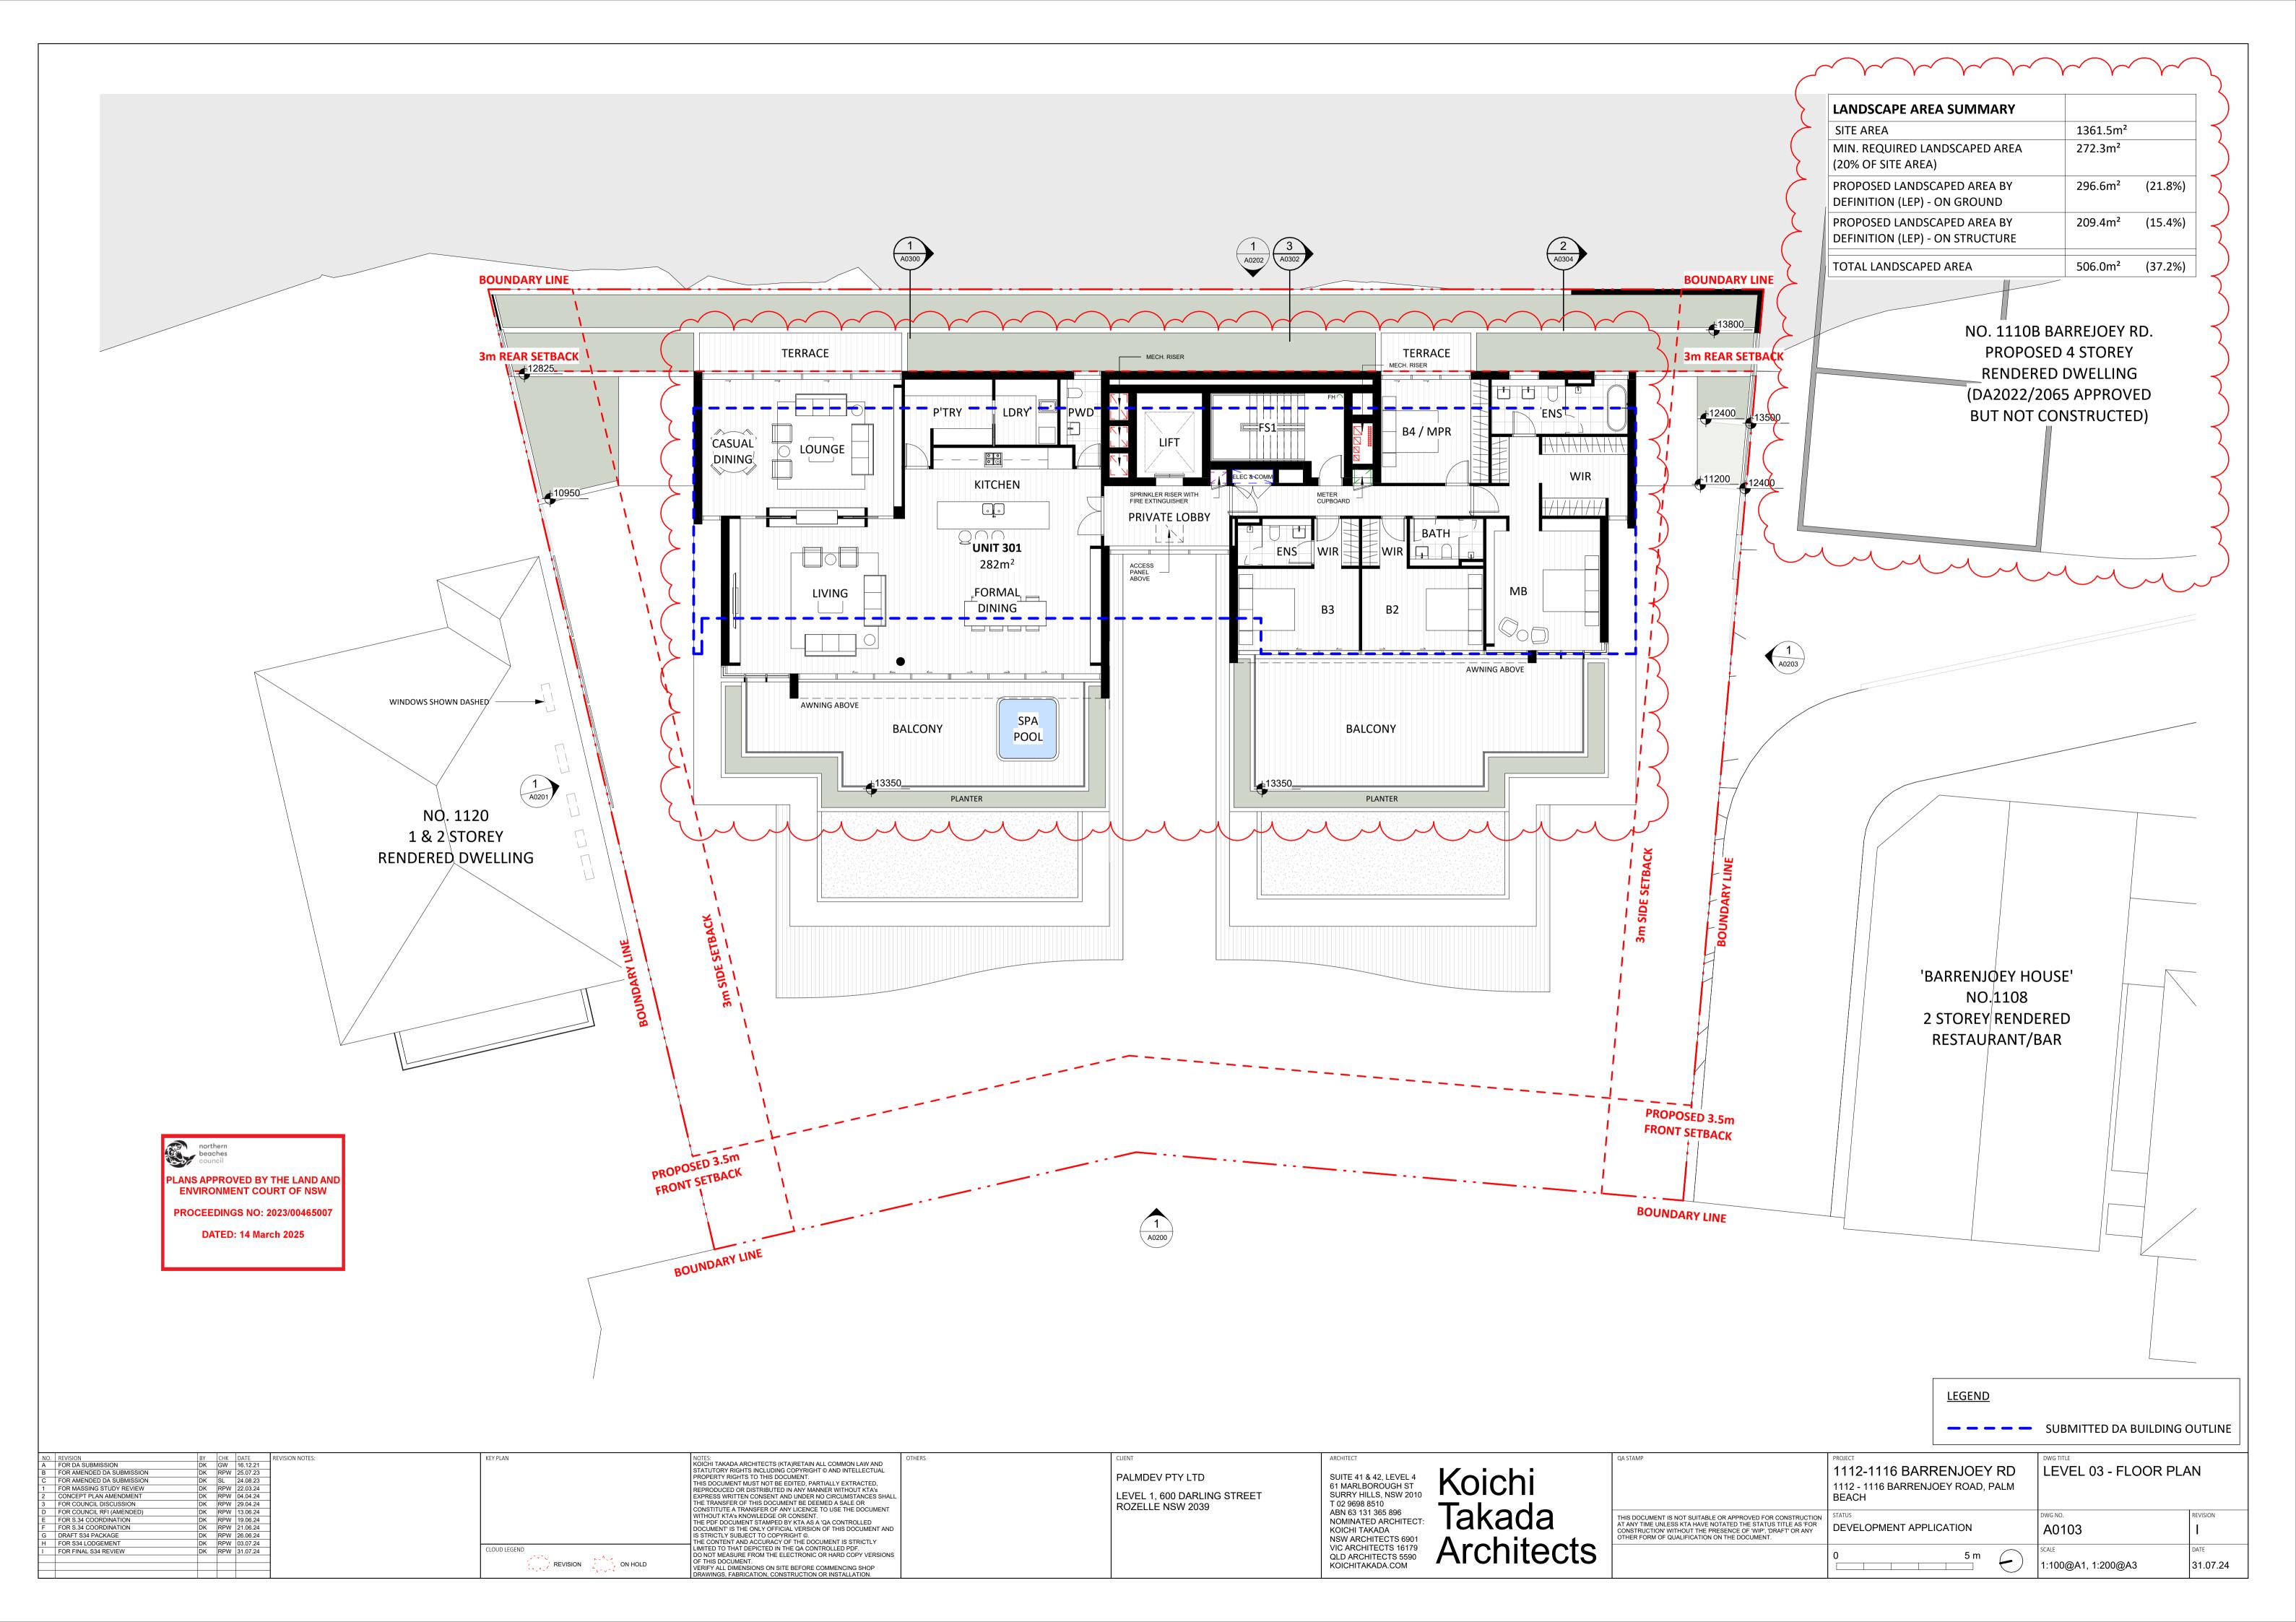

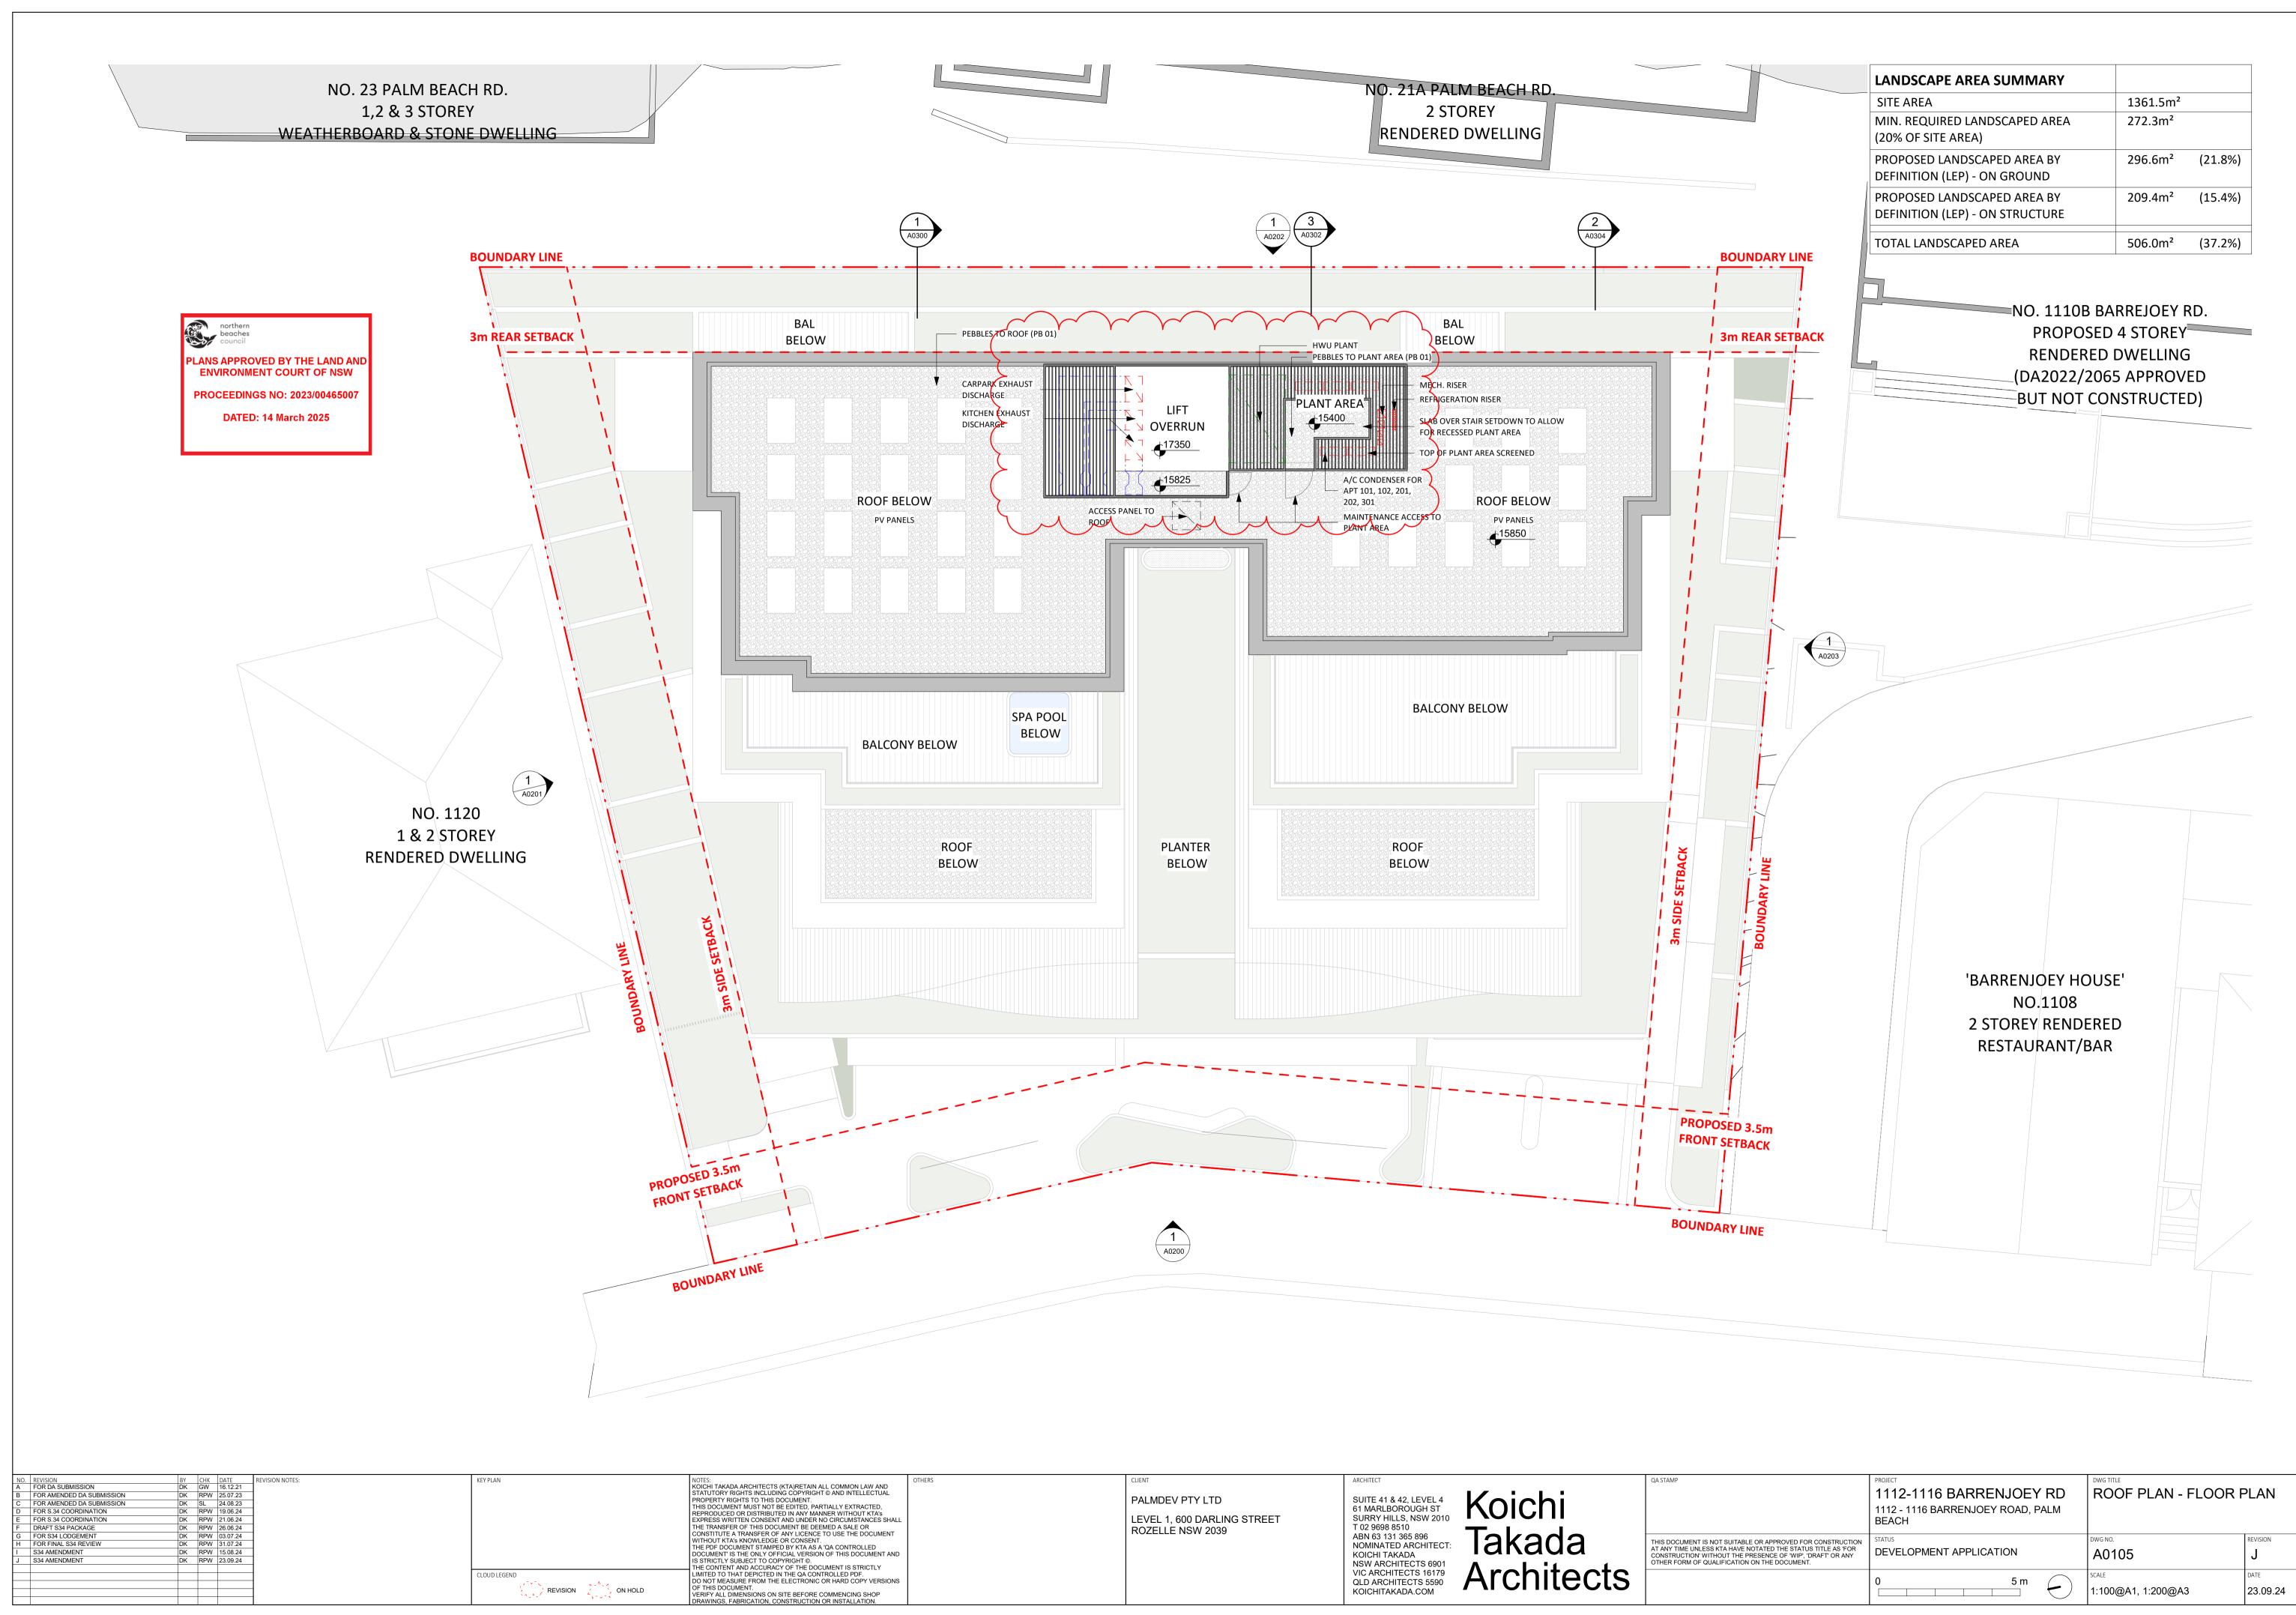


	OTHERS	CLIENT	ARCHITECT	QA STAMP
AND TUAL ED, A's ES SHALL JMENT ENT AND .Y ERSIONS		PALMDEV PTY LTD LEVEL 1, 600 DARLING STREET ROZELLE NSW 2039	SUITE 41 & 42, LEVEL 4 61 MARLBOROUGH ST SURRY HILLS, NSW 2010 T 02 9698 8510 ABN 63 131 365 896 NOMINATED ARCHITECT: KOICHI TAKADA NSW ARCHITECTS 6901 VIC ARCHITECTS 16179 QLD ARCHITECTS 5590 KOICHITAKADA.COM	THIS DOCUMENT IS NOT SUITABLE OR AP AT ANY TIME UNLESS KTA HAVE NOTATED CONSTRUCTION' WITHOUT THE PRESENC OTHER FORM OF QUALIFICATION ON THE

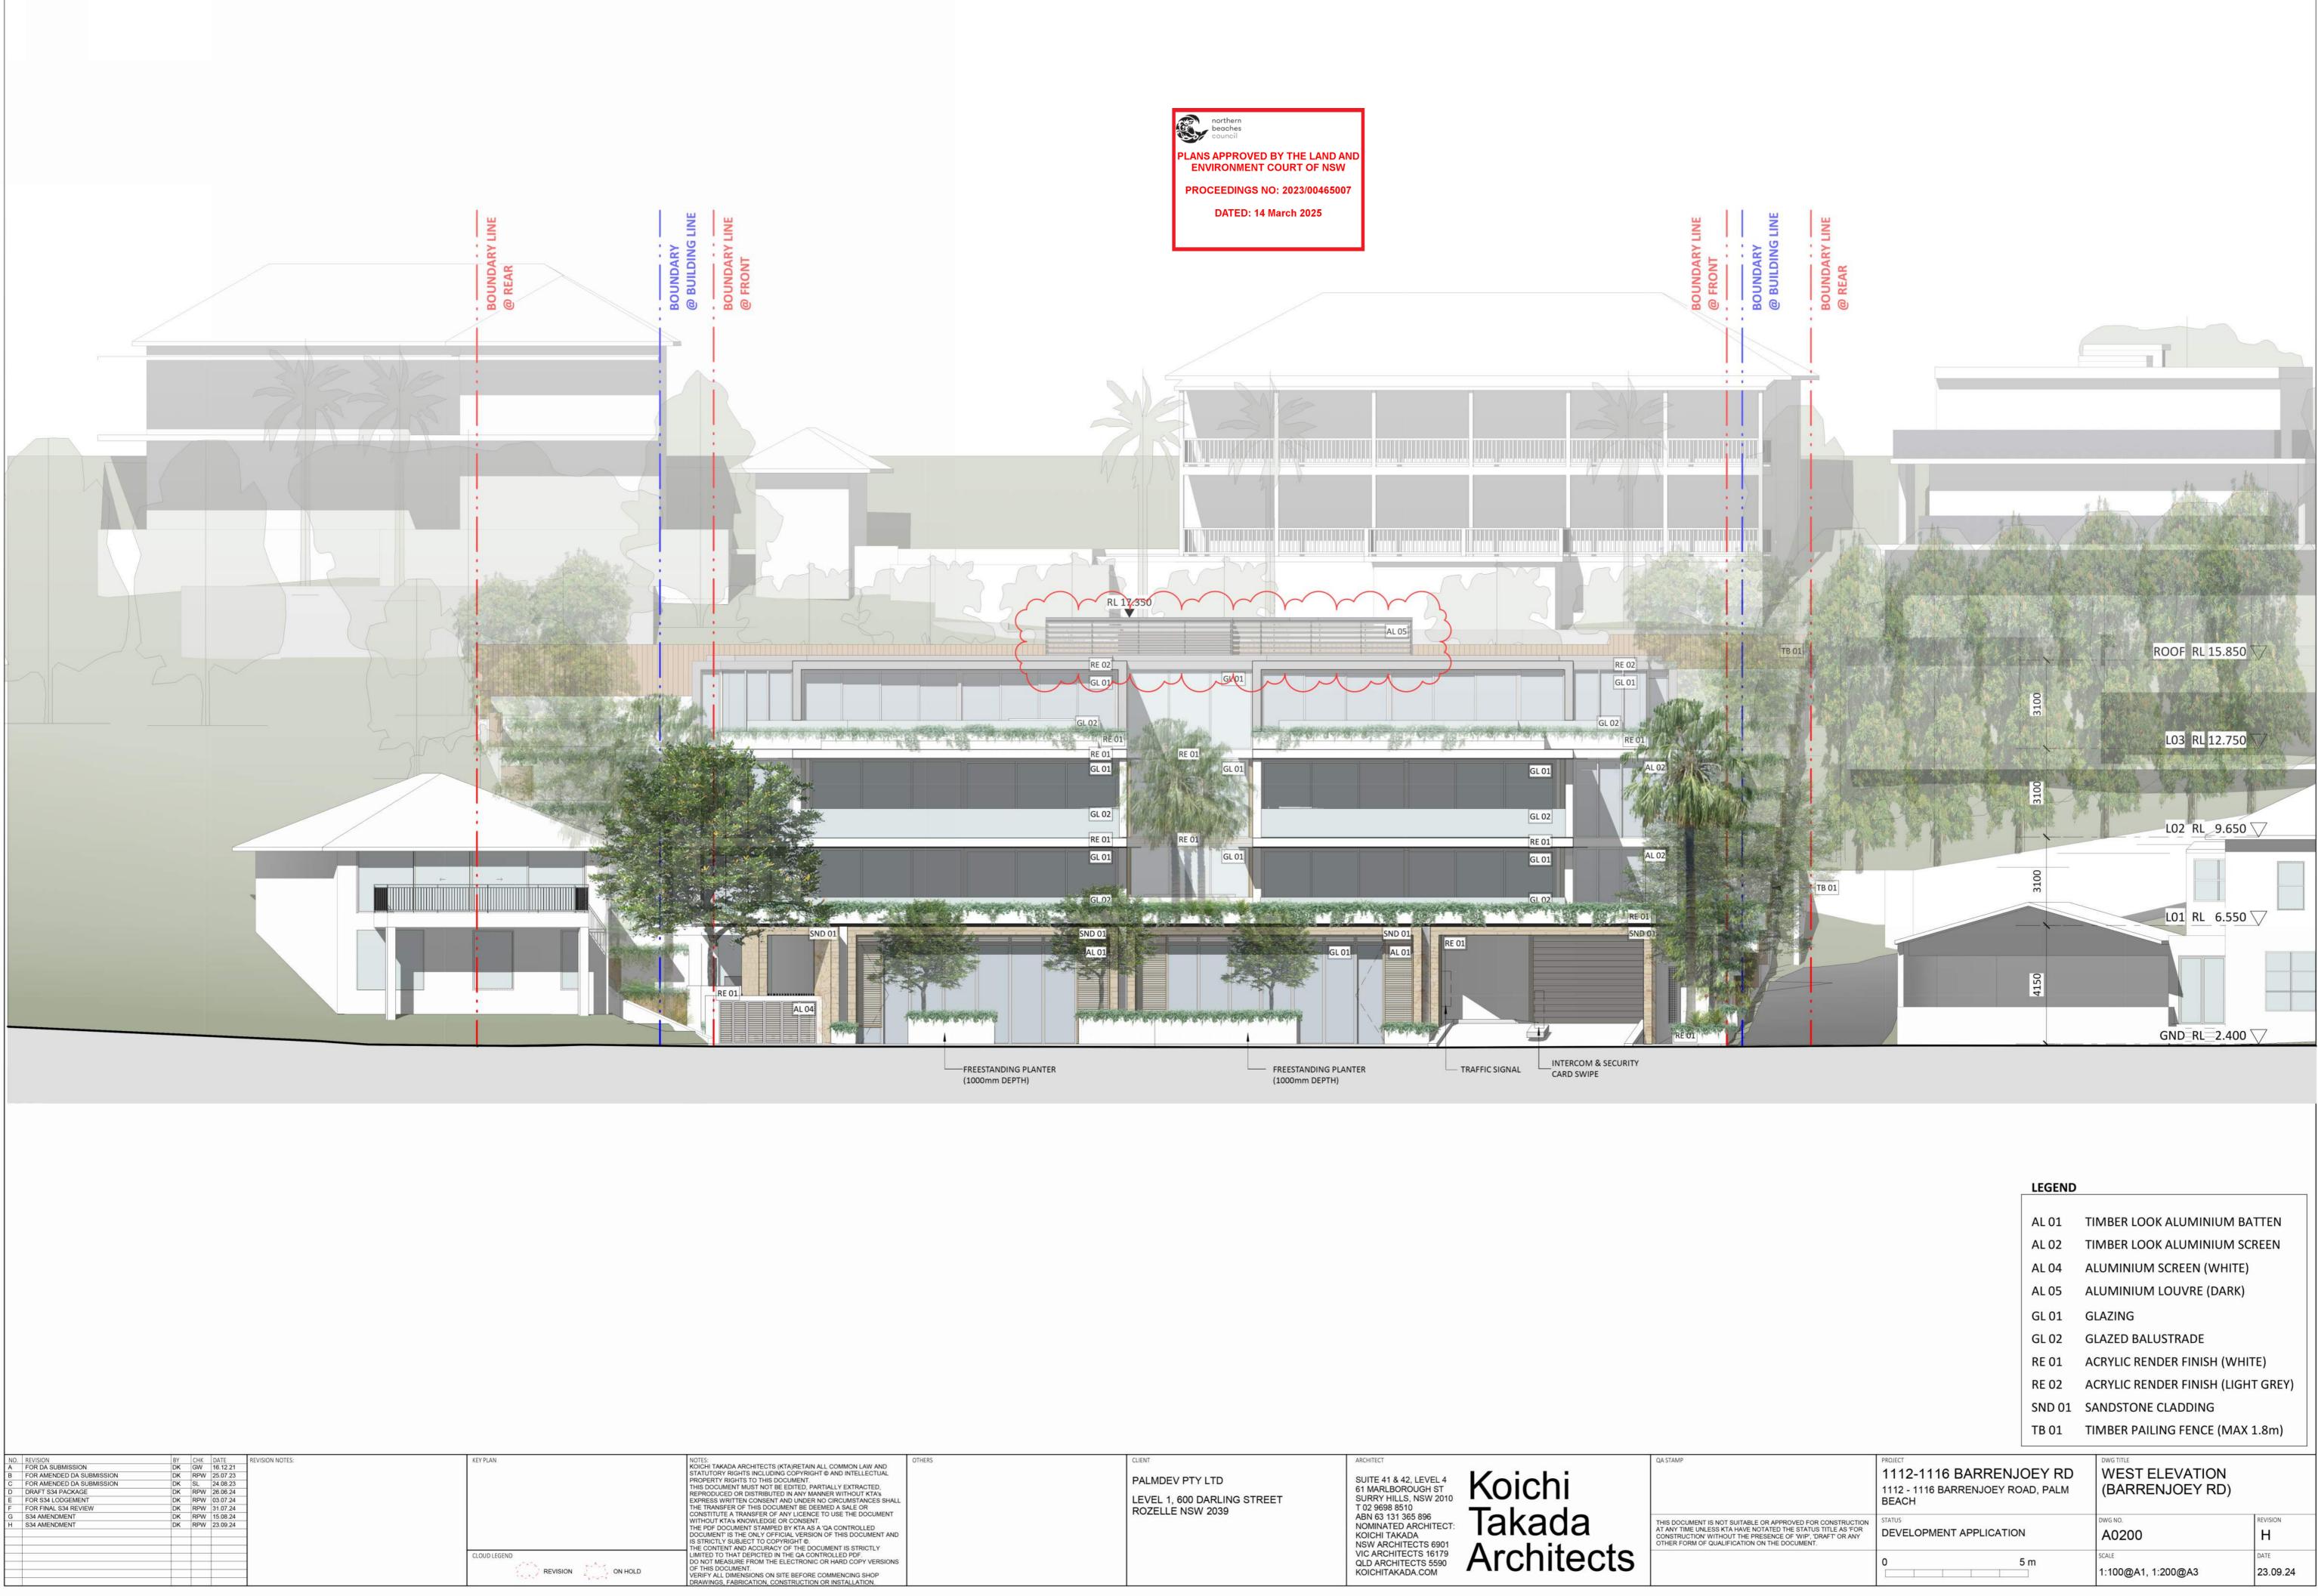


D AL SHALL	OTHERS	CLIENT PALMDEV PTY LTD LEVEL 1, 600 DARLING STREET	ARCHITECT SUITE 41 & 42, LEVEL 4 61 MARLBOROUGH ST SURRY HILLS, NSW 2010	Koichi	QA STAMP
ENT T AND SIONS		ROZELLE NSW 2039	T 02 9698 8510 ABN 63 131 365 896 NOMINATED ARCHITECT: KOICHI TAKADA NSW ARCHITECTS 6901 VIC ARCHITECTS 16179 QLD ARCHITECTS 5590 KOICHITAKADA.COM	Takada Architects	THIS DOCUMENT IS NOT SUITABLE OR APPR AT ANY TIME UNLESS KTA HAVE NOTATED TH CONSTRUCTION' WITHOUT THE PRESENCE O OTHER FORM OF QUALIFICATION ON THE DO

		LEGEND		
		AL 01	TIMBER LOOK ALUMINIUM BA	ATTEN
		AL 02	TIMBER LOOK ALUMINIUM SC	CREEN
		AL 04	ALUMINIUM SCREEN (WHITE)	6 9
		AL 05	ALUMINIUM LOUVRE (DARK)	
		GL 01	GLAZING	
		GL 02	GLAZED BALUSTRADE	
		RE 01	ACRYLIC RENDER FINISH (WHI	TE)
		RE 02	ACRYLIC RENDER FINISH (LIGH	IT GREY)
		SND 01	SANDSTONE CLADDING	
		TB 01	TIMBER PAILING FENCE (MAX	1.8m)
	PROJECT		DWG TITLE	1
	1112-1116 BARRENJ	OEY RD	WEST ELEVATION	
	1112 - 1116 BARRENJOEY RO BEACH		(BARRENJOEY RD)	
FOR CONSTRUCTION	STATUS		DWG NO.	REVISION
IP', 'DRAFT' OR ANY IENT.	DEVELOPMENT APPLICATION	N	A0200	Н
			SCALE	DATE

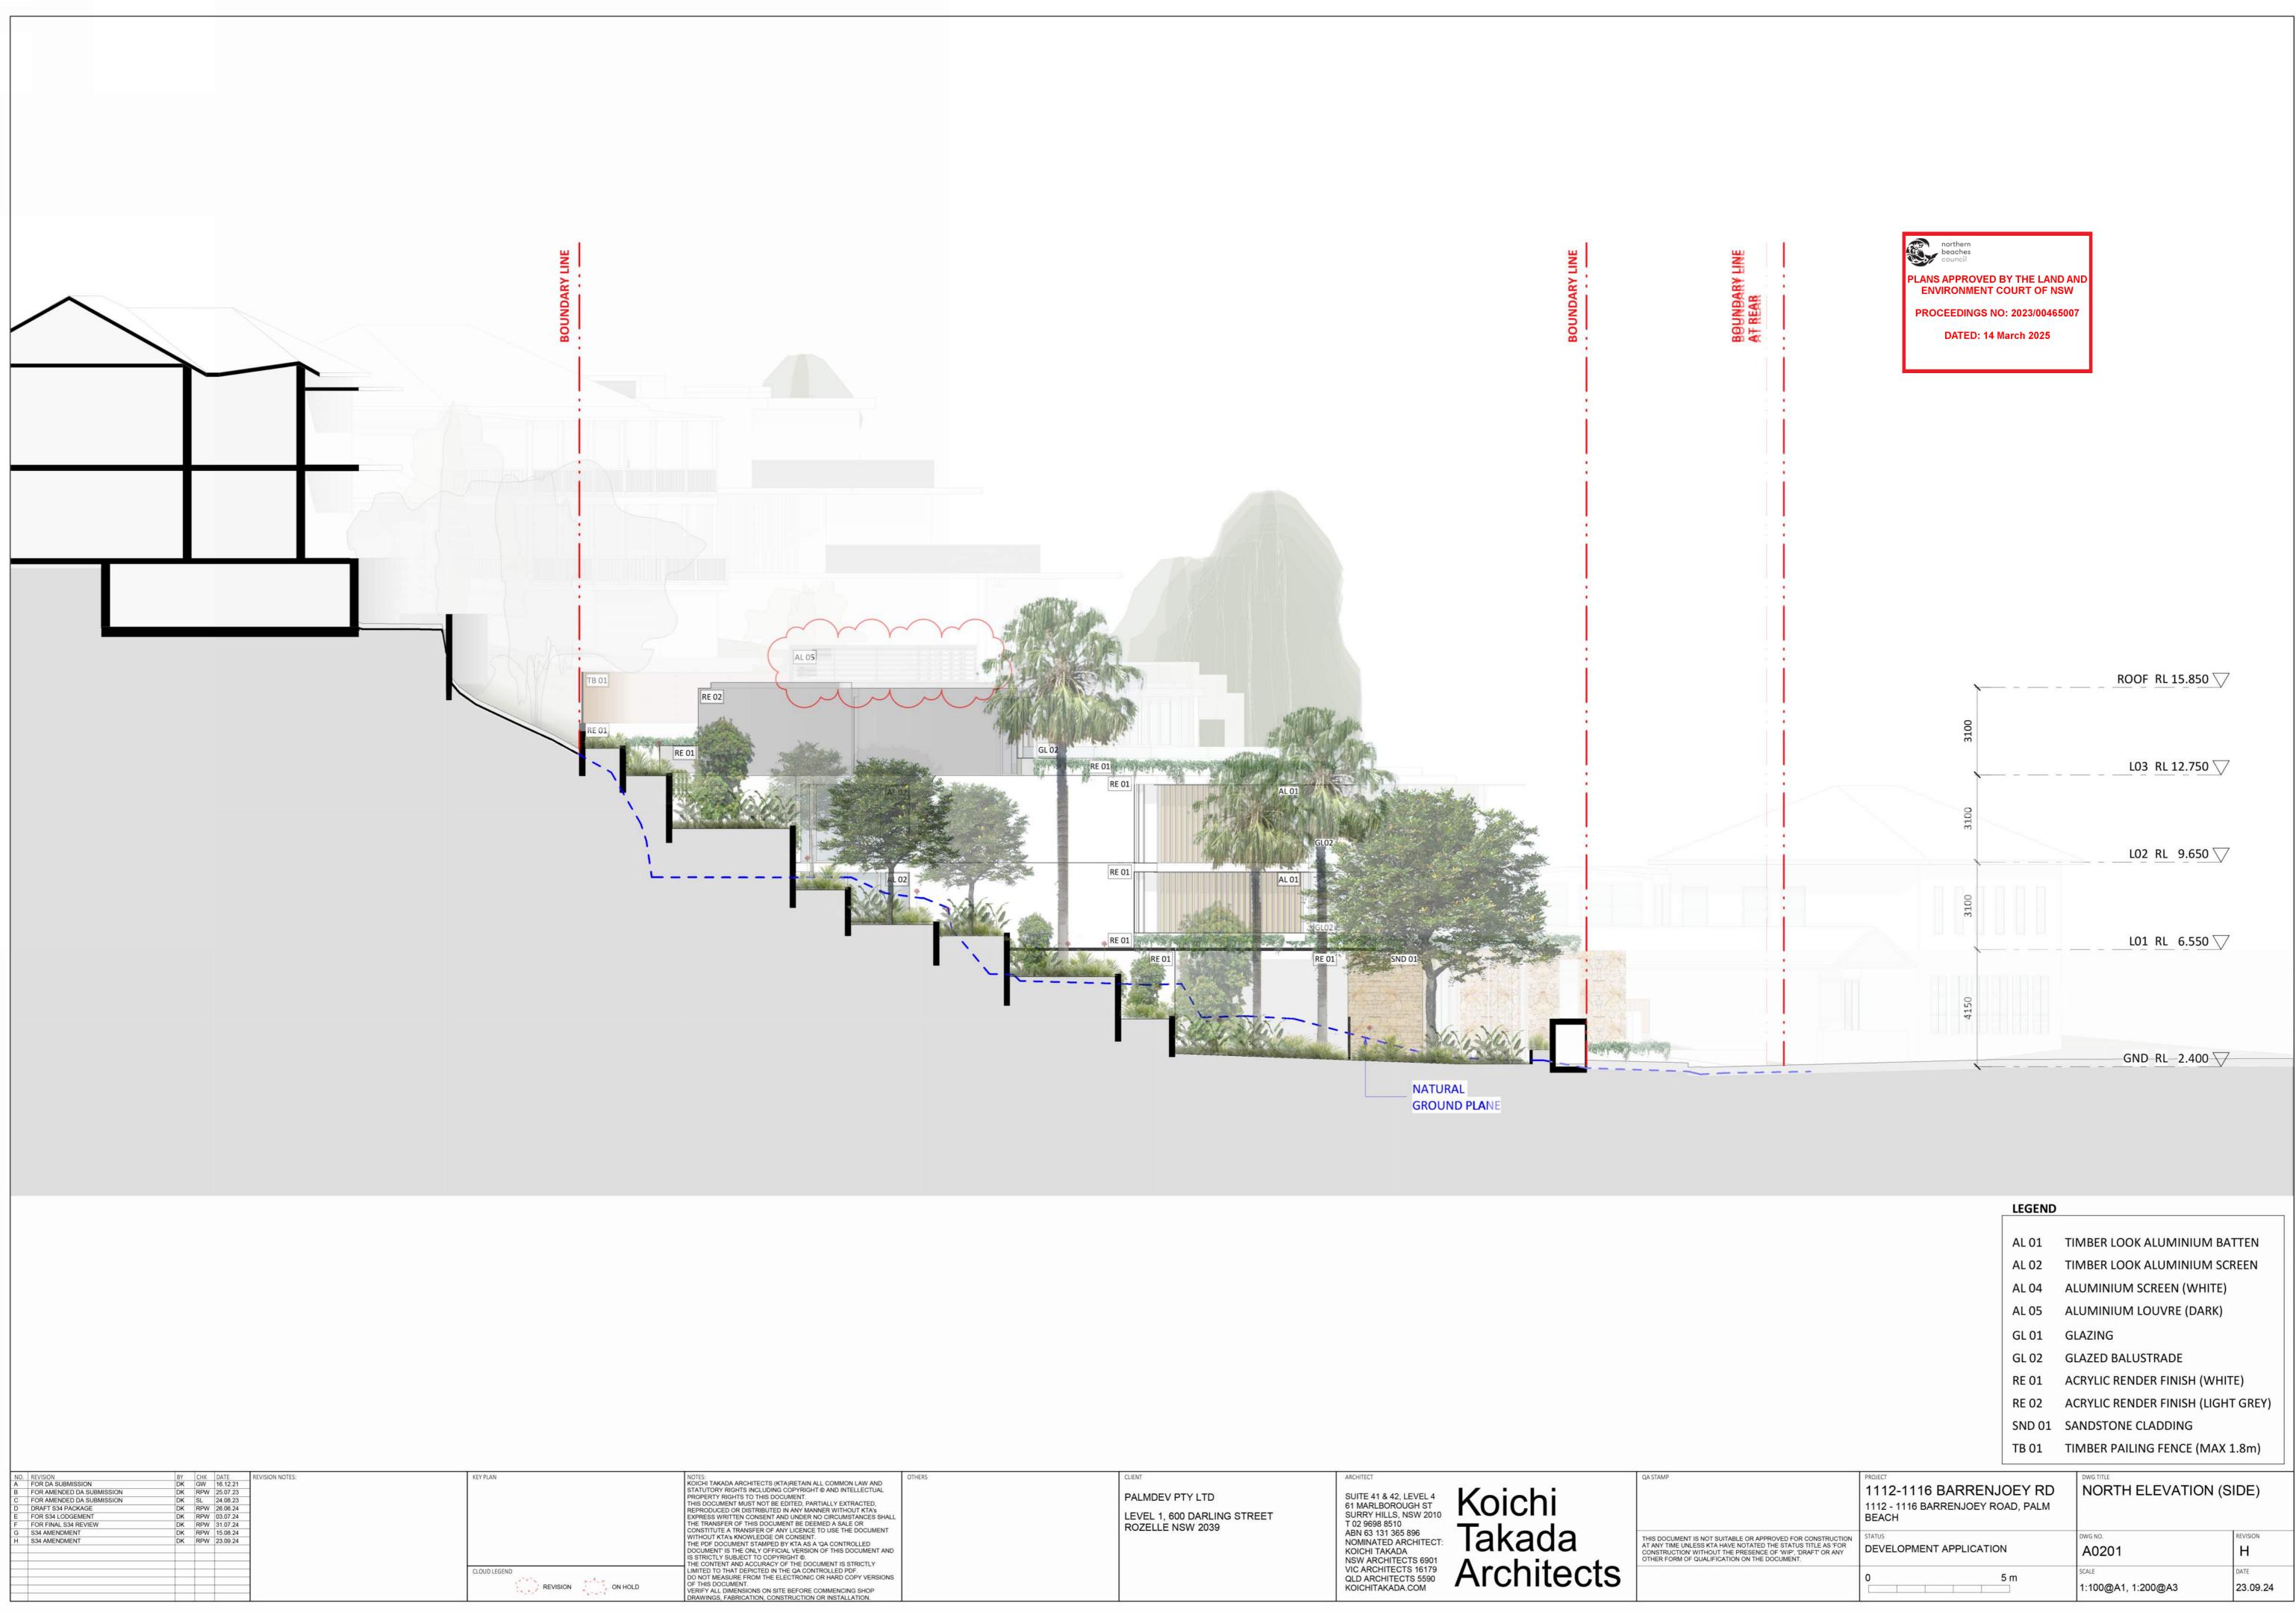

V AND CTUAL	0
TED, TA's CES SHALL	
CUMENT	
D MENT AND	
TLY	
/ERSIONS	
OP	

		LEGEND			1
		AL 01	TIN	MBER LOOK ALUMINIUM BA	TTEN
		AL 02	TIN	ABER LOOK ALUMINIUM SC	REEN
		AL 04	AL	UMINIUM SCREEN (WHITE)	
		AL 05	AL	UMINIUM LOUVRE (DARK)	
		GL 01	GL	AZING	
		GL 02	GL	AZED BALUSTRADE	
		RE 01	AC	RYLIC RENDER FINISH (WHI	ΓE)
		RE 02	AC	RYLIC RENDER FINISH (LIGH	T GREY)
		SND 01	SA	NDSTONE CLADDING	
		TB 01	TIN	MBER PAILING FENCE (MAX	1.8m)
	PROJECT			DWG TITLE	
	1112-1116 BARRENJOEY RD 1112 - 1116 BARRENJOEY ROAD, PALM BEACH			NORTH ELEVATION (S	SIDE)
APPROVED FOR CONSTRUCTION ED THE STATUS TITLE AS 'FOR NCE OF 'WIP', 'DRAFT' OR ANY HE DOCUMENT.	STATUS DEVELOPMENT APPLICATION	N		DWG NO. A0201	
		5 m		scale 1:100@A1, 1:200@A3	DATE 23.09.24

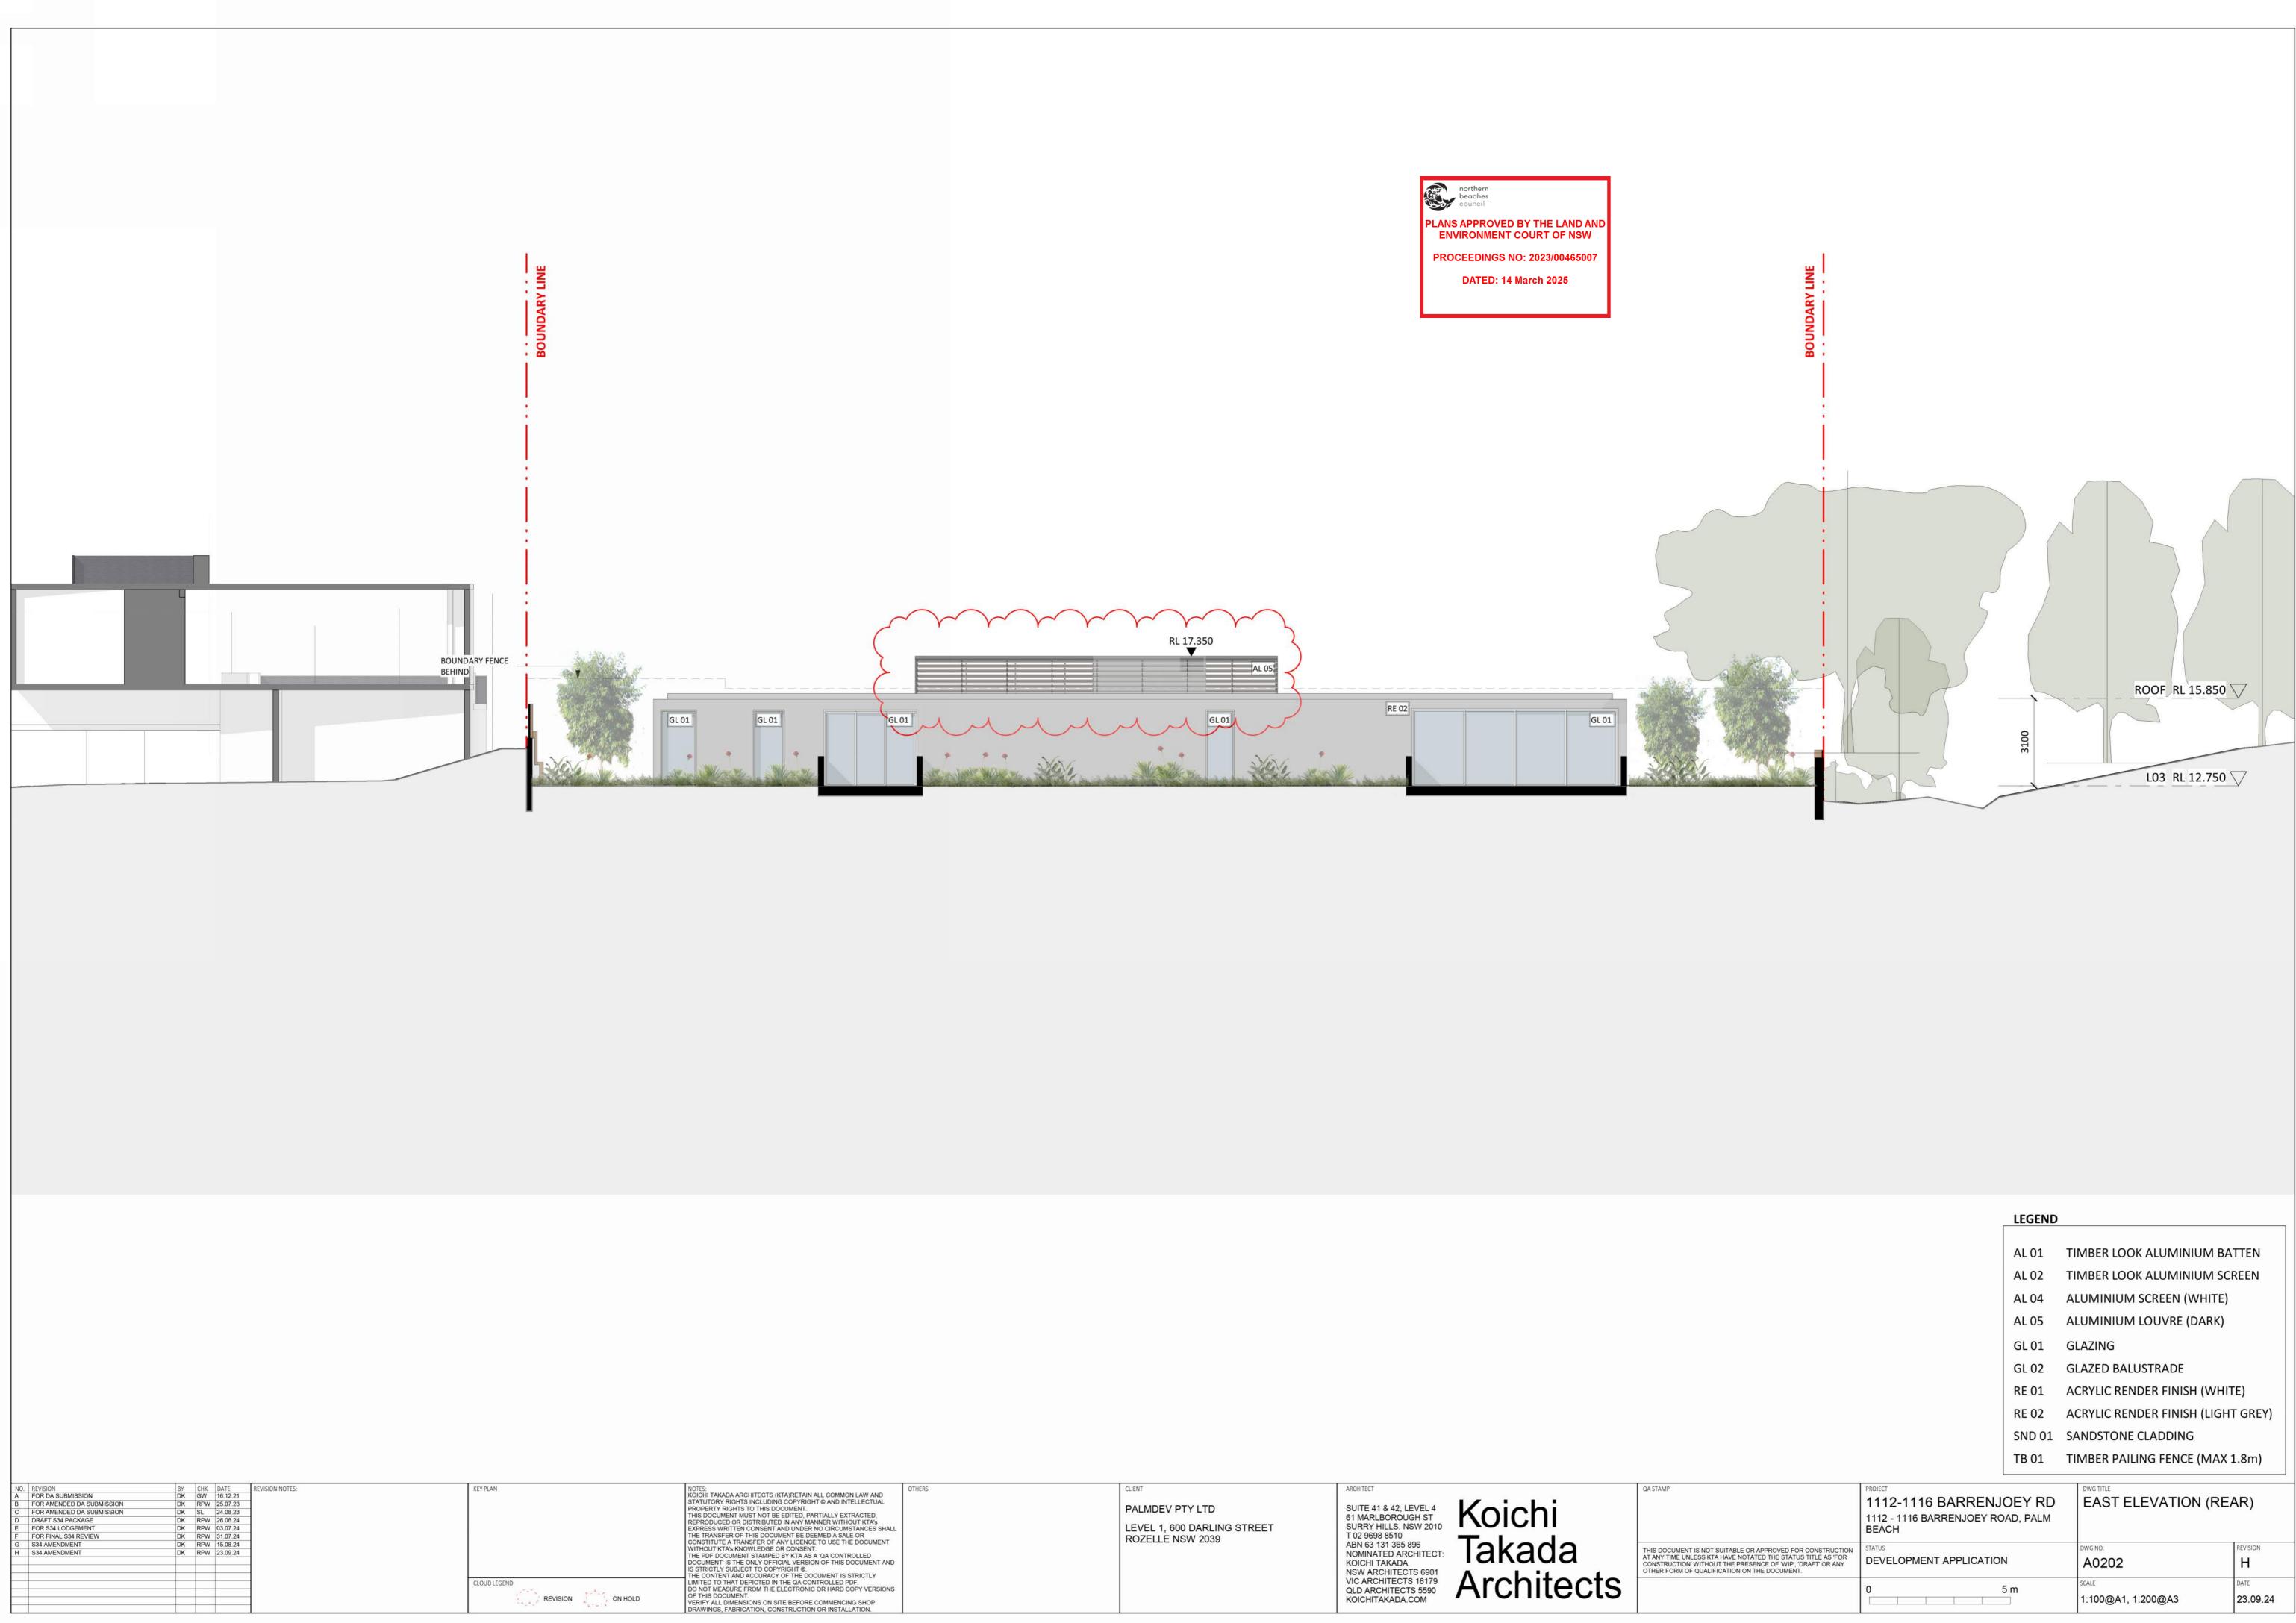




W AND ECTUAL	0
TED, KTA's ICES SHALL	
ED MENT AND	
CTLY	
VERSIONS	

т	HIS DOCUMENT IS NOT SUITABLE OR A
A	T ANY TIME UNLESS KTA HAVE NOTATE
C	ONSTRUCTION' WITHOUT THE PRESEN
0	THER FORM OF QUALIFICATION ON THI

	LEGEND	
	AL 01	TIMBER LOOK ALUMINIUM BATTEN
	AL 02	TIMBER LOOK ALUMINIUM SCREEN
	AL 04	ALUMINIUM SCREEN (WHITE)
	AL 05	ALUMINIUM LOUVRE (DARK)
	GL 01	GLAZING
	GL 02	GLAZED BALUSTRADE
	RE 01	ACRYLIC RENDER FINISH (WHITE)
	RE 02	ACRYLIC RENDER FINISH (LIGHT GREY)
	SND 01	SANDSTONE CLADDING
	TB 01	TIMBER PAILING FENCE (MAX 1.8m)
4		DWG TITLE
		Dwo mee

	PROJECT 1112-1116 BARRENJOEY RD 1112 - 1116 BARRENJOEY ROAD, PALM BEACH	EAST ELEVATION (REAR)	
APPROVED FOR CONSTRUCTION THE STATUS TITLE AS 'FOR NCE OF 'WIP', 'DRAFT' OR ANY HE DOCUMENT.	STATUS DEVELOPMENT APPLICATION	DWG NO. A0202	REVISION H
	0 5 m	scale 1:100@A1, 1:200@A3	DATE 23.09.24

		BOUNDARY LINE AT REAR	BOUNDARY LINE
✓ 15.850 RL ROOF ✓ 12.750 RL L03	3100		
∑ 9.650 RL LO2 ∑ 6.550 RL LO1	3100		GL 02
<u>2.400_RL_GND</u>	4150		SND 01 NATURAL GROUND PLANE
NO. REVISION BY CHK A FOR DA SUBMISSION DK GW B FOR AMENDED DA SUBMISSION DK RPW C FOR AMENDED DA SUBMISSION DK SL D DRAFT S34 PACKAGE DK RPW E FOR S34 LODGEMENT DK RPW F FOR FINAL S34 REVIEW DK RPW G S34 AMENDMENT DK RPW H S34 AMENDMENT DK RPW	16.12.21 25.07.23 24.08.23 26.06.24 03.07.24 31.07.24 15.08.24	KEY PLAN	NOTES: KOICHI TAKADA ARCHITECTS (KTA)RETAIN ALL COMMON LAW AND STATUTORY RIGHTS INCLUDING COPYRIGHT © AND INTELLECTUAL PROPERTY RIGHTS TO THIS DOCUMENT. THIS DOCUMENT MUST NOT BE EDITED, PARTIALLY EXTRACTED, REPRODUCED OR DISTRIBUTED IN ANY MANNER WITHOUT KTA'S EXPRESS WRITTEN CONSENT AND UNDER NO CIRCUMSTANCES SHALL THE TRANSFER OF THIS DOCUMENT BE DETED A SALE OR CONSTITUTE A TRANSFER OF ANY LICENCE TO USE THE DOCUMENT WITHOUT KTA'S KNOWLEDGE OR CONSENT. THE PDF DOCUMENT STAMPED BY KTA AS A 'OA CONTROLLED DOCUMENT' IS THE ONLY OFFICIAL VERSION OF THIS DOCUMENT AND
		CLOUD LEGEND REVISION ON HOLD	IS STRICTLY SUBJECT TO COPYRIGHT ©. THE CONTENT AND ACCURACY OF THE DOCUMENT IS STRICTLY LIMITED TO THAT DEPICTED IN THE QA CONTROLLED PDF. DO NOT MEASURE FROM THE ELECTRONIC OR HARD COPY VERSIONS OF THIS DOCUMENT. VERIFY ALL DIMENSIONS ON SITE BEFORE COMMENCING SHOP DOM/DIMENSIONS ON SITE BEFORE COMMENCING SHOP

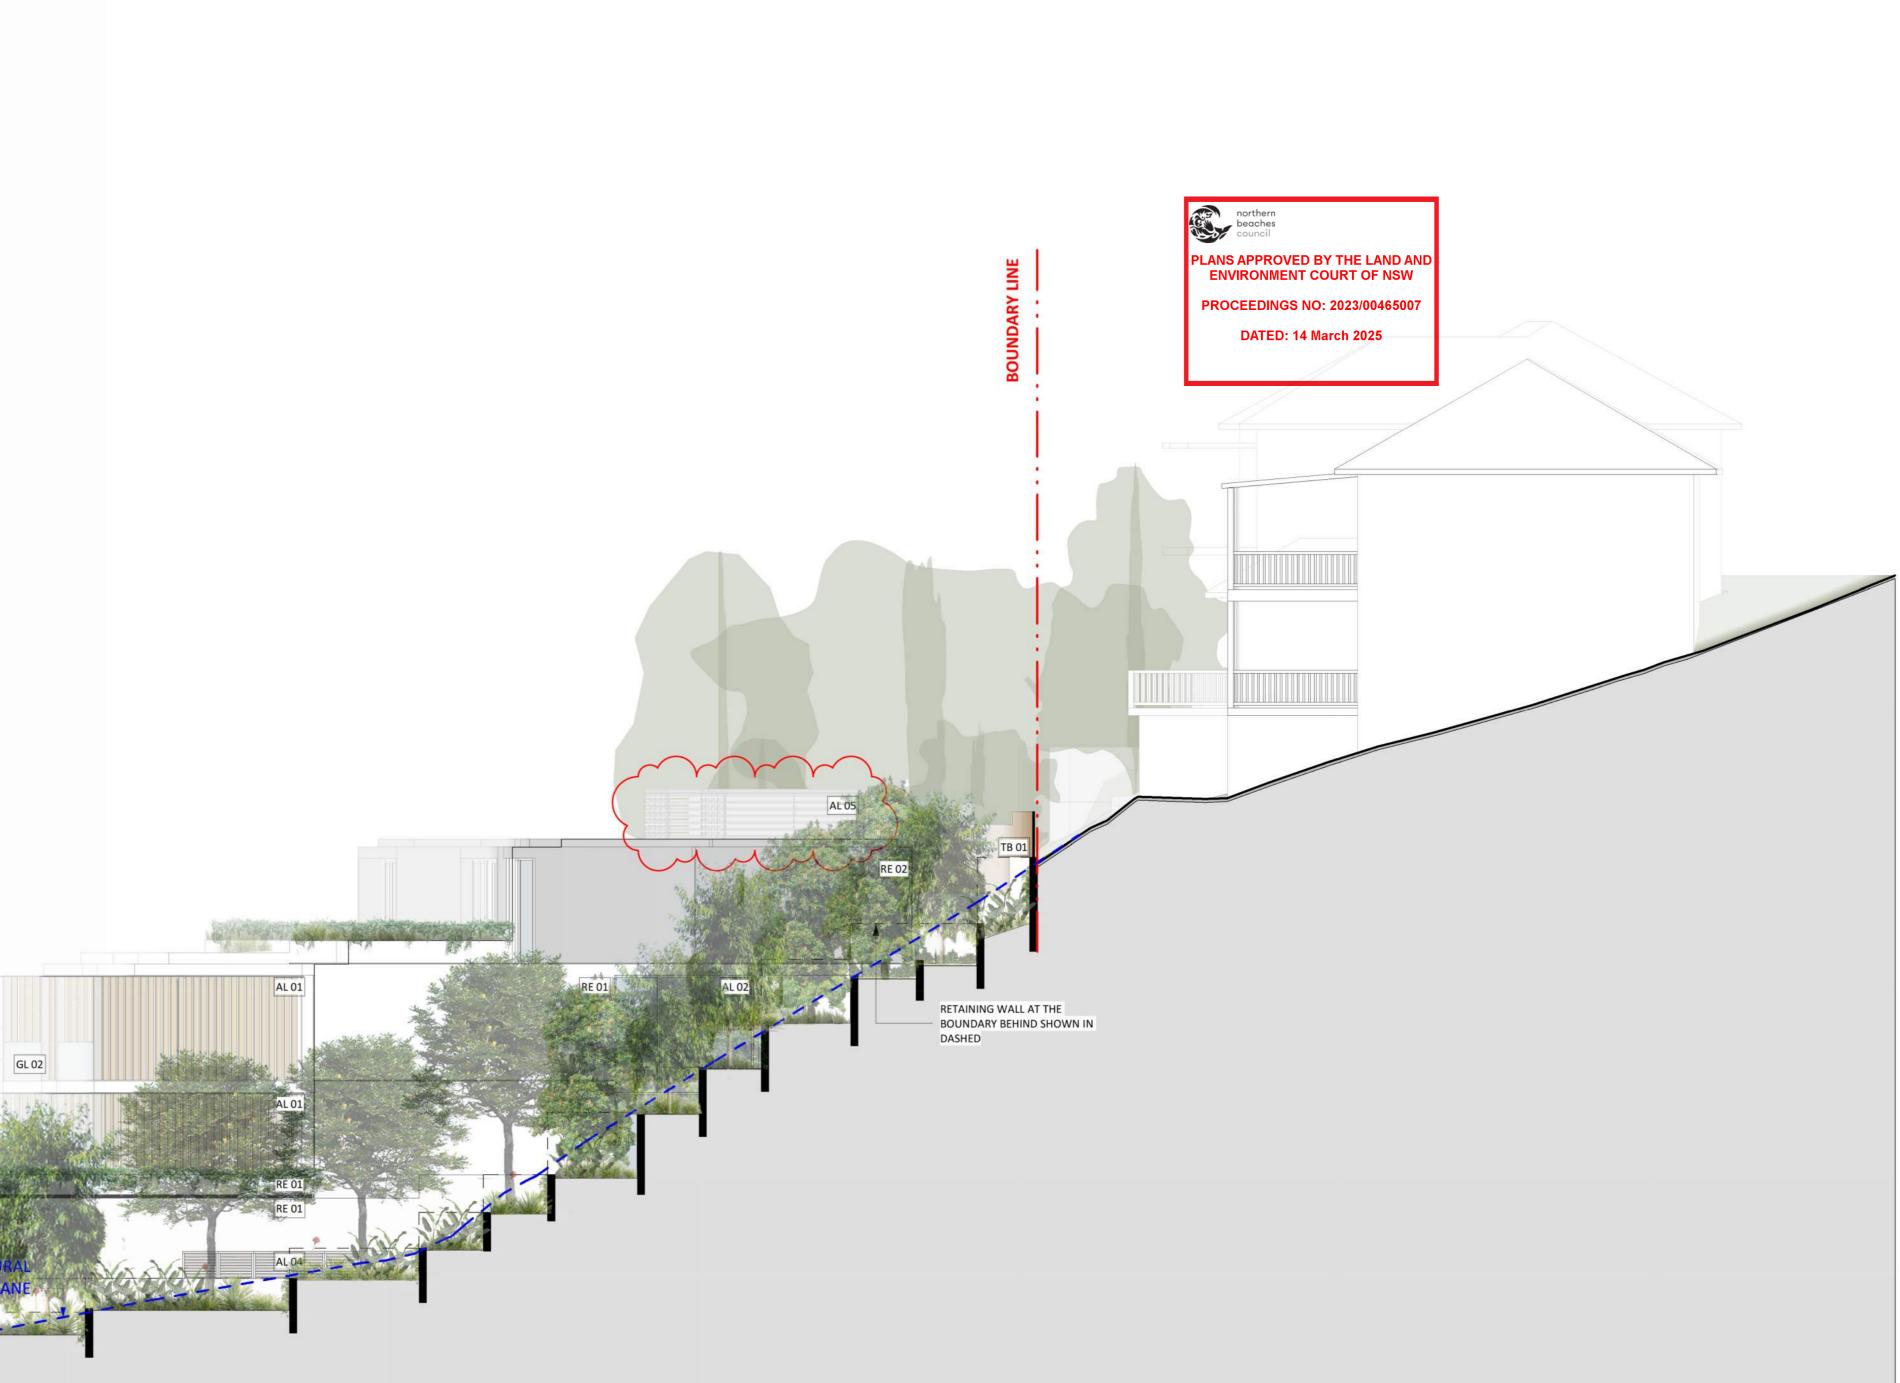

PALMDEV PTY LTD LEVEL 1, 600 DARLING STREET ROZELLE NSW 2039

CLIENT




SUITE 41 & 42, LEVEL 4 61 MARLBOROUGH ST SURRY HILLS, NSW 2010 T 02 9698 8510 ABN 63 131 365 896 NOMINATED ARCHITECT: KOICHI TAKADA NSW ARCHITECTS 6901 VIC ARCHITECTS 16179 QLD ARCHITECTS 5590 KOICHITAKADA.COM


THIS DOCUMENT IS NOT SUITABLE OR AP
AT ANY TIME UNLESS KTA HAVE NOTATED
CONSTRUCTION' WITHOUT THE PRESENCE
OTHER FORM OF QUALIFICATION ON THE

QA STAMP


		LEGEND		
		AL 01	TIMBER LOOK ALUMINIUM BAT	IEN
		AL 02	TIMBER LOOK ALUMINIUM SCR	EEN
		AL 04	ALUMINIUM SCREEN (WHITE)	
		AL 05	ALUMINIUM LOUVRE (DARK)	
		GL 01	GLAZING	
		GL 02	GLAZED BALUSTRADE	
		RE 01	ACRYLIC RENDER FINISH (WHITE)
		RE 02	ACRYLIC RENDER FINISH (LIGHT	GREY)
		SND 01	SANDSTONE CLADDING	
		TB 01	TIMBER PAILING FENCE (MAX 1.	8m)
	PROJECT 1112-1116 BARRENJOEY RD 1112 - 1116 BARRENJOEY ROAD, PALM BEACH		SOUTH ELEVATION (SIE	DE)
ROVED FOR CONSTRUCTION THE STATUS TITLE AS 'FOR E OF 'WIP', 'DRAFT' OR ANY DOCUMENT.	STATUS DEVELOPMENT APPLICATION	1		evision
	0	5 m	1797-5303 C.X	ate 3.09.24

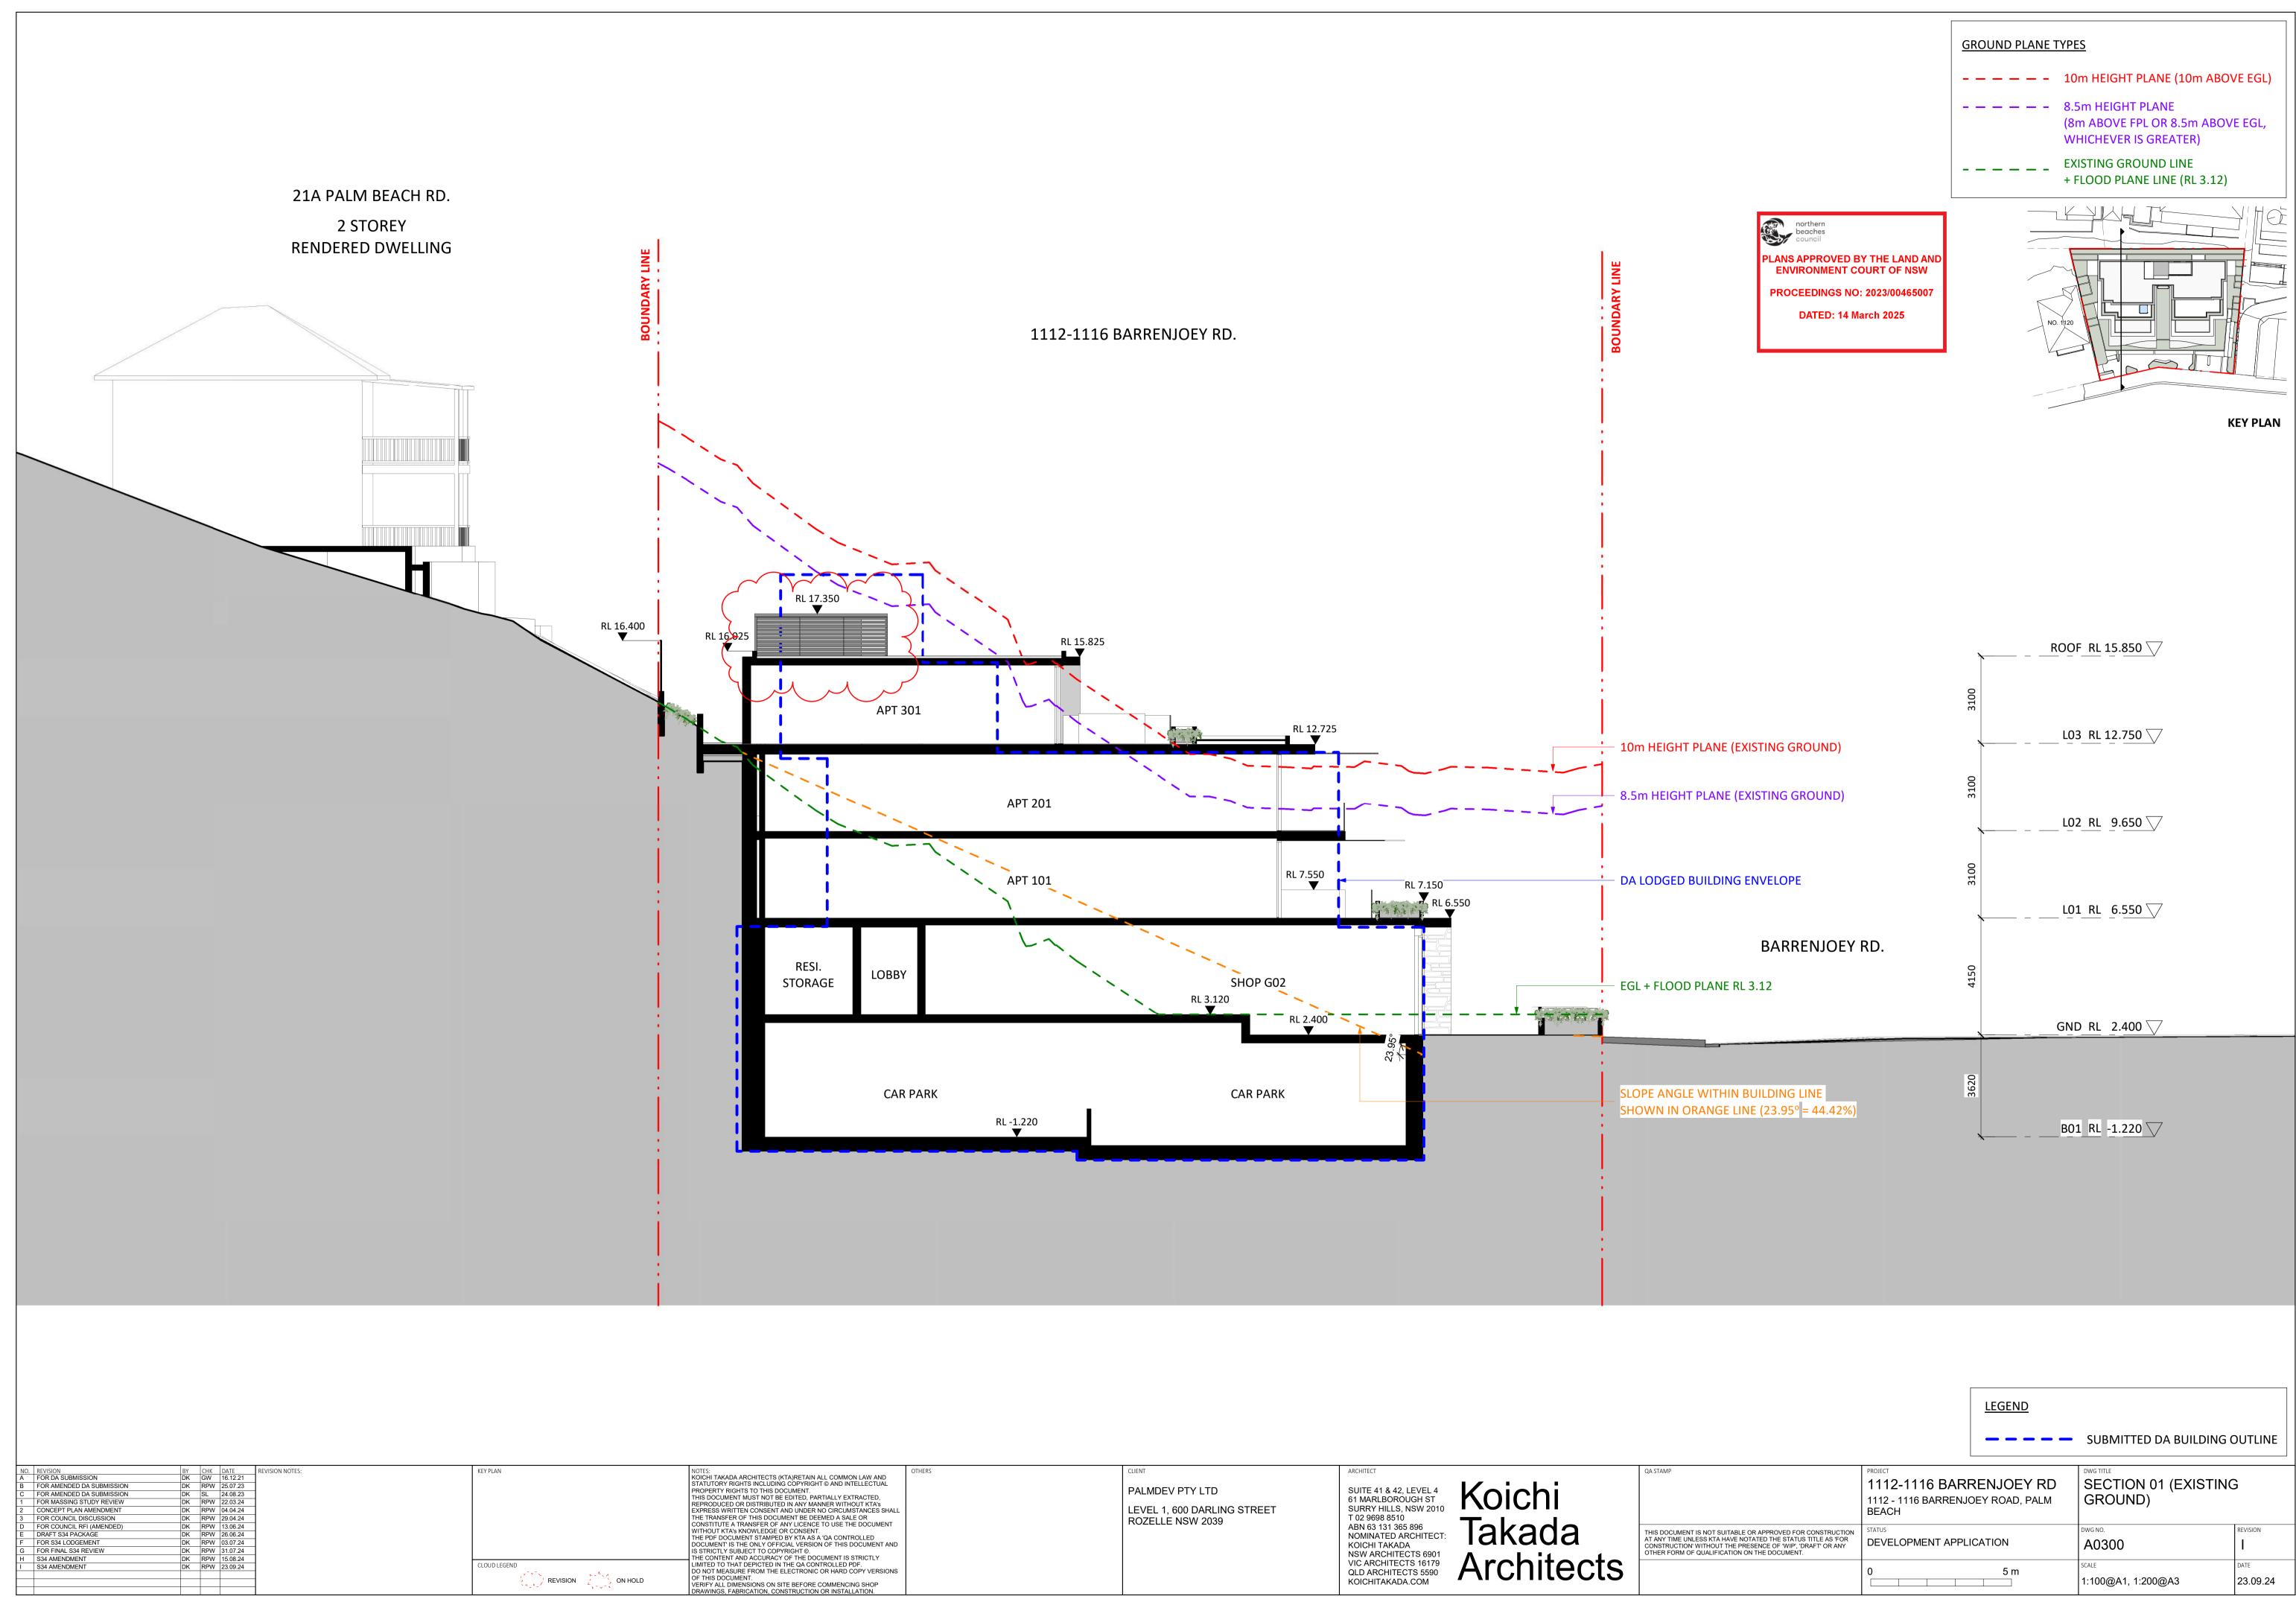


PALMDEV PTY LTD PALMDEV PTY LTD LEVEL 1, 600 DARLING STREET NT AND Y PALMDEV PTY LTD LEVEL 1, 600 DARLING STREET NOZELLE NSW 2039 VITE 41 & 42, LEVEL 4 61 MARLBOROUGH ST SURRY HILLS, NSW 2010 T 02 9698 8510 ABN 63 131 365 896 NOMINATED ARCHITECT: KOICHI TAKADA NSW ARCHITECTS 16179 VIC ARCHITECTS 16179 VIC ARCHITECTS 16179					
	AND TUAL D, XS SS SHALL IMENT INT AND Y RSIONS P	OTHERS	PALMDEV PTY LTD LEVEL 1, 600 DARLING STREET	suite 41 & 42, level 4 61 Marlborough st surry Hills, NSW 2010 t 02 9698 8510 ABN 63 131 365 896 Nominated architect: Koichi takada NSW Architects 6901 Vic Architects 16179 QLD Architects 5590	THIS DOCUMENT IS NOT SUITABLE OR API AT ANY TIME UNLESS KTA HAVE NOTATED CONSTRUCTION' WITHOUT THE PRESENC

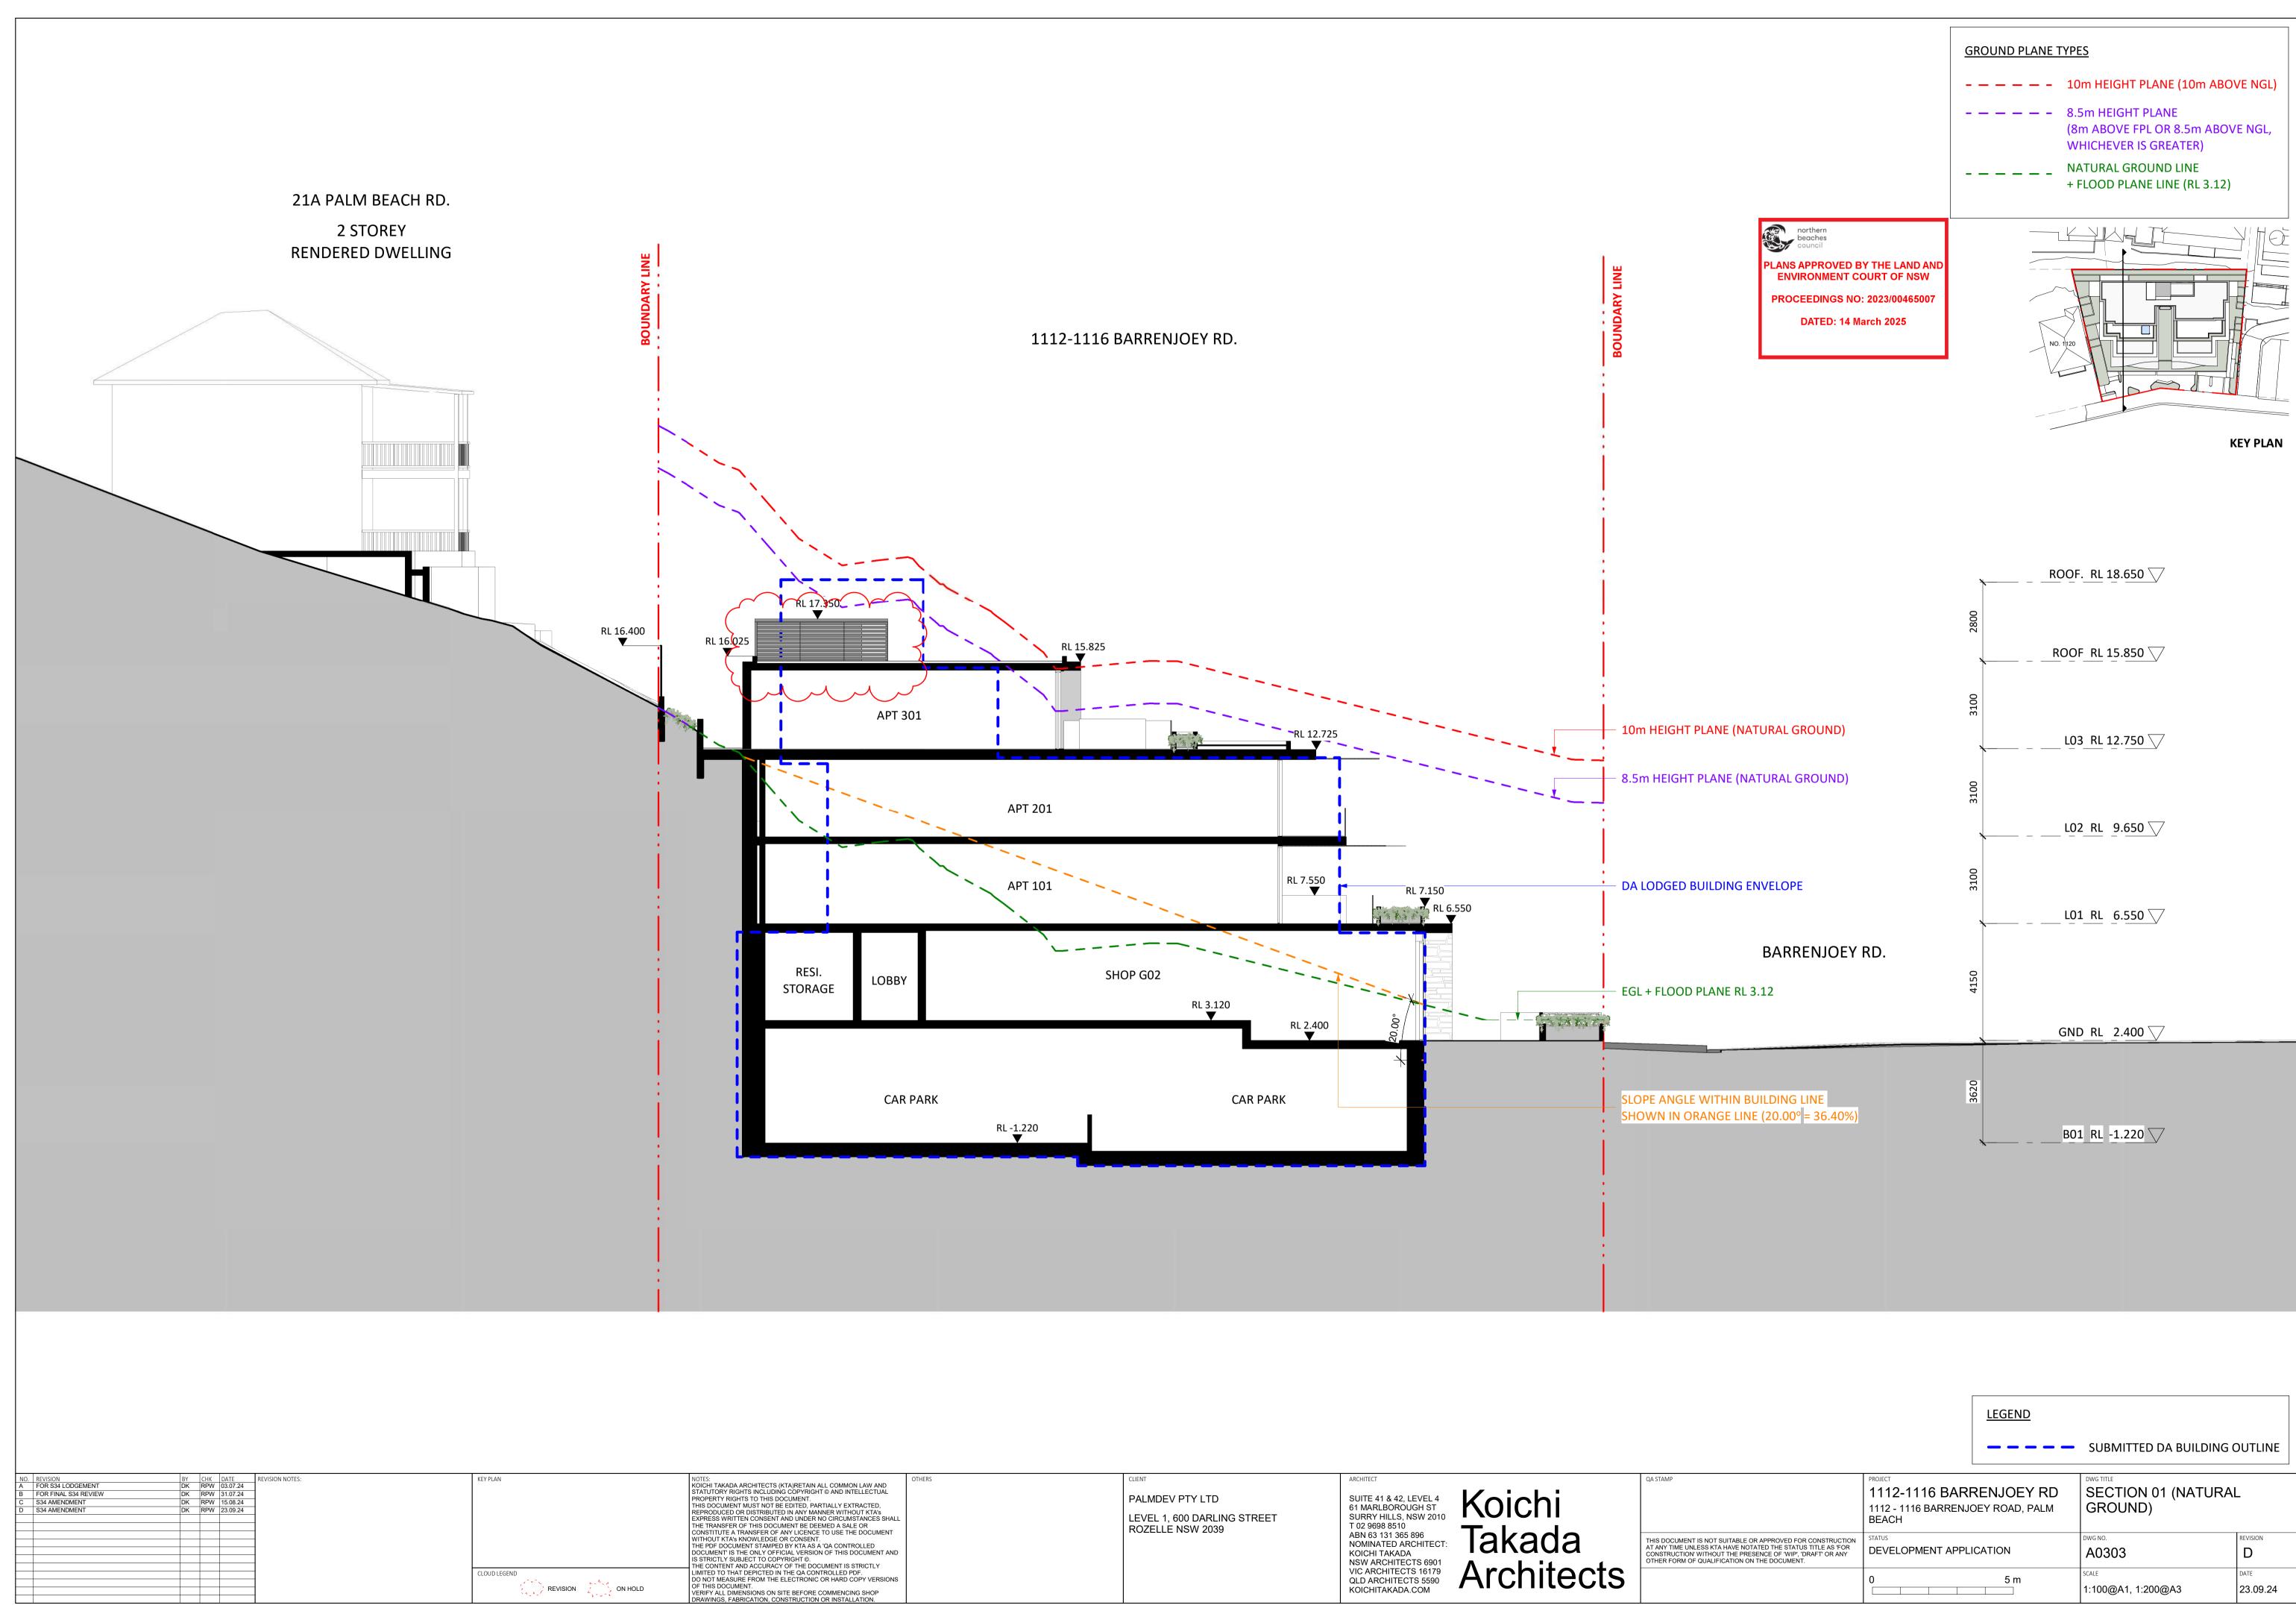


							SUBMITTED DA BUILDING	3 OUTLINE
AND CTUAL ED, FA's ES SHALL UMENT	OTHERS	CLIENT PALMDEV PTY LTD LEVEL 1, 600 DARLING STREET ROZELLE NSW 2039	ARCHITECT SUITE 41 & 42, LEVEL 4 61 MARLBOROUGH ST SURRY HILLS, NSW 2010 T 02 9698 8510	QA STAMP	PROJECT 1112-1116 BARF 1112 - 1116 BARRENJO BEACH		SECTION 01 (NATURA	AL
D ENT AND			ABN 63 131 365 896 NOMINATED ARCHITECT: KOICHI TAKADA NSW ARCHITECTS 6901	THIS DOCUMENT IS NOT SUITABLE OR APPROVED FOR CONSTRUCTION AT ANY TIME UNLESS KTA HAVE NOTATED THE STATUS TITLE AS 'FOR CONSTRUCTION' WITHOUT THE PRESENCE OF 'WIP', 'DRAFT' OR ANY OTHER FORM OF QUALIFICATION ON THE DOCUMENT.	DEVELOPMENT APPLI	ICATION	dwg no. A0303	REVISION D
ERSIONS DP I.			NSW ARCHITECTS 6901 VIC ARCHITECTS 16179 QLD ARCHITECTS 5590 KOICHITAKADA.COM	5	0	5 m	scale 1:100@A1, 1:200@A3	DATE 23.09.24

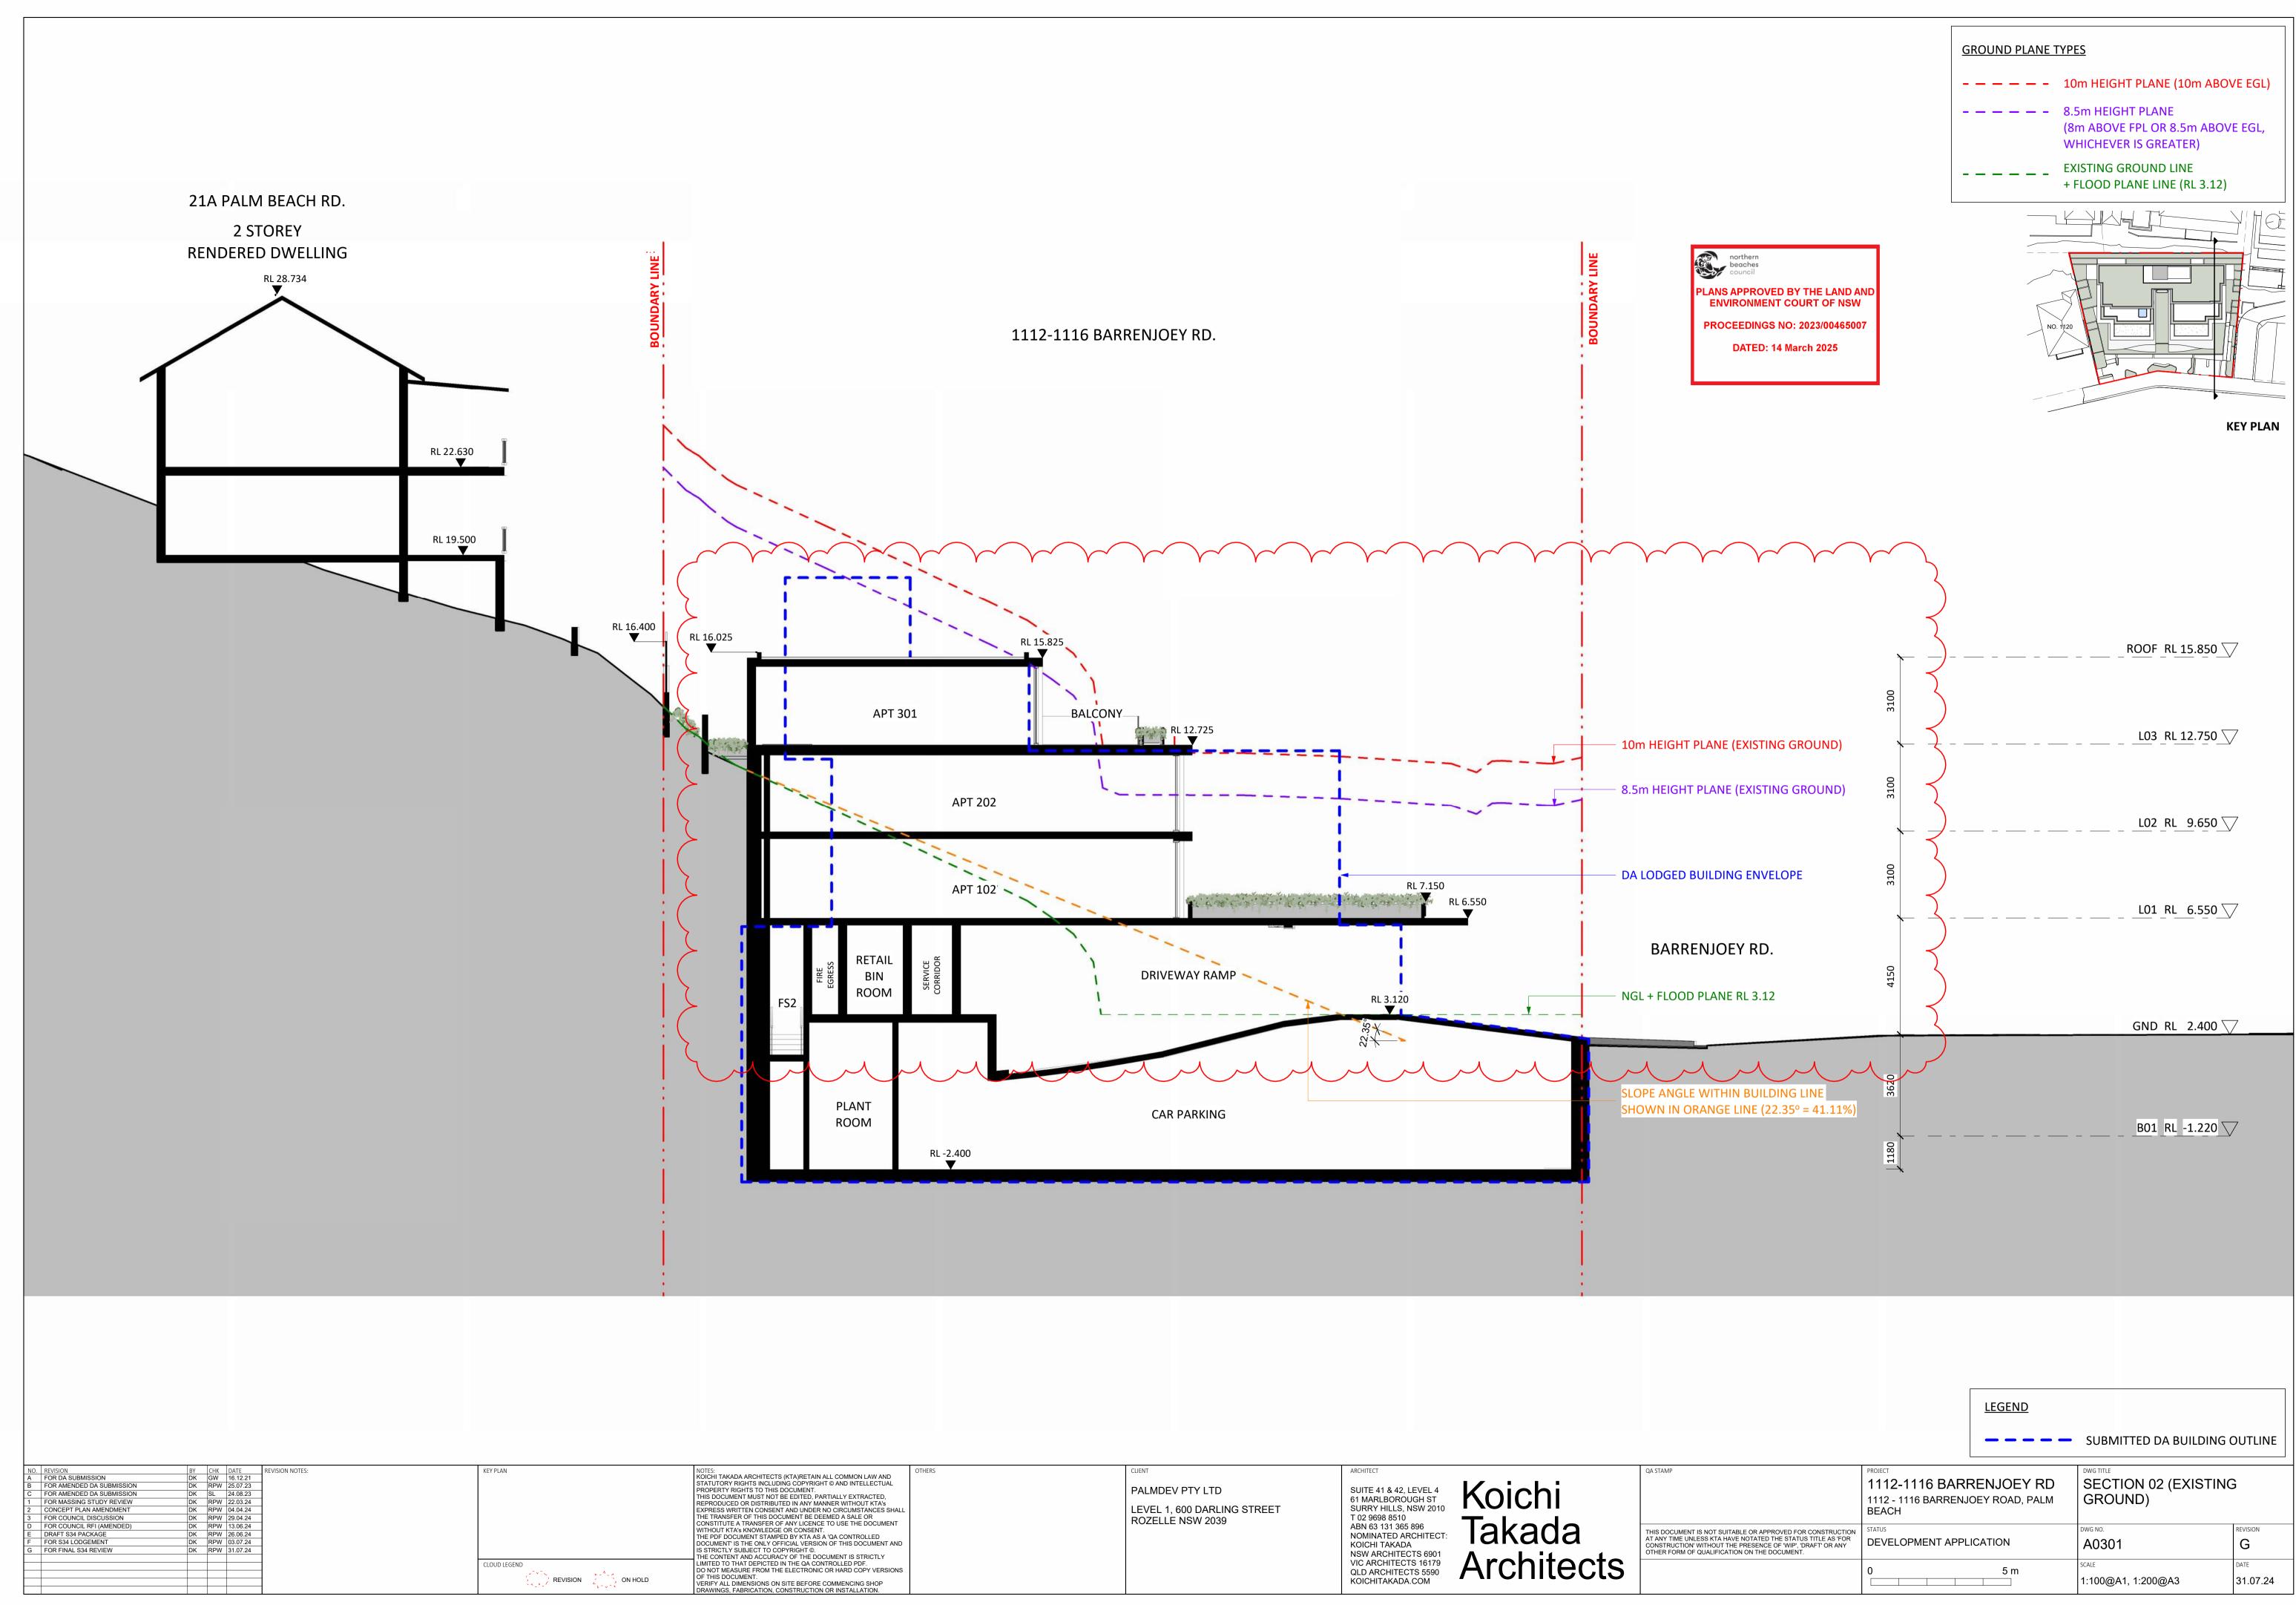


	OTHERS	CLIENT	ARCHITECT	QA STAMP
ND UAL D, S SHALL MENT NT AND Y RSIONS	UITEKS	PALMDEV PTY LTD LEVEL 1, 600 DARLING STREET ROZELLE NSW 2039	SUITE 41 & 42, LEVEL 4 61 MARLBOROUGH ST SURRY HILLS, NSW 2010 T 02 9698 8510 ABN 63 131 365 896 NOMINATED ARCHITECT: KOICHI TAKADA NSW ARCHITECTS 6901 VIC ARCHITECTS 16179 QLD ARCHITECTS 5590 KOICHITAKADA.COM	THIS DOCUMENT IS NOT SUITABLE OR APP AT ANY TIME UNLESS KTA HAVE NOTATED CONSTRUCTION' WITHOUT THE PRESENCE

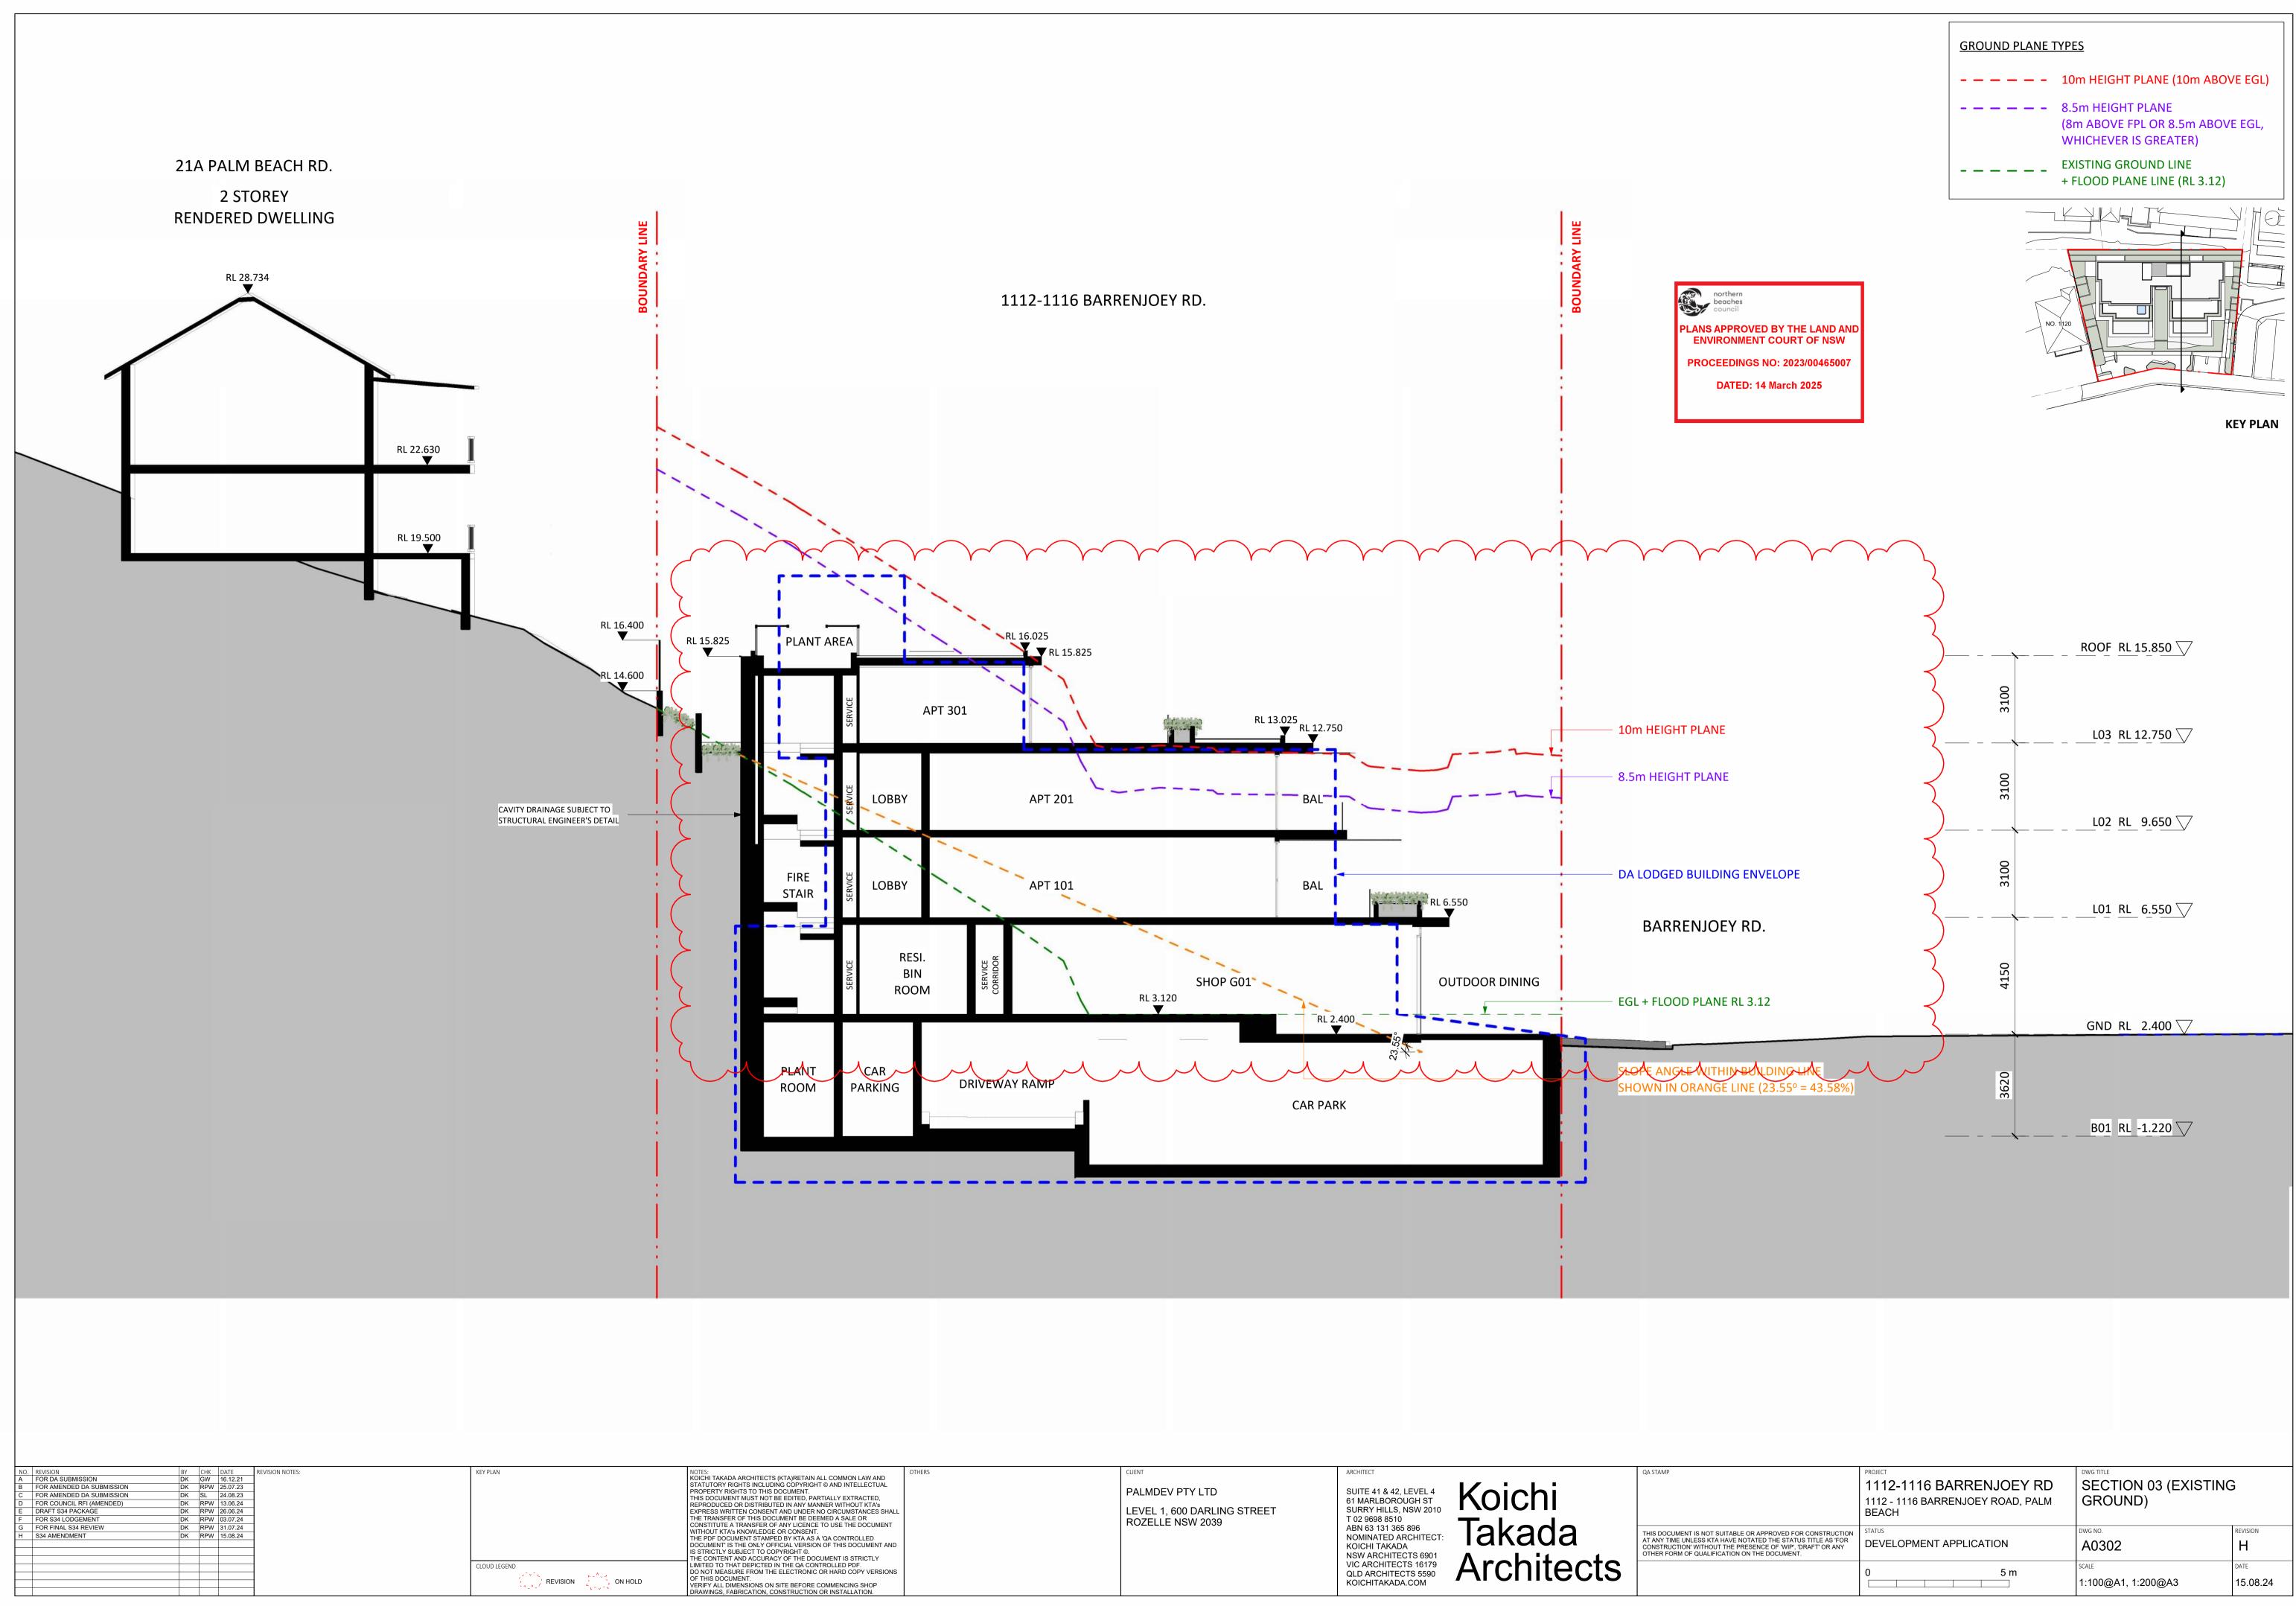


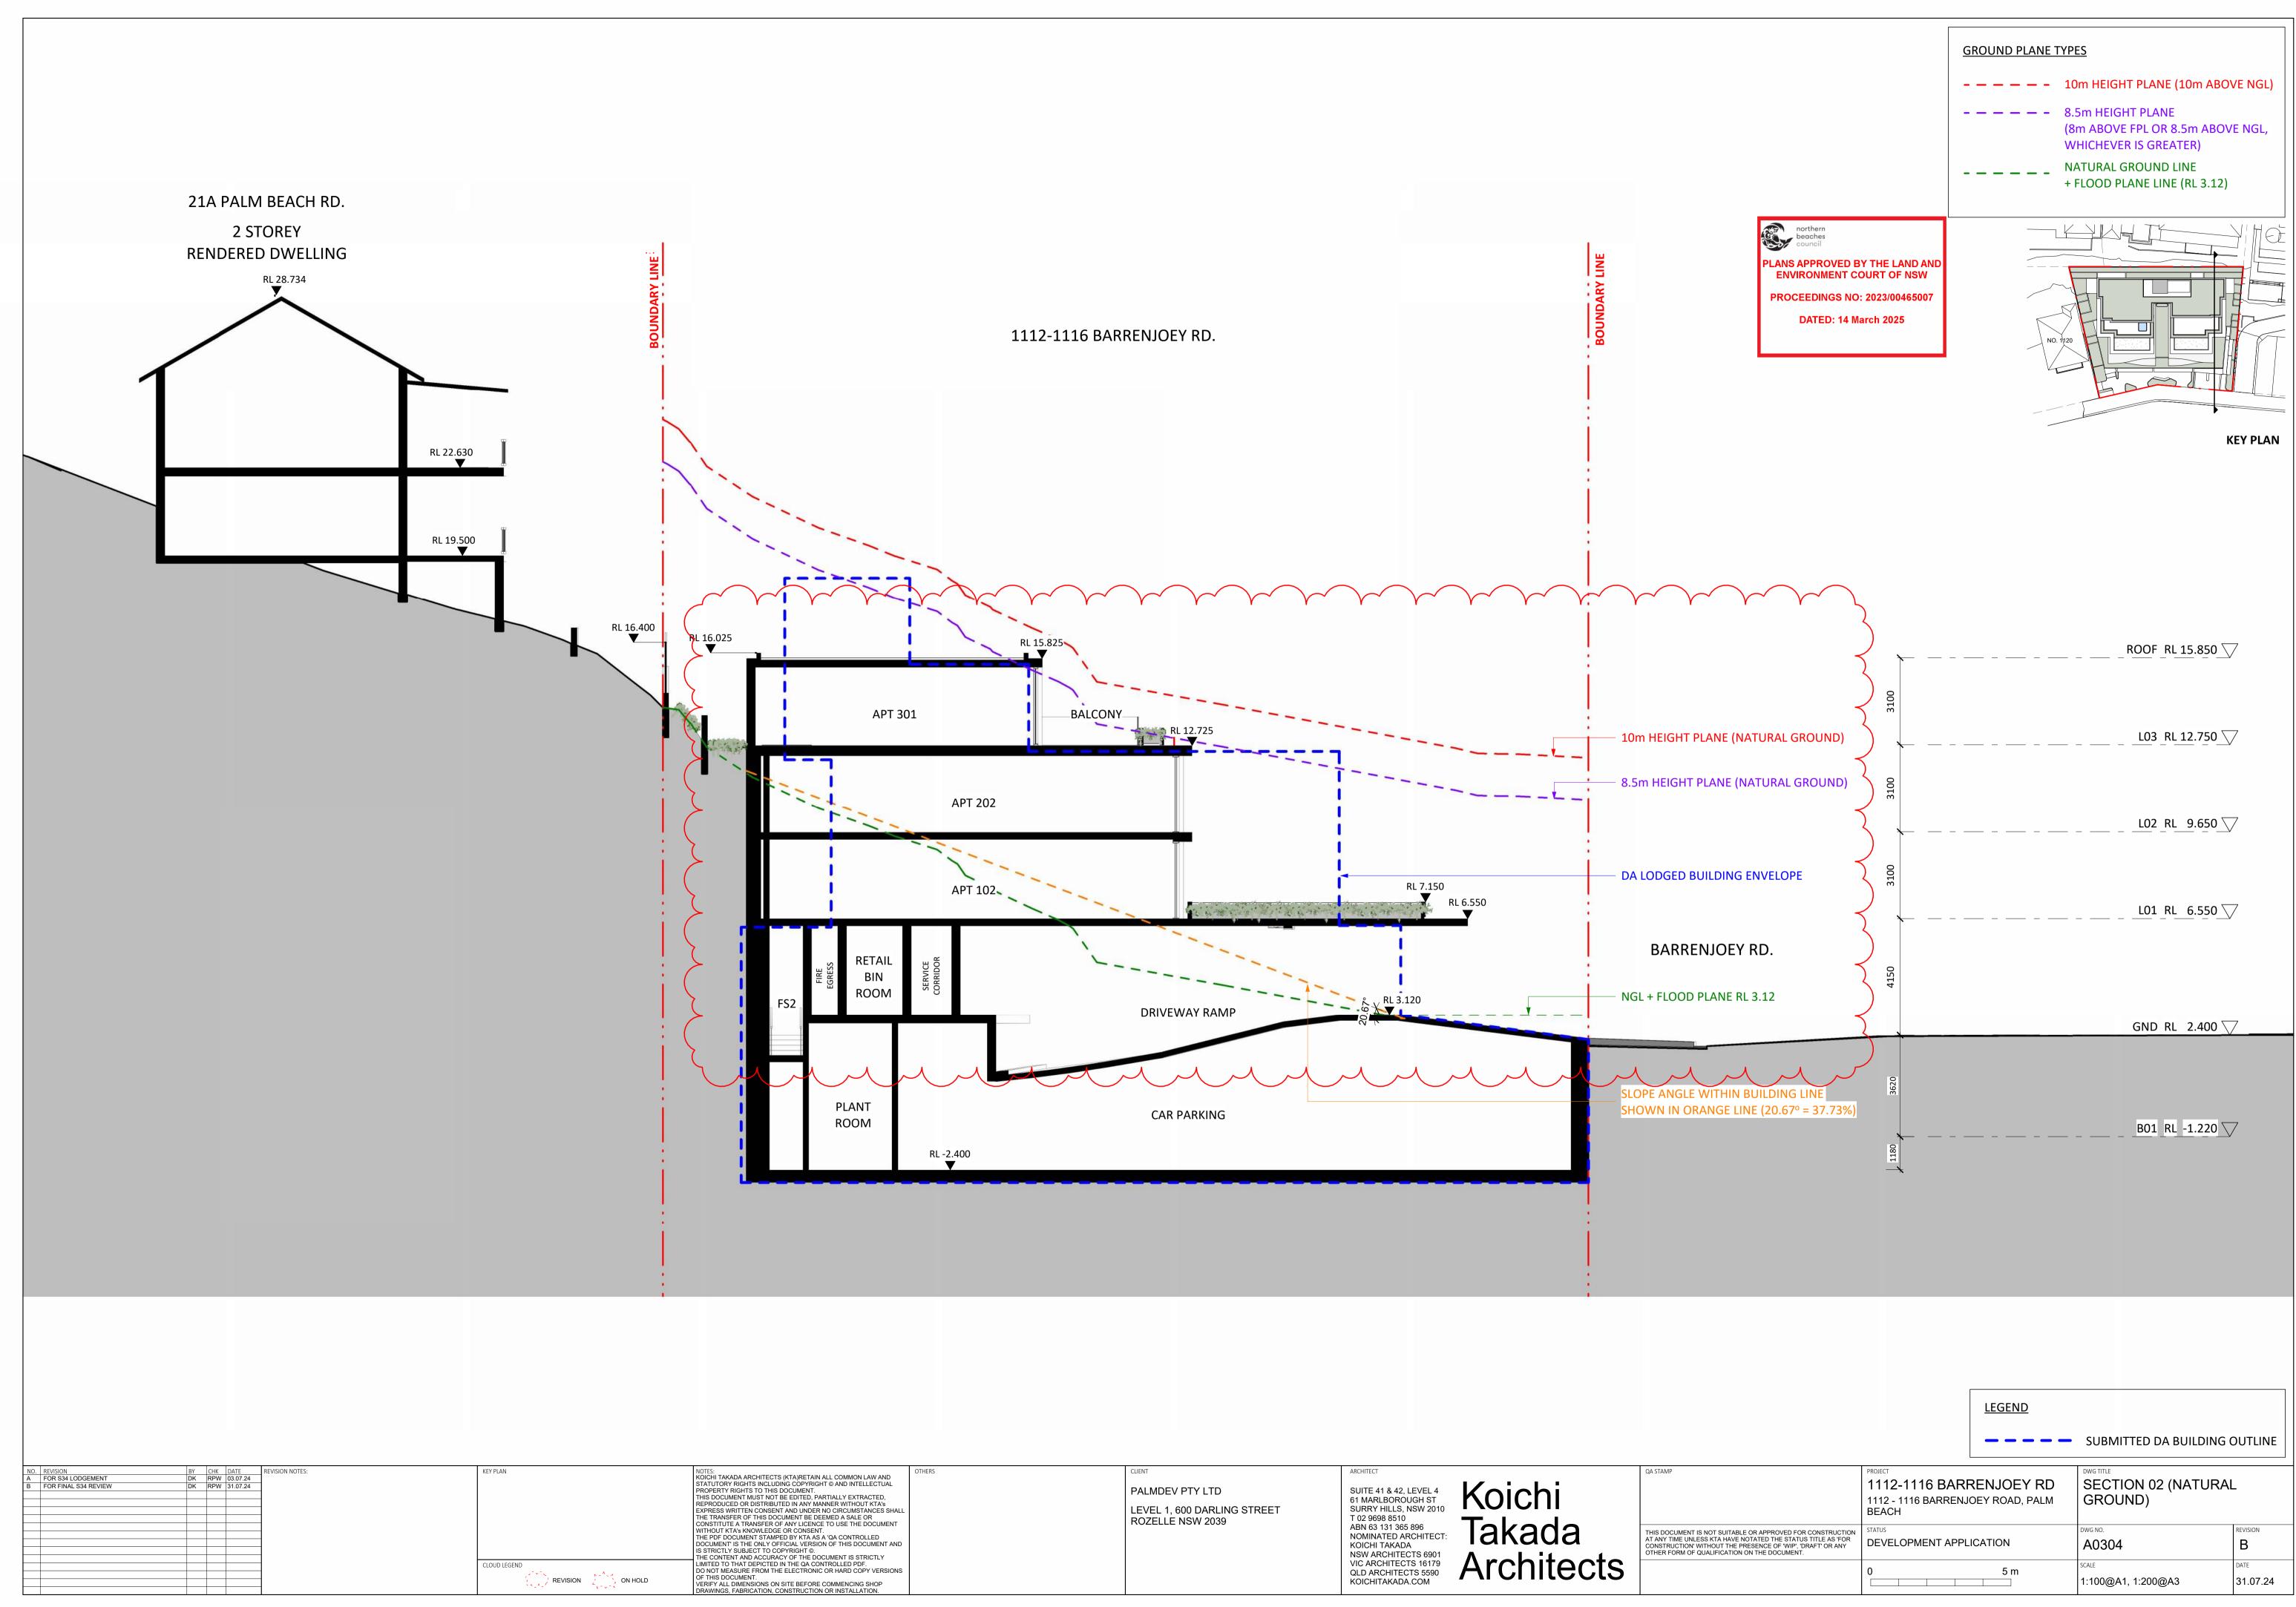

AND ONS	CLIENT PALMDEV PTY LTD LEVEL 1, 600 DARLING STREET ROZELLE NSW 2039	ARCHITECT SUITE 41 & 42, LEVEL 4 61 MARLBOROUGH ST SURRY HILLS, NSW 2010 T 02 9698 8510 ABN 63 131 365 896 NOMINATED ARCHITECT: KOICHI TAKADA NSW ARCHITECTS 6901 VIC ARCHITECTS 6901 VIC ARCHITECTS 16179 QLD ARCHITECTS 5590 KOICHITAKADA.COM	QA STAMP THIS DOCUMENT IS NOT SUITABLE OR APP AT ANY TIME UNLESS KTA HAVE NOTATED CONSTRUCTION' WITHOUT THE PRESENCE OTHER FORM OF QUALIFICATION ON THE I
---------	--	---	---

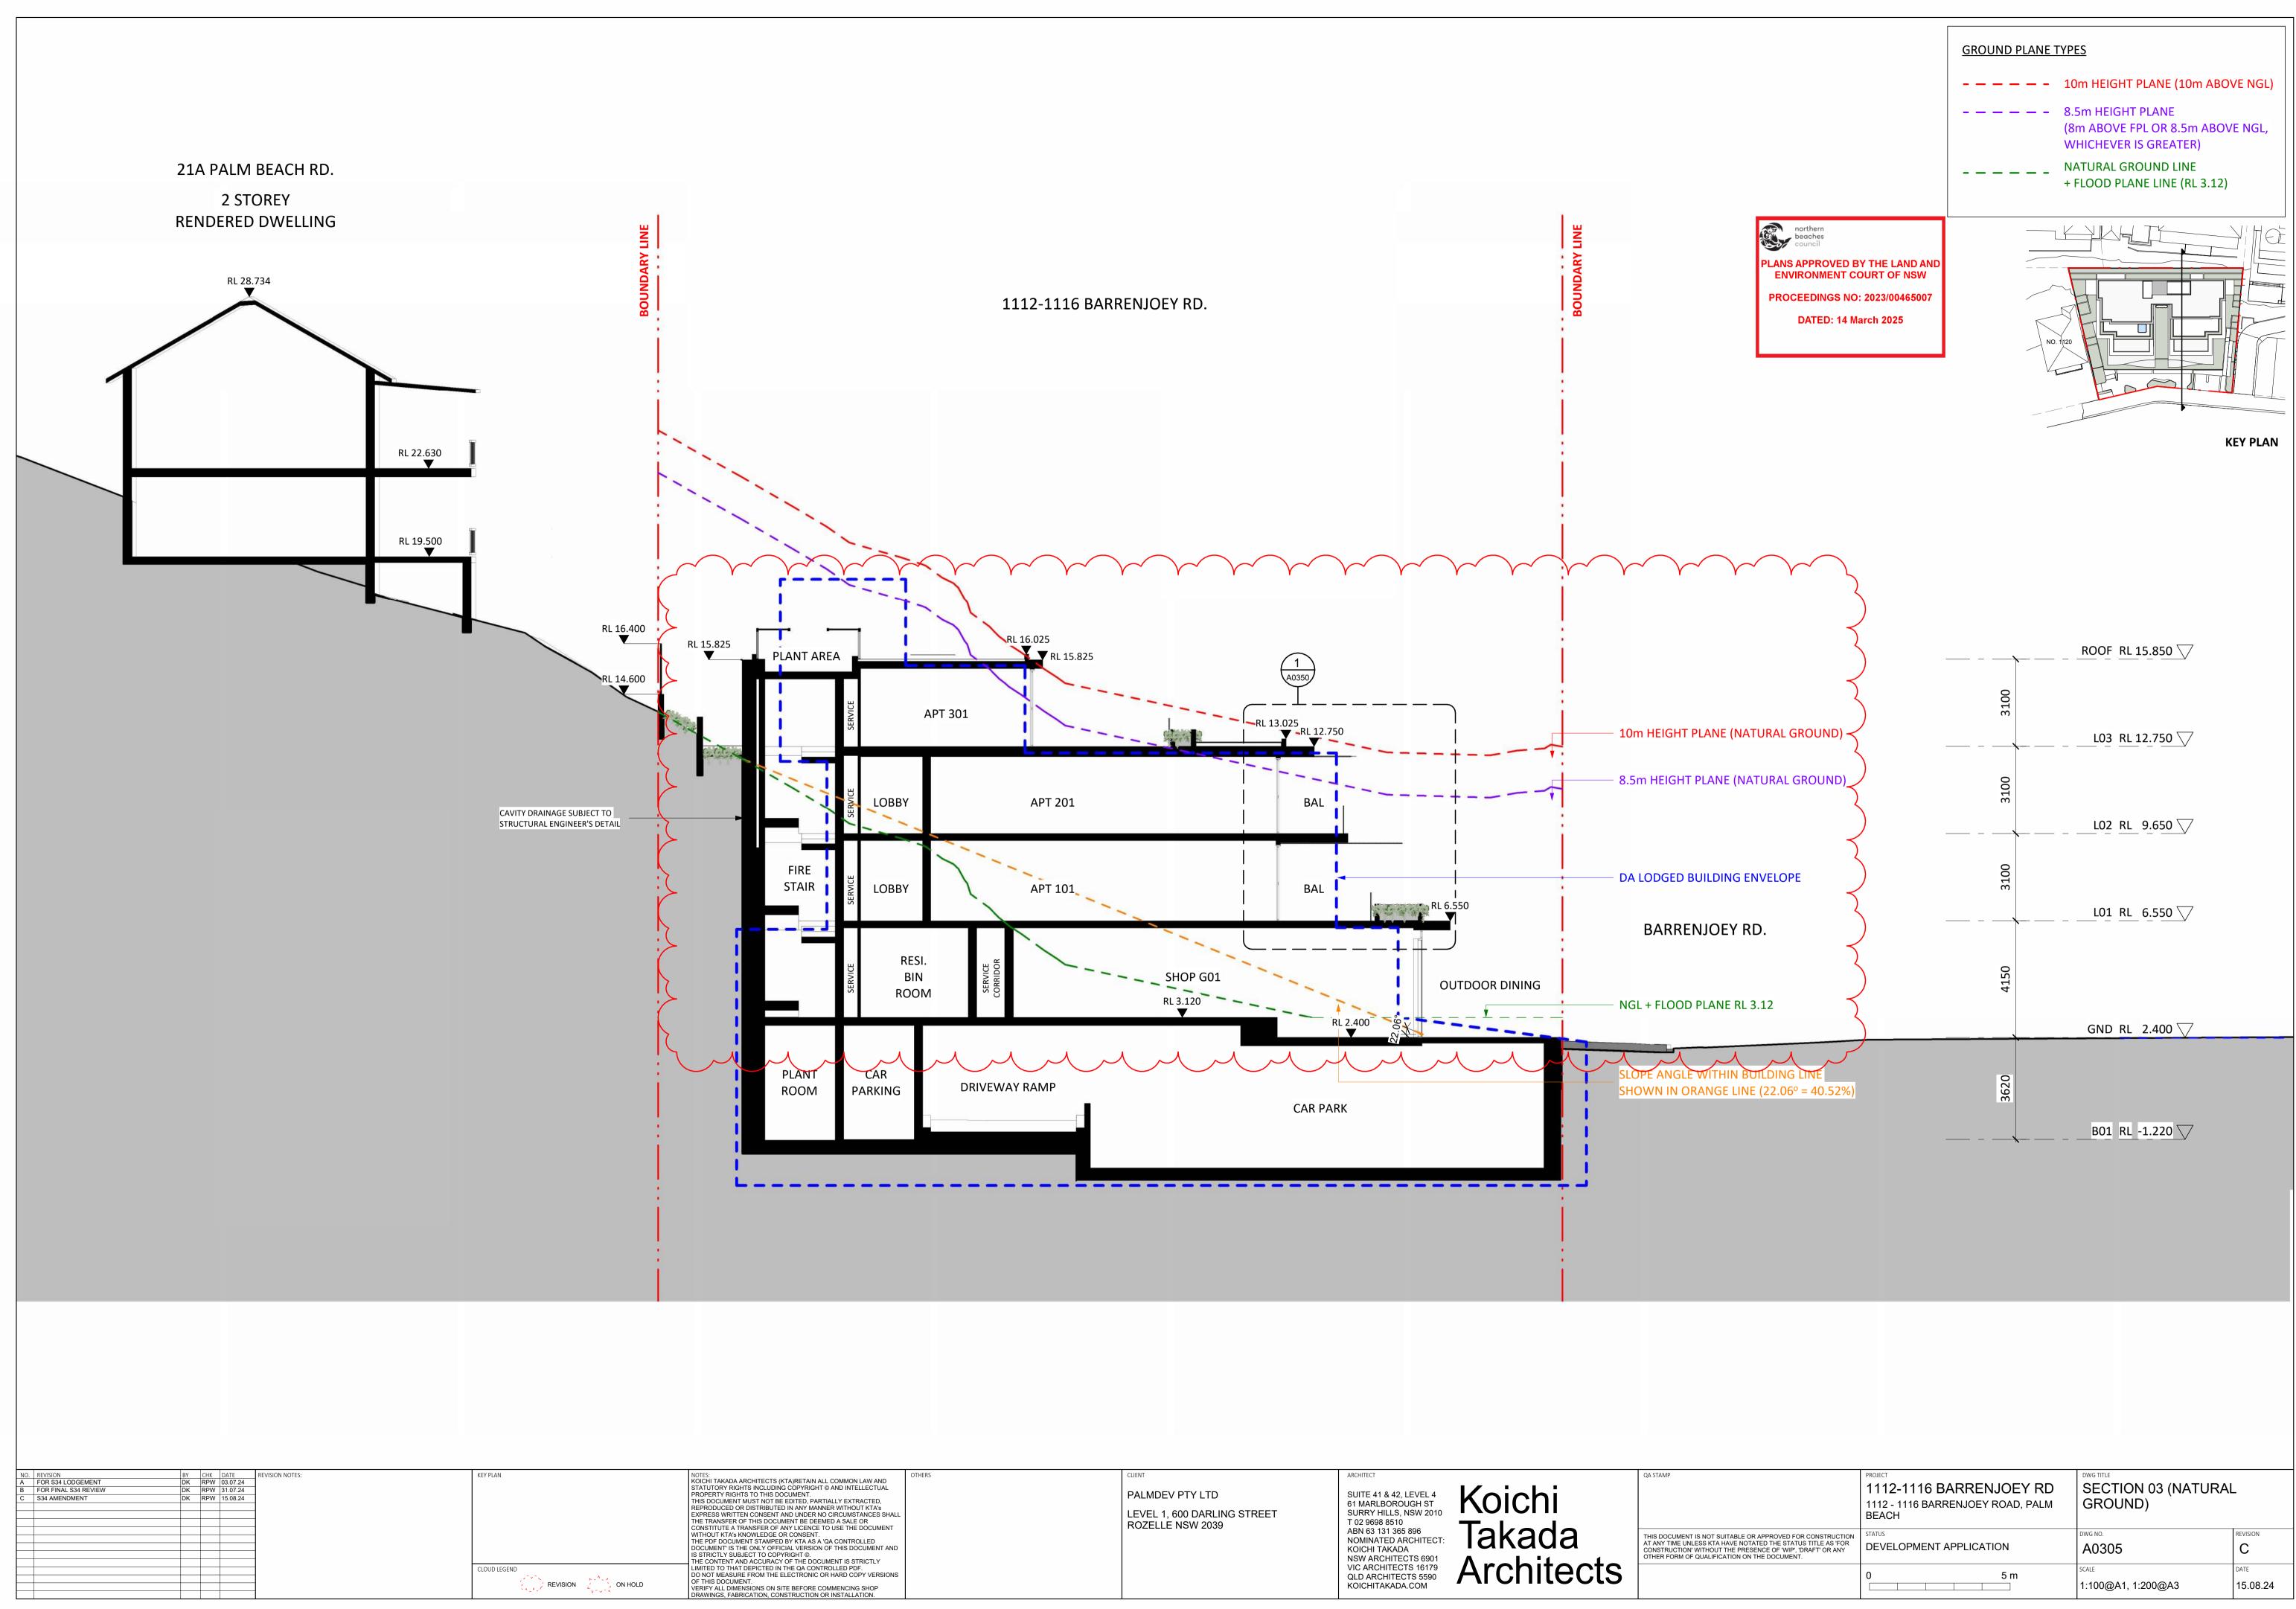

OTHERS CLIENT PALMDEV PTY LTD LEVEL 1, 600 DARLING STREET ROZELLE NSW 2039	ARCHITECT SUITE 41 & 42, LEVEL 4 61 MARLBOROUGH ST SURRY HILLS, NSW 2010 T 02 9698 8510 ABN 63 131 365 896 NOMINATED ARCHITECT: KOICHI TAKADA NSW ARCHITECTS 6901 VIC ARCHITECTS 16179 QLD ARCHITECTS 5590 KOICHITAKADA.COM	CONSTRUCTION' WITHOUT THE PRESENCE
--	--	------------------------------------

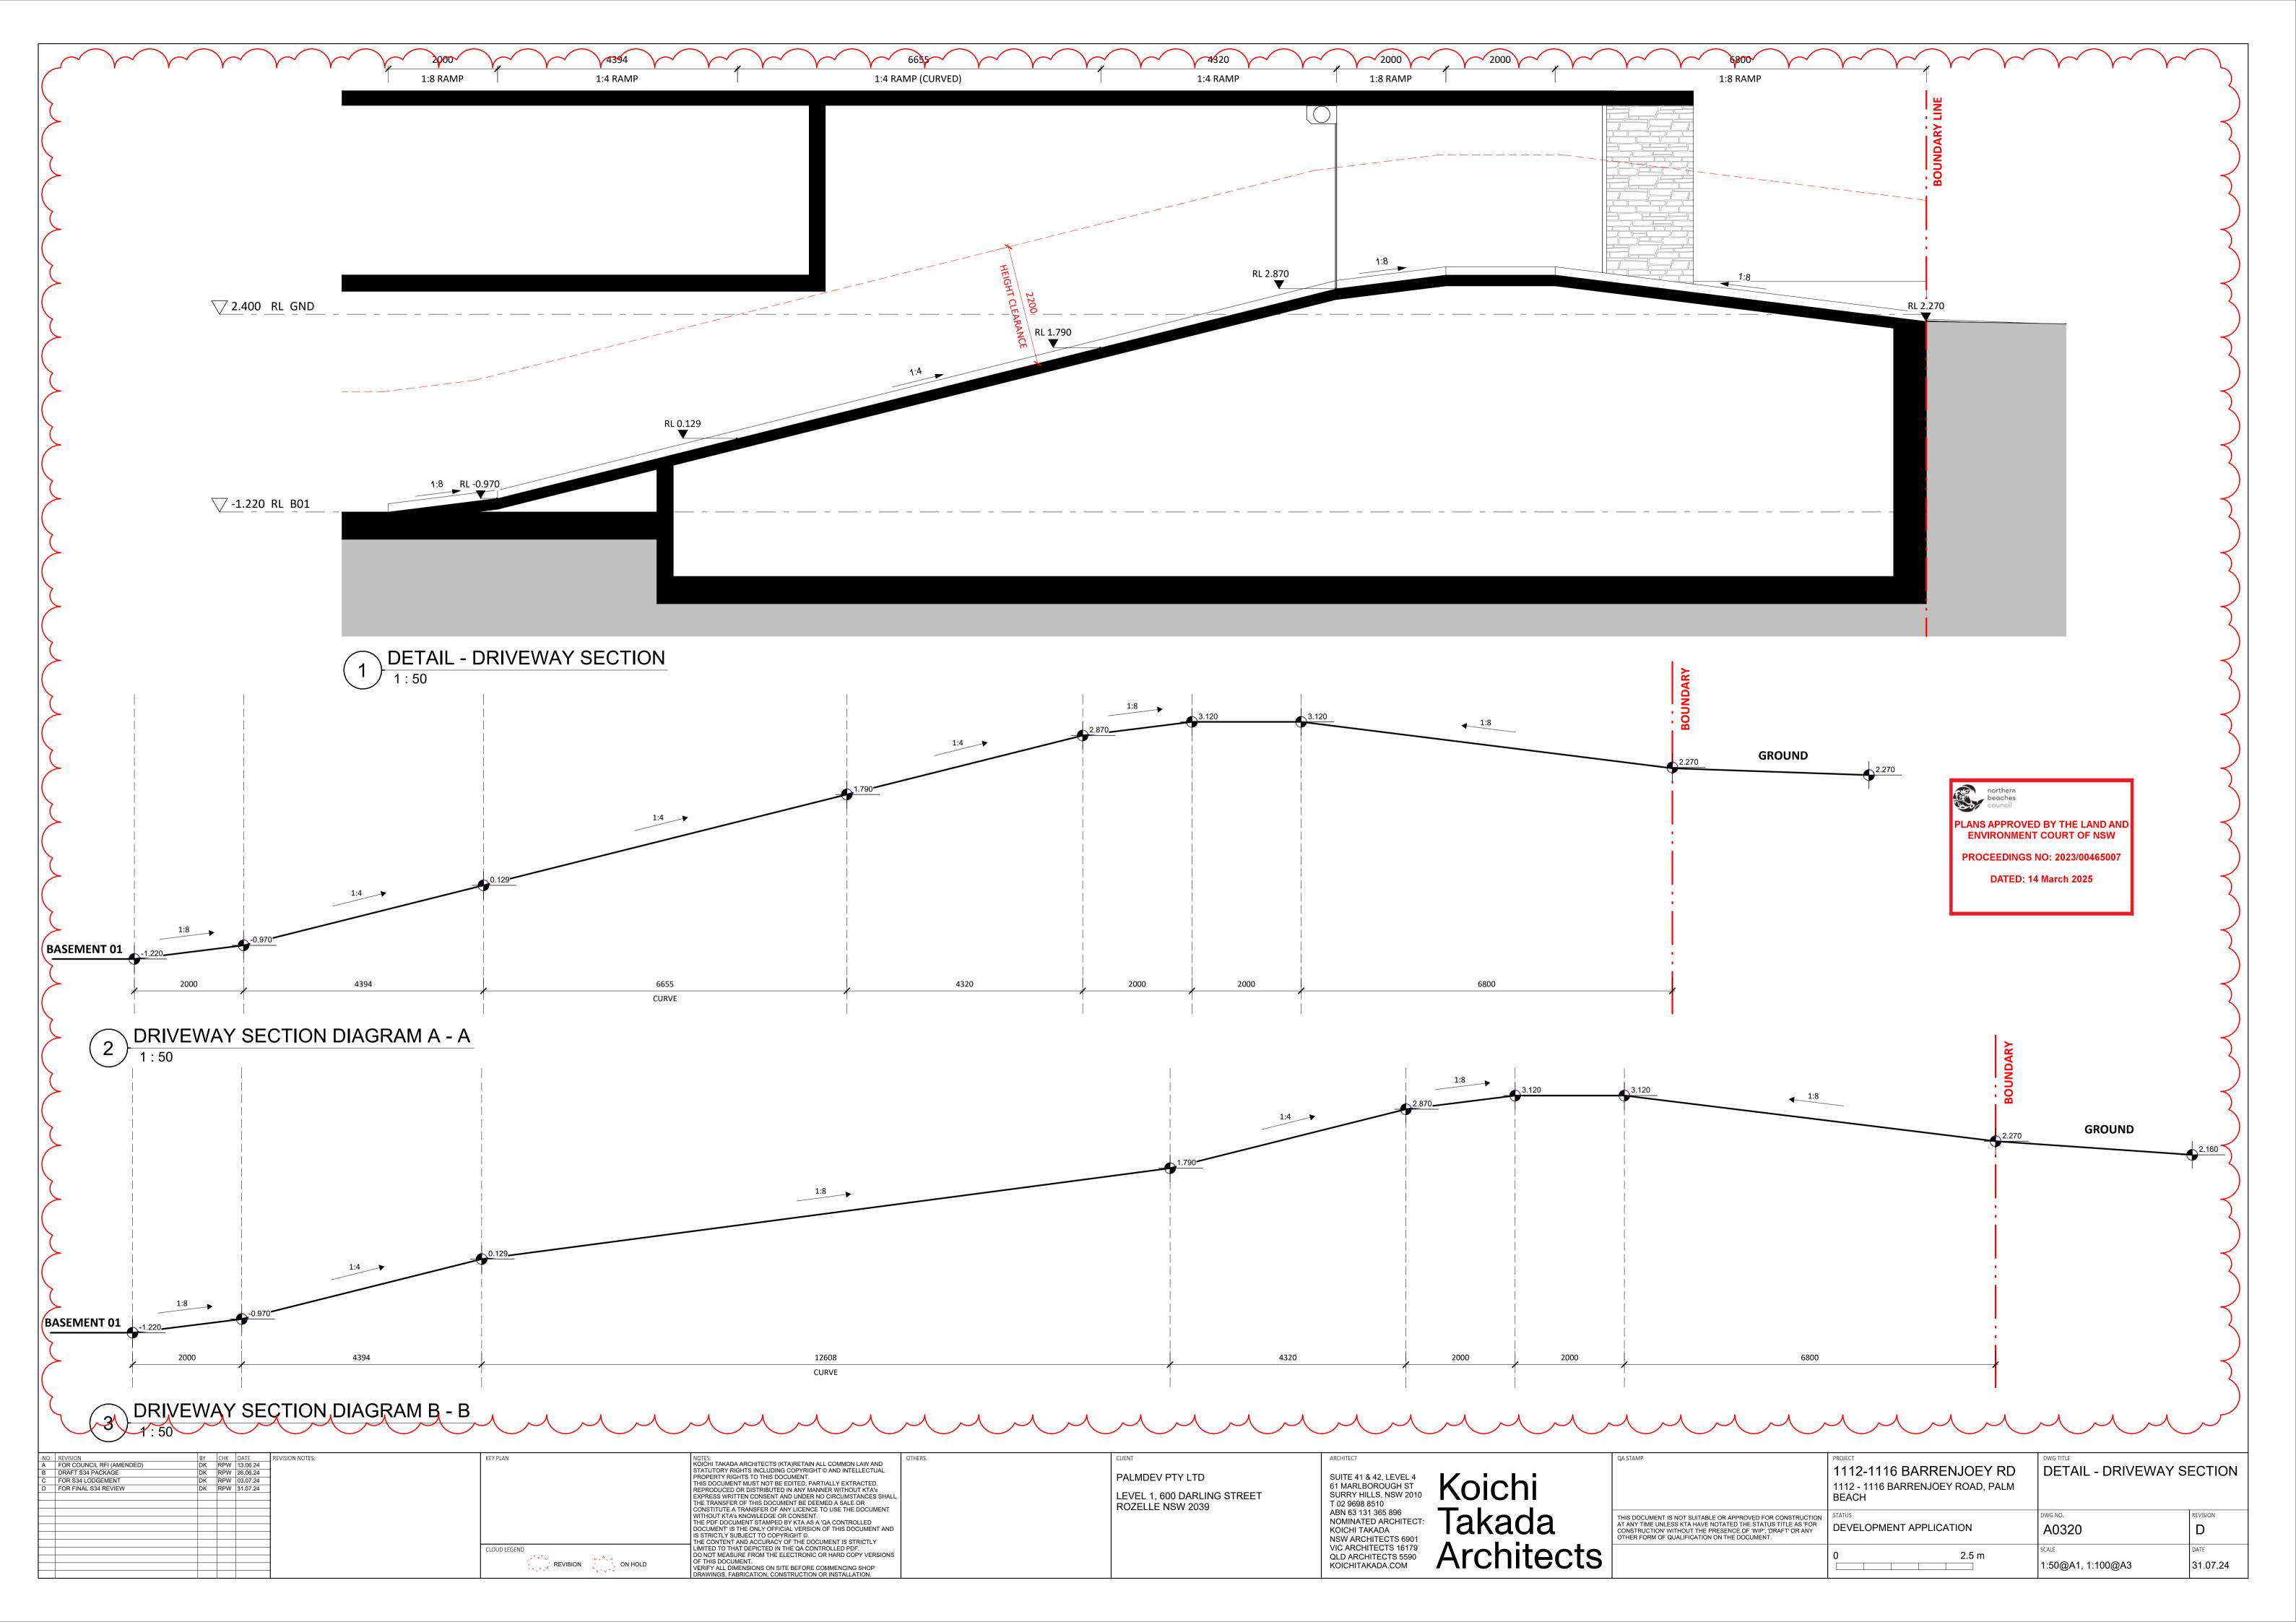




NC	REVISION	BY	СНК	DATE	REVISION NOTES:	KEY PLAN	NOTES:
А	FOR FINAL S34 REVIEW	DK	RPW	31.07.24			KOICHI TAKADA ARCHITECTS (KTA)RETAIN ALL COMMON LAV
							STATUTORY RIGHTS INCLUDING COPYRIGHT © AND INTELLEC PROPERTY RIGHTS TO THIS DOCUMENT.
							THIS DOCUMENT MUST NOT BE EDITED. PARTIALLY EXTRACT
							REPRODUCED OR DISTRIBUTED IN ANY MANNER WITHOUT K
							EXPRESS WRITTEN CONSENT AND UNDER NO CIRCUMSTANC
							THE TRANSFER OF THIS DOCUMENT BE DEEMED A SALE OR
							CONSTITUTE A TRANSFER OF ANY LICENCE TO USE THE DOC
							WITHOUT KTA'S KNOWLEDGE OR CONSENT. THE PDF DOCUMENT STAMPED BY KTA AS A 'QA CONTROLLE'
							DOCUMENT' IS THE ONLY OFFICIAL VERSION OF THIS DOCUM
							IS STRICTLY SUBJECT TO COPYRIGHT ©.
							THE CONTENT AND ACCURACY OF THE DOCUMENT IS STRICT
					1	CLOUD LEGEND	LIMITED TO THAT DEPICTED IN THE QA CONTROLLED PDF.
						A CALL AND A CALL	DO NOT MEASURE FROM THE ELECTRONIC OR HARD COPY V OF THIS DOCUMENT.
					1	REVISION 2' , ON HOLD	VERIFY ALL DIMENSIONS ON SITE BEFORE COMMENCING SHO
							DRAWINGS, FABRICATION, CONSTRUCTION OR INSTALLATION

ARCHITECT QA STAMP CLIENT AW AND ECTUAL SUITE 41 & 42, LEVEL 4 61 MARLBOROUGH ST SURRY HILLS, NSW 2010 T 02 9698 8510 ABN 63 131 365 896 NOMINATED ARCHITECT: KOICHI TAKADA NSW ARCHITECTS 6901 VIC ARCHITECTS 16179 QLD ARCHITECTS 5590 KOICHITAKADA.COM PALMDEV PTY LTD Koichi ACTED, IT KTA's ANCES SHALL LEVEL 1, 600 DARLING STREET ROZELLE NSW 2039 OCUMENT Takada THIS DOCUMENT IS NOT SUITABLE OR APP AT ANY TIME UNLESS KTA HAVE NOTATED CONSTRUCTION' WITHOUT THE PRESENCE OTHER FORM OF QUALIFICATION ON THE LLED CUMENT AND RICTLY Architects VERSIONS HOP

northern beaches council

PLANS APPROVED BY THE LAND AND ENVIRONMENT COURT OF NSW PROCEEDINGS NO: 2023/00465007 DATED: 14 March 2025

	PROJECT 1112-1116 BARRENJOEY RD 1112 - 1116 BARRENJOEY ROAD, PALM BEACH	DWG TITLE DETAIL - AWNING DETAIL		
APPROVED FOR CONSTRUCTION TED THE STATUS TITLE AS 'FOR INCE OF 'WIP', 'DRAFT' OR ANY HE DOCUMENT.		dwg no. A0350	REVISION A	
	0 2.5 m	^{SCALE} 1:50@A1, 1:100@A3	DATE 31.07.24	

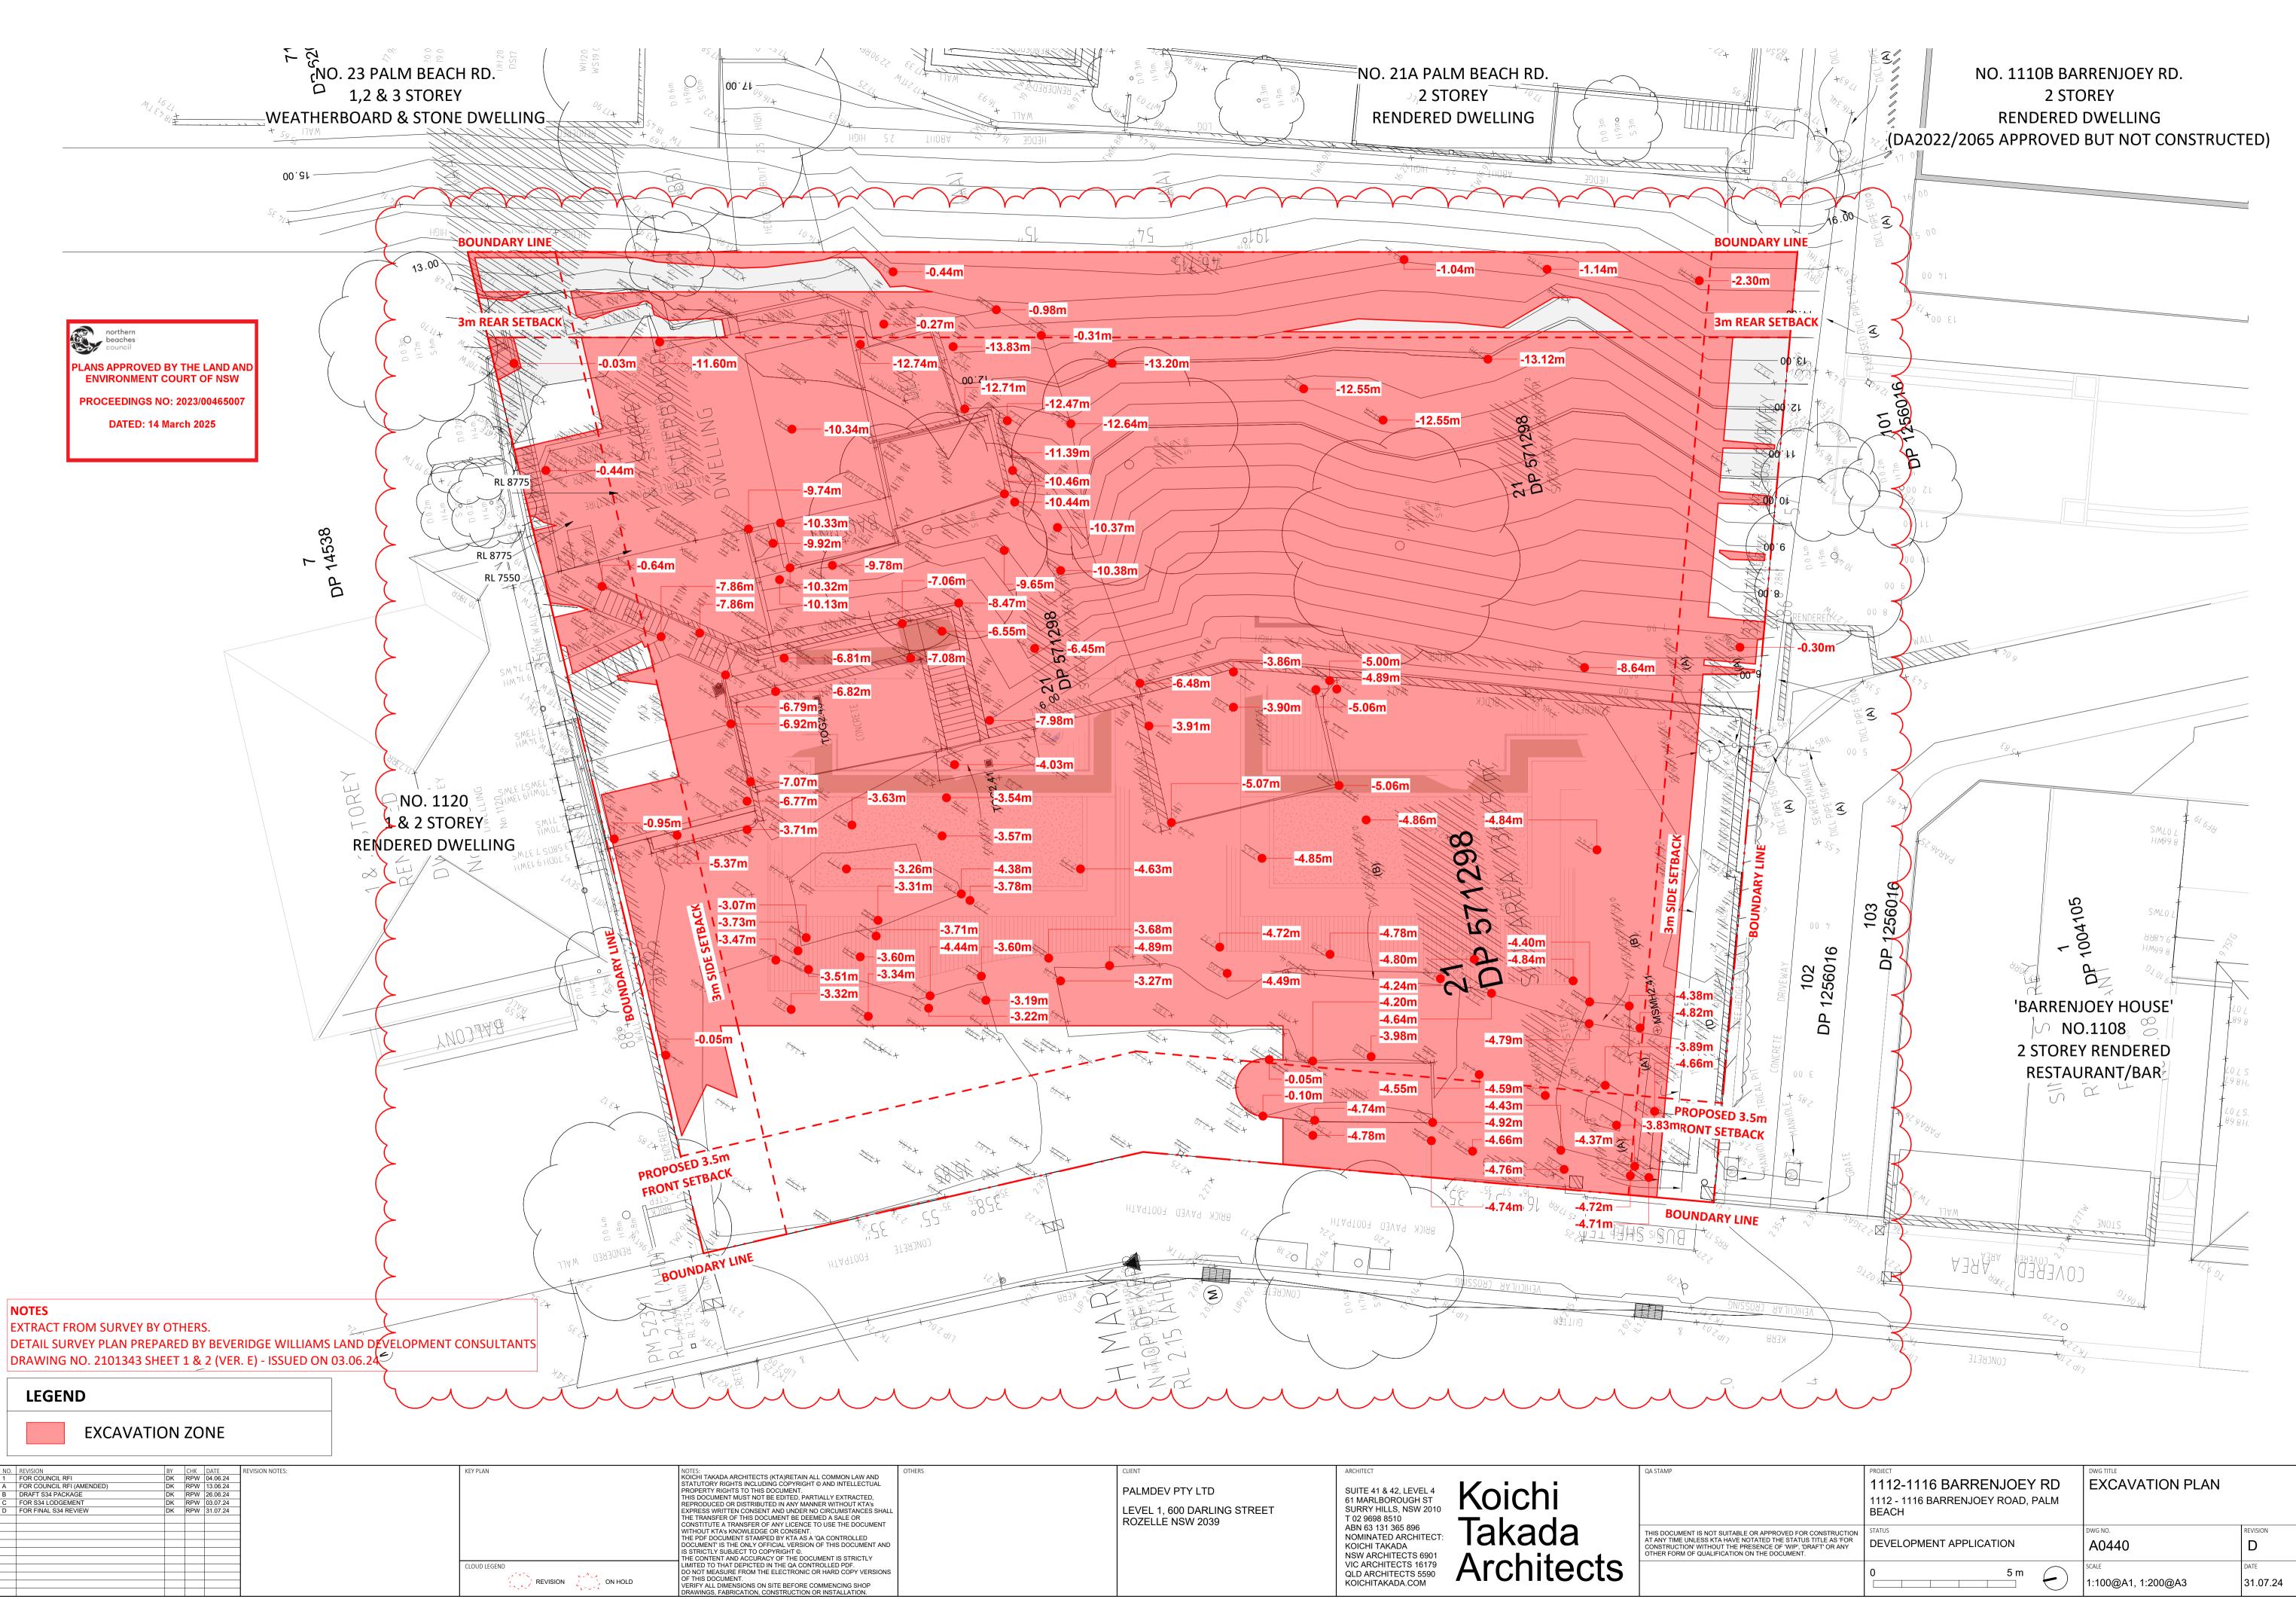

V AND CTUAL FED, TA's CES SHALL CUMENT CUMENT MENT AND TLY	OTHERS	CLIENT PALMDEV PTY LTD LEVEL 1, 600 DARLING STREET ROZELLE NSW 2039	ARCHITECT SUITE 41 & 42, LEVEL 4 61 MARLBOROUGH ST SURRY HILLS, NSW 2010 T 02 9698 8510 ABN 63 131 365 896 NOMINATED ARCHITECT: KOICHI TAKADA NSW ARCHITECTS 6901 VIC ARCHITECTS 16179	QA STAMP THIS DOCUMENT IS NOT SUITABLE OR APP AT ANY TIME UNLESS KTA HAVE NOTATED CONSTRUCTION WITHOUT THE PRESENCE OTHER FORM OF QUALIFICATION ON THE D
TLY /ERSIONS OP N.				OTHER FORM OF QUALIFICATION ON THE D
				,

	1112-1116 BARRENJOEY ROAD, PALM BEACH	EACAVATION PLAN	
PPROVED FOR CONSTRUCTION D THE STATUS TITLE AS 'FOR CE OF 'WIP', 'DRAFT' OR ANY E DOCUMENT.	STATUS DEVELOPMENT APPLICATION	dwg NO. A0440	revision D
	0 5 m	^{SCALE} 1:100@A1, 1:200@A3	DATE 31.07.24




NO.	REVISION	BY	CHK	DATE
А	FOR DA SUBMISSION	DK	GW	16.12.21
В	FOR AMENDED DA SUBMISSION	DK	RPW	25.07.23
С	FOR AMENDED DA SUBMISSION	DK	SL	24.08.23
D	DRAFT S34 PACKAGE	DK	RPW	26.06.24
Е	FOR S34 LODGEMENT	DK	RPW	03.07.24
F	FOR FINAL S34 REVIEW	DK	RPW	31.07.24
G	S34 AMENDMENT	DK	RPW	15.08.24

REVISION NOTES:

CLOUD LEGEND	
REVISION	ON HOLD

KEY PLAN

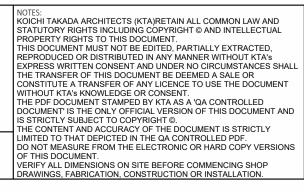

LEGEND	AL 01	TIMBER LOOK ALUMINIUM BATTEN	PB
	AL 02	TIMBER LOOK ALUMINIUM SCREEN	PV
	AL 04	ALUMINIUM SCREEN (WHITE)	RE
	AL 05	ALUMINIUM LOUVRE (DARK)	RE
	GL 01	GLAZING	SN
	GL 02	GLAZED BALUSTRADE	ТВ

PALMDEV PTY LTD LEVEL 1, 600 DARLING STREET ROZELLE NSW 2039 ARCHITECT

SUITE 41 & 42, LEVEL 4 61 MARLBOROUGH ST SURRY HILLS, NSW 2010 T 02 9698 8510 ABN 63 131 365 896 NOMINATED ARCHITECT: KOICHI TAKADA NSW ARCHITECTS 6901 VIC ARCHITECTS 16179 QLD ARCHITECTS 5590 KOICHITAKADA.COM

Koichi Takada Architects

QASTAWI
THIS DOCUMENT IS NOT SUITABLE OR AP AT ANY TIME UNLESS KTA HAVE NOTATED CONSTRUCTION' WITHOUT THE PRESENC OTHER FORM OF QUALIFICATION ON THE

northern beaches council PLANS APPROVED BY THE LAND AN ENVIRONMENT COURT OF NSW

PROCEEDINGS NO: 2023/00465007 DATED: 14 March 2025

01
01
01
02
D
01

	PROJECT 1112-1116 BARRENJOEY RD 1112 - 1116 BARRENJOEY ROAD, PALM BEACH	DWG TITLE MATERIALS SAMPLE BOARD	
APPROVED FOR CONSTRUCTION TED THE STATUS TITLE AS 'FOR NCE OF 'WIP', 'DRAFT' OR ANY HE DOCUMENT.	STATUS DEVELOPMENT APPLICATION	dwg NO. A0500	REVISION G
		SCALE	DATE 15.08.24

PLANTS SCHEDULE Botanic Name	Common Name	Mature Height(m) Pot Si	ze	Qty
Alocasia brisbanensis	Colocasia	2m	300mm	30
Alpinia nutans	Dwarf Cardamom	1.2m	200mm	114
Angophorahispida	Dwarf Apple	7m	200Ltr	2
Asplenium australasicum	Bird's Nest Fern	0.5-1.5	200mm	50
Banksia ericifolia 'Little Eric'	Heath Leaved Banksia	0.3m	200mm	21
Banksia integrifolia	Coastal Banksia	5-10m	400Ltr	10
Banksia 'Roller Coaster'	Roller Coaster	0.3m	200mm	22
Blechnum nudum	Fishbone Waterfern	0.4m	200mm	53
Bougainvillea alba	White Bougainvillea	Climber	200mm	26
Buckinghamia celsissima	Ivory Curl Flower	30m	200Ltr	1
Carpobrotus glaucescens	Pig Face	0.3m	200mm	80
Casuarina glauca 'Cousin It'	Cousin It	0.3m	200mm	30
Cissus antarctica	Kangaroo Vine	ground cover	200mm	954
Crassula ovata	Jade	0.6m	35Ltr	40
Cupaniopsis anacardioides	Tuckeroo	5-10m	400Ltr	3
Cyathea cooperi	Rough Tree Fern	2-4m	400Ltr	18
Doryanthes excelsa	GymeaLily	1-3m	500mm	11
Elaeocarpus reticulatus	Blueberry Ash	3-10m	100Ltr	3
Epipremnum aureum	Devil's Ivy	0.3m	200mm	40
Ficinia nodosa	Knobby Club-Rush	0.8-1m	300mm	10
Grevillea sp.	Grevillea	0.3m	200mm	39
Hibbertia scandens	Guinea Flower	Climber	200mm	59
Howeaforsteriana	Kentia Palm	5-12m	advanced	7
Livistona australis	Cabbage Tree Palm	10-20m	advanced	3
Lomandra longifolia	Spiny-Headed Mat Rush	0.4-1m	200mm	24
Lomandra 'Tanika'	Fine Matt Grass	0.7m	200mm	153
Macrozamia communis	Burrawang	1.5-2m	400Ltr	6
Muehlenbeckia axillaris	Creeping Wire Vine	0.4m	300mm	50
Muehlenbeckia complexa	Creeping Wire Vine	0.4m	300mm	64
Myoporum parvifolium	Creeping Boobialla	Groundcover	200mm	839
Pandorea pandorana	Wonga Wonga Vine	Climber	200mm	106
Pennisetum 'Nafray'	Dwarf Fountain Grass	0.6m	200mm	48
Philodendron 'Burle Marx'	Burle Marx Philodendron	0.5-0.75m	200mm	3
Philodendron 'Xanadu'	Xanadu	0.7m	35Ltr	50
Poa 'Eskdale'	Tussock Grass	0.7m-0.9m	200mm	27
Sansevieria 'Uganda'	Snake Plant	0.6m	35Ltr	33
Strelitzia nicolai	Giant Bird Of Paradise	5-7m	300mm	11
Syzygium 'Resilience'	Resilience Lilly Pilly	6-10m	400Ltr	37
Thunbergia grandiflora	Blue Sky Flower	Climber	200mm	15
Trachelospermum jasminoides	Star Jasmine	Climber	200mm	43
Tristaniopsis 'Luscious'	Luscious Water Gum	4-6m	400Ltr	7
Tristaniopsis sp.	Luscious Water Gum	4-6m	100Ltr	1

Denotes Native Species

NOTE: 85.81% of proposed plants are native

NOTES

RE: Statements of Facts and Contentions for Case Number 2023/00465007

CHARACTER AND BUILT FORM

e) Landscape design does not suitably offset building mass. Insufficient landscaping integrated into building design to soften massing

Additional landscaping has been integrated into the building design through planters on each level to soften the visual massing of the building. A typical detail for these raised planters has been provided on LP07-D7621.

g) Scenic Protection Category 1 area. Refer Clause D12.4 which seeks to minimise visual impact when viewed from waterway, road or public

As per Clause D12.4 additional groundcovers, shrubs and canopy trees have been added to the vertical break to minimize visual impact when viewed from the waterway, road or public reserve. As shown on LP03-D762. As per Clause D12.4 the proposal of 1x additional Cupaniopsis anacardioides street tree has been added as shown on LP02-D7621.

INADEQUATE LANDSCAPE AMENITY

d) Fails to meet outcomes and controls of Clause C2.1 Landscaping of P21DCP which requires development to incorporate a range of ground covers shrubs and trees to soften the built form from the street.

As per Clause C2.1 landscaping of P21DCP a range of native ground covers, shrubs and trees have been added through all levels to soften the built form from the street

e) The proposal fails to meet the outcomes and controls of Clause D12.1 Character as viewed from a public place of P21 DCP which requires landscaping to be integrated with the building design

As per Clause D12.1 of P21 DCP the updated architectural layout allows for a significantly higher integration of landscape into the built form including large canopy trees/palms.

g) The rear setback and upper side setbacks are not suitable for the establishment of significant tree planting when considering view impact to neighbouring properties

Planting layout and species has been reviewed as to not obstruct views for properties to the rear (21A and 23 Palm Beach Road). 7x Tristaniopsis Luscious' planted at the rear on LP05-D7621 can technically reach a mature height of 6-8m, this is in an ideal environment, given the soil depths & site conditions we would not expect this tree to exceed the 3-4m range. 4x Banksia integrifolia at the rear on LP05-D7621 can technically grow to 5-10m, however, the soil depth & site conditions we would

expect this to stunt the trees growth to 3-4meters. As a general note Bankia's respond well to cutbacks & can be maintained to a certain height, as necessary

URBAN DESIGN

12. A significant characteristic of the area is how the buildings are set into the hillside with landscape surrounding each building. The division of he building into two parts enables the potential for the proposal to be compatible with this character with substantial landscape two pavilions. How does the retail engage with this. How does the retail engage with interpretation of the indigenous heritage?

The landscape planters within the Heritage Preservation Zone soften the built form from the street frontage & provide ammenity to the retail spaces. These landscape gestures use a plant palette comprised of native Australian species and species that are endemic to the Northern Beaches area.

13 What landscape would remain around the perimeter be visible at the rear over the top of the roof, at the sides?

The Tristaniopsis luscious planted along the Eastern boundary as shown in LP05-D7621 will be visible behind the roof from some elevations. However these trees shouldn't reach a height over the proposed level of the mechanical room located on the roof.

RE: Front Setback Small Tree Request for 1112-1116 Barrenjoey Rd, F

This is to support the proposal for the addition of a small/medium t suggesting a Tristaniopsis laurina luscious to be positioned as per

playing in the footsetback as requested by council. We are d planoutsice the Heritage Preservation Zone.

PLANS APPROVED BY THE LAND AND **ENVIRONMENT COURT OF NSW**

PROCEEDINGS NO: 2023/00465007

DATED: 14 March 2025

S34 Cover Page

GENERAL NOTES

Graphic Illustration

Please note that the plant graphics are indicative sizes only and not an accurate representation at time of purchase. Do not scale from drawings. All dimensions in mm unless otherwise stated. Figure dimensions shall take precendence over scale. Contractors must verify all dimensions on site before commencing any work or making shop drawings. All works shall be carried out in accordance with ASA,BCA and Local Government Regulations. This drawing is protected by copyright.

Site Preparation All existing plants marked for retention shall be protected for the duration of works. Remove from site all

perennial weeds and rubbish before commencing landscape works. Soilworks

Thoroughly cultivate the subsoil to a depth of 200mm. Supply and install to a depth of 300mm quality garden soil mix to all planting beds and 150mm turf underlay to lawn areas.

Mulch Supply and install a 75mm layer of hardwood horticultural grade mulch to all planting beds set down 25mm

from adjacent paving or garden edge. Maintenance

All failed or defective plant species to be replaced by landscaper for a 3 months period following completion of work. Further maintenance during and after this period should include watering, weeding, fertilising, pest

and disease control, pruning and hedging, reinstatement of mulch and keeping the site neat and tidy. Irrigation All garden areas are to include drip irrigation based on station timer and to be maintained by Strata body of the

building Safe works on roofs

Works undertaken on the rooftop garden are to be in accordance with the 'Code of Practice for Safe Work on Roofs'& all Australian Standards associated in this Code of Practice. These standards are outlined by Safe Work NSW.

BOUNDARY LINE ÈRRACE oof Belo WINDOWS SHOWN DASH BALCONY NQ. 1120 1 & 2\STOREY RENDERED DWELLING EXTENDED MULLIONS FOR P SCREENING THE RL 2400 TWO SETS FIRE HYDRANT AN SERVICE BACKFLC DEVICES AUTHORITY MASTER COLD WATER MET 2 x RETAIL WATER METER BOUNDARY LINE E HYDRANT BOOSTER

> Figure dimensions shall take precendence over scale. Contractors must verify all dimensions on job before commencing any work or making shop drawings. This drawing is protected by copyright.

DCP CONTROLS

Note It is recommended that all plants used be subject to an establishment period. During this period maintenance work carried out will include; watering, mowing, weeding, fertilising, pest and disease control,

GENERAL PLANTING NOTES

and tidy.

services.

ARBORIST REPORT:

Tree Management Solutions

E: leigh@treemanagmentstrategies.com.au

Leigh Brennan

T:0447356059

reseeding, returfing, staking and tying, replanting,

cultivating, pruning, hedge clipping, aerating, reinstatement of mulch, top dressing and keeping the site neat

Note Plants shall be vigorous, well established, of good form consistent with species or variety, not soft or forced, free from disease and insect pests, with large healthy root systems and no evidence of having been restricted in growth or damaged. Root system shall be well balanced in relation to the size of the plant.

Note install "root barrier" or equivalent to manufacturers specifications to protect nearby structures and

Note Install temporary drip irrigation system under mulch in tree protection zones and water on allotted

Landscape plans are in conjunction with the Arboricultural Impact Assessment Report prepared by


Soil Depth A minimum soil depth is of 600mm for shrubs & 1000mm for trees is provided All planters contain a minimum area of 4m2 & 8m2 where canopy trees are located Plant material All plant material is specified with the following minimum sizes: Ground cover: 200mm Shrubs: 35Ltr Trees: 400Ltr Garden Beds All garden areas are to contain a minimum depth of 500mm of garden mix (ANL Botany Mix or equivalent) All garden areas are to be covered with 150mm hardwood chip mulch Indigenous Tree Species

A variety of the following indigenous tree species are included within the landscape design: Cupaniopsis anacardioides Tristaniopsis laurina

Banksia integrifolia Garden Bed Barriers

All garden areas that contain proposed trees are to have root barriers installed to all edges (preferred barrier is 100mm thick & 300mm depth concrete)



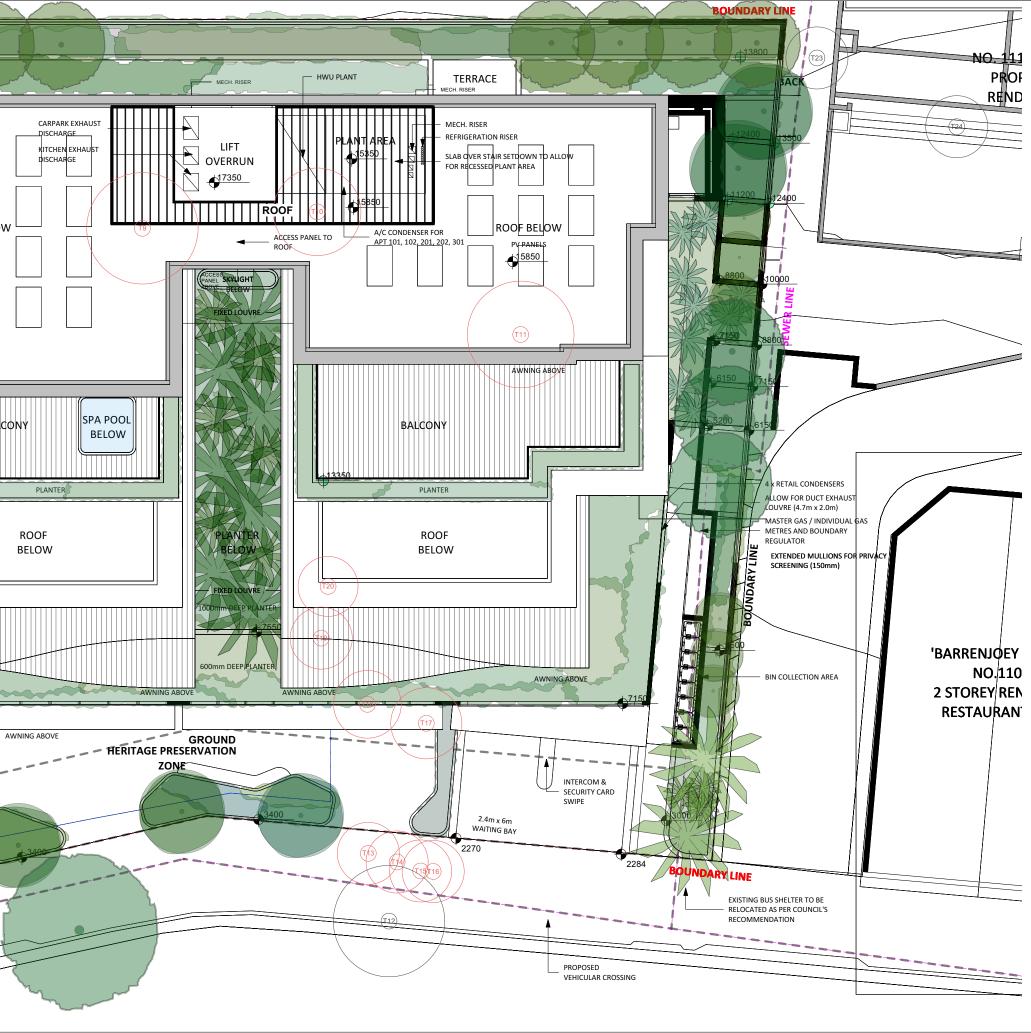

Client: IPM Palm Beach Project Address: 1112-1118 Barrenjoey RD Palm Beach, NSW 2108

Dwg no: LP01-D7621 Title: S34 Cover Page

Drawn by: FD/EF Issue: 01

Checked: WD Revision: Ν

Scale: 1:150 @ A2 Date: 06.08.2024

Landscape Design Sydney 53 Cranbrook St, Botany T (02) 9316 9044 F (02) 9316 9055



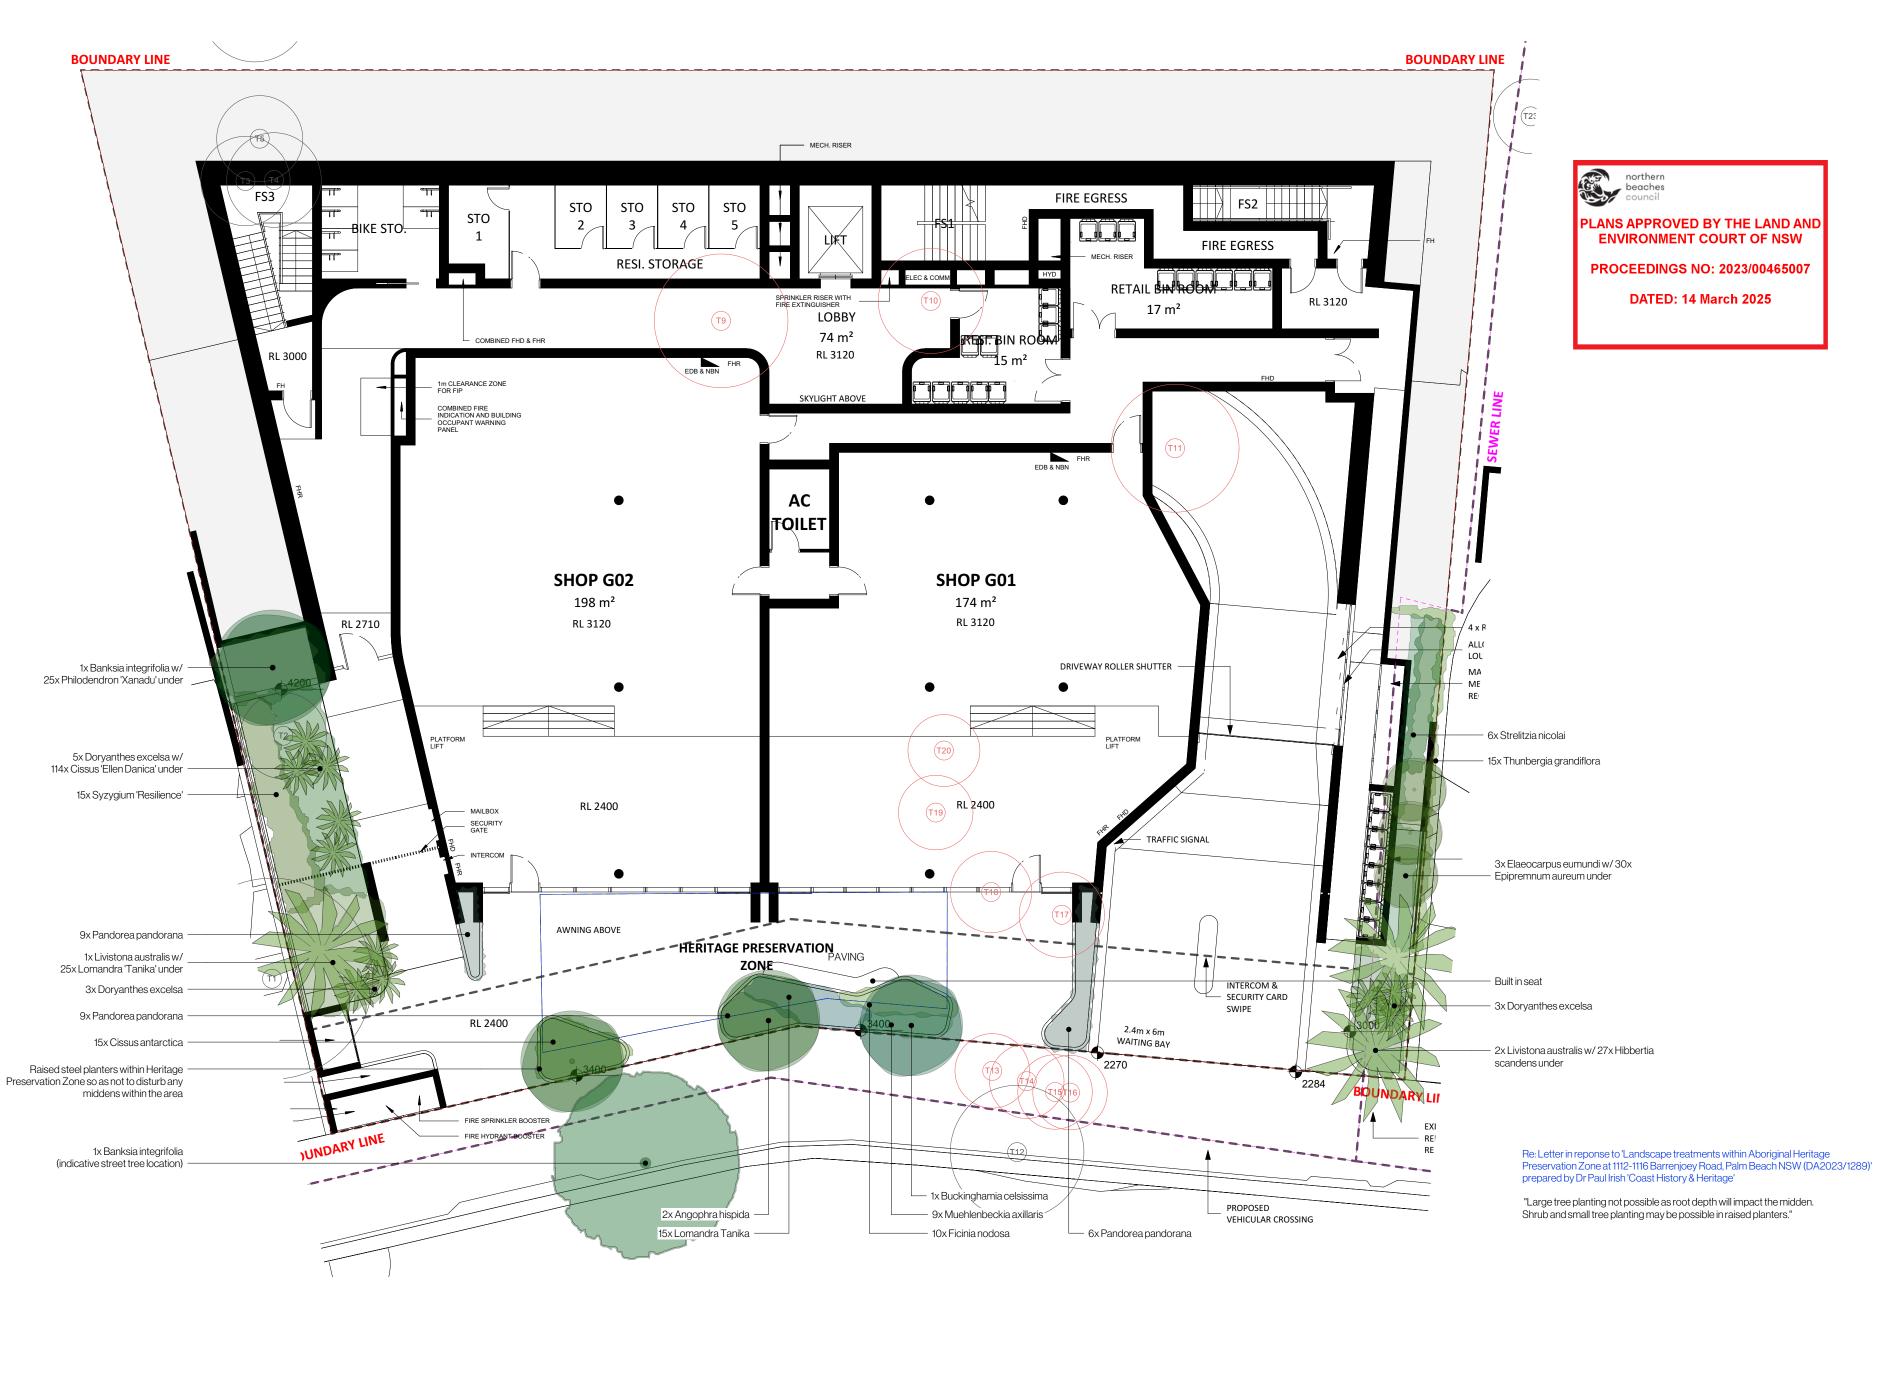


Figure dimensions shall take precendence over scale. Contractors must verify all dimensions on job before commencing any work or making shop drawings. This drawing is protected by copyright.

awing

Client: IPM Palm Beach Project Address: 1112-1118 Barrenjoey RD Palm Beach, NSW 2108 Dwg no: LP02-D7621 Title: S34 Ground Landscape Drawn by: FD/EF Issue: 01 Checked: WD Revision: N Scale: 1:125@ A2 Date: 06.08.2024 Landscape Design Sydney 53 Cranbrook St, Botany T (02) 9316 9044 F (02) 9316 9055

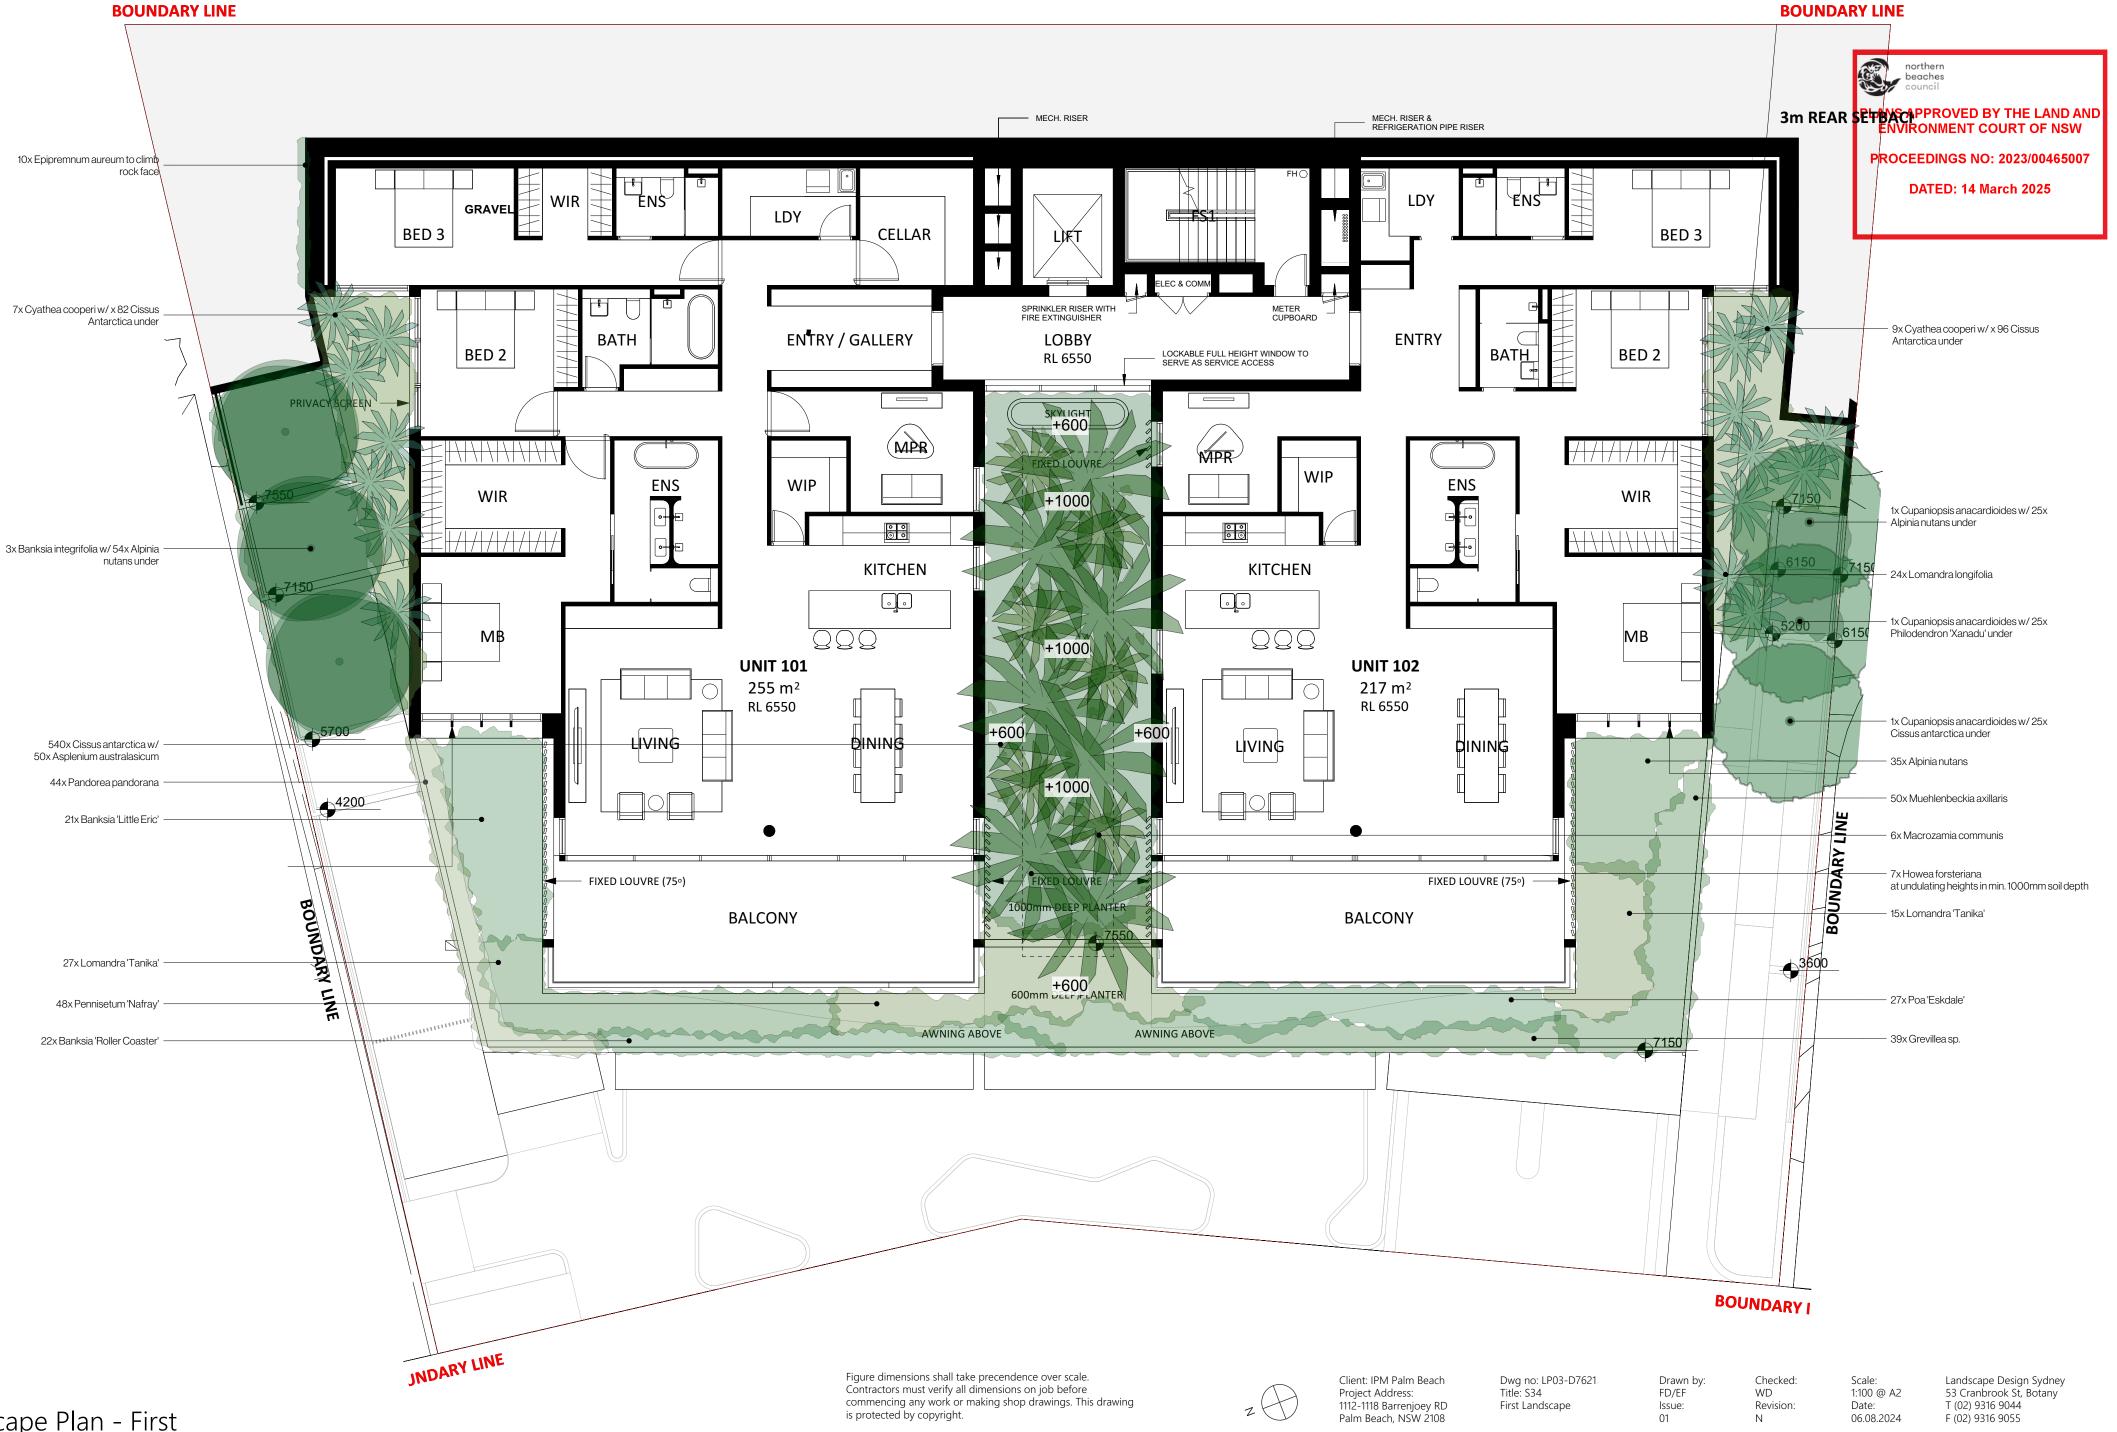

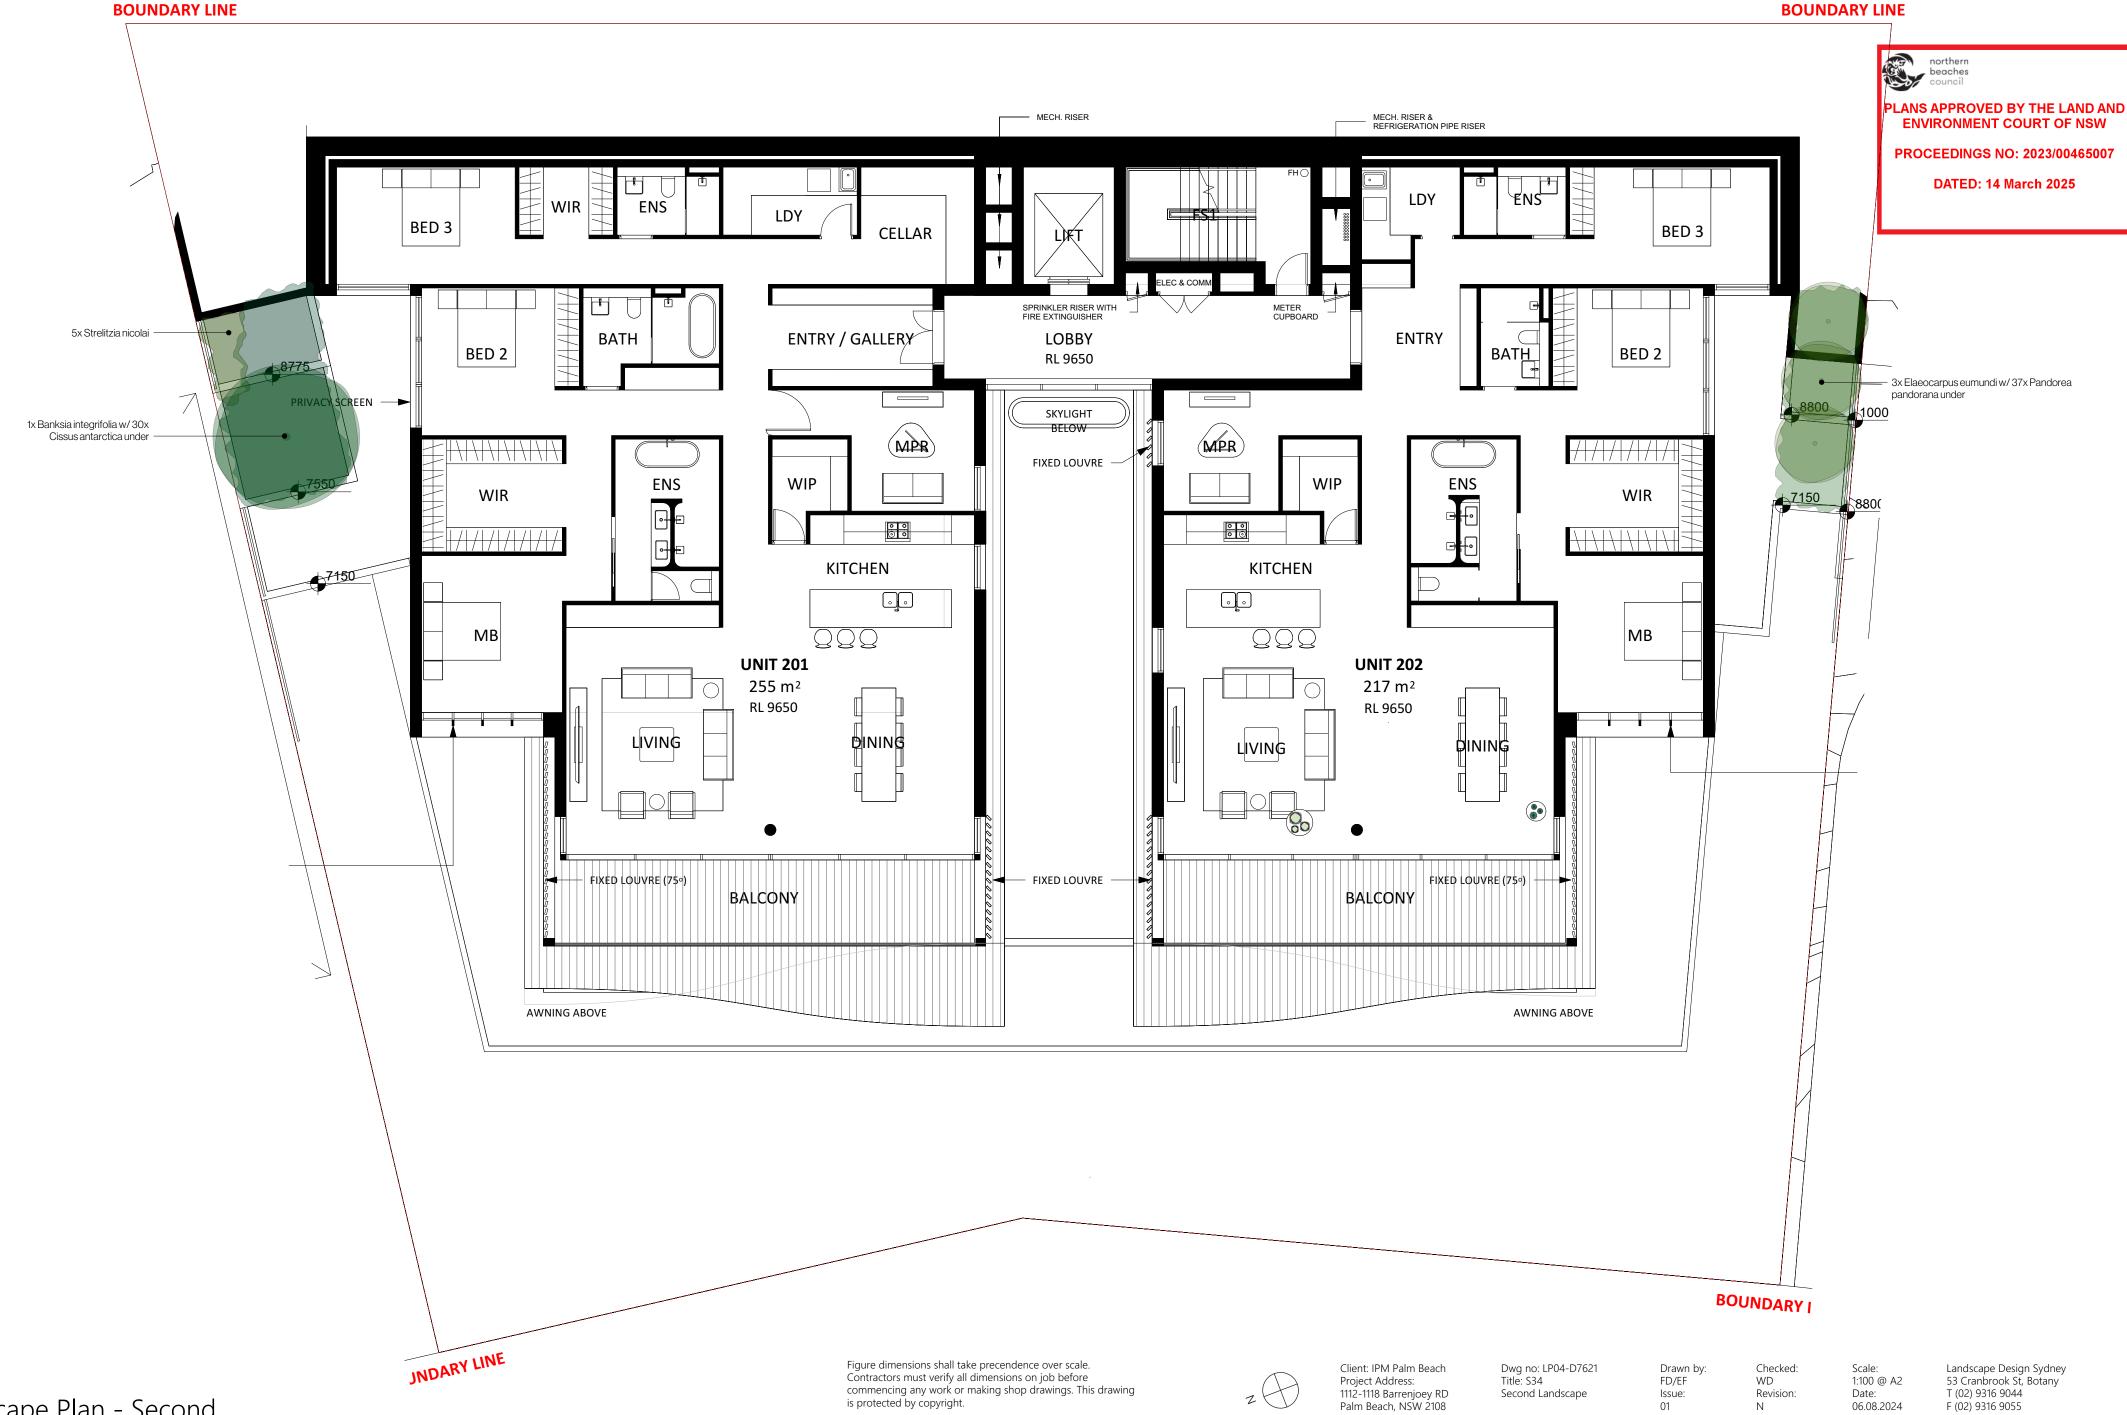

+11





1112-1118 Barrenjoey RD Palm Beach, NSW 2108


01

Ν

T (02) 9316 9044 F (02) 9316 9055

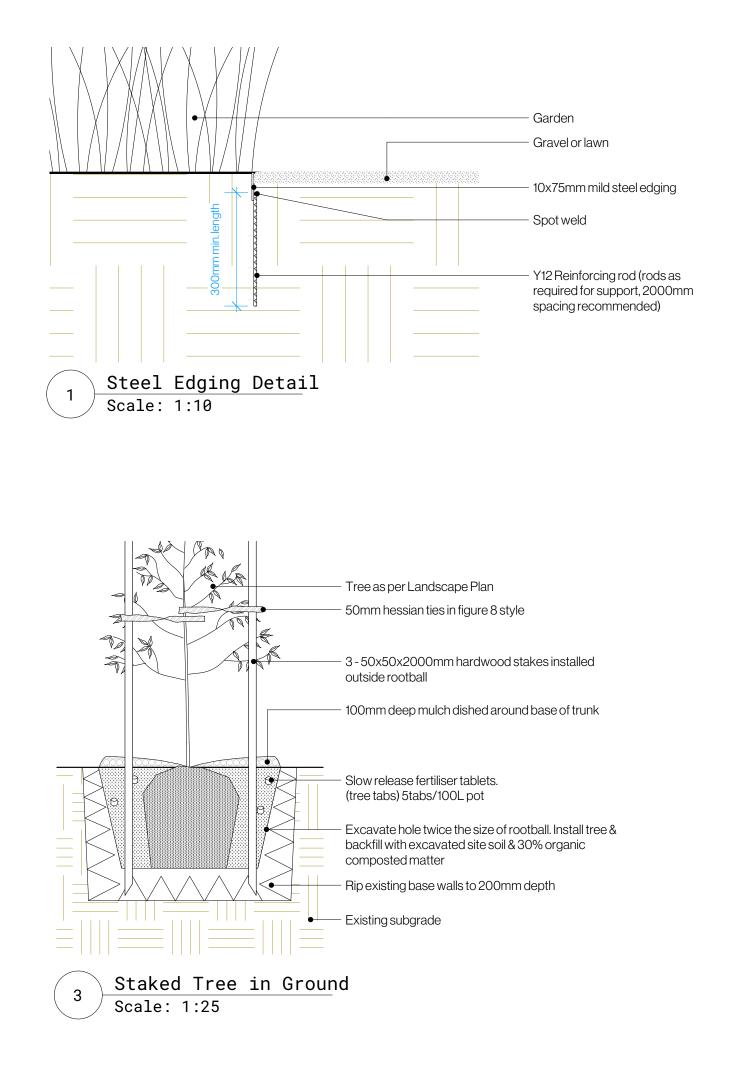

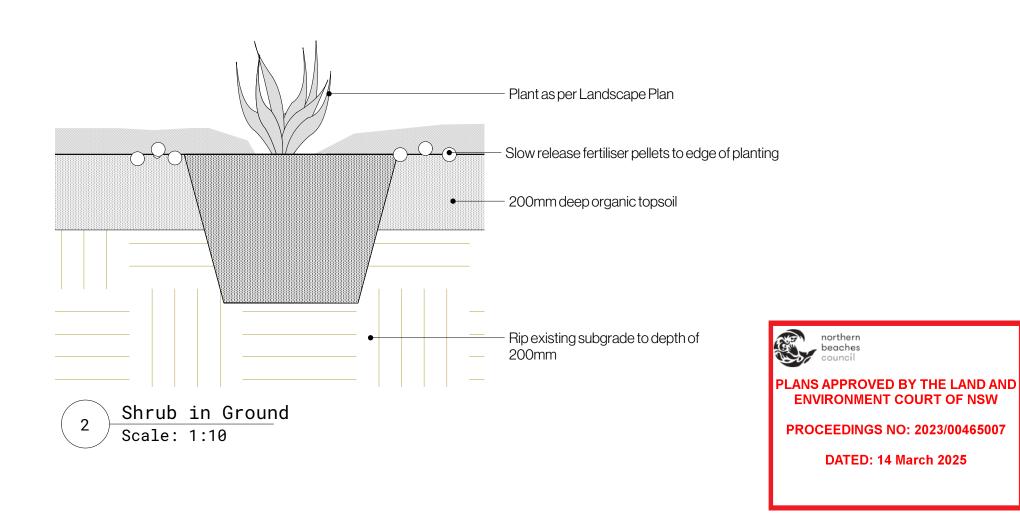

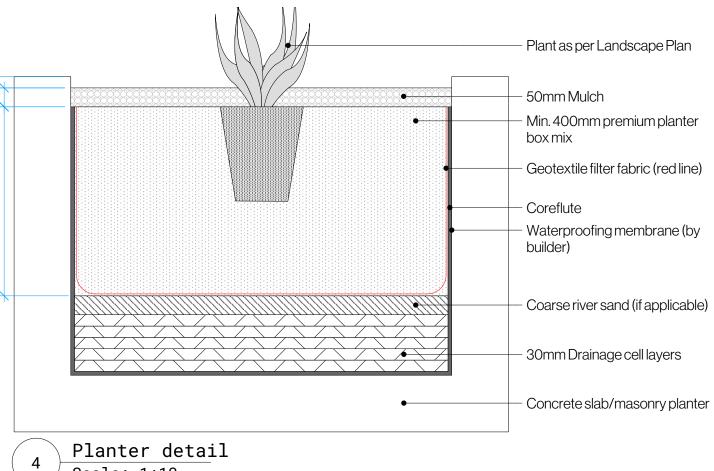

Scale: 1:10

21


Client: IPM Palm Beach Project Address: 1112-1118 Barrenjoey RD Palm Beach, NSW 2108 Dwg no: LP07-D7621 Title: S34 Details

Drawn by: FD/EF Issue: 01

Checked: WD Revision: Ν

Scale: 1:150 @ A2 Date: 06.08.2024

Landscape Design Sydney 53 Cranbrook St, Botany T (02) 9316 9044 F (02) 9316 9055

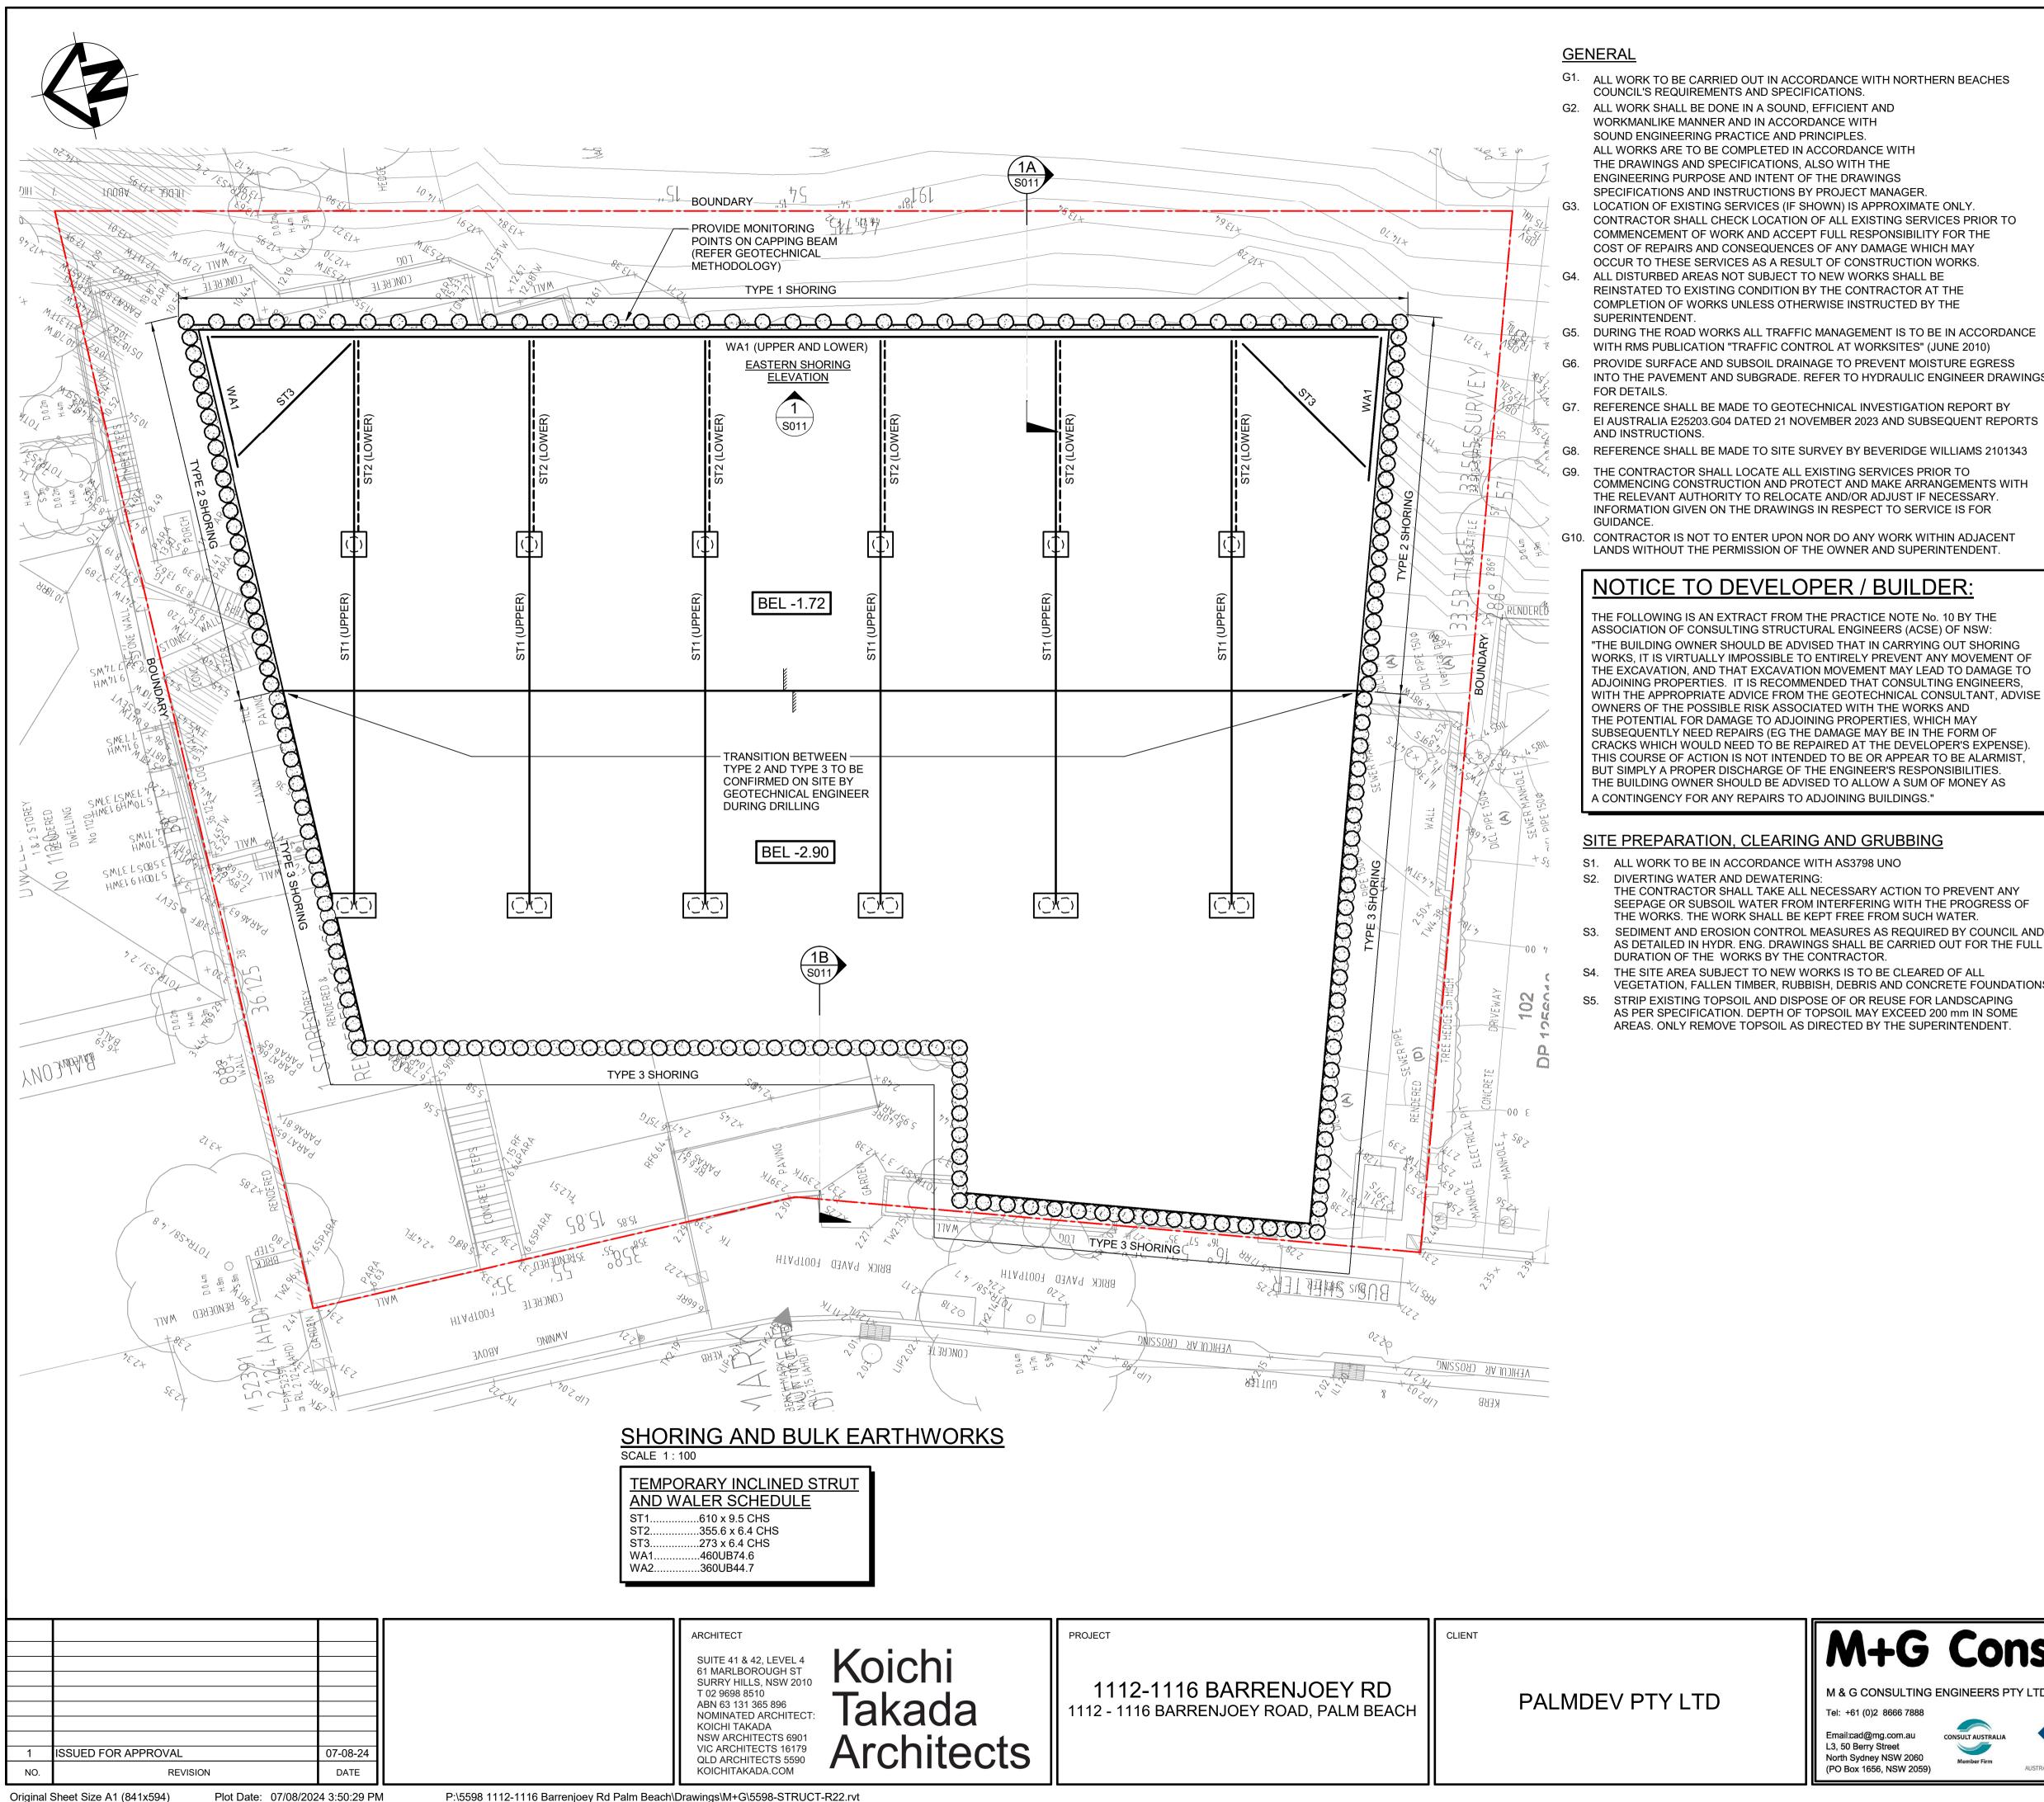

Plot Date: 07/08/2024 3:50:29 PM P:\5598 1112-1116 Barrenjoey Rd Palm Beach\Drawings\M+G\5598-STRUCT-R22.rvt


NBEACHES	E1. ALL WORK TO BE IN ACCORDANCE WITH AS3798-2007 AND COUNCIL REQUIREMENTS.
	E2. IN CUT AREAS:- CUT TO LEVEL OF TOP OF SUBGRADE. REPLACE SOFT AREAS. TOP 200 OF SUBGRADE TO BE COMPACTED TO 100% STANDARD, AS PER
	FILLING NOTES UNO.
	E3. IN FILL AREAS:- REPLACE SOFT AREAS, PLACE AND COMPACT NEW FILL IN 200mm MAX.
ILY.	THICK LAYERS (LOOSE FILL), AT MOISTURE CONTENT IN RANGE OF ± 2% OF STANDARD OPTIMUM (AS PER AS1289.5) AND COMPACT TO A RANGE BETWEEN
S PRIOR TO R THE	98% AND 102% OF STANDARD DRY DENSITY RATIO AS PER AS1289.5 TEST COMPACTED FILL UNO. TOP 200 OF SUB GRADE TO BE COMPACTED TO 100%
1AY RKS.	STANDARD DRY DENSITY RATIO UNO.
E	E4. FILL MATERIAL- TO BE AS SPECIFIED IN AS3798-2007 CLAUSE 4.4 AND AS AGREED WITH THE SITE SUPERINTENDENT.
	EARTHWORKS WHERE IN ROCK
E 2010) RE EGRESS	EARTHWORKS WITH AS3798 UNO.
NEER DRAWINGS	E2. CUT TO LEVEL OF TOP OF SUBGRADE PLUS THICKNESS OF GRANULAR LAYER. SUBGRADE PREPARATION TO SUIT REQUIREMENTS OF PILING CONTRACTOR'S EQUIPMENT. BULK EXCAVATION LEVELS SHOWN INCLUDE ANY TOP LAYERS
JENT REPORTS	REPLACED TO CREATE WORKING PLATFORM FOR PILING RIG. TOP LAYER SHALL BE COMPACTED GRANULAR MATERIAL.
AMS 2101343	E3. FOLLOWING COMPLETION OF PILING WORKS AND PRIOR TO CONSTRUCTION OF BASEMENT SLAB, GEOTECHNICAL INSPECTION AND COMPACTION WILL BE REQUIRED.
EMENTS WITH ESSARY.	E4. REFER GEOTECHNICAL REPORT: EI AUSTRALIA E25203.G04 DATED 21 NOVEMBER 2023 AND SUBSEQUENT REPORTS
S FOR	AND INSTRUCTIONS.
ADJACENT NDENT.	E5. DETAILED, ON-GOING INSPECTION BY AN EXPERIENCED GEOTECH ENGINEER OF ANY EXCAVATED ROCK FACES.
२:	NOTE:
BY THE	1. SHORING WALL TO BE CONSTRUCTED IN A STAGED MANNER SO THAT
⁻ NSW: JT SHORING	THE TEMPORARY EXCAVATION IS STABLE AT ALL TIMES. 2. STAGING OF EXCAVATION TO BE REVIEWED BY GEOTECHNICAL ENGINEER.
OVEMENT OF D DAMAGE TO	 NO EXCAVATION BELOW 500 BELOW TEMPORARY ANCHOR LOCATION UNTIL TEMPORARY ANCHOR HAS BEEN FULLY STRESSED AND APPROVED.
ENGINEERS, JLTANT, ADVISE	
	/ SLAB ON GROUND
ORM OF R'S EXPENSE).	
BILITIES.	
BILITIES.	• <u>SSL</u>
BILITIES.	•
BILITIES.	•
BILITIES. IONEY AS	OND ON
BILITIES. IONEY AS REVENT ANY PROGRESS OF	
BILITIES. ONEY AS EVENT ANY ROGRESS OF TER. BY COUNCIL AND	•
BILITIES. ONEY AS EVENT ANY ROGRESS OF FER. BY COUNCIL AND T FOR THE FULL	
BILITIES. IONEY AS REVENT ANY PROGRESS OF TER. BY COUNCIL AND T FOR THE FULL F ALL	OND OP 100 BLINDING CONCRETE
BILITIES. IONEY AS REVENT ANY PROGRESS OF TER. BY COUNCIL AND T FOR THE FULL F ALL TE FOUNDATIONS. DSCAPING	(0) 0) 0) 0) 0) 0) 0) 0) 0) 0)
BILITIES. MONEY AS REVENT ANY PROGRESS OF TER. BY COUNCIL AND IT FOR THE FULL OF ALL TE FOUNDATIONS. IDSCAPING nm IN SOME	ONDO ODDO ODDO ODDO ODDO ODDO ODDO ODDO
BE ALARMIST, IBILITIES. MONEY AS PROGRESS OF TER. BY COUNCIL AND IT FOR THE FULL OF ALL TE FOUNDATIONS. IDSCAPING mm IN SOME NTENDENT.	DUINDING BLINDING CONCRETE LAYER TYPICAL BULK EXCAVATION DETAIL
BILITIES. ONEY AS EVENT ANY ROGRESS OF FER. BY COUNCIL AND T FOR THE FULL F ALL F ALL F ALL F ALL F ALL TE FOUNDATIONS. DSCAPING IM IN SOME	DUINDING BLINDING CONCRETE LAYER TYPICAL BULK EXCAVATION DETAIL
BILITIES. IONEY AS REVENT ANY ROGRESS OF TER. BY COUNCIL AND T FOR THE FULL F ALL FE FOUNDATIONS. DSCAPING Im IN SOME	DUINDING BLINDING CONCRETE LAYER TYPICAL BULK EXCAVATION DETAIL

1001 council

PLANS APPROVED BY THE LAND AN **ENVIRONMENT COURT OF NSW** PROCEEDINGS NO: 2023/00465007


DATED: 14 March 2025

ISSUED FOR APPROVAL M+G Consulting SHORING & BULK EXCAVATION PLAN DATE SCALE DRAWN DESIGNED REVIEWED ZG AUG 2024 AS NOTED RМ ZG CONSULT AUSTRAL JOB NO. DRAWING NO. 5598 Member of AUSTRALIAN STEEL INSTITUTE Member Firm S010 ISSUE

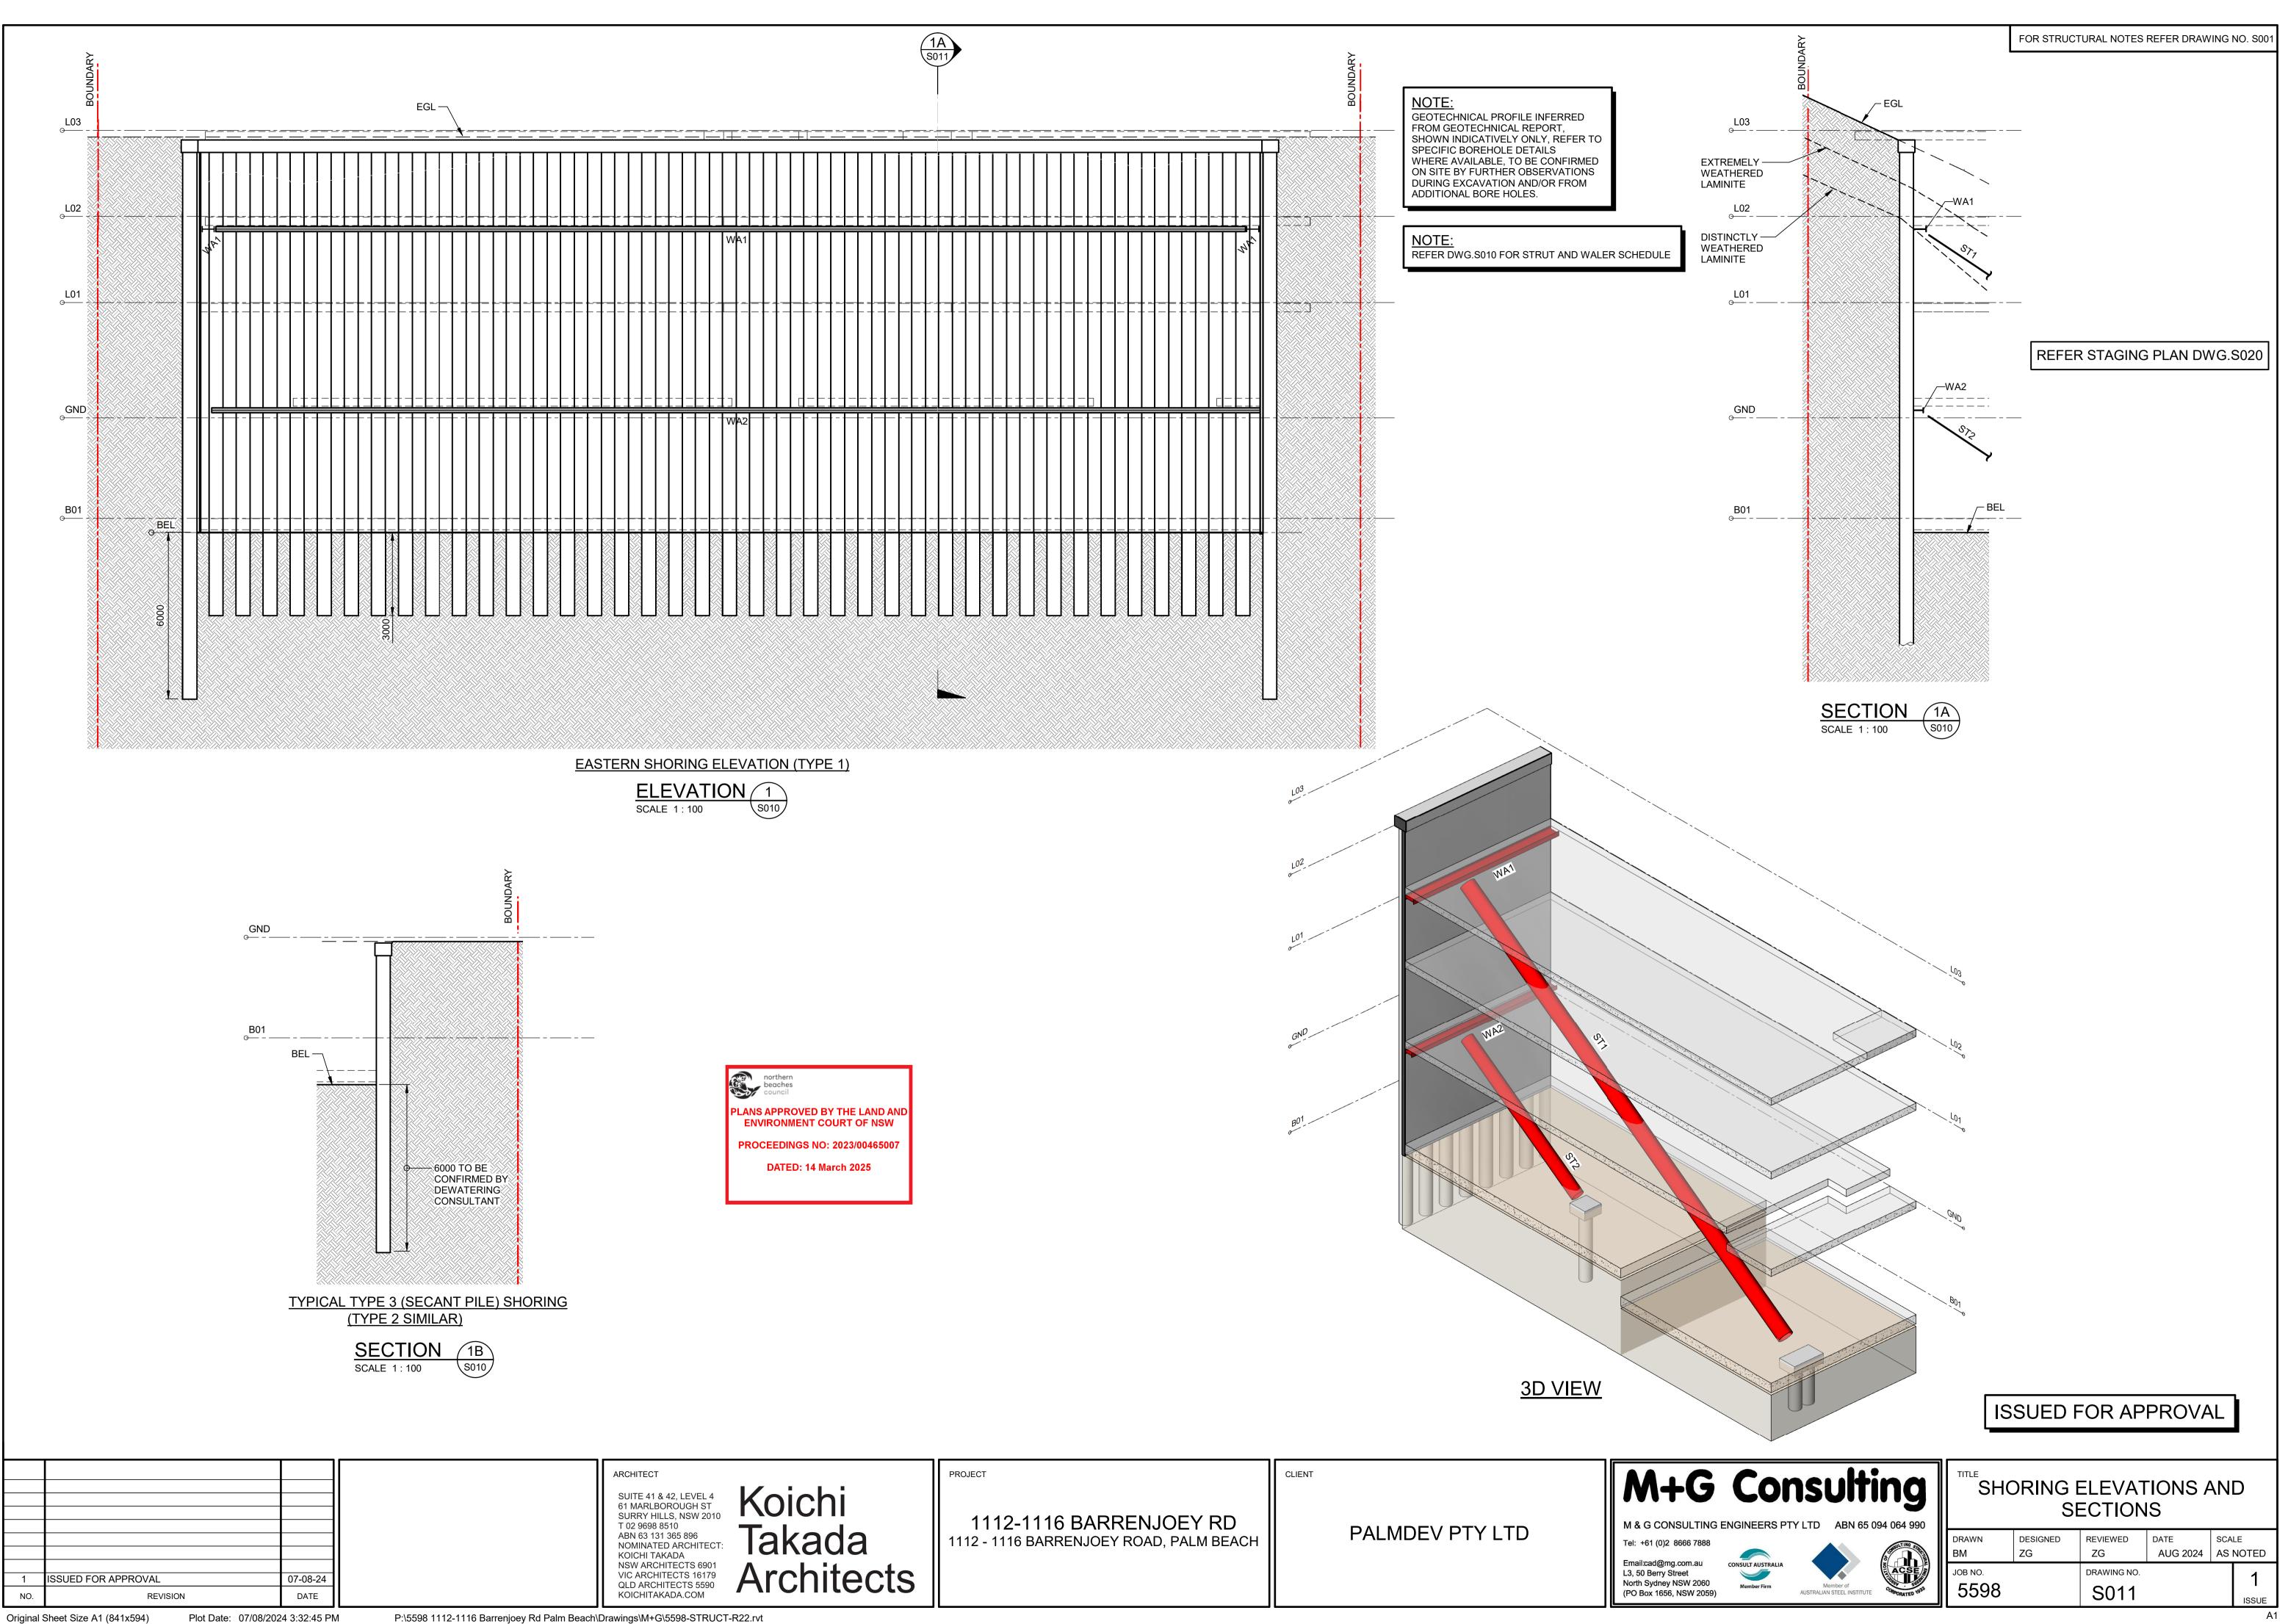

Plot Date: 07/08/2024 3:32:45 PM

1112-1116 BARRENJOEY RD
1112 - 1116 BARRENJOEY ROAD, PALM BEACH

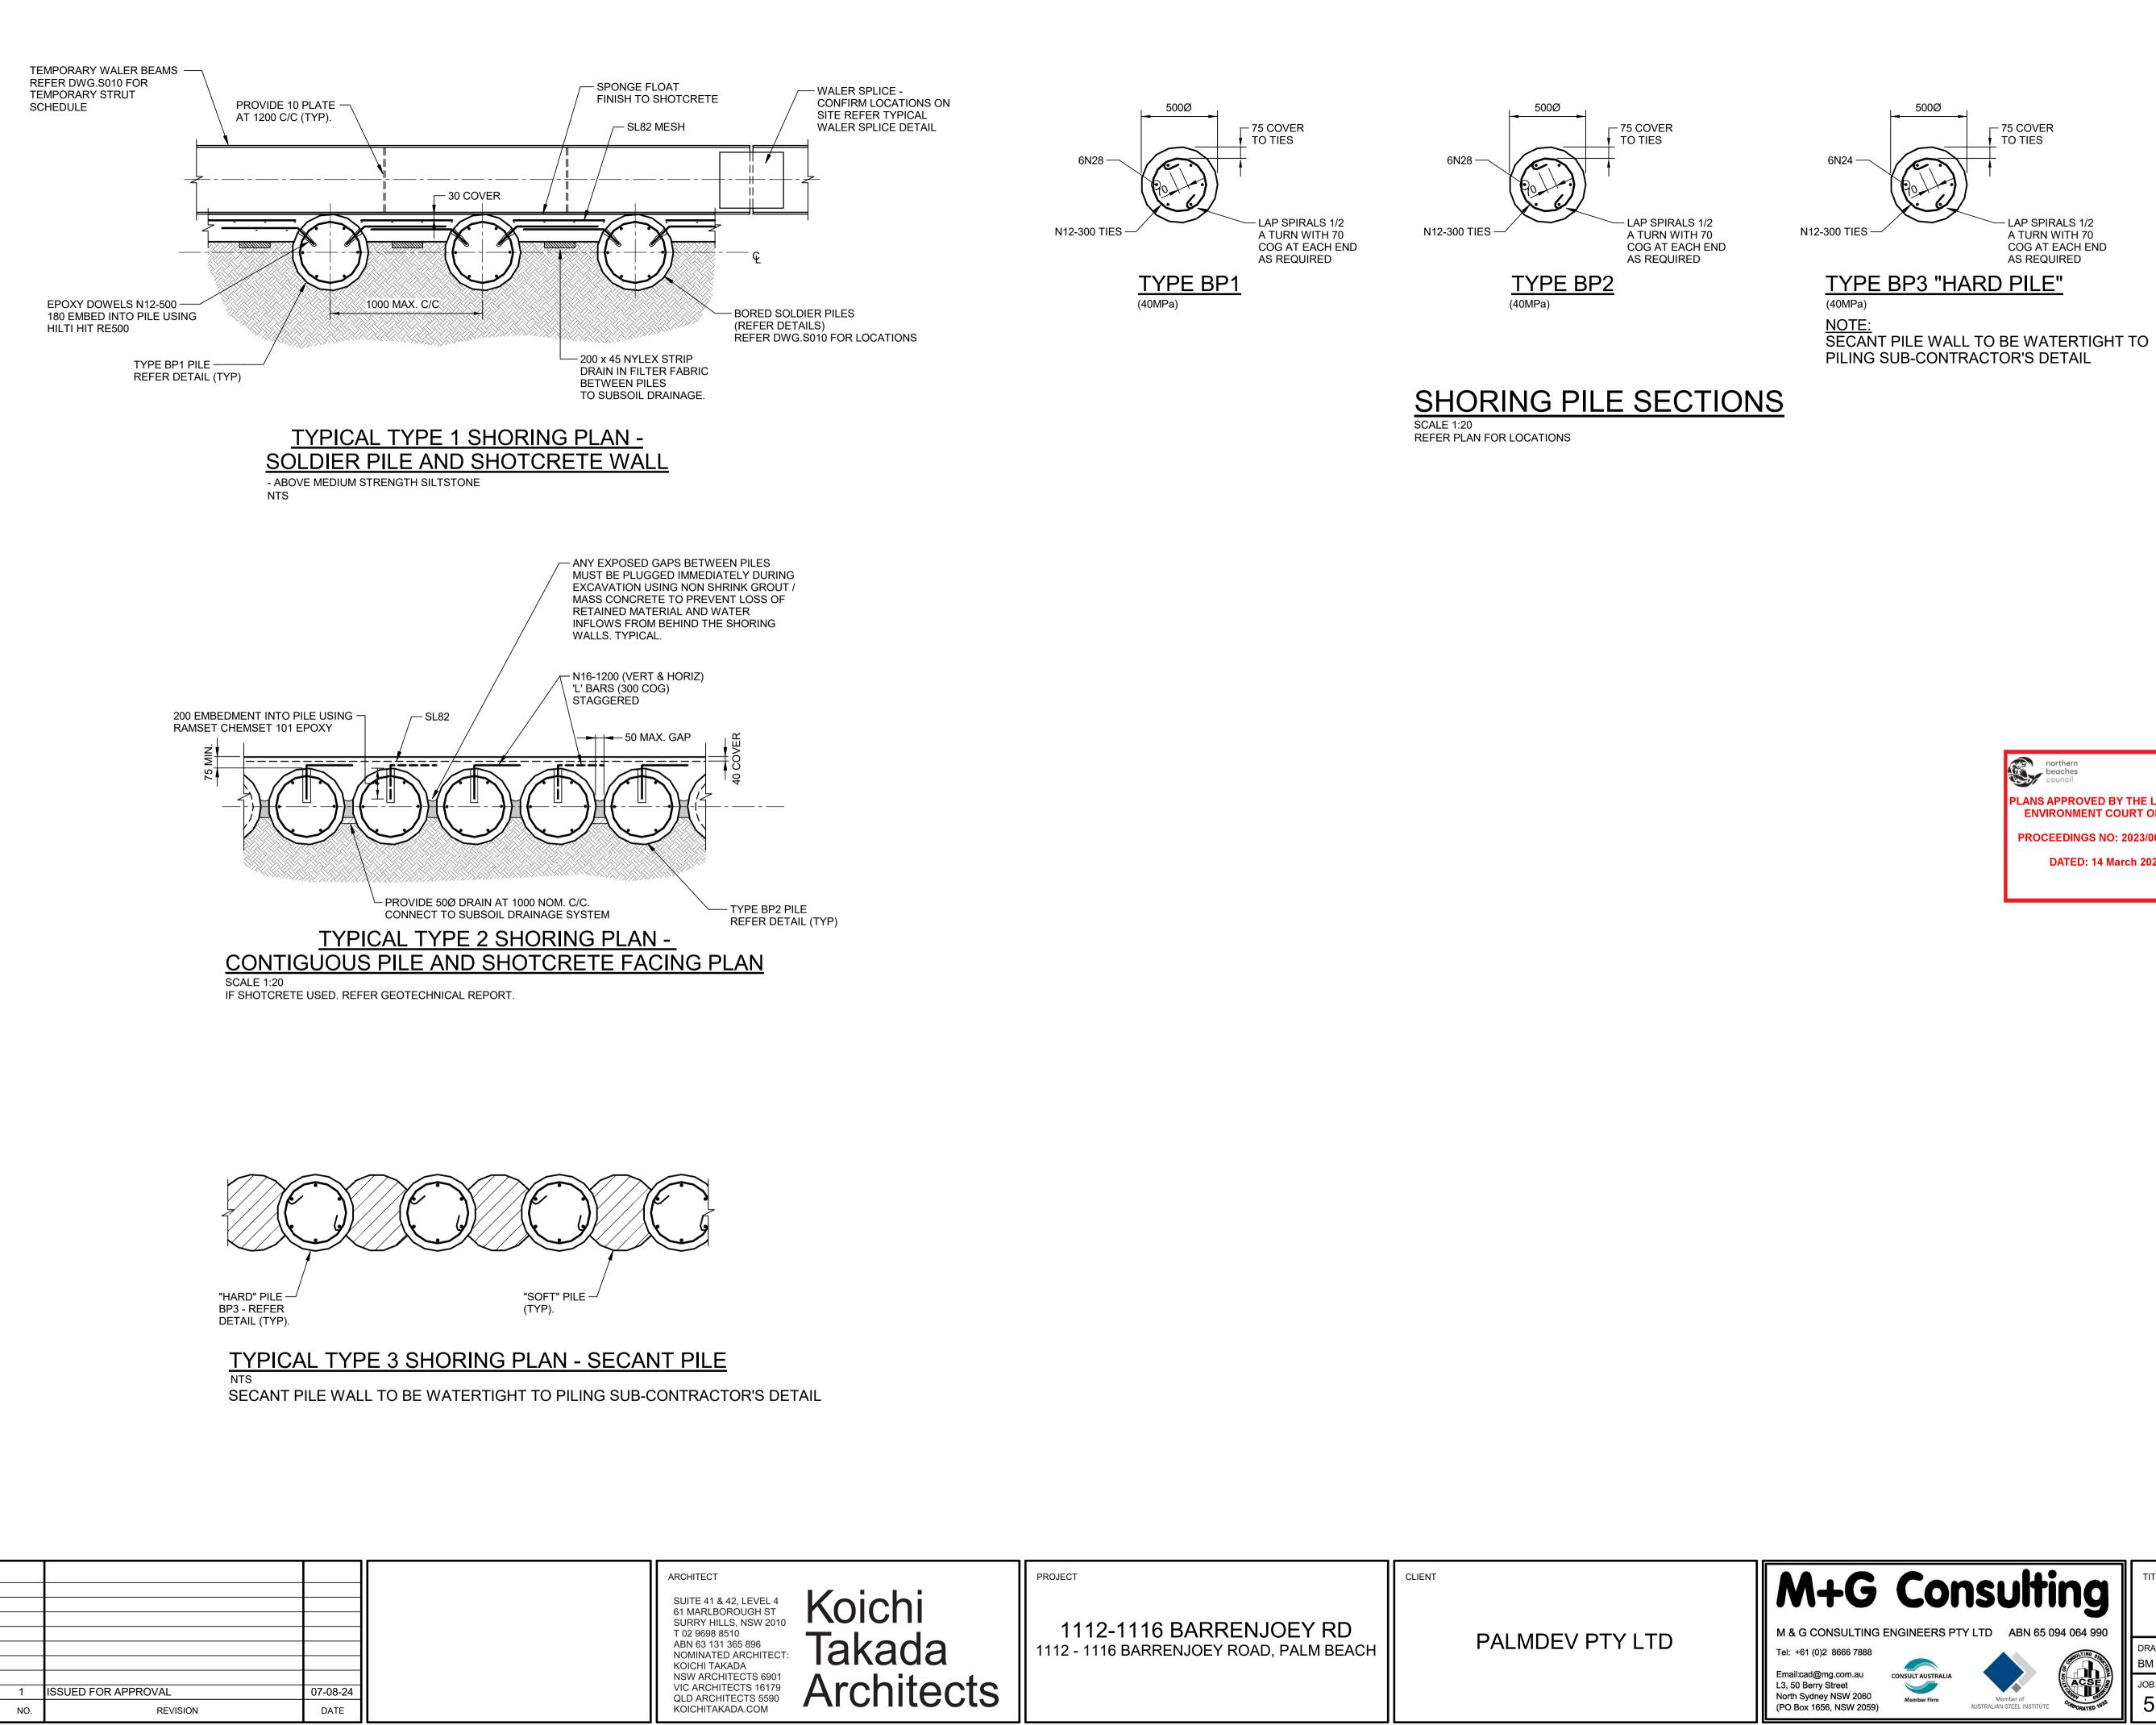

Original Sheet Size A1 (841x594)

FOR STRUCTURAL NOTES REFER DRAWING NO. S001

PLANS APPROVED BY THE LAND AND ENVIRONMENT COURT OF NSW PROCEEDINGS NO: 2023/00465007


DATED: 14 March 2025

ISSUED FOR APPROVAL

TITLE

SHORING DETAILS DRAWN REVIEWED DATE SCALE DESIGNED BM ZG ZG AUG 2024 AS NOTED JOB NO. DRAWING NO. 5598 S015

ISSUE A1

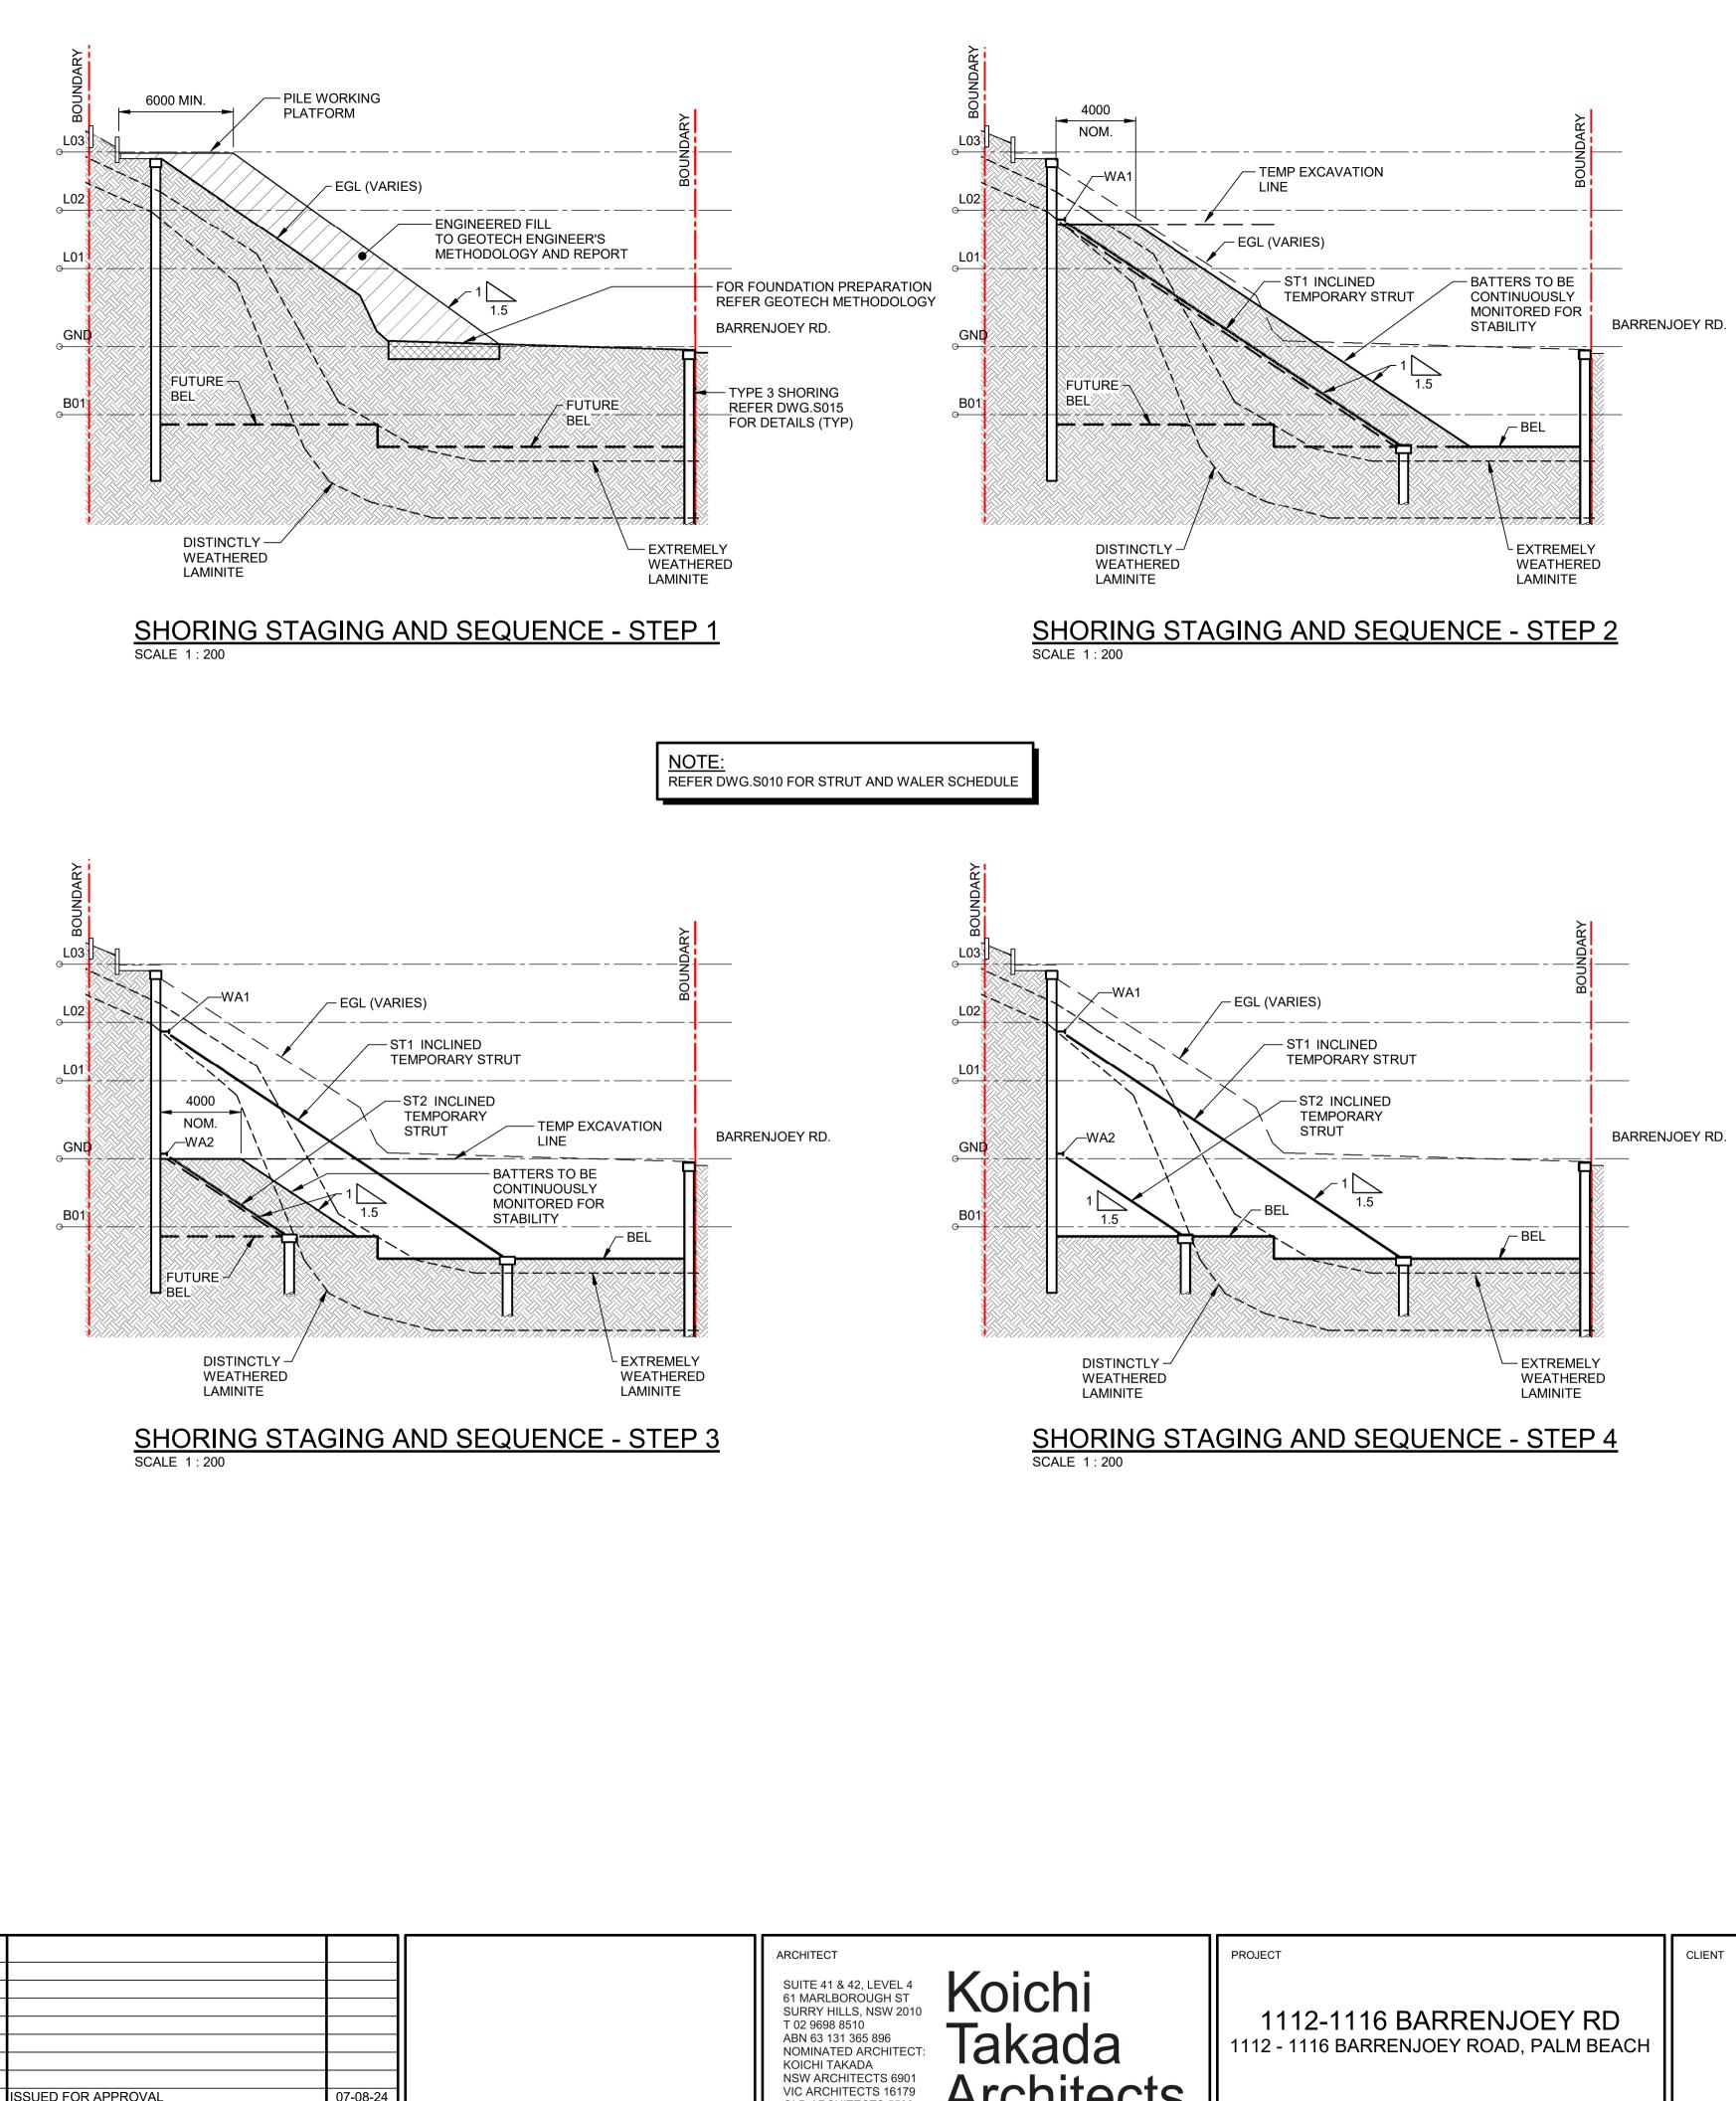

Original Shoot Size A1 (841x504)	Plot Date:	07/08/2024 3:33:16 PM
Original Sheet Size A1 (841x594)	FIOL Date.	07/00/2024 3.33.10 PW

REVISION

07-08-24

DATE


SSUED FOR APPROVAL

1

NO.

P:\5598 1112-1116 Barrenjoey Rd Palm Beach\Drawings\M+G\5598-STRUCT-R22.rvt

QLD ARCHITECTS 5590 KOICHITAKADA.COM

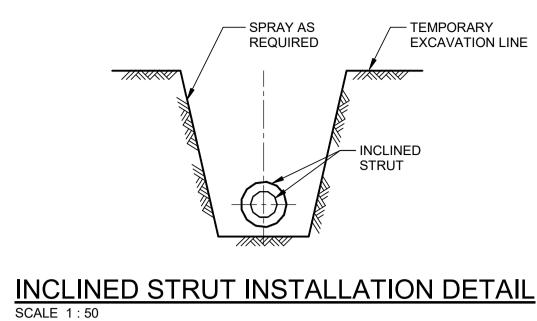

- **STAGING SEQUENCE** I. REMOVE EXISTING STRUCTURES AND RETAINING WALLS WITHIN THE SITE. COMPACT EGL AND BUILD ACCESS PLATFORM FOR THE PILING RIG, IN ACCORDANCE WITH THE REQUIREMENTS AND DETAILS IN THE GEOTECHNICAL METHODOLOGY BY EIA.
- 2. CONSTRUCT PILING AROUND THE FULL PERIMETER OF THE EXCAVATION AS PER THE PLAN.
- 3. REMOVE THE PILING RIG AND COMMENCE PROGRESSIVE EXCAVATION, DOWN TO TEL1 (TEMPORARY EXCAVATION LINE 1). INSTALL WALER BEAMS WA1 AS SPECIFIED. CUT SLOTS IN THE BATTER AS PER DETAIL, INSTALL BASE RESTRAINT PILES AND INSTALL INCLINED STRUTS ST1.
- 4. COMMENCE DEWATERING AS SPECIFIED BY EIA.
- 5. CONTINUE PROGRESSIVE EXCAVATION DOWN TO TEL2. INSTALL WALER BEAMS WA2 AS SPECIFIED, PROVIDE SLOTS AND BASE PILES FOR STRUTS ST2 AND INSTALL ST2 STRUTS.
- 6. COMPLETE EXCAVATION TO BEL AS NOTED.
- 7. PROGRESS BUILDING STRUCTURE TO GF LEVEL INCLUDING HYDROSTATIC SLAB AND WALLS (TANKED BASEMENT) AND GF SLAB.
- 8. ONCE GF SLAB CURED, REMOVE ST2 STRUTS AND WA2 WALERS.
- 9. CONTINUE BUILDING STRUCTURE UP TO L2 INCLUDING L2 SLAB.
- 10. ONCE L3 SLAB SUFFICIENTLY CURED, REMOVE ST1 STRUTS AND WA1 WALERS.
- 11. COMPLETE STRUCTURE TO THE ROOF LEVEL, DEWATERING MAY BE DISCONTINUED.

NOTE:

GEOTECHNICAL PROFILE INFERRED FROM GEOTECHNICAL REPORT, SHOWN INDICATIVELY ONLY, REFER TO SPECIFIC BOREHOLE DETAILS WHERE AVAILABLE, TO BE CONFIRMED ON SITE BY FURTHER OBSERVATIONS DURING EXCAVATION AND/OR FROM ADDITIONAL BORE HOLES.

Koichi	PROJECT	CLIENT	M+G
Takada	1112-1116 BARRENJOEY RD 1112 - 1116 BARRENJOEY ROAD, PALM BEACH	PALMDEV PTY LTD	M & G CONSULTING EN Tel: +61 (0)2 8666 7888
Architects			Email:cad@mg.com.au c L3, 50 Berry Street North Sydney NSW 2060 (PO Box 1656, NSW 2059)

northern beaches council

PLANS APPROVED BY THE LAND ANI ENVIRONMENT COURT OF NSW

PROCEEDINGS NO: 2023/00465007

DATED: 14 March 2025

ISSUED FOR APPROVAL




Member Firm

TITLE

SHORING STAGING AND SEQUENCE


DRAWN	DESIGNED	REVIEWED	DATE	SCA	LE
BM	ZG	ZG	AUG 2024	AS	NOTED
JOB NO.		DRAWING NO.			1
5598		S020			I
0000		0020			ISSUE

- WHERE POSSIBLE DRAINAGE LINES SHALL BE LAID IN AREAS PREVIOUSLY DISTURBED BY OTHER SITE WORKS AND FOLLOW TOPOGRAPHICAL FEATURES TO REDUCE IMPACT AND AVOID TREE ROOTS THIS STORMWATER MANAGEMENT PLAN HAS BEEN PREPARED FOR SUBMISSION TO COUNCIL/CERTIFEIR AND DOES NOT NECESSARILY CONTAIN ALL APPROPRIATE INFORMATION TO ENABLE FOR ISSUE TO PLUMBER/BUILDER FOR CONSTRUCTION. CONTACT TAYLOR CONSULTING FOR MORE INFORMATION.
- PLUMBING AND DRAINAGE WORKS TO COMPLY WITH AS-3500, THE NATIONAL DRAINAGE & PLUMBING CODE.
- MAKE GOOD ALL DISTURBED AREAS. STORMWATER SYSTEM REQUIRES SIGNIFICANT MAINTENANCE DUE TO POTENTIAL HIGH POLLUTANT LOAD. FILTERS AND POLLUTANT TRAPS SHOULD BE CHECKED AFTER LARGE STORM EVENTS AND CLEANED EVERY 6 MONTHS.
- CONSTRUCTION WORKS. CONTRACTOR SHALL ENSURE THAT SERVICES TO BUILDINGS NOT AFFECTED BY THE WORKS ARE NOT DISRUPTED. CONTRACTOR SHALL CONSTRUCT TEMPORARY SERVICES TO MAINTAIN EXISTING SUPPLY TO BUILDINGS WHERE REQUIRED. ONCE WORKS ARE COMPLETE AND COMMISSIONED THE CONTRACTOR SHALL REMOVE ALL TEMPORARY SERVICES AND
- ATTACHED TO UNDERSIDE OF STRUCTURE AT 600mm c/c AS NECESSARY PIPE ROUTES SHOWN ARE INDICATIVE ONLY AND SHOULD BE AS NECESSARY ACCORDING TO SITE CONDITIONS, TREE POSITIONS ETC. CONFIRM SIGNIFICANT CHANGES IN PIPES SYSTEM DETAILS WITH SUPERVISING ENGINEER PRIOR TO COMMENCEMENT OF DRAINAGE
- ALL PIPES TO BE LAID ON COMPACTED FINE CRUSHED ROCK OR SAND BEDDING 75mm THICK & PIPES BACKFILLED WITH COMPACTED SAND TO 300mm ABOVE TOP OF PIPE, ELSE
- APPROVED PRE-CAST PITS MAY BE USED.
- PIT BENCHING TO BE HALF THE OUTGOING PIPE DIAMETER. CONCRETE FOR BENCHING TO BE 20 MPa MASS CONCRETE.
- REMOVE REDUNDANT DRAINAGE PITS AND SEAL PIPES.
- ENGINEER) DURING CONSTRUCTION TO ENABLE FULL CERTIFICATION UPON COMPLETION OF WORKS ALL CONSTRUCTION OF COUNCIL DRAINAGE WORKS TO COMPLY WITH COUNCIL STANDARD.
- CONSTRUCTION DETAILS. INSPECTIONS MUST BE UNDERTAKEN BY THIS OFFICE (BY PRIOR ARRANGEMENT WITH
- ALL STORMWATER PIPES TO HAVE SOLVENT CEMENT WATERTIGHT JOINTS. CHECK & LOCATE DEPTH OF EXISTING MAINS & SERVICES PRIOR TO CONSTRUCTION OF STORMWATER SYSTEM AS VARIATIONS IN POSITION OF MAINS COULD AFFECT DRAINAGE
- SURFACE GRATES 300 SQ. UNLESS OTHERWISE NOTED.
- SUB-SOIL DRAINAGE TO BE CONNECTED TO THE SITE DRAINAGE SYSTEM AS NECESSARY.
- FALL STORMWATER PIPES AT 1% MIN. UNLESS OTHERWISE NOTED.
- + DENOTES EXISTING GROUND LEVEL
- DRAINAGE NOTES

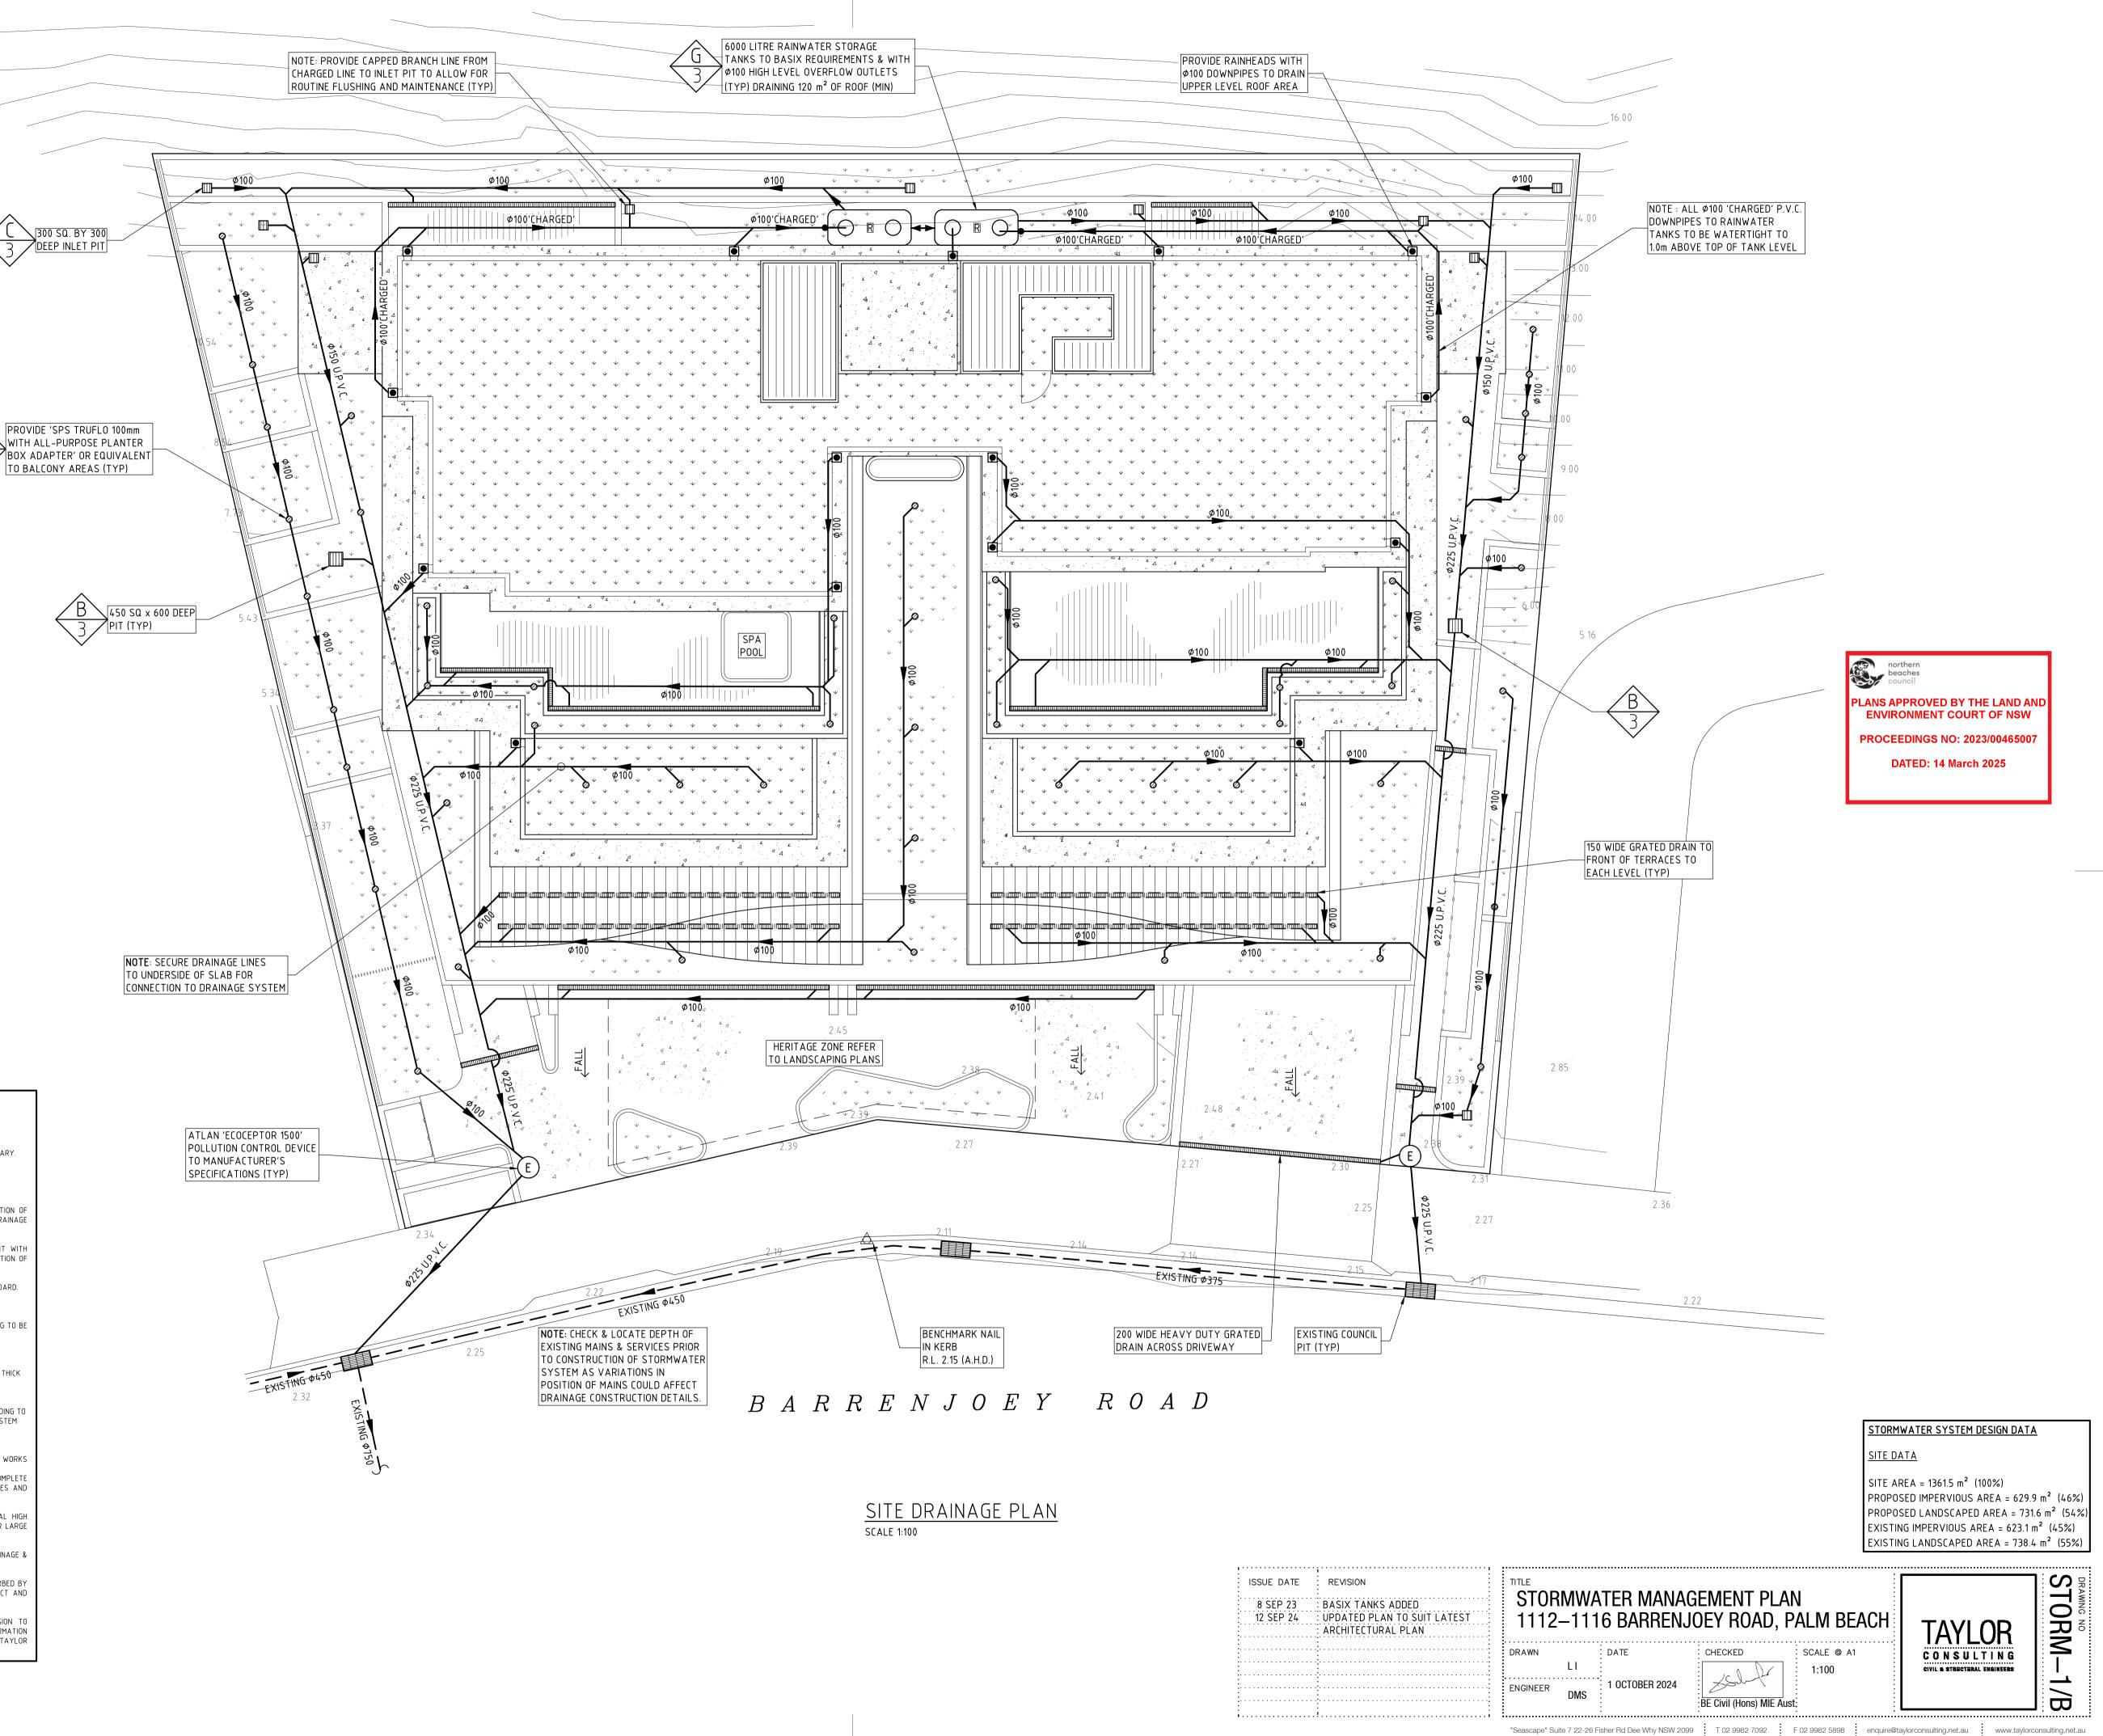

SCALE	1:100	


ISSUE DATE	REVISION
	BASIX TANKS ADDED UPDATED PLAN TO SUIT LATEST ARCHITECTURAL PLAN
· · · · · · · · · · · · · · · · · · ·	
	ii

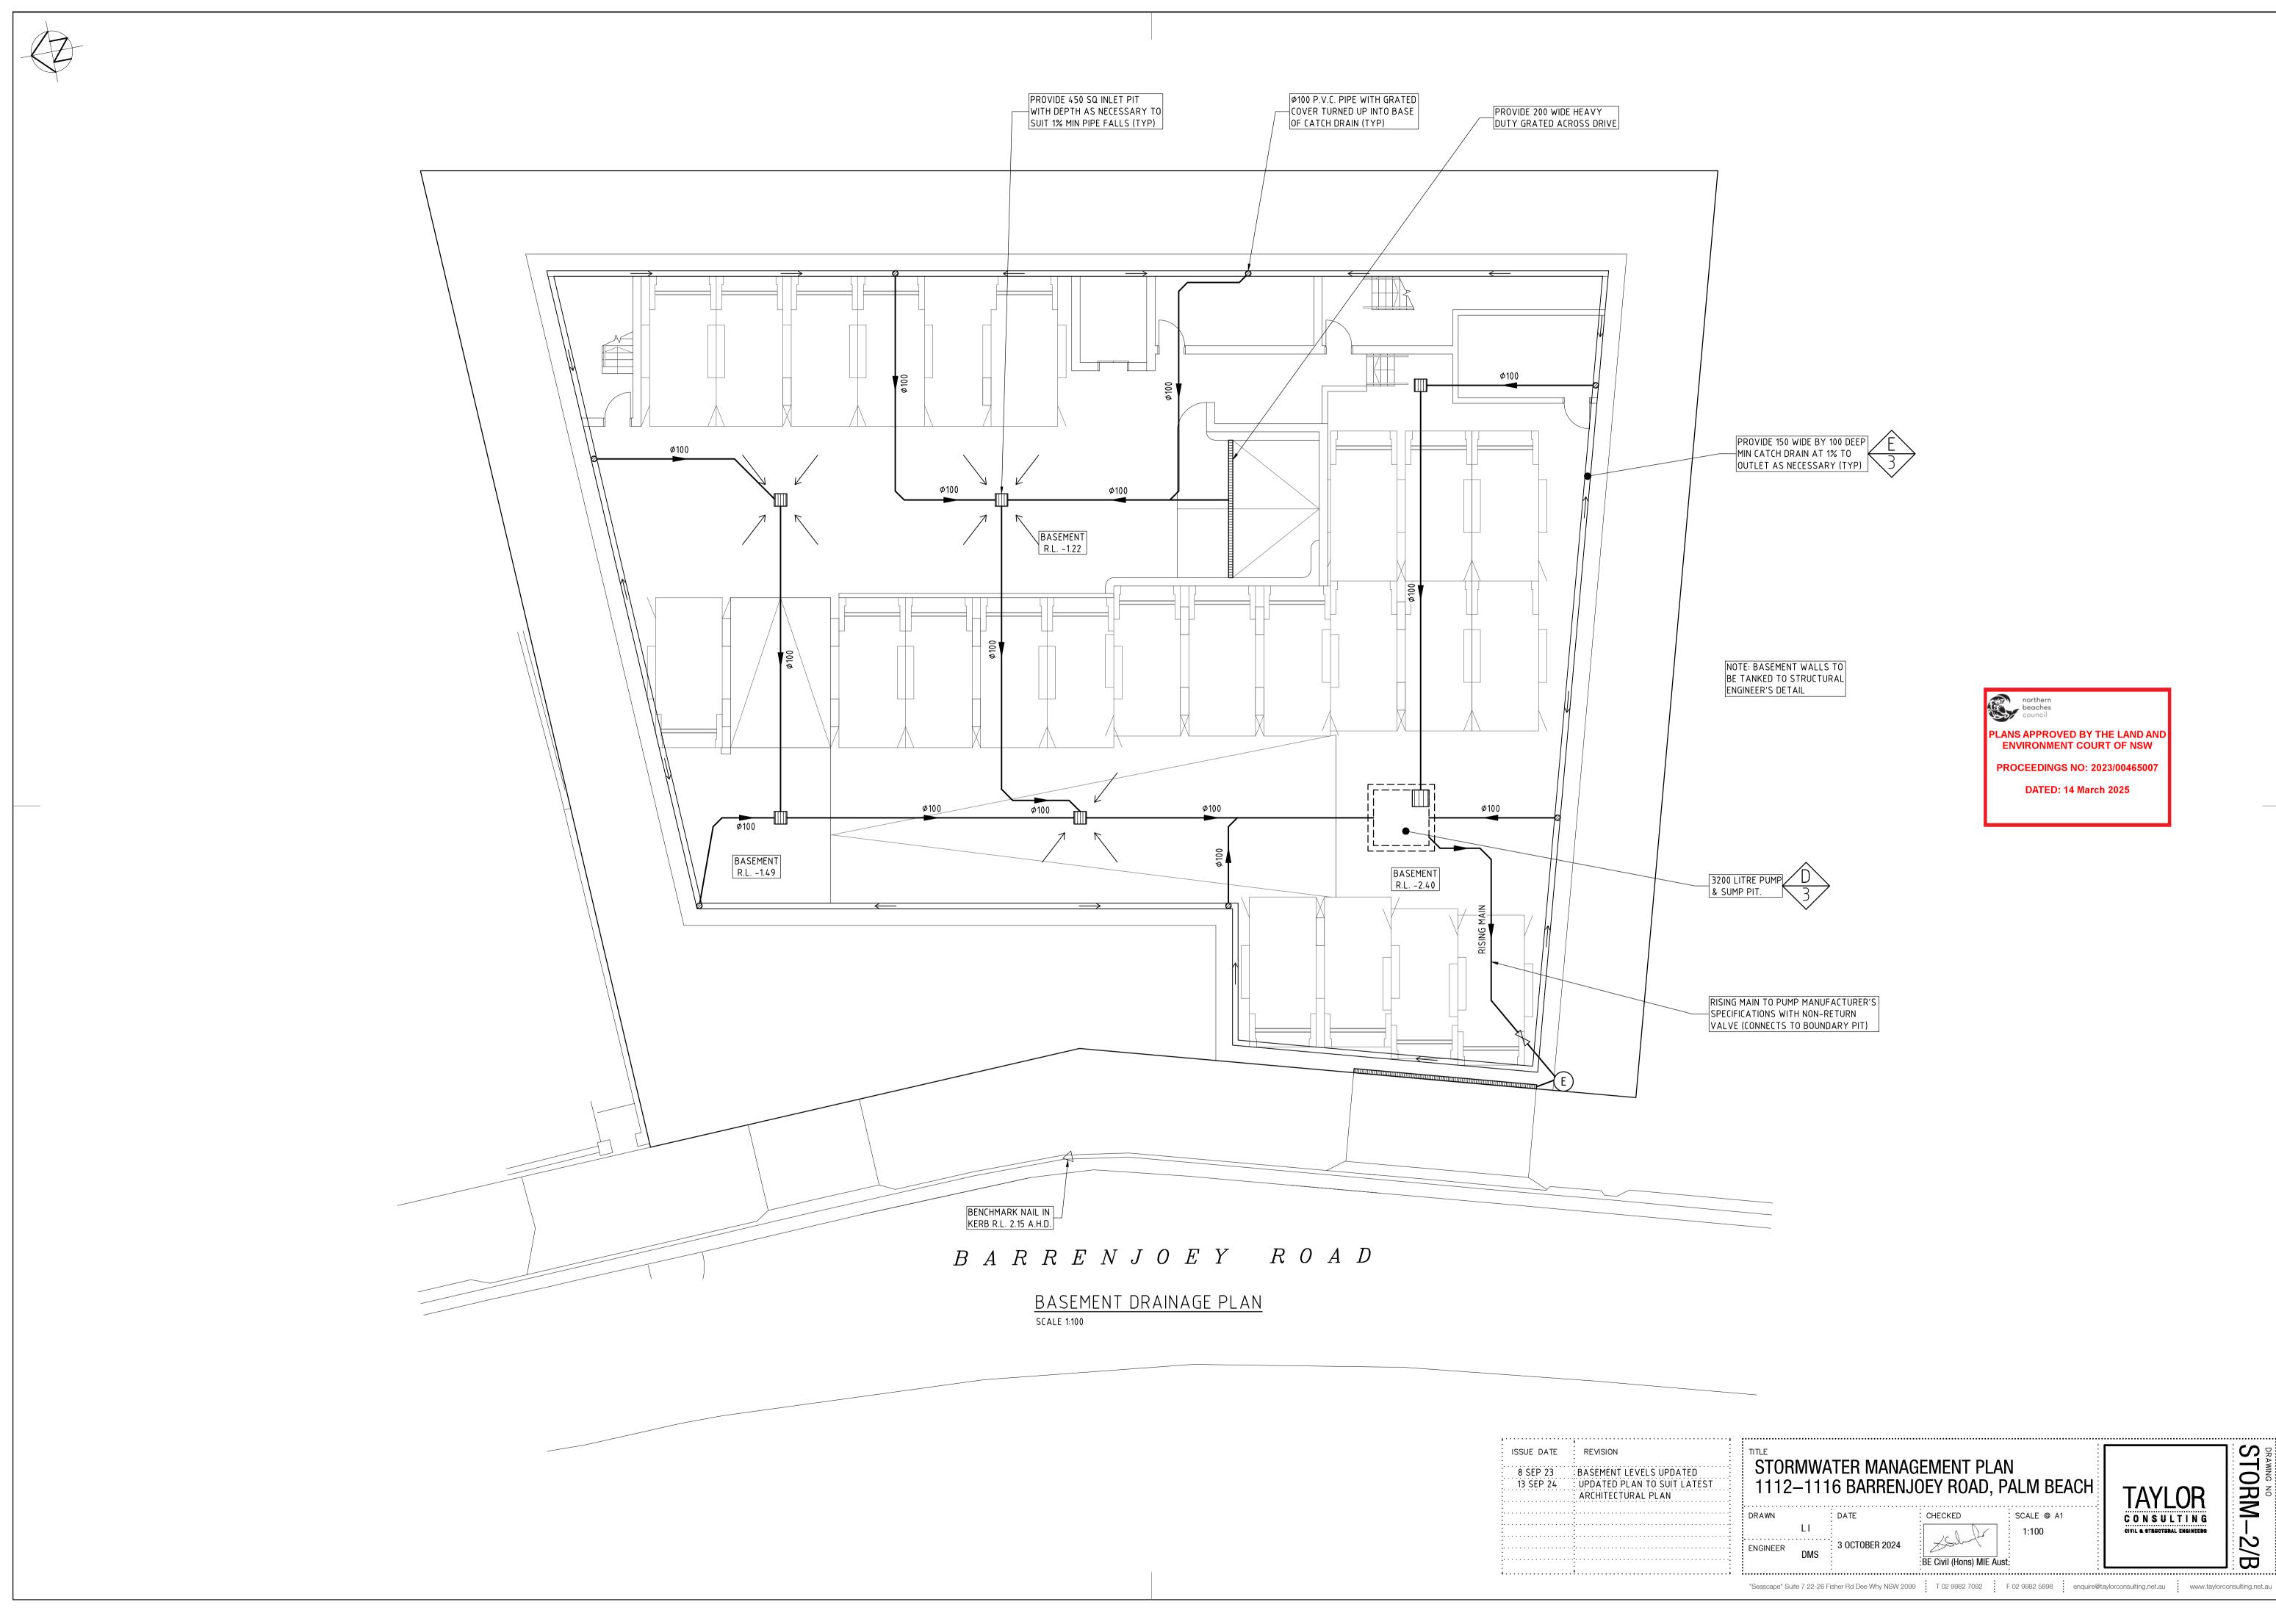

STORM-STORMWATER MANAGEMENT PLAN 1112–1116 BARRENJOEY ROAD, PALM BEACH TAYLOR CONSULTING CIVIL & STRUCTURAL ENGINEERS SCALE @ A1 CHECKED 1:100)2/B BE Civil (Hons) MIE Aust:

northern beaches council PLANS APPROVED BY THE LAND AND ENVIRONMENT COURT OF NSW PROCEEDINGS NO: 2023/00465007

DATED: 14 March 2025

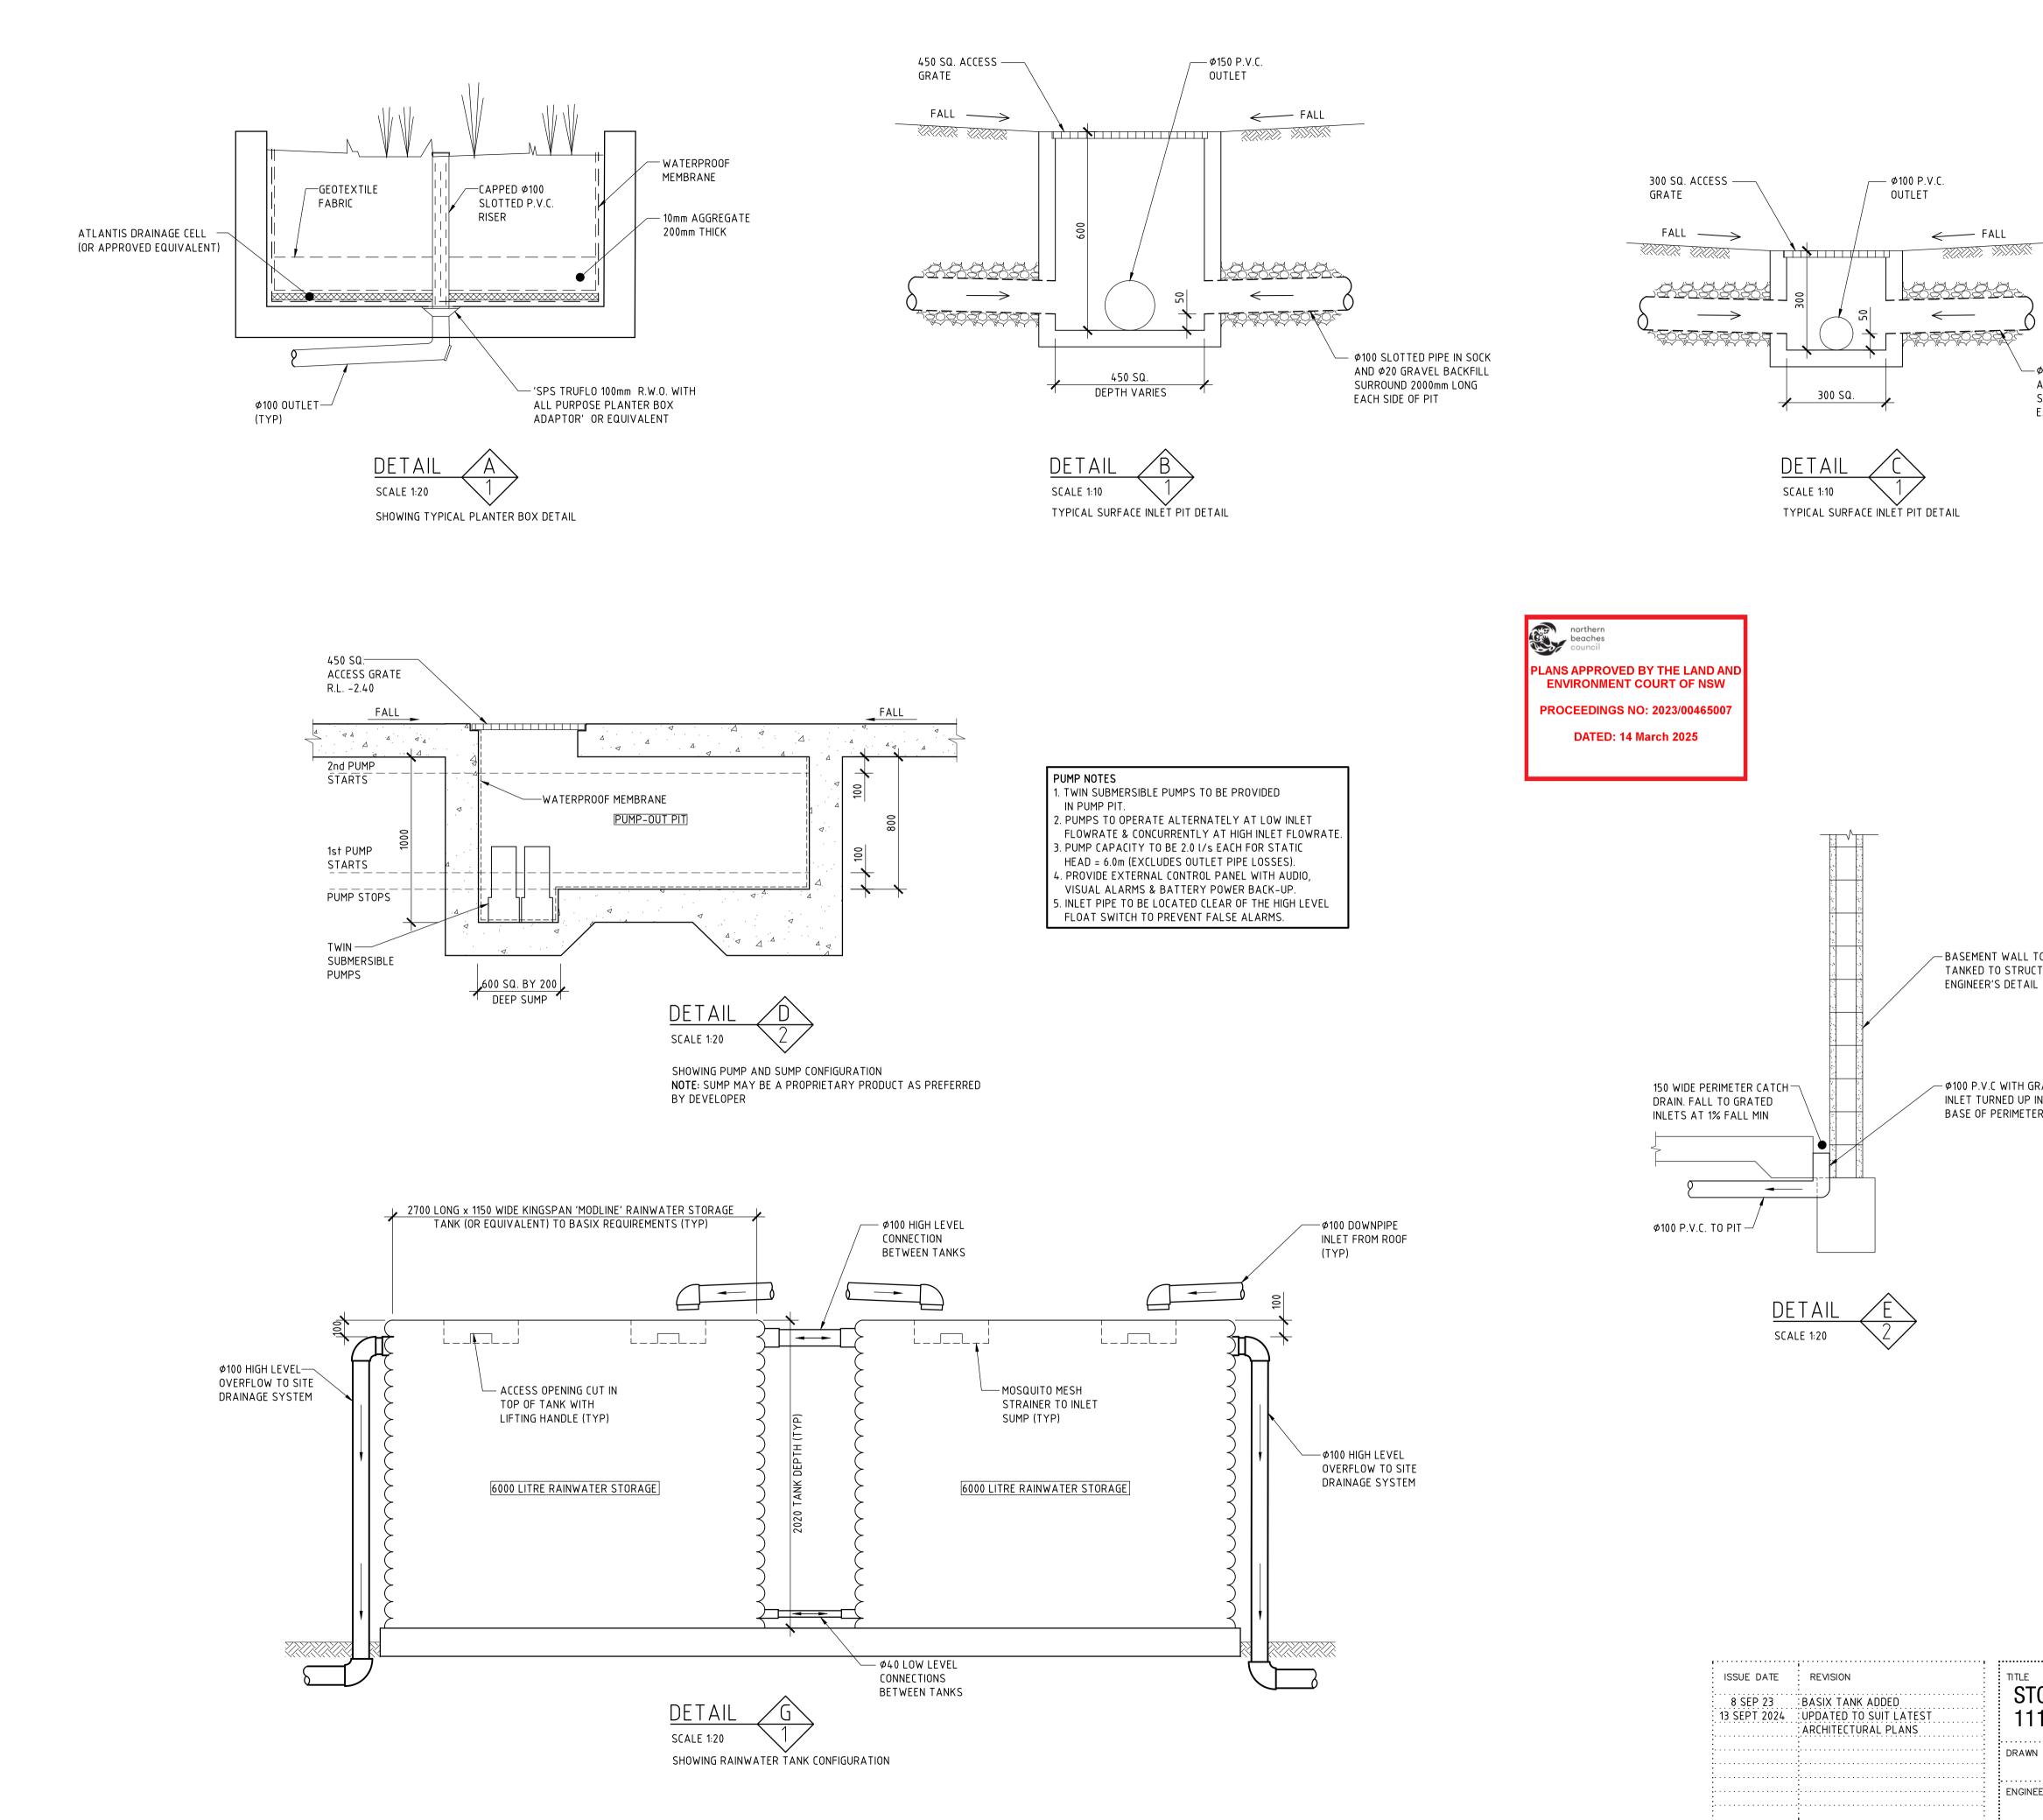

2	DRAINAGE NOTES
	1. + DENOTES EXISTING GROUND LEVEL
\backslash	2. FALL STORMWATER PIPES AT 1% MIN. UNLESS OTHERWISE NOTED.
\$\overline\$ \$\ \$\ \$\ \$	3. SUB-SOIL DRAINAGE TO BE CONNECTED TO THE SITE DRAINAGE SYSTEM AS NECESSARY.
SURROUND 2000mm LONG	4. SURFACE GRATES 300 SQ. UNLESS OTHERWISE NOTED.
EACH SIDE OF PIT	5. ALL STORMWATER PIPES TO HAVE SOLVENT CEMENT WATERTIGHT JOINTS.
	 CHECK & LOCATE DEPTH OF EXISTING MAINS & SERVICES PRIOR TO CONSTRUCTION OF STORMWATER SYSTEM AS VARIATIONS IN POSITION OF MAINS COULD AFFECT DRAINAGE CONSTRUCTION DETAILS.
	 INSPECTIONS MUST BE UNDERTAKEN BY THIS OFFICE (BY PRIOR ARRANGEMENT WITH ENGINEER) DURING CONSTRUCTION TO ENABLE FULL CERTIFICATION UPON COMPLETION OF WORKS.
	8. ALL CONSTRUCTION OF COUNCIL DRAINAGE WORKS TO COMPLY WITH COUNCIL STANDARD.
	9. REMOVE REDUNDANT DRAINAGE PITS AND SEAL PIPES.
	10. PIT BENCHING TO BE HALF THE OUTGOING PIPE DIAMETER. CONCRETE FOR BENCHING TO BE 20 MPa MASS CONCRETE.
	11. APPROVED PRE-CAST PITS MAY BE USED.
	12. ALL PIPES TO BE LAID ON COMPACTED FINE CRUSHED ROCK OR SAND BEDDING 75mm THICK & PIPES BACKFILLED WITH COMPACTED SAND TO 300mm ABOVE TOP OF PIPE, ELSE ATTACHED TO UNDERSIDE OF STRUCTURE AT 600mm c/c AS NECESSARY
	13. PIPE ROUTES SHOWN ARE INDICATIVE ONLY AND SHOULD BE AS NECESSARY ACCORDING TO SITE CONDITIONS, TREE POSITIONS ETC. CONFIRM SIGNIFICANT CHANGES IN PIPES SYSTEM DETAILS WITH SUPERVISING ENGINEER PRIOR TO COMMENCEMENT OF DRAINAGE CONSTRUCTION WORKS.
	14. CONTRACTOR SHALL ENSURE THAT SERVICES TO BUILDINGS NOT AFFECTED BY THE WORKS ARE NOT DISRUPTED. CONTRACTOR SHALL CONSTRUCT TEMPORARY SERVICES TO MAINTAIN EXISTING SUPPLY TO BUILDINGS WHERE REQUIRED. ONCE WORKS ARE COMPLETE AND COMMISSIONED THE CONTRACTOR SHALL REMOVE ALL TEMPORARY SERVICES AND MAKE GOOD ALL DISTURBED AREAS.
	 STORMWATER SYSTEM REQUIRES SIGNIFICANT MAINTENANCE DUE TO POTENTIAL HIGH POLLUTANT LOAD. FILTERS AND POLLUTANT TRAPS SHOULD BE CHECKED AFTER LARGE STORM EVENTS AND CLEANED EVERY 6 MONTHS.
	16. PLUMBING AND DRAINAGE WORKS TO COMPLY WITH AS-3500, THE NATIONAL DRAINAGE & PLUMBING CODE.
	17. WHERE POSSIBLE DRAINAGE LINES SHALL BE LAID IN AREAS PREVIOUSLY DISTURBED BY OTHER SITE WORKS AND FOLLOW TOPOGRAPHICAL FEATURES TO REDUCE IMPACT AND AVOID TREE ROOTS
	18. THIS STORMWATER MANAGEMENT PLAN HAS BEEN PREPARED FOR SUBMISSION TO COUNCIL/CERTIFEIR AND DOES NOT NECESSARILY CONTAIN ALL APPROPRIATE INFORMATION TO ENABLE FOR ISSUE TO PLUMBER/BUILDER FOR CONSTRUCTION. CONTACT TAYLOF CONSULTING FOR MORE INFORMATION.
	RAINWATER RE-USE NOTES AND SPECIFICATIONS
WALL TO BE STRUCTURAL DETAIL	1. ROOF WATER ONLY TO BE DRAINED TO THE RAINWATER STORAGE TANK.
	2. THE RAINWATER STORAGE TANK NEEDS TO BE CONNECTED FOR RE-USE AS REQUIRED BY THE OWNER.
	3. RAINWATER STORAGE TANK TO BE CONFIGURED IN ACCORDANCE WITH SYDNEY WATER SPECIFICATIONS 'GUIDELINES FOR RAINWATER TANK ON RESIDENTIAL PROPERTIES'.
	 PROVIDE MAINS 'TOP-UP' SUPPLY TO RAINWATER TANK. MAINS TOP-UP ZONE TO BE BASED ON THE DAILY NON-POTABLE USAGE THAT MAY BE EXPECTED FROM THE TANK.
TH GRATED UP INTO METER DRAIN	 PROVIDE A MECHANICAL PUMPING ARRANGEMENT (IN SOUND-PROOF HOUSING) TO PUMP SUPPLIERS SPECIFICATION TO SUIT INTENDED USAGE OF RAINWATER STORAGE. PUMPING ARRANGEMENTS MUST COMPLY WITH EPA GUIDELINES.
	 INLETS TO RAINWATER TANK MUST BE SCREENED TO PREVENT THE ENTRY OF FOREIGN MATTER, ANIMALS OR INSECTS.
	7. A SIGN MUST BE AFFIXED TO THE RAINWATER TANK CLEARLY STATING THAT THE WATER IN THE TANK IS RAINWATER AND IS NOT TO BE USED FOR HUMAN CONSUMPTION.
	8. RAINWATER TANK TO BE PLACED ON A STRUCTURALLY ADEQUATE BASE IN ACCORDANCE WITH THE MANUFACTURER'S OR STRUCTURAL ENGINEER'S DETAILS.
	9. THE TANK MUST NOT BE INSTALLED OVER ANY MAINTENANCE STRUCTURE OR FITTINGS USED BY A PUBLIC AUTHORITY.
	 RAINWATER TANK AND ASSOCIATED PLUMBING WORKS TO BE INSTALLED AND CONFIGURED BY A LICENSED PLUMBER. PUMP TO BE INSTALLED BY A LICENSED ELECTRICIAN.

STORMWATER MANAGEMENT DETAILS 1112–1116 BARRENJOEY ROAD, PALM BEACH					TAYLOR	STORM	
DRAWN	MDB	DATE	CHECKED	SCALE @ A1 1:20	CONSULTING Civil a structural engineers	Ī	
ENGINEER	DMS	3 OCTOBER 2024	BE Civil (Hons) MIE Aust;	1:10		3/B	
"Seascape" Suite 7 22-26 Fisher Rd Dee Why NSW 2099 T 02 9982 7092 F 02 9982 5898 enquire@taylorconsulting.net.au www.taylorconsulting.net.au							