


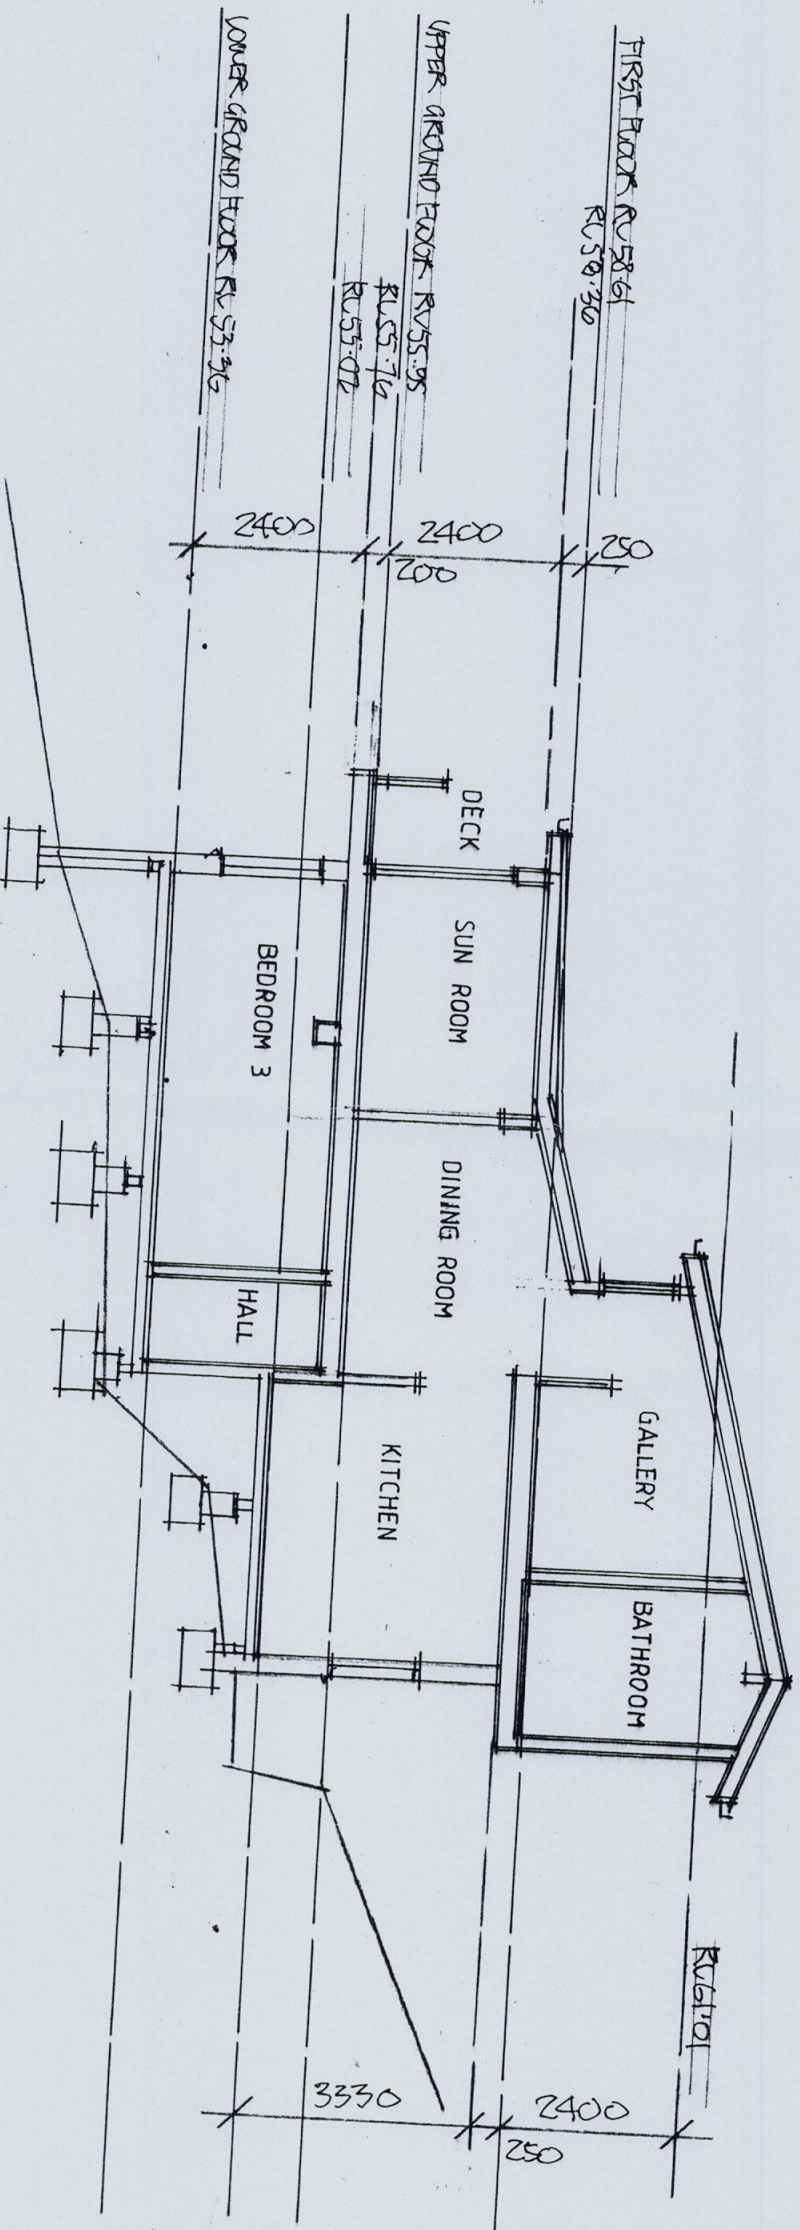

SECTION A - A


1. Builder to check and confirm all necessary requirements on site prior to construction. Do not make any alterations.
2. All dimensions shall be in accordance with the Building Code of Australia (BCA) and the relevant standards.
3. All work shall be in accordance with the Building Code of Australia (BCA) and the relevant standards.
4. All work shall be in accordance with the Building Code of Australia (BCA) and the relevant standards.
5. Any structural alterations shall be in accordance with the Building Code of Australia (BCA) and the relevant standards.
6. Roof water & sub-soil drainage shall be in accordance with the Building Code of Australia (BCA) and the relevant standards.
7. All electrical power & light shall be in accordance with the Building Code of Australia (BCA) and the relevant standards.
8. Make good and repair all existing fixtures damaged by new work. Please ceiling indicates where possible.

COPYRIGHT
ALL PLANS AND DRAWINGS ARE SUBJECT OF
COPYRIGHT AND ANY ATTEMPT OR USE OF
THESE DRAWINGS FOR ANY PURPOSES
WITHOUT THE WRITTEN PERMISSION OF
J.D. EVANS AND COMPANY PTY. LTD.
WILL BE PROSECUTED TO THE FULL
EXTENT OF THE LAW.

No.	REVISION	DATE



J.D. EVANS and COMPANY PTY. LTD.
BUILDING DESIGN CONSULTANTS
74 RIVERA AVE, AVALON BEACH, N.S.W. 2107
Phone (02) 9918 9206 Fax (02) 9973 5434
Mobile 098 976 596

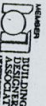

PROJECT
AS BUILT DRAWING OF EXISTING AT
No. 62 HERBERT AVENUE
NEWPORT N.S.W. 2106
CLIENT
JEREMY & ARIELLA RICHMAN

DATE 15/7/2008	SCALE 1:100
DRAWN JDE	CHECKED

1107-8

