

7.0 APPENDIX C – GLAZING MARK-UP





1 Ground Floor
1 : 100



W. tzannes.com.au Suite 5, Level 5
T. 61 2 9319 3744 2-12 Foveaux Street, Surry Hills
E. tzannes@tzannes.com.au NSW 2010 Sydney Australia

Copyright
Copyright owned by Tzannes. Rights to this document are subject to payment in full of all Tzannes fees. This document may only be used for the express purpose for which it has been created and any unauthorised use is at the user's sole risk and without limiting Tzannes' rights the user releases and indemnifies Tzannes from and against all loss so arising

Nominated Architects
Alec Tzannes 4174
Jonathan Evans 6613
Miaden Prnjatovic 7468
Ben Green 7066
Chi Melhem 7754

General Notes
Verify dimensions on site prior to commencement of work. Check existing RL's on site. Advise Architect of any discrepancies before commencement. Allow for adjustments to suit discrepancies. Comply with relevant authorities requirements. Comply with Building Code of Australia requirements. Comply with relevant Australian Standards for materials and construction practice. Comply with Basic Certificate. Do not scale from drawings.

Rev	Date	For
A	21/01/19	Consultant Issue
B	31/01/19	Consultant Issue
C	27/02/19	Development Application

Quantity Surveyor
KGCB
9906 5355 kchoo@kgcb.com.au
Planner
City Plan
8270 3500 stephenk@cityplan.com.au
Arborist
Earthscape
9319 3744 earthscape@iinet.net.au
Landscape Architect
Dangar Barin Smith
9316 9044 will@dangarbarinsmith.com.au

Structural, Civil Engineer
TTW
9439 7288 jane.armstrong@ttw.com.au
Hyd, Mech, Elec, Basis
Umow Lai
9431 9491 david.arnott@umowlai.com.au
Traffic Engineer
TEF Consulting
0414 978 067 o.s@tefconsult.com.au
Ecologist
Abel Ecology
4751 9487 info@abelecolgy.com.au

Legend			
---	BOUNDARY LINES	GL	GLASS
---	SETBACK LINES	BR	BRONZE
---	DEMOLISHED	COP	COPPER
REN	RENDER	DP	DOWN PIPE
STN1	DRESSED STONE	PV	PHOTO-VOLTAIC CELLS
STN2	LANDSCAPE WALLS	CON	CONCRETE
MS	MILD STEEL		
MWS	METAL WAL SHEETING		
MRS	METAL ROOF SHEETING		
ELS	BALLAST		
ALV	METAL LOUVRE		
STN3	STONE		
PAV	LANDSCAPE PAVING		

Tzannes

NOT FOR CONSTRUCTION


Scale 1:100 @A1

0 1000 2000 3000 4000 5000 mm

Project
Palm Beach Residence
Address
346-352 Whale Beach Road,
Palm Beach
Status
DEVELOPMENT APPLICATION

Drawing
Ground Floor Plan
Project No.
17018
Drawing No.
1102
Revision
C

Drawn
KD
Checked
AT

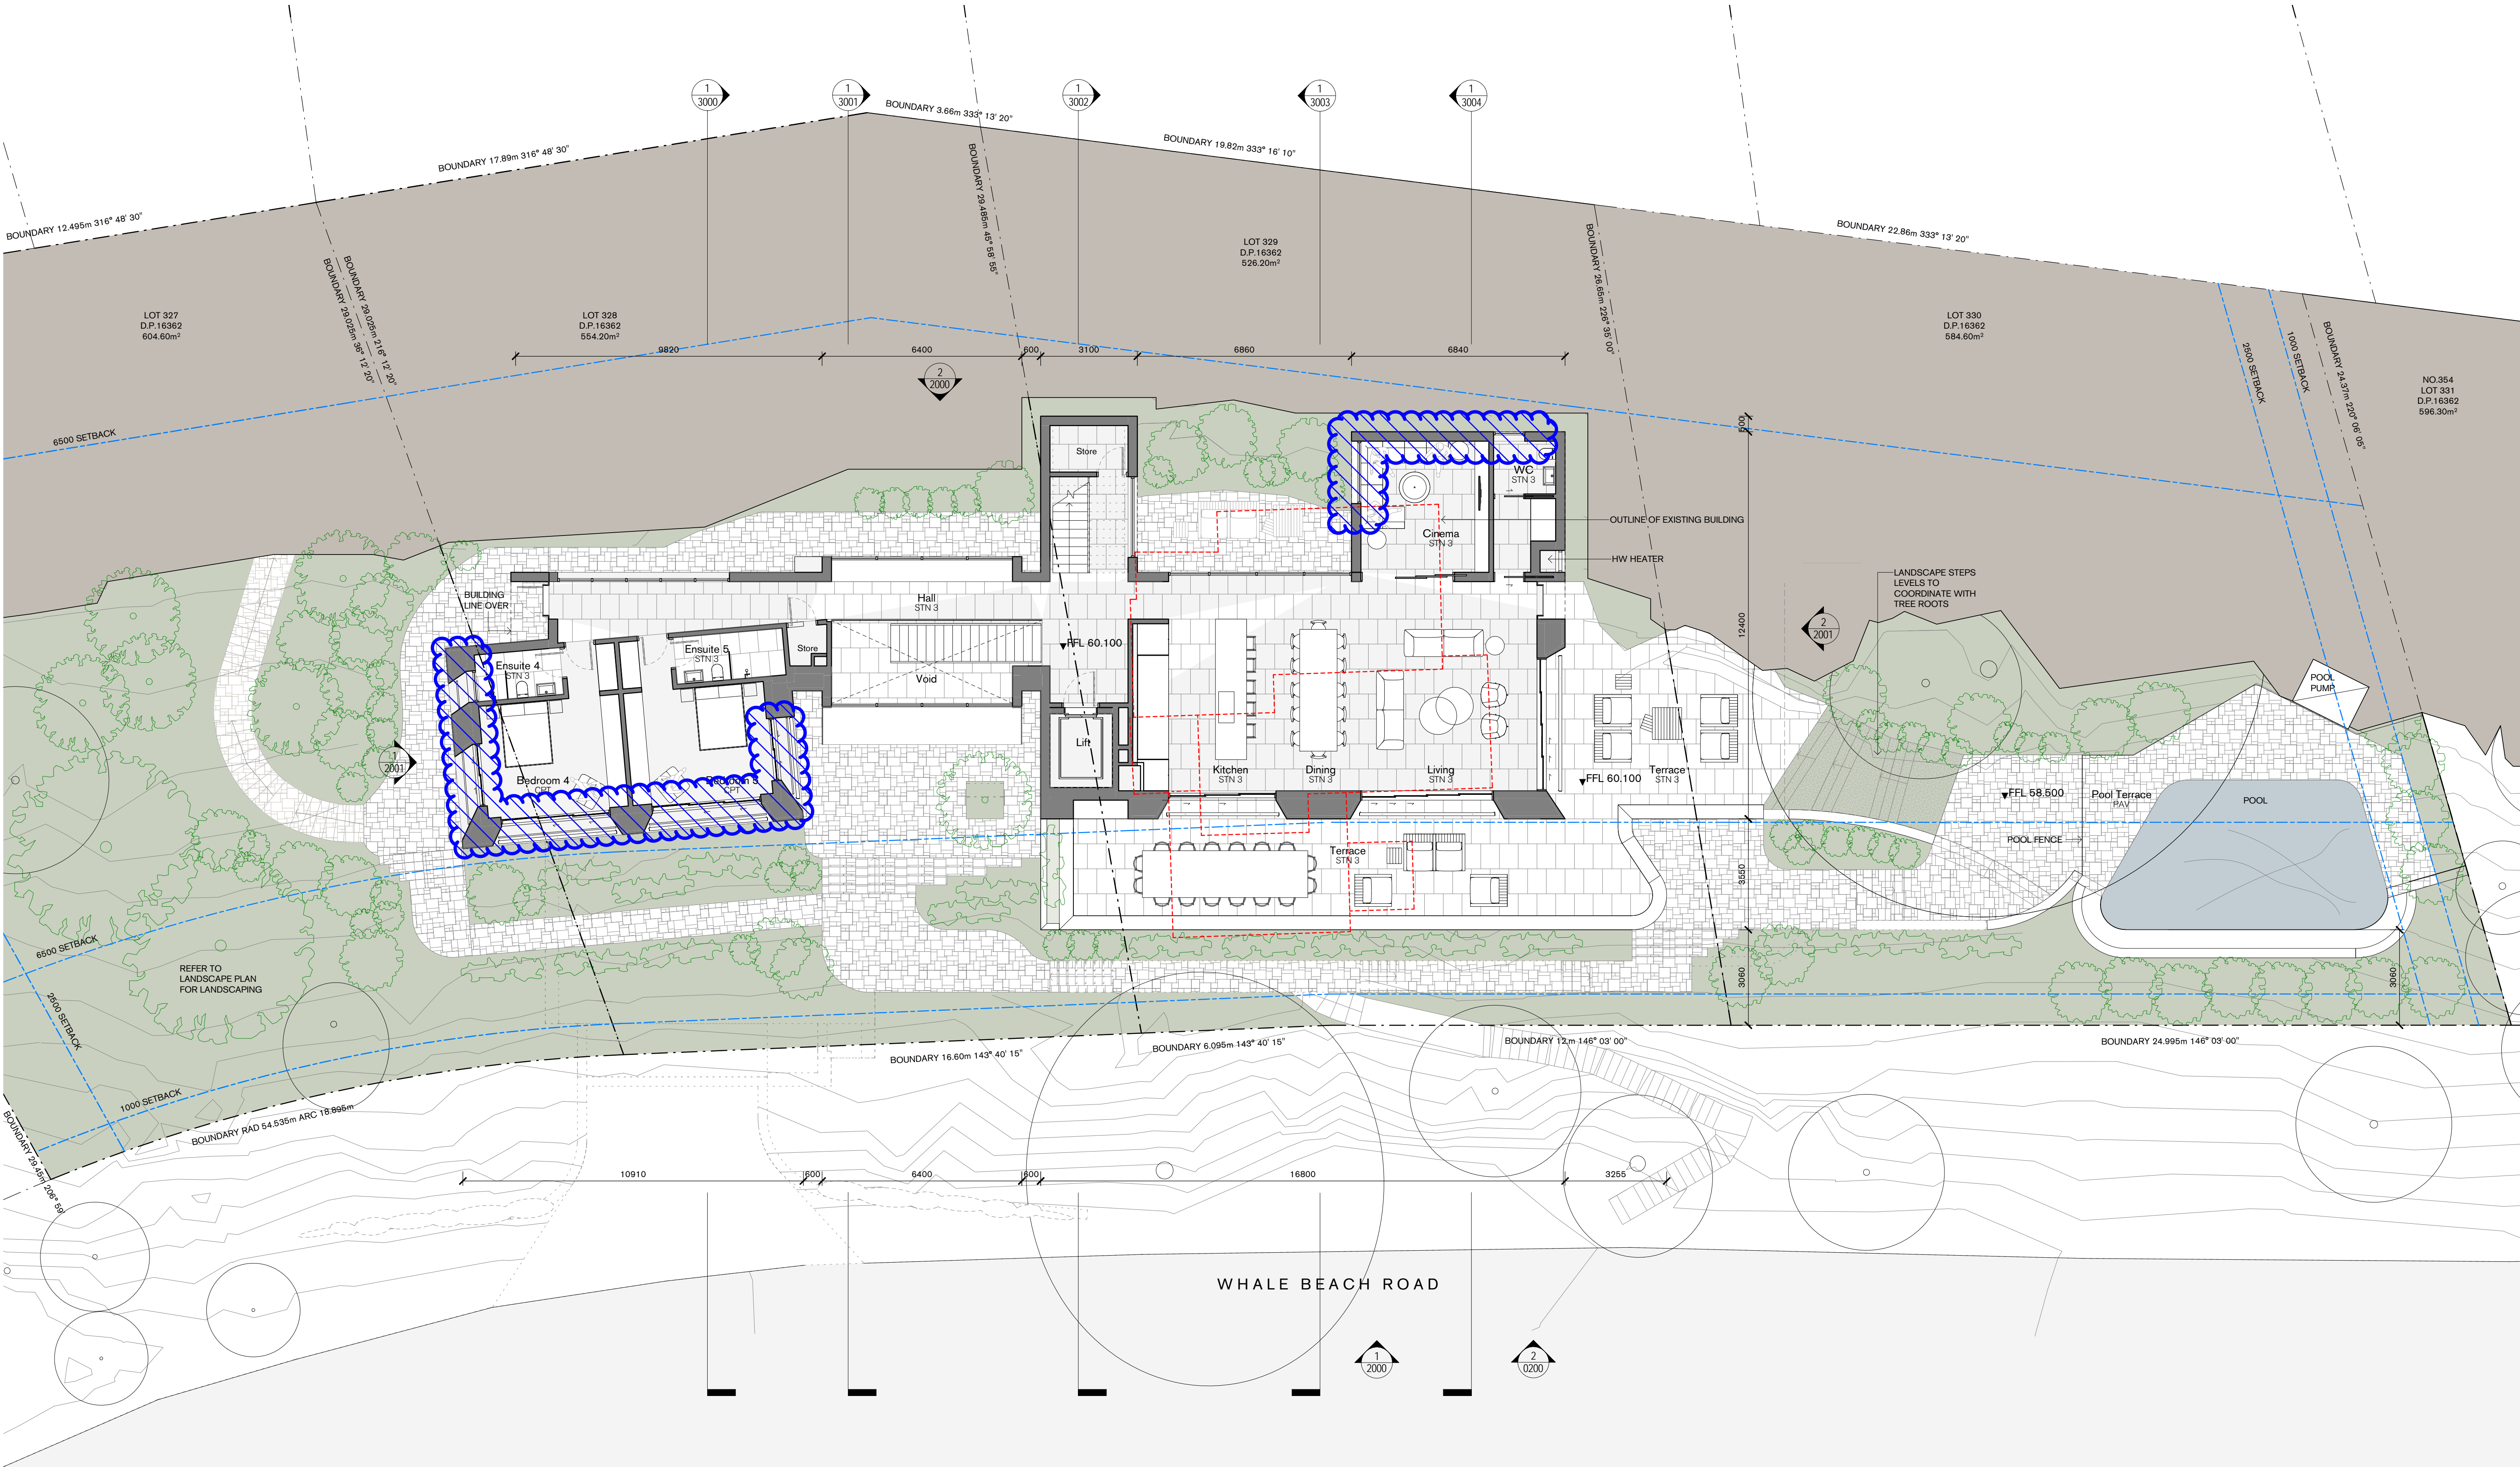

1 | Level 1
1:100



W. tzannes.com.au Suite 5, Level 5
T. 61 2 9319 3744 2-12 Foveaux Street, Surry Hills
E. tzannes@tzannes.com.au NSW 2010 Sydney Australia

Copyright

Copyright owned by Tzannes. Rights to this document are subject to payment in full of all Tzannes fees. This document may only be used for the express purpose for which it has been created and any unauthorised use is at the user's sole risk and without limiting Tzannes' rights the user releases and indemnifies Tzannes from and against all loss so arising

Nominated Architects

Alec Tzannes 4174
Jonathan Evans 6613
Mladen Prnjatovic 7468
Ben Green 7066
Chi Melhem 7754

General Notes

Verify dimensions on site prior to commencement of work. Check existing RL's on site. Advise Architect of any discrepancies before commencement. Allow for adjustments to suit discrepancies. Comply with relevant authorities requirements. Comply with Building Code of Australia requirements. Comply with relevant Australian Standards for materials and construction practice. Comply with Basic Certificate. Do not scale from drawings.

Rev	Date	For
A	21/01/19	Consultant Issue
B	31/01/19	Consultant Issue
C	27/02/19	Development Application

Quantity Surveyor

KGCB
9906 5355 kchoo@kgcb.com.au

Planner

City Plan
8270 3500 stephenk@cityplan.com.au

Arborist

Earthscape
9319 3744 earthscape@iinet.net.au

Landscape Architect

Dangar Barin Smith
9316 9044 will@dangarbarinsmith.com.au

Structural, Civil Engineer

TTW
9439 7288 jane.armstrong@ttw.com.au

Hyd, Mech, Elec, Basis

Umow Lai
9431 9491 david.arnott@umowlai.com.au

Traffic Engineer

TEF Consulting
0414 978 067 o.s@tefconsult.com.au

Ecologist

Abel Ecology
4751 9487 info@abelecolgy.com.au

Legend


- BOUNDARY LINES
- SETBACK LINES
- DEMOLISHED

REN STN1	RENDER	GL	GLASS
STN2	DRESSED STONE	BR	BRONZE
MS	LANDSCAPE WALLS	COP	COPPER
MWS	MILD STEEL	DP	DOWN PIPE
MRS	METAL WAL SHEETING	PV	PHOTO-VOLTAIC CELLS
ELS	METAL ROOF SHEETING	CON	CONCRETE
ALV	BALLAST		
STN3	METAL LOUVRE		
PAV	STONE		
	LANDSCAPE PAVING		

Tzannes

NOT FOR CONSTRUCTION

Scale 1:100 @A1

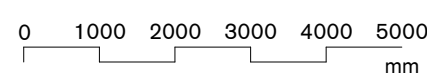

North



Project
Palm Beach Residence

Address
346-352 Whale Beach Road,
Palm Beach

Status
DEVELOPMENT APPLICATION

Drawing
Level 1 Plan


Project No.
17018

Drawn
KD

Drawing No.
1103

Checked
AT

Revision
C

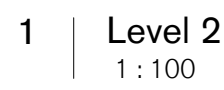

Structural, Civil Engineer

TTW

9439 7288 jane.armstrong@ttw.com.au

Hyd, Mech, Elec, Basic

Umow Lai

9431 9491 david.arnott@umowlai.com.au

Traffic Engineer

TEF Consulting

0414 978 067 o.s@tefconsult.com.au

Ecologist


Abel Ecology

4751 9487 info@abelecolology.com.au

REN	RENDER	C
STN1	DRESSED STONE	E
STN2	LANDSCAPE WALLS	D
MS	MILD STEEL	F
MWS	METAL WAL SHEETING	C
MRS	METAL ROOF SHEETING	
BLS	BALLAST	
ALV	METAL LOUVRE	
STN3	STONE	
PAV	LANDSCAPE PAVING	

GLASS
BRONZE
COPPER
DOWN PIPE
PHOTO-VOLTAIC
CONCRETE

Scale	No.
-------	-----

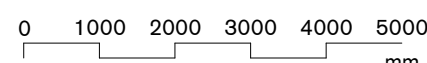

Status	DEVELOPMENT APPLICATION
--------	-------------------------

Project No.	Drawing No.	Revision
17018	1104	C