


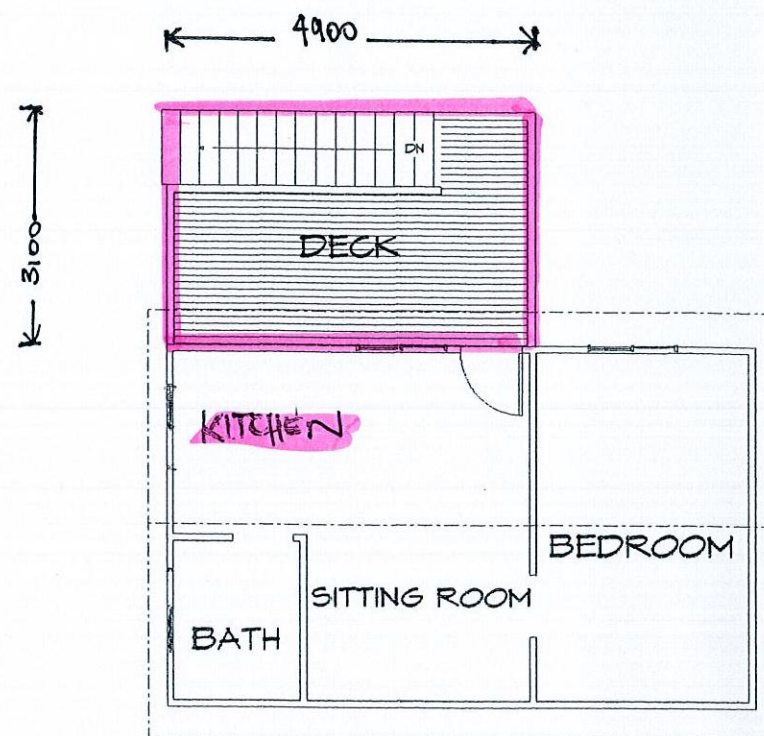

EXISTING FIRST FLOOR PLAN
(AS CONSTRUCTED)

REVISIONS

PROPOSED ALTERATIONS AND ADDITIONS

AT 143 BALGOWLAH ROAD
BALGOWLAH
FOR
MR. AND MRS. FLEW

EXISTING FIRST FLOOR PLAN

W & B CONSULTING PTY LTD

BUILDING DESIGNERS
PROJECT MANAGERS

11 HARST PLACE BELROSE NSW 2085

PH. 02 9452 4367
FAX. 02 9452 4366
MBL 0419 244 670

ABN 32 001 864 955

e.mail mled@bigpond.net.au

DRAWN BY	MIKE LEDBURY
----------	--------------

DATE	6 SEPT 2009
------	-------------

SCALE	1 : 100
-------	---------

MEMBER
HOUSING INDUSTRY ASSOCIATION



DRAWING NUMBER

09.FLEW.03