
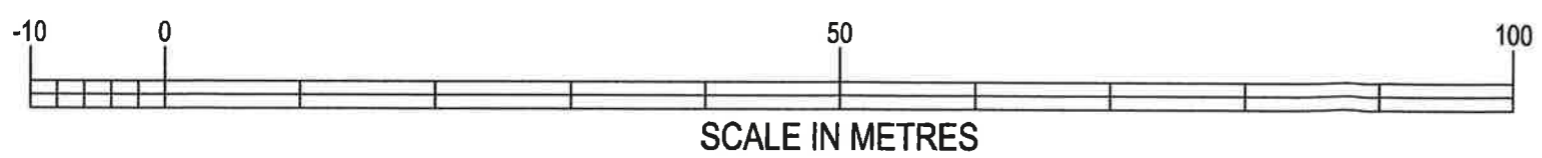


THIS PLAN IS TO BE READ
 IN CONJUNCTION WITH
 MOD 2013 / 0074 IN
 WARRINGAH COUNCIL

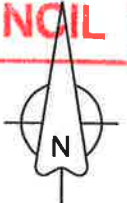

ORDER	DRAWN	CHKD	AMENDMENT	EXAM	APPD	DATE	ISS
X11296	GW	GW	ORIGINAL PROPOSAL	KJ	KJ	07.10.11	1
X11296	GW	GW	UPDATED PROPOSAL	KJ	KJ	27.10.11	2
X11296	GW	GW	UPDATED AS BUILT	AB	AB	28.06.12	3
X11296	GW	GW	PROPOSED ROADS UPDATED	AB	AB	19.11.12	4

Telstra

SYDNEY SES - OXFORD FALLS
 PROPOSED MULTI ANTENNA FACILITY DEVELOPMENT
 PROPOSED SHELTER LOCATION OPTIONS

DWG NO. OF-S00030 SHT NO. 2 INDEX

DO NOT SCALE
 DIMENSIONS IN
 F