




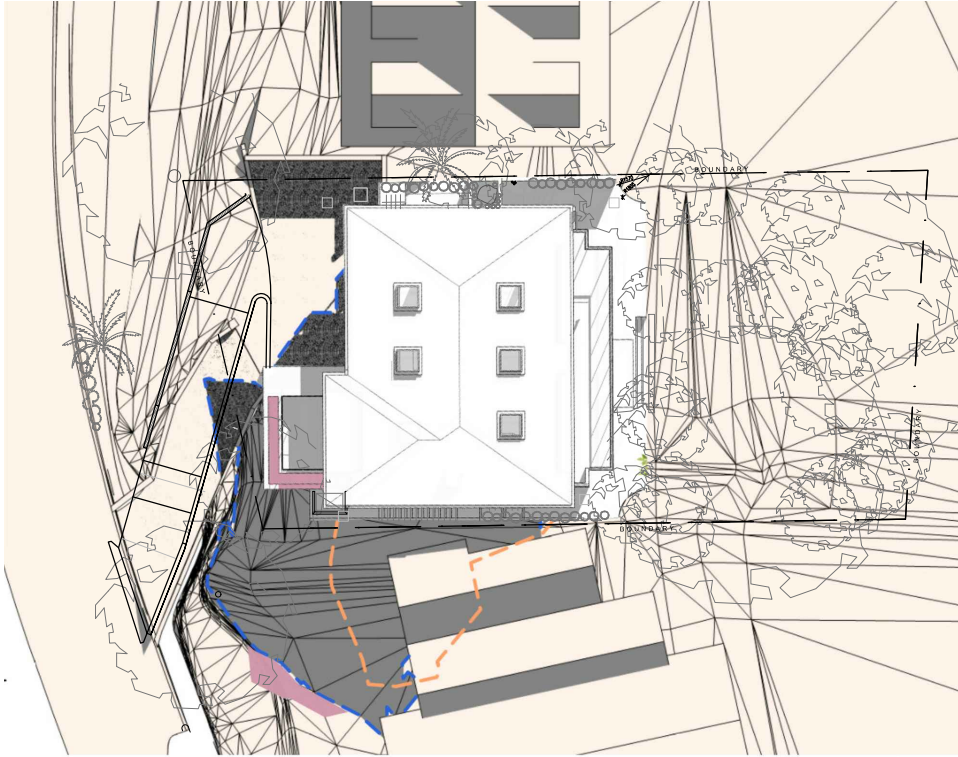

1 SHADOW DIAGRAM - 9AM 21/JUNE

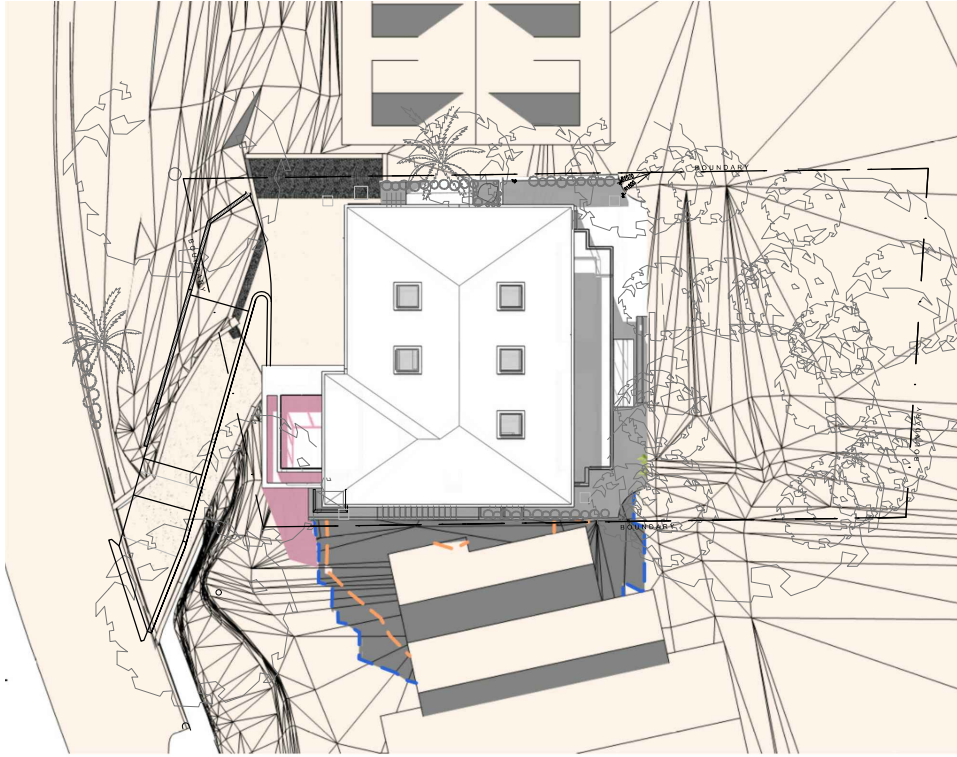

2 SHADOW DIAGRAM - 12PM 21/JUNE

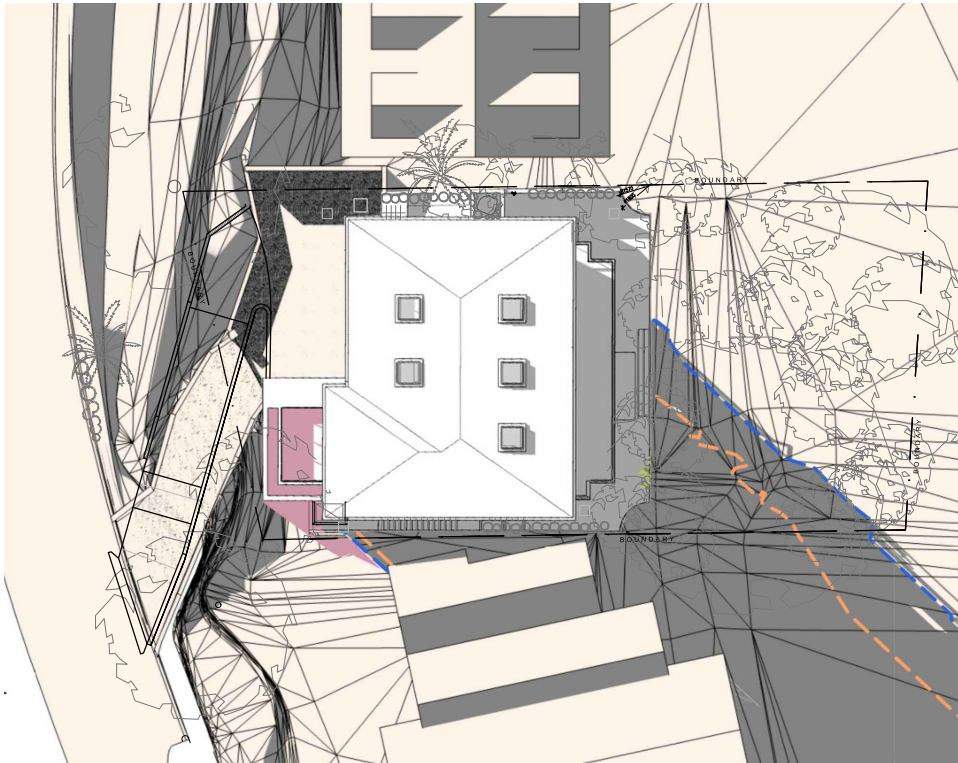

3 SHADOW DIAGRAM - 3PM 21/JUNE

- EXISTING SHADOW LINE
- APPROVED SHADOWS LINES
- PROPOSED D.A. MODIFICATIONS SHOWN IN RED INCREMENT OF SHADOWS

ALL DIMENSIONS & LEVELS TO BE CHECKED ON SITE BY CONTRACTOR PRIOR TO CONSTRUCTION. ALL BOUNDARIES & CONTOURS SUBJECT TO SURVEY. ALL RIGHTS RESERVED. THIS DRAWING MAY NOT BE REPRODUCED OR TRANSMITTED, IN PART OR IN WHOLE WITHOUT THE PERMISSION OF CRAWFORD ARCHITECTS PTY LTD.

THIS DRAWING IS NOT TO BE USED FOR CONSTRUCTION UNLESS APPROVED BY A DIRECTOR OF CRAWFORD ARCHITECTS PTY LTD.

©CRAWFORD ARCHITECTS PTY LTD 2017
SUITE 3.01, LEVEL 3 80 MOUNT STREET
NORTH SYDNEY, NSW 2060 AUSTRALIA
ABN 56 120 779 106
NOMINATED ARCHITECTS:
TONY GRAY 5303 & PAUL GODSELL 6726
P 02 9660 3644
E arch@crawford.com.au
www.crawford.com.au

04	19.08.21	Revised Section 96 Issue
ISSUE	DATE	AMENDMENTS


CLIENT
**RICHARD &
NEROLI NAYLOR**

22 PALM BEACH ROAD, PALM BEACH

PROJECT
**EXTENSION
APPROVED GARAGE**

22 PALM BEACH ROAD, PALM BEACH

TITLE
SHADOW DIAGRAM

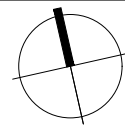


SCALE N.T.S.
APPROVED
DRAWN MG
CHECKED TG
DATE OCTOBER/2018
STATUS DA-S96

PROJECT NUMBER
15083

DRAWING NUMBER
A010

ISSUE
01

crawford
architects

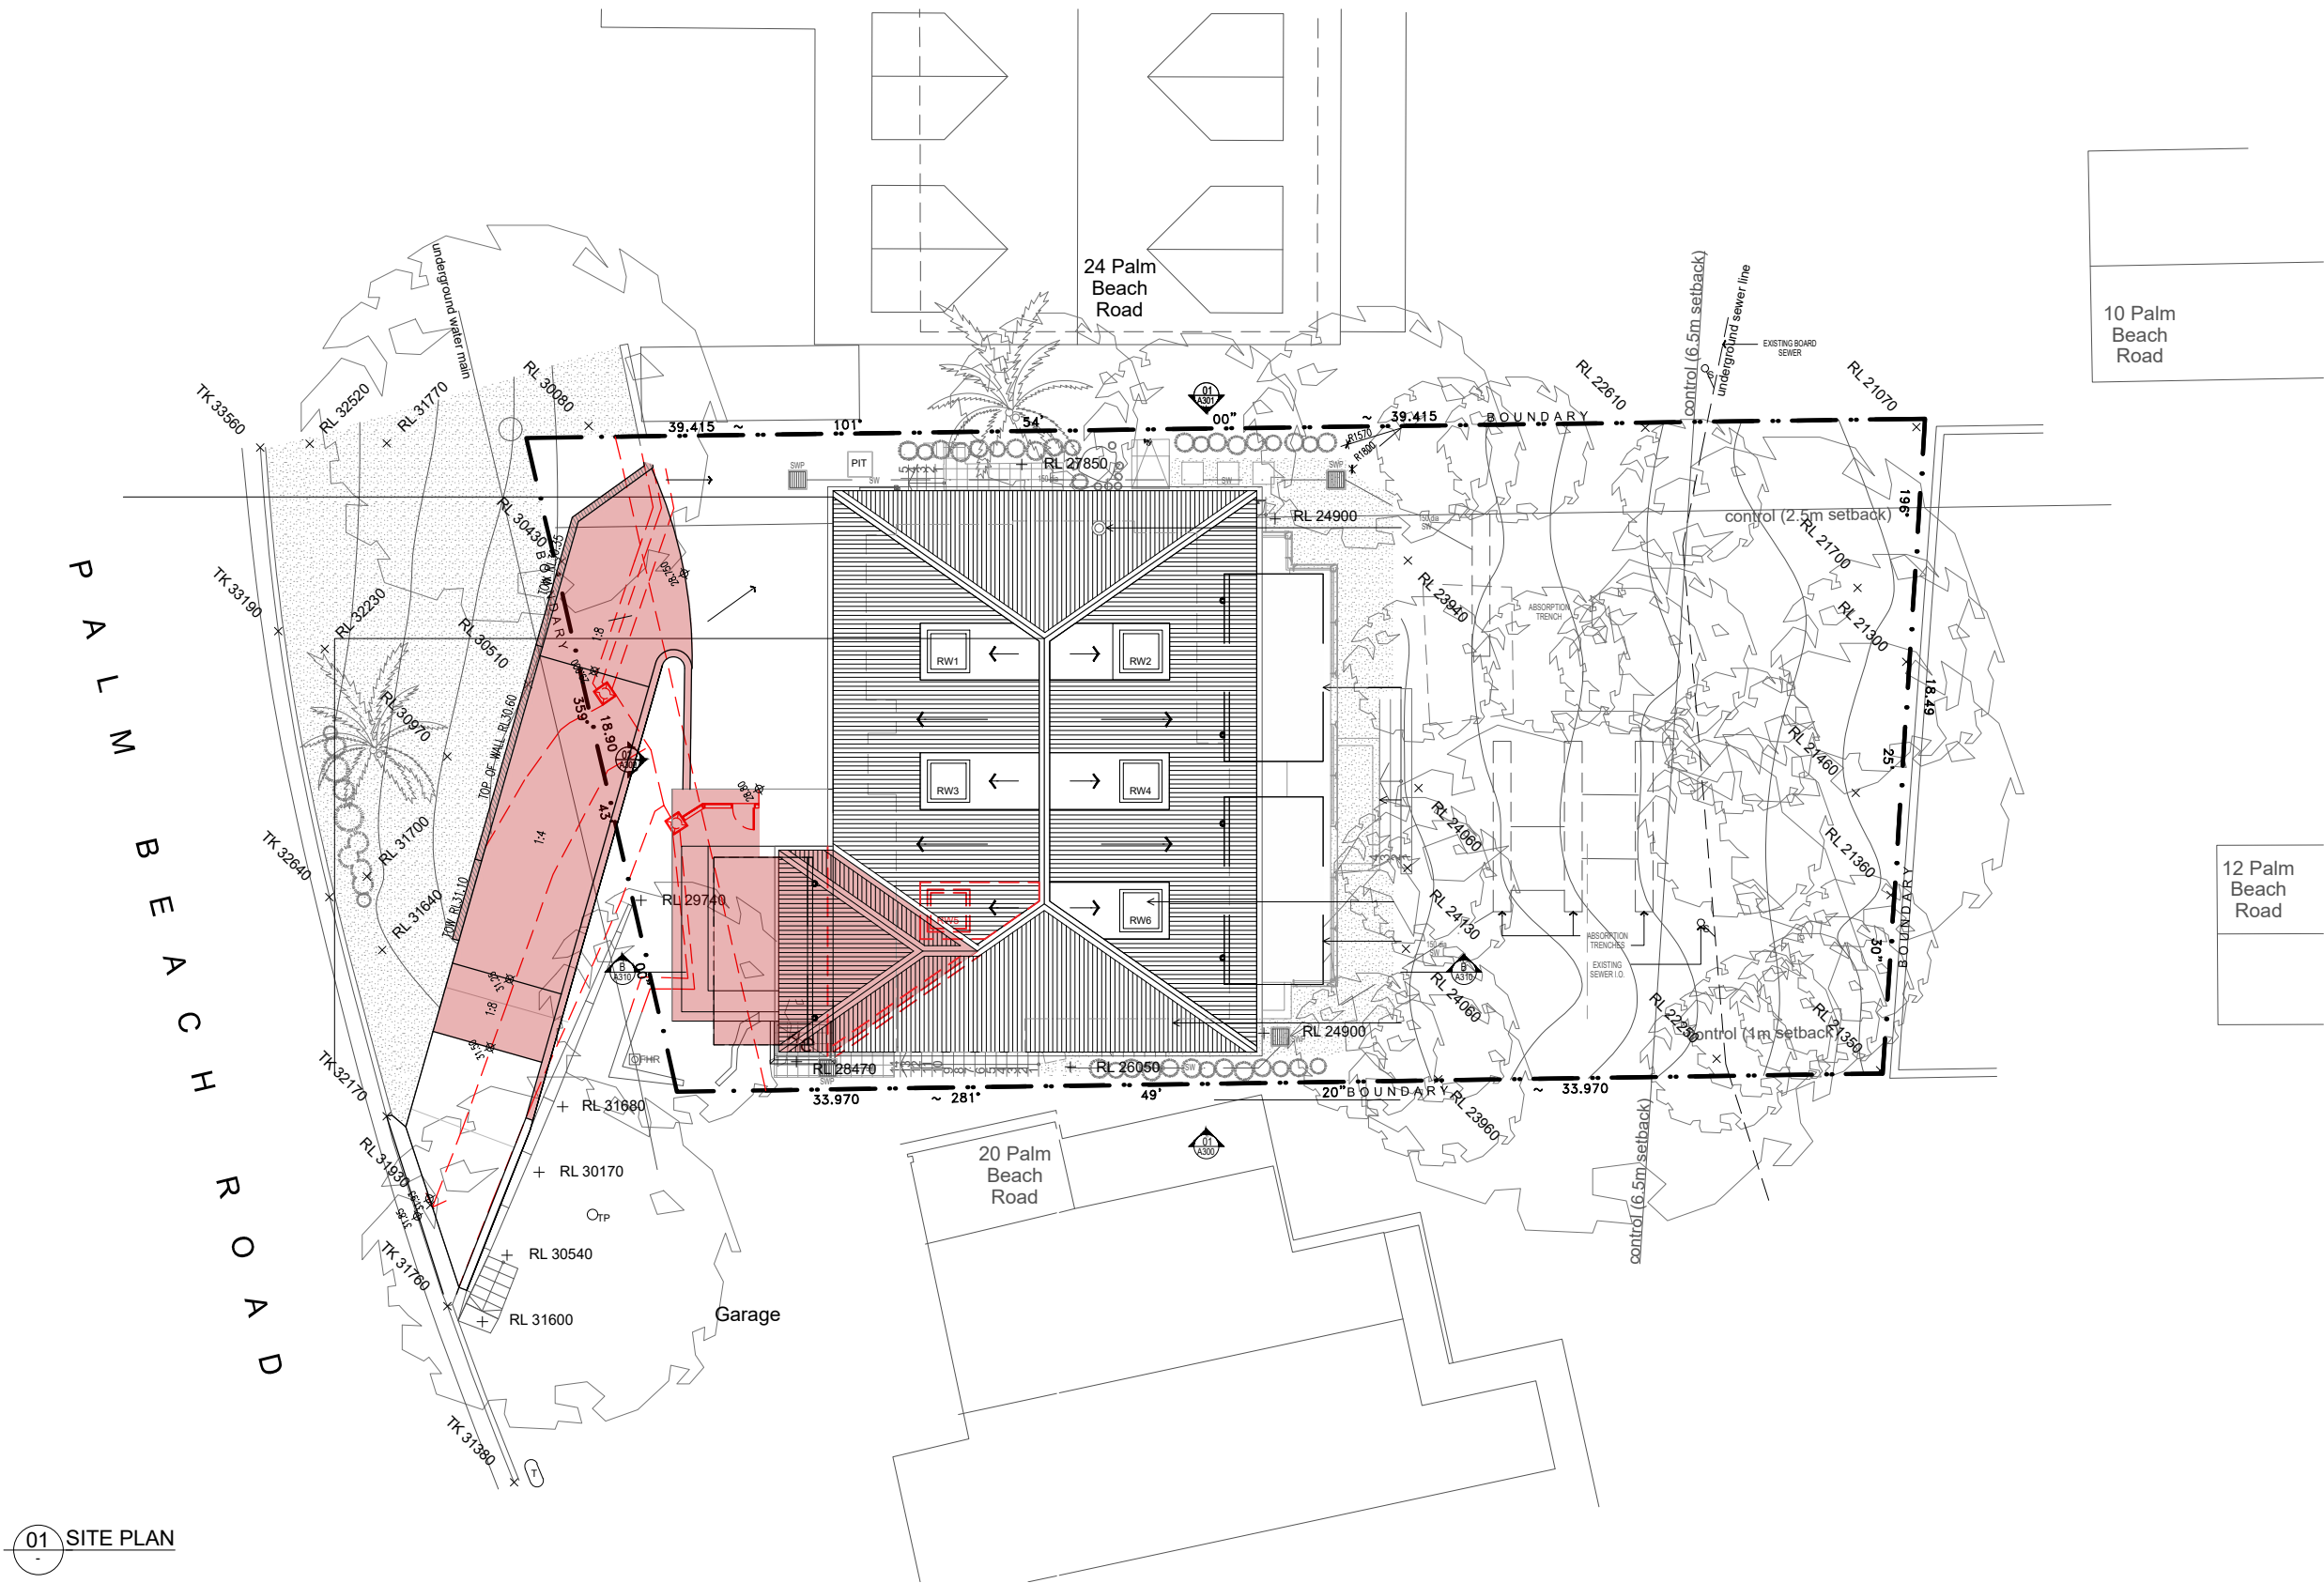

01 SITE PLAN

PROPOSED D.A. MODIFICATIONS SHOWN IN RED

NOTE: PROPOSED D.A. MODIFICATIONS TO MATCH APPROVED D.A. MATERIALS

ALL DIMENSIONS & LEVELS TO BE CHECKED ON SITE BY CONTRACTOR PRIOR TO CONSTRUCTION. ALL BOUNDARIES & CONTOURS SUBJECT TO SURVEY. ALL RIGHTS RESERVED. THIS DRAWING MAY NOT BE REPRODUCED OR TRANSMITTED, IN PART OR IN WHOLE WITHOUT THE PERMISSION OF CRAWFORD ARCHITECTS PTY LTD.

THIS DRAWING IS NOT TO BE USED FOR CONSTRUCTION UNLESS APPROVED BY A DIRECTOR OF CRAWFORD ARCHITECTS PTY LTD.

©CRAWFORD ARCHITECTS PTY LTD 2017
SUITE 3.01, LEVEL 3 80 MOUNT STREET
NORTH SYDNEY, NSW 2060 AUSTRALIA
ABN 56 120 779 106
NOMINATED ARCHITECTS:
TONY GRAY 5303 & PAUL GODSELL 6726
P 02 9660 3644
E arch@crawford.com.au
www.crawford.com.au

ISSUE	DATE	AMENDMENTS
04	19.08.21	Revised Section 96 Issue
03	19.03.01	Section 96 Issue
02	18.11.16	DA-S96 REVISION
01	18.10.24	DA-S96 ISSUE


CLIENT
**RICHARD &
NEROLI NAYLOR**

22 PALM BEACH ROAD, PALM BEACH

PROJECT
**EXTENSION
APPROVED GARAGE**

22 PALM BEACH ROAD, PALM BEACH

TITLE
SITE PLAN

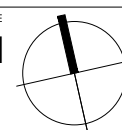

SCALE 1:200 @ A3


APPROVED - MG
DRAWN - TG
CHECKED -
DATE OCTOBER/2018
STATUS DA-S96

PROJECT NUMBER
15083

DRAWING NUMBER
A100

ISSUE
04


crawford
architects

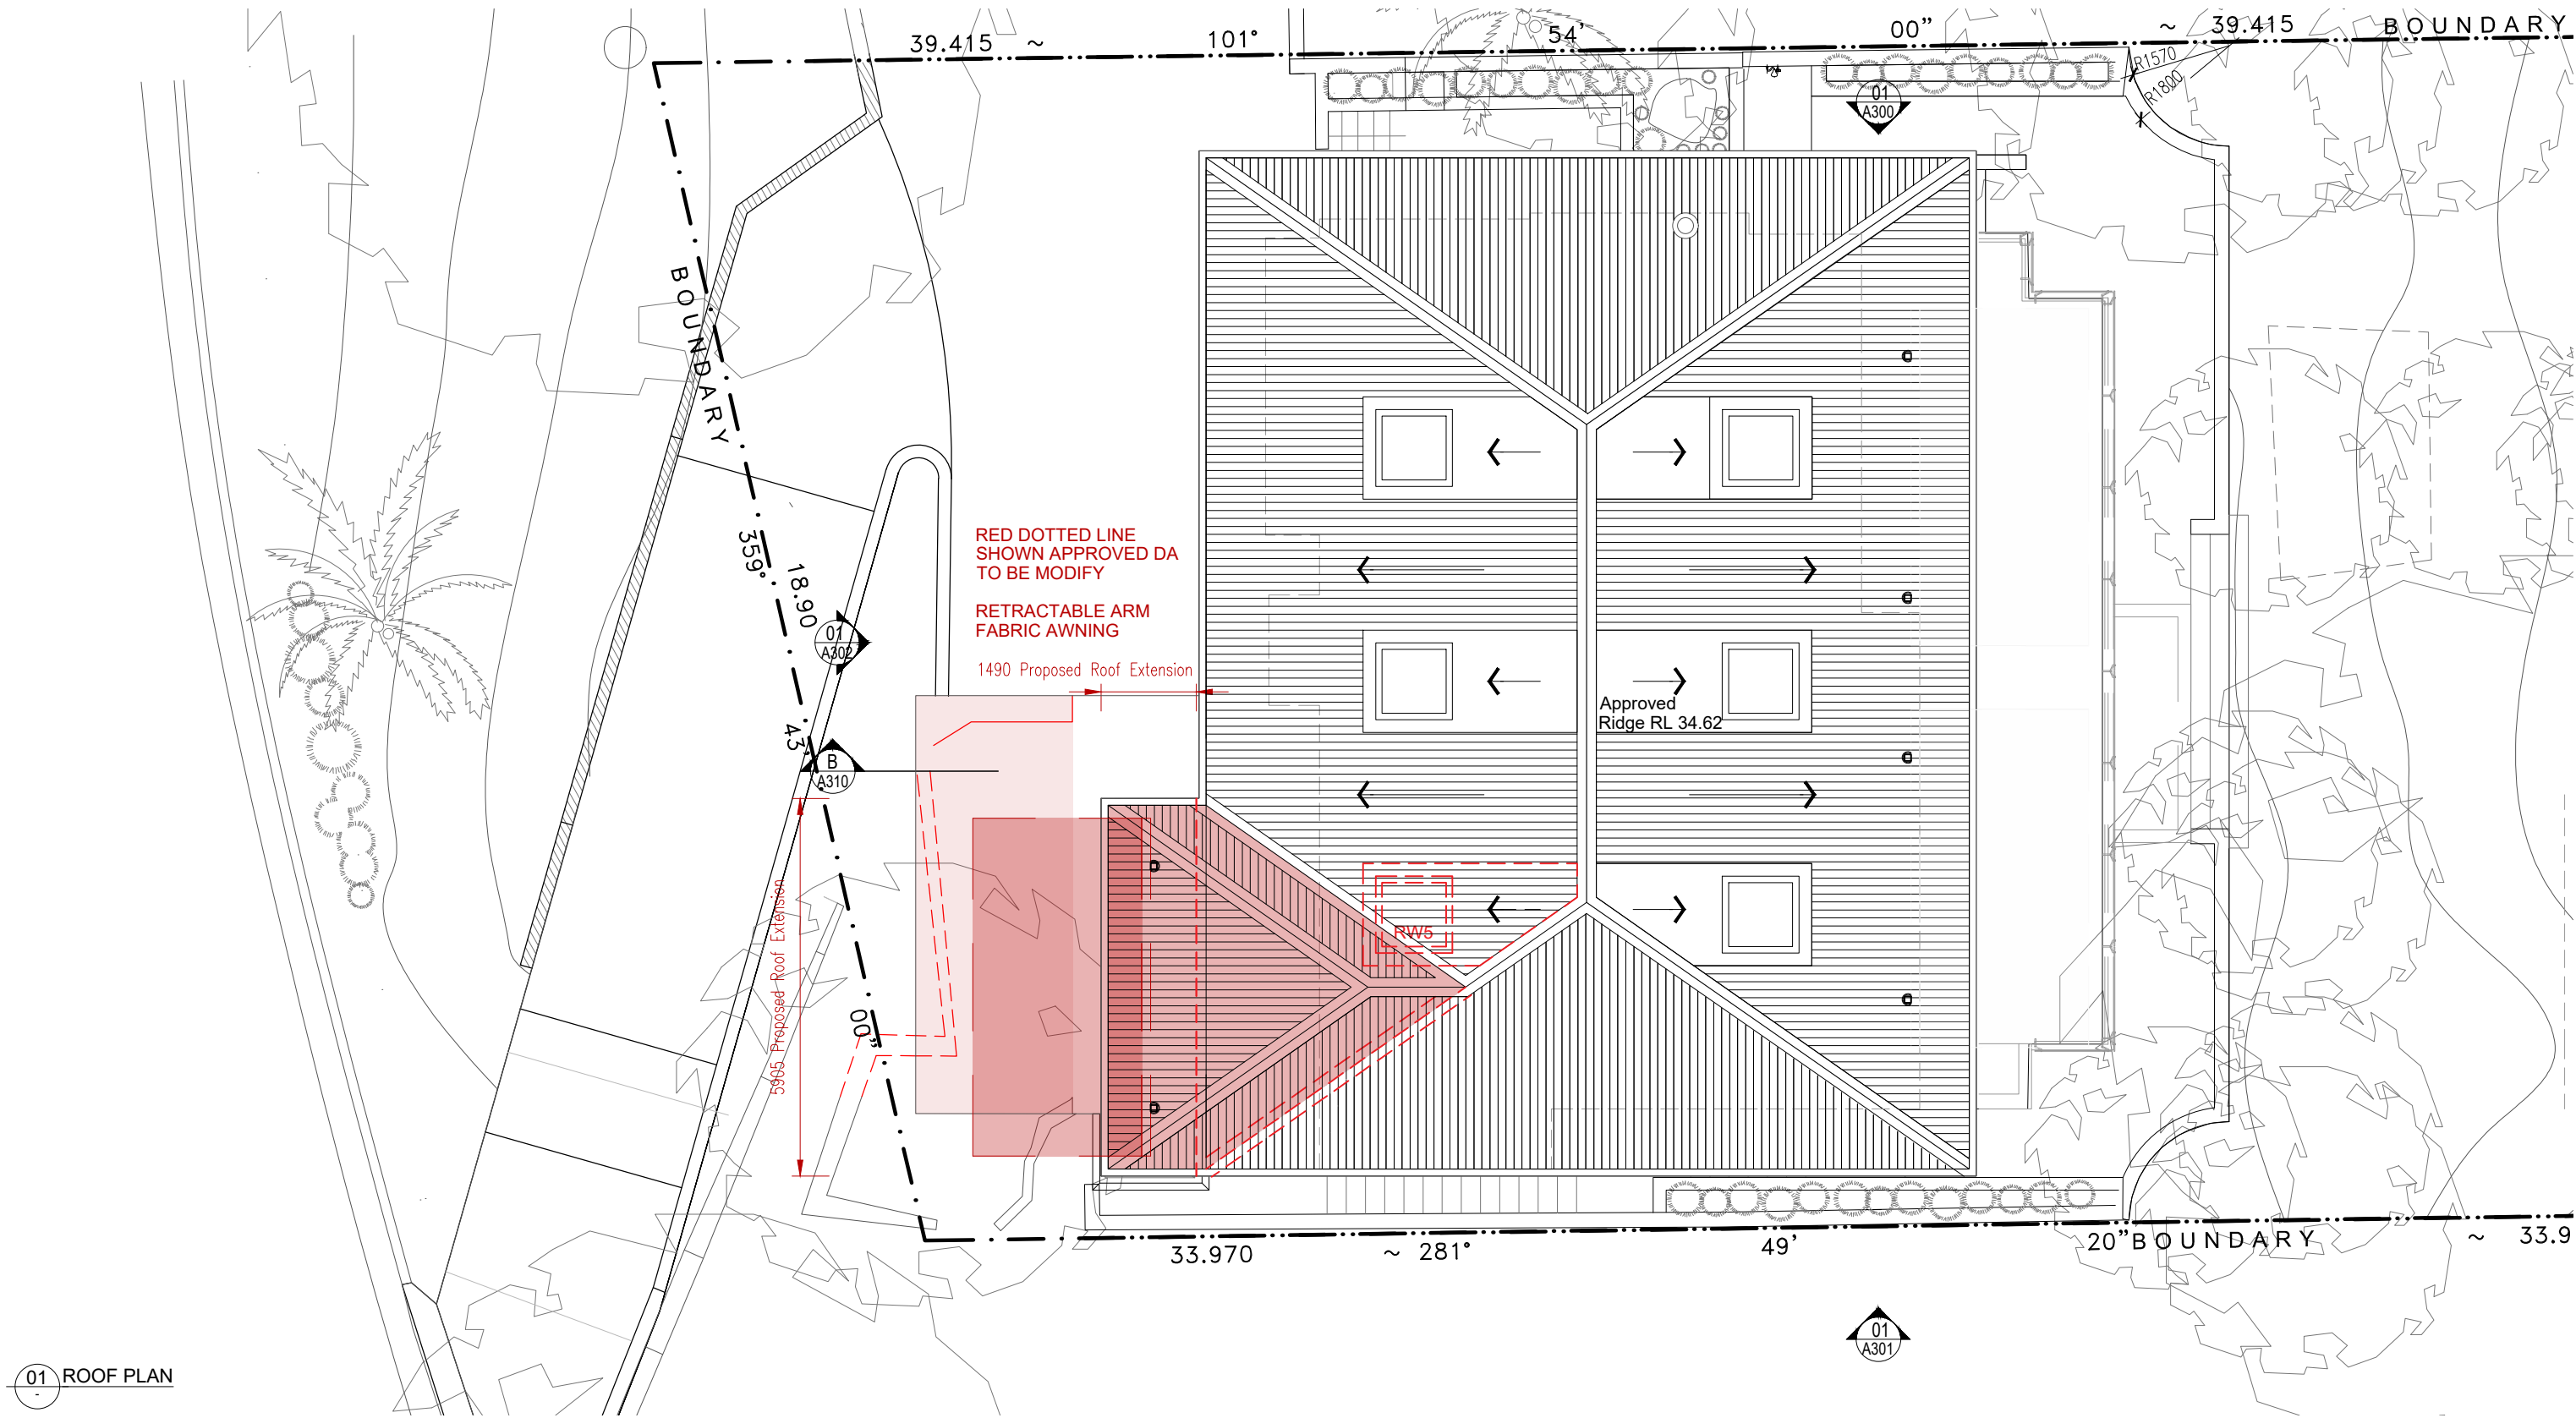

01 ROOF PLAN

PROPOSED D.A. MODIFICATIONS SHOWN IN RED

NOTE: PROPOSED D.A. MODIFICATIONS TO MATCH APPROVED D.A. MATERIALS

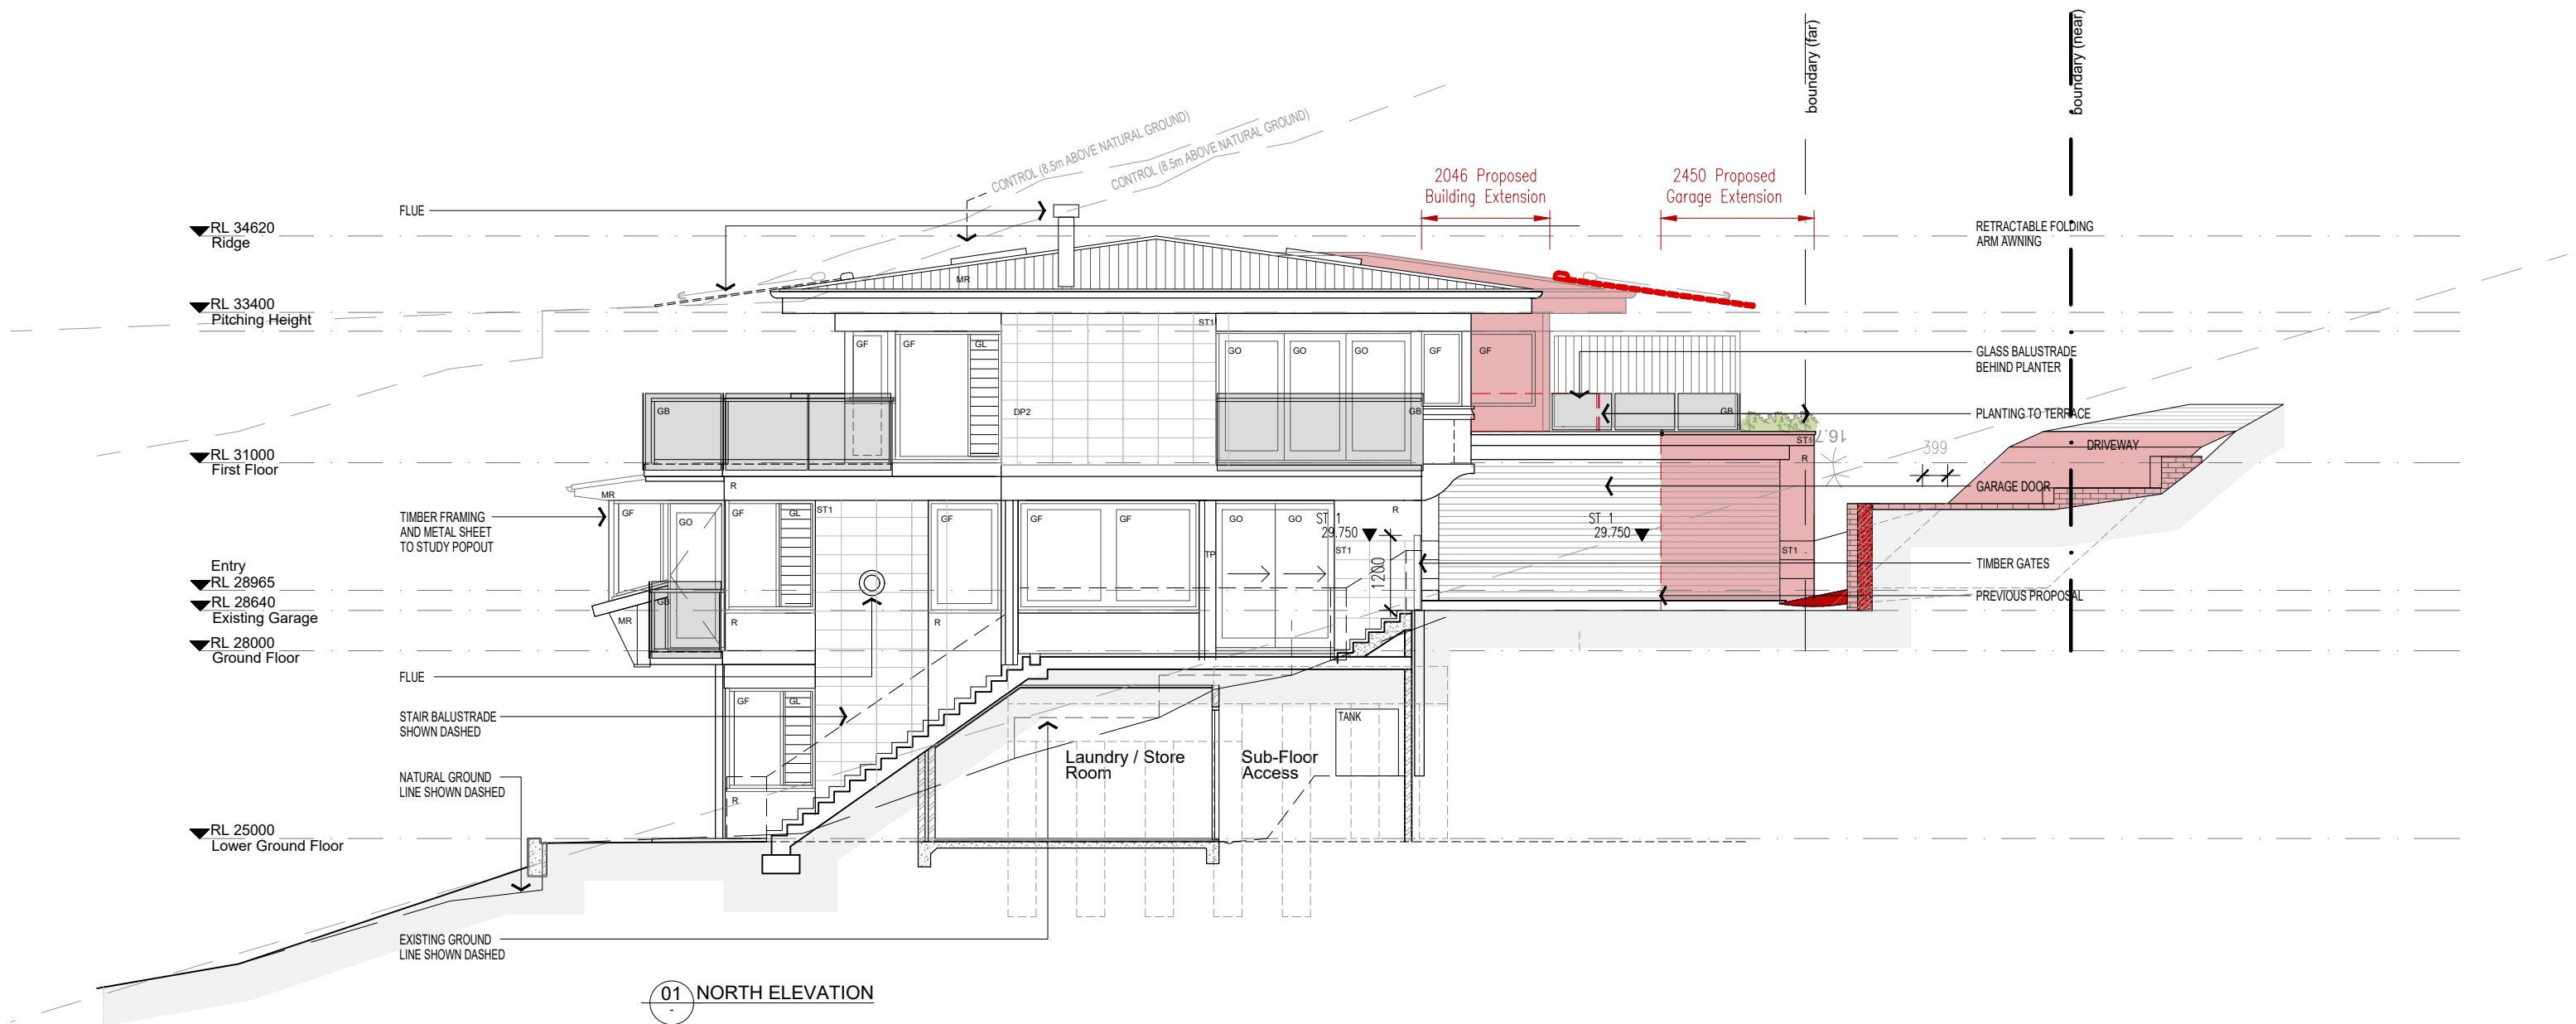

PROPOSED D.A. MODIFICATIONS SHOWN IN RED

NOTE: PROPOSED D.A. MODIFICATIONS TO MATCH
APPROVED D.A. MATERIALS

ALL DIMENSIONS & LEVELS TO BE CHECKED ON
SITE BY CONTRACTOR PRIOR TO CONSTRUCTION.
ALL BOUNDARIES & CONTOURS SUBJECT TO
SURVEY. ALL RIGHTS RESERVED. THIS DRAWING
MAY NOT BE REPRODUCED OR TRANSMITTED, IN
PART OR IN WHOLE WITHOUT THE PERMISSION OF
CRAWFORD ARCHITECTS PTY LTD.

THIS DRAWING IS NOT TO BE USED FOR
CONSTRUCTION UNLESS APPROVED BY A
DIRECTOR OF CRAWFORD ARCHITECTS PTY LTD.

©CRAWFORD ARCHITECTS PTY LTD 2017
SUITE 3.01, LEVEL 3 80 MOUNT STREET
NORTH SYDNEY, NSW 2060 AUSTRALIA
ABN 56 120 779 106
NOMINATED ARCHITECTS:
TONY GRAY 5303 & PAUL GODSELL 6726
P 02 9660 3644
E arch@crawford.com.au
www.crawford.com.au

DATE	ISSUE	AMENDMENTS
04	19.08.21	Revised Section 96 Issue
03	19.03.01	Section 96 Issue
02	18.11.16	DA-S96 REVISION
01	18.10.24	DA-S96 ISSUE

CLIENT
**RICHARD &
NEROLI NAYLOR**

22 PALM BEACH ROAD, PALM BEACH

PROJECT
**EXTENSION
APPROVED GARAGE**

22 PALM BEACH ROAD, PALM BEACH

TITLE
NORTH ELEVATION

SCALE 1:100 @ A3
APPROVED -
DRAWN MG
CHECKED TG
DATE OCTOBER 2018
STATUS DA-S96

PROJECT NUMBER
15083

DRAWING NUMBER
A300

ISSUE
04
crawford
architects



PROPOSED D.A. MODIFICATIONS SHOWN IN RED

NOTE: PROPOSED D.A. MODIFICATIONS TO MATCH
APPROVED D.A. MATERIALS

ALL DIMENSIONS & LEVELS TO BE CHECKED ON
SITE BY CONTRACTOR PRIOR TO CONSTRUCTION.
ALL BOUNDARIES & CONTOURS SUBJECT TO
SURVEY. ALL RIGHTS RESERVED. THIS DRAWING
MAY NOT BE REPRODUCED OR TRANSMITTED, IN
PART OR IN WHOLE WITHOUT THE PERMISSION OF
CRAWFORD ARCHITECTS PTY LTD.

THIS DRAWING IS NOT TO BE USED FOR
CONSTRUCTION UNLESS APPROVED BY A
DIRECTOR OF CRAWFORD ARCHITECTS PTY LTD.

©CRAWFORD ARCHITECTS PTY LTD 2017
SUITE 3.01, LEVEL 3 80 MOUNT STREET
NORTH SYDNEY, NSW 2060 AUSTRALIA
ABN 56 120 779 106
NOMINATED ARCHITECTS:
TONY GRAY 5303 & PAUL GODSELL 6726
P 02 9660 3644
E arch@crawford.com.au
www.crawford.com.au

ISSUE	DATE	AMENDMENTS
04	19.08.21	Revised Section 96 Issue
03	19.03.01	Section 96 Issue
02	18.11.16	DA-S96 REVISION
01	18.10.24	DA-S96 ISSUE

CLIENT
**RICHARD &
NEROLI NAYLOR**

22 PALM BEACH ROAD, PALM BEACH

PROJECT
**EXTENSION
APPROVED GARAGE**

22 PALM BEACH ROAD, PALM BEACH

TITLE
SOUTH ELEVATION


SCALE 1:100 @ A3
APPROVED -
DRAWN MG
CHECKED TG
DATE OCTOBER/2018
STATUS DA-S96

PROJECT NUMBER
15083

DRAWING NUMBER
A301

ISSUE
04

crawford
architects

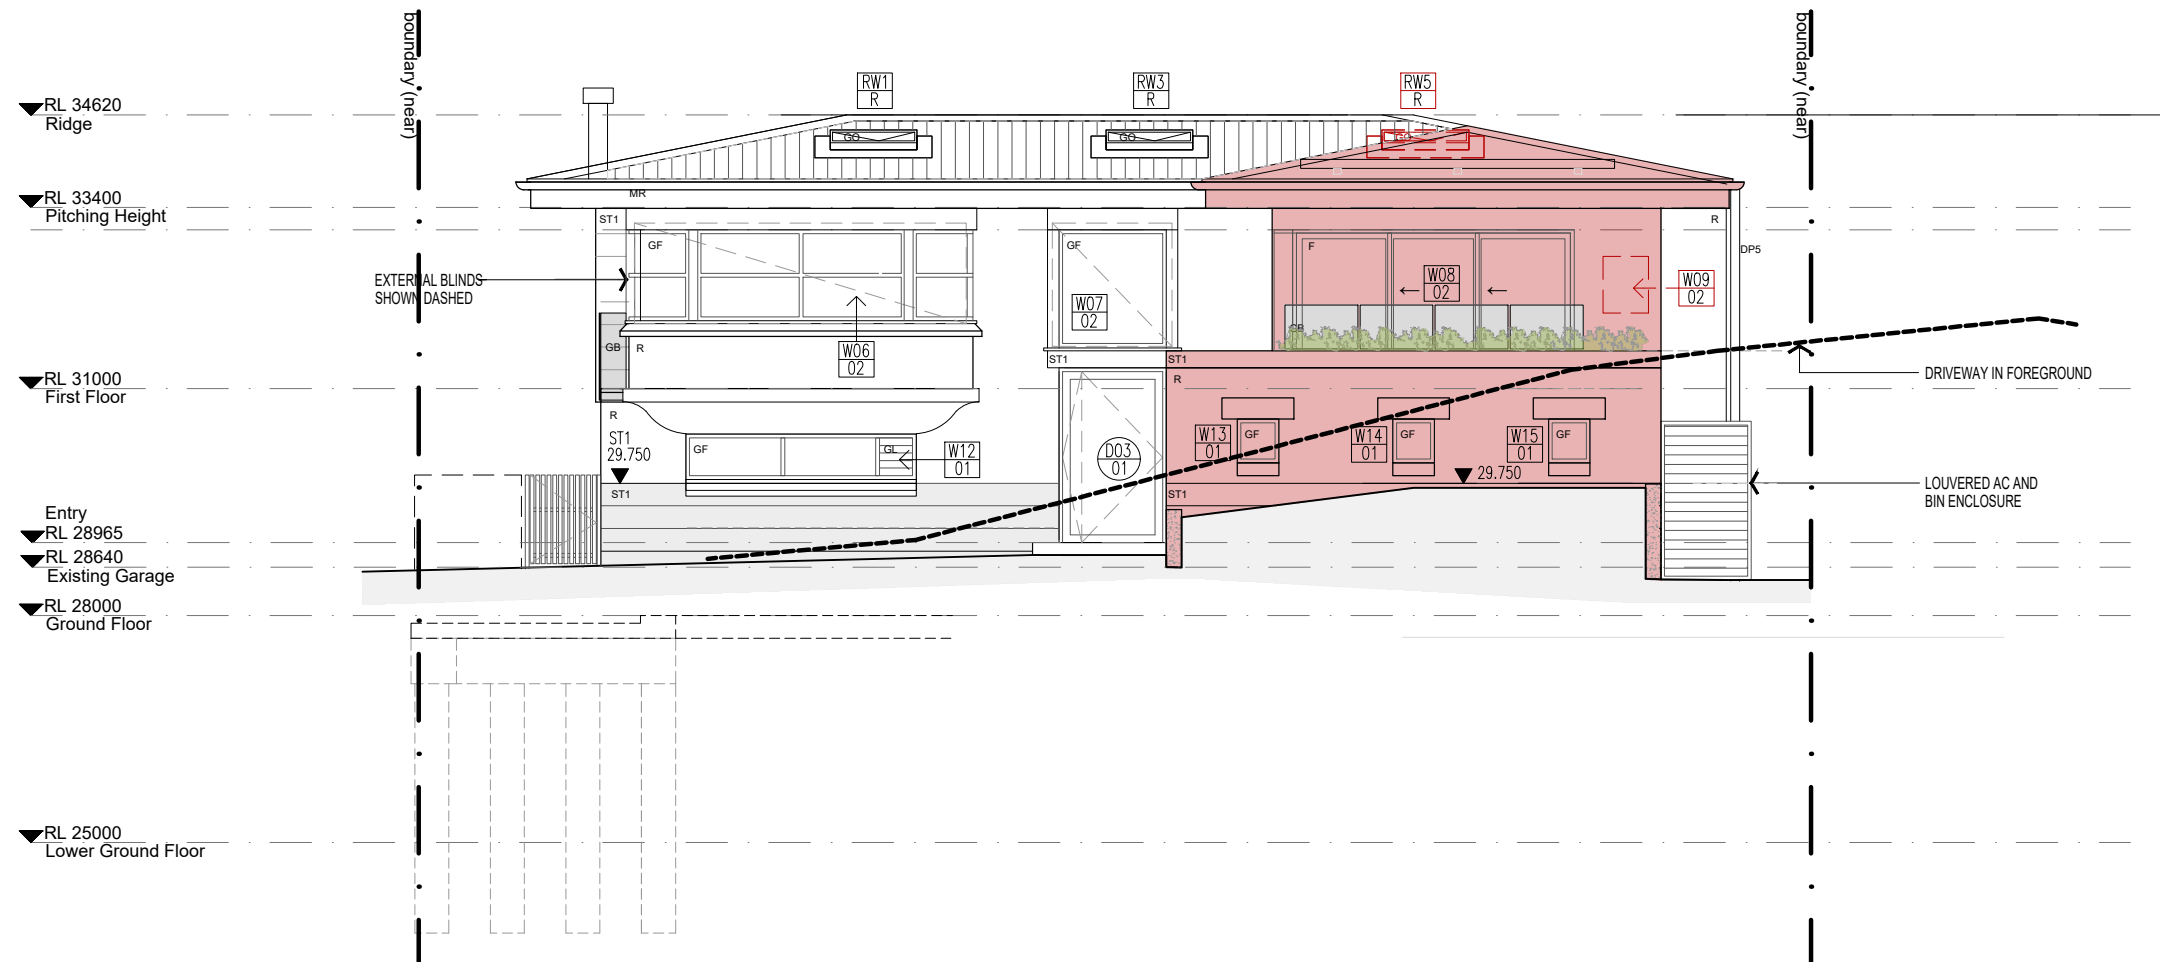

01 WEST ELEVATION
SCALE 1:100 @ A3

PROPOSED D.A. MODIFICATIONS SHOWN IN RED

NOTE: PROPOSED D.A. MODIFICATIONS TO MATCH
APPROVED D.A. MATERIALS

ALL DIMENSIONS & LEVELS TO BE CHECKED ON
SITE BY CONTRACTOR PRIOR TO CONSTRUCTION.
ALL BOUNDARIES & CONTOURS SUBJECT TO
SURVEY. ALL RIGHTS RESERVED. THIS DRAWING
MAY NOT BE REPRODUCED OR TRANSMITTED, IN
PART OR IN WHOLE WITHOUT THE PERMISSION OF
CRAWFORD ARCHITECTS PTY LTD.

THIS DRAWING IS NOT TO BE USED FOR
CONSTRUCTION UNLESS APPROVED BY A
DIRECTOR OF CRAWFORD ARCHITECTS PTY LTD

©CRAWFORD ARCHITECTS PTY LTD 2017
SUITE 3.01, LEVEL 3 80 MOUNT STREET
NORTH SYDNEY, NSW 2060 AUSTRALIA
ABN 56 120 779 106
NOMINATED ARCHITECTS:
TONY GRAY 5303 & PAUL GODSELL 6726
P 02 9660 3644
E arch@crawford.com.au
www.crawford.com.au

ISSUE	DATE	AMENDMENTS
04	19.08.21	Revised Section 96 Issue
03	19.03.01	Section 96 Issue
02	18.11.16	DA-S96 REVISION
01	18.10.24	DA-S96 ISSUE

CLIENT
**RICHARD &
NEROLI NAYLOR**

22 PALM BEACH ROAD, PALM BEACH

PROJECT
**EXTENSION
APPROVED GARAGE**

22 PALM BEACH ROAD, PALM BEACH

TITLE
WEST ELEVATION

SCALE 1:100 @ A3
APPROVED -
DRAWN MG
CHECKED TG
DATE OCTOBER 2018
STATUS DA-S96

PROJECT NUMBER
15083

DRAWING NUMBER
A302

ISSUE
04
crawford
architects