

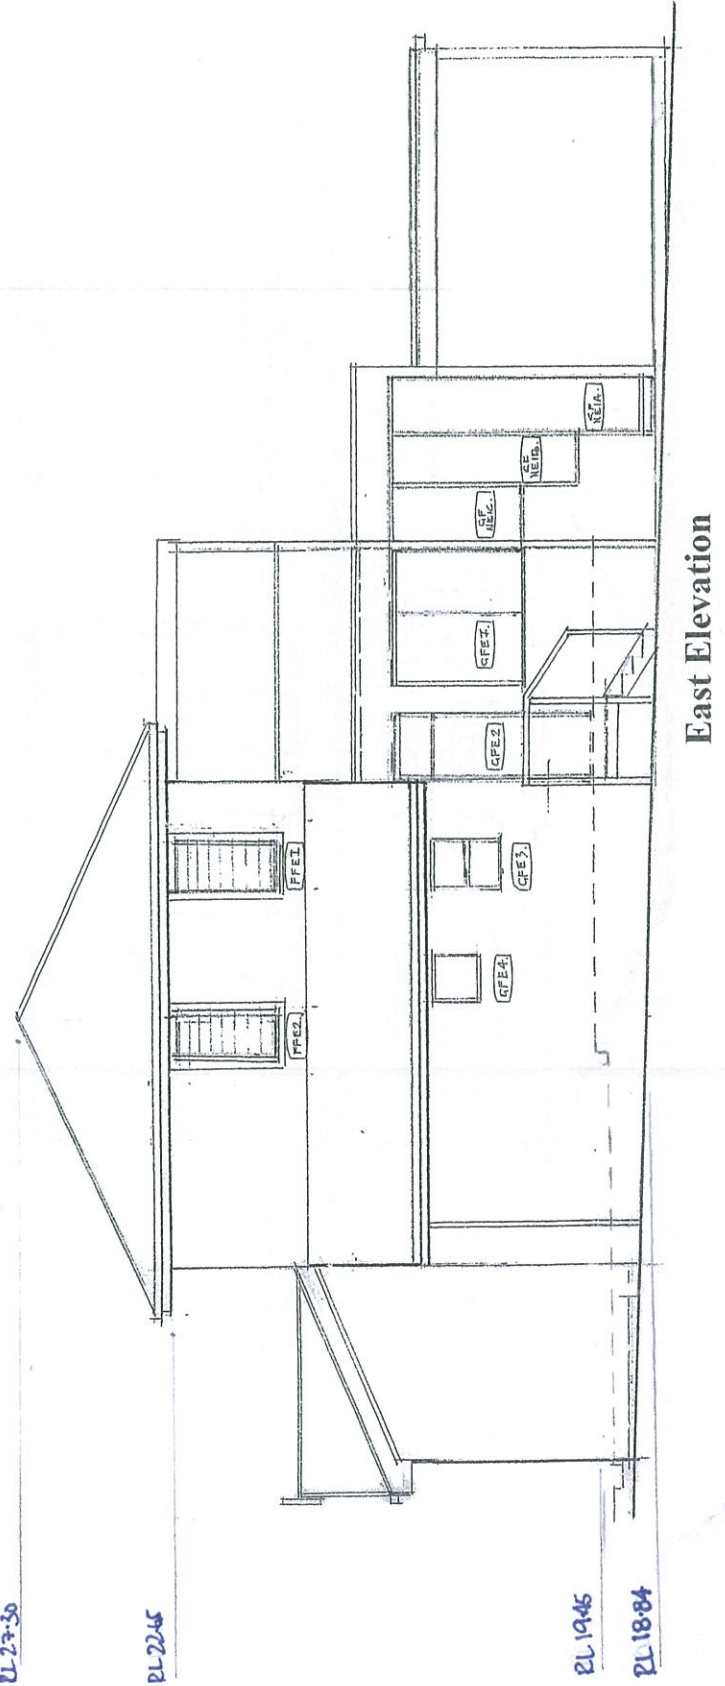


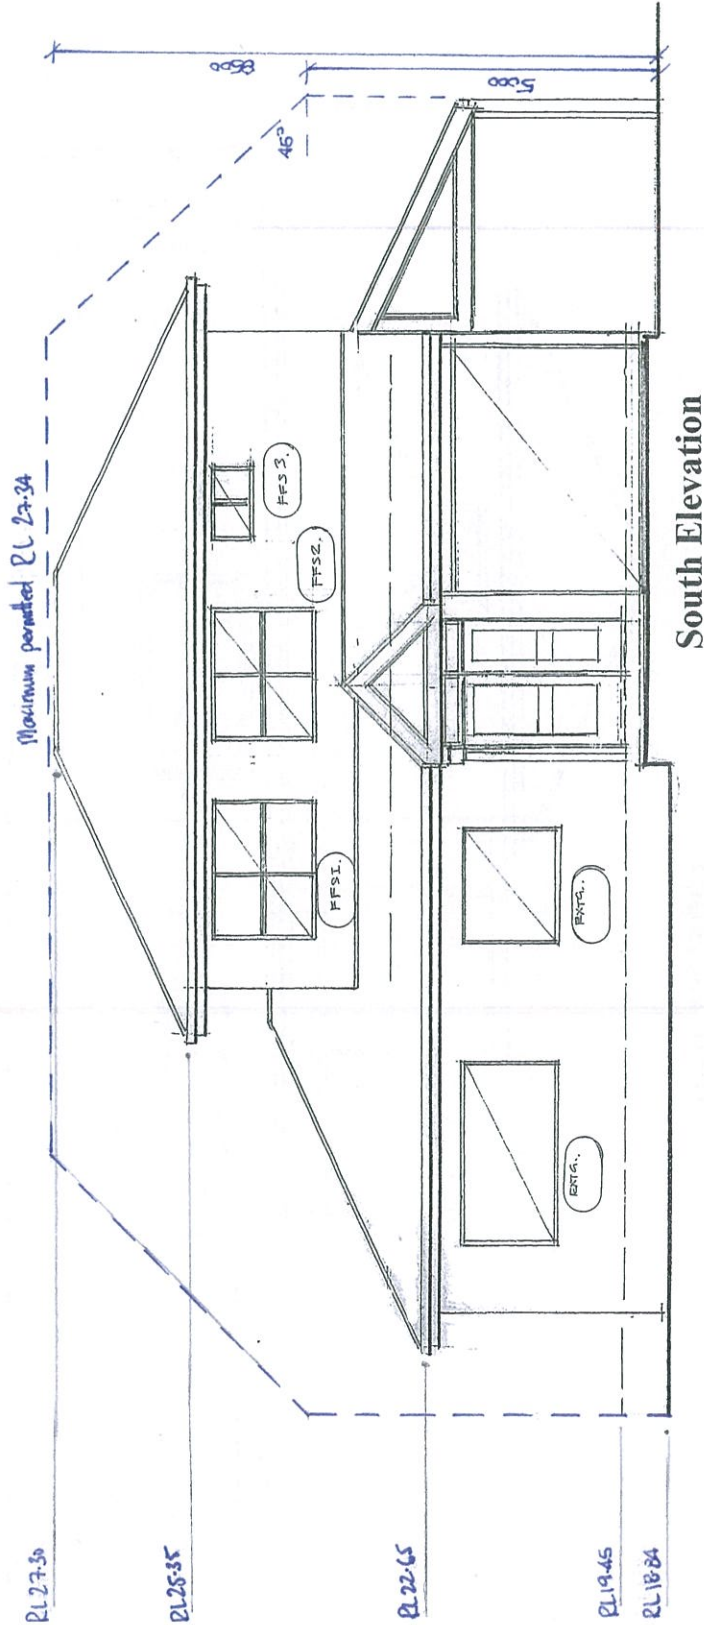


Client	BIERER FAMILY
Project	107 Wyadra Av North Manly

Drawing Series AS BUILT			
Scale:	100/50	Date / rev:	22 Aug 13
Drawn:	PMN	Approved:	
Name:	Elevations		
Number:	0820: 06		

PETER M NOLAN ARCHITECT
 ABN 55302 109541
 9 Antill Crescent
 Baulkham Hills NSW 2153
 Phone 0418 224 327
 Email p.m.nolan@bigpond.com

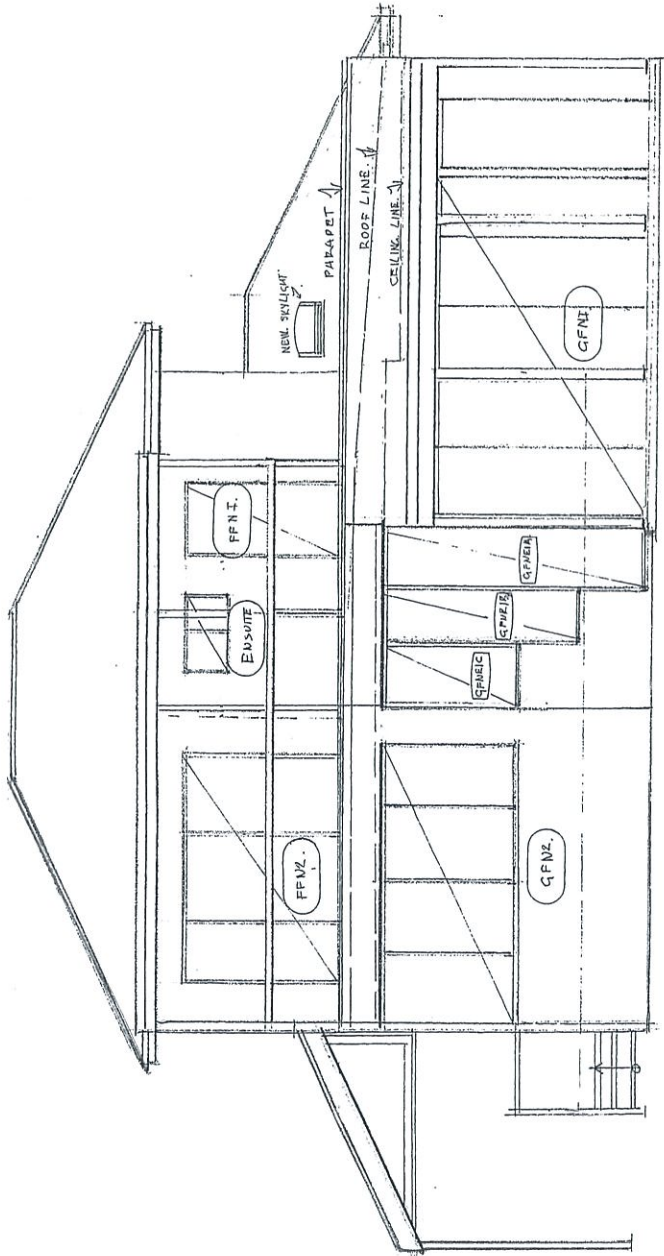

North Elevation

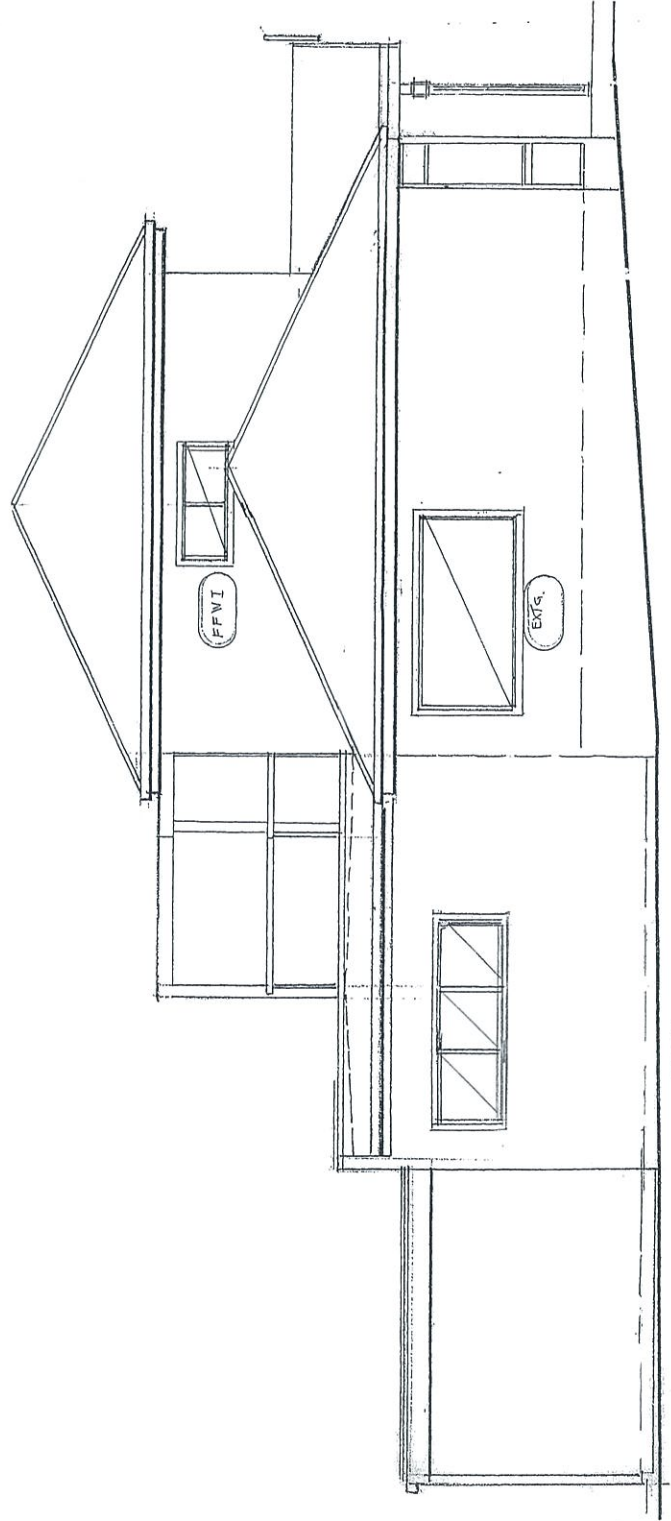

GFV2

West Elevation

Client	BIERER FAMILY
Project	107 Wyadra Av North Manly

Drawing Series	
AS BUILT	
Scale1:	100/50
Drawn:	PMN
Name:	Elevations
Number:	0820: 05

PETER M NOLAN ARCHITECT	
ABN 55302 109541	
9 Antill Crescent	
Baulkham Hills NSW 2153	
Phone 0418 224 327	
Email p.m.nolan@bigpond.com	