

As Built Buidling Certifciate

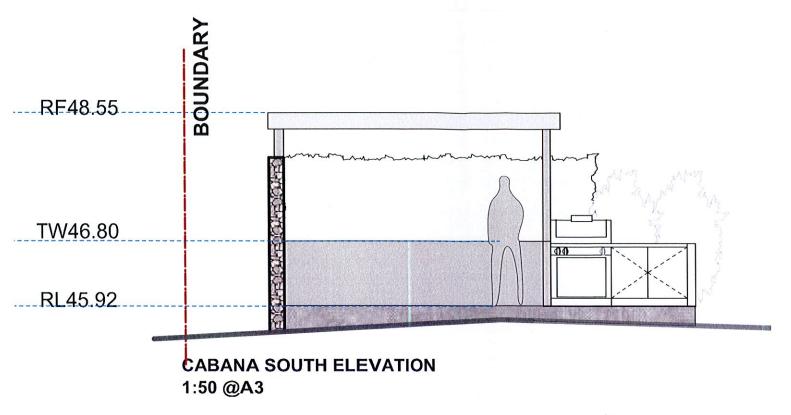

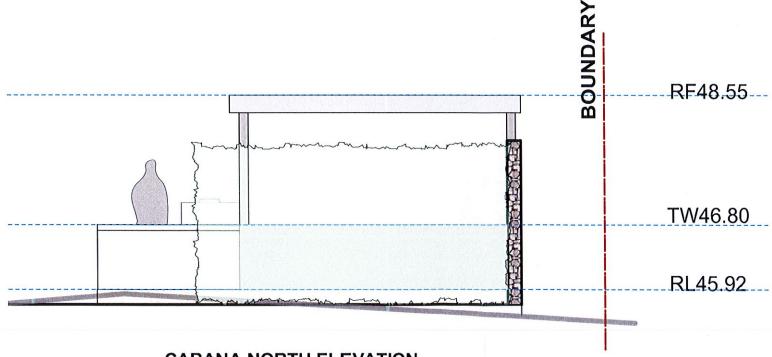

CABANA NORTH ELEVATION 1:50 @A3

Page

03

creating gardens to live in and enjoy

SITEDESIGN +STUDIOS

Po Box 265 SEAFORTH NSW 2093 Julian Brady M: 0417685846 E: Julian@sdstudios.com.au p 1300 22 44 55 info@sdstudios.com.au

s.com.au 22 44 55 ss.com.au Drawi

Project ALTERATION AND ADDITION

Address 21 TUTUS ST BALGOWLAH HEIGHTS NSW Revision A/1

Drawing Title CABANA ELEVATION

Date 04.05.17 Scale 1:50 @A3 Drawing No. 14-687

AMENDMENTS - ISSUE DATE COMMENT

NOTES
GENERAL NOTES
All work to be carr
all Local and State

A/1 04.5.17 ASBUILD BUILDING ISSUE

landscape architects // construction // maintenance // irrigation