


northern beaches council

THIS PLAN IS TO BE READ IN CONJUNCTION WITH THE CONDITIONS OF DEVELOPMENT CONSENT

DA2022/0775

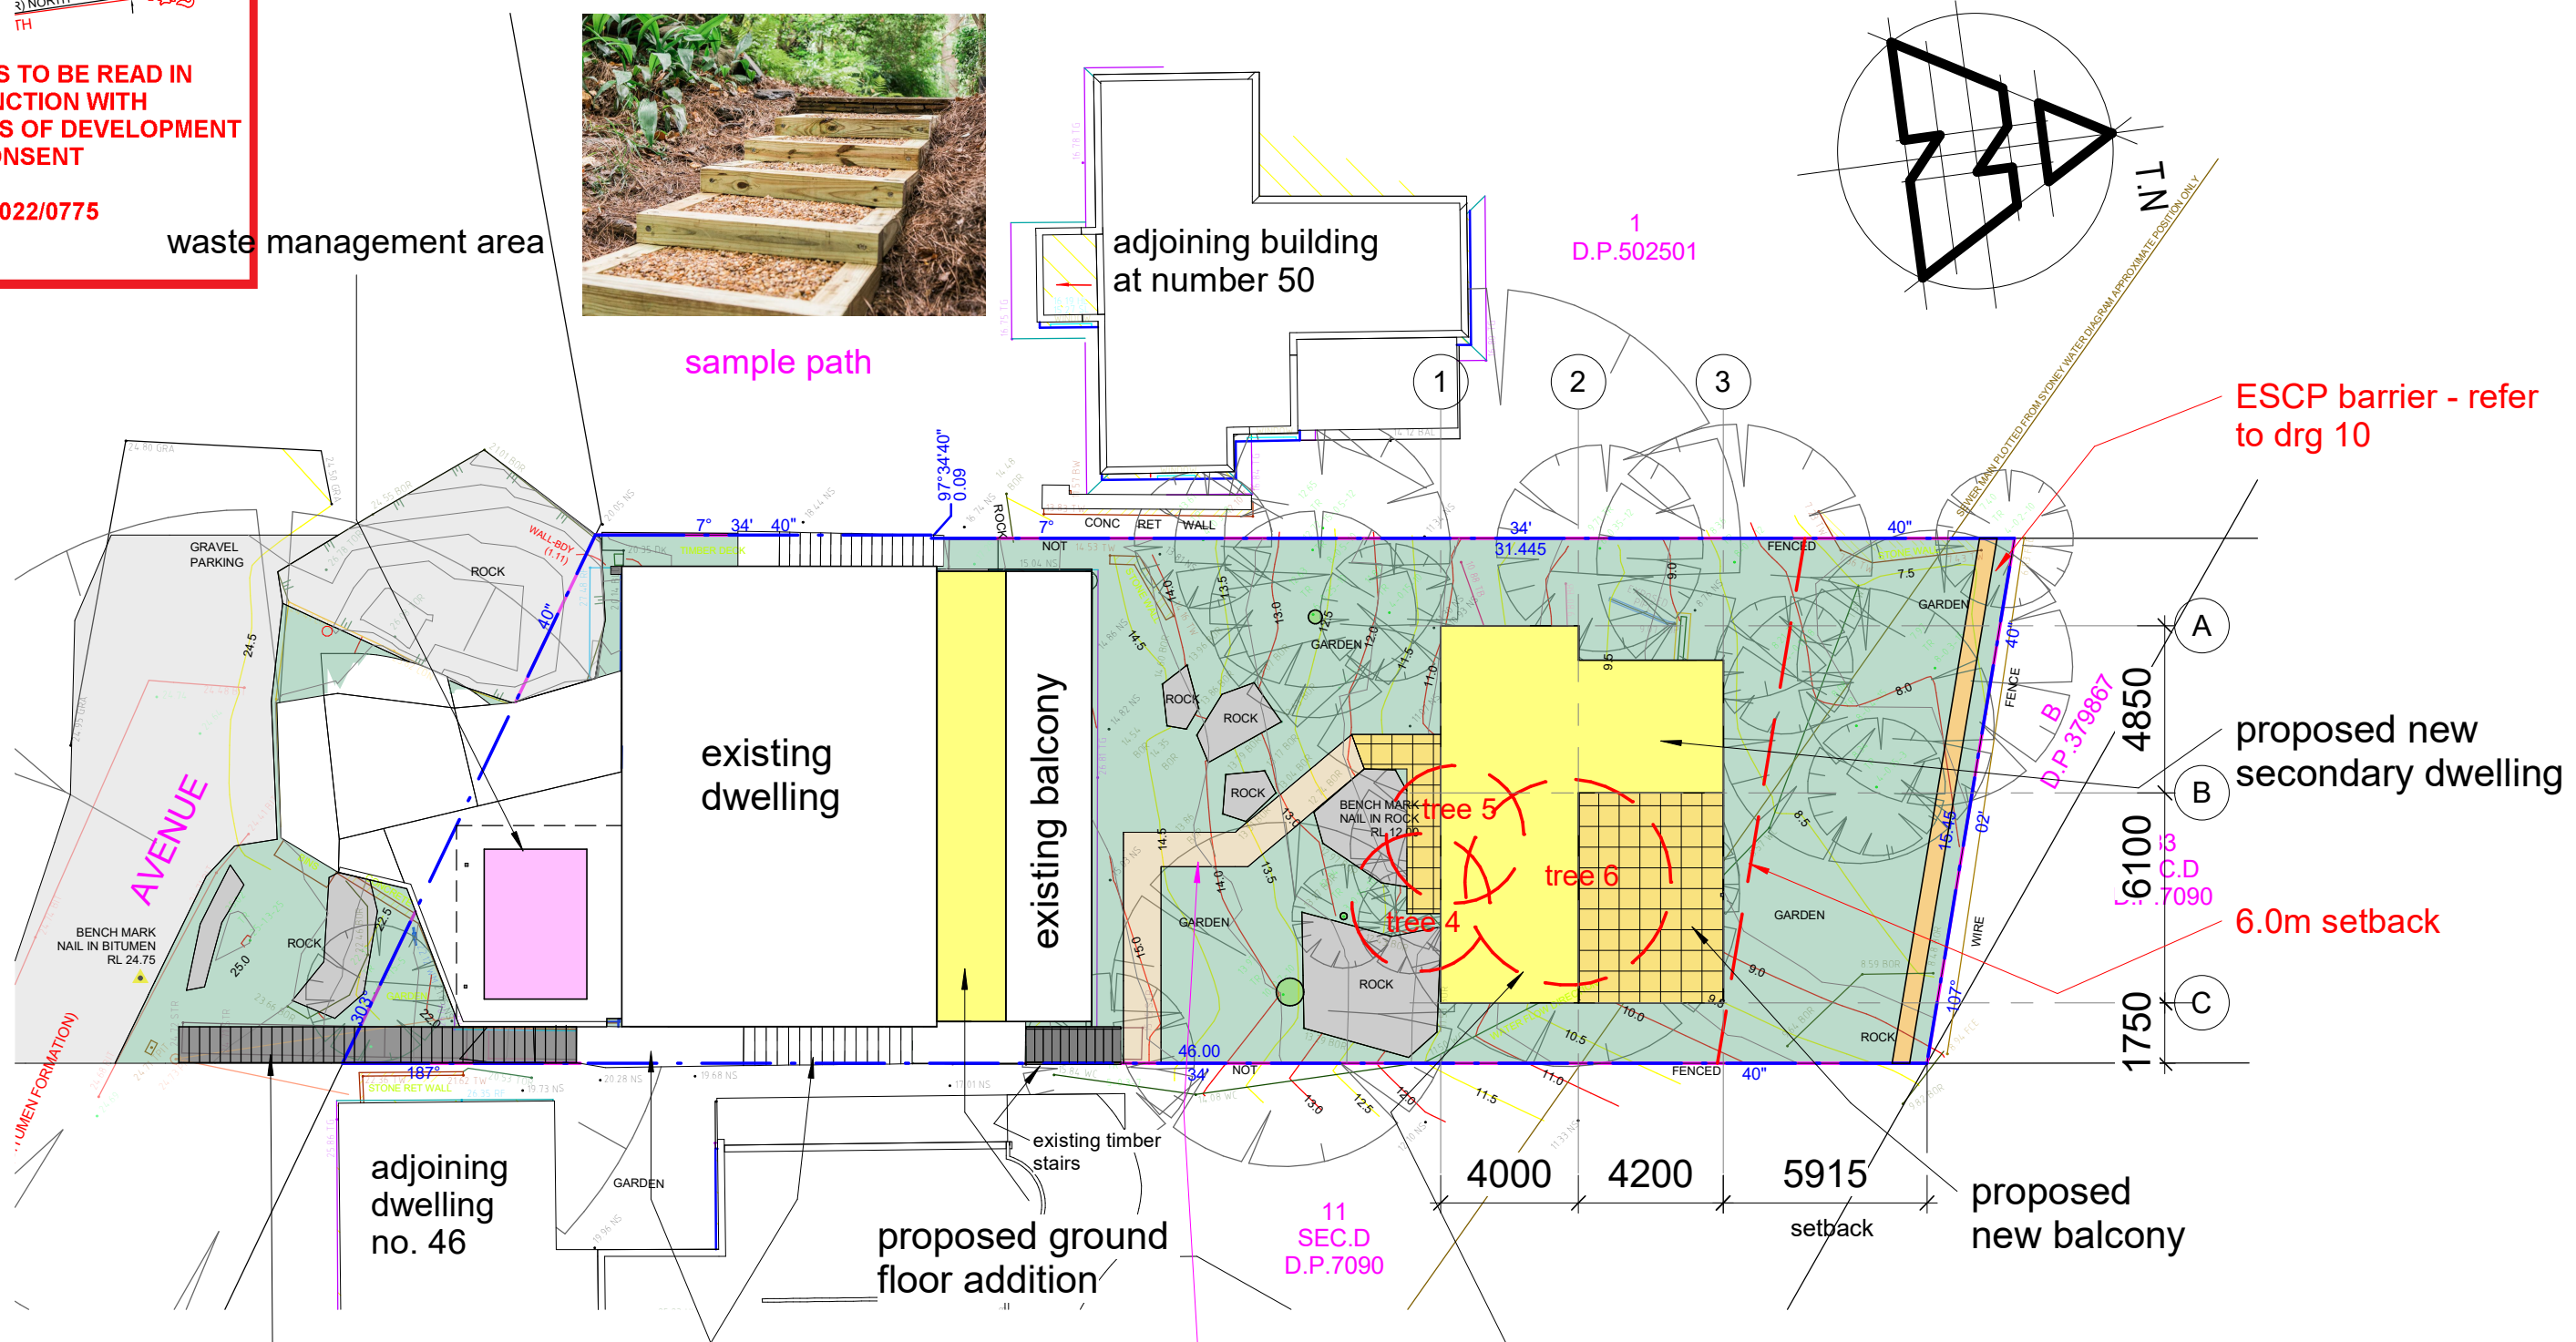

existing concrete stairs and landing

existing concrete stairs and paths


1000 wide access path with steps consisting of decorative gravel treads and landings and timber riser. The path is to follow the ground levels

trees to be removed shown in red. Tree 5 to be replaced in accordance with the Flora and Fauna report recommendations.



REVISION REV A 18.07.22 SECONDARY DWELLING ACCESS STAIRS AND PATH ALTERED	multi-award winner address 77 Riviera rd, Avalon 2107 phone 0488 662 445 www.peterdownes.com	PROJECT New secondary dwelling at 48 Lindley Ave, Narrabeen DRAWING Site Plan	DRAWN PD	CHECKED PD
			SCALE 1 : 200	DATE 18.8.19
			DRG. No. A3	
			2201-01A	

DA ISSUE

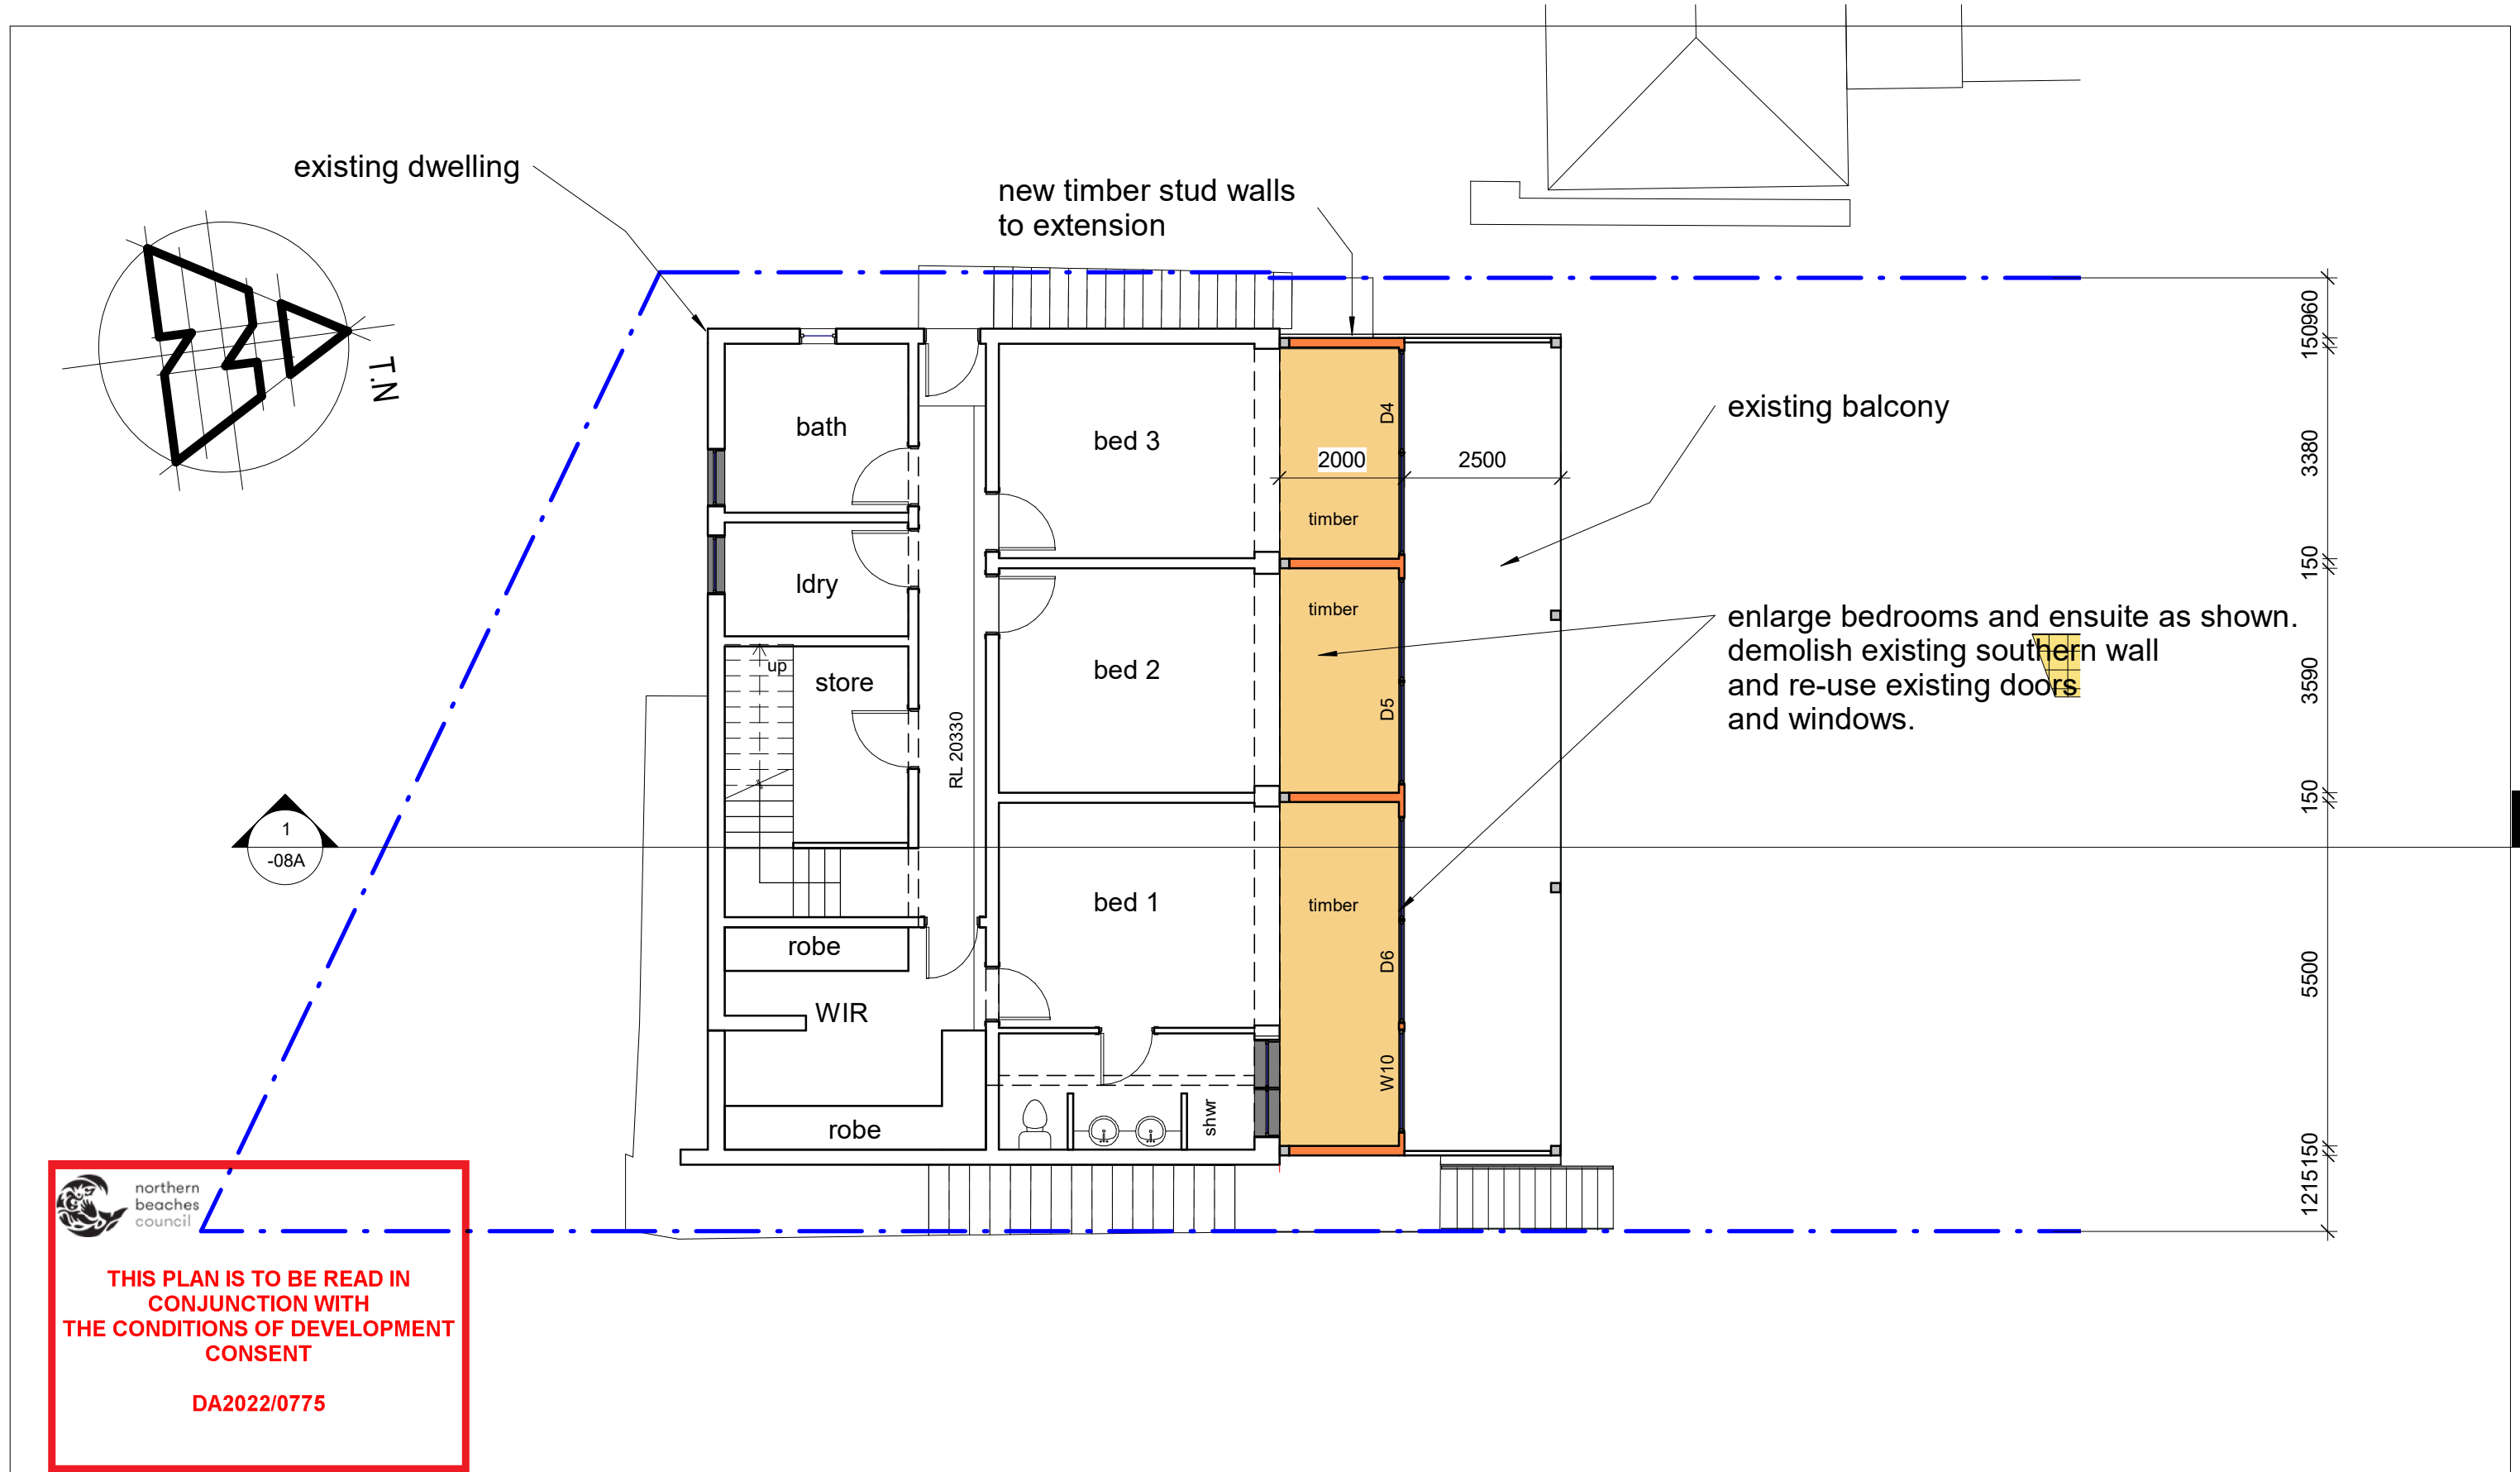

REVISION	REV A 18.07.22 SECONDARY DWELLING ACCESS STAIRS AND PATH ALTERED	 address 77 Riviera rd, Avalon 2107 phone 0488 662 445 www.peterdownes.com	PROJECT New secondary dwelling at 48 Lindley Ave, Narrabeen		DRAWN PD	CHECKED PD
			DRAWING ground floor plan house		SCALE 1 : 100	DATE 01.04.22
					DRG. No. A3	2201-02A
					DA ISSUE	

WINDOW AND DOOR SCHEDULE				
Mark	Orientation	Width	Height	Description
W1	E	2700	600	2 awning, 1 fixed
W2	S	900	600	1 awning
W3	S	900	600	1 awning
W4	S	1600	600	2 awning
W5	W	2700	600	2 awning, 1 fixed
W6	N	800	2400	1 louvre
W7	W	2700	600	2 awning, 1 fixed
W8	N	800	2400	1 louvre
W9	N	800	2400	1 louvre
D1	N	2700	2400	3 stacking
D2	N	2700	2400	3 stacking
D3	S	820	2400	selected front door
SK1	N	460	780	1 fixed
SK2	N	460	780	1 fixed
SK3	N	460	780	1 fixed
W10	N	1650	2700	1 fixed
D4	N	3300	2700	2 sliding
D5	N	3300	2700	2 sliding
D6	N	3300	2700	2 sliding

WINDOW AND DOOR NOTES

- all windows and doors to be powder coated aluminium
- all window and door dimensions to be verified by the builder
- all doors and windows to be fitted with draft seals
- glazing specification to be in accordance with BASIX etc



THIS PLAN IS TO BE READ IN CONJUNCTION WITH THE CONDITIONS OF DEVELOPMENT CONSENT

DA2022/0775

All work to Geotech, and BASIX requirements.



REVISION


REV A 18.07.22

SECONDARY DWELLING ACCESS STAIRS AND PATH ALTERED





address 77 Riviera rd, Avalon 2107
phone 0488 662 445 www.peterdownes.com

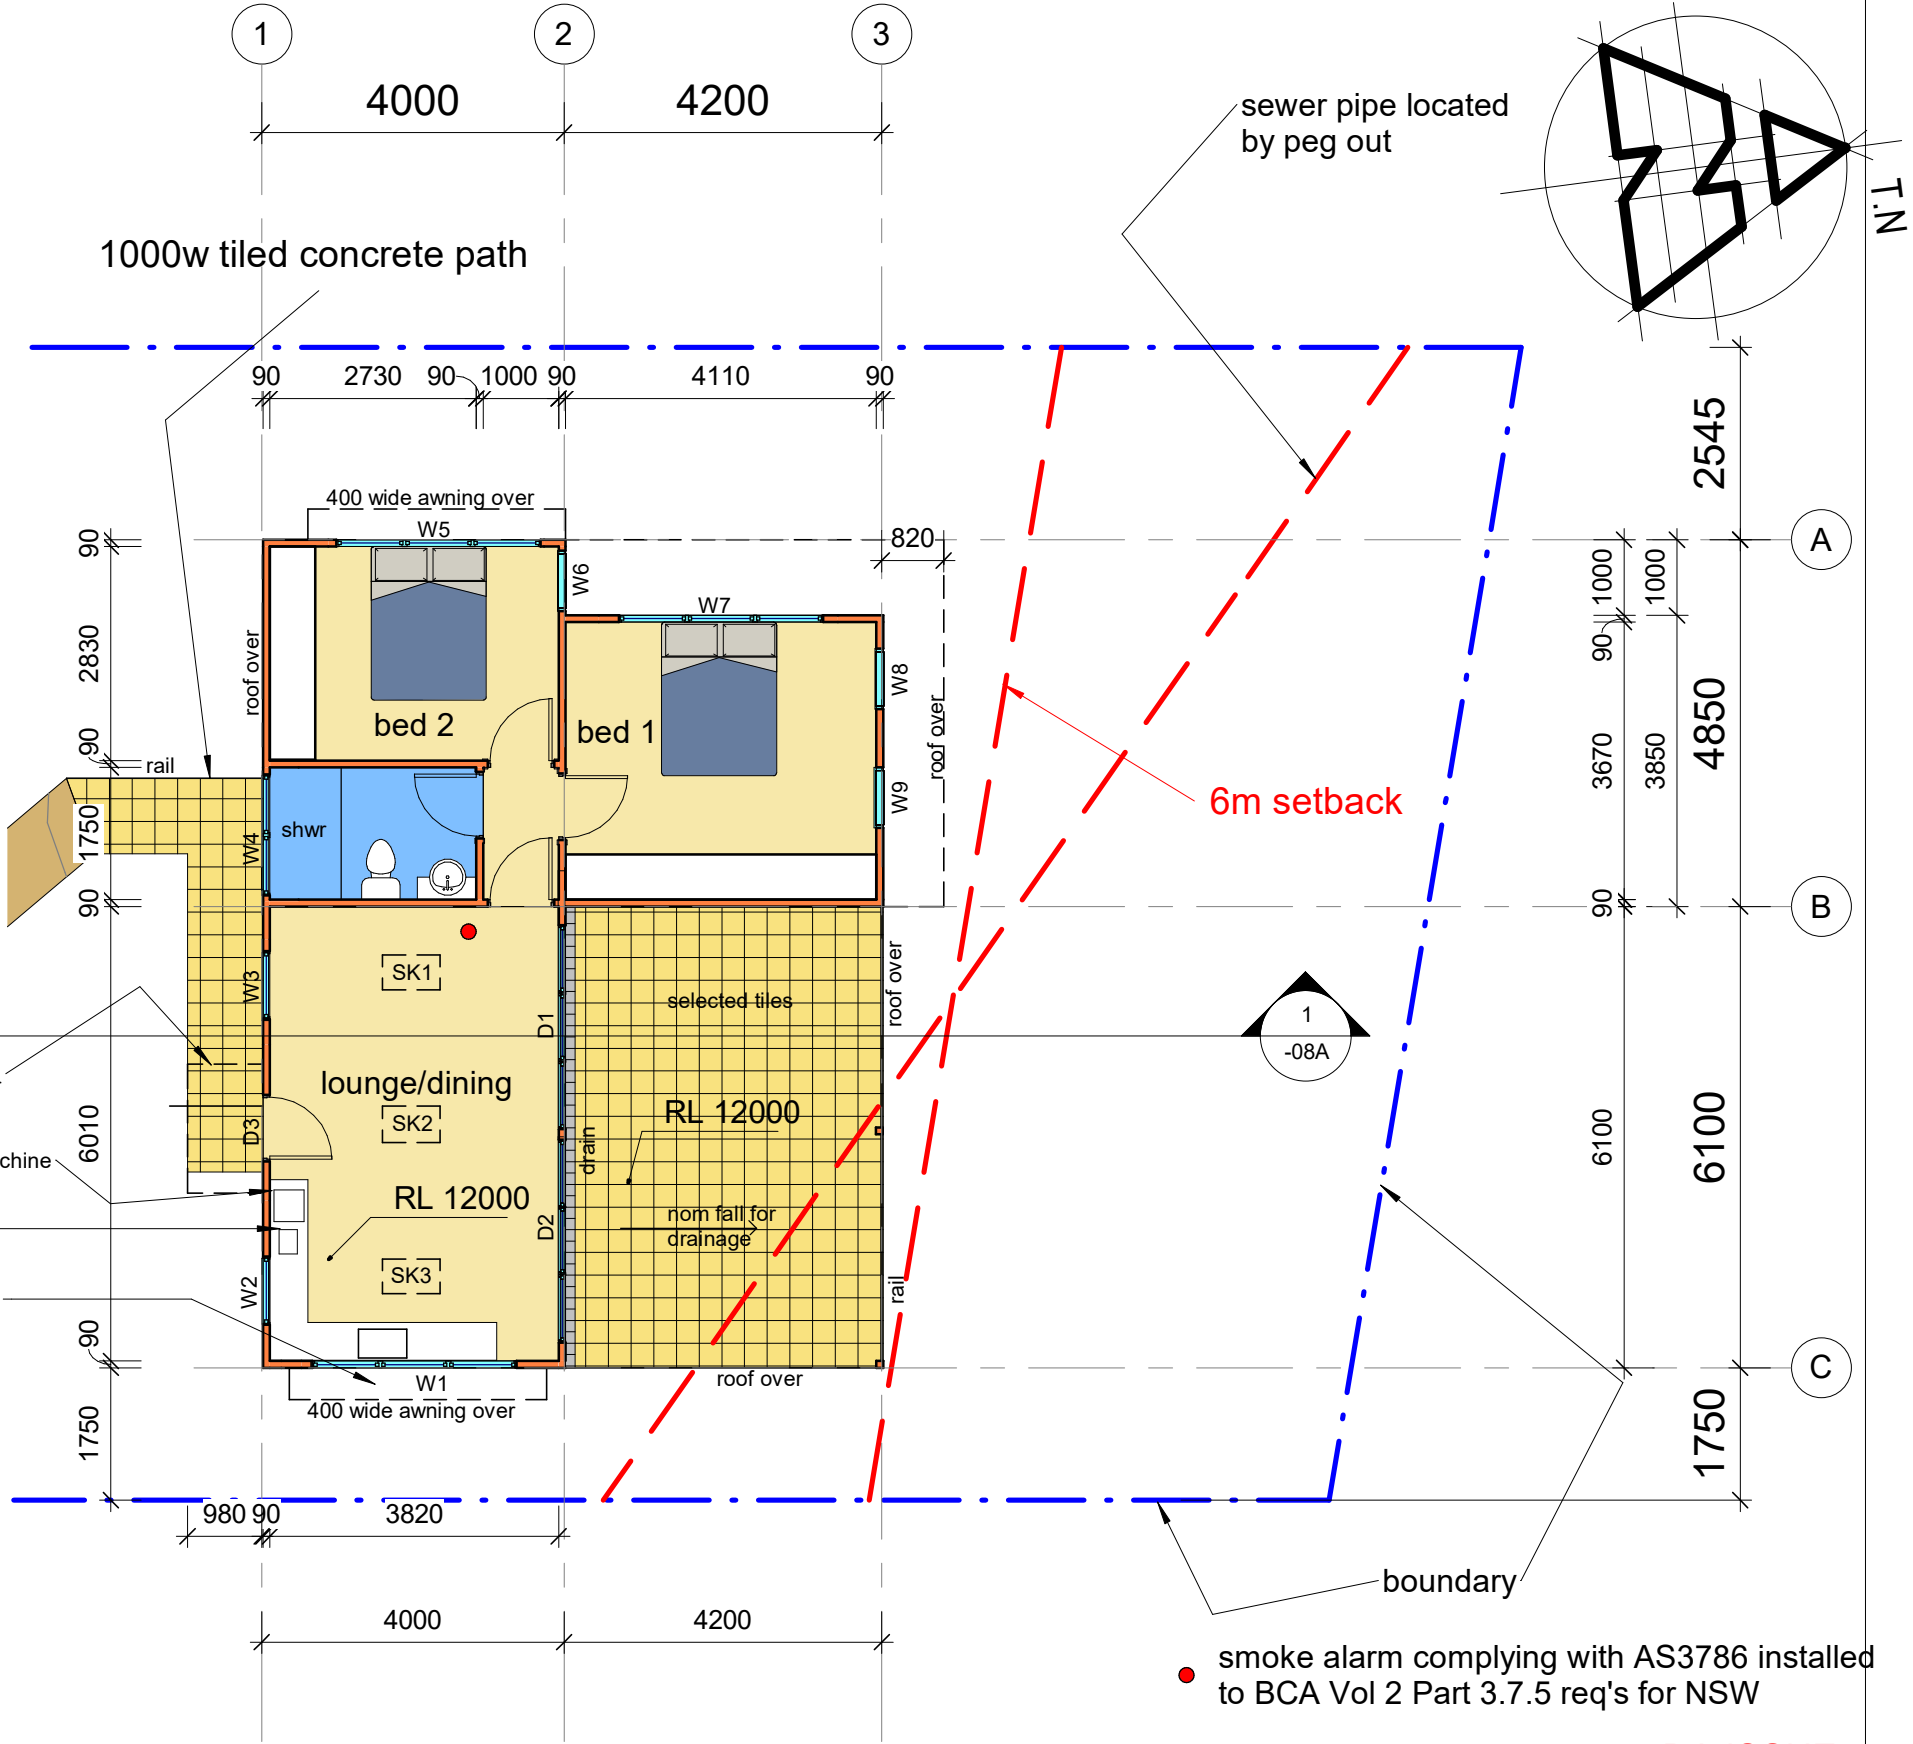

DA ISSUE


PROJECT New secondary dwelling at 48 Lindley Ave, Narrabeen	DRAWN PD	CHECKED PD
	SCALE 1 : 100	DATE 01.04.22
	DRG. No. A3 2201 -03A	



northern
beaches
council

THIS PLAN IS TO BE READ IN
CONJUNCTION WITH
THE CONDITIONS OF DEVELOPMENT
CONSENT

DA2022/0775

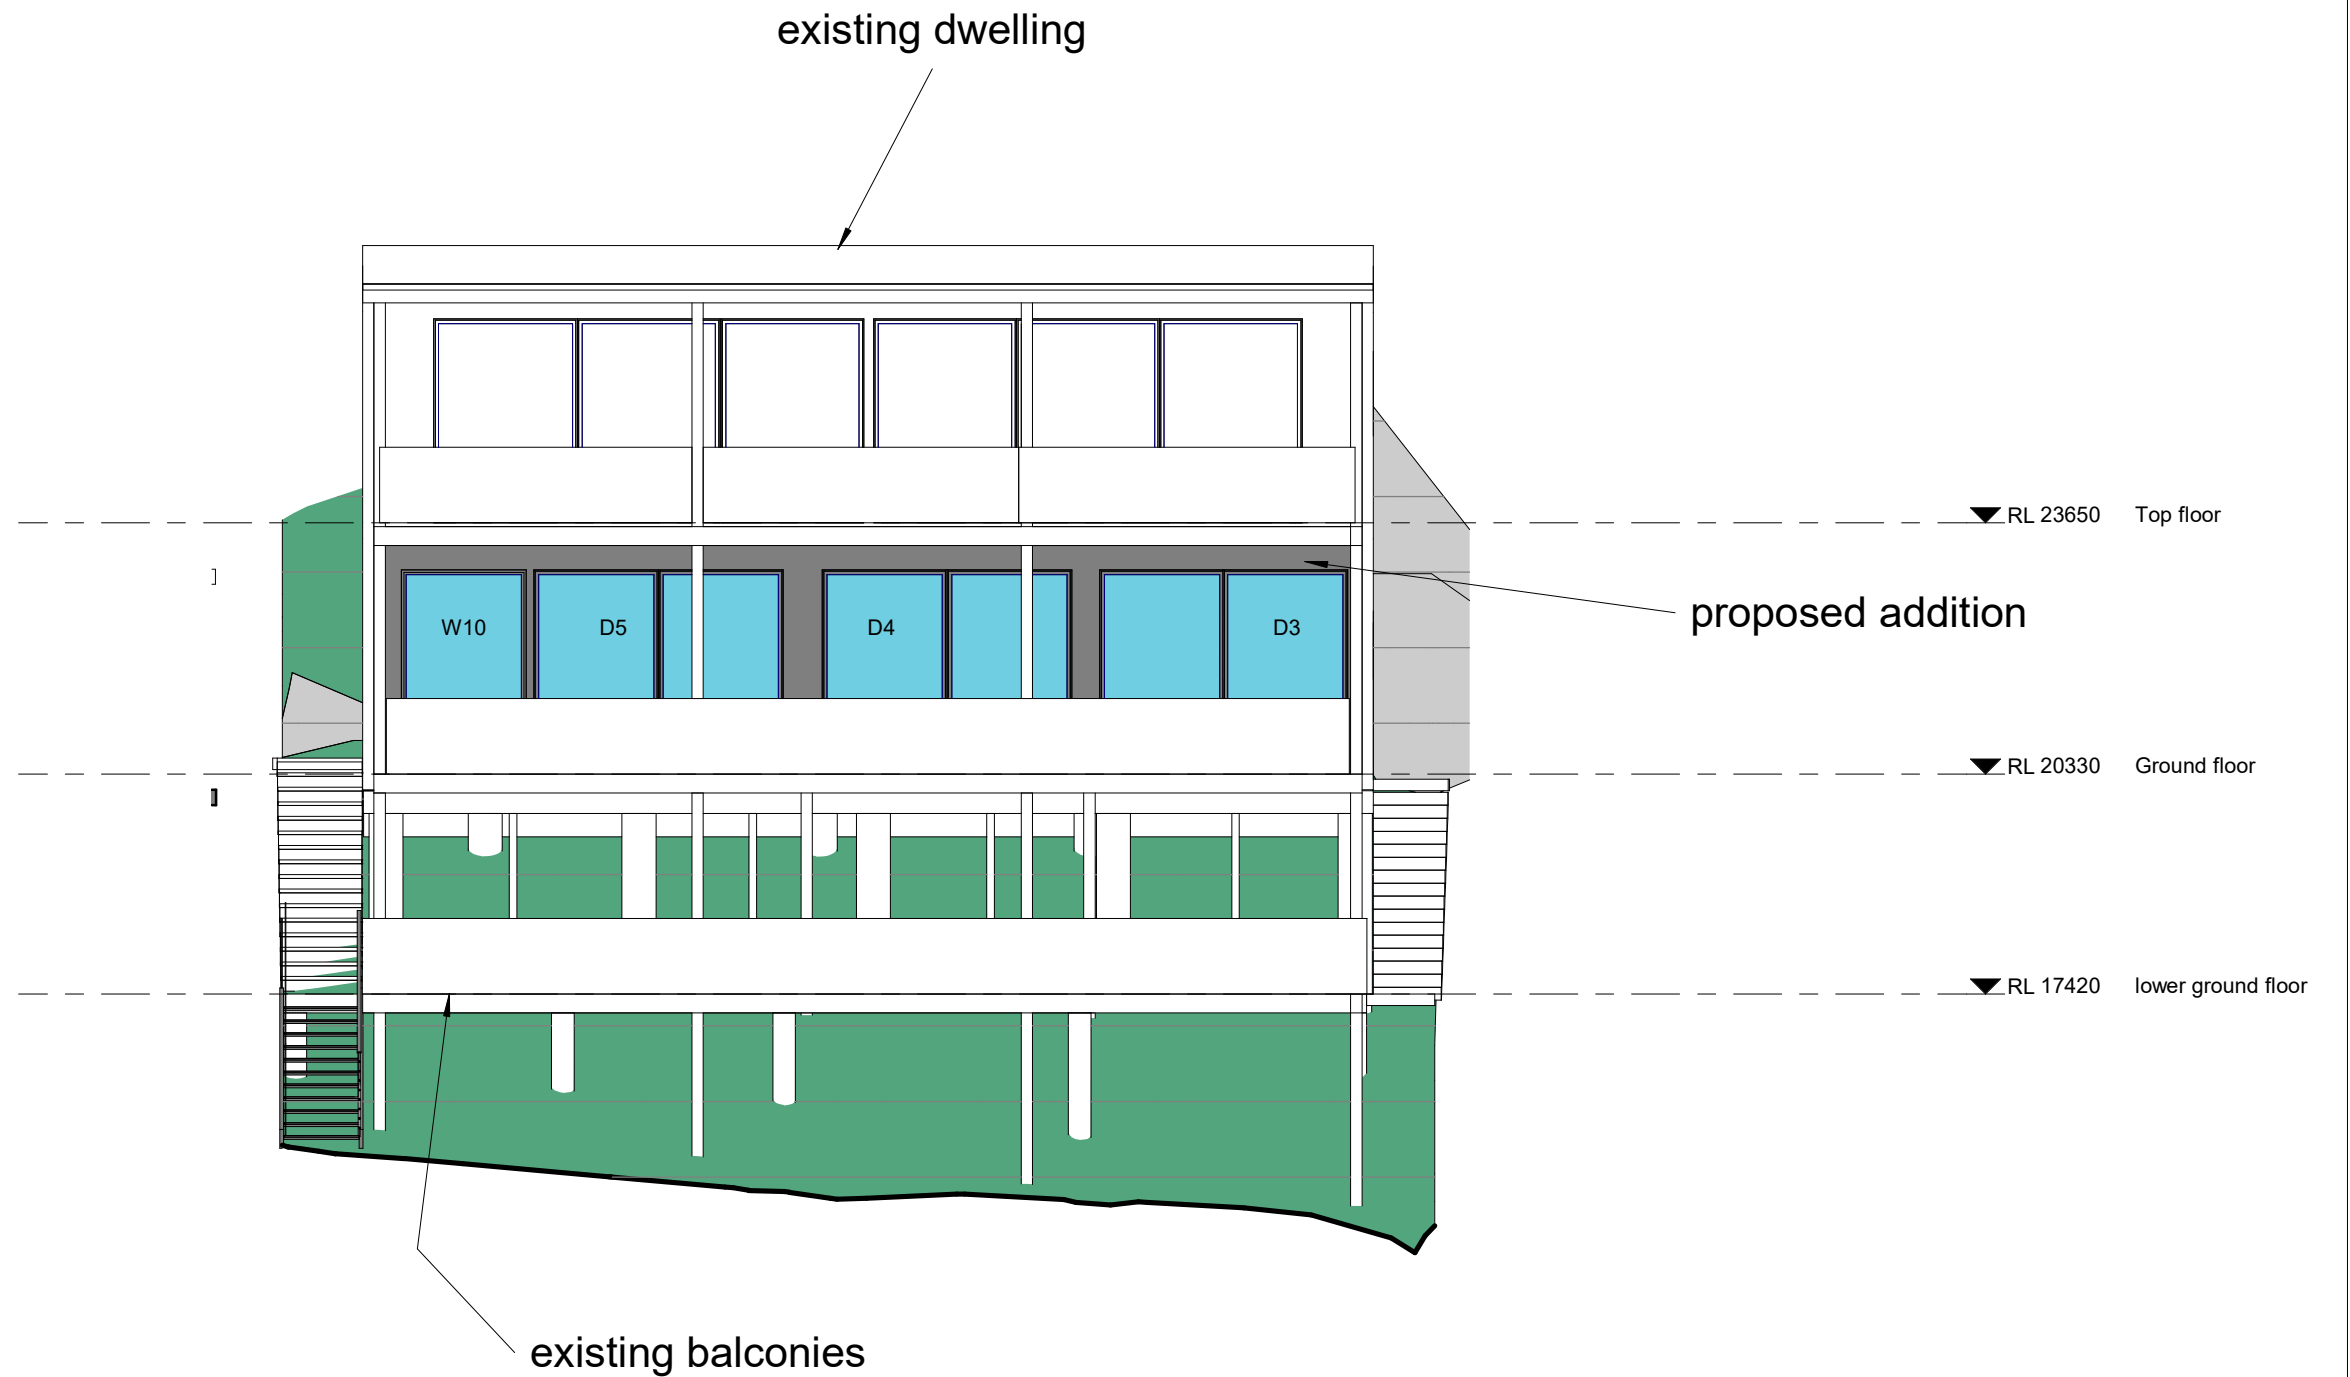

DA ISSUE

REVISION

REV A 18.07.22

SECONDARY DWELLING
ACCESS STAIRS AND
PATH ALTERED



peterdownes
multi-award winner designs

address 77 Riviera rd, Avalon 2107
phone 0488 662 445 www.peterdownes.com

PROJECT

New secondary dwelling at 48 Lindley
Ave, Narrabeen

DRAWING

house north elevation

DRAWN

PD

SCALE

1 : 100

DRG. No.

A3


CHECKED

PD

DATE


01.04.22

2201 -05A

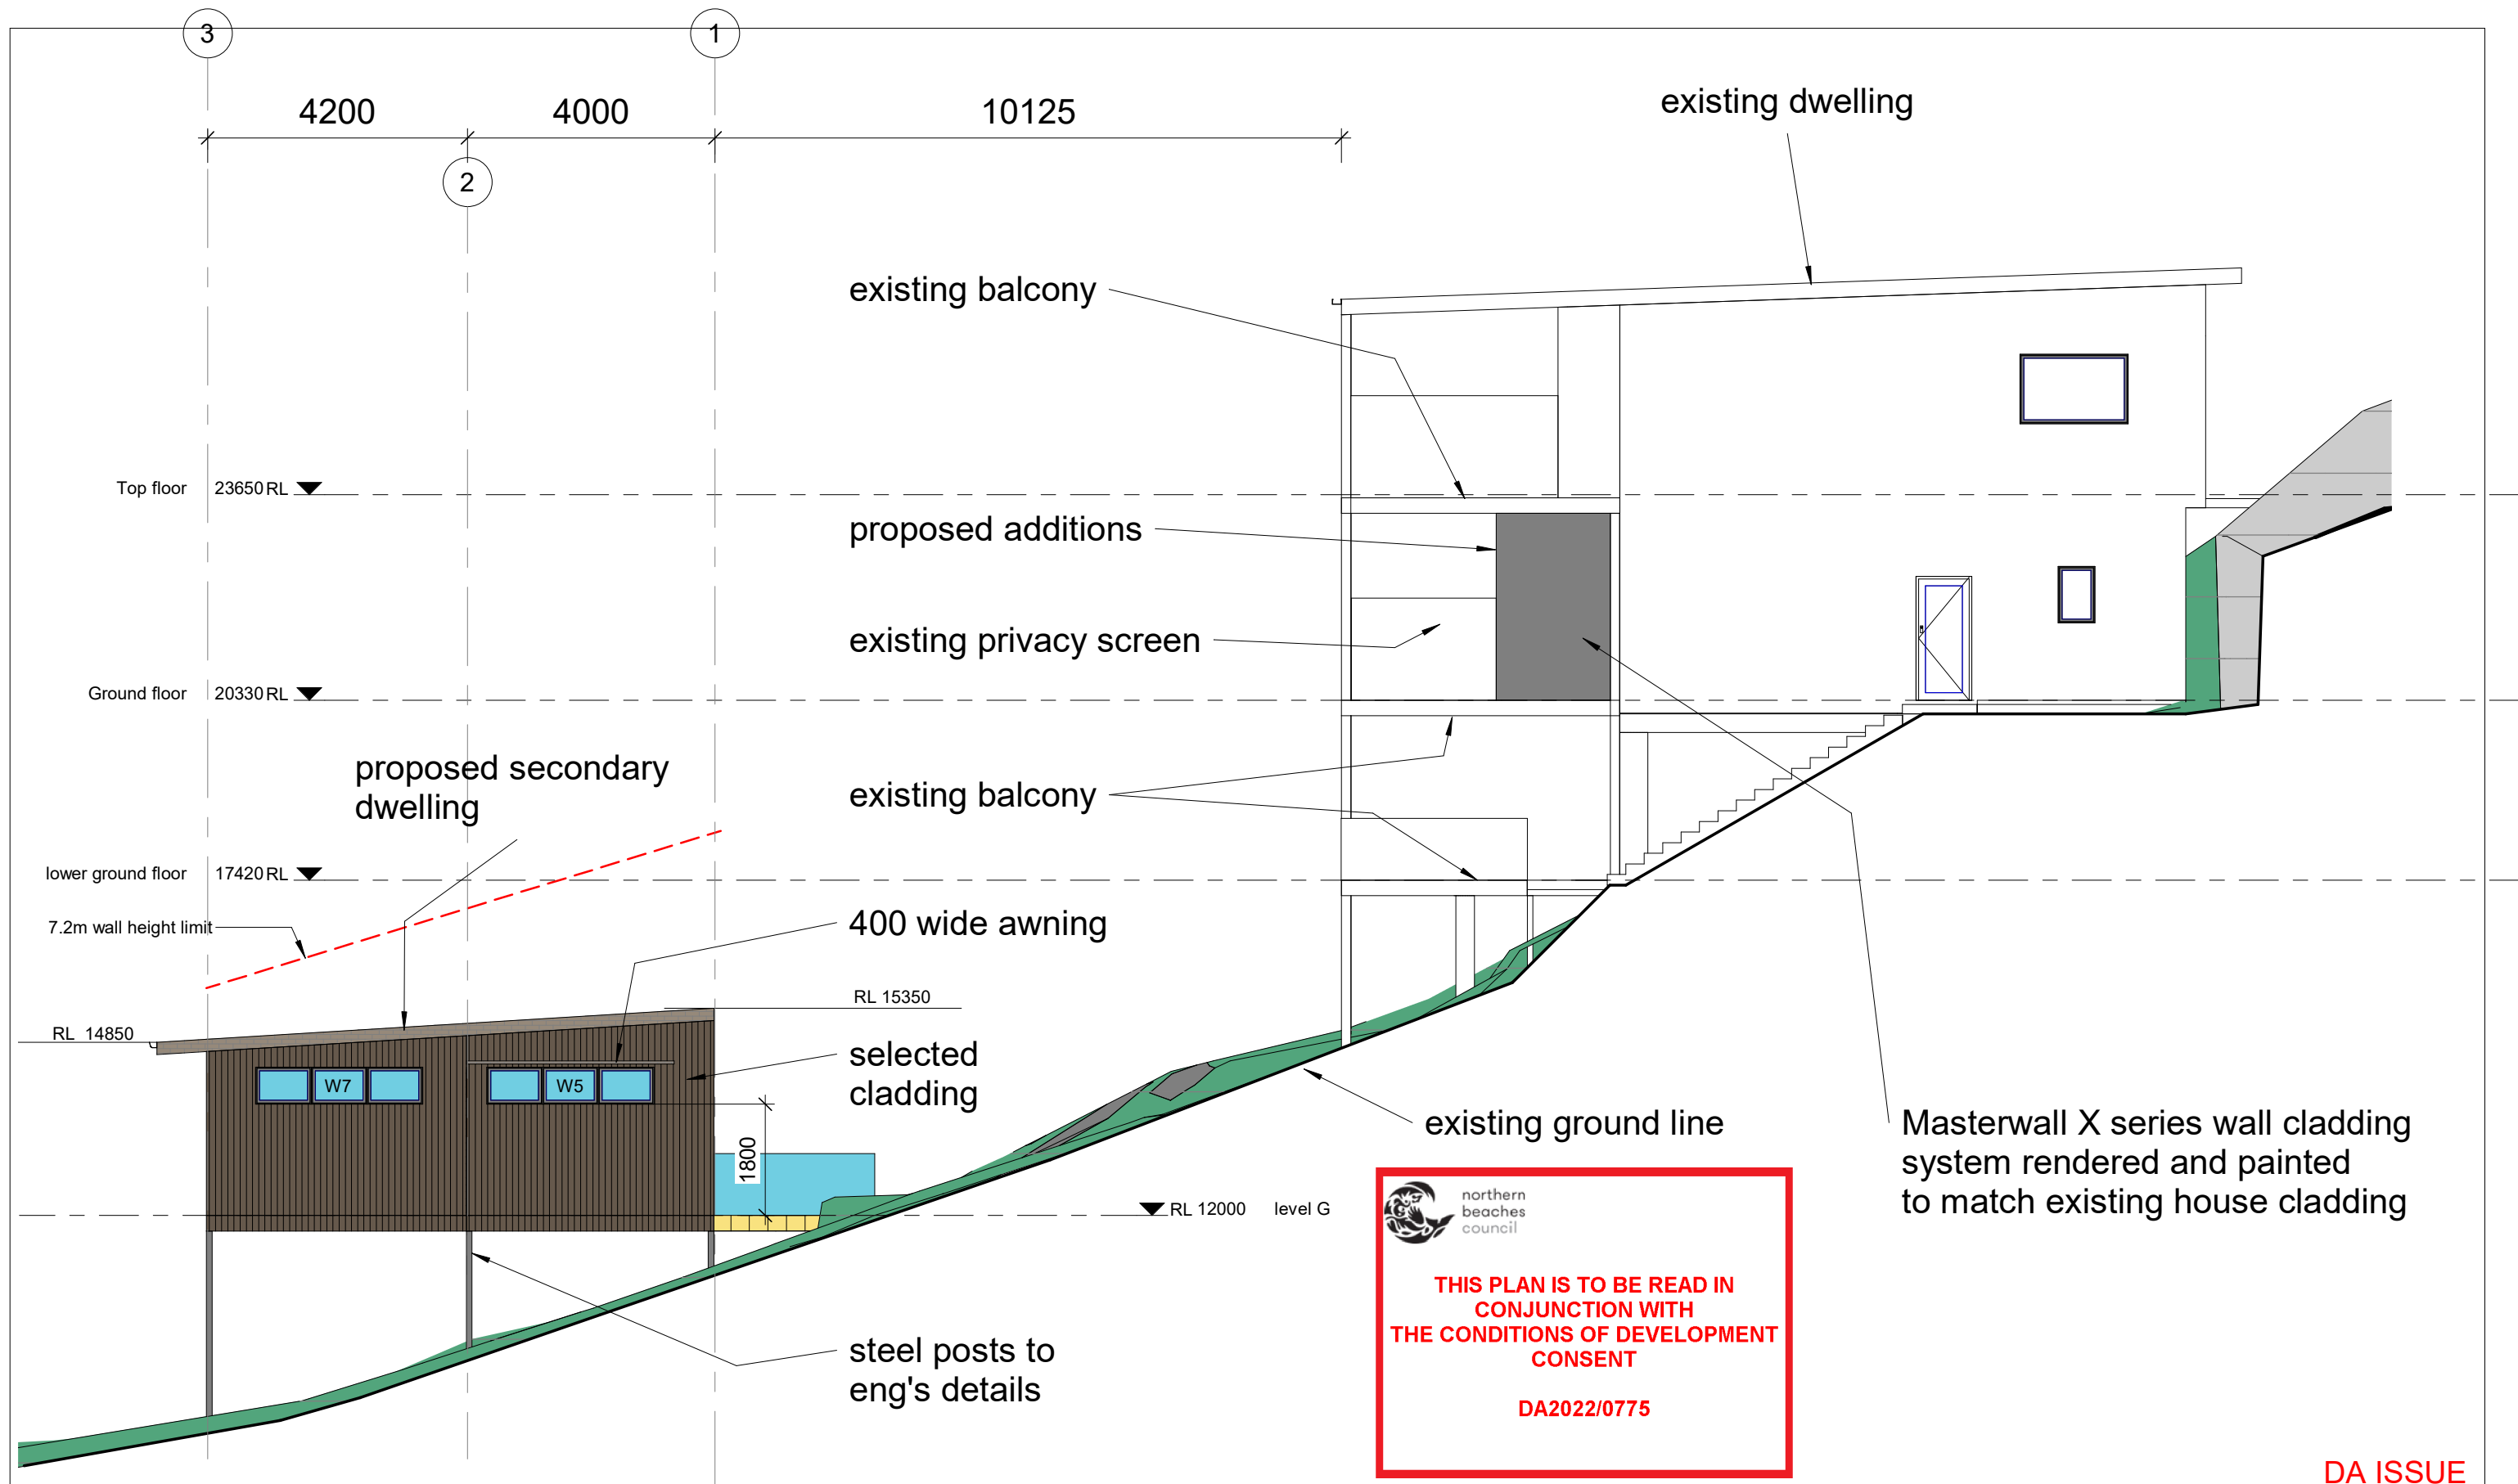

DA ISSUE

REVISION	REV A 18.07.22	SECONDARY DWELLING ACCESS STAIRS AND PATH ALTERED		 address 77 Riviera rd, Avalon 2107 phone 0488 662 445 www.peterdownes.com	PROJECT		DRAWN	CHECKED
					New secondary dwelling at 48 Lindley Ave, Narrabeen		PD	PD
					DRAWING	west elevations	SCALE	DATE
							1 : 100	01.04.22
							DRG. No.	
							A3 2201-06A	

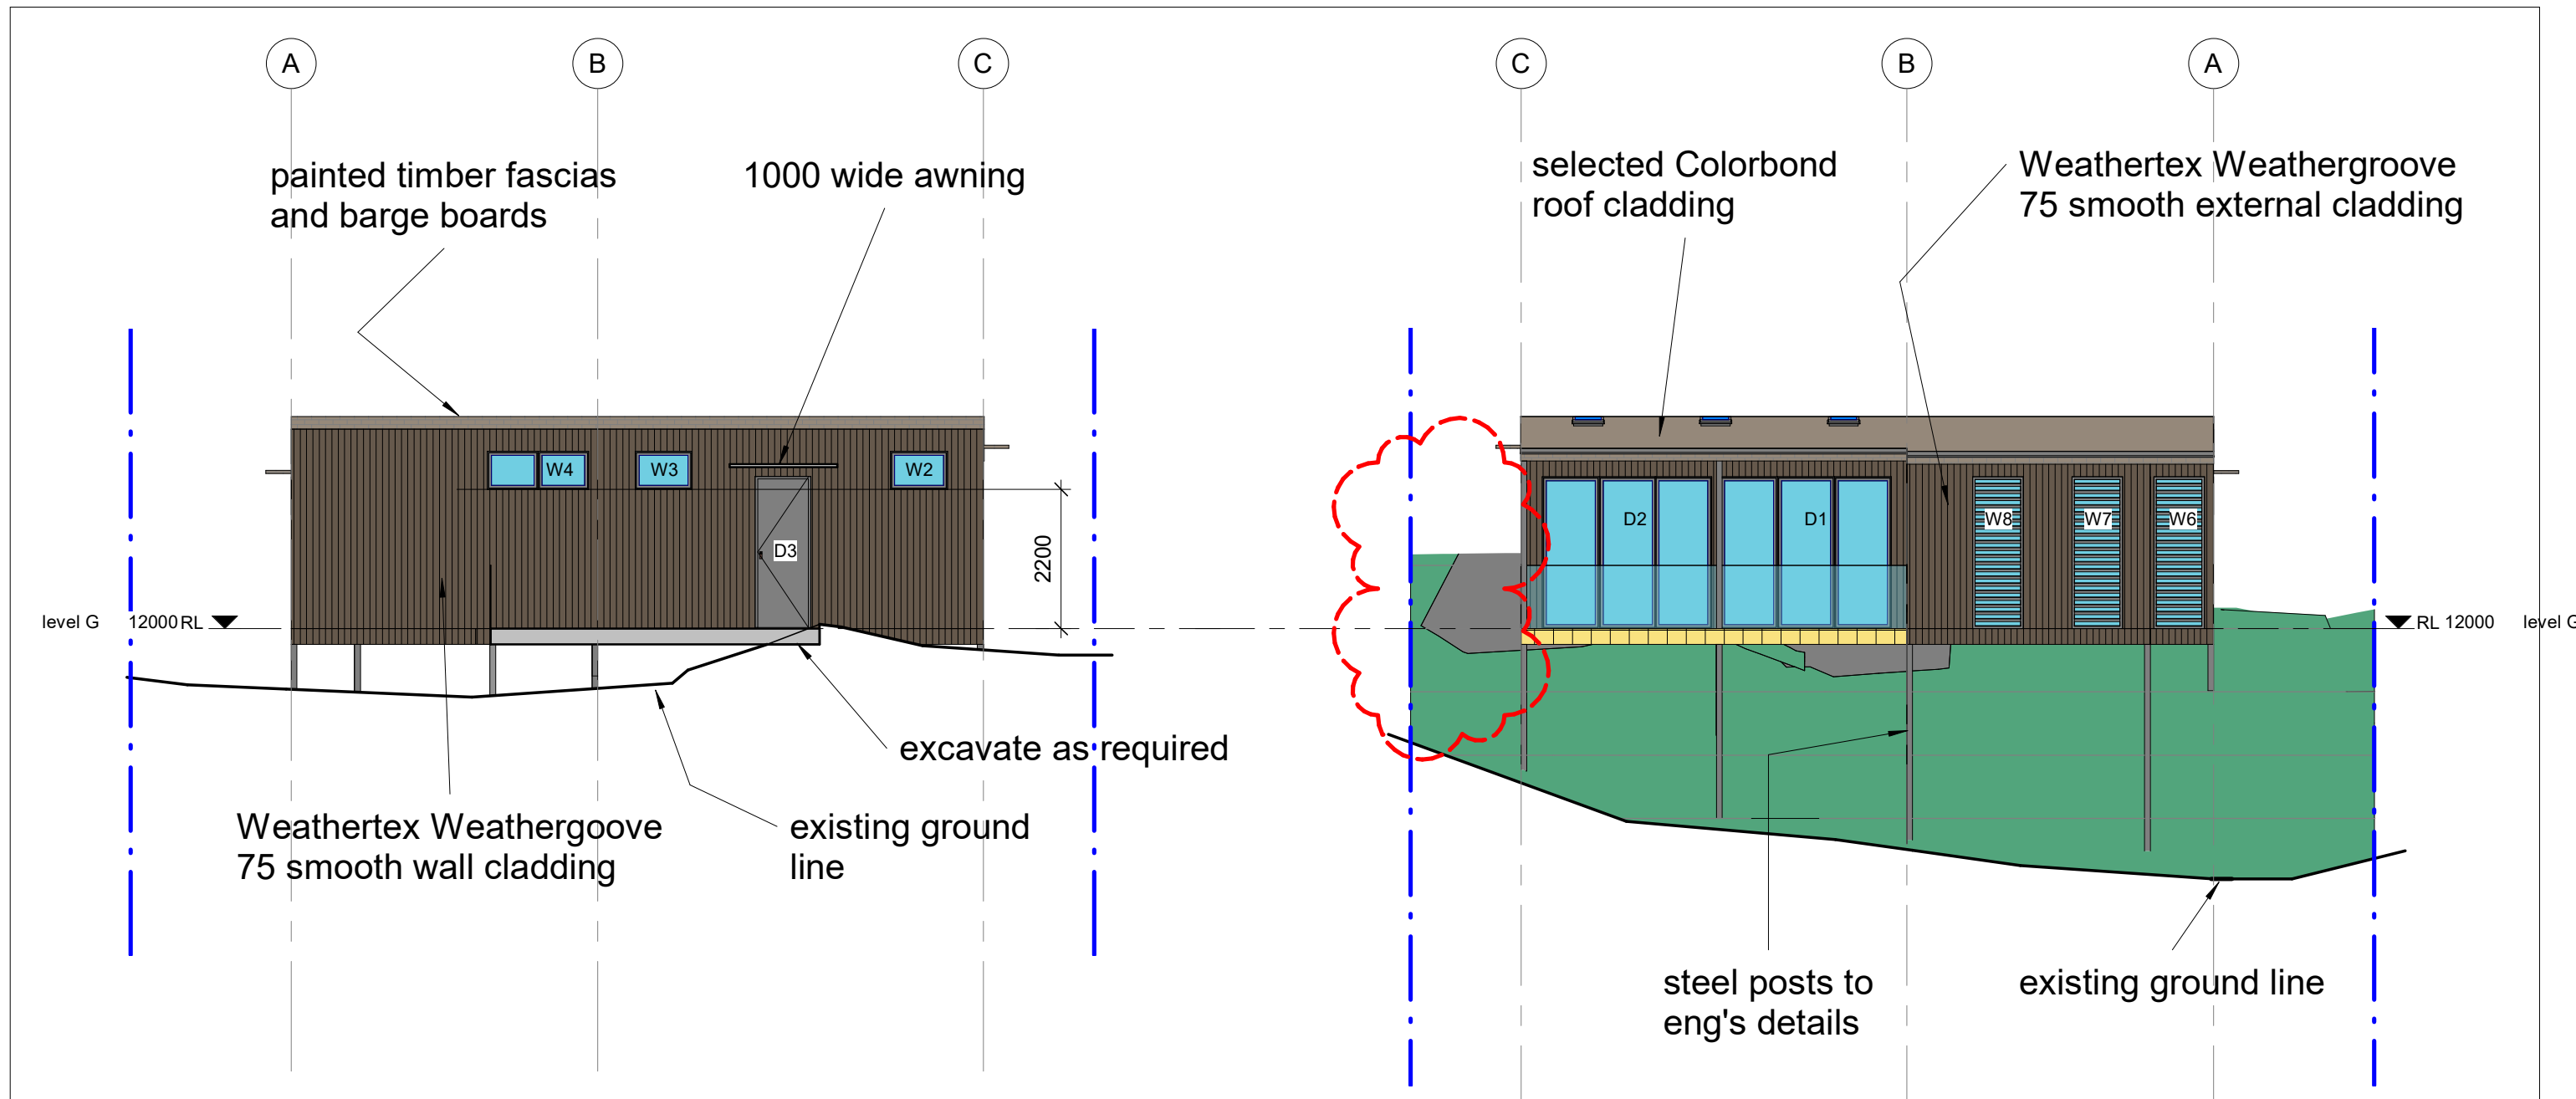

SOUTH

NORTH



northern
beaches
council

THIS PLAN IS TO BE READ IN
CONJUNCTION WITH
THE CONDITIONS OF DEVELOPMENT
CONSENT


DA2022/0775

All work to Geotech,
and BASIX requirements.



REVISION	REV A 18.07.22 SECONDARY DWELLING ACCESS STAIRS AND PATH ALTERED	 address 77 Riviera rd, Avalon 2107 phone 0488 662 445 www.peterdownes.com	PROJECT New secondary dwelling at 48 Lindley Ave, Narrabeen		DRAWN PD	CHECKED PD
			DRAWING secondary dwelling north and south elevations		SCALE 1 : 100	DATE 18.8.19
					DRG. No. A3	
					2201-07A	

DA ISSUE

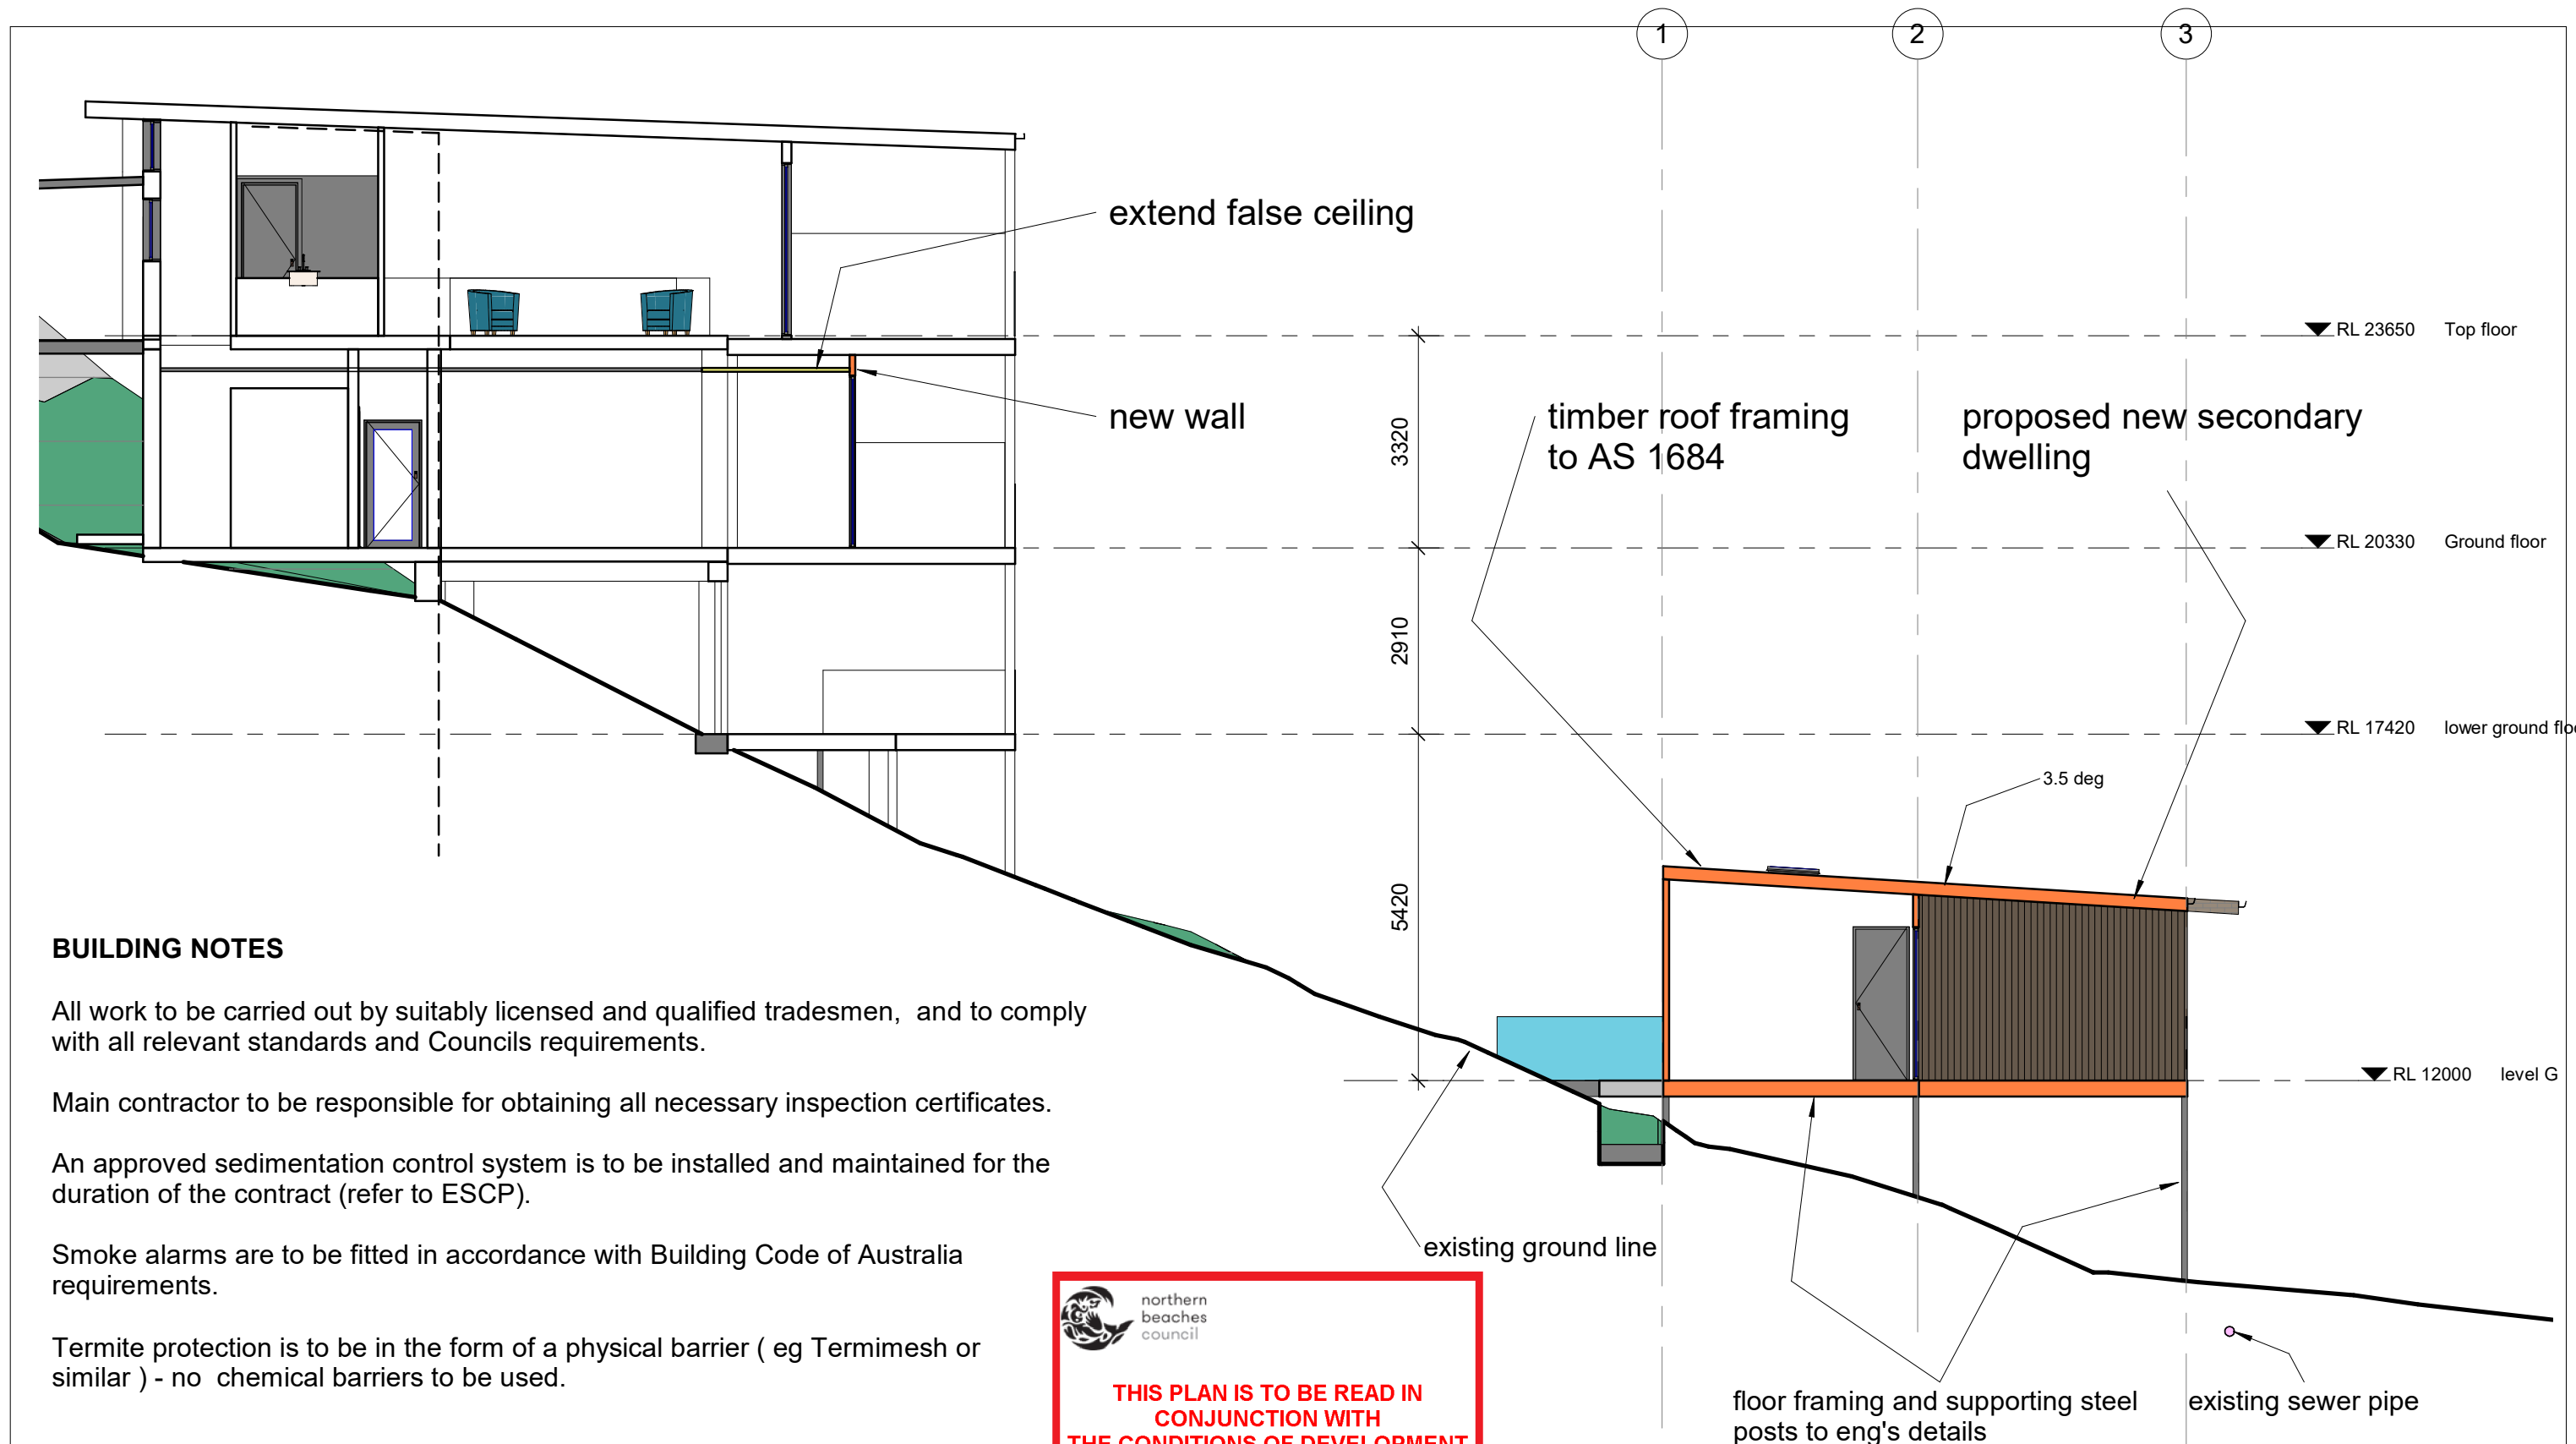

BUILDING NOTES

- All work to be carried out by suitably licensed and qualified tradesmen, and to comply with all relevant standards and Councils requirements.
- Main contractor to be responsible for obtaining all necessary inspection certificates.
- An approved sedimentation control system is to be installed and maintained for the duration of the contract (refer to ESCP).
- Smoke alarms are to be fitted in accordance with Building Code of Australia requirements.
- Termite protection is to be in the form of a physical barrier (eg Termimesh or similar) - no chemical barriers to be used.

All work to Geotech,
and BASIX requirements.



THIS PLAN IS TO BE READ IN
CONJUNCTION WITH
THE CONDITIONS OF DEVELOPMENT
CONSENT

DA2022/0775



REVISION	REV A 18.07.22	SECONDARY DWELLING ACCESS STAIRS AND PATH ALTERED

peterdownes
multi-award winner designs

address 77 Riviera rd, Avalon 2107
phone 0488 662 445 www.peterdownes.com

PROJECT	New secondary dwelling at 48 Lindley Ave, Narrabeen		DRAWN	CHECKED
	DRAWING		PD	PD
section 1 , notes		SCALE	DATE	
		1 : 100	01.04.22	
		DRG. No.		
		A3	2201 -08A	

DA ISSUE