							1
DRAWING REGISTER		ISSUE DATE + REVISION				7	1
DWG NO. DWG TITLE	SCALE	29/03/2022		1 1 1 1 1 1 1 1 1 1 1 1 1 1 1 1 1 1 1		1 1 1 1 1 1 1 1 1 1 1 1 1 1 1 1 1 1 1	1 1 1 1 1 1 1 1 1 1 1 1 1 1 1 1 1 1 1
						$\begin{array}{c ccccccccccccccccccccccccccccccccccc$	
0483 S4.55-A-00; DRAWING REGISTER		A	'_		!		
0483 \$4.55-A-01 SITE PLAN + SITE ANALYSIS PLAN + WASTE MANAGEMENT SITE PLAN	1:200@ A1 1:400@ A3	A '	-		,	,, , , , , , , , , , , , , , , , , , ,	
0483 \$4.55-A-01 EXCAVATION & FILL PLAN	1:100@ A1 1:200@_A3	A					
	1·100@ A1						
0483 \$4.55-D-01¦ ROOF PLAN	1:200@ A3 1:100@ A1	A			 	   <del>-</del>	
0483 \$4.55-D-02' FIRST FLOOR PLAN	1:200@ A3 1:100@ A1	Δ					
0483 \$4.55-D-03 GROUND FLOOR PLAN 0483 \$4.55-D-04 POOL + LOWER GROUND PLAN	1:200@ A3 1:100@ A1	Δ '					
0400 54:55-D-04, 1 OOL 1 LOWER OROUND 1 LAIN	1:200@_A3		 	· · · · · · · · · · · · · · · · · · ·	 	1 1	<u> </u>
0483 \$4.55-E-01 ELEVATIONS - WEST	1:100@ A1	A			!		
0483 \$4.55-E-02 ELEVATIONS - SOUTH	1:200@ A3 1:100@ A1	A '					
0483 \$4.55-E-03 ELEVATIONS - EAST	1:100@ A1 1:200@ A3	Α			<del> </del>		
0483 \$4.55-E-04 ELEVATIONS - NORTH	1:100@ A1 1:200@ A3	Α ,	<u> </u>	<u>-</u>	¦		
					/		
0483 \$4.55-F-01 SECTIONS - AA	1:100@ A1 1:200@ A3	A '	-		+		
			<del> </del>		,	,	
0483 S4.55-S-02 SHADOW DIAGRAMS - PROPOSED	1:100@ A1 1:200@ A3	A '					
						1 1 1 1 1 1 1 1 1 1 1 1 1 1 1 1 1 1 1	
				<u> </u>			
			 		   <del></del>		
						1	
		<del> </del>	 		 	1 1 1 1	
			'_		!		
			-				
		<del>-  </del>	<del> </del>		1		
		   <del> </del>				· · · · · · · · · · · · · · · · · · ·	
; 		   <del> </del>	 	<u> </u>	 	 	
· · · · · · · · · · · · · · · · · · ·							
		   <del></del>	; ;		; 		<del></del>
			· 		: !		<u> </u>
	 	 	; 		; !		
			<del> </del>		; ;		
					/		
			-	r	,		
						1 1 1 1 1 1	1 1
APPENDIX							1 1
						1 1	1
<del>-</del>			 		   <del> </del>	1 1 T	<u>                                     </u>
		<del></del>	<del> </del>	$\frac{1}{1}$ $\frac{1}{1}$ $\frac{1}{1}$ $\frac{1}{1}$ $\frac{1}{1}$	!   <del> </del>	$ \begin{array}{cccccccccccccccccccccccccccccccccccc$	
	1			1 1 1 1 1 1 1 1 1 1 1 1 1 1 1 1 1 1 1	l	1 1 1 1 1 1 1 1 1 1 1 1 1 1 1 1 1 1 1	
	!						
							1
							1
							1 1 1

\_\_\_\_\_\_

DATE ISSUE REVISION

CHECK ALL DIMENSIONS ON SITE PRIOR TO THE COMMENCEMENT OF WORK USE FIGURED DIMENSIONS ONLY DO NOT SCALE COMPLY WITH RELEVANT AUTHORITIES REQUIREMENTS COMPLY WITH BUILDING CODE OF AUSTRALIA COMPLY WITH ALL RELEVANT AUSTRALIAN STANDARDS COPYRIGHT IN ALL DOCUMENTS AND

DRAWINGS PREPARED BY AKIN ATELIER

# AKIN ATELIER

#4 / 1 MARYS PLACE SURRY HILLS NSW, Australia, 2010

T: + 61 2 9043 3166 E: INFO@AKINATELIER.COM NOMINATED ARCHITECT: KELVIN HO NSW ARB #11251

### PROJECT Rothwell House

191 WHALE BEACH ROAD WHALE BEACH NSW 2107


# CLIENT

SARAH & DAVID ROTHWELL

# DRAWING

DRAWING REGISTER

PROJECT NO. 0483	DRAWN AR
SCALE NTS	CHECKED AS
DWG NO. <b>\$4.55-A-00</b>	ISSUE A

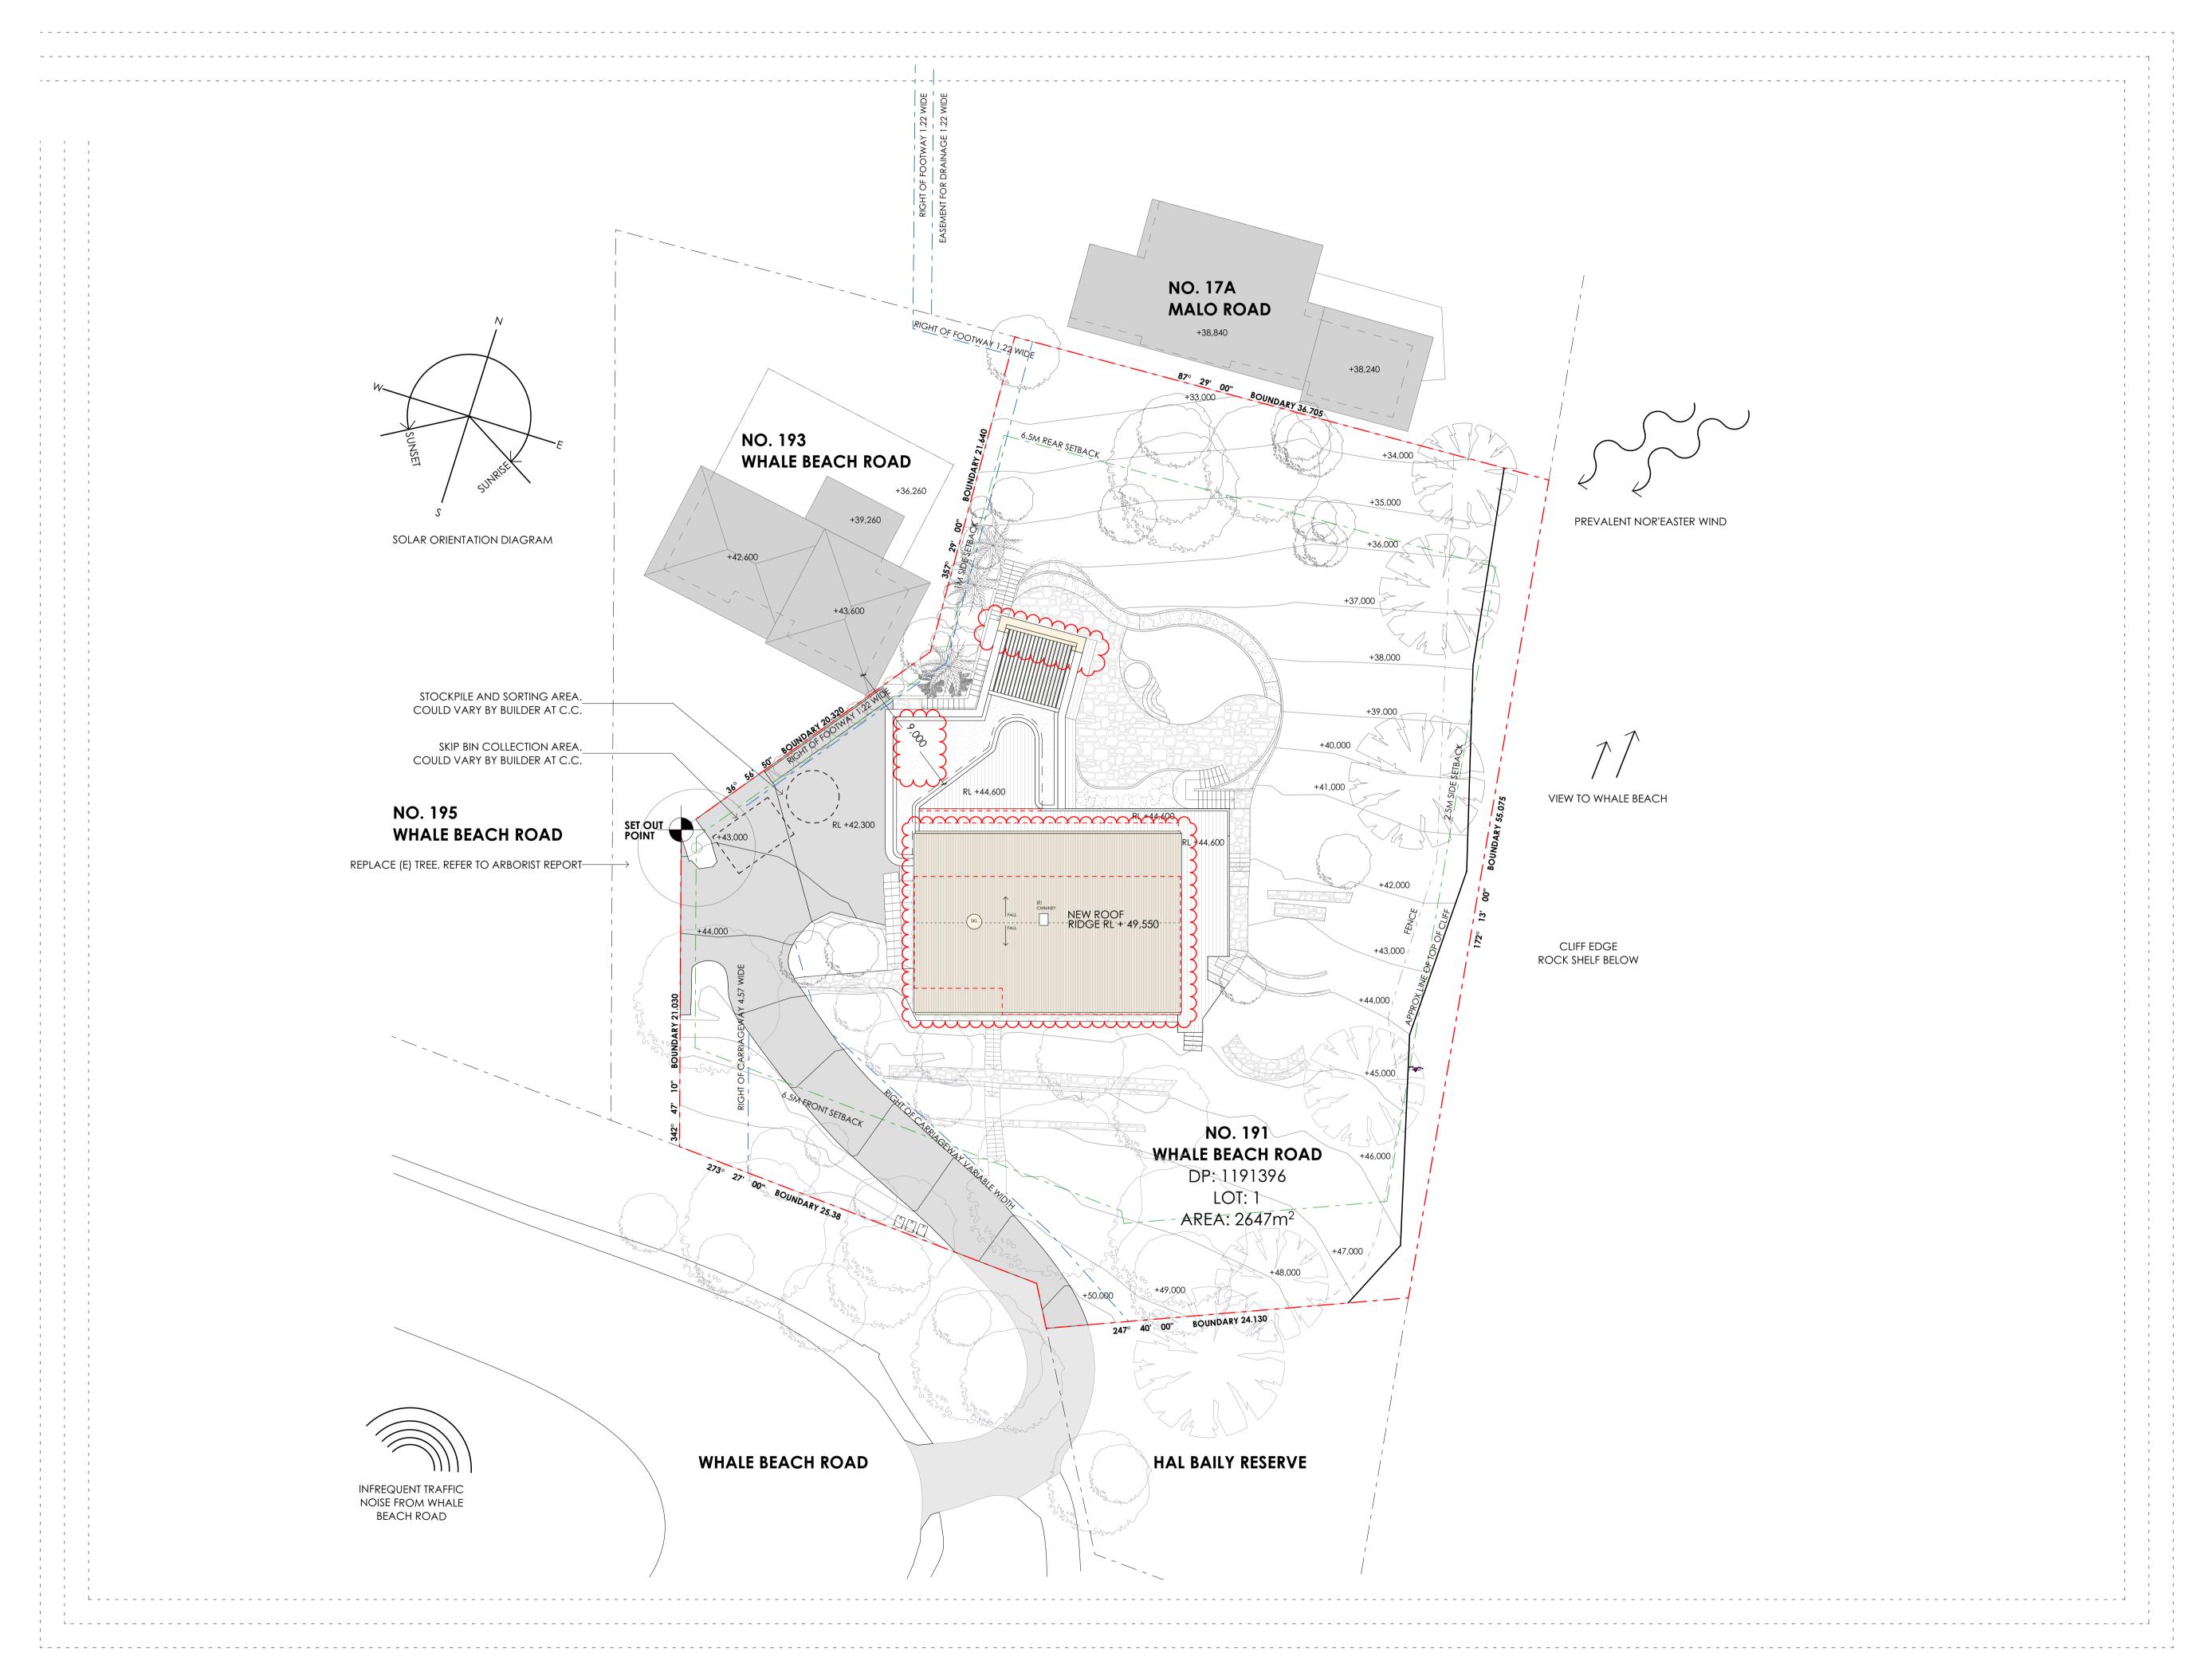

EXISTING TO BE RETAIN
PROPOSED WORKS

A.201	STONE WALL
A.202	STONE FLOOR
A.301	TIMBER - NATURAL
A.302	TIMBER - PAINTED*
A.303	TIMBER SHIPLAP - PAINTED
A.401	GLASS
A.501	METAL ROOFING
A.502	METAL BALUSTRADE
A.503	STAINLESS STEEL
ı	1

A.801 CONCRETE

\*PAINTED FINISH TO MATCH EXISTING COLOUR

ISSUE REVISION
3/2022 A \$4.55


CHECK ALL DIMENSIONS ON SITE PRIOR TO THE COMMENCEMENT OF WORK USE FIGURED DIMENSIONS ONLY DO NOT SCALE COMPLY WITH RELEVANT AUTHORITIES REQUIREMENTS COMPLY WITH BUILDING CODE OF AUSTRALIA

COMPLY WITH ALL RELEVANT AUSTRALIAN STANDARDS
COPYRIGHT IN ALL DOCUMENTS AND DRAWINGS PREPARED BY AKIN ATELIER

# AKIN ATELIER

#4 / 1 MARYS PLACE SURRY HILLS NSW, Australia, 2010

T: +61 2 9043 3166 E: INFO@AKINATELIER.COM NOMINATED ARCHITECT: KELVIN HO NSW ARB #11251

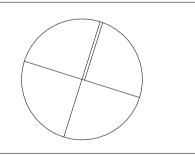

PROJECT Rothwell House

191 WHALE BEACH ROAD WHALE BEACH NSW 2107


CLIENT

SARAH & DAVID ROTHWELL

DRAWING

SITE PLAN + SITE ANALYSIS PLAN + WASTE MANAGMENT SITE PLAN

PROJECT NO. 0483	DRAWN AR
SCALE 1:200@ A1 1:400@ A3	CHECKED AS
DWG NO. <b>\$4.55-A-01</b>	ISSUE A

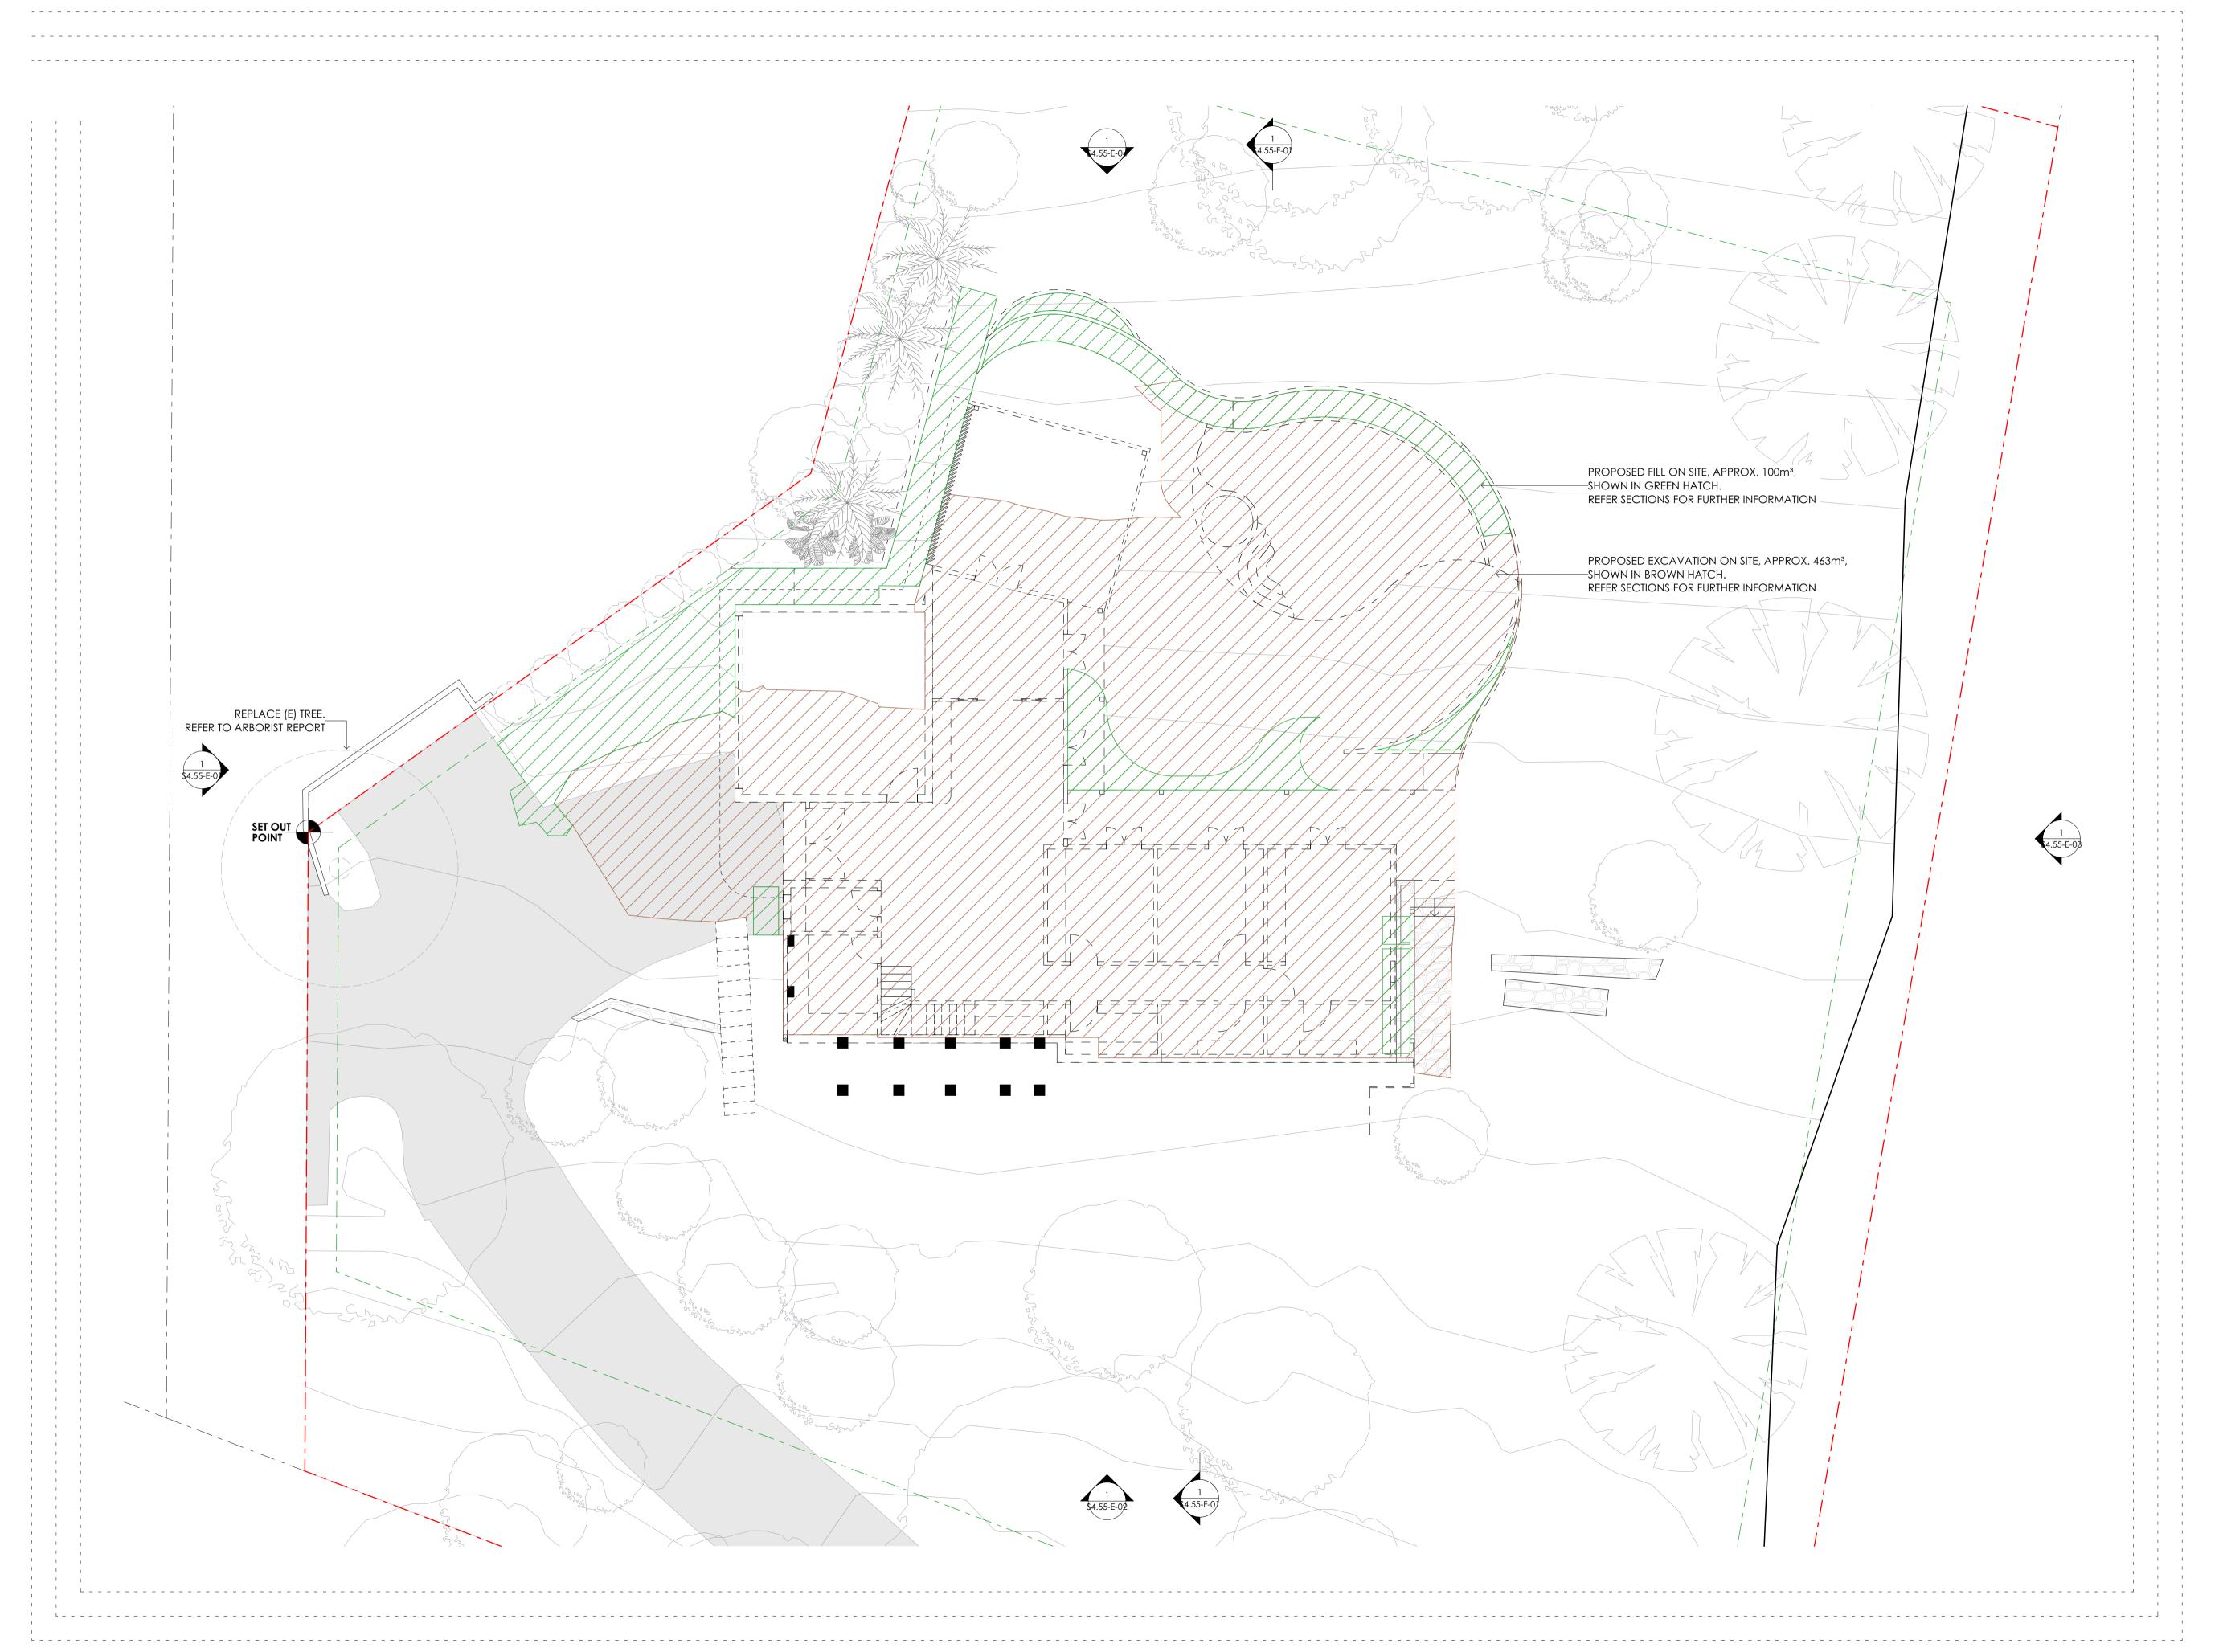

PROPOSED WORKS

DATE ISSUE REVISION


THE COMMENCEMENT OF WORK
USE FIGURED DIMENSIONS ONLY DO NOT
SCALE
COMPLY WITH RELEVANT AUTHORITIES
REQUIREMENTS
COMPLY WITH BUILDING CODE OF
AUSTRALIA
COMPLY WITH ALL RELEVANT AUSTRALIAN
STANDARDS
COPYRIGHT IN ALL DOCUMENTS AND
DRAWINGS PREPARED BY AKIN ATELIER

CHECK ALL DIMENSIONS ON SITE PRIOR TO

# AKIN ATELIER

#4 / 1 MARYS PLACE SURRY HILLS NSW, Australia, 2010

T: + 61 2 9043 3166 E: INFO@AKINATELIER.COM NOMINATED ARCHITECT: KELVIN HO NSW ARB #11251

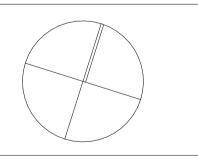

# PROJECT ROTHWELL HOUSE

191 WHALE BEACH ROAD WHALE BEACH NSW 2107


# CLIENT

SARAH & DAVID ROTHWELL

# DRAWING

# EXCAVATION + FILL PLAN (ALT)

0483 SCALE 1:100@ A1	AR CHECKED AS
1:200@ A3 DWG NO.	ISSUE
\$4.55-A-04	A

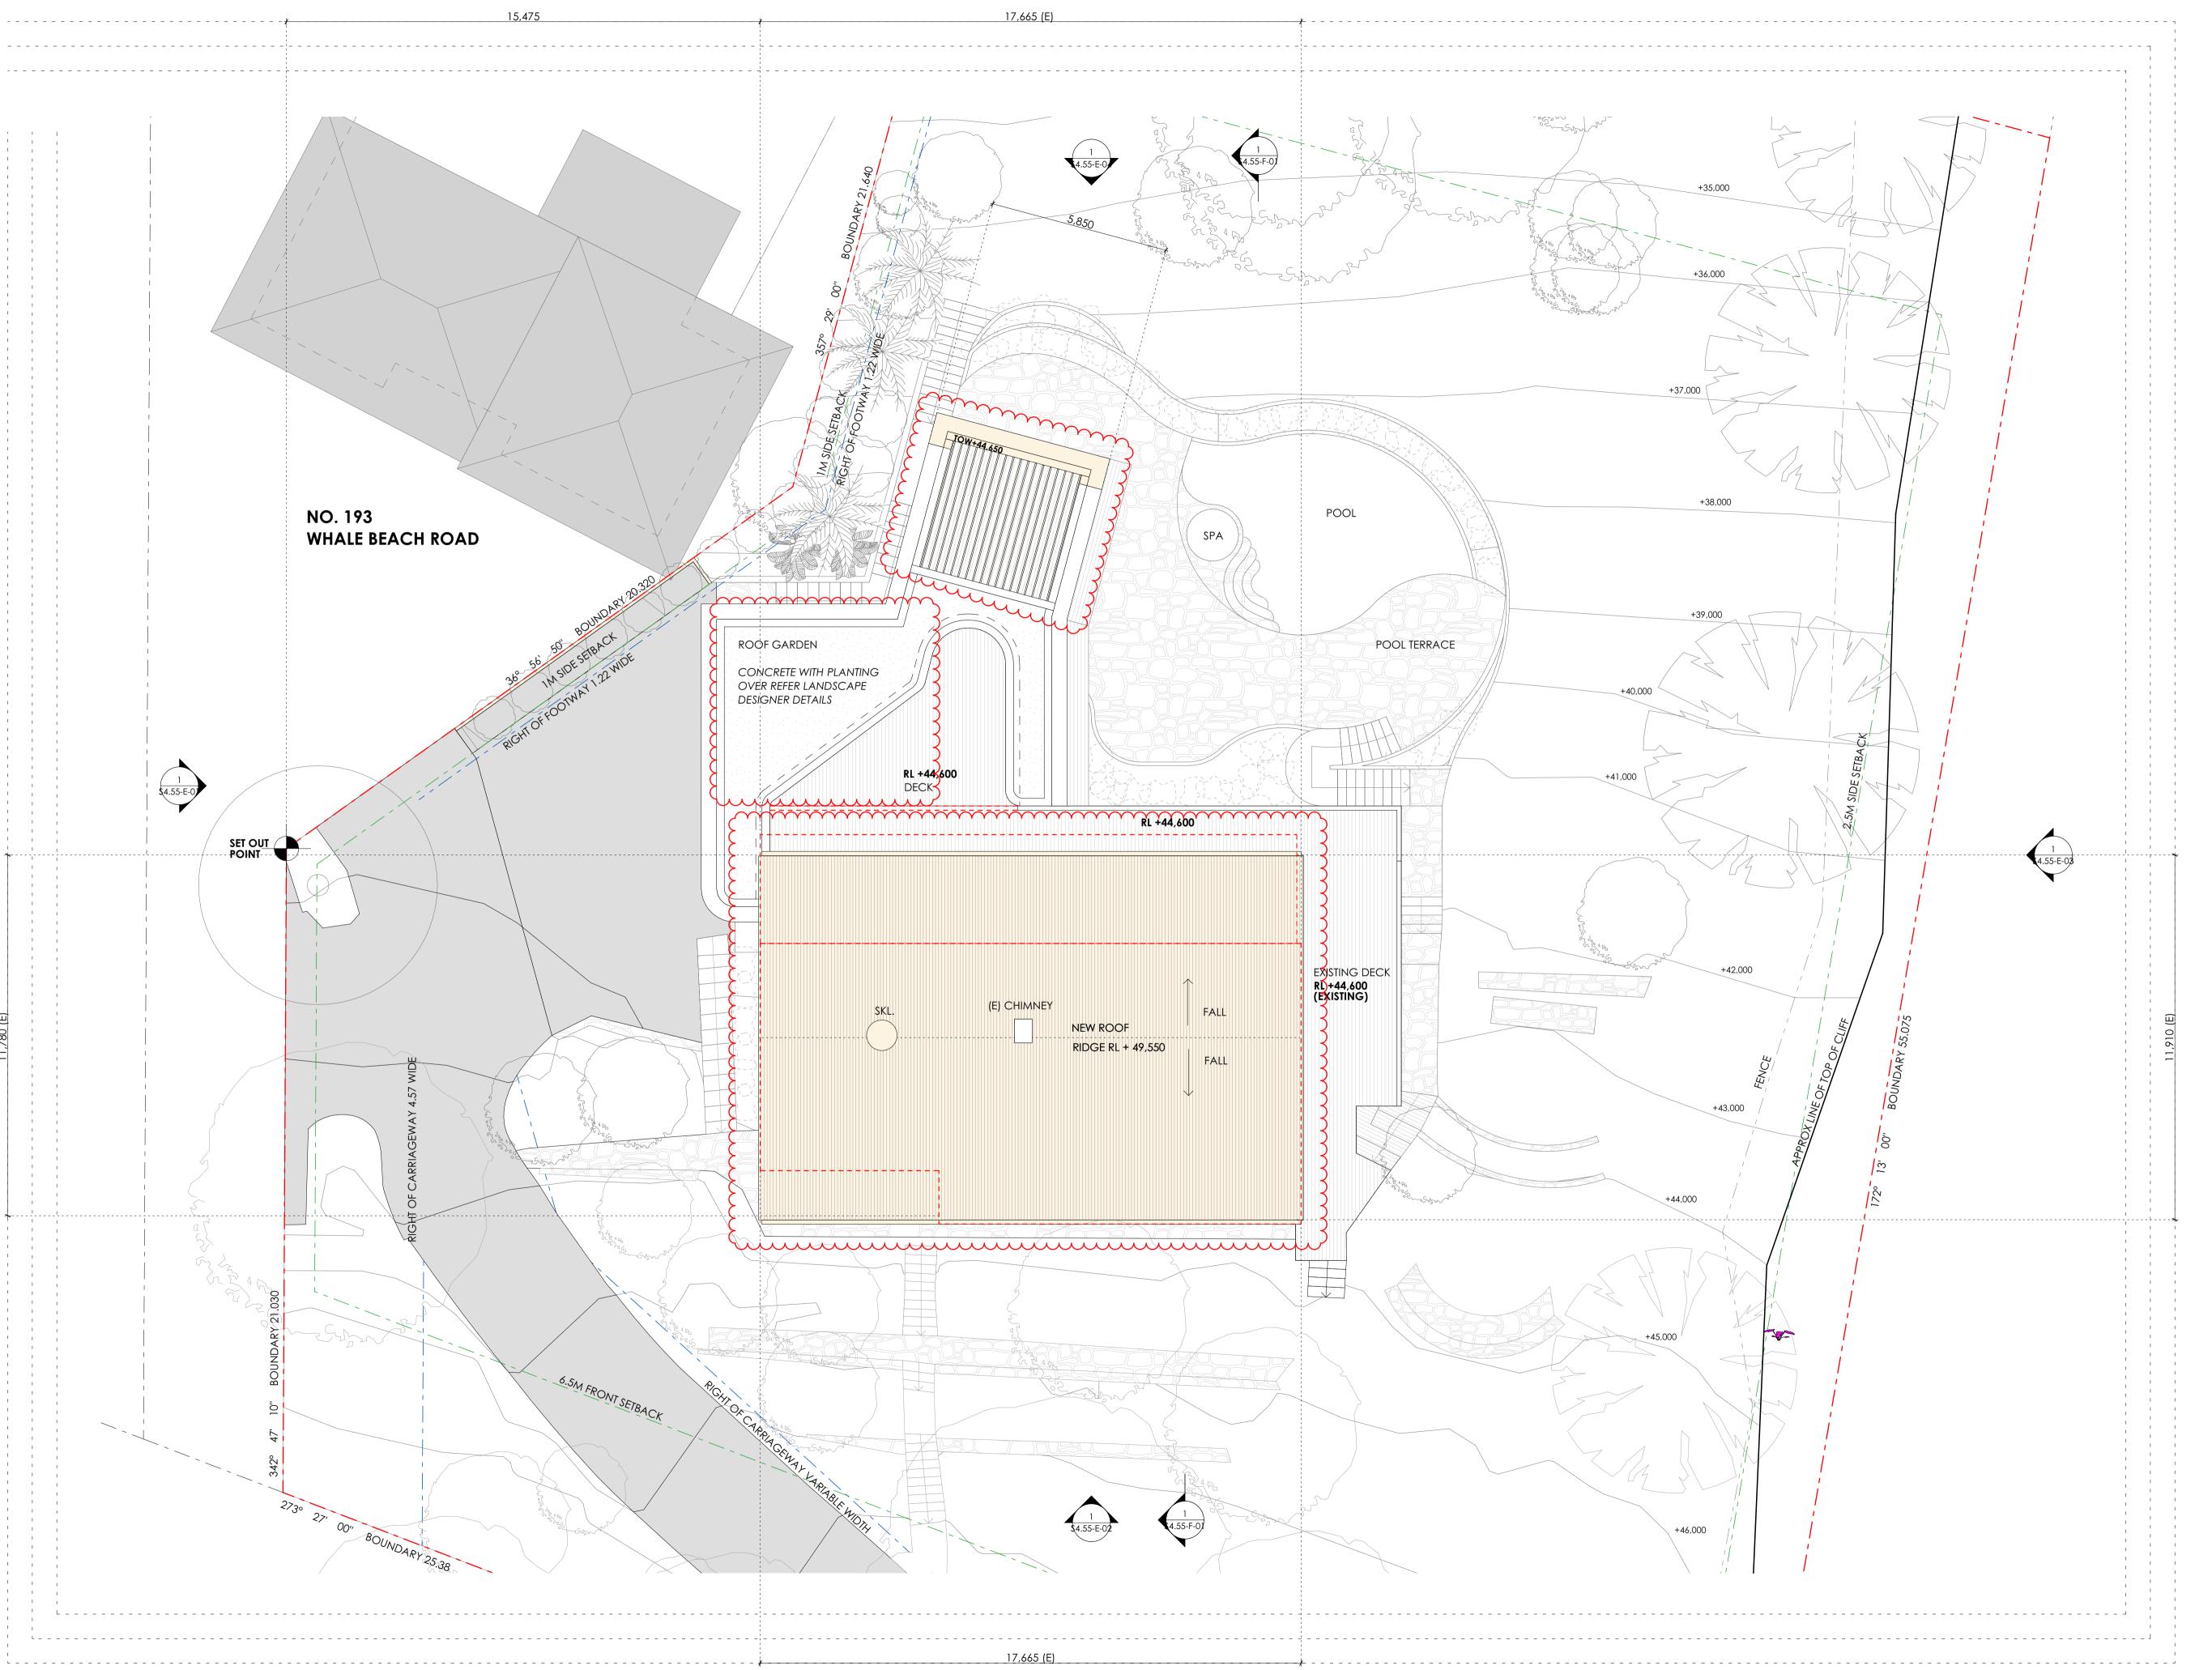

	EXISTING TO BE RETAINE
	PROPOSED WORKS

### FINIS

A.201	STONE WALL
A.202	STONE FLOOR
A.301	TIMBER - NATURAL
A.302	TIMBER - PAINTED*
A.303	TIMBER SHIPLAP - PAINTED*
A.401	GLASS
A.501	METAL ROOFING
A.502	METAL BALUSTRADE
A.503	STAINLESS STEEL
A.801	CONCRETE

\*PAINTED FINISH TO MATCH EXISTING COLOUR

TE ISSUE REVISION

CHECK ALL DIMENSIONS ON SITE PRIOR TO THE COMMENCEMENT OF WORK

USE FIGURED DIMENSIONS ONLY DO NOT SCALE

COMPLY WITH RELEVANT AUTHORITIES

REQUIREMENTS


COMPLY WITH BUILDING CODE OF

AUSTRALIA
COMPLY WITH ALL RELEVANT AUSTRALIAN
STANDARDS
COPYRIGHT IN ALL DOCUMENTS AND
DRAWINGS PREPARED BY AKIN ATELIER

# AKIN ATELIER

#4 / 1 MARYS PLACE SURRY HILLS NSW, Australia, 2010

T: + 61 2 9043 3166 E: INFO@AKINATELIER.COM NOMINATED ARCHITECT: KELVIN HO NSW ARB #11251

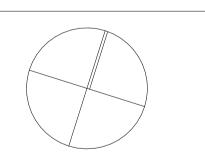

# PROJECT ROTHWELL HOUSE

191 WHALE BEACH ROAD WHALE BEACH NSW 2107


# CLIENT

SARAH & DAVID ROTHWELL

# DRAWING

# ROOF PLAN

PROJECT NO.	DRAWN
0483	AR
SCALE	CHECKED
1:100@ A1	AS
1:200@ A3 DWG NO. <b>\$4.55-D-01</b>	ISSUE A

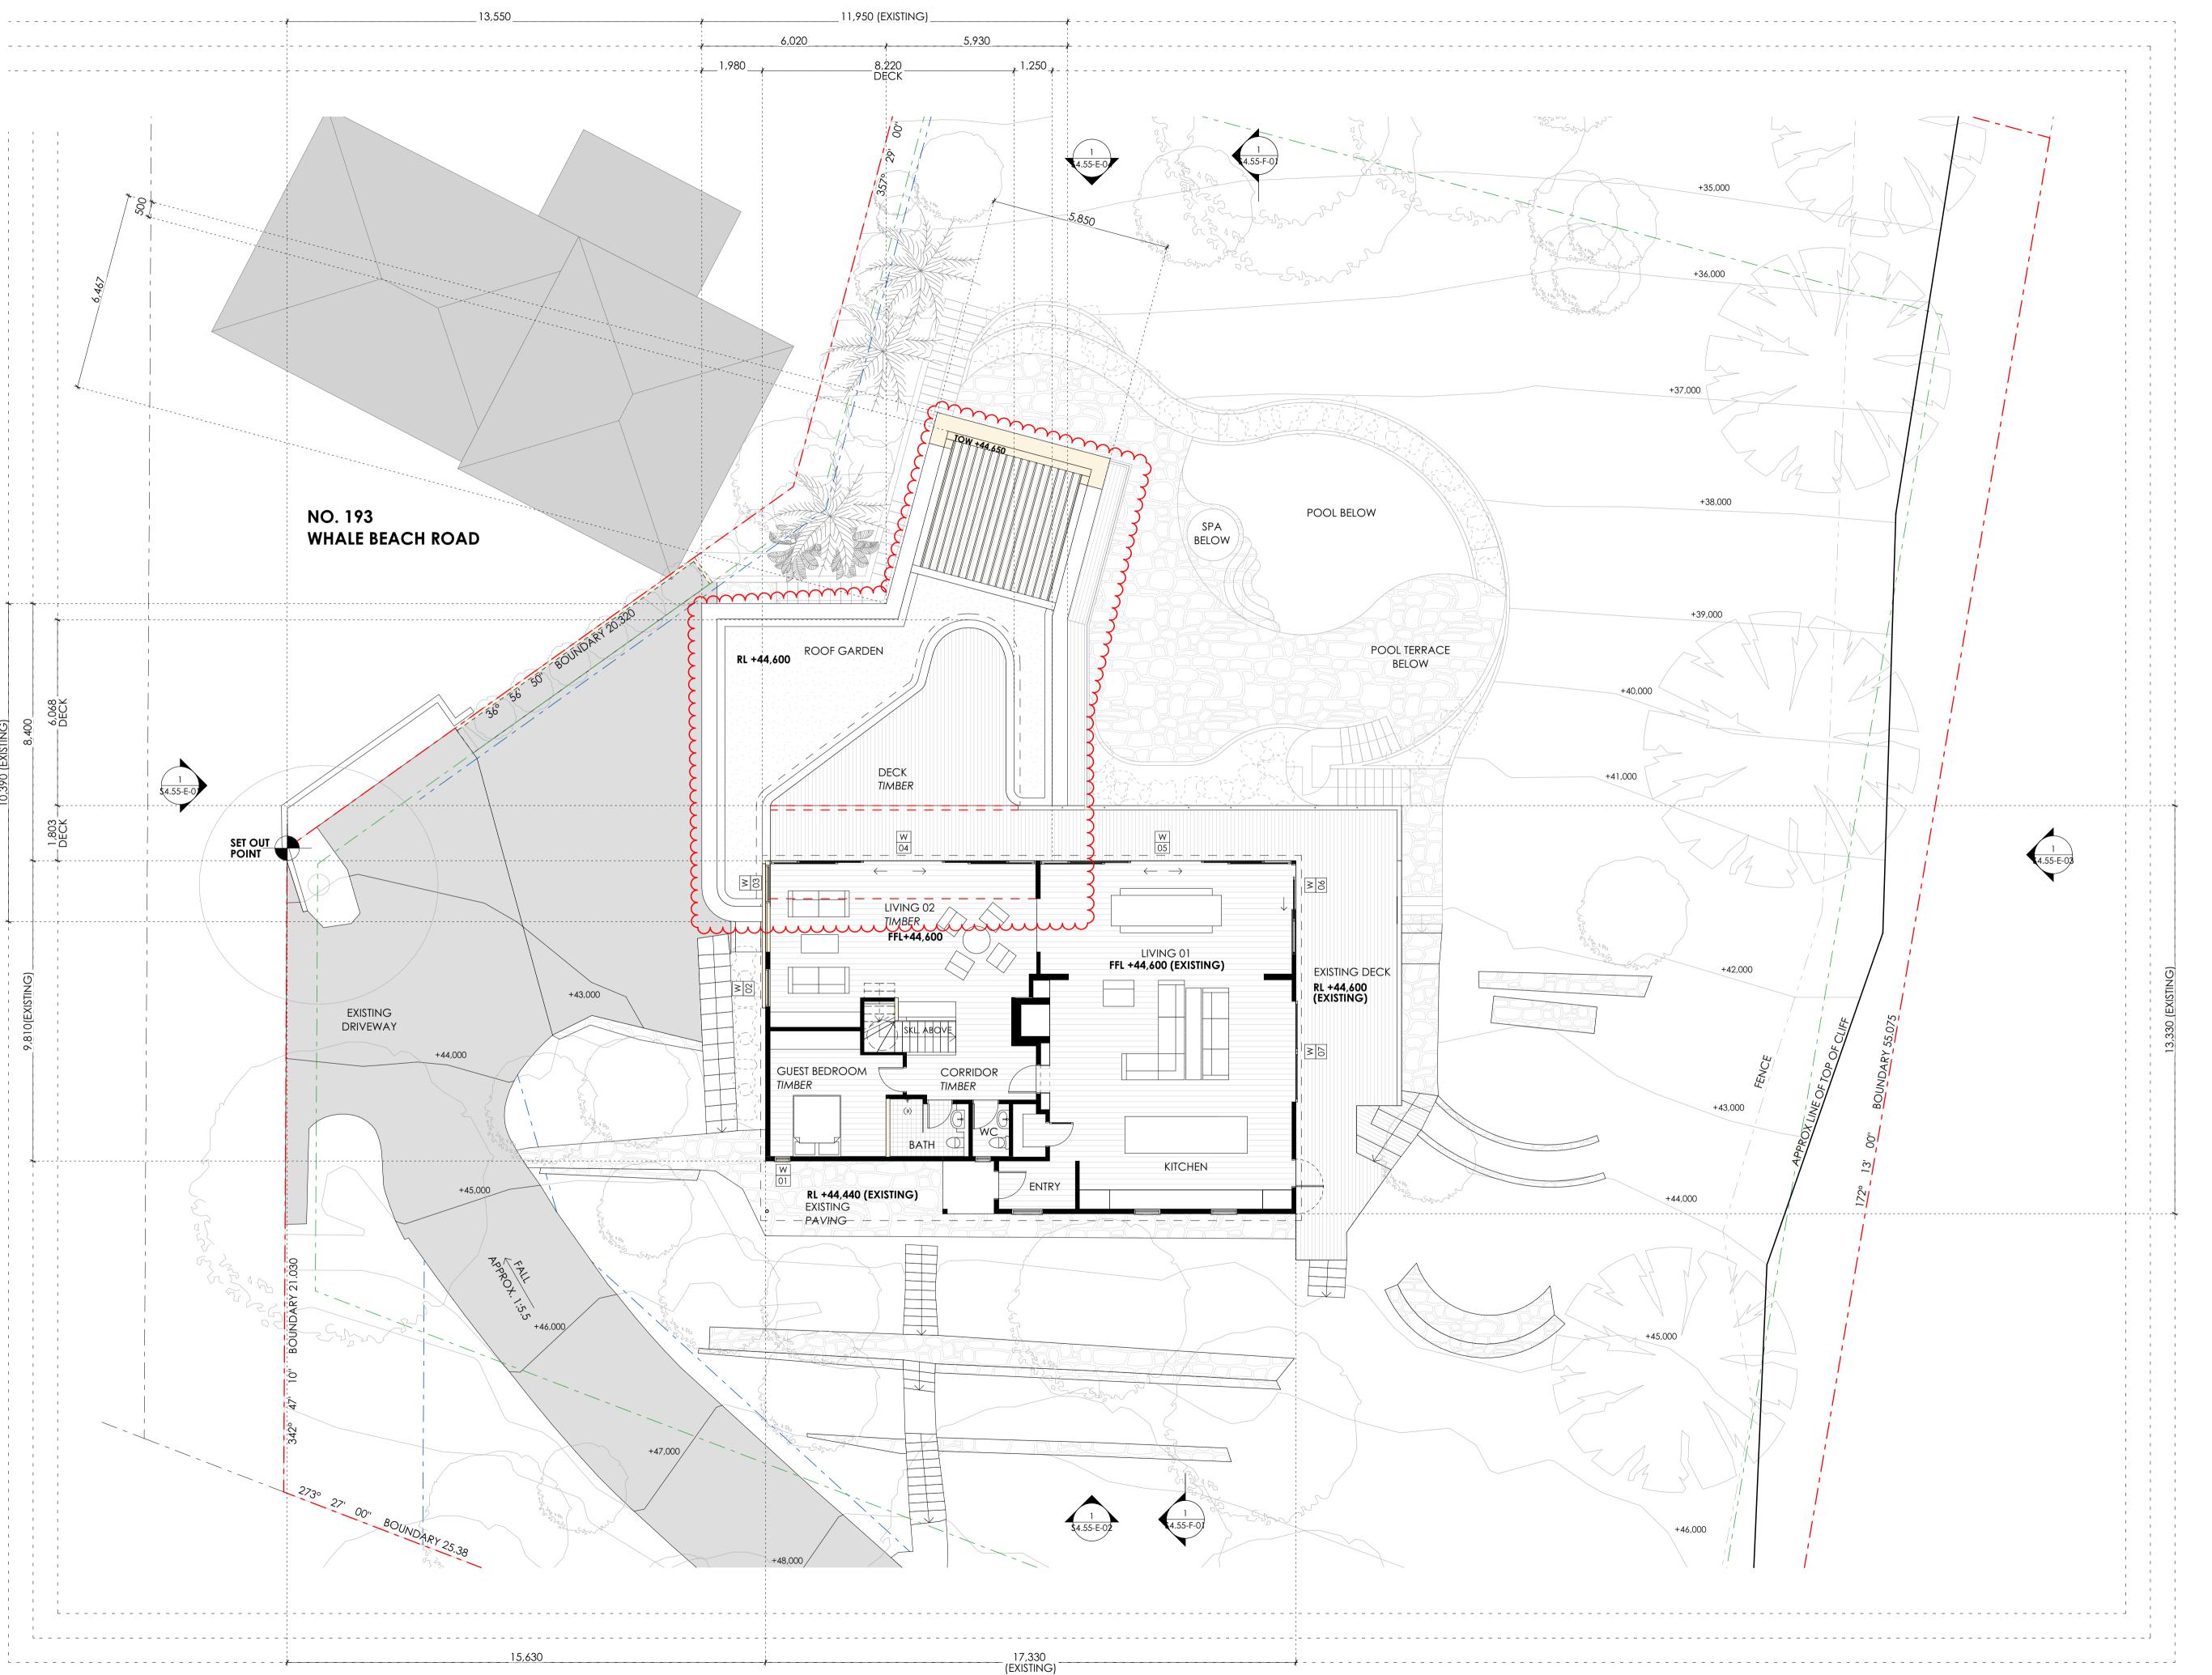

	EXISTING TO BE RETAIN
	BBOBOSED WORKS

### EINIC

A.201	STONE WALL
A.202	STONE FLOOR
A.301	TIMBER - NATURAL
A.302	TIMBER - PAINTED*
A.303	TIMBER SHIPLAP - PAINTED
A.401	GLASS
A.501	METAL ROOFING
A.502	METAL BALUSTRADE
A.503	STAINLESS STEEL

A.801 CONCRETE

\*PAINTED FINISH TO MATCH EXISTING COLOUR

TE ISSUE REVISION

CHECK ALL DIMENSIONS ON SITE PRIOR TO THE COMMENCEMENT OF WORK

USE FIGURED DIMENSIONS ONLY DO NOT SCALE

COMPLY WITH RELEVANT AUTHORITIES

REQUIREMENTS

COMPLY WITH BUILDING CODE OF AUSTRALIA

COMPLY WITH ALL RELEVANT AUSTRALIAN

STANDARDS


COPYRIGHT IN ALL DOCUMENTS AND

DRAWINGS PREPARED BY AKIN ATELIER

# AKIN ATELIER

#4 / 1 MARYS PLACE SURRY HILLS NSW, Australia, 2010

T: + 61 2 9043 3166 E: INFO@AKINATELIER.COM NOMINATED ARCHITECT: KELVIN HO NSW ARB #11251

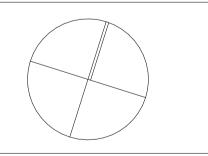

### PROJECT Rothwell House

191 WHALE BEACH ROAD WHALE BEACH NSW 2107


# CLIENT

SARAH & DAVID ROTHWELL

# DRAWING

FIRST FLOOR PLAN

PROJECT NO. 0483	DRAWN AR
SCALE 1:100@ A1 1:200@ A3	CHECKED AS
DWG NO. <b>\$4.55-D-02</b>	ISSUE A

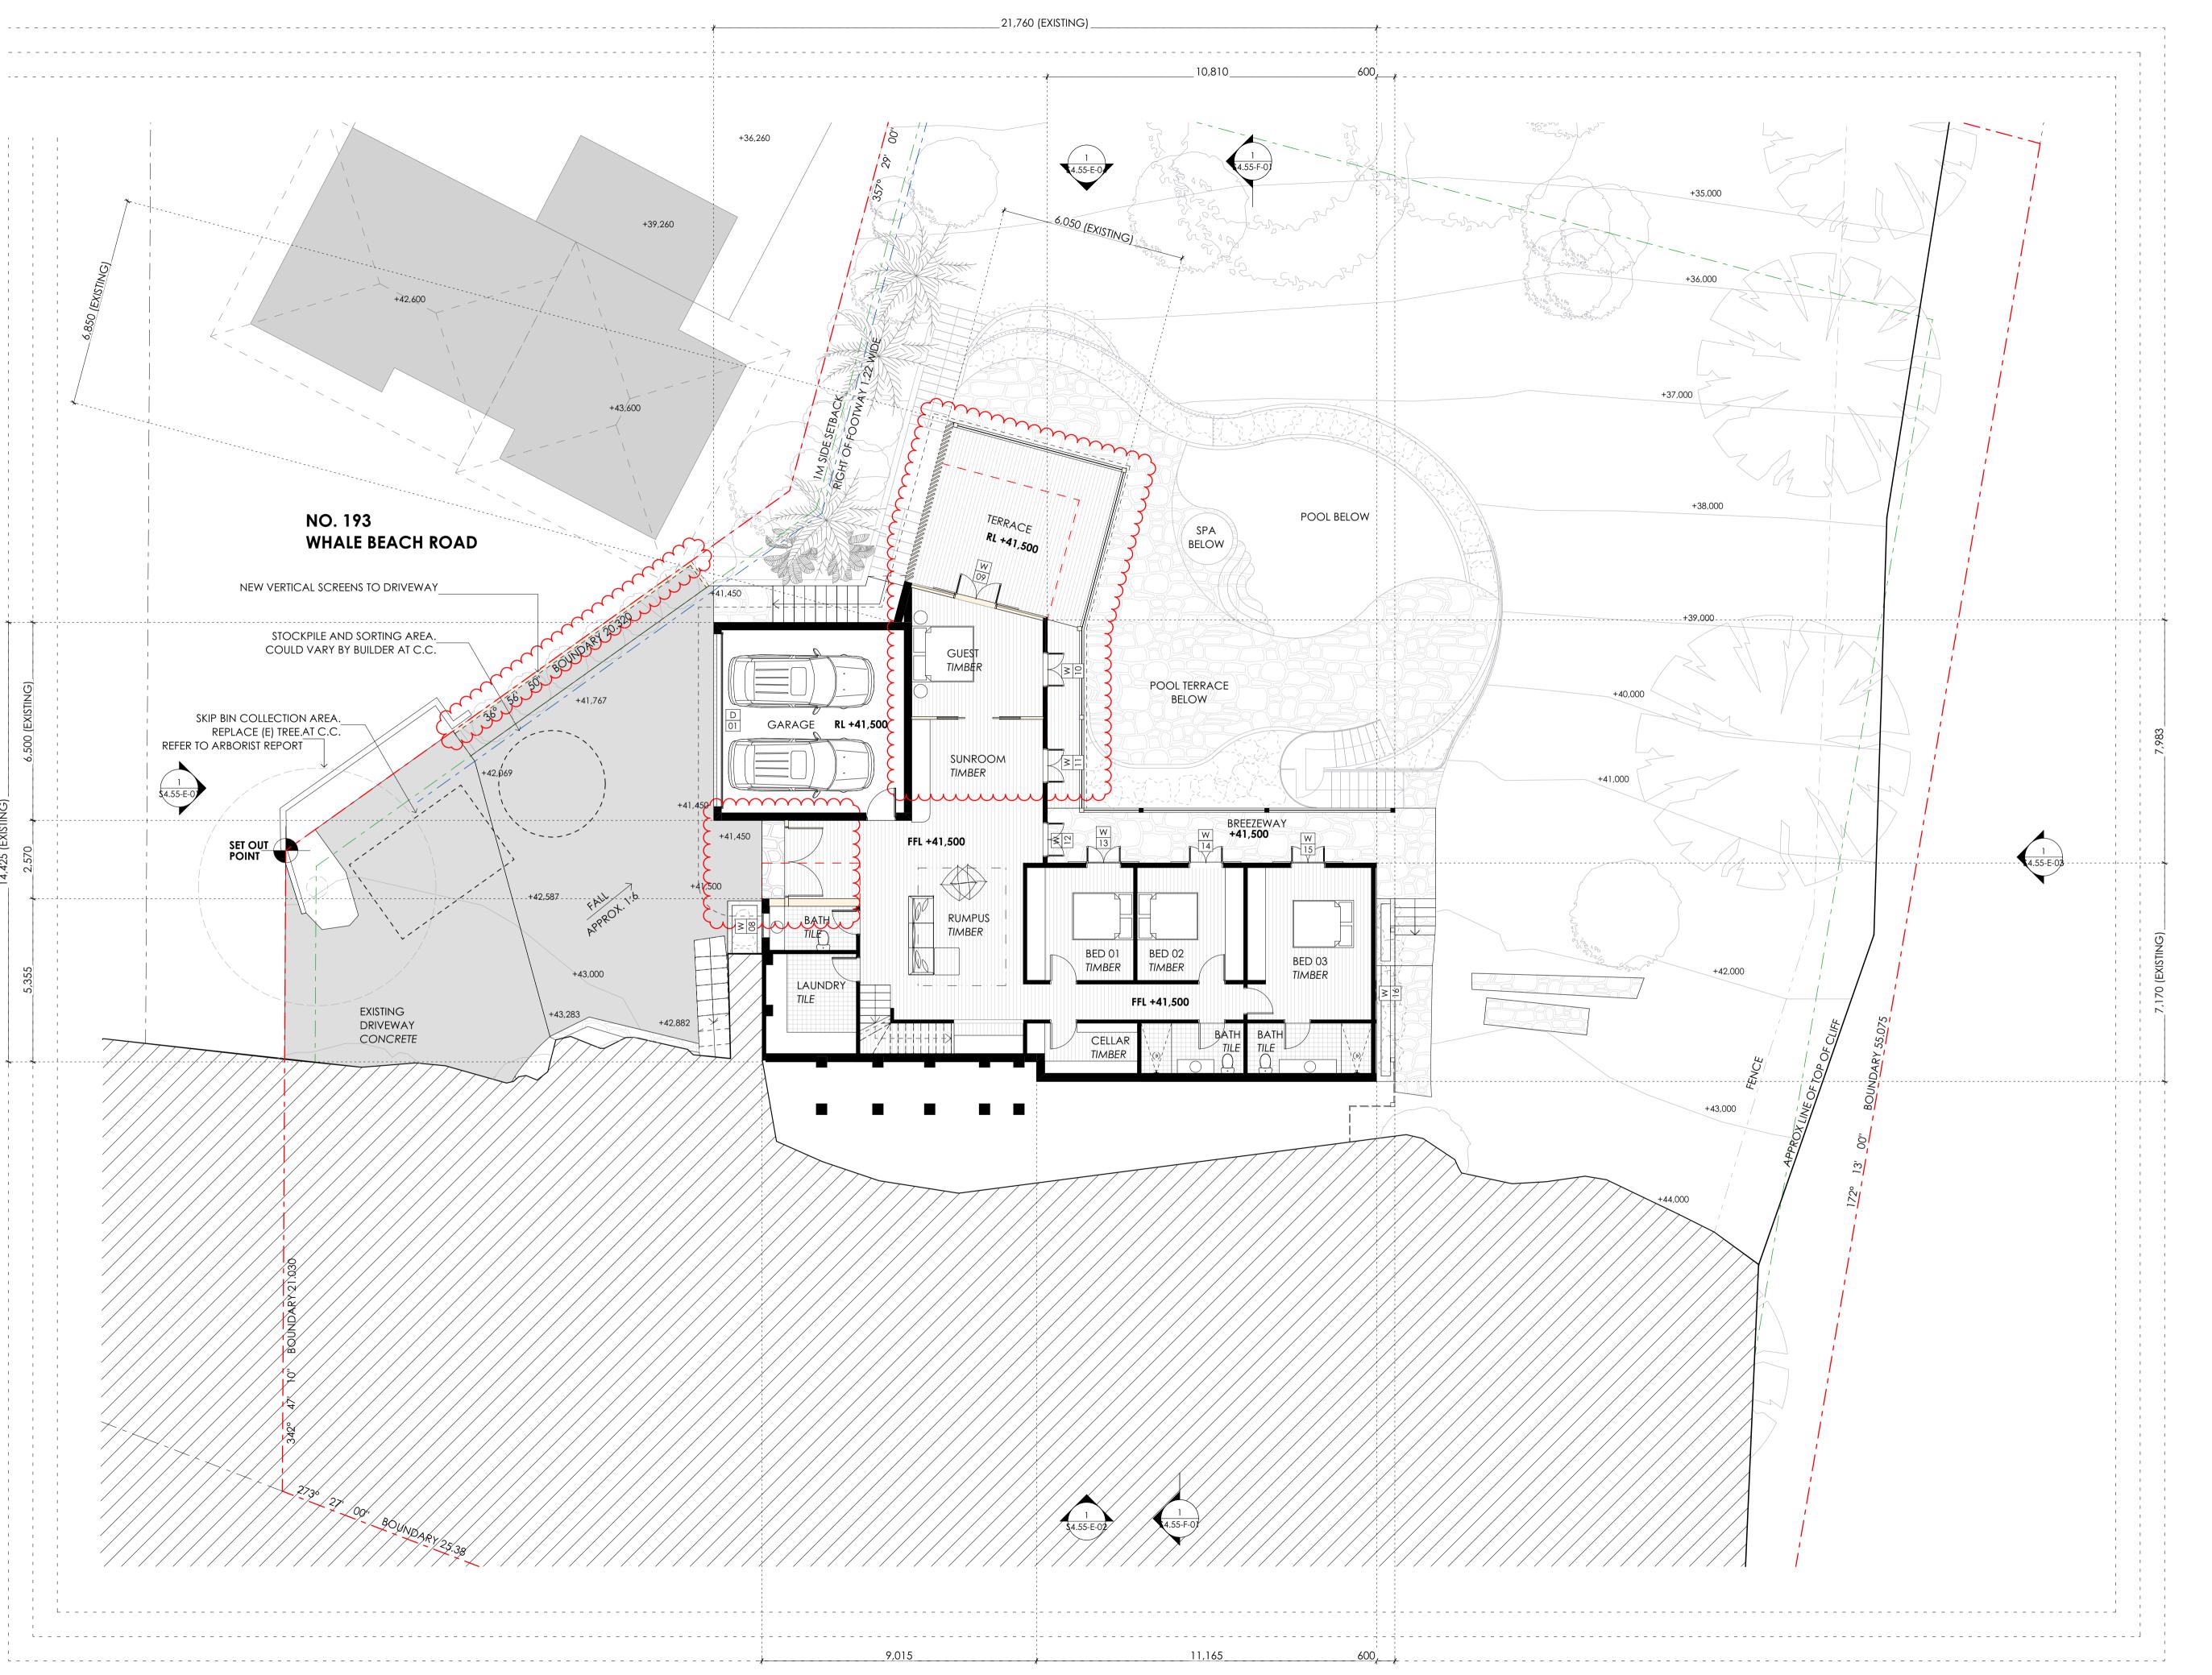

	EXISTING TO BE RETAINE
	PROPOSED WORKS

### FINISH

A.201	STONE WALL
A.202	STONE FLOOR
A.301	TIMBER - NATURAL
A.302	TIMBER - PAINTED*
A.303	TIMBER SHIPLAP - PAINTED*
A.401	GLASS
A.501	METAL ROOFING
A.502	METAL BALUSTRADE
A.503	STAINLESS STEEL

A.801 CONCRETE

\*PAINTED FINISH TO MATCH EXISTING COLOUR

DATE ISSUE REVISION

CHECK ALL DIMENSIONS ON SITE PRIOR TO THE COMMENCEMENT OF WORK USE FIGURED DIMENSIONS ONLY DO NOT SCALE COMPLY WITH RELEVANT AUTHORITIES REQUIREMENTS COMPLY WITH BUILDING CODE OF AUSTRALIA COMPLY WITH ALL RELEVANT AUSTRALIAN

COPYRIGHT IN ALL DOCUMENTS AND


DRAWINGS PREPARED BY AKIN ATELIER

AKIN ATELIER

STANDARDS

#4 / 1 MARYS PLACE SURRY HILLS NSW, Australia, 2010

T: + 61 2 9043 3166 E: INFO@AKINATELIER.COM NOMINATED ARCHITECT: KELVIN HO NSW ARB #11251

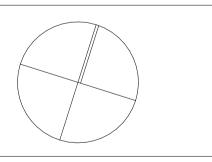

PROJECT Rothwell House

191 WHALE BEACH ROAD WHALE BEACH NSW 2107

CLIENT

SARAH & DAVID ROTHWELL

DRAWING

GROUND FLOOR PLAN

PROJECT NO.	DRAWN
0483	AR
SCALE	CHECKED
1:100@ A1	AS
1:200@ A3 DWG NO. <b>\$4.55-D-03</b>	ISSUE A



EXISTING TO BE RETAIN
PROPOSED WORKS

### EINII

A.201	STONE WALL
A.202	STONE FLOOR
A.301	TIMBER - NATURAL
A.302	TIMBER - PAINTED*
A.303	TIMBER SHIPLAP - PAINTED*
A.401	GLASS
A.501	METAL ROOFING
A.502	METAL BALUSTRADE
A.503	STAINLESS STEEL

A.801 CONCRETE

\*PAINTED FINISH TO MATCH EXISTING COLOUR

ATE ISSUE REVISION


CHECK ALL DIMENSIONS ON SITE PRIOR TO THE COMMENCEMENT OF WORK USE FIGURED DIMENSIONS ONLY DO NOT SCALE COMPLY WITH RELEVANT AUTHORITIES REQUIREMENTS COMPLY WITH BUILDING CODE OF AUSTRALIA

COMPLY WITH ALL RELEVANT AUSTRALIAN
STANDARDS
COPYRIGHT IN ALL DOCUMENTS AND
DRAWINGS PREPARED BY AKIN ATELIER

# AKIN ATELIER

#4 / 1 MARYS PLACE SURRY HILLS NSW, Australia, 2010

T: + 61 2 9043 3166 E: INFO@AKINATELIER.COM NOMINATED ARCHITECT: KELVIN HO NSW ARB #11251

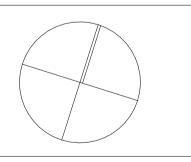

### PROJECT Rothwell House

191 WHALE BEACH ROAD WHALE BEACH NSW 2107


# CLIENT

SARAH & DAVID ROTHWELL

# DRAWING

POOL + LOWER GROUND FLOOR PLAN

PROJECT NO. 0483	DRAWN AR
SCALE 1:100@ A1 1:200@ A3	CHECKED AS
DWG NO. \$4.55-D-04	ISSUE A

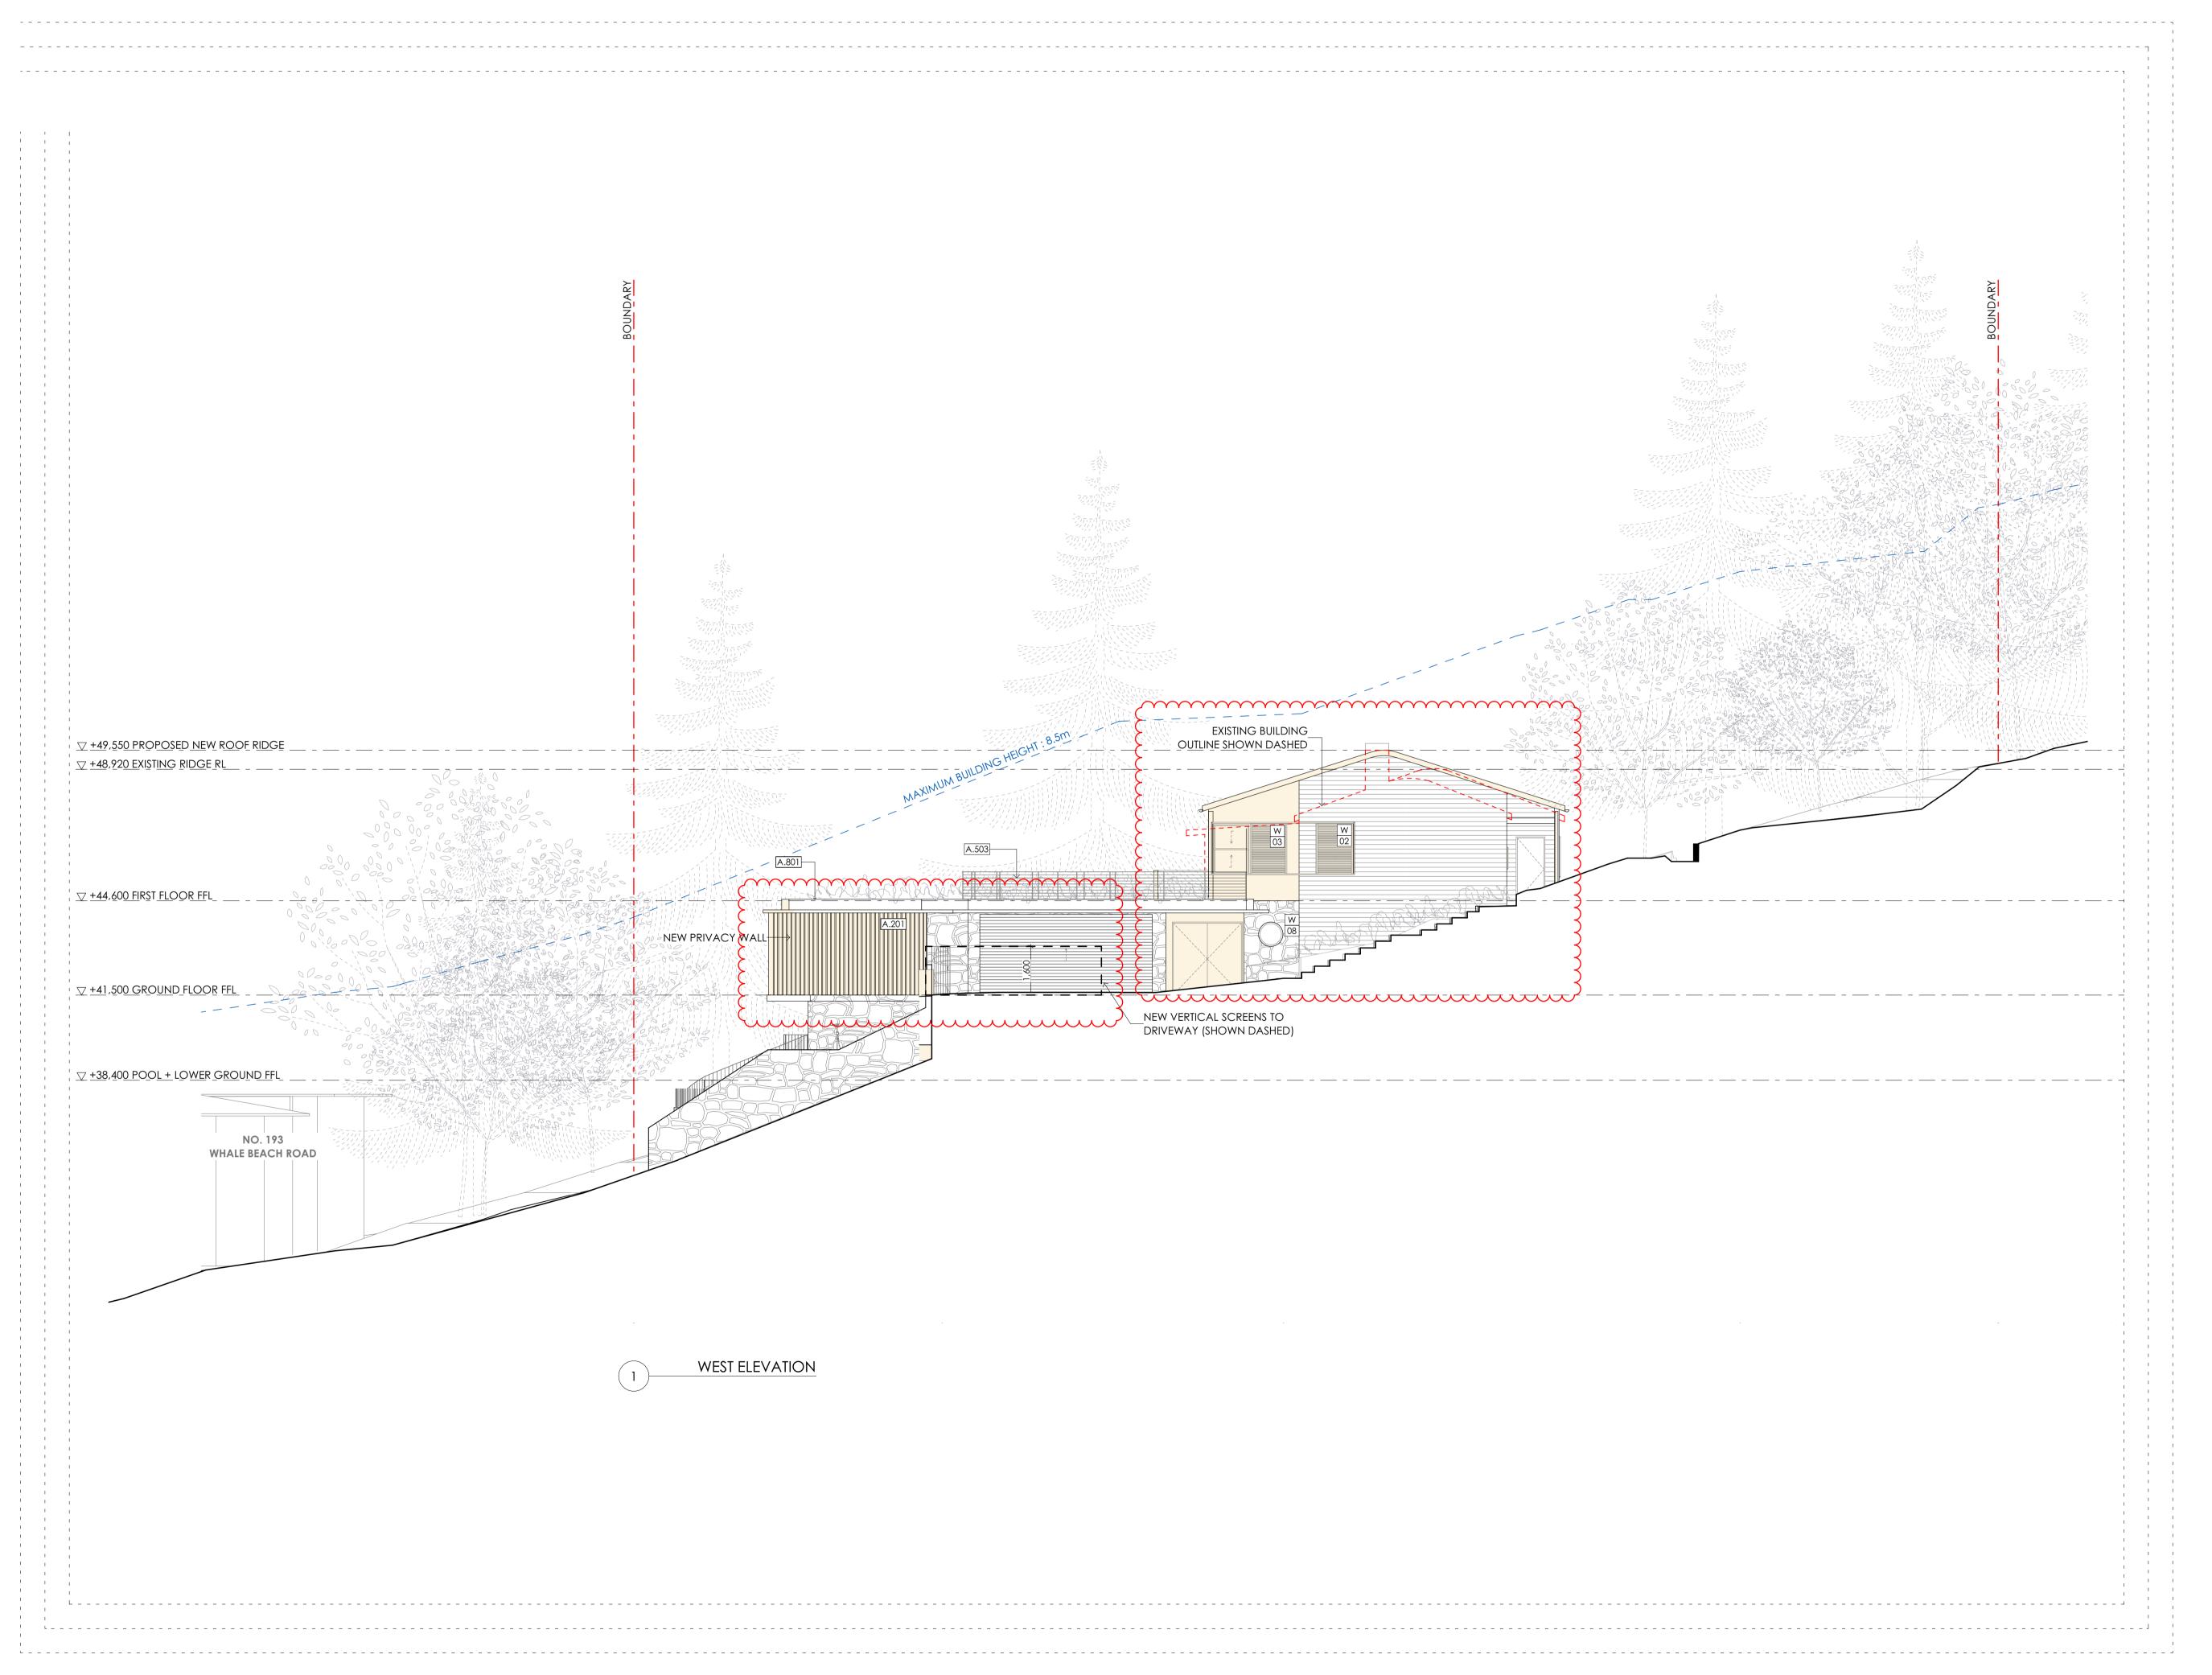

EXISTING TO BE R	
	PROPOSED WORKS

### FINIS

A.201	STONE WALL
A.202	STONE FLOOR
A.301	TIMBER - NATURAL
A.302	TIMBER - PAINTED*
A.303	TIMBER SHIPLAP - PAINTED*
A.401	GLASS
A.501	METAL ROOFING
A.502	METAL BALUSTRADE
A.503	STAINLESS STEEL
	A.202 A.301 A.302 A.303 A.401 A.501 A.502

A.801 CONCRETE

\*PAINTED FINISH TO MATCH EXISTING COLOUR

ATOTI EXISTINO COLOGIC

e issue revision

CHECK ALL DIMENSIONS ON SITE PRIOR TO THE COMMENCEMENT OF WORK USE FIGURED DIMENSIONS ONLY DO NOT SCALE COMPLY WITH RELEVANT AUTHORITIES REQUIREMENTS

COMPLY WITH BUILDING CODE OF AUSTRALIA COMPLY WITH ALL RELEVANT AUSTRALIAN STANDARDS COPYRIGHT IN ALL DOCUMENTS AND DRAWINGS PREPARED BY AKIN ATELIER

# AKIN ATELIER

#4 / 1 MARYS PLACE SURRY HILLS NSW, Australia, 2010

T: + 61 2 9043 3166
E: INFO@AKINATELIER.COM
NOMINATED ARCHITECT: KELVIN HO NSW ARB #11251

PROJECT Rothwell House

191 WHALE BEACH ROAD WHALE BEACH NSW 2107


CLIENT

SARAH & DAVID ROTHWELL

DRAWING

WEST ELEVATION

PROJECT NO.	DRAWN
0483	AR
SCALE 1:100@ A1 1:200@ A3	CHECKED AS
DWG NO.	ISSUE
<b>\$4.55-E-01</b>	A

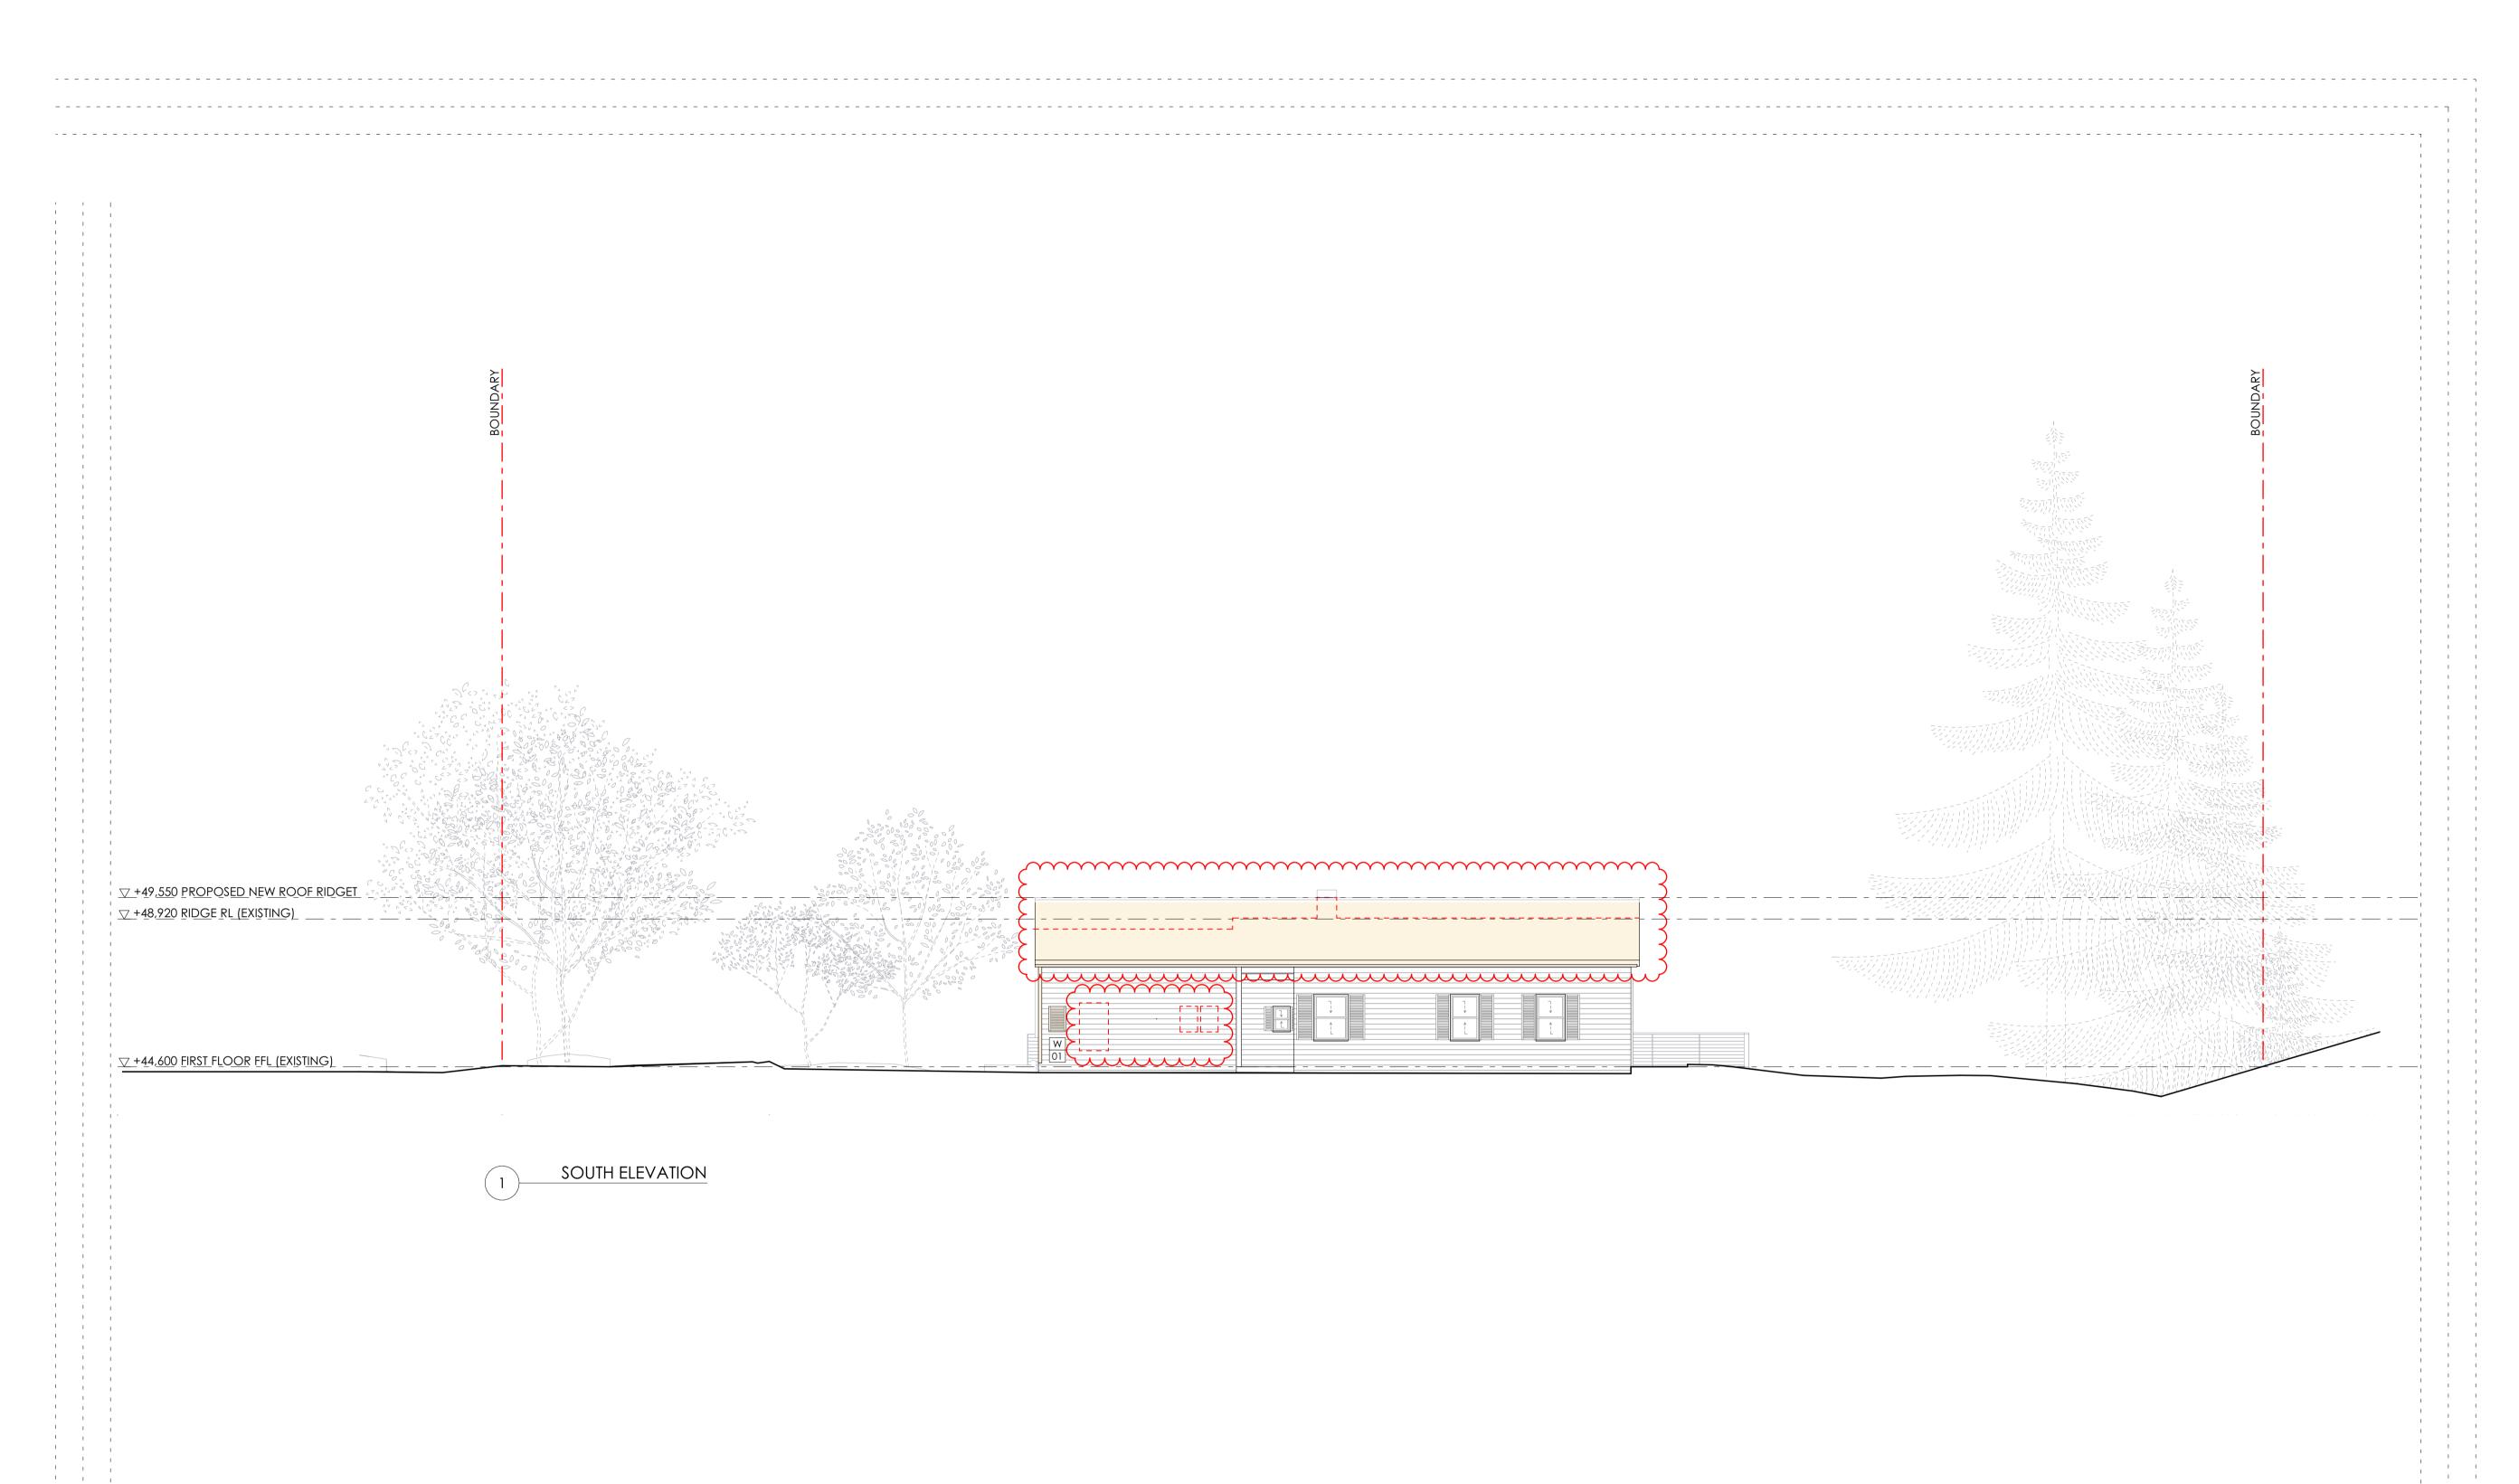

### LEGEND

	EXISTING TO BE RETA
	PROPOSED WORKS

### FINIS

A.201	STONE WALL
A.202	STONE FLOOR
A.301	TIMBER - NATURAL
A.302	TIMBER - PAINTED*
A.303	TIMBER SHIPLAP - PAINTED
A.401	GLASS
A.501	METAL ROOFING
A.502	METAL BALUSTRADE
A.503	STAINLESS STEEL

A.801 CONCRETE

\*PAINTED FINISH TO MATCH EXISTING COLOUR

DATE ISSUE REVISION

CHECK ALL DIMENSIONS ON SITE PRIOR TO THE COMMENCEMENT OF WORK USE FIGURED DIMENSIONS ONLY DO NOT SCALE COMPLY WITH RELEVANT AUTHORITIES REQUIREMENTS COMPLY WITH BUILDING CODE OF AUSTRALIA COMPLY WITH ALL RELEVANT AUSTRALIAN STANDARDS COPYRIGHT IN ALL DOCUMENTS AND

DRAWINGS PREPARED BY AKIN ATELIER

# AKIN ATELIER

#4 / 1 MARYS PLACE SURRY HILLS NSW, Australia, 2010

T: + 61 2 9043 3166 E: INFO@AKINATELIER.COM NOMINATED ARCHITECT: KELVIN HO NSW ARB #11251

PROJECT Rothwell House

191 WHALE BEACH ROAD WHALE BEACH NSW 2107


CLIENT

SARAH & DAVID ROTHWELL

DRAWING

SOUTH ELEVATION

PROJECT NO. 0483	DRAWN AR
SCALE 1:100@ A1 1:200@ A3	CHECKED AS
DWG NO. <b>\$4.55-E-02</b>	ISSUE A

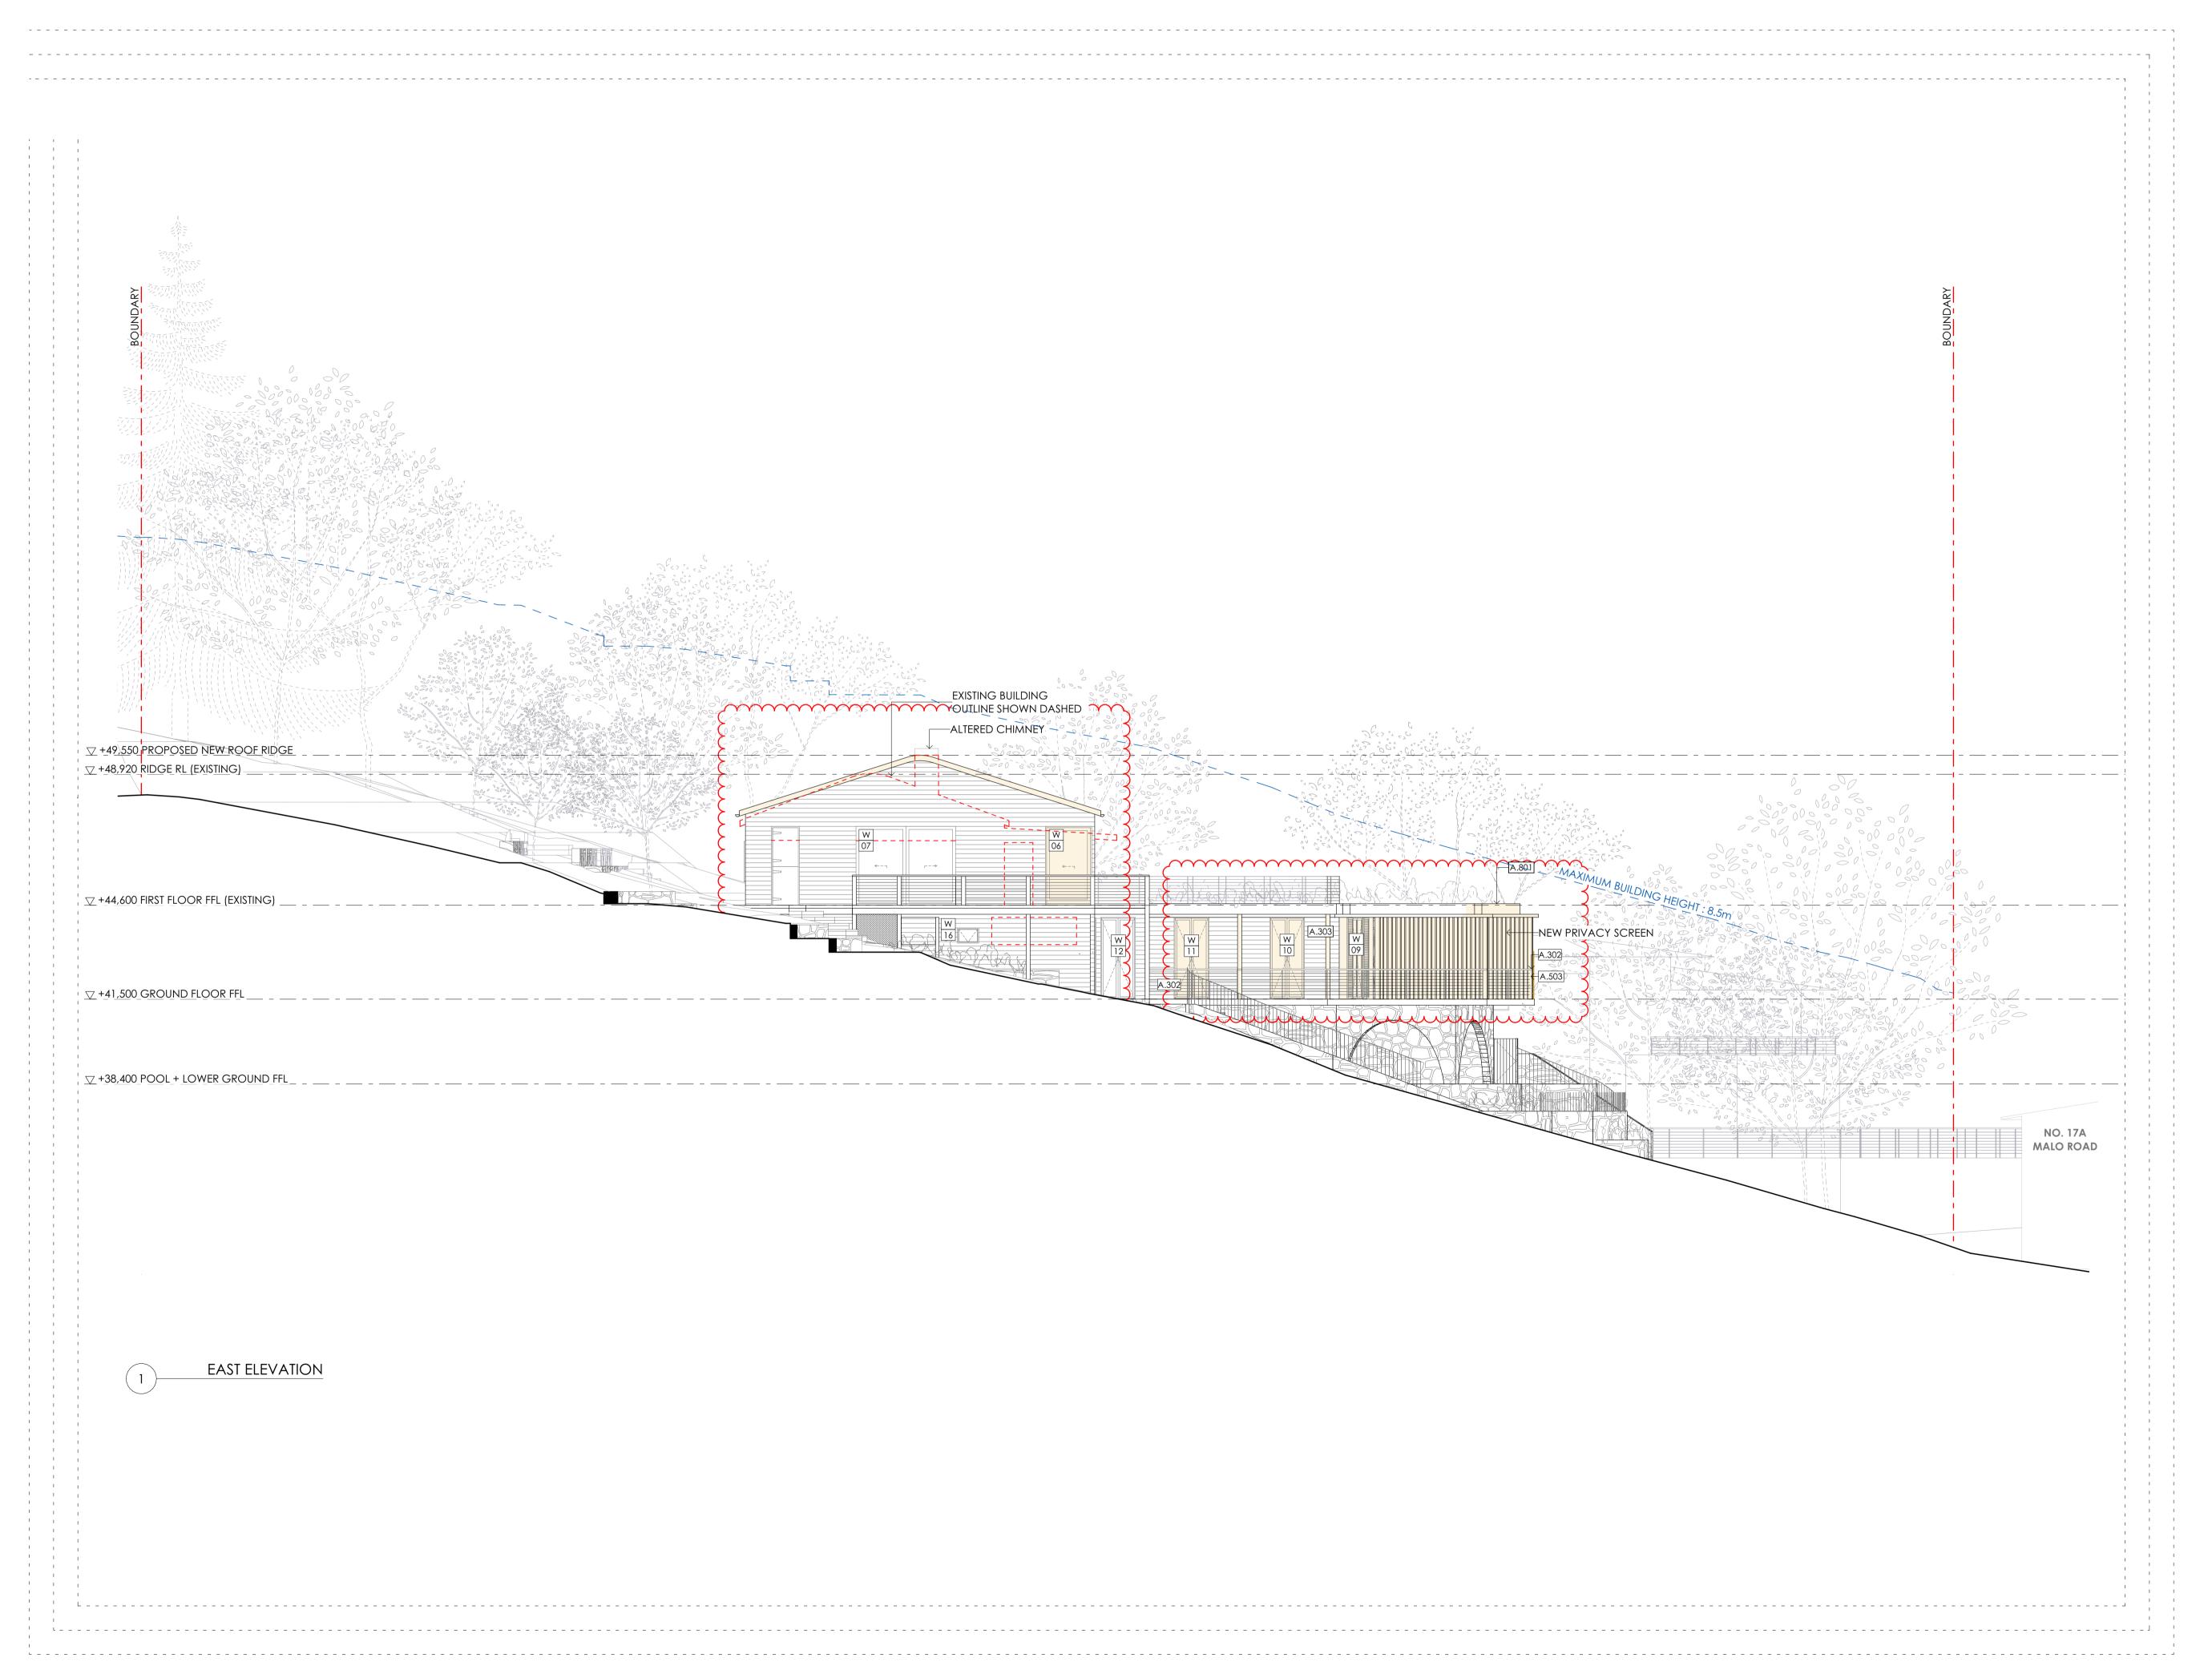

EXISTING TO BE RETAIN
PROPOSED WORKS

### \_...

A.201	STONE WALL
A.202	STONE FLOOR
A.301	TIMBER - NATURAL
A.302	TIMBER - PAINTED*
A.303	TIMBER SHIPLAP - PAINTED
A.401	GLASS
A.501	METAL ROOFING
A.502	METAL BALUSTRADE
A.503	STAINLESS STEEL

A.801 CONCRETE

\*PAINTED FINISH TO MATCH EXISTING COLOUR

E ISSUE REVISION

CHECK ALL DIMENSIONS ON SITE PRIOR TO THE COMMENCEMENT OF WORK USE FIGURED DIMENSIONS ONLY DO NOT SCALE COMPLY WITH RELEVANT AUTHORITIES REQUIREMENTS
COMPLY WITH BUILDING CODE OF AUSTRALIA

COMPLY WITH ALL RELEVANT AUSTRALIAN STANDARDS
COPYRIGHT IN ALL DOCUMENTS AND DRAWINGS PREPARED BY AKIN ATELIER

# AKIN ATELIER

#4 / 1 MARYS PLACE SURRY HILLS NSW, Australia, 2010

T: + 61 2 9043 3166
E: INFO@AKINATELIER.COM
NOMINATED ARCHITECT: KELVIN HO NSW ARB #11251

PROJECT Rothwell House

191 WHALE BEACH ROAD WHALE BEACH NSW 2107


CLIENT

SARAH & DAVID ROTHWELL

DRAWING

EAST ELEVATION

PROJECT NO. 0483	DRAWN AR
SCALE 1:100@ A1 1:200@ A3	CHECKED AS
DWG NO. <b>\$4.55-E-03</b>	ISSUE A

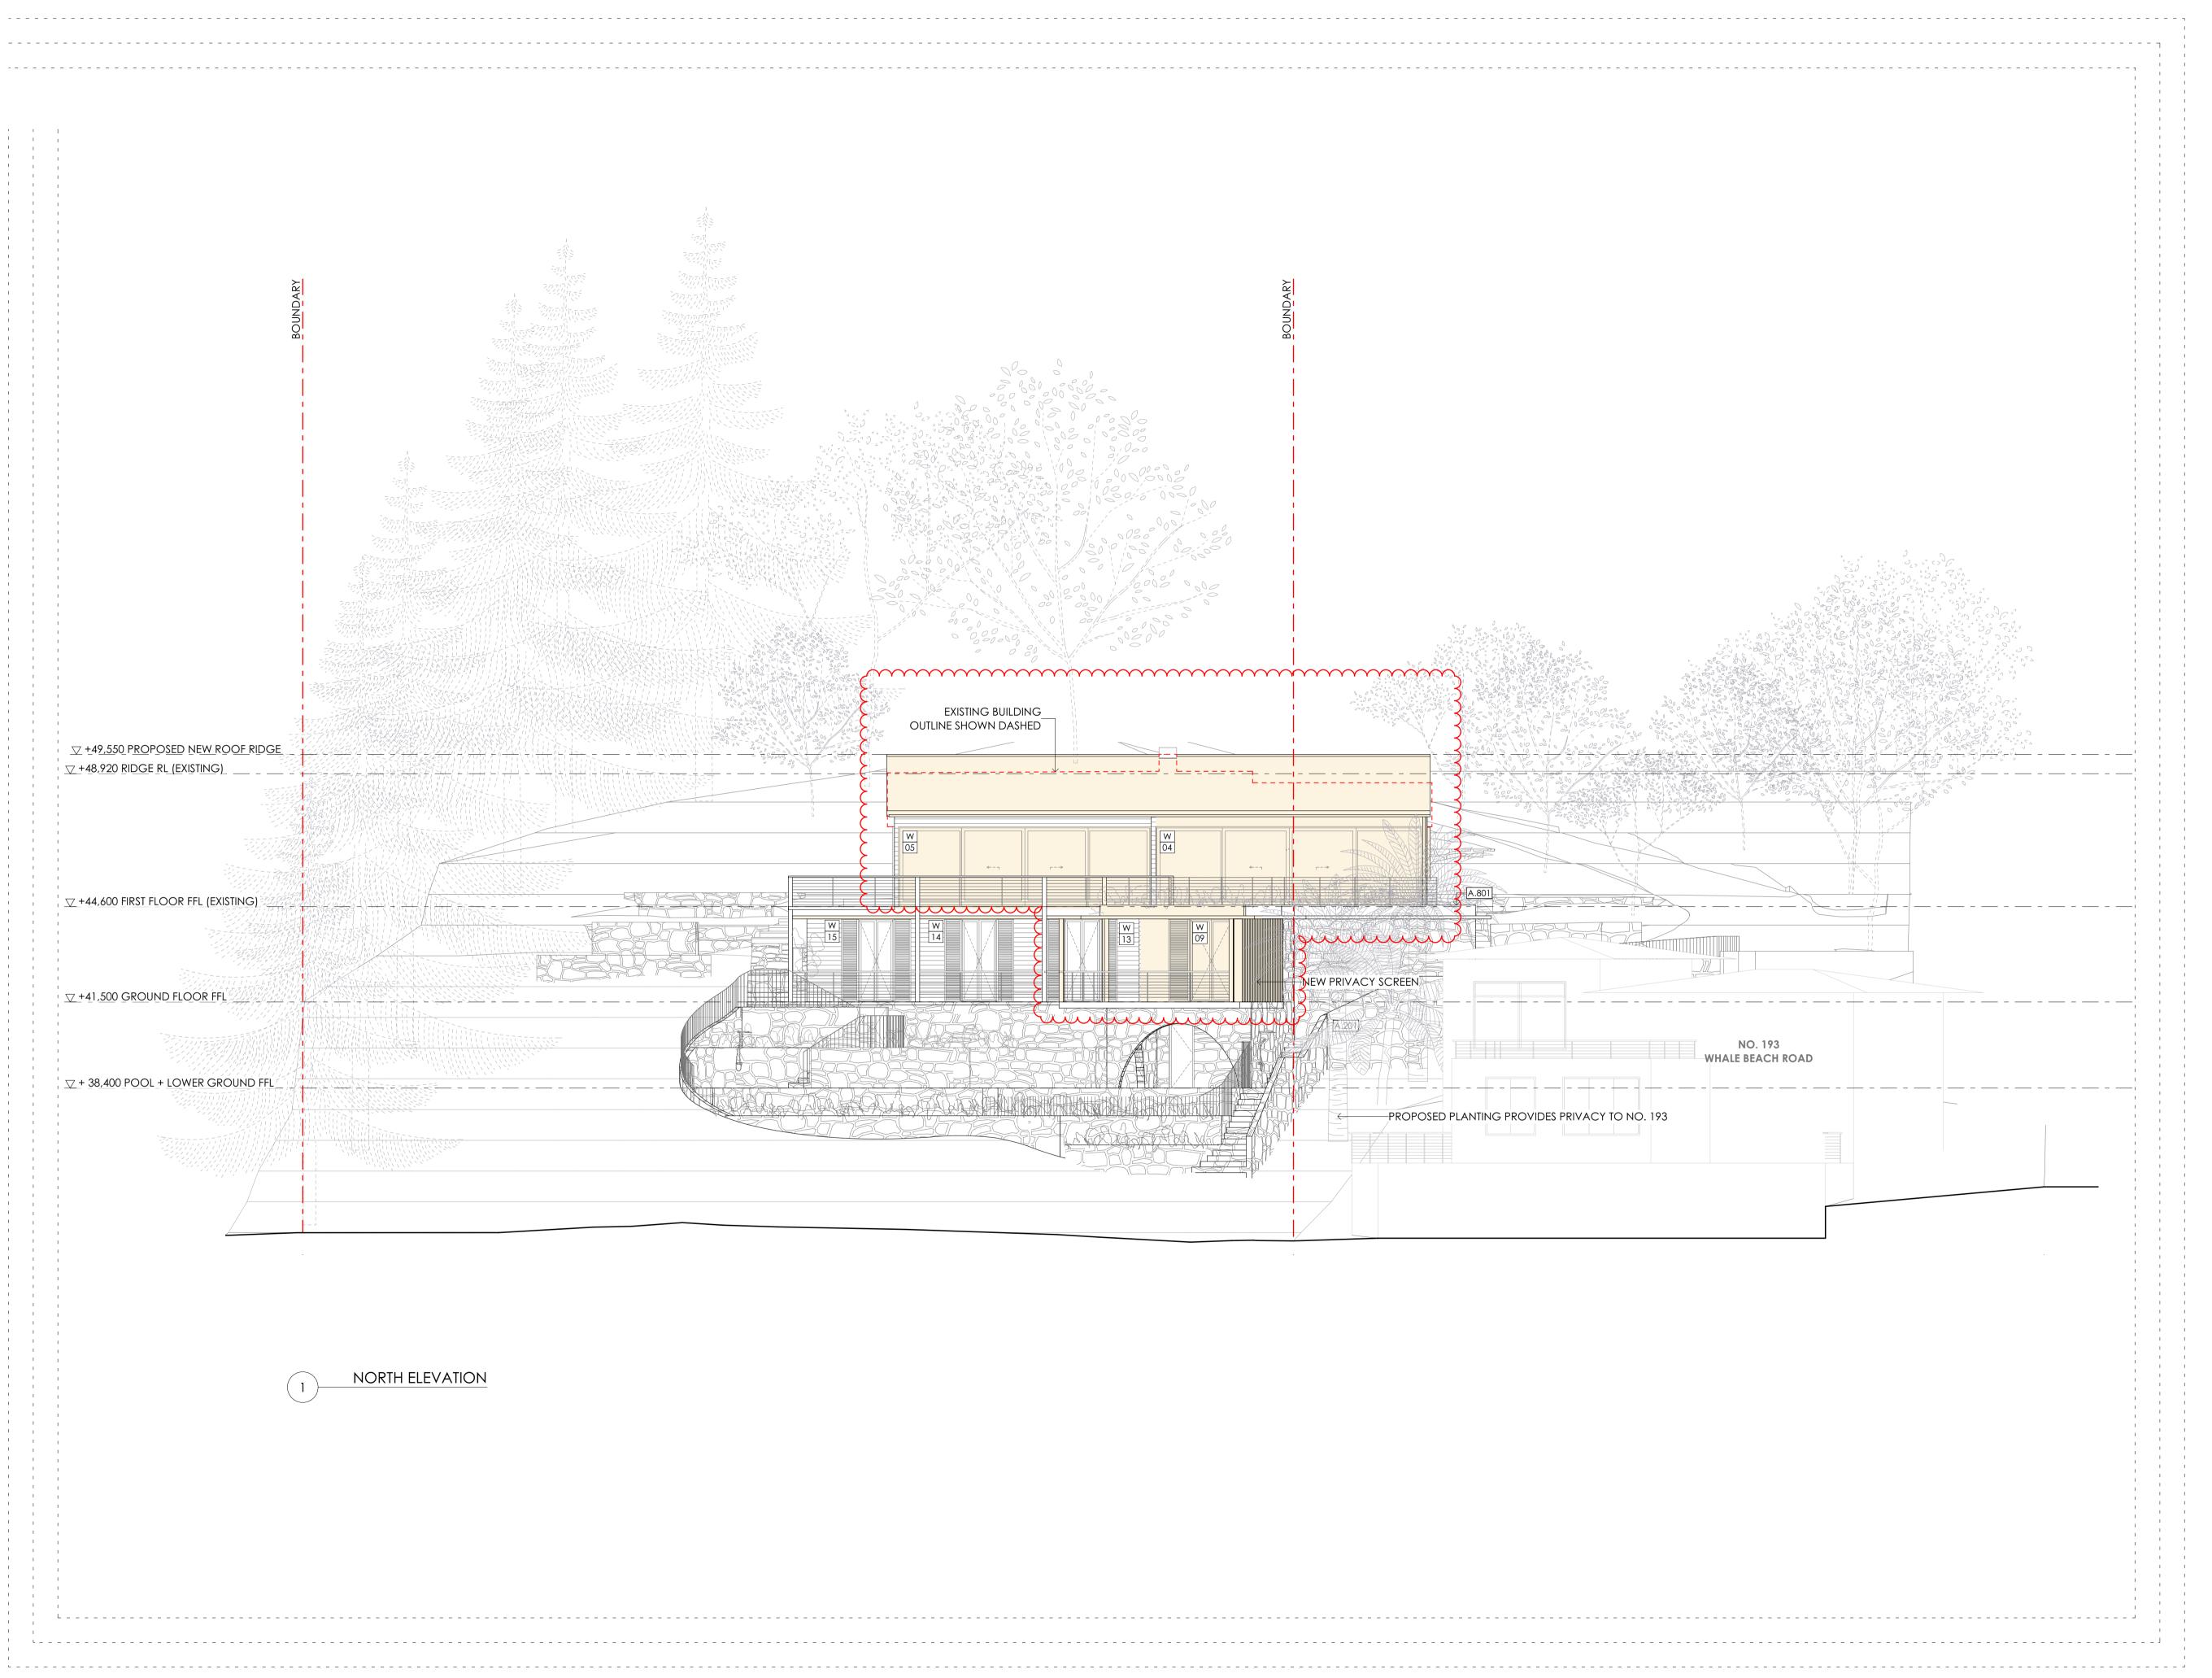

EXISTING TO BE RETAI
PROPOSED WORKS

### EINIC

A.201	STONE WALL
A.202	STONE FLOOR
A.301	TIMBER - NATURAL
A.302	TIMBER - PAINTED*
A.303	TIMBER SHIPLAP - PAINTED*
A.401	GLASS
A.501	METAL ROOFING
A.502	METAL BALUSTRADE
A.503	STAINLESS STEEL

A.801 CONCRETE

\*PAINTED FINISH TO MATCH EXISTING COLOUR

E ISSUE REVISION

THE COMMENCEMENT OF WORK
USE FIGURED DIMENSIONS ONLY DO NOT
SCALE
COMPLY WITH RELEVANT AUTHORITIES
REQUIREMENTS
COMPLY WITH BUILDING CODE OF
AUSTRALIA
COMPLY WITH ALL RELEVANT AUSTRALIAN
STANDARDS

COPYRIGHT IN ALL DOCUMENTS AND DRAWINGS PREPARED BY AKIN ATELIER

CHECK ALL DIMENSIONS ON SITE PRIOR TO

# AKIN ATELIER

#4 / 1 MARYS PLACE SURRY HILLS NSW, Australia, 2010

T: + 61 2 9043 3166 E: INFO@AKINATELIER.COM NOMINATED ARCHITECT: KELVIN HO NSW ARB #11251

PROJECT Rothwell House

191 WHALE BEACH ROAD WHALE BEACH NSW 2107


CLIENT

SARAH & DAVID ROTHWELL

DRAWING

NORTH ELEVATION

PROJECT NO.	DRAWN
0483	AR
SCALE	CHECKED
1:100@ A1 1:200@ A3	AS
DWG NO.	ISSUE
<b>\$4.55-E-04</b>	A

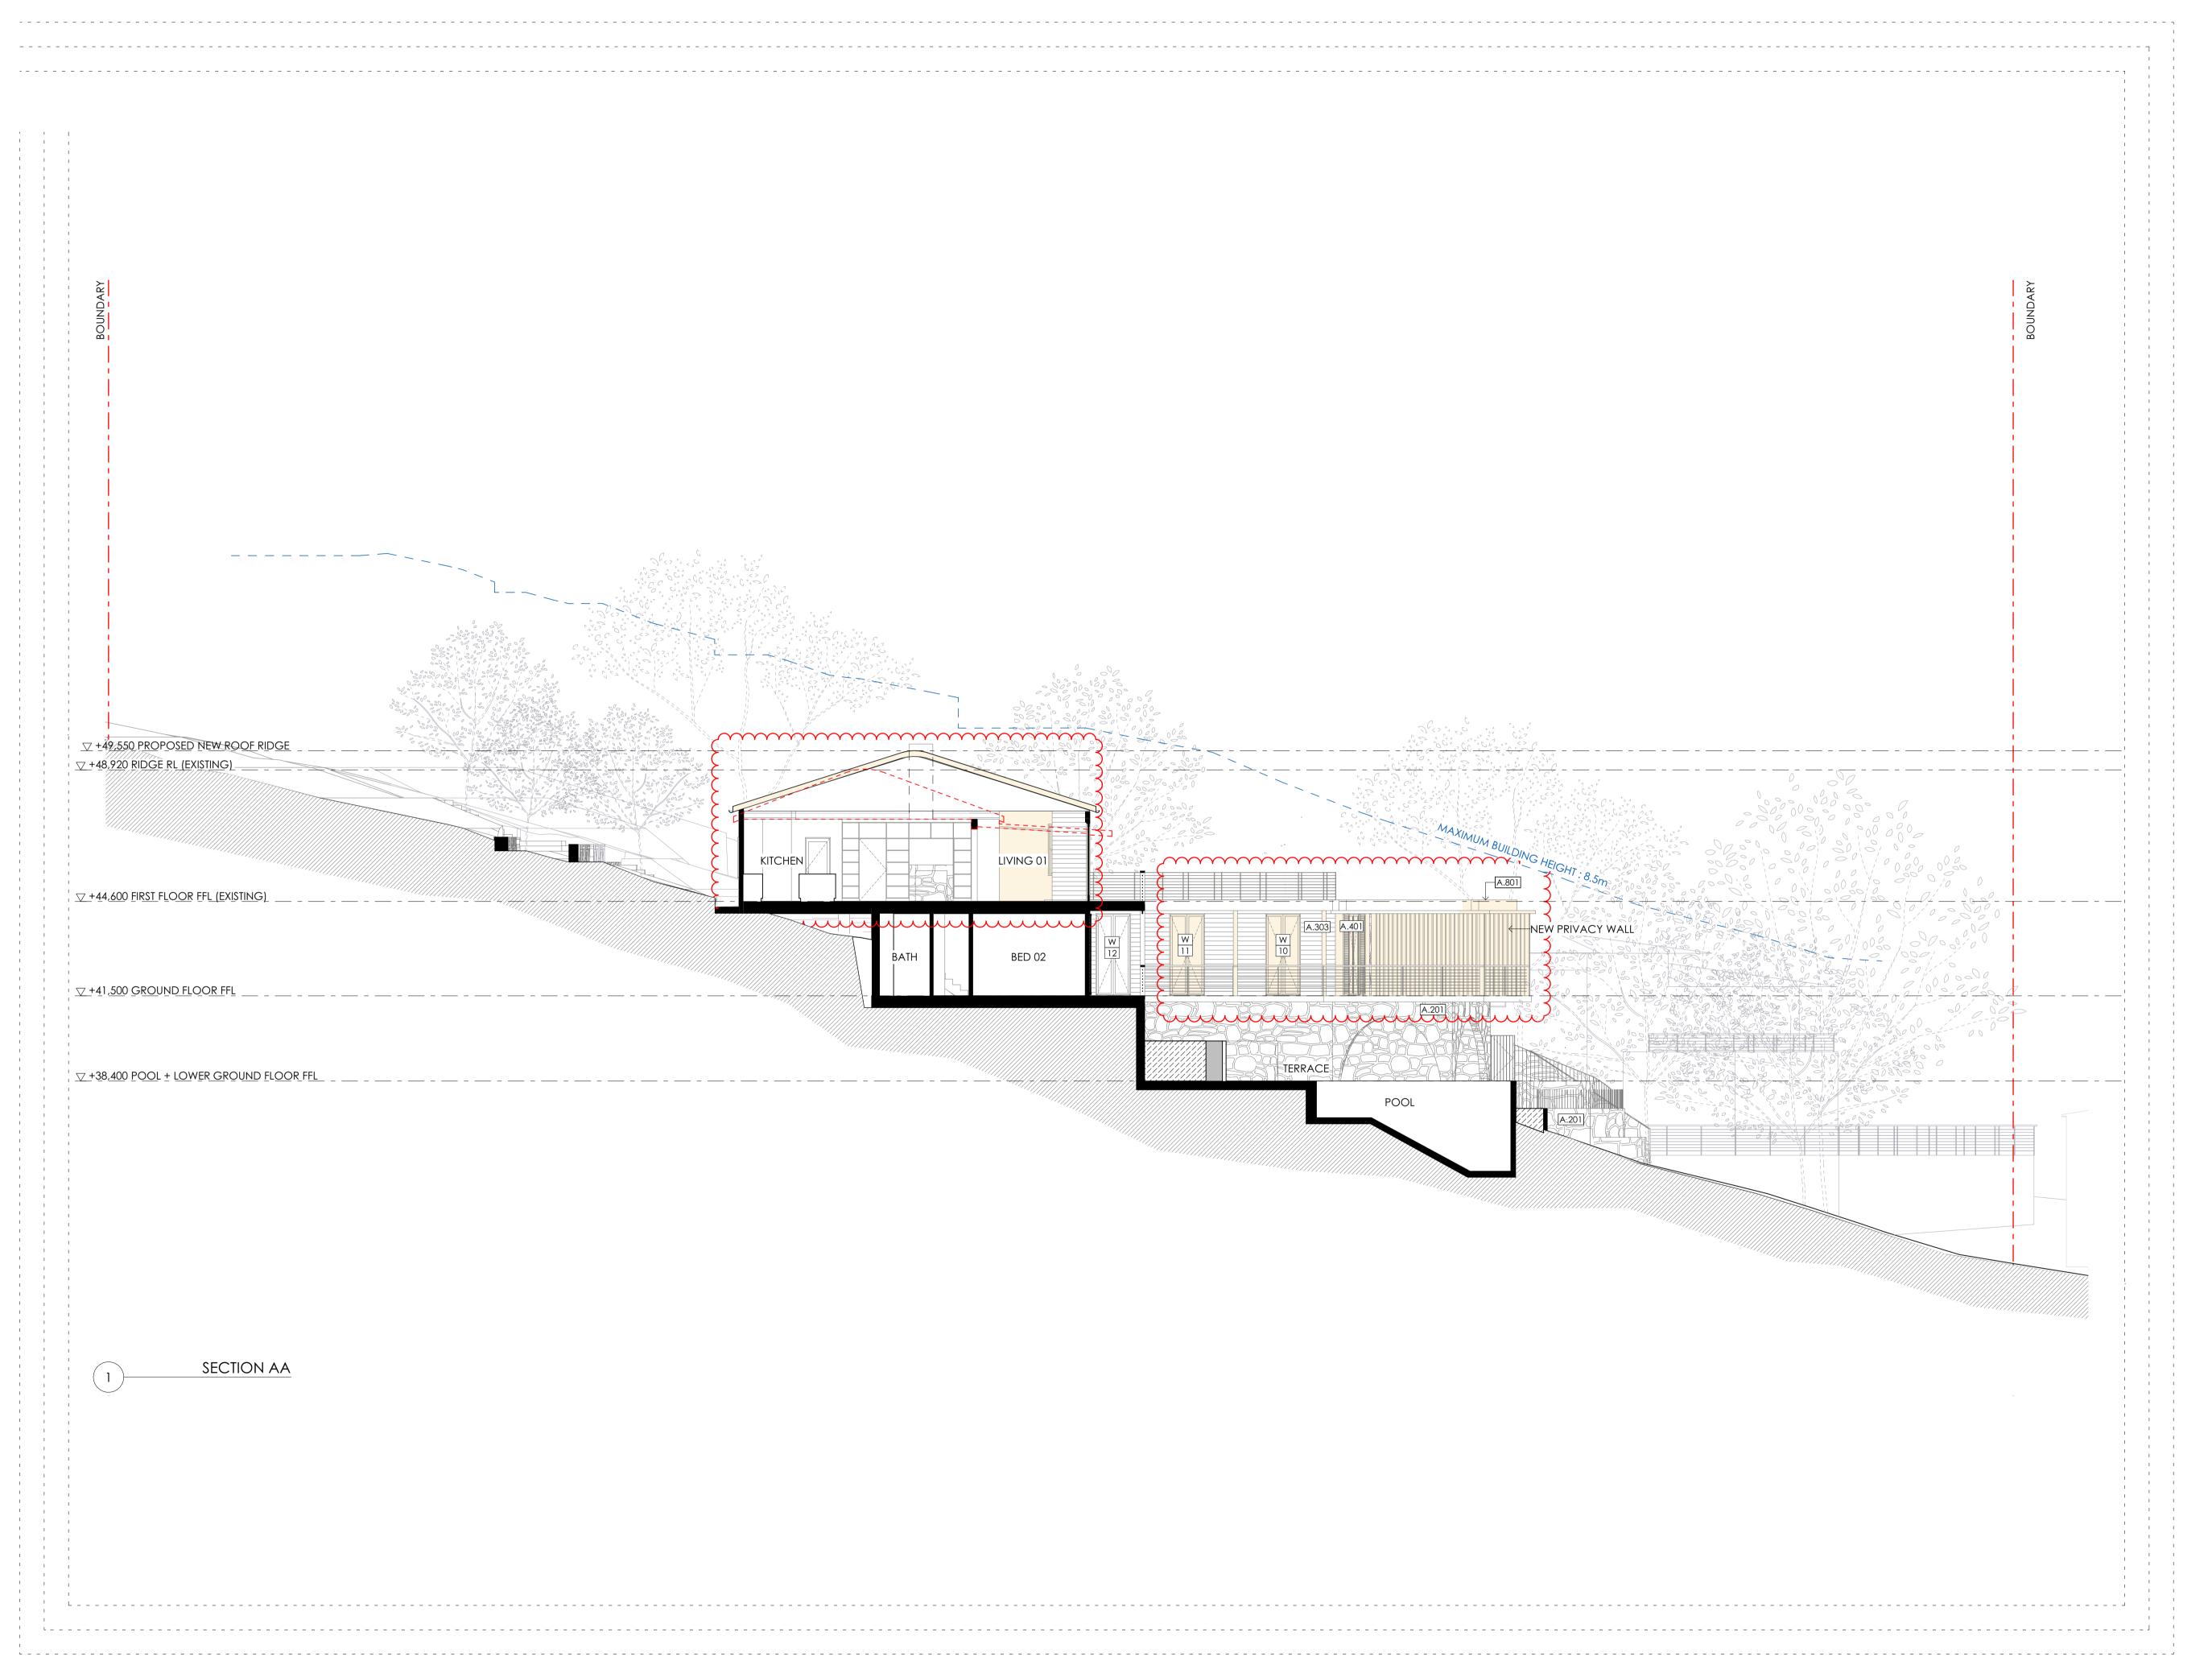

EXISTING TO BE RETAIN
PROPOSED WORKS

### \_...

A.201	STONE WALL
A.202	STONE FLOOR
A.301	TIMBER - NATURAL
A.302	TIMBER - PAINTED*
A.303	TIMBER SHIPLAP - PAINTEI
A.401	GLASS
A.501	METAL ROOFING
A.502	METAL BALUSTRADE
A.503	STAINLESS STEEL

A.801 CONCRETE

\*PAINTED FINISH TO MATCH EXISTING COLOUR

e issue revision

CHECK ALL DIMENSIONS ON SITE PRIOR TO THE COMMENCEMENT OF WORK USE FIGURED DIMENSIONS ONLY DO NOT SCALE COMPLY WITH RELEVANT AUTHORITIES REQUIREMENTS COMPLY WITH BUILDING CODE OF AUSTRALIA

COMPLY WITH ALL RELEVANT AUSTRALIAN STANDARDS COPYRIGHT IN ALL DOCUMENTS AND DRAWINGS PREPARED BY AKIN ATELIER

# AKIN ATELIER

#4 / 1 MARYS PLACE SURRY HILLS NSW, Australia, 2010

T: +61 2 9043 3166 E: INFO@AKINATELIER.COM NOMINATED ARCHITECT: KELVIN HO NSW ARB #11251

### PROJECT Rothwell House

191 WHALE BEACH ROAD WHALE BEACH NSW 2107


# CLIENT

SARAH & DAVID ROTHWELL


# DRAWING

# SECTION AA

PROJECT NO. 0483	DRAWN AR
SCALE 1:100@ A1 1:200@ A3	CHECKED AS
DWG NO. <b>\$4.55-F-01</b>	ISSUE A

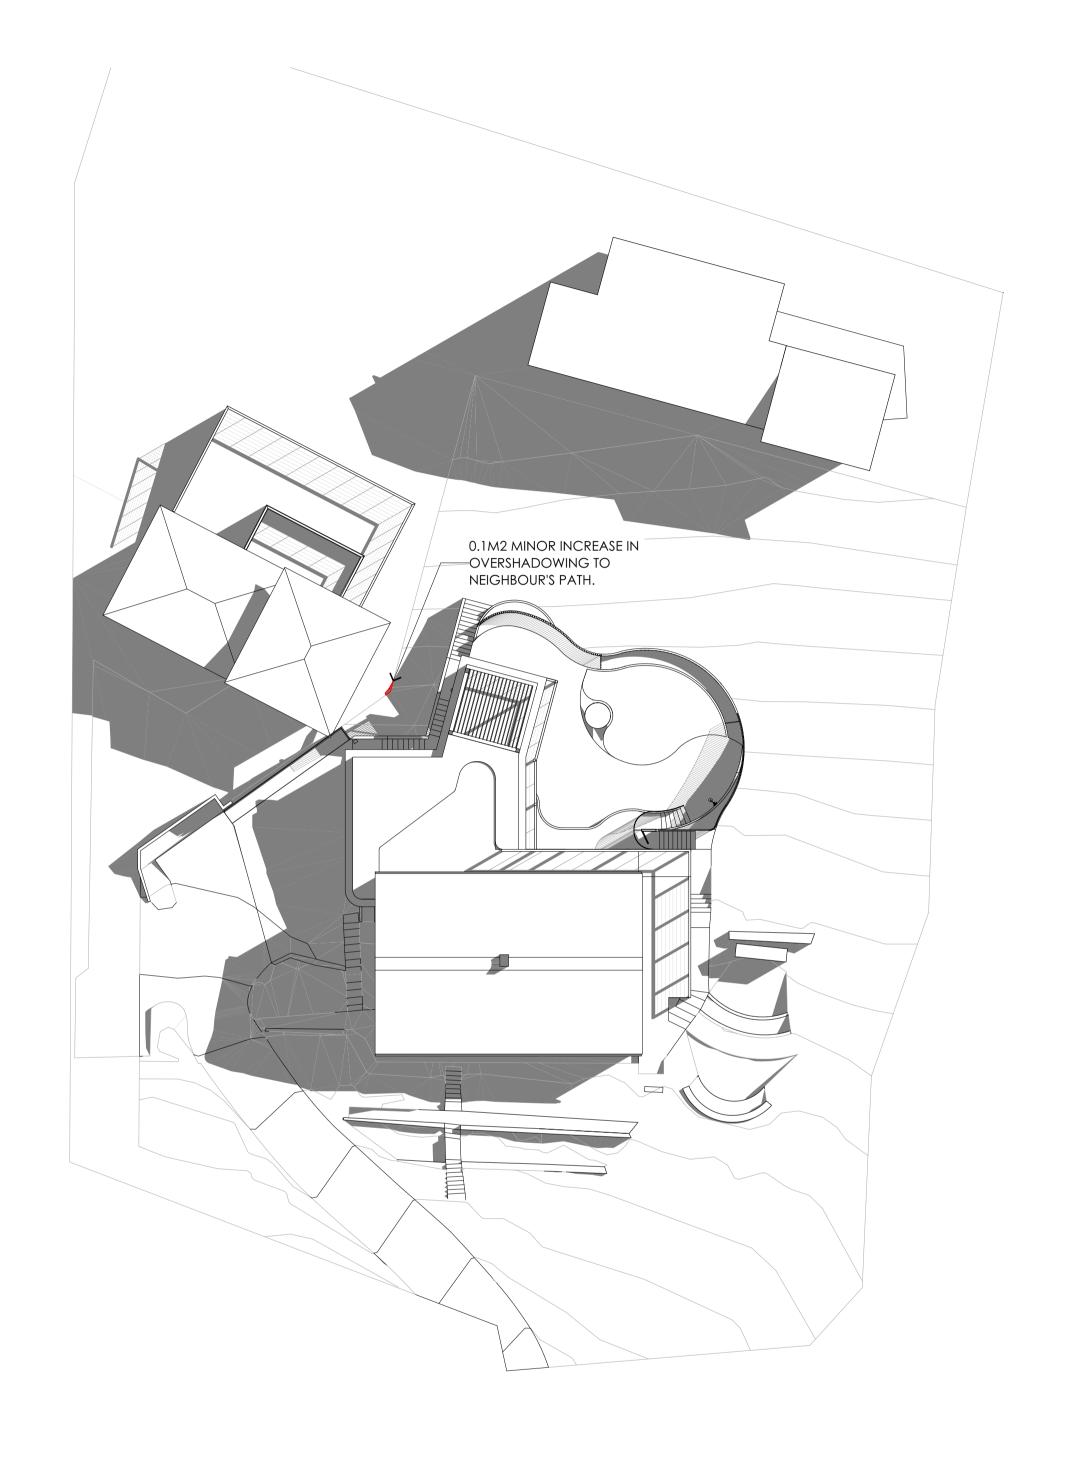



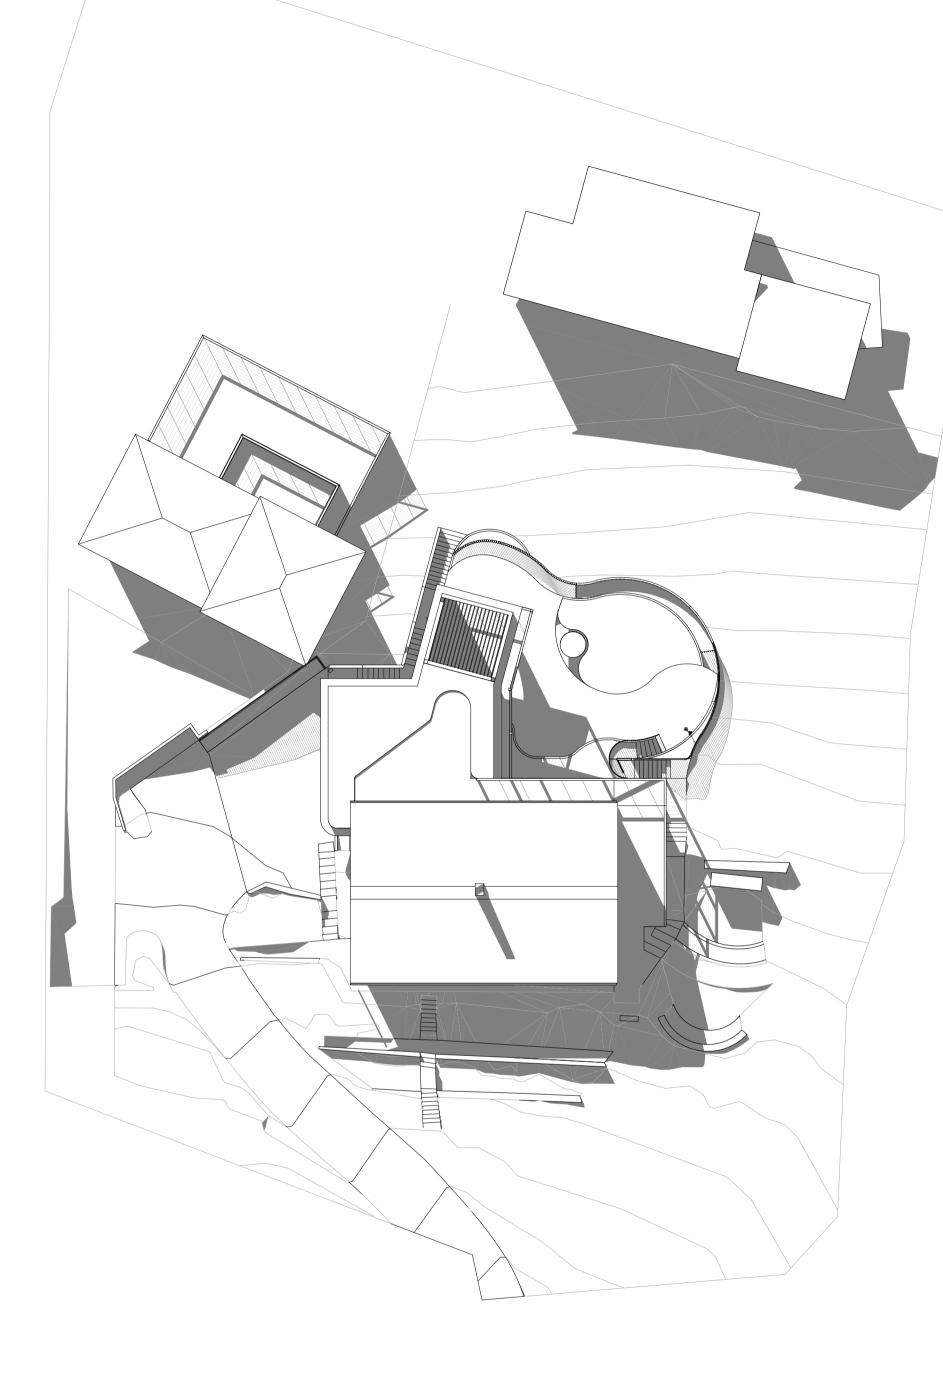

SHADOW DIAGRAM - PROPOSED - JUNE 21ST 9AM

NOTE: PROPOSED WORKS HAVE ONLY MINOR OVER SHADOWING IMPACT ON NEIGHBOUR NO. 193 WHALE BEACH ROAD SHADOW DIAGRAMS - PROPOSED - JUNE 21ST 12PM

NOTE: PROPOSED WORKS HAVE NO OVER SHADOWING IMPACT ON NEIGHBOURING PROPERTIES

SHADOW DIAGRAMS - PROPOSED - JUNE 21ST 3PM

NOTE: PROPOSED WORKS HAVE NO OVER SHADOWING IMPACT ON NEIGHBOURING PROPERTIES


DATE ISSUE REVISION

29/03/2022 A \$4.55

AKIN ATELIER

#4 / 1 MARYS PLACE SURRY HILLS NSW, Australia, 2010

T: + 61 2 9043 3166 E: INFO@AKINATELIER.COM NOMINATED ARCHITECT: AMANDINE SIMONETTI NSW ARB #10238

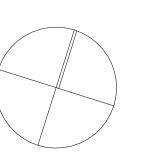

CLIENT PROJECT Rothwell House Sarah & David Rothwell

191 WHALE BEACH ROAD WHALE BEACH NSW 2107

DRAWING

SHADOW DIAGRAMS - PROPOSED

CHECK ALL DIMENSIONS ON SITE PRIOR TO THE COMMENCEMENT OF WORK USE FIGURED DIMENSIONS ONLY DO NOT SCALE COMPLY WITH RELEVANT AUTHORITIES REQUIREMENTS COMPLY WITH BUILDING CODE OF AUSTRALIA COMPLY WITH ALL RELEVANT AUSTRALIAN STANDARDS COPYRIGHT IN ALL DOCUMENTS AND DRAWINGS PREPARED BY AKIN ATELIER

PROJECT NO. 0483	DRAWN KD, AH
SCALE 1:250@ A1 1:500@ A3	CHECKED KD
DWG NO. <b>\$4.55-\$-02</b>	ISSUE A



# 191 WHALE BEACH ROAD, WHALE BEACH

# LANDSCAPE DOCUMENTATION

# SECTION 4.55 SUBMISSION

# DRAWING REGISTER

Dwg No.	Drawing Title	Scale	Size
General			
L-DA-00	Cover Page & Drawing Schedule	N/A	A1
L-DA-01	Landscape Schedules & Notes	N/A	A1
L-DA-02	Landscape Statement & Diagrams	N/A	A1
Plans			
L-DA-03	Site Analysis Plan	1:100	A1
L-DA-04	Tree Removal Plan	1:100	A1
L-DA-05	Landscape Plan	1:100	A1
Sections			
L-DA-06	Landscape Sections & Elevations	1:50	A1
Palettes			
L-DA-07	Planting Palette	N/A	A1

# SITE



# LOCATION PLAN





Rev	Amendment	Date	Ву
Α	Draft DA	19.08.20	СВ
В	Draft DA	08.09.20	СВ
С	DA	14.09.20	СВ
D	Draft S4.55	21.09.21	ВН
Е	S4.55	22.11.21	ВН

# **GENERAL NOTES**

- \* FOR DEVELOPMENT APPLICATION ONLY
- \* All tree dimensions and RLs in metres. All other dimensions in mm unless stated otherwise.
- \* Do not scale from drawings. Use figured dimensions only. Larger scale drawings and written dimensions take preference.
- \* All work shall be carried out in accordance with current versions of Australian Standards, BCA and Local Government Regulations.
- \* Structural Details are indicative only and are subject to Structural Engineer's Details and Specifications.
- \* Drainage details are subject to Hydraulic / Civil Engineer's Detail and Specification.
- \* Subbase details including compaction are to Civil and Structural Engineer's Specification.
- \* Lighting Plans are subject to detailed design by a qualified Lighting Consultant or Electrical Contractor.
- \* Water Feature Details are indicative only and are subject to detailed design by a specialist Water Feature designer.
- \* Service location on plans are indicative only. 360 Degrees Landscape Architects Pty Ltd accepts no responsibility for the accuracy of service locations shown or for services not shown. It is the responsibility of the contractor to determine service locations prior to the commencement of work, including contacting Dial Before You Dig and performing on site service locations. Locate and protect all services on site and in adjacent public domain. Any damages to services and associated damages remains the responsibility of the contractor and shall be rectified at no cost to the client or any other party.
- \*All adjoining property elements including but not limited to buildings, walls, trees and paving to be protected. Damaged elements remain the responsibility of the contractor and shall be rectified at no cost to the client or any other party.
- \* Existing trees to be retained are to be protected to Council and Project Arborist's requirements. No vehicular traffic, stockpiling or storage of materials within Tree Protection Zones (TPZs).
- \* No responsibility will be taken by 360 Degrees Landscape Architects Pty Ltd for any variations in design, construction method, materials specified and general specifications without permission from the Project Landscape Architect.
- \* This Drawing is copyright to 360 Degrees Landscape Architects Pty Ltd.

# **IRRIGATION NOTES**

PRELIMINARY

NOT FOR CONSTRUCTION

- \* Irrigation by specialist D&C Irrigation Consultant in accordance with the Performance Specification in the Landscape Technical Specification. Refer to Irrigation Consultant documentation for details and requirements of landscape irrigation system.
- \* Irrigation is to comply with Council Conditions of Consent and Water Authorities.
- \* All turf and garden beds within the site boundary are to be irrigated unless stated otherwise.
- \* Irrigation must be spaced at min. 200 centres and adjusted according to plant setout to provide adequate irrigation to all plants.
- \* Drip irrigation is to be fully concealed by 75mm minimum of mulch.

	Rev	Amendment	Date
	Α	Draft DA	19.08.20
	В	Draft DA	08.09.20
	С	DA	14.09.20
	D	Draft S4.55	21.09.21
	F	S4 55	22 11 21

PLANT SCHEDULE

<b>Botanical Name</b>	Common Name	Mature Height	Size	Quantity	Native
Trees, Screen Planting & Palms		_		-	
Acmena smithii 'Sublime'	Sublime Lilly Pilly	4-5m	400mm	20	N
Backhousia citriodora	Lemon Myrtle	8m	100L	2	N
Banksia integrifolia	Coast Banksia	5-10m	45L	2	$\mathcal{N}$
Buckinghamia celsissima	Ivory Curl	6-8m	45L	1	N
Chamaerops humilis	European Fan Palm	1-4m	100L		
Eucalyptus botryoides	Bangalay	10-20m	75L	1	N
Howea forsteriana	Kentia Palm	5-10m	ex ground	3	
Livistona australis	Cabbage Palm	10-20m	ex ground	7	N
Pandanus tectorius	Screw Pine	5m	200L	1	_
Plumeria rubra	Frangipani	2-8m	ex ground	2	_
Strelitzia nicolai	Giant Bird of Paradise	6m	200L	1	-
Shrubs & Perennials					
Aloe plicatilis	Fan Aloe	2-4m	400mm	7	-
Correa baeuerlenii	Chef's Cap Correa	2.5m	200mm	48	N
Gardenia augusta 'Florida'	Gardenia .	1m	200mm	15	_
Leptospermum laevigatum 'Fore Shore'	Fore Shore Dwarf Tea Tree	0.3-0.5m	200mm	75	N
Ozothamnus diosmifolius	Rice Flower	2m	200mm	25	N
Rosmarinus officinalis	Rosemary	0.6-1.5m	200mm	23	_
Salvia leucantha 'White Velour'	White Velour Mexican Sage	0.6-0.9m	200mm	5	_
Salvia leucantha 'Santa Barbara'	Santa Barbara Salvia	1.2m	200mm	3	_
Telopea 'Wirrimbirra White'	White Waratah	2.5-3m	200mm	17	N
Westringia fruticosa 'Mundi'	Coastal Rosemary	0.5m	200mm	42	N
Grasses & Ferns					
Dianella caerulea	Blue Flax Lily	0.75m	150mm	126	N
Lomandra hystrix	Hystrix Lomandra	0.7-1.5m	150mm	150	N
Lomandra tanika	Tanika Lomandra	0.5m	150mm	32	N
Groundcovers & Climbers					
Actinotus helianthi	Flannel Flower	0.5m	150mm	30	N
Banksia integrifolia 'Roller Coaster'	Roller Coaster Banksia	0.5m	150mm	25	N
Baeckea virgata 'Nana'	Miniature Baeckea	0.5m	150mm	52	N
Casuarina glauca 'Cousin It'	Cousin It Sheoak	0.1-0.2m	150mm	15	N
Chrysocephalum apiculatum	Yellow Buttons	0.2-0.6m	150mm	130	N
Dichondra repens	Kidney Weed	0.1-0.3m	150mm	500	N
Helichrysum italicum	Curry Plant	0.3-0.6m	150mm	32	_
Lampranthus 'Pink Explosion'	Pink Explosion	0.4m	150mm	45	_
Rosmarinus 'Blue Lagoon'	Rosemary Blue Lagoon	0.5-1m	150mm	30	_
Rosmarinus 'Irene'	Rosemary Irene	0.4m	150mm	20	_
Senecio serpens	Blue Chalksticks	0.1-0.3m	150mm	30	_
Viola hederacea	Native Violet	0.1-0.2m	150mm	50	N


Landscape Schedules & Notes

191 Whale Beach Road, Whale Beach

PROJECT






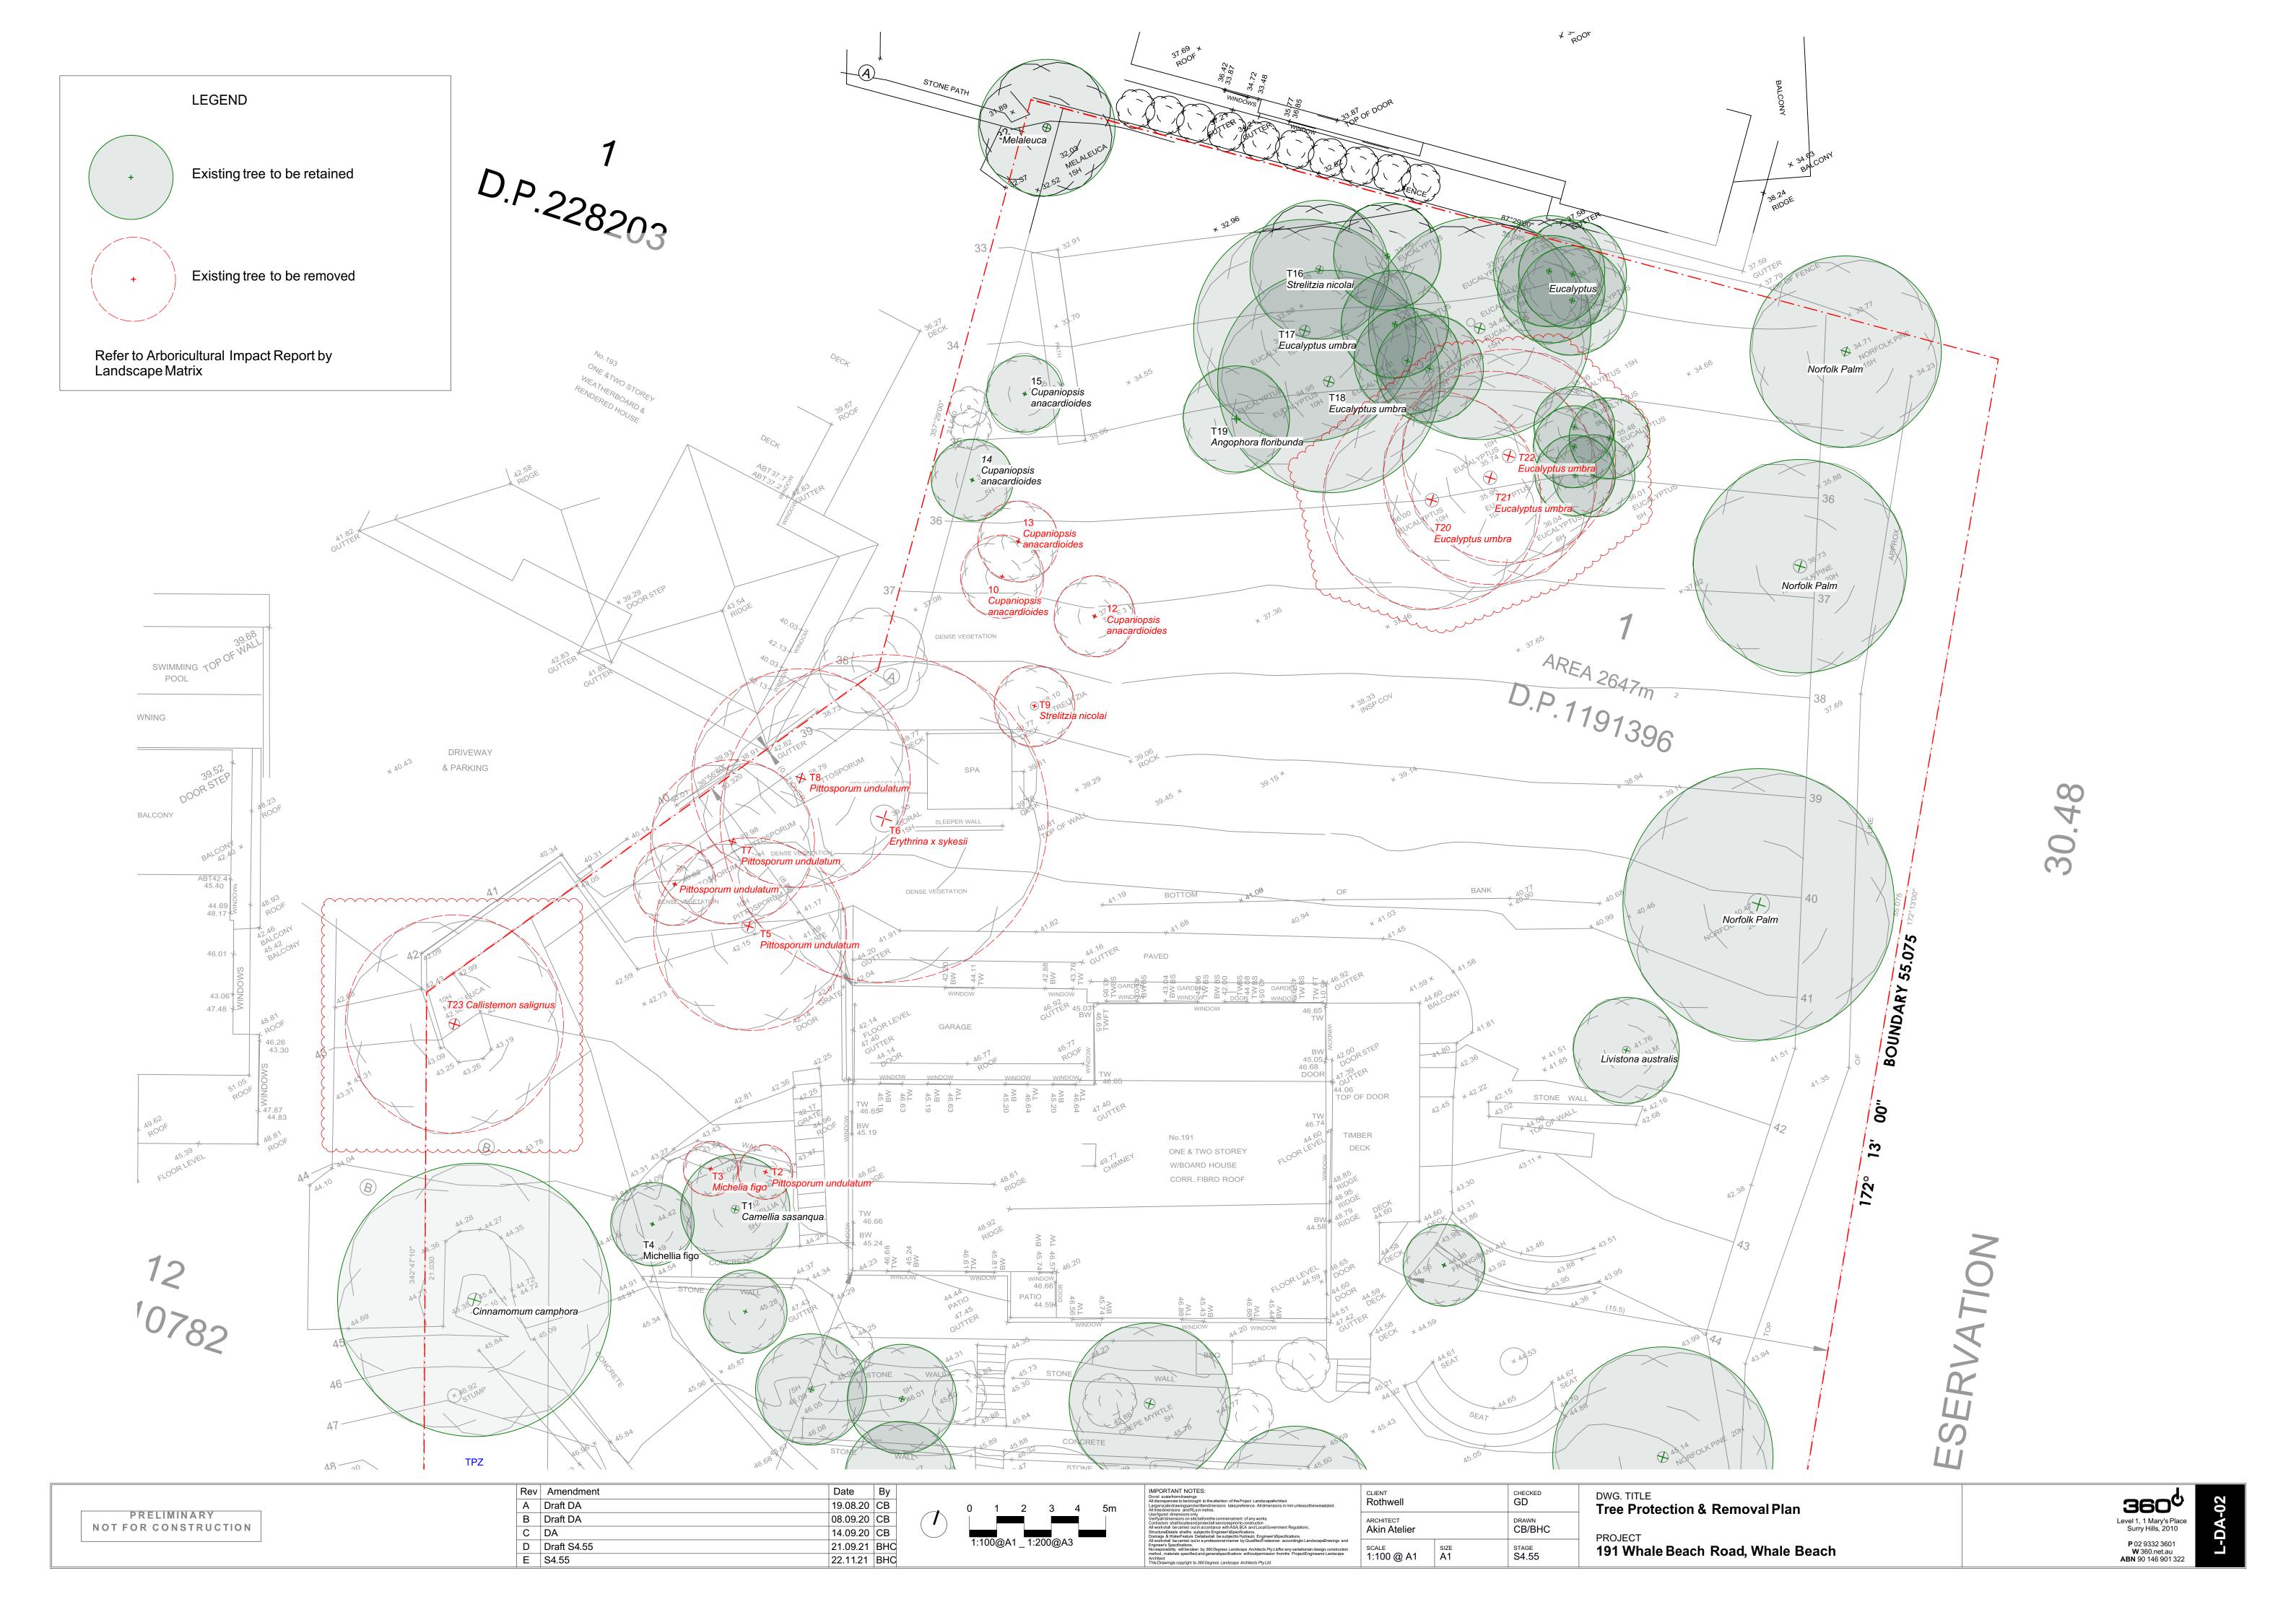



	Rev	Amendment
	Α	Draft DA
	В	Draft DA
NOT FOR CONSTRUCTION	С	DA
	D	Draft S4.55
	Е	S4.55

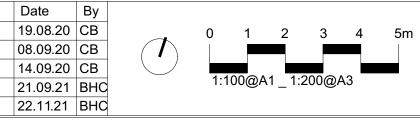

IMPORTANT NOTES: Donot scale-from drawings All discrepancies to be brought to the attention of the Project LandscapeArchitect Largerscaledrawingsand-writtendimensions take preference. All dimensions in mm unless otherwisestated. All free dimensions and ARLs in meters.	Roth
Use figured dimensions only Verifyall dimensions on site beforethe commencement of any works Contractors shall locate and protectall servicesprior to construction. All workshall be carried out in accordance with ASPA GA and Local Government Regulations. Structura Details shallbe subject to Engineer's Specifications. Drainage & Water Feature Detailstable be subjected by Hydraulic Engineer's Specifications.	ARCHIT <b>Akin</b>
All workshall be carried out in a professional manner by Qualified fradesman accordingto LandscapeDrawings and Engineer's Specifications.  Noresponsibility will be taken by 360 Degrees Landscape Architects PtyLtdfor any variations in design construction method, materials specified and generalspecifications withoutpermission from the ProjectEngineeror Landscape Architect  This Drawing is copyright to 360 Degrees Landscape Architects PtyLtd.	SCALE 1:10

	CLIENT Rothwell	CHECKED GD	
	ARCHITECT Akin Atelier	DRAWN CB/BHC	
and tion e	scale 1:100 @ A1	SIZE A1	STAGE S4.55

DWG. TITLE

Landscape Plan - First Floor Plan PROJECT
191 Whale Beach Road, Whale Beach



Rev	Amendment	Date
Α	Draft DA	19.08.20
В	Draft DA	08.09.20
С	DA	14.09.20
D	Draft S4.55	21.09.21
E	S4.55	22.11.21



CHECKED Cacle from drawings pandwrittendinensions take preference. All dimensions and relative inspanding to the attention of the Project LandscapeArchitect ganders to be brought to the attention of the Project LandscapeArchitect GDD described by the called trawings and writtendinensions and steep before the commencement of any works ones shall located and protectal services prior to construction.

Indimensions on site before the commencement of any works ones shall located and protectal services prior to construction.

Shall be carried out in a professional manner by Qualified Tradesman according to Landscape Drawings and respectifications.

Say Starter actual to the professional manner by Qualified Tradesman according to Landscape Drawings and respectifications.

Scale Starter actual to the professional manner by Qualified Tradesman according to Landscape Drawings and respectifications.

Scale Starter S

DWG. TITLE


Landscape Plan - Ground Floor Plan

PROJECT

191 Whale Beach Road, Whale Beach



	Rev	Amendment	Date	Ву
	Α	Draft DA	19.08.20	СВ
PRELIMINARY	В	Draft DA	08.09.20	СВ
NOT FOR CONSTRUCTION	С	DA	14.09.20	СВ
	D	Draft S4.55	21.09.21	внс
	E	S4.55	22.11.21	BHC

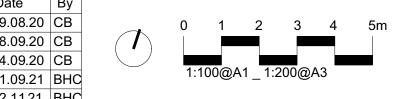

IMPORTANT NOTES:  Donot scale from drawings  All discrepancies to be brought to the attention of the Project LandscapeArchitect  Largerscale drawingsand writtendimensions take preference. All dimensions in mm unless otherwisestated. All treedimensions and RLs in metres.	CLIENT Rothwell	
Use figured dimensions only Verifyall dimensions on site beforethe commencement of any works Contractors shall locate and protectall servicesprior to construction. All workshall be carried out in accordance with ASA ECA and LocalGovernment Regulations. StructuraDetails shallies subject to Engineer'sSpecifications. Drainage & WaterFeature Detailshall be subjectfor hydradiic Engineer'sSpecifications.	ARCHITECT Akin Atelier	
All workshall be carried out in a professional manner by Qualified Tradesman according to Landscape Drawings and Engineer's Specifications. Noresponsibility will be taken by 360 Degrees Landscape Architects PtyLtdfor any variations in design, construction method, materials specified and general specifications without permission from the Project Engineeror Landscape Architect  This Drawing is copyright to 360 Degrees Landscape Architects PtyLtd.	scale 1:100 @ A1	SIZE A1

CHECKED GD

DRAWN CB/BHC


STAGE S4.55

DWG. TITLE  Landscape Plan - Pool and Lower Ground Level
PROJECT 191 Whale Beach Road, Whale Beach



INDICATIVE SECTIONAL ELEVATION 1




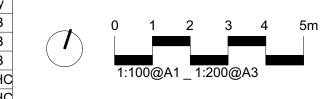

IMPORTANT NOTES: Donot scale fromdrawings All discrepancies to be brought to the attention of the Project Landscape/vchitect Largerscale drawingsand/writtendimensions take preference. All dimensions in mm unless otherwisestated. All treedimensions and RLs in metres.	Roth
Use figured dimensions only Verifyall dimensions on site beforethe commencement of any works, Contractors shall locateand protectall servicesprior to construction. All workshall be carried out in accordance with ASA BCA and Local Government Regulations. StructuraDetails shallbe subjectto Engineer'sSpecifications. Drainage & WaterFeature Detailsshall be subjectto Hydraulic Engineer'sSpecifications.	ARCHIT <b>Akin</b>
All workshall be carried out in a professional miamer by Qualified fradesman accordingto LandscapeDrawings and Engineer's Specifications. Noresponsibility will be taken by 360 Degrees Landscape Architects PtyLtifor any variations in design construction method, materials specified and generalspecifications withoutpermission fromthe ProjectEngineeror Landscape Architect This Drawingis copyright to 360 Degrees Landscape Architects PtyLtd.	SCALE 1:10

	CLIENT Rothwell	CHECKED GD	
	ARCHITECT Akin Atelier	DRAWN CB/BHC	
and ction pe	scale 1:100 @ A1	SIZE A1	STAGE S4.55

DWG. TITLE  Landscape Sectional Elevation
PROJECT 191 Whale Beach Road, Whale Beach

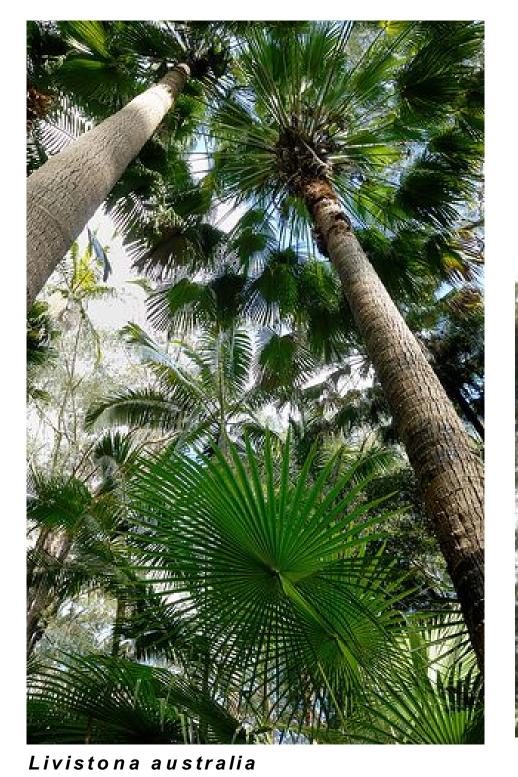







Pandanus tectorius









Backhousia citriodora Chamaerops humilis Strelitzia nicolai

Plumeria rubra

CLIENT CHECKED GD

ARCHITECT Akin Atelier

Scale N/A @ A1

CHECKED GD

DRAWN
CB/BHC

STAGE
S4.55

DWG. TITLE
Planting Palette
PROJECT
191 Whale Beach Road, Whale Beach

Acmena 'Sublime











Westringia fruticosa 'Mundi'

Baeckea virgata nana


Salvia leucantha 'Santa barbara'

Salvia leuchantha 'White Velour'

Rosmarinus officinalis





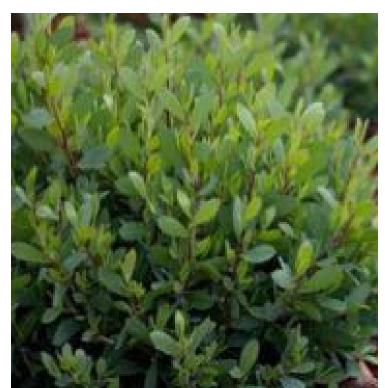









Ozothamnus diosmifolius

Telopea 'Wirrimbia White'


Leptospermum laevigatum 'Fore Shore'


Aloe plicatilis

Rosmarinus officinalis 'Irene' Rosmarinus officinalis 'Blue Lagoon'

*Banksia integrifolia* 'Roller Coaster'

Casuarina 'Cousin It'

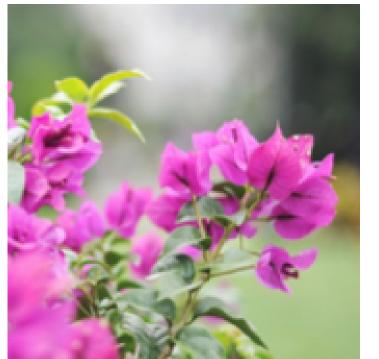

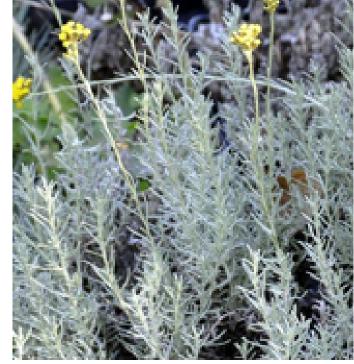













Bougainvillea

Helichrysum italicum

Dianella caerulea 'Little Jess' Senecio serpens


Lampranthus 'Pink Explosion'


Chrysocephalum apiculatum Dichondra repens

Viola hederacea

	Rev	Amendment	Date	Ву
	Α	Draft DA	19.08.20	СВ
	В	Draft DA	08.09.20	СВ
	С	DA	14.09.20	СВ
	D	Draft S4.55	21.09.21	ВН
	Е	S4.55	22.11.21	ВН

	CLIENT Rothwell	CHECKED GD	
	ARCHITECT Akin Atelier	DRAWN CB/BHC	
nd on	SCALE N/A @ A1	SIZE A1	STAGE S4.55

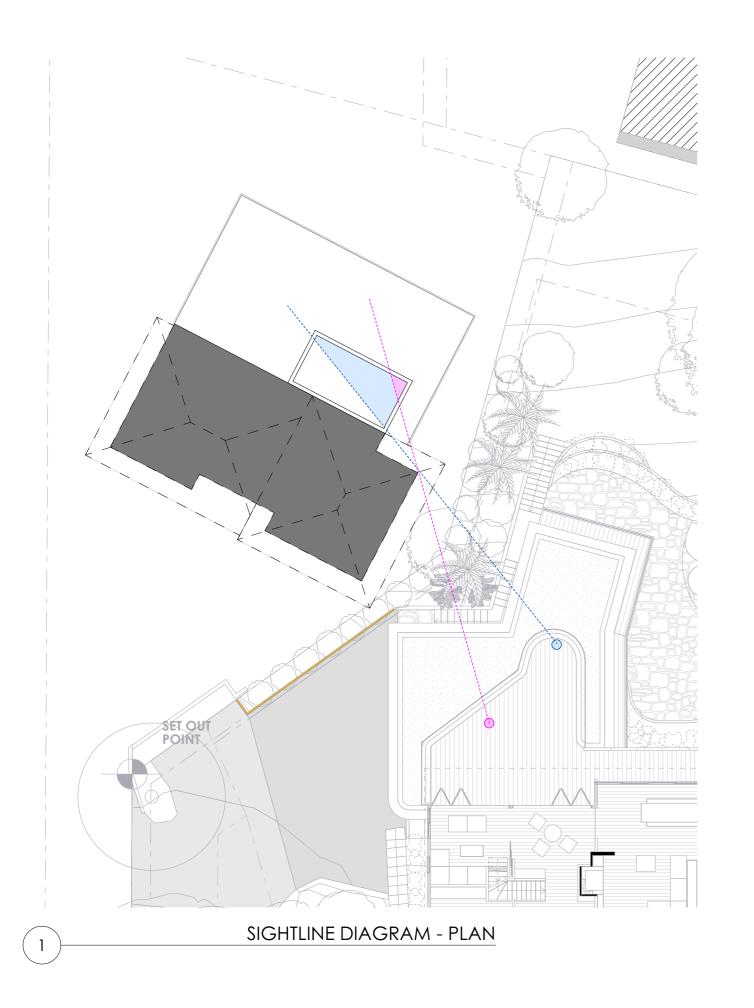

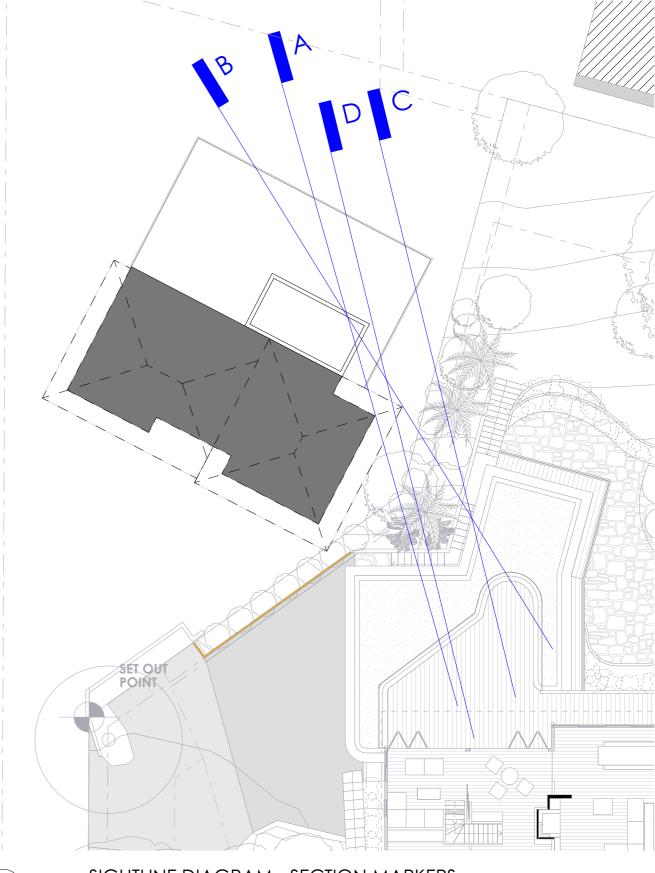


SIGHTLINE DIAGRAM - SECTION MARKERS

AKIN ATELIER
0483\_ROTHWELL HOUSE

SK\_ 210713 1:200@A3


SIGHT LINE DIAGRAMS
PLANS

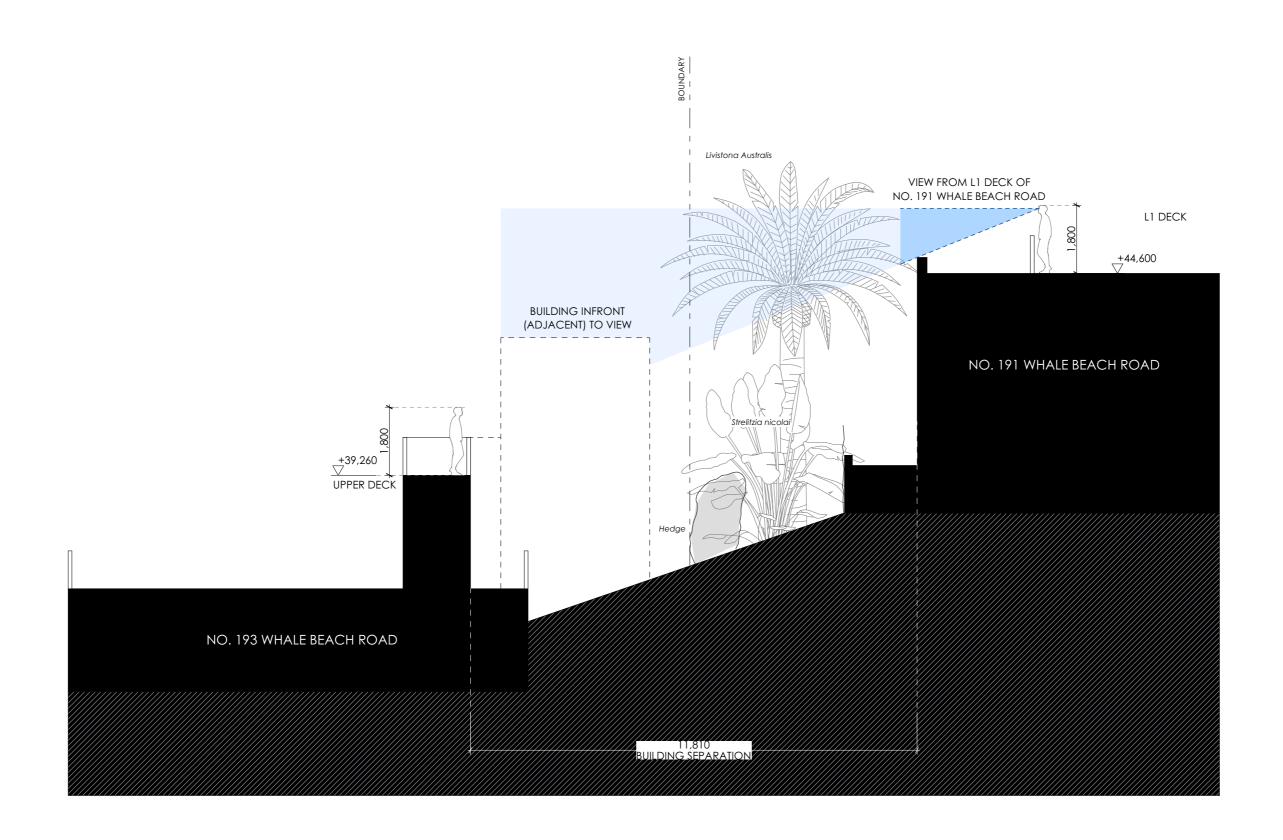

AKIN ATELIER
0483\_ROTHWELL HOUSE

SK\_ 210713 1:100@A3


SIGHT LINE DIAGRAMS SECTION B

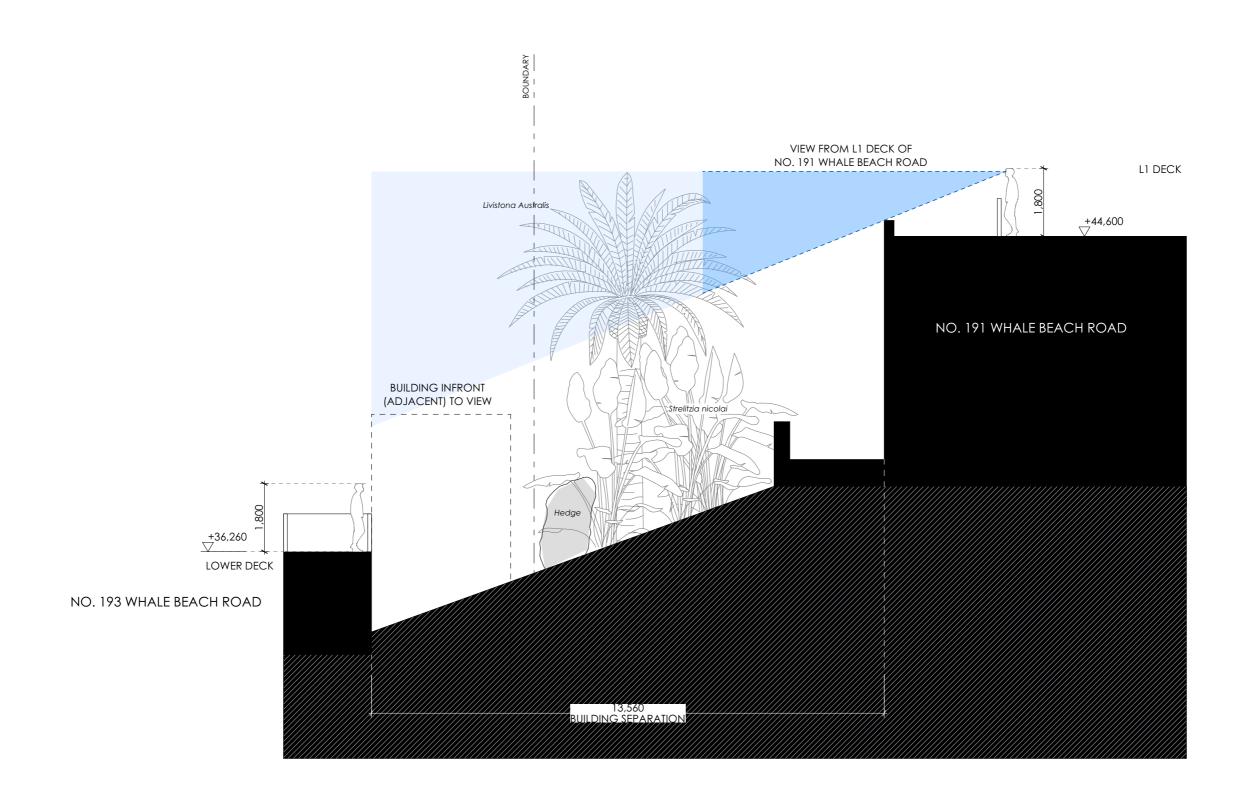

AKIN ATELIER
0483\_ROTHWELL HOUSE

SK\_ 210713 1:100@A3

SIGHT LINE DIAGRAMS SECTION C

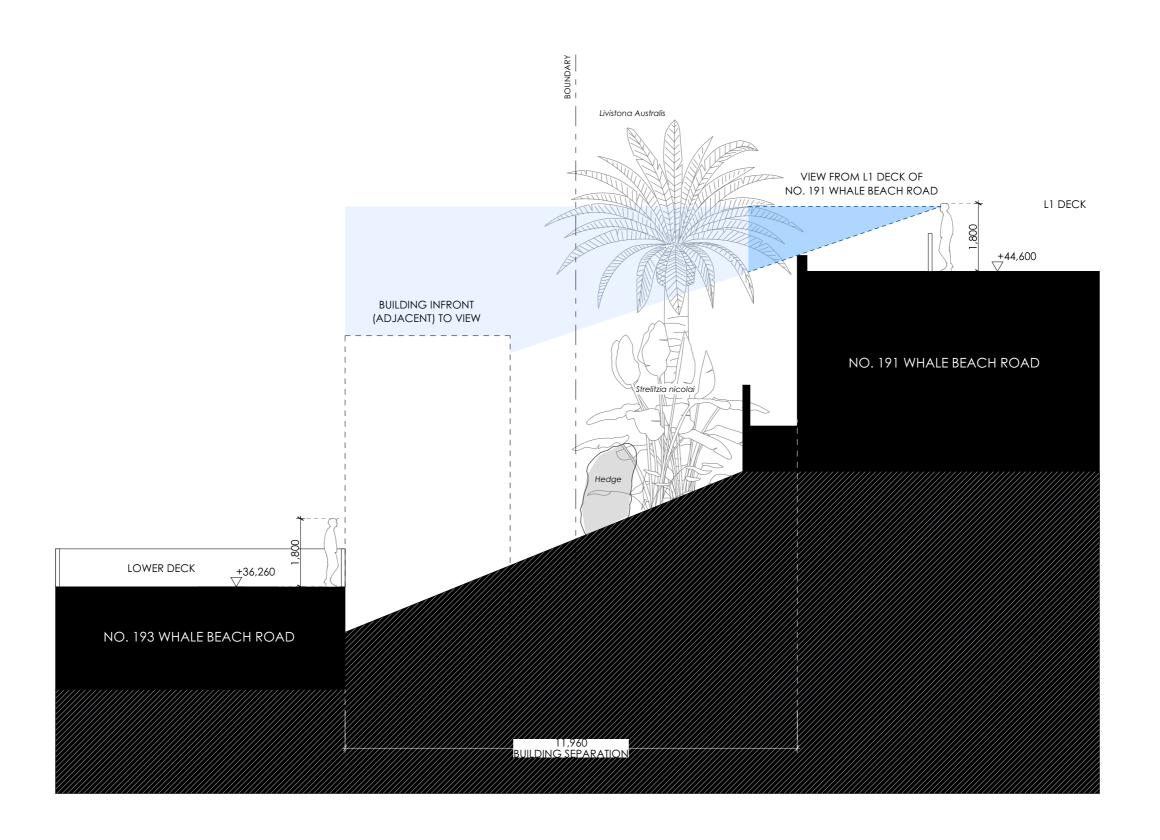

**AKIN ATELIER**0483\_ROTHWELL HOUSE

SK\_ 210713 1:100@A3

SIGHT LINE DIAGRAMS SECTION D