


development application / construction certificate

manly ocean beach house

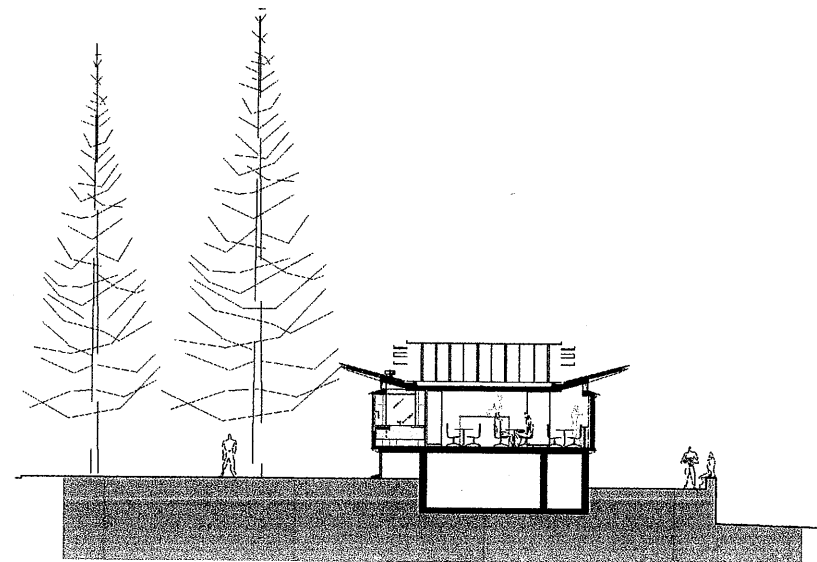

issue	date	comments
c	10.11.2008	D.A. & C.C.
b	30.10.2008	D.A. & C.C.
a	oct 2008	design concept

alterations - new toilets
manly ocean beach house

LESIUK ARCHITECTS PTY LTD
the studio, 1118 barrenjoey road palm beach nsw
po box 30 palm beach nsw 2108
telephone 612 9974 1010 faxsimile 612 9974 5502
email lesiukarchitects@bigpond.com

client manly ocean beach house
site manly ocean beach house
 manly nsw

project consultants

architect lesiuk architects pty lts
 the studio, 1118 barrenjoey road palm beach nsw
 p.o. box 30 palm beach nsw 2108
 telephone 612 9974 1010 facsimile 612 9974 5502
 email lesiukarchitects@bigpond.com

architectural drawing schedule

issue	date	dwg no.	drawing	scale
c	10.11.2008	10.08.B01	floor plan	1:100@A3
c	10.11.2008	10.08.B02	W.C. floor plan	1:50@A3
c	10.11.2008	10.08.B03	W.C. setout plan	1:50@A3
c	10.11.2008	10.08.B04	section a	1:50@A3
c	10.11.2008	10.08.B05	east elevation	1:100@A3
c	10.11.2008	10.08.B06	west elevation	1:100@A3

summary list of changes

1. white tint to be applied to existing bi-fold windows to new toilet area.
2. remove existing timber floor.
adjust floor framing as required for existing timber floor to be flush with new floor tiles on screed over CFC sheeting.
to fall to waste to connect to sewer to all relevant codes & requirements (waterproofing to A.S. typical)
3. new timber stud framed wall to WC.
dining room side to be paint finish to set plasterboard/ skirting to match existing.
new solid core door with sealed frame.
4. new nib walls to either side of vanity joinery.
5. new fc sheeting with wall tiles to internal walls to WC.
(waterproofing to A.S. typical)
6. new toilet cubicle divider with doors.
7. new toilets (2) installed.
to connect to sewer to all relevant codes & requirements
8. new vanity joinery with limestone bench to match to existing.
new mirror to wall above vanity.
new pelmet with lighting above vanity/mirror.
9. new basin & tapware installed to vanity.
10. new mechanical exhaust to ceiling / roof to be consistent with BCA F4.9
11. new select lights above toilet cubicles.
12. new select hand dryer & towel dispenser to wall.
13. new GPO located for hand dryer.

10.11.2008	C	DA / CC
30.10.2008	B	DA / CC
oct 2008	A	design concept

date issue

amendments

Alterations - New Toilets
Manly Ocean Beach House
Manly NSW

LESIUK ARCHITECTS PTY LTD

the studio, 1118 barrenjoey road palm beach nsw
po box 30 palm beach nsw 2108
telephone 612 9974 1010 facsimile 612 9974 5502
email lesiukarchitects@bigpond.com

STATEMENT OF EFFECTS + HERITAGE REPORT

Background

- The existing Manly Ocean Beach House was constructed in 2002 replacing the previous Information Centre constructed in the 1980's.
- The proposed Development Application identifies;
 1. NO change to the existing structure to the building,
 2. No change to the exterior fabric of the building
 3. No increase to the buildings footprint or bulk and scale

Application

- The Development Application identifies two (2) Internal toilets and associated facilities to be provided in the location of an existing sitting nook.
- Existing plumbing connections are available immediately below this existing structure.

Impact on Amenity

Nil.

Heritage Impact


Nil



Location of Proposed Toilets - No change to exterior fabric or structure



Location of Proposed Toilets within building

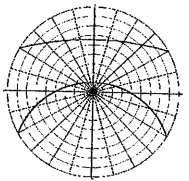

manly ocean beach house
toilet alterations
statement of effect


lesiuk architects pty ltd
the studio, 1118 barrenjoey road palm beach nsw
po box 30 palm beach nsw 2108
telephone 612 9974 1010 faxsimile 612 9974 5502
email lesiukarchitects@bigpond.com
nsw board of architects registration number 6593

copyright © 2008 lesiuk architects pty. ltd.
This document is copyright. Apart from any fair dealing for the purposes of private research, criticism or reviews, as permitted under the Copyright Act, no part of this drawing may be reproduced by any process without written permission.

amendments

A	11th Nov. 2008	development application + const. cert.
Issue	date	comments

notes

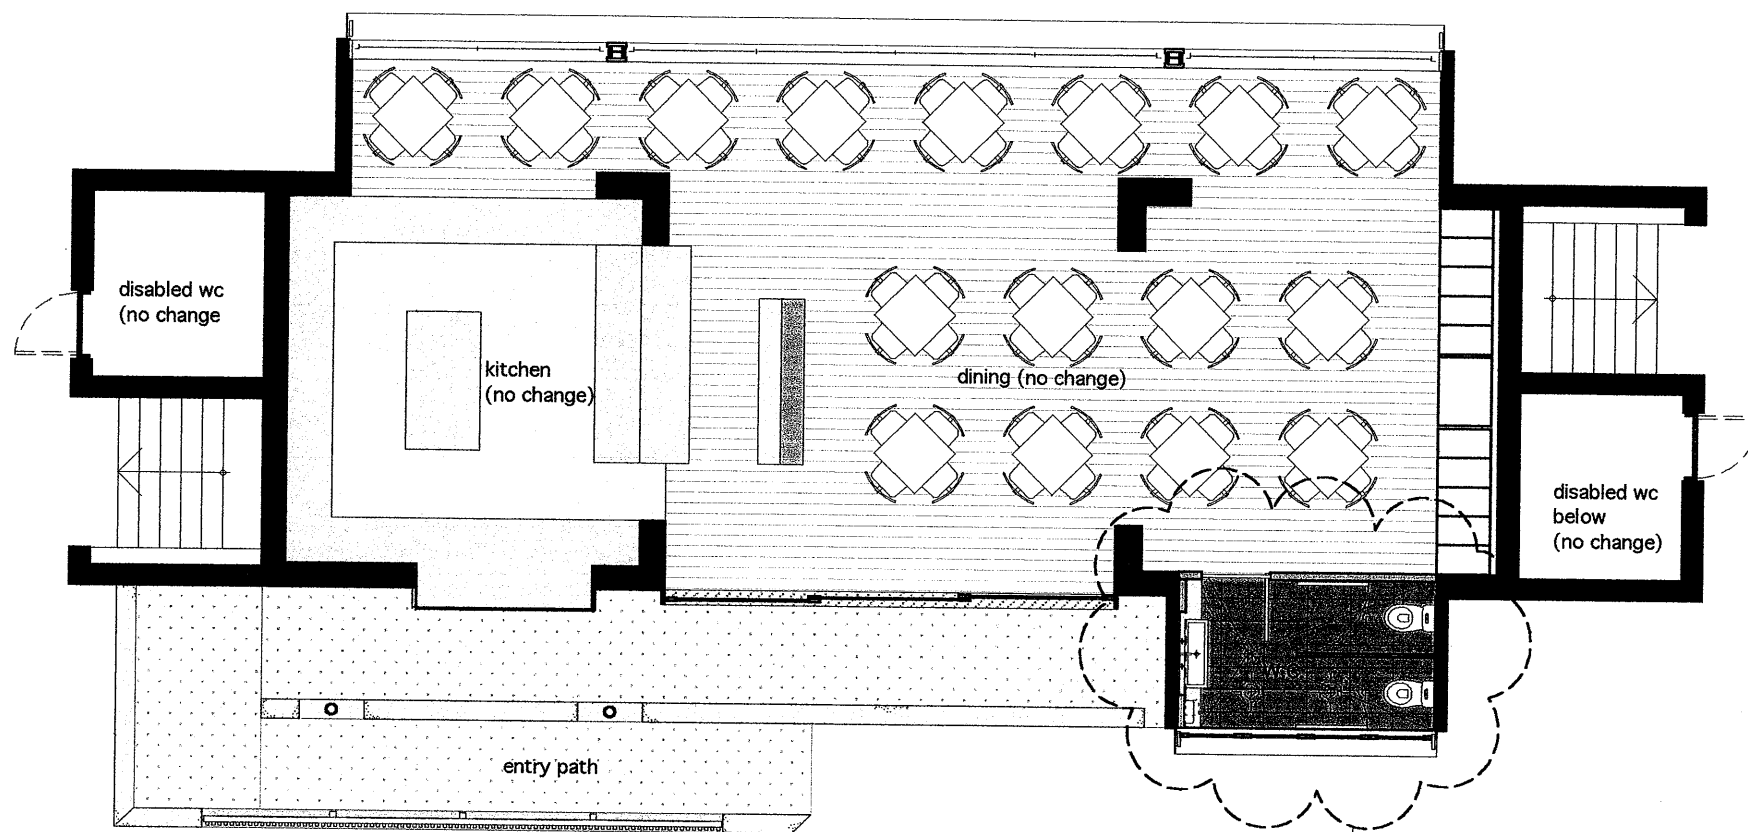

floor plan
1:100 @ A3

new WC to cafe.
refer drg no. 10.08.B02.

note: existing disabled toilets
still to be used consistent
with lease document.

PC Items

1. floor tiles
2. wall tiles
3. toilet suites (2)
4. basin
5. tapware
6. hand dryer
7. towel dispenser
8. toilet roll holders (2)

10.11.2008	C	DA / CC
30.10.2008	B	DA / CC
oct 2008	A	design concept

date issue

amendments

drawing : floor plan
dwg. no. : 10.08.B01
date : oct 2008
drawn :
checked :


Alterations - New Toilets Manly Ocean Beach House Manly NSW

LESIUK ARCHITECTS PTY LTD

the studio, 1118 barrenjoey road palm beach nsw
po box 30 palm beach nsw 2108
telephone 612 9974 1010 faxsimile 612 9974 5502
email lesiukarchitects@bigpond.com

PC Items

1. floor tiles
2. wall tiles
3. toilet suites (2)
4. basin
5. tapware
6. hand dryer
7. towel dispenser
8. toilet roll holders (2)

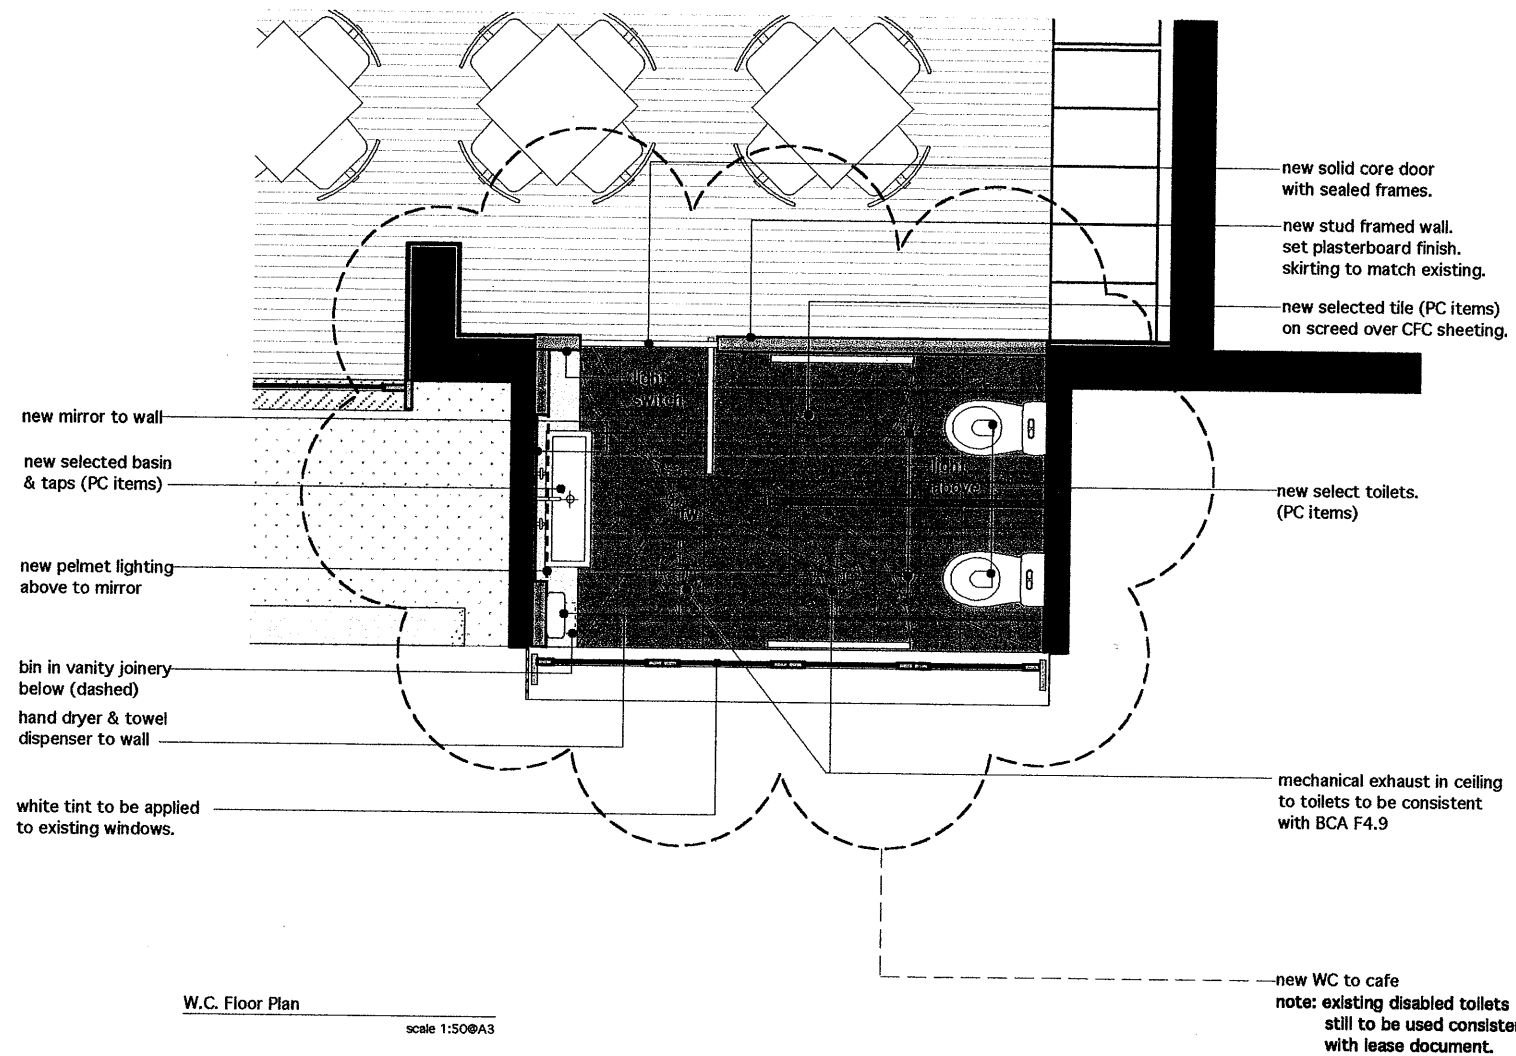

W.C. Floor Plan

scale 1:50@A3

10.11.2008	C	DA / CC
30.10.2008	B	DA / CC
oct 2008	A	design concept

date issue

amendments

drawing : W.C. Plan
dwg. no. : 10.08.B02
date : oct 2008
drawn :
checked :


Alterations - New Toilets
Manly Ocean Beach House
Manly NSW

LESIUK ARCHITECTS PTY LTD

the studio, 1118 barrenjoey road palm beach nsw
po box 30 palm beach nsw 2108
telephone 612 9974 1010 fax 612 9974 5502
email lesiukarchitects@bigpond.com

PC Items

1. floor tiles
2. wall tiles
3. toilet suites (2)
4. basin
5. tapware
6. hand dryer
7. towel dispenser
8. toilet roll holders (2)

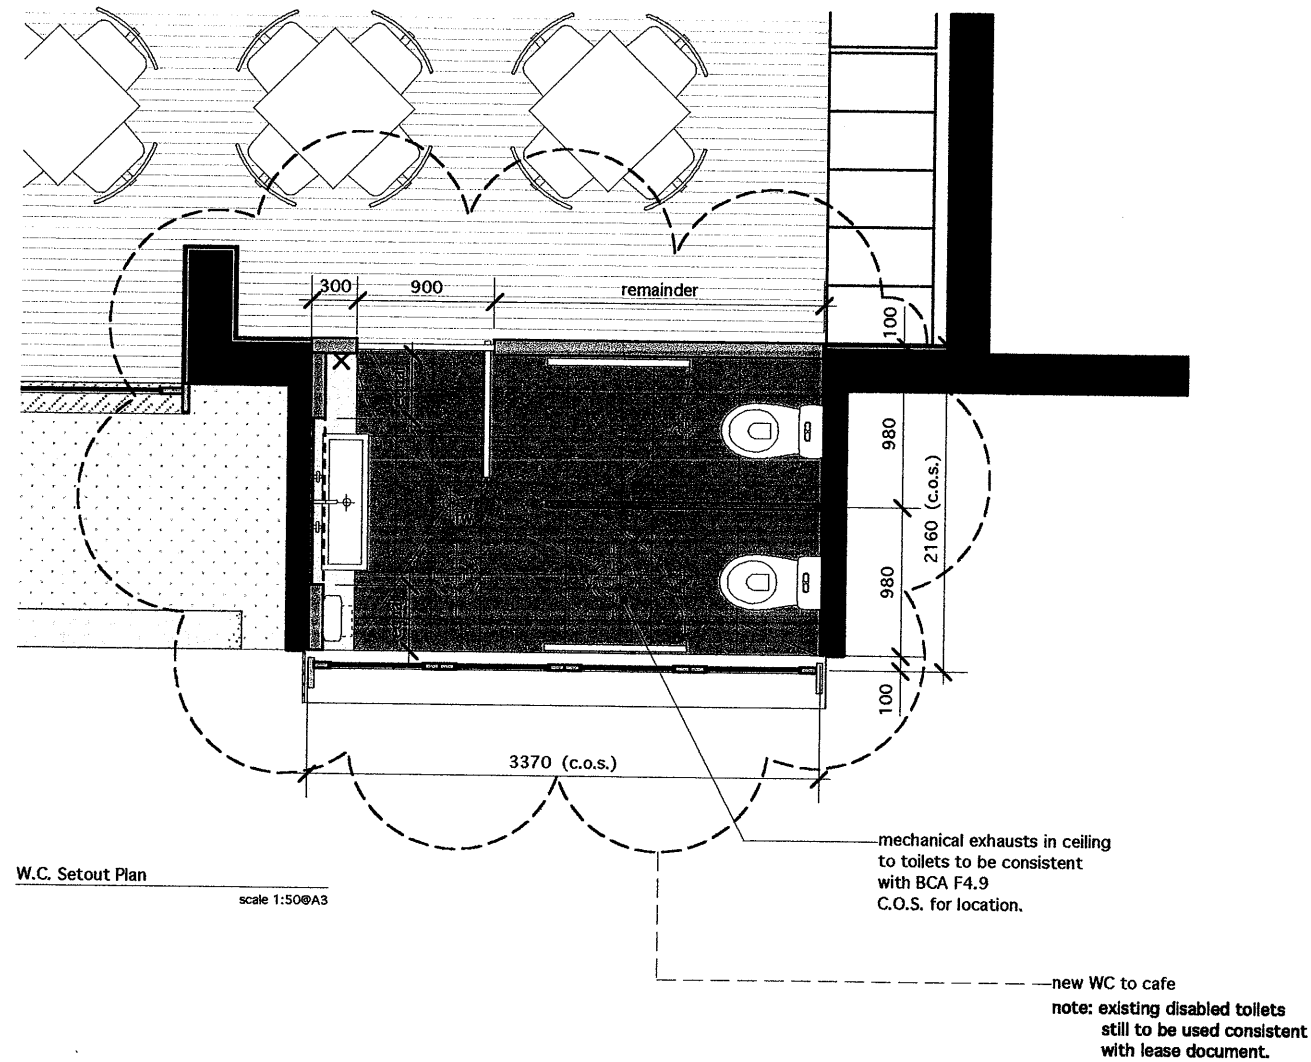

10.11.2008	C	DA / CC
30.10.2008	B	DA / CC
oct 2008	A	design concept

date issue

amendments

drawing : W.C. Setout Plan
dwg. no. : 10.08.B03
date : oct 2008
drawn :
checked :


Alterations - New Toilets
Manly Ocean Beach House
Manly NSW

LESIUK ARCHITECTS PTY LTD

the studio, 1118 barrenjoey road palm beach nsw
po box 30 palm beach nsw 2108
telephone 612 9974 1010 faxsimile 612 9974 6502
email lesiukarchitects@bigpond.com

PC Items

1. floor tiles
2. wall tiles
3. toilet suites (2)
4. basin
5. tapware
6. hand dryer
7. towel dispenser
8. toilet roll holders (2)

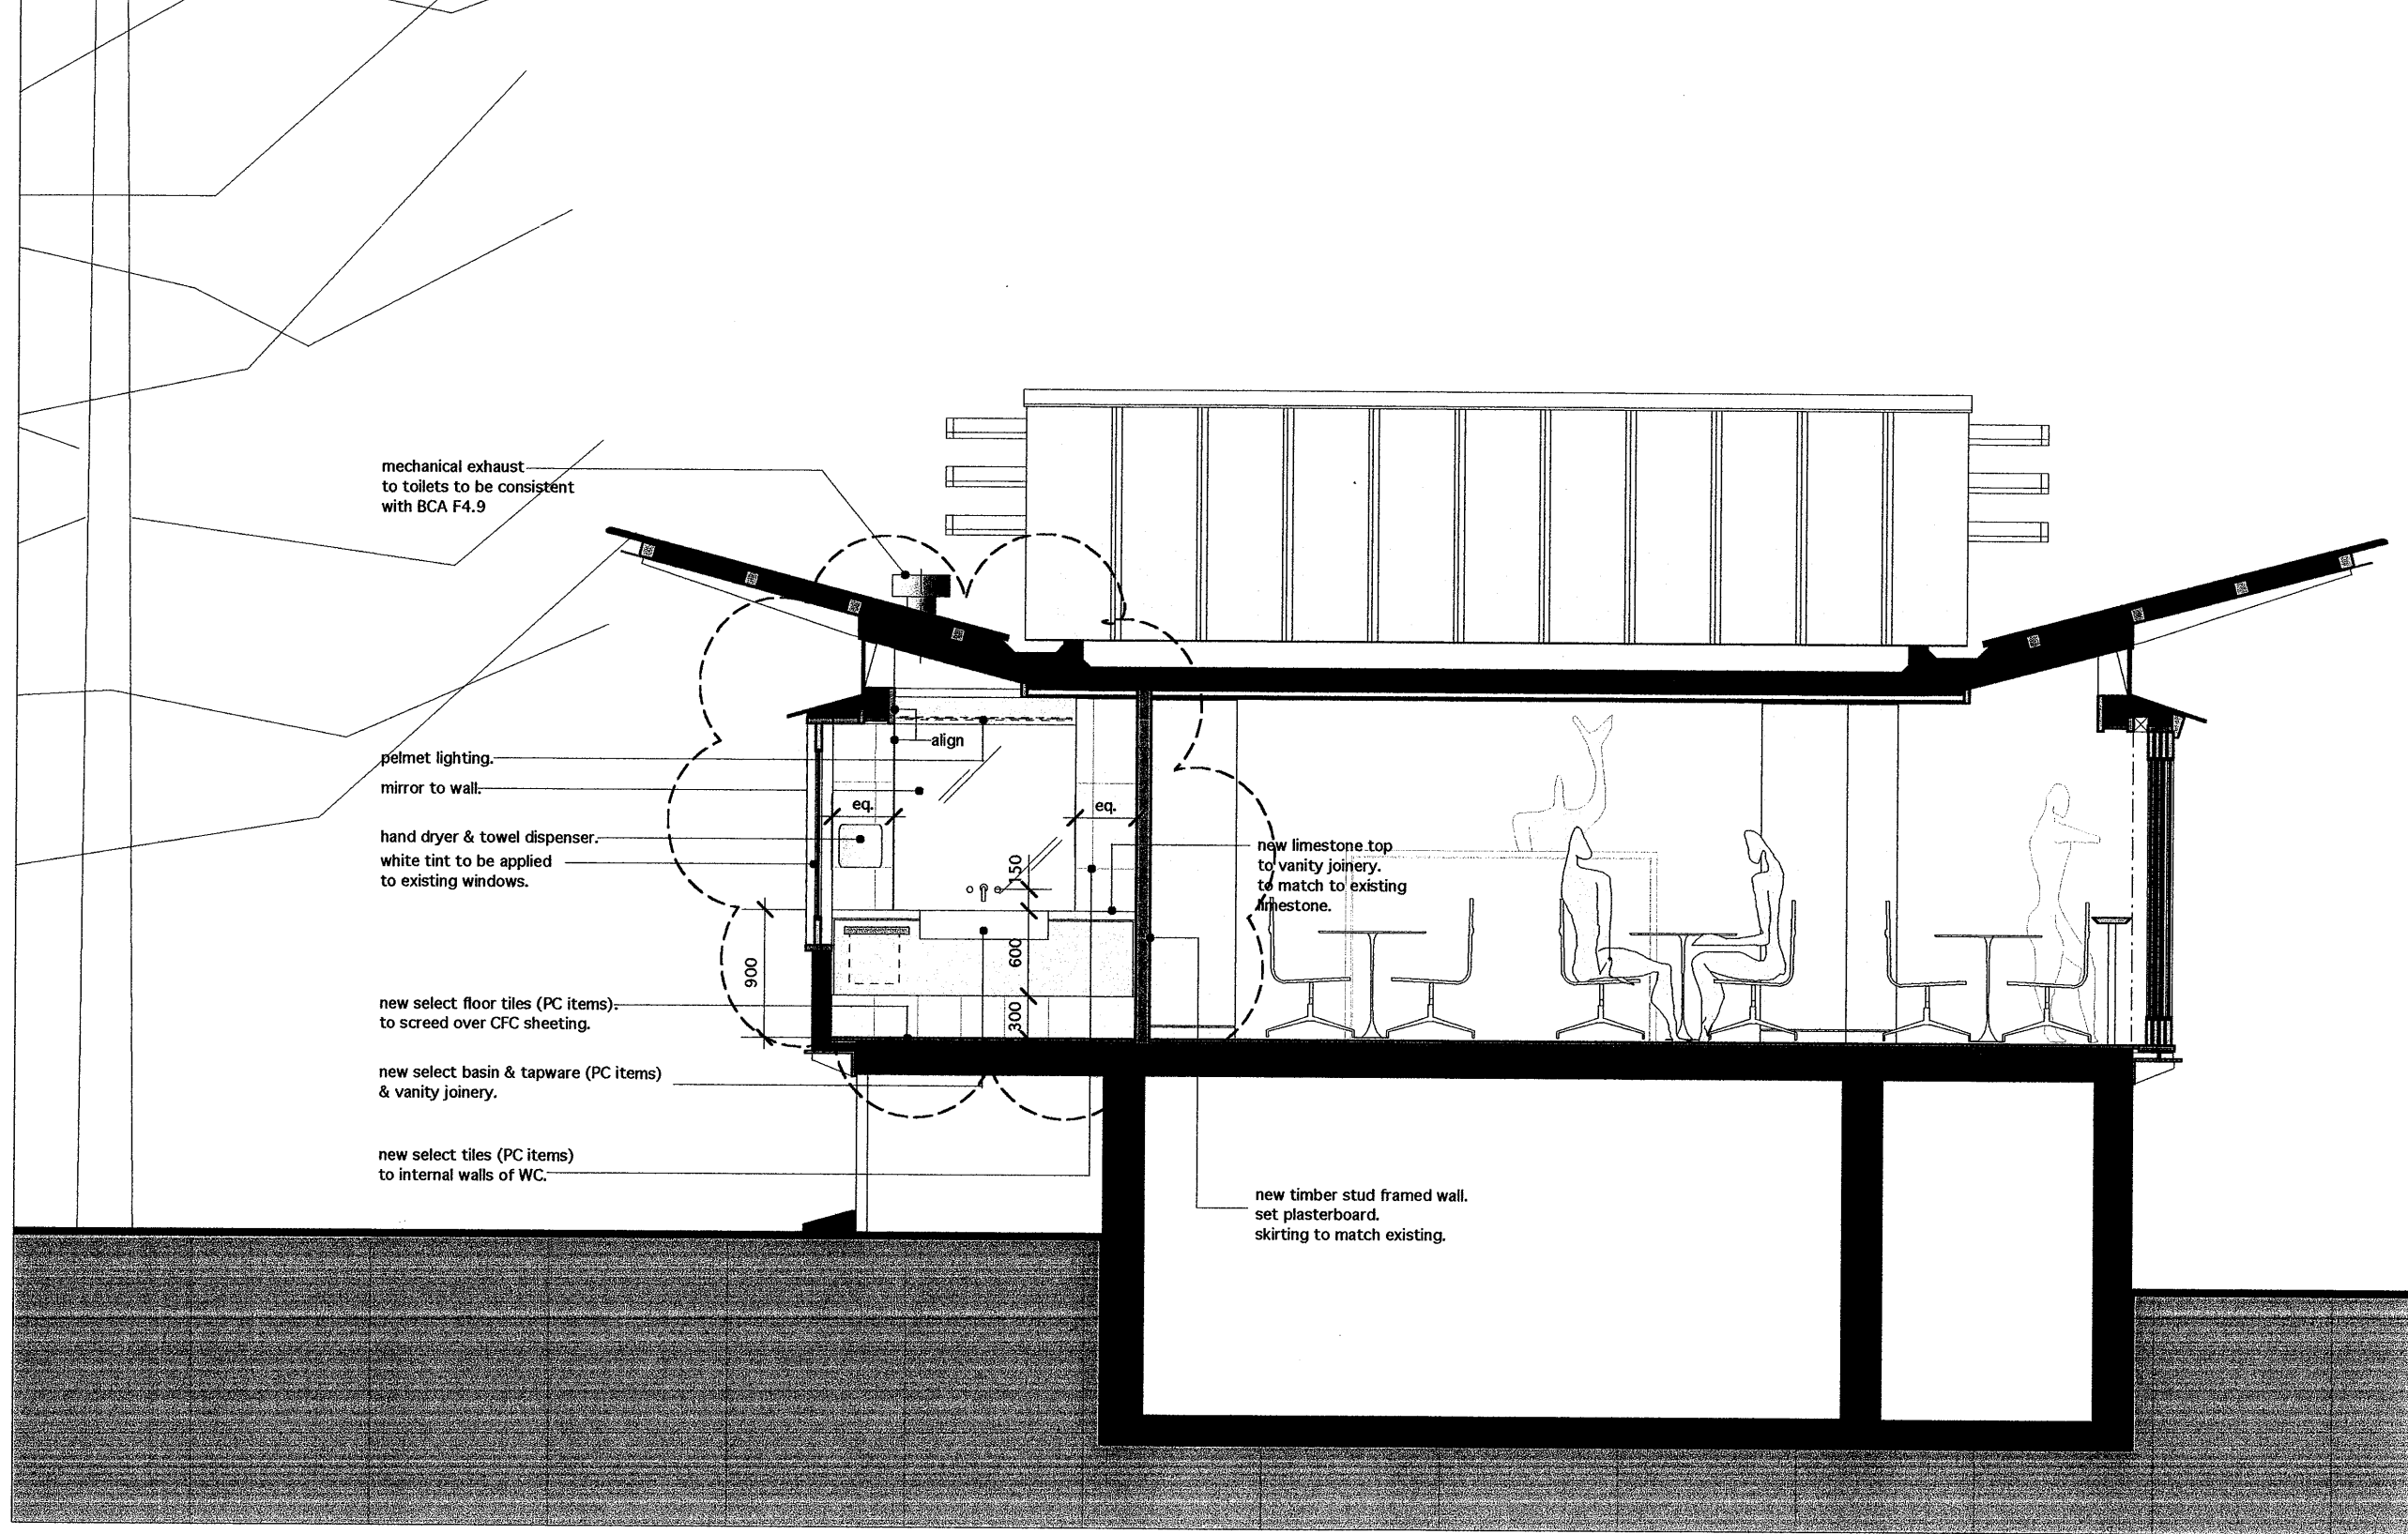

section A

scale 1:50@A3

10.11.2008	C	DA / CC
30.10.2008	B	DA / CC
oct 2008	A	design concept

date issue

amendments


drawing :
 dwg. no. : 10.08.B 04
 date : oct 2008
 drawn :
 checked :

Alterations - New Toilets
 Manly Ocean Beach House
 Manly NSW

LESIUK ARCHITECTS PTY LTD
 the studio, 1118 barrenjoey road palm beach nsw
 po box 30 palm beach nsw 2108
 telephone 612 9974 1010 fax/mile 612 9974 5502
 email lesiukarchitects@bigpond.com

PC Items

1. floor tiles
2. wall tiles
3. toilet suites (2)
4. basin
5. tapware
6. hand dryer
7. towel dispenser
8. toilet roll holders (2)

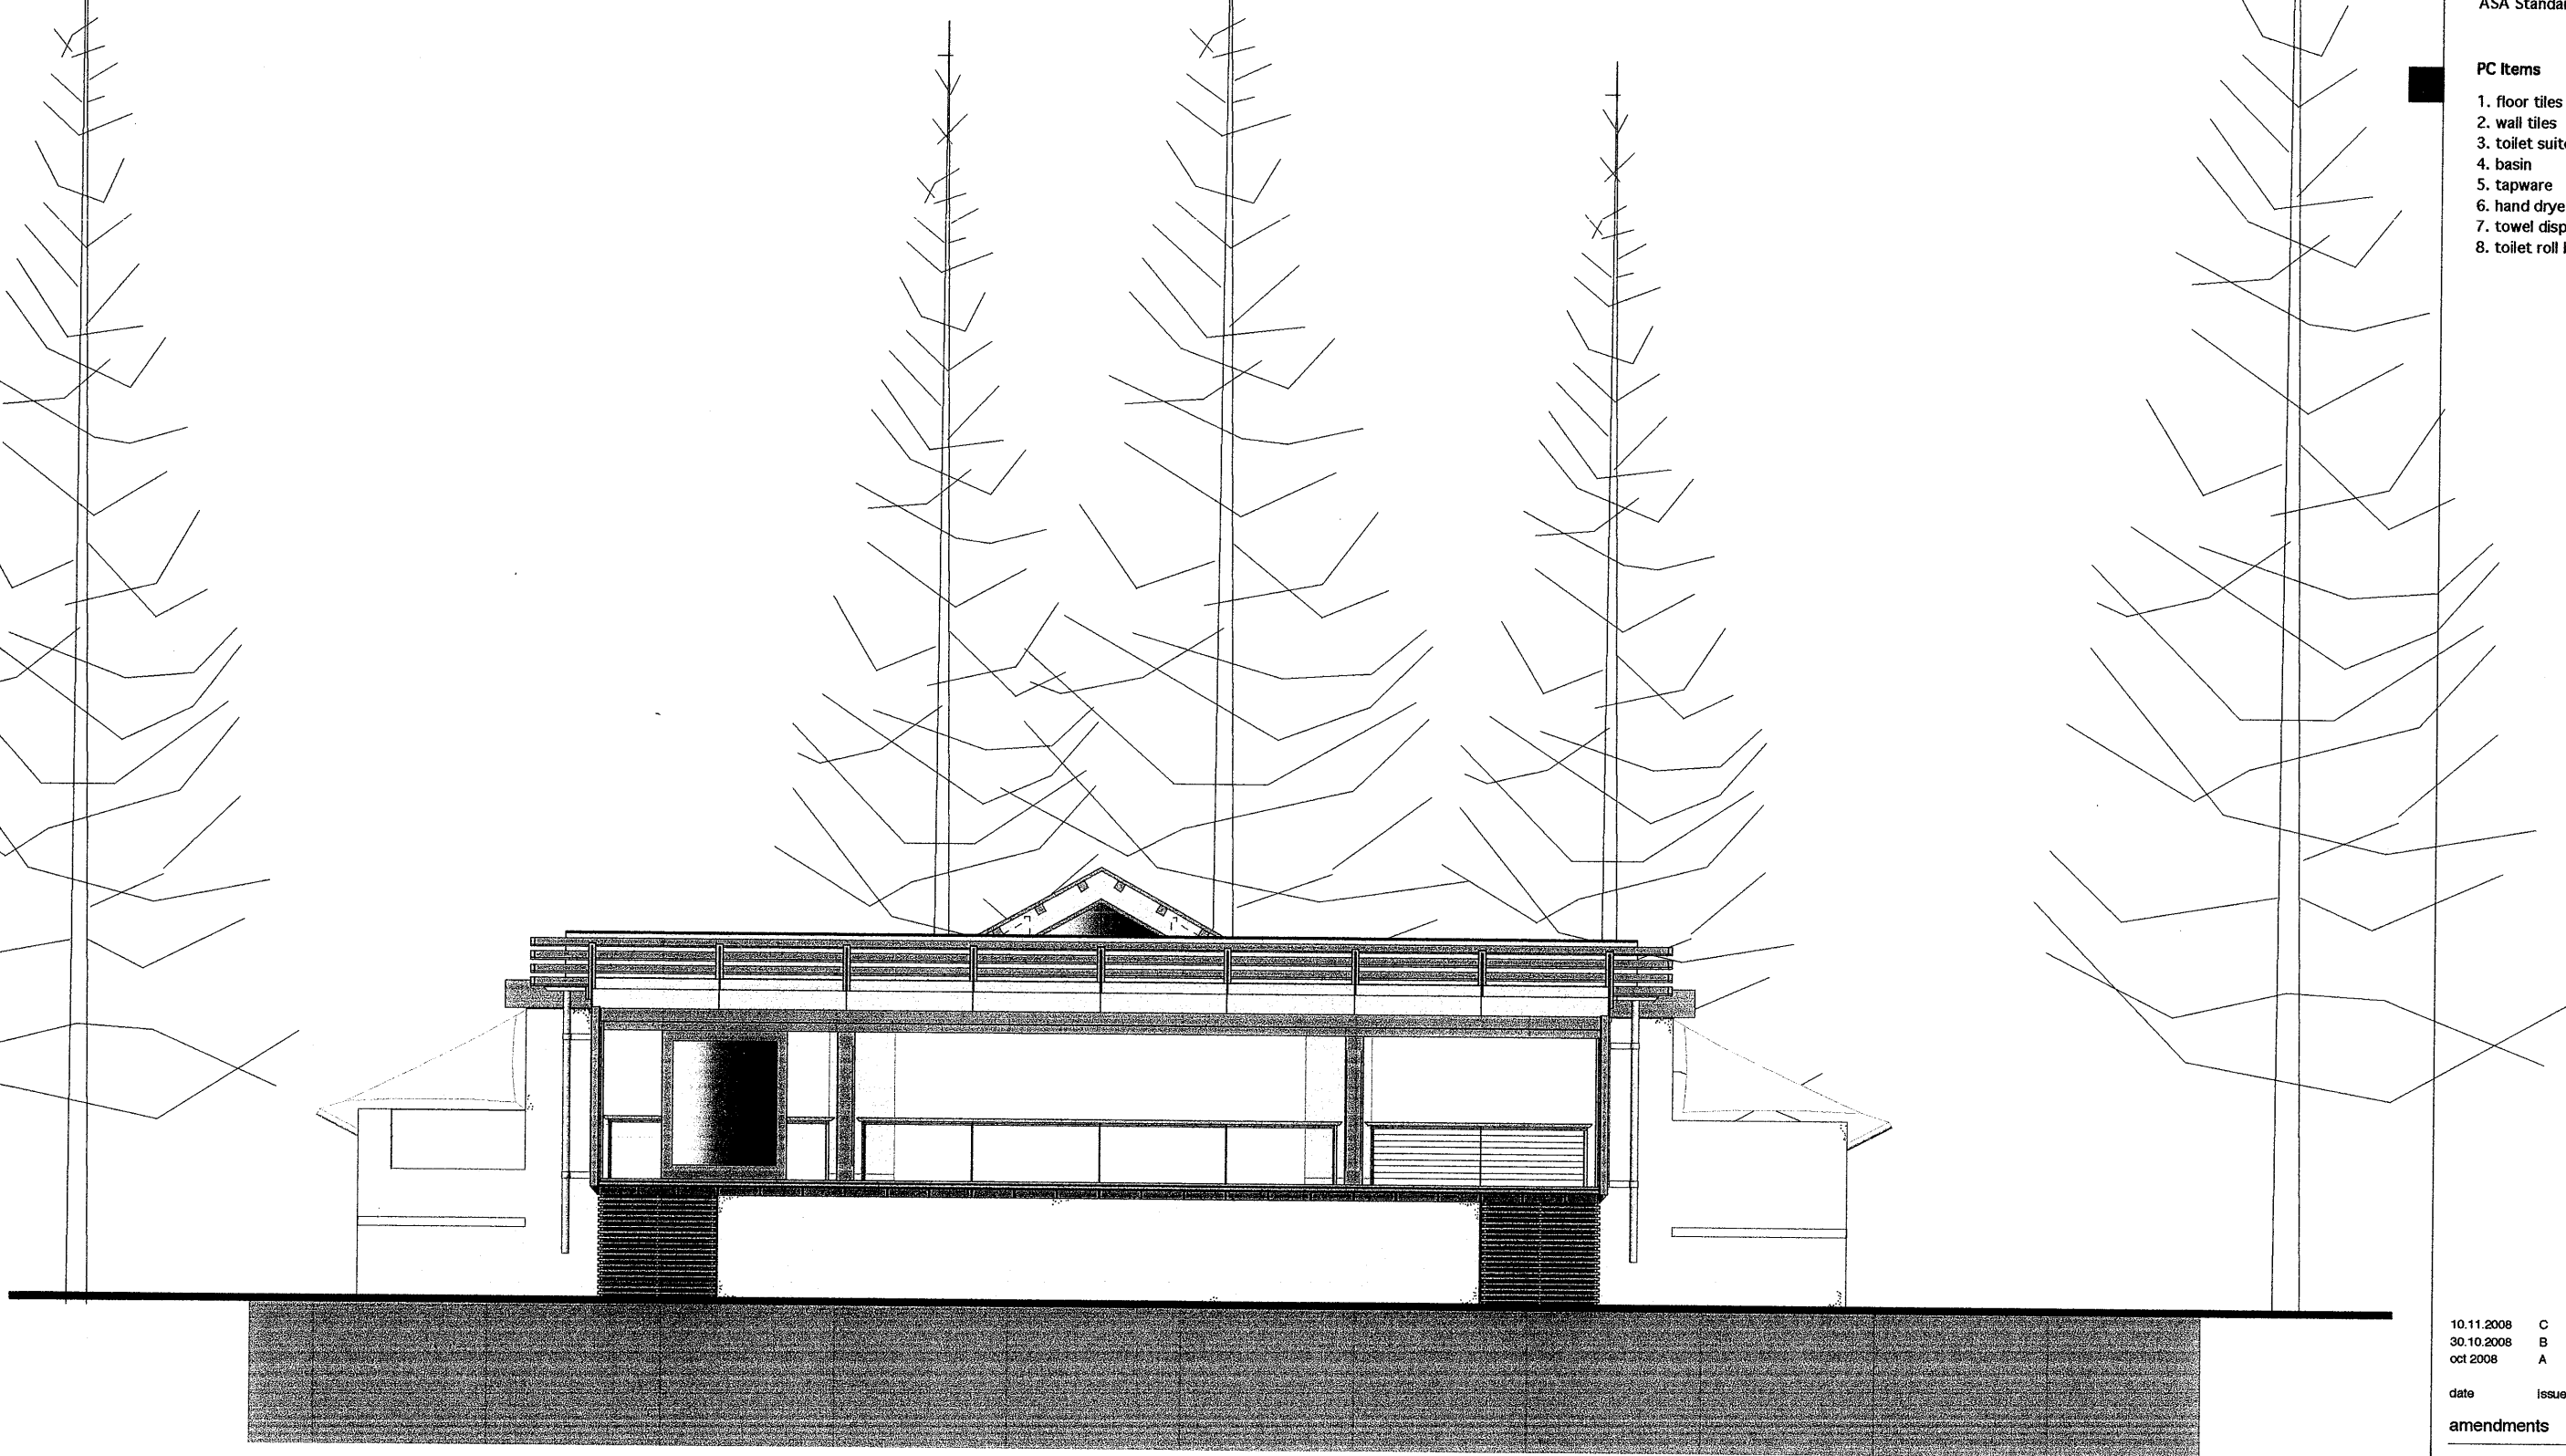

east elevation (existing)
1:100 @ A3

*note: north, south & east elevations - no change.
existing disabled toilets still to be used
consistent with lease document.

10.11.2008	C	DA / CC
30.10.2008	B	DA / CC
oct 2008	A	design concept

date issue

amendments

drawing : east elevation - existing
dwg. no. : 10.08.B05
date : oct 2008
drawn :
checked :


Alterations - New Toilets
Manly Ocean Beach House
Manly NSW

LESIUK ARCHITECTS PTY LTD

the studio, 1118 barrenjoey road palm beach nsw
po box 30 palm beach nsw 2108
telephone 612 9974 1010 faxsimile 612 9974 5502
email lesiukarchitects@bigpond.com

PC Items

1. floor tiles
2. wall tiles
3. toilet suites (2)
4. basin
5. tapware
6. hand dryer
7. towel dispenser
8. toilet roll holders (2)

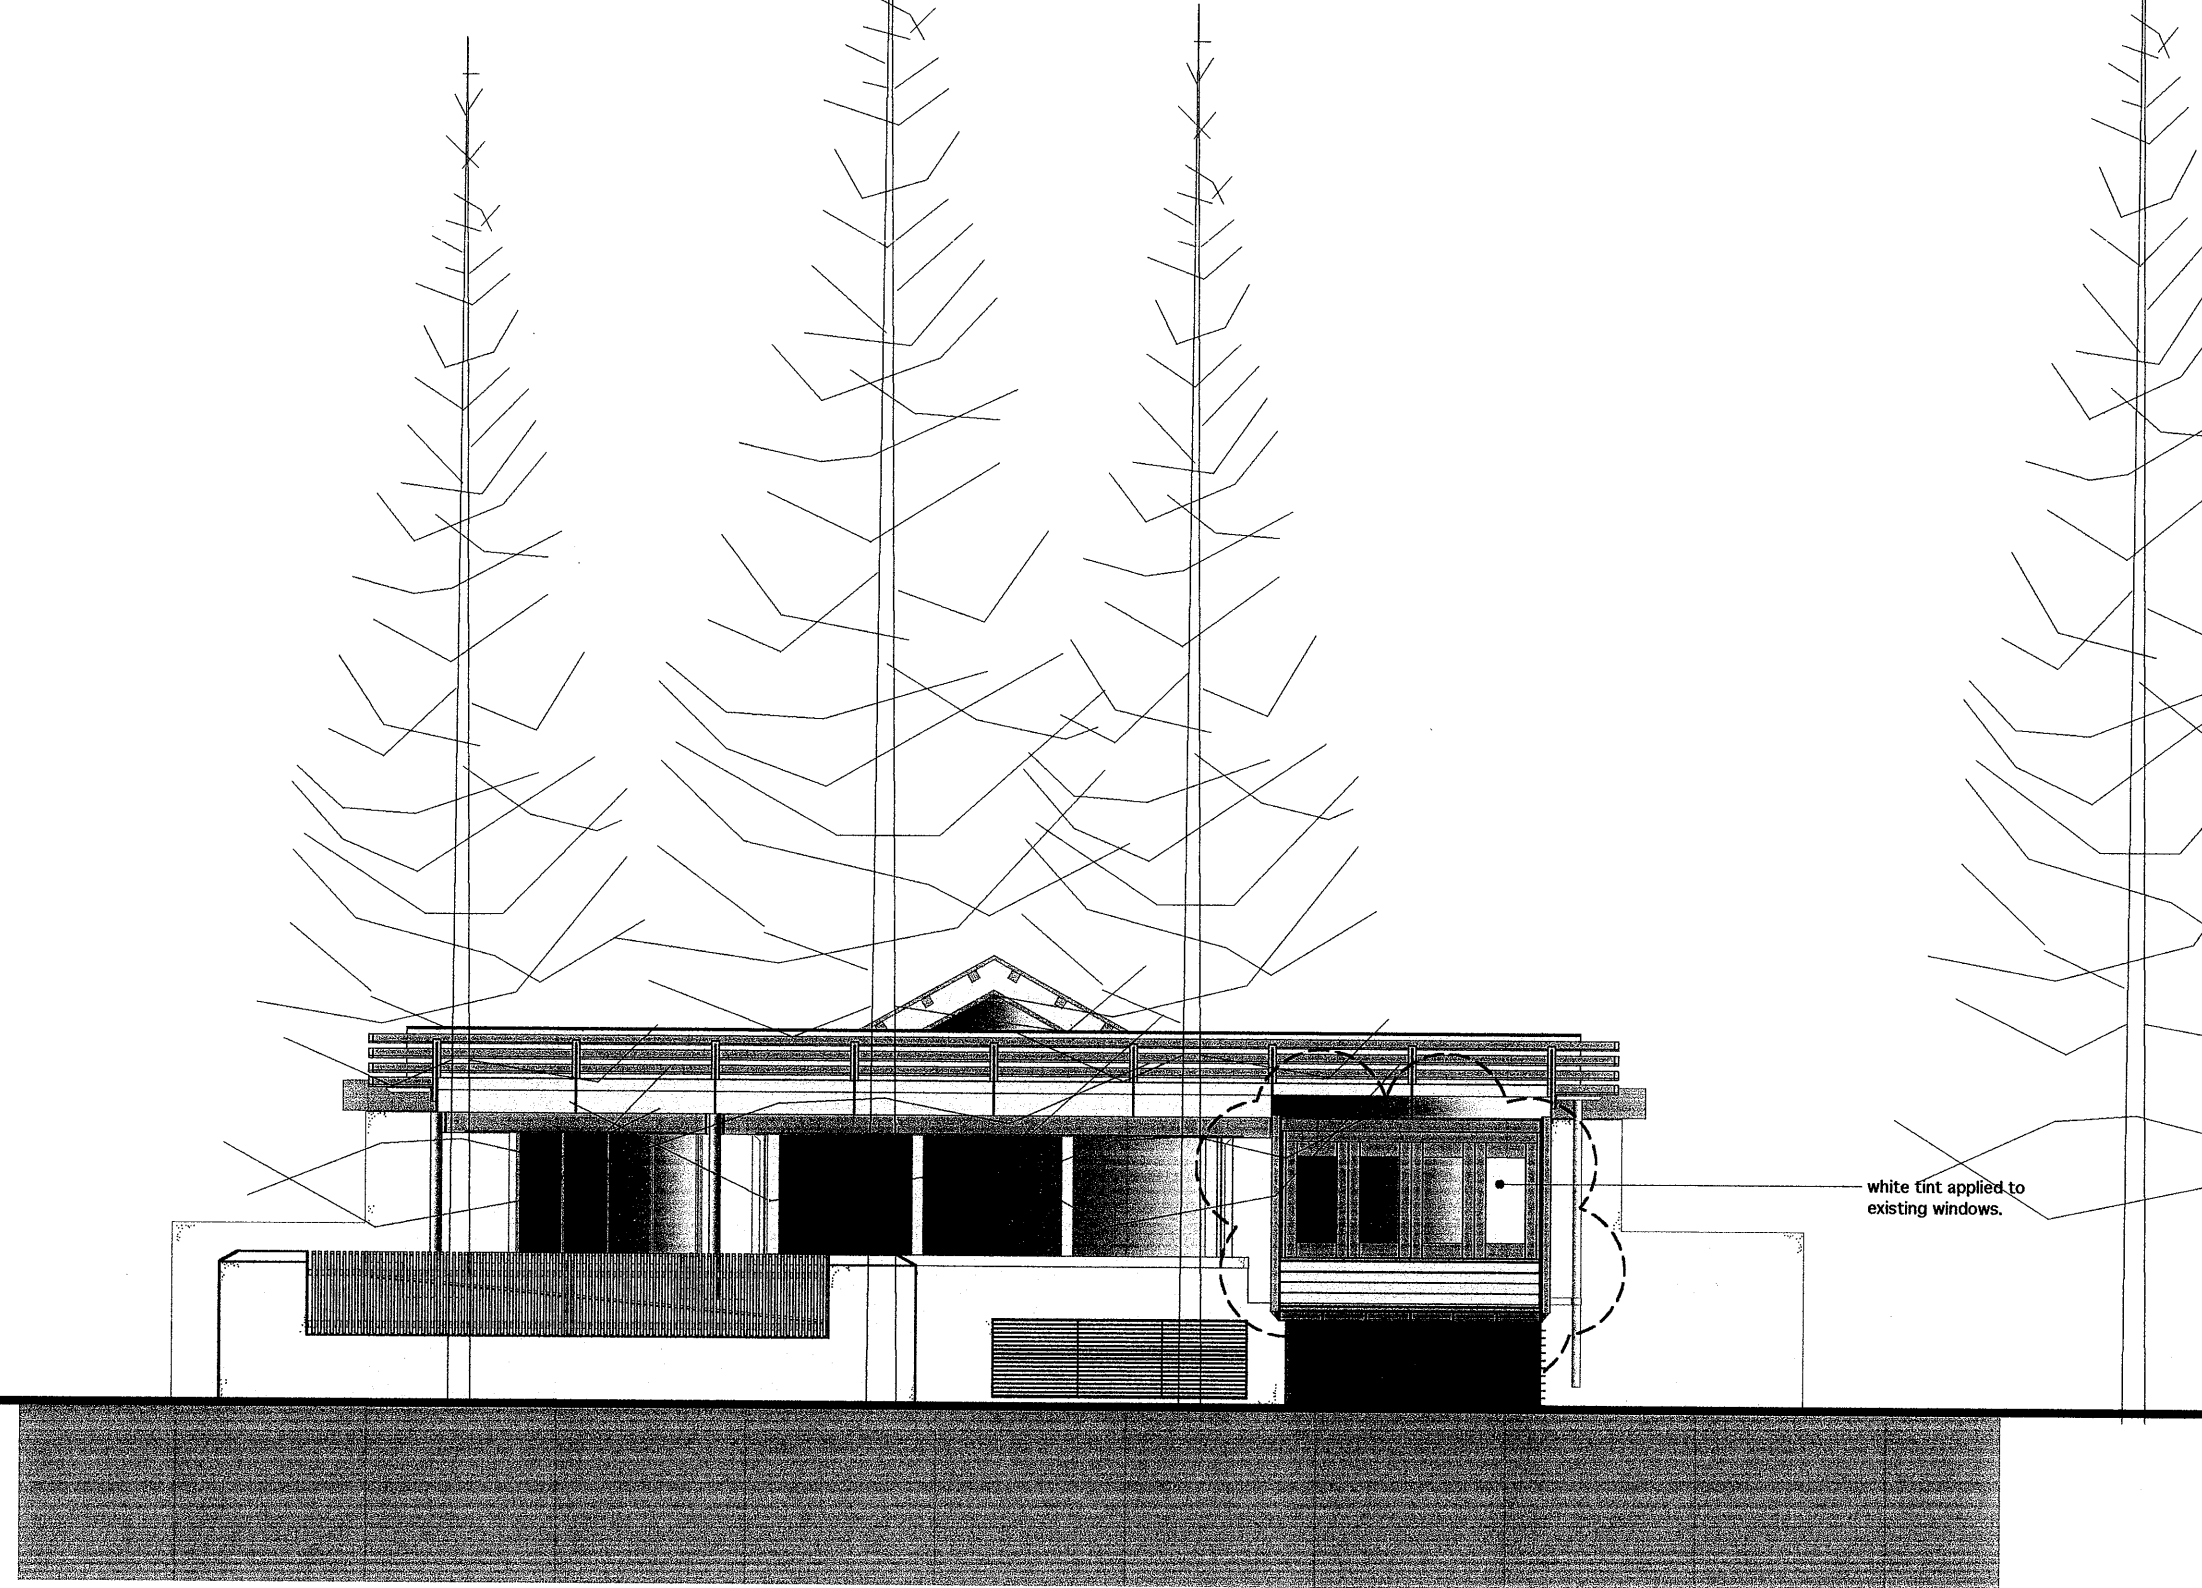

white tint applied to
existing windows.

west elevation

1:100 @ A3

*note: north, south & east elevations - no change.
existing disabled toilets still to be used
consistent with lease document.

10.11.2008	C	DA / CC
30.10.2008	B	DA / CC
oct 2008	A	design concept

date	issue
------	-------

amendments

drawing	:	west elevation
dwg. no.	:	10.08.B06
date	:	oct 2008
drawn	:	
checked	:	

Alterations - New Toilets
Manly Ocean Beach House
Manly NSW


LESIUK ARCHITECTS PTY LTD

the studio, 1118 barrenjoey road palm beach nsw
po box 30 palm beach nsw 2108
telephone 612 9974 1010 faxsimile 612 9974 5502
email lesiukarchitects@bigpond.com

PLAN
1:100
DATE
10/11/08

development application / construction certificate

manly ocean beach house

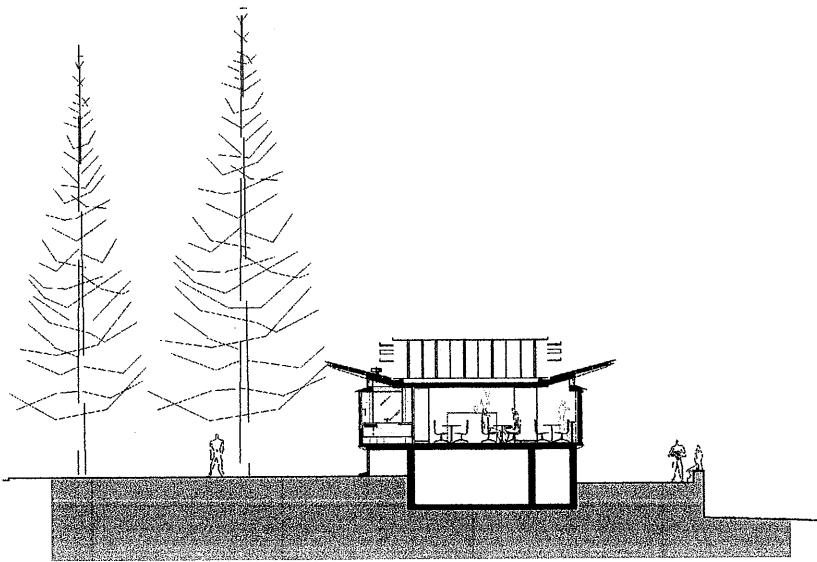

issue	date	comments
c	10.11.2008	D.A. & C.C.
b	30.10.2008	D.A. & C.C.
a	oct 2008	design concept

alterations - new toilets
manly ocean beach house

LESIUK ARCHITECTS PTY LTD
the studio, 1118 barrenjoey road palm beach nsw
po box 30 palm beach nsw 2108
telephone 612 9974 1010 faxsimile 612 9974 5502
email lesiukarchitects@bigpond.com