




Section AA 1:50

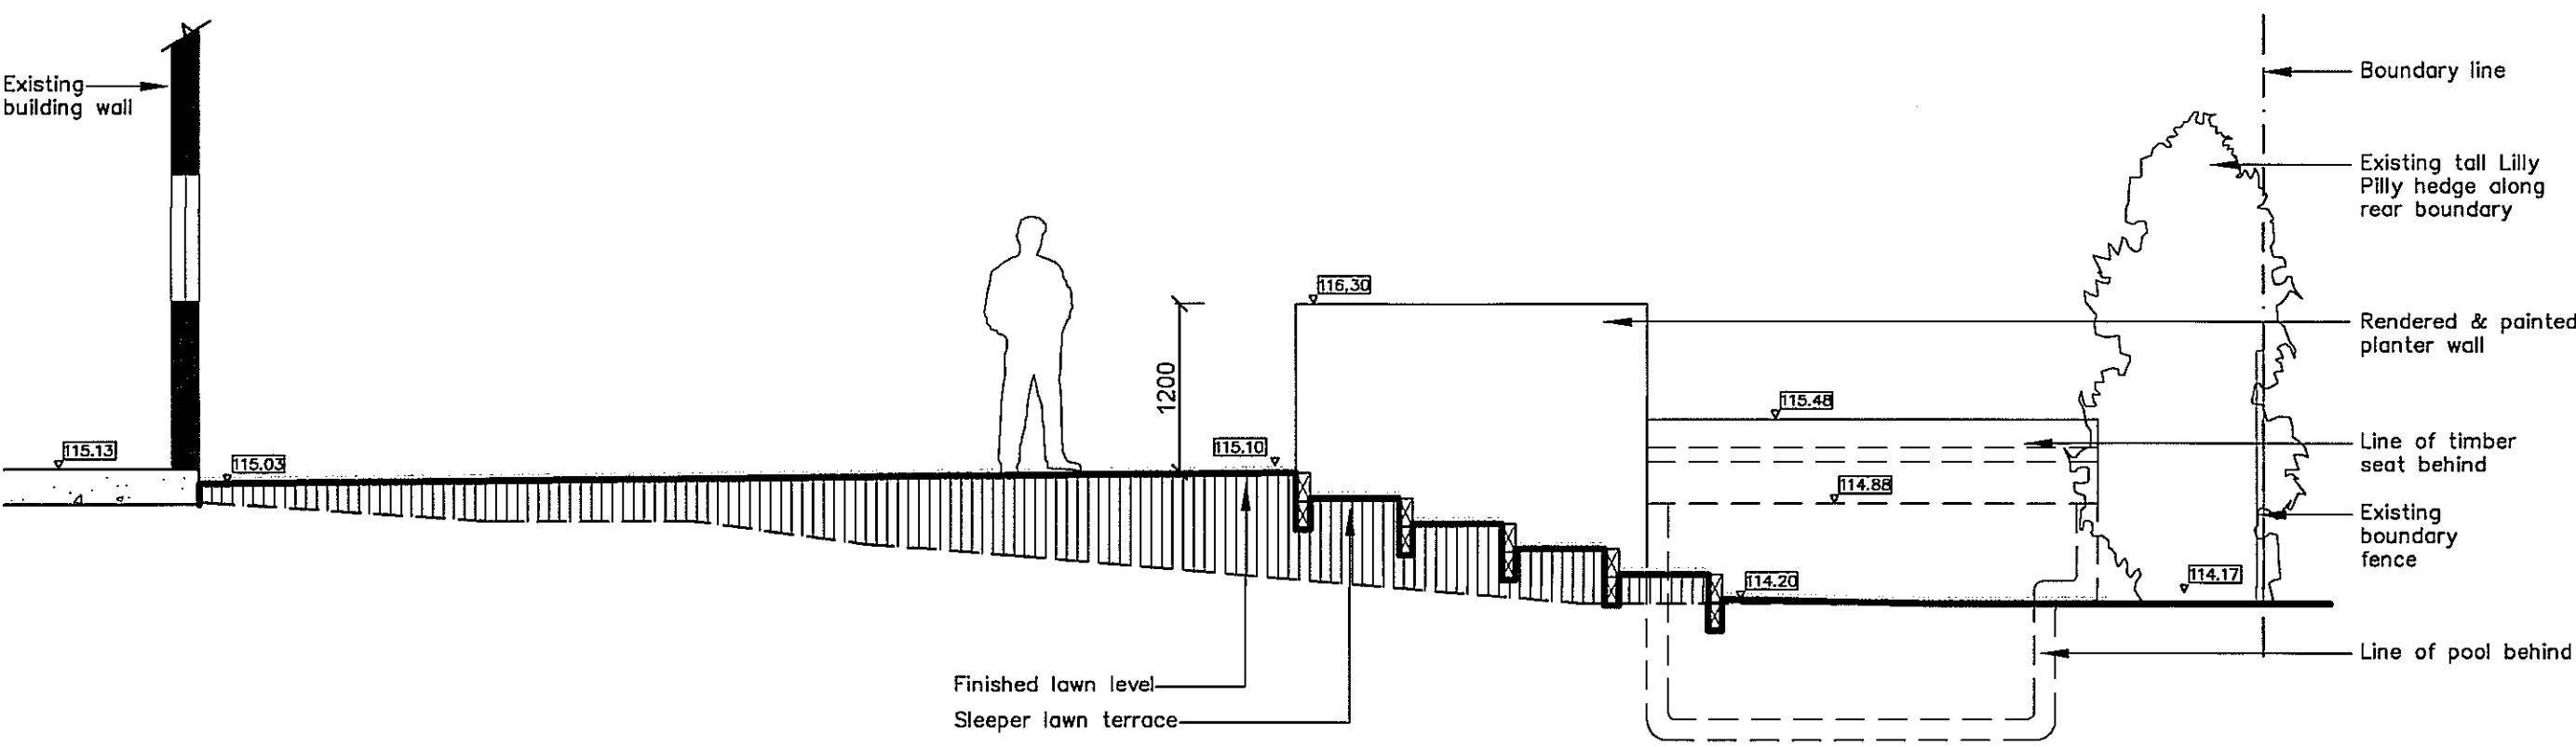


Sectional elevation DD 1:50

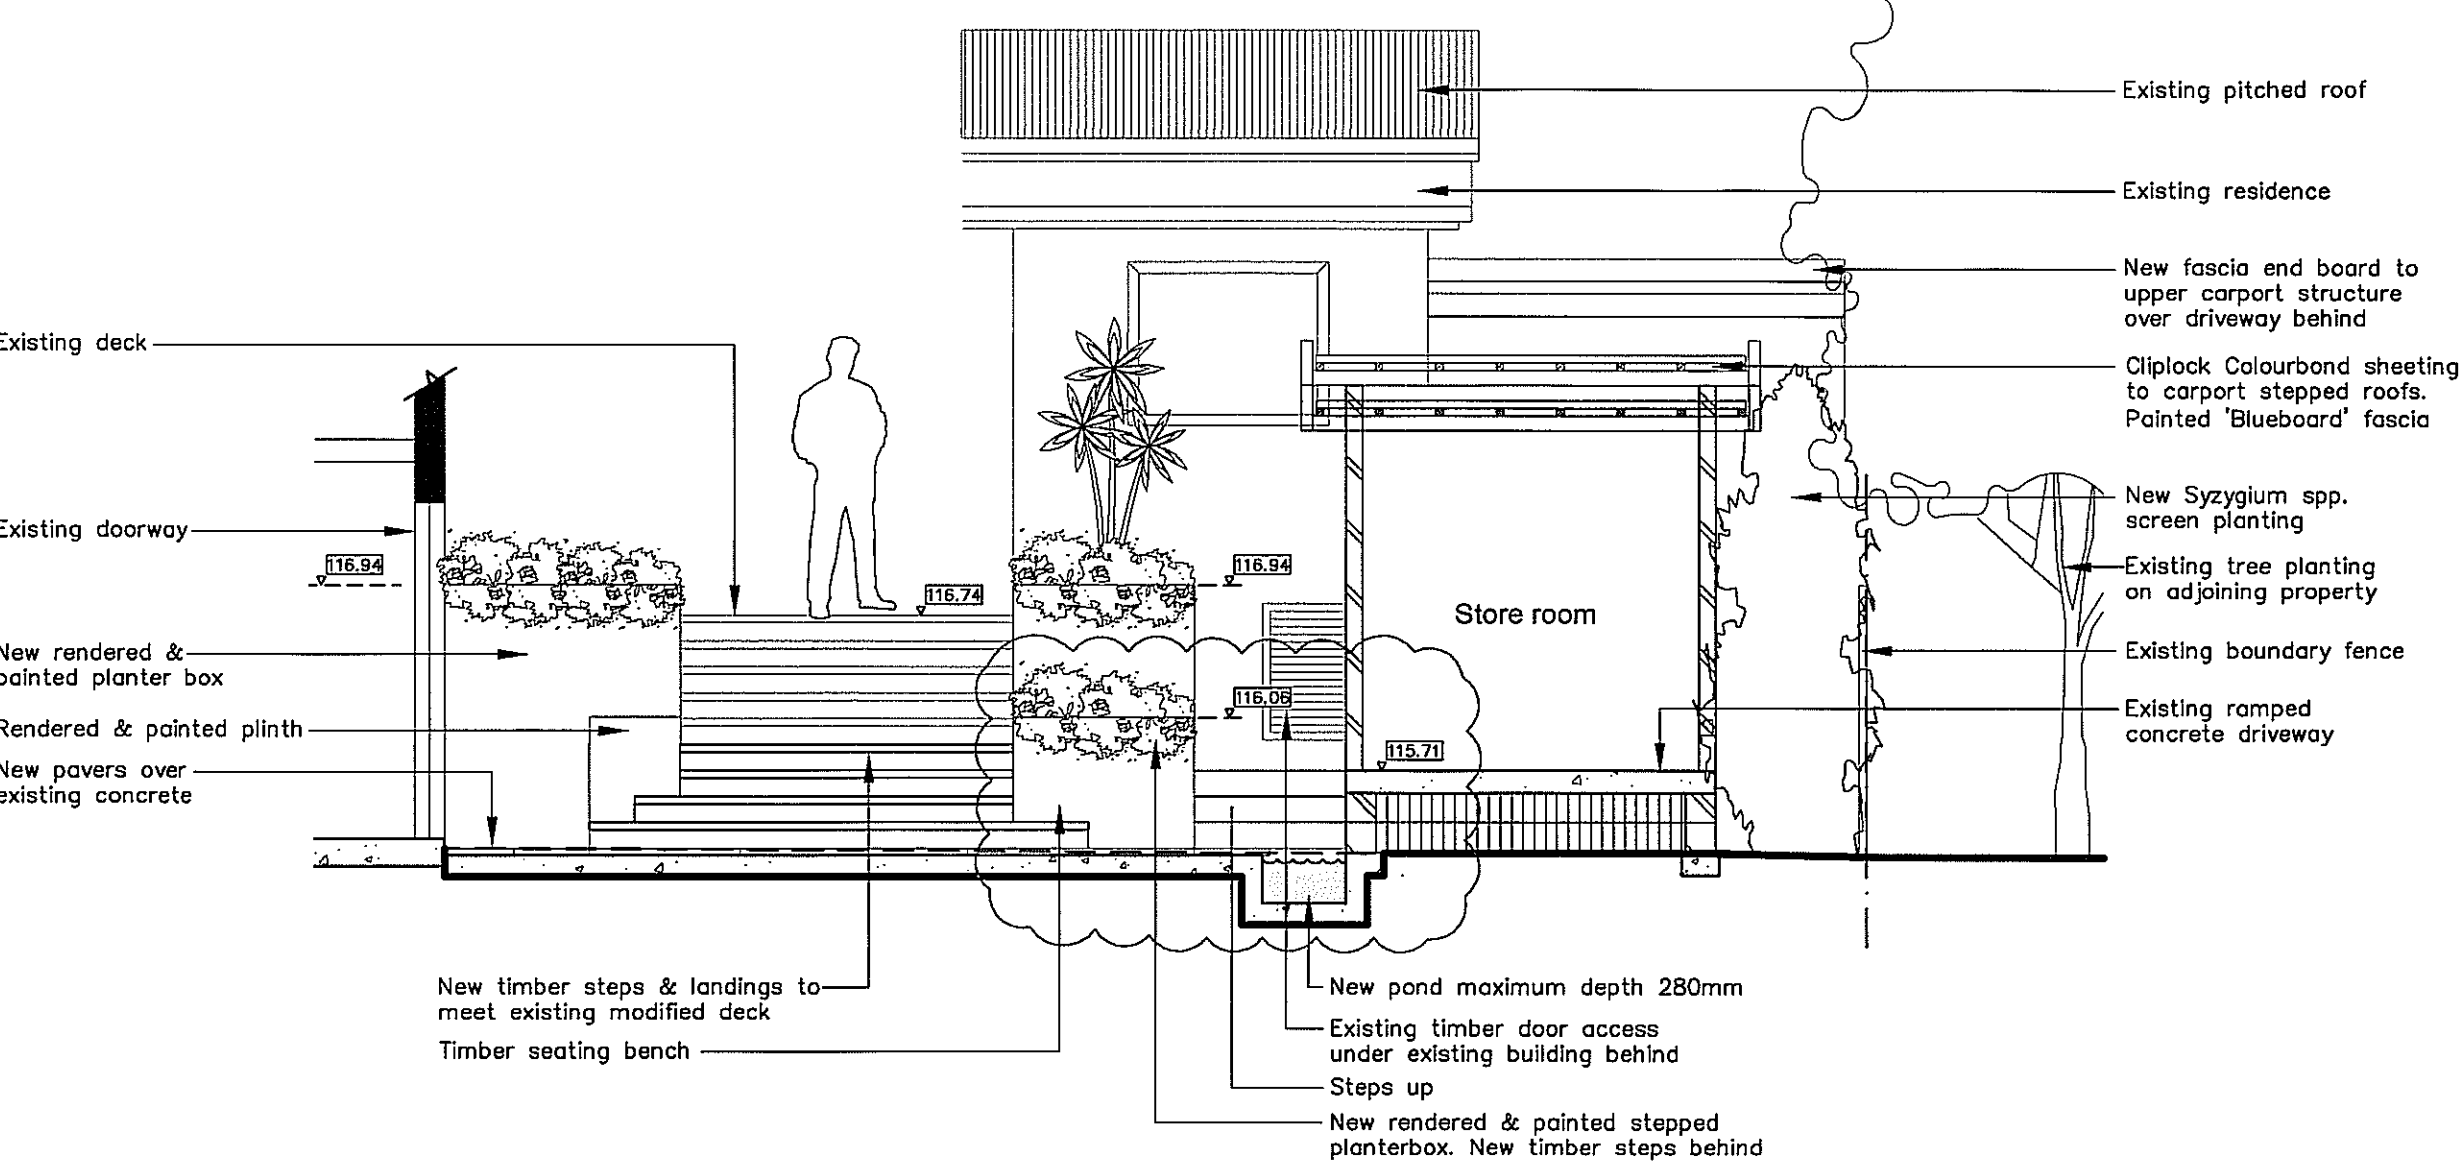

Section BB 1:50

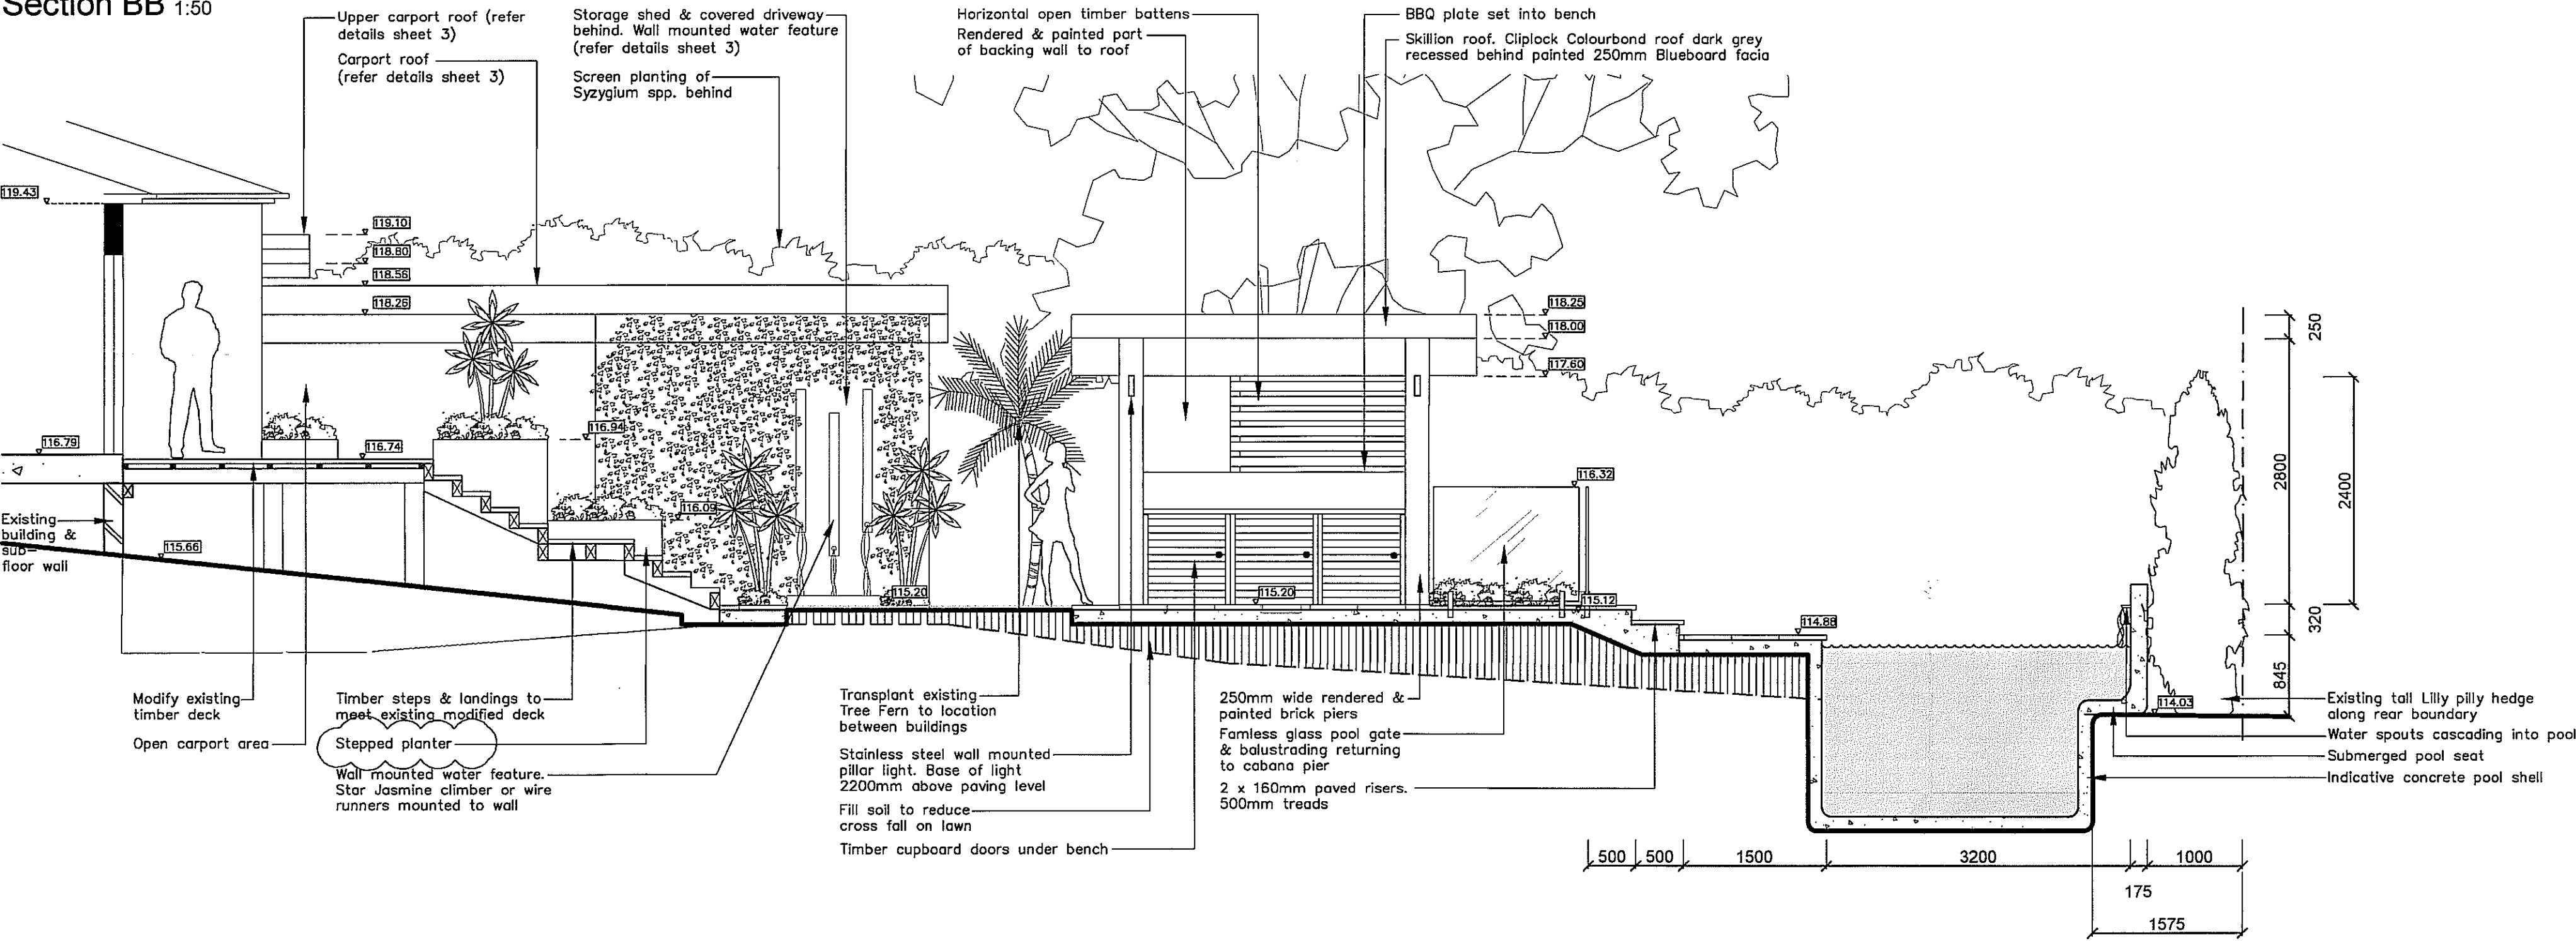

Section CC 1:50

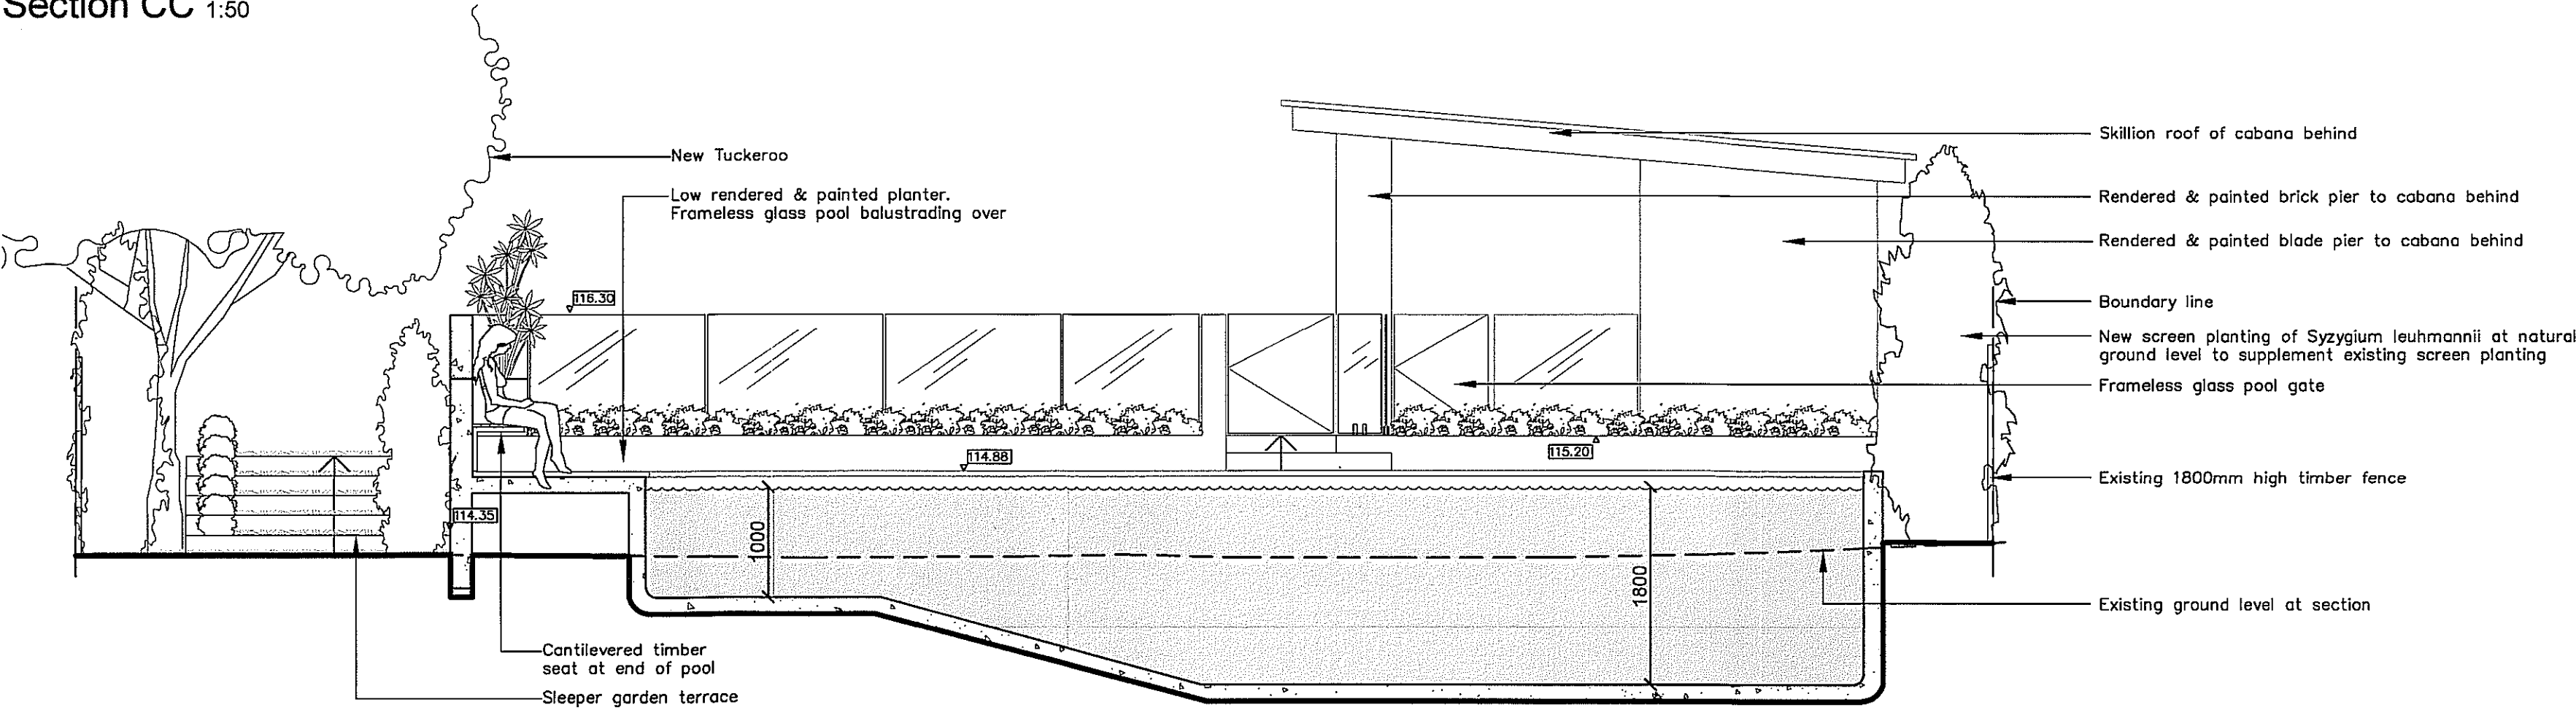

THIS PLAN IS TO BE READ
IN CONJUNCTION WITH
DA 2009 / 0683
WARRINGAH COUNCIL

Issue B:
Amendments to comply with Council issues.

- Reduce paving surfaces by 15m²
- Reduce new driveway parking fall to max 1:20 slope



PAUL SCRIVENER
LANDSCAPE ARCHITECT

PO Box 813 NEWPORT NSW 2106
ACN 070 598 882
ABN 56 070 598 882

PHONE: 02 9907 8011
FAX: 02 9948 9527
MOBILE: 0417 258 629
WWW.SCRIVENER-DESIGN.COM
EMAIL: paul@scrivener-design.com

PROJECT: POOL, CABANA & CARPORT AT
69 ROOSEVELT AVENUE
ALLAMBIE HEIGHTS

DWG: SECTIONAL ELEVATIONS (A)

DATE: 1.07.09	SCALE: 1:50@A1
JOB REF: 09/1392/DA2	SHEET No: 2 OF 6
ISSUE: B	

BUILDER MUST VERIFY ALL DIMENSIONS OF THE SITE BEFORE WORK COMMENCES.
FIGURED DIMENSIONS SHOULD BE USED IN PREFERENCE TO THOSE SCALED OFF.


©Copyright is the property of Paul Scrivener Landscape Architects Pty Ltd A.C.N. 070 598 882.
The concepts, design, details and information described in this drawing are copyright. Other
than for the purpose described under the Copyright Act, no part of it may in any form or by
any means be used or reproduced without prior written permission.

AMENDMENTS


Red line work indicates previous
detail now amended to comply
with Council requirements

NORTH


Sectional elevation EE 1:50

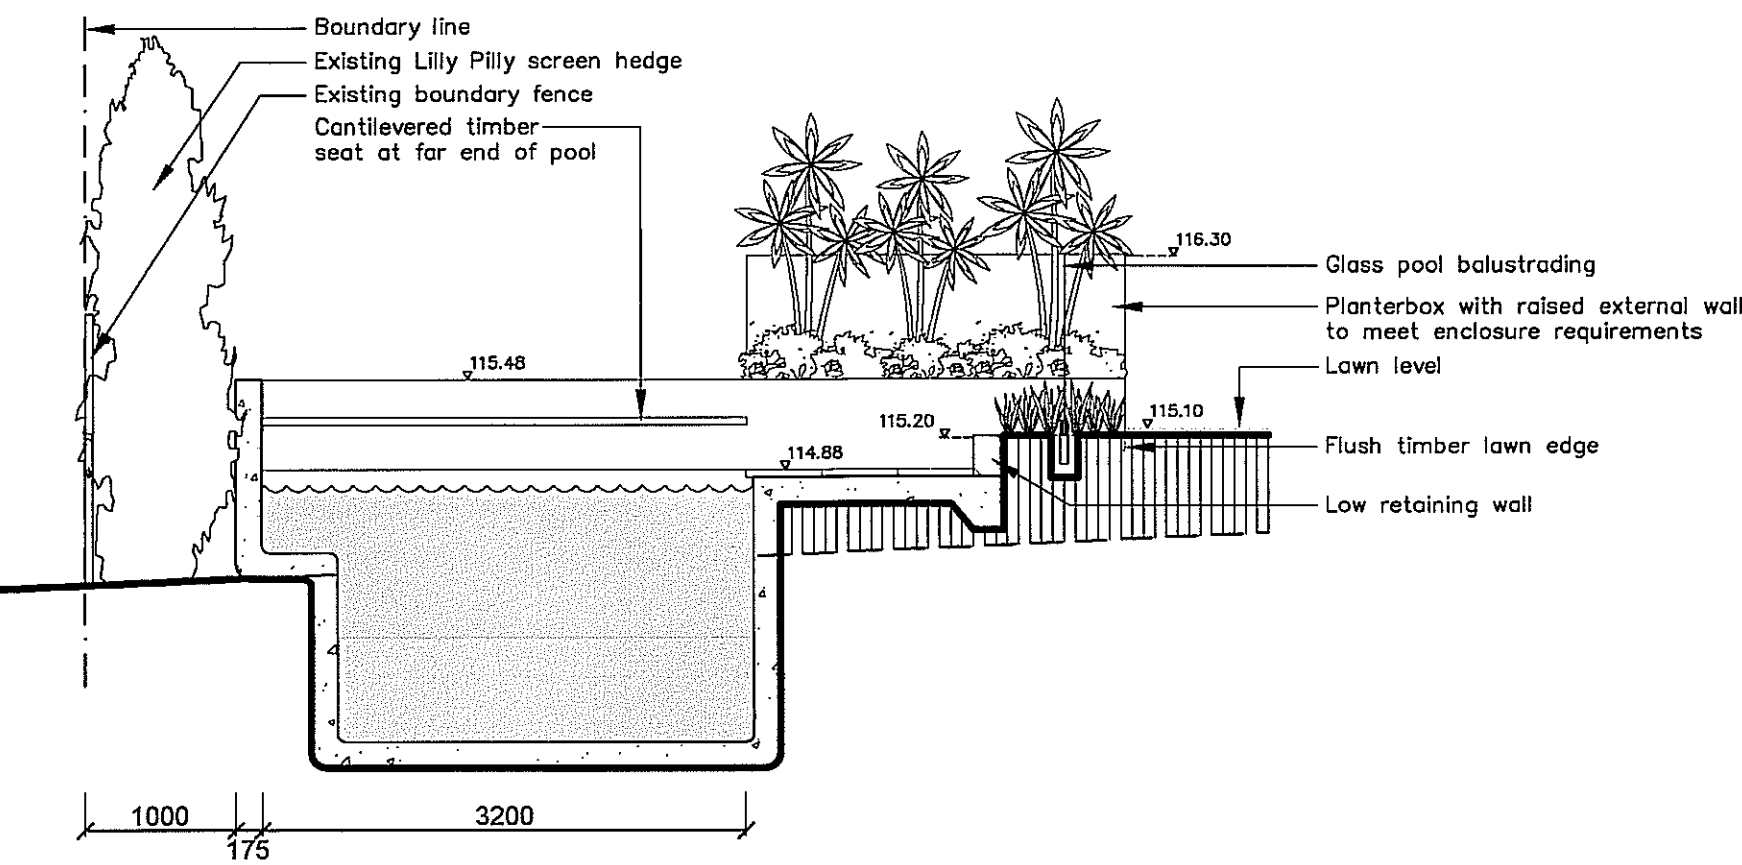


Sectional elevation HH 1:50

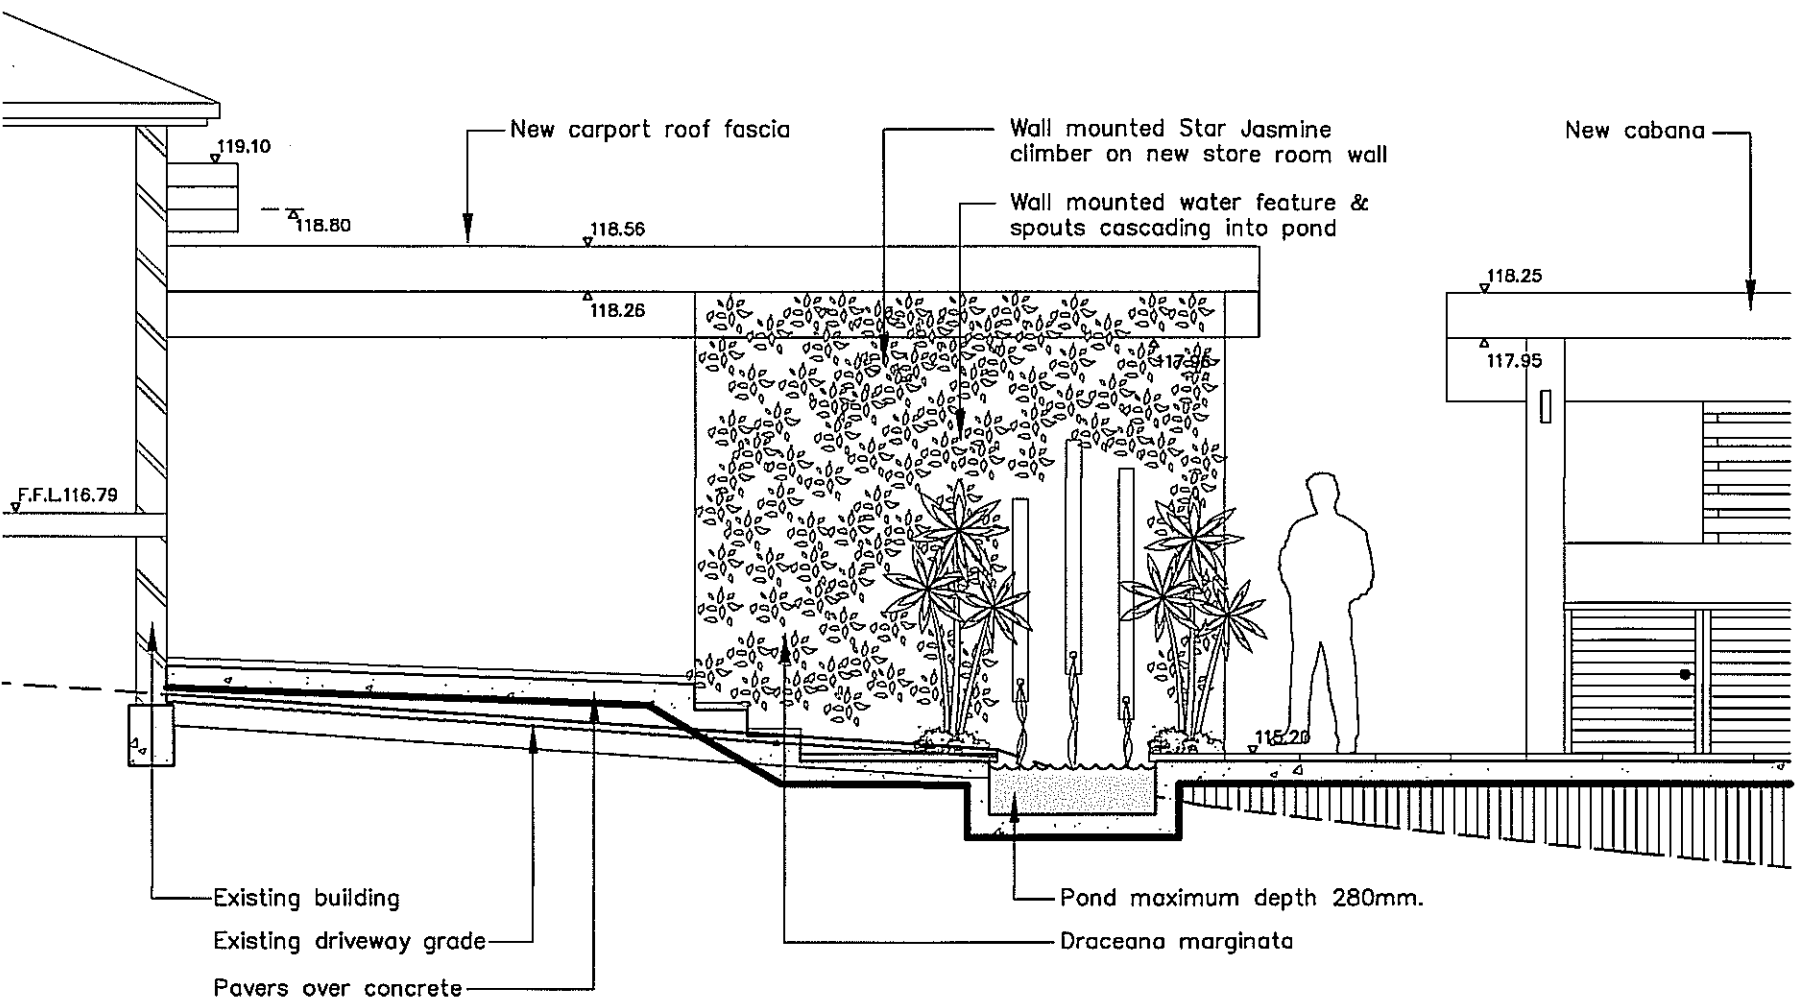

Sectional elevation FF 1:50

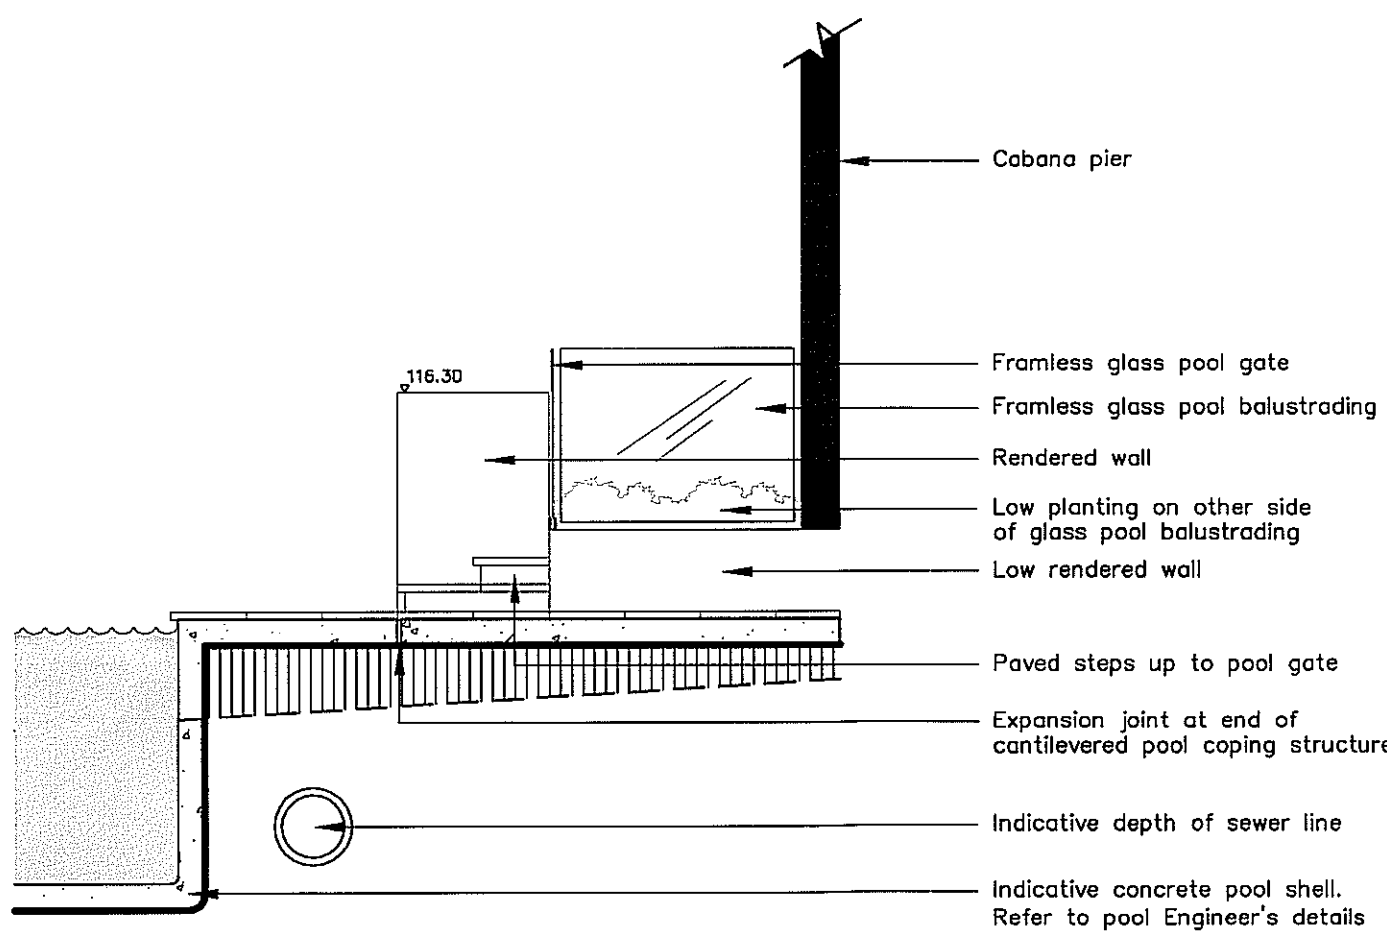


Sectional elevation II 1:50

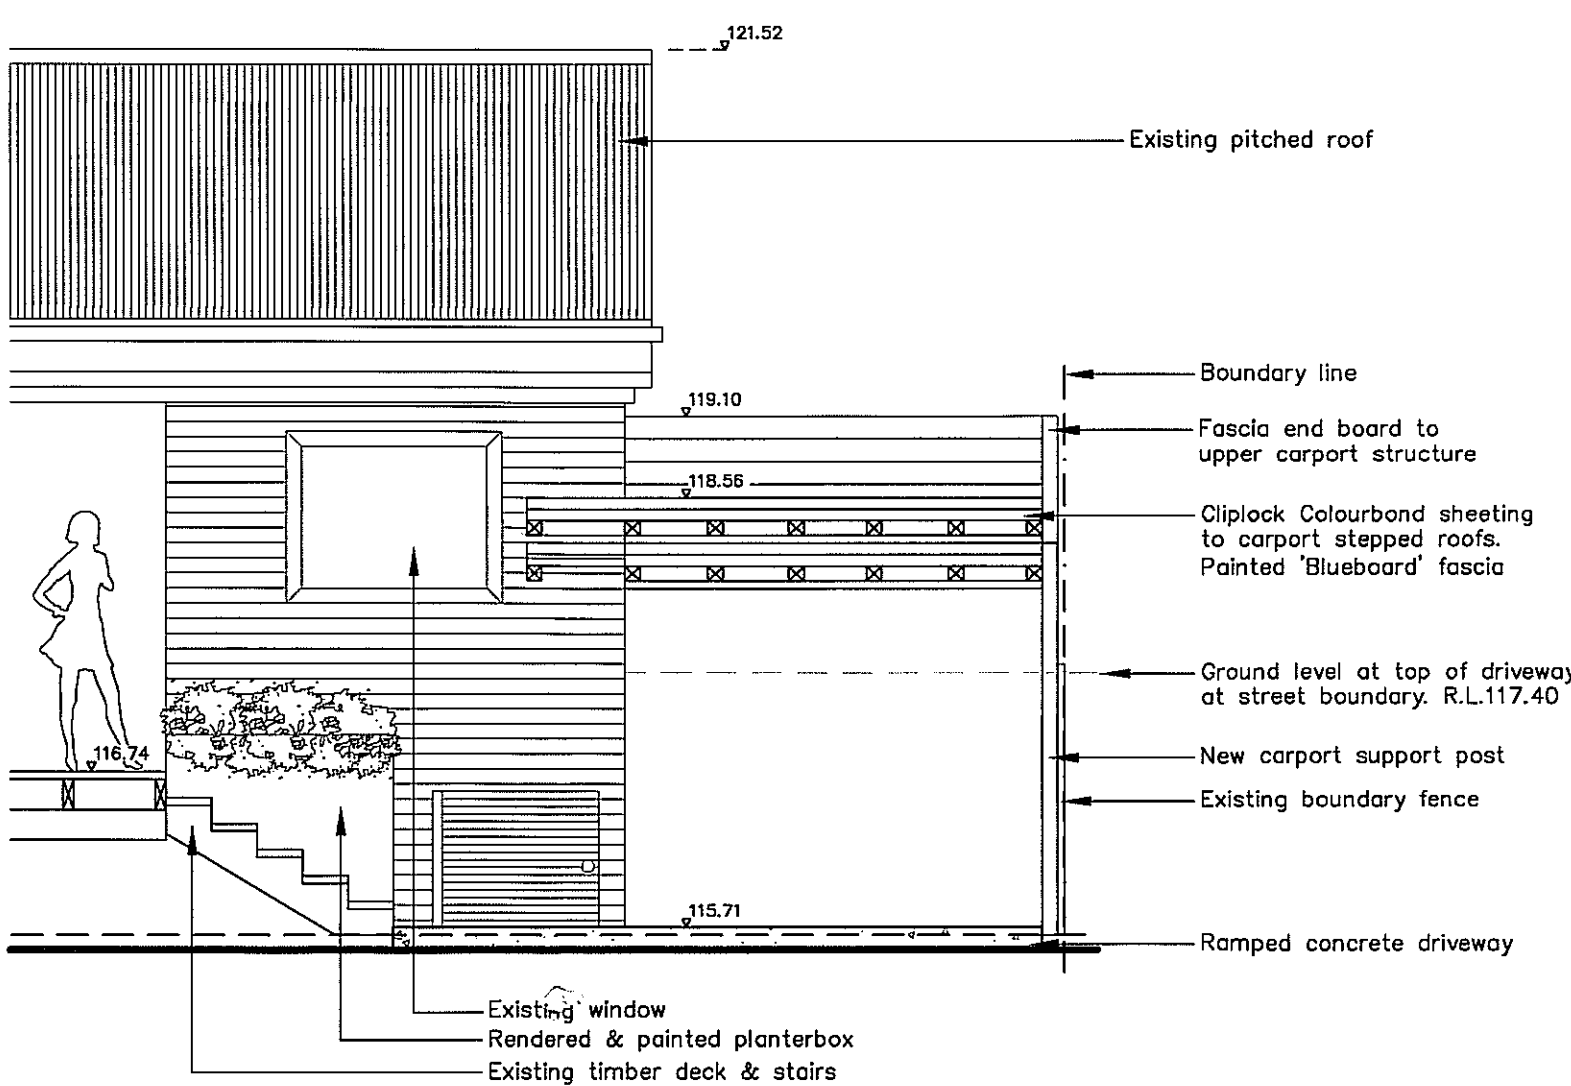

Sectional elevation GG 1:50

Carport long section

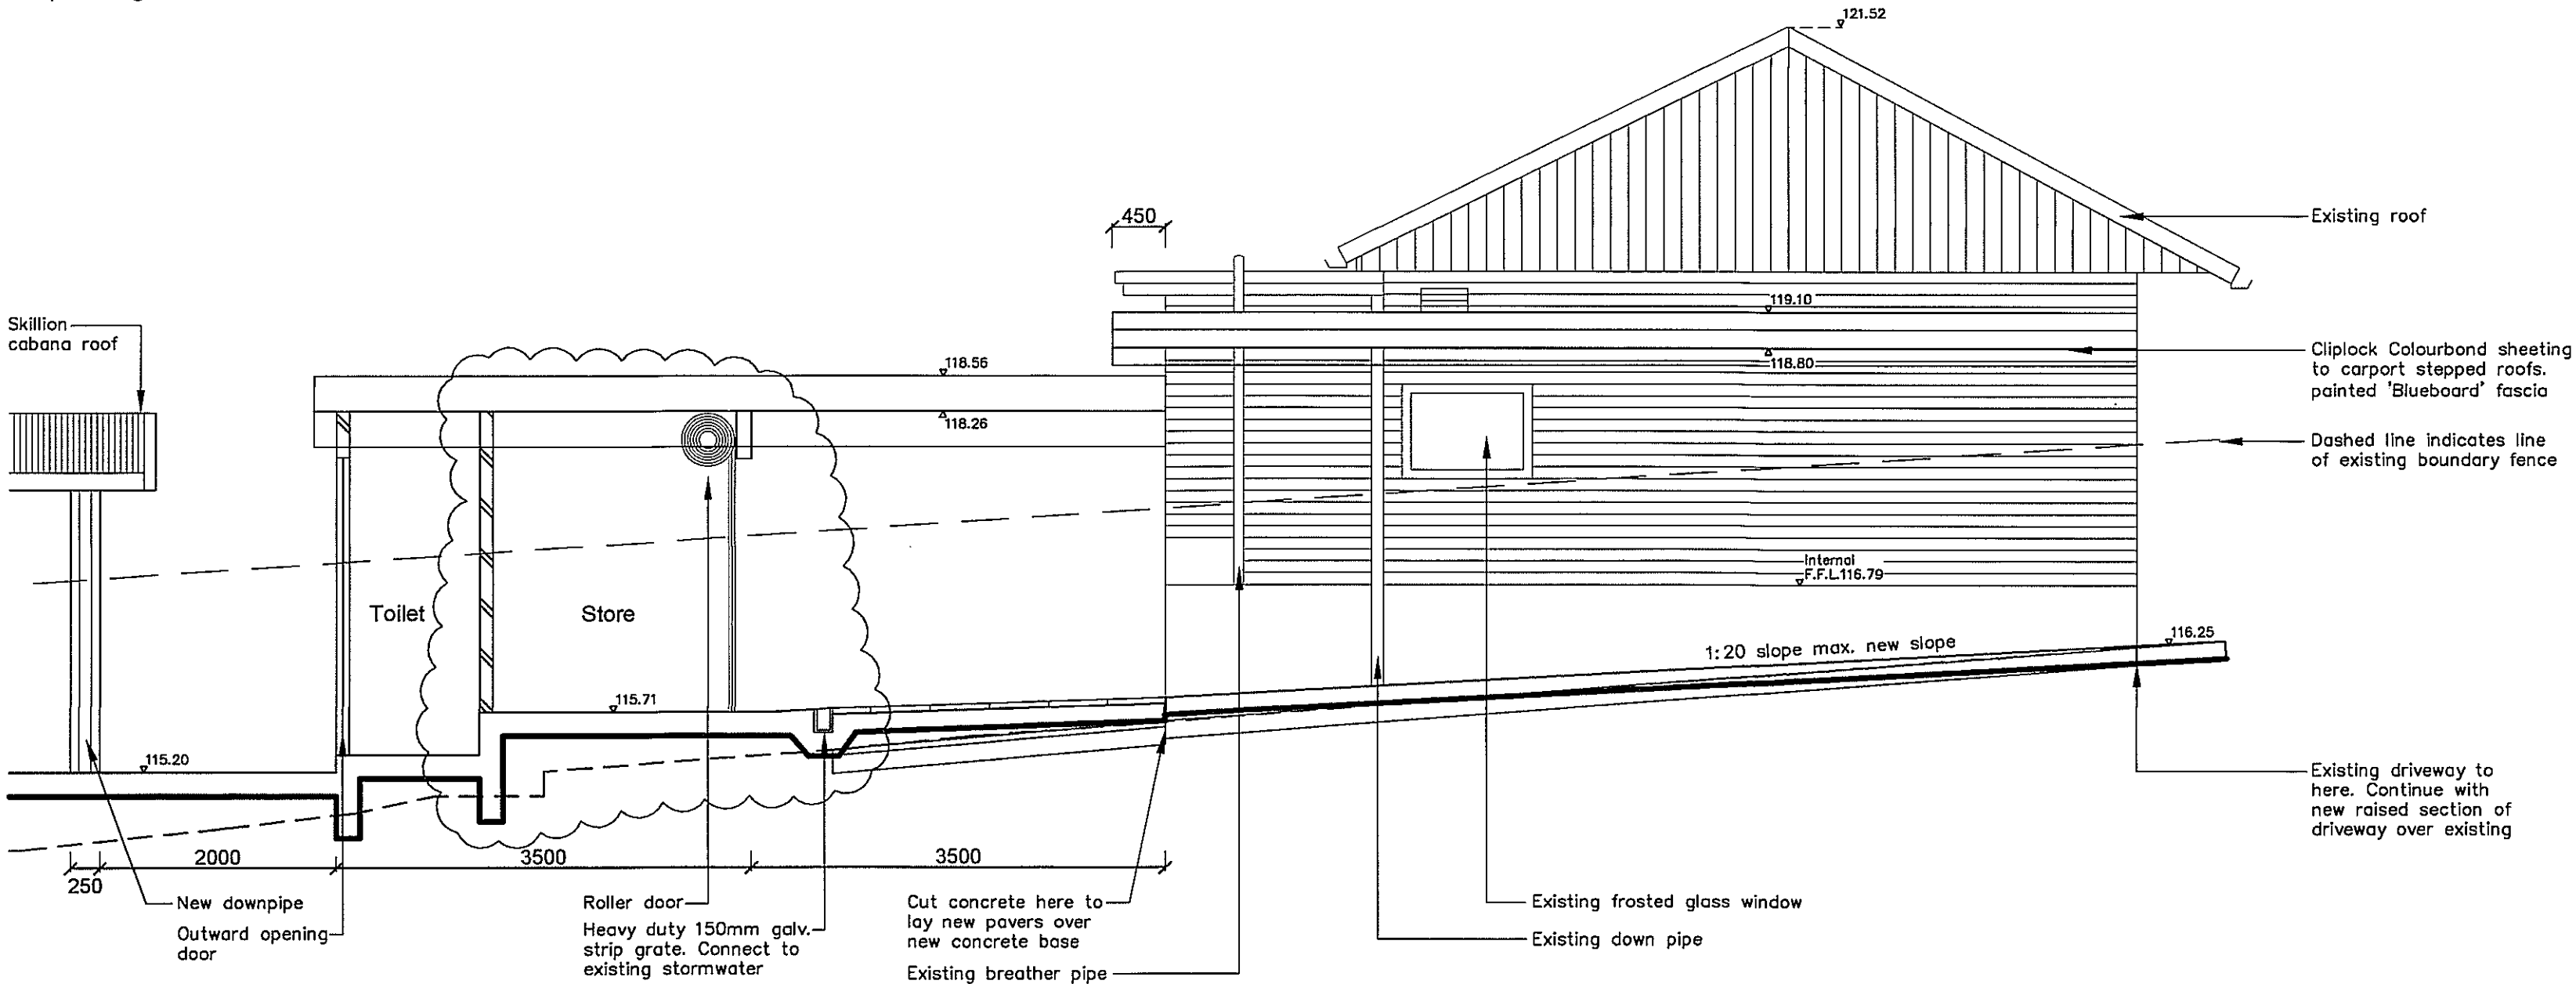

THIS PLAN IS TO BE READ
IN CONJUNCTION WITH
DA 2009 / 0683
WARRINGAH COUNCIL

Issue B:
Amendments to comply with Council issues.

- Reduce paving surfaces by 15m²
- Reduce new driveway parking fall to max 1:20 slope



PAUL SCRIVENER

LANDSCAPE ARCHITECT

PO Box 813 NEWPORT NSW 2106

ACN 070 598 882

ABN 56 070 598 882

PHONE: 02 9907 8011

FAX: 02 9948 9527

MOBILE: 0417 258 629

WWW.SCRIVENER-DESIGN.COM

EMAIL: paul@scrivener-design.com

PROJECT: POOL, CABANA & CARPORT AT

69 ROOSEVELT AVENUE

ALLAMBIE HEIGHTS

DWG: SECTIONAL ELEVATIONS (B)

DATE: 1.07.09 SCALE: 1:50@A1

JOB REF: 09/1392/DA3 SHEET No: 3 OF 6

ISSUE: B

BUILDER MUST VERIFY ALL DIMENSIONS OF THE SITE BEFORE WORK COMMENCES.


FOUNDED DIMENSIONS SHOULD BE USED IN PREFERENCE TO THOSE SCALE ONLY.

©Copyright is the property of Paul Scrivener Landscape Architects Pty Ltd A.C.N. 096 948 882.


The concepts, design, details and information described in the drawing are copyright. Other than for the purpose prescribed under the Copyright Act, no part of it may in any form or by any means be used or reproduced without prior written permission.

AMENDMENTS

Red line work indicates previous detail now amended to comply with Council requirements

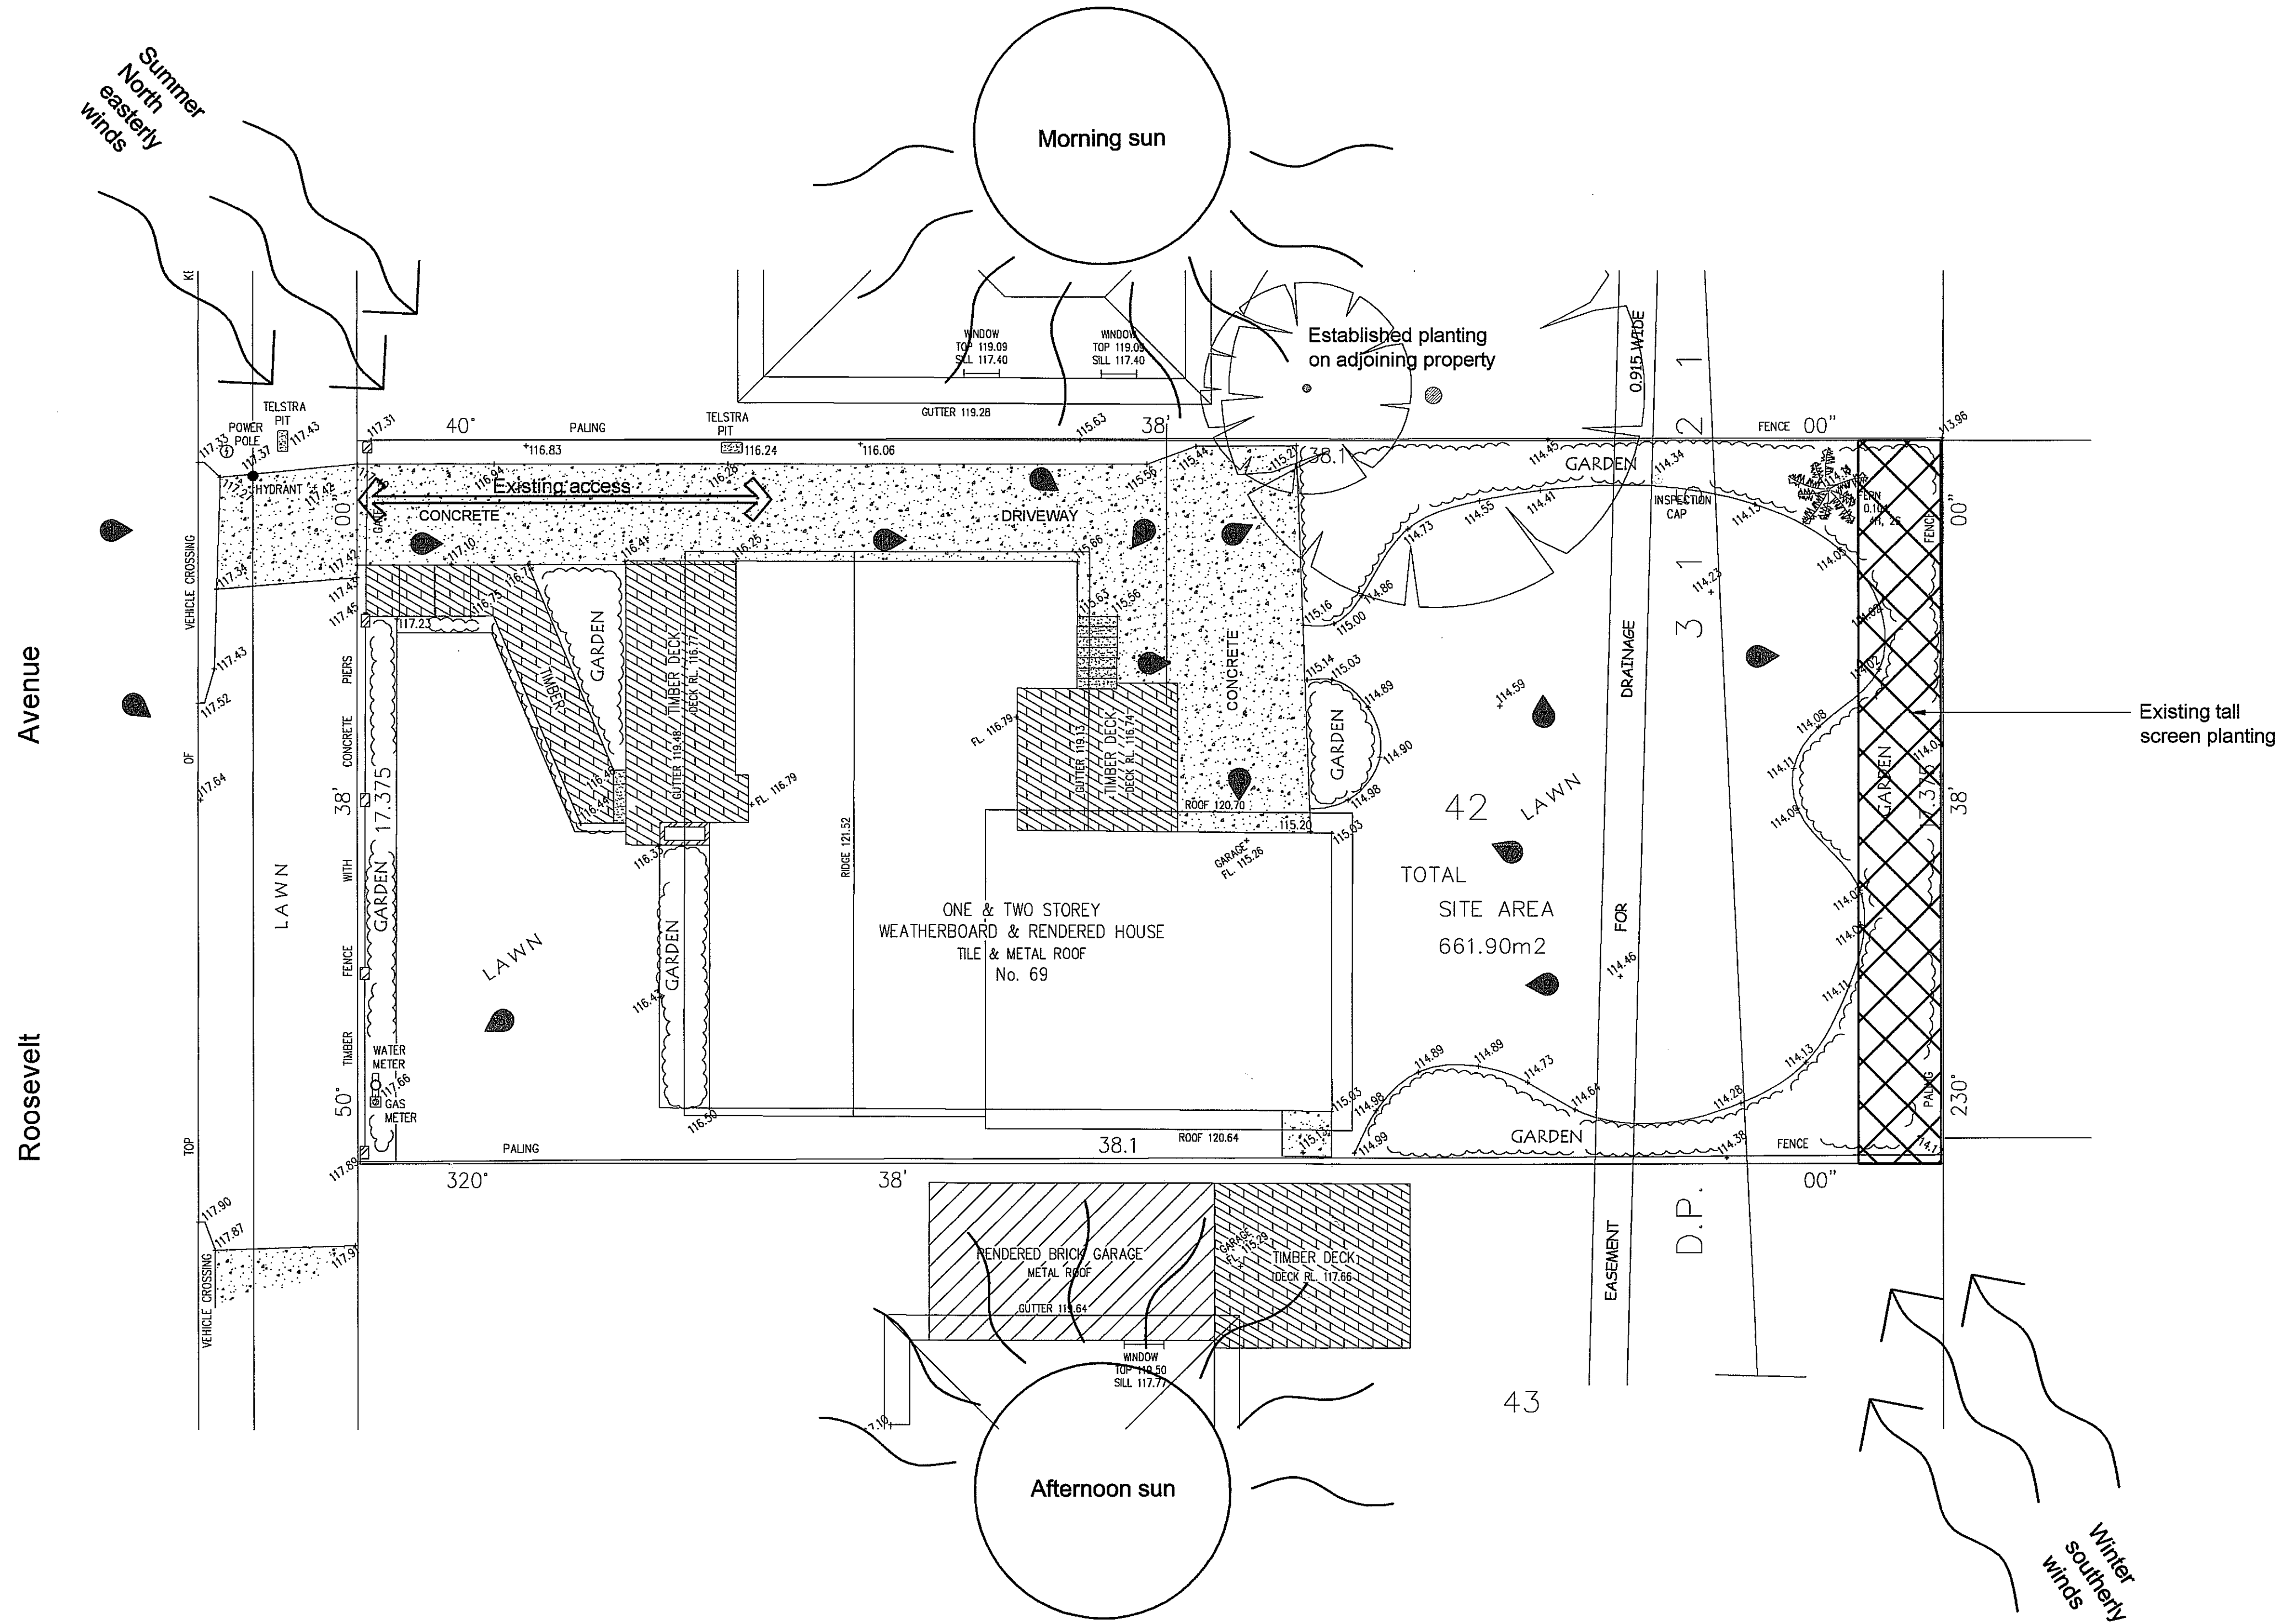

Legend

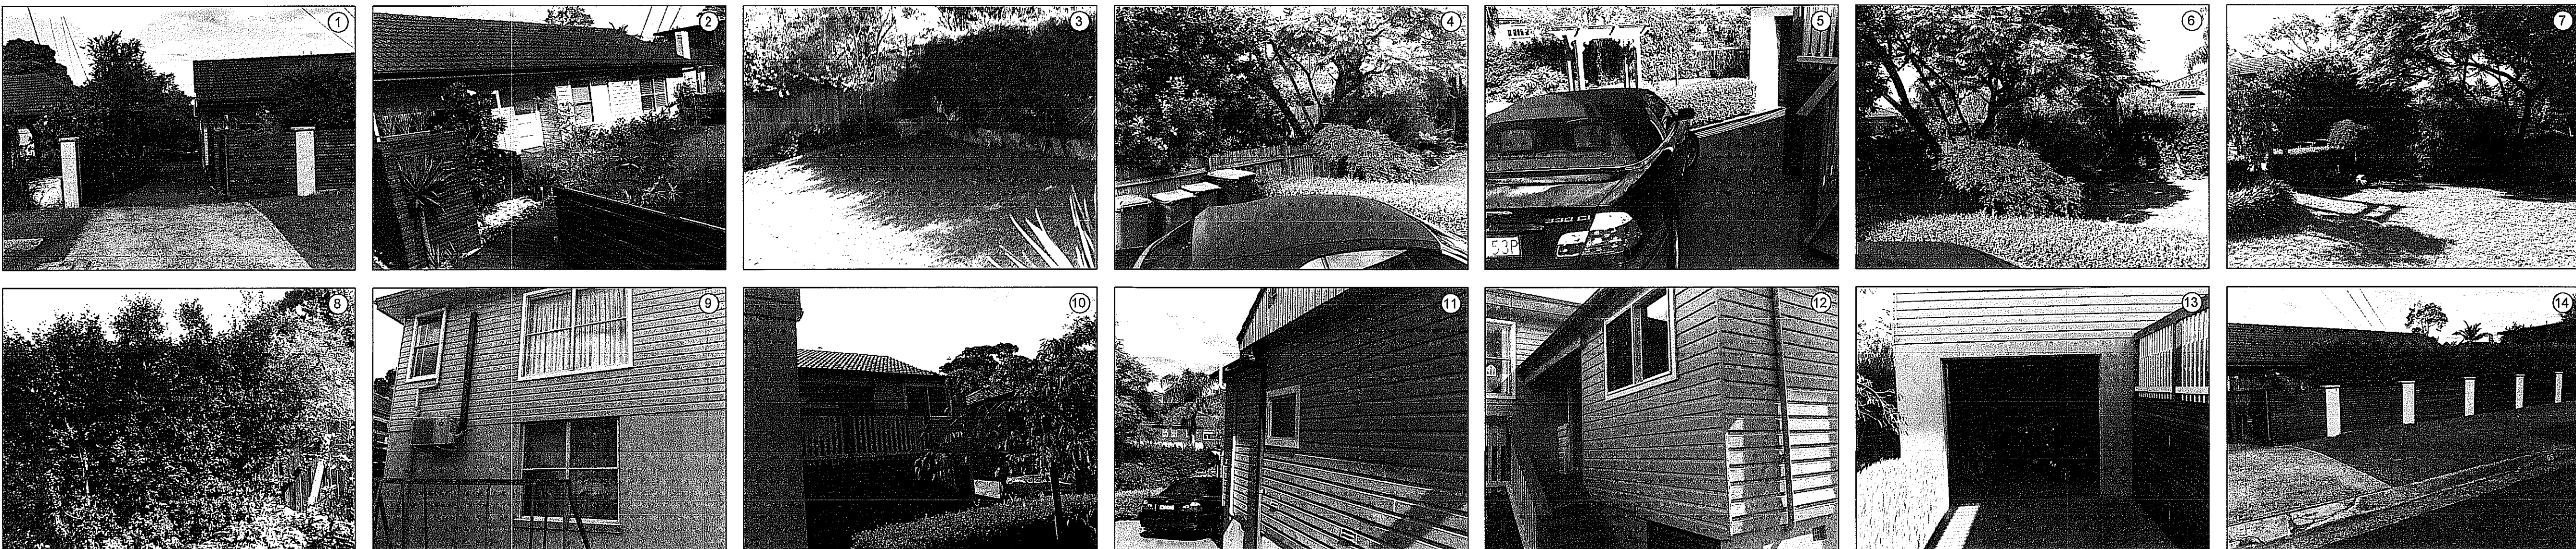

PAUL SCRIVENER

LANDSCAPE ARCHITECT

PO Box 813 NEWPORT NSW 2106
ACK 070 598 882
AIB 56 070 598 882

PHONE: 02 9907 8011
FAX: 02 9948 9527
MOBILE: 0417 258 629
www.scrivener-design.com
EMAIL: paul@scrivener-design.com

PROJECT: RESIDENTIAL DEVELOPMENT AT
69 ROOSEVALT AVENUE
ALLAMBIE HEIGHTS

DWG: SITE ANALYSIS

DATE: 27.04.09 SCALE: 1:100

JOB REF: 09/1392/DA6 SHEET No: 6 OF 6

ISSUE: A

BUILDER MUST VERIFY ALL DIMENSIONS OF THE SITE BEFORE WORK COMMENCES.
FOOTED DIMENSIONS SHOULD BE USED IN PREFERENCE TO HOIST SCALED OFF.

©Copyright is the property of Paul Scrivener Landscape Architects Pty Ltd A.C.N. 679 988 882.
The concepts, design, details and information described in the drawing are copyright. Other
than for the purposes prescribed under the Copyright Act, no part of it may in any form or by
any means be used or reproduced without prior written permission.

AMENDMENTS NORTH

