



LOCALITY PLAN



SITE PLAN

DO NOT SCALE FROM PLANS

M. 0437 275 275

P. 02 9905 5502

E. tony@styleness.com.au


W. www.styleness.com.au

S. www.linkedin.com/in/tony-johnson-aus

Unit 25, 9 Powells Road
Brookvale NSW 2100 AUSTRALIA
Builders Licence No. 361260C
ABN 37 604 270 840

styleness®

PROPERTIES
PROPERTY STYLING
PROJECT MANAGEMENT

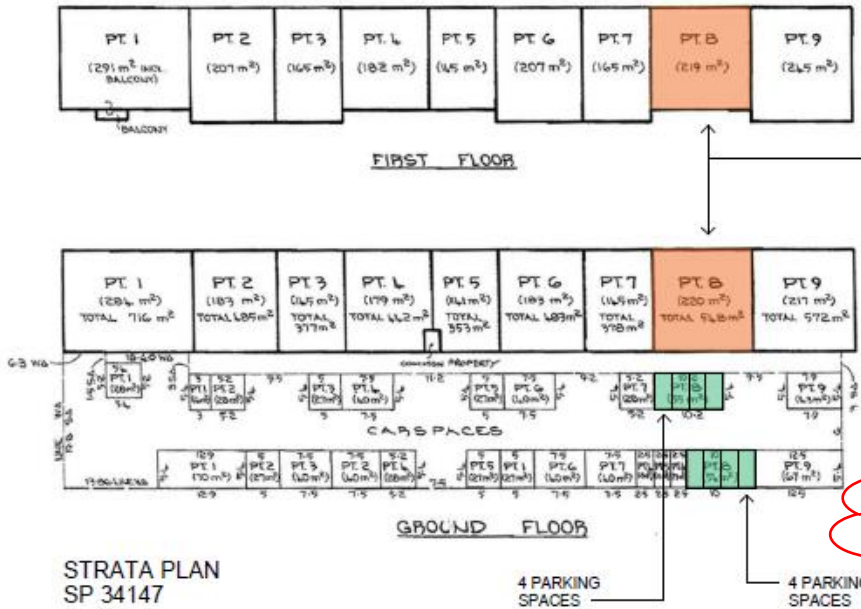

UNIT 8
I LOVE IT ENTERPRISES PTY LTD
ALLAMBIE HEIGHTS

OPERATING HOURS:
MONDAY-FRIDAY 7AM – 7PM
SATURDAY 8AM – 4PM

NUMBER OF EMPLOYEES: 8

SUMMARY OF USES:
Warehouse, Storage, Picking and Packing
of Skincare products

Commercial office component for the support
of online retail operations, such as marketing,
inventory management and customer service.

Health services facility used to provide other
services relating to the maintenance and
improvement of the health, restoration to health,
of persons and includes a health consulting room.

FRONT ELEVATION



FRONT ELEVATION (EXISTING BIN STORAGE)

PROJECT TITLE:
PROJECT No.
AT:
FOR:
DRAWING TITLE
DRAWING No.
SCALE:


ISSUE 2
DATE 29.3.21


PROPOSED CHANGE OF USE
001
8/252 ALLAMBIE ROAD ALLAMBIE HEIGHTS
I LOVE IT ENTERPRISES PTY LTD
SITE PLAN
DA02-01
AS INDICATED

DESCRIPTION
DA-02 ISSUE

DRAWN
TJ

APPROVED
DP

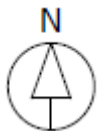

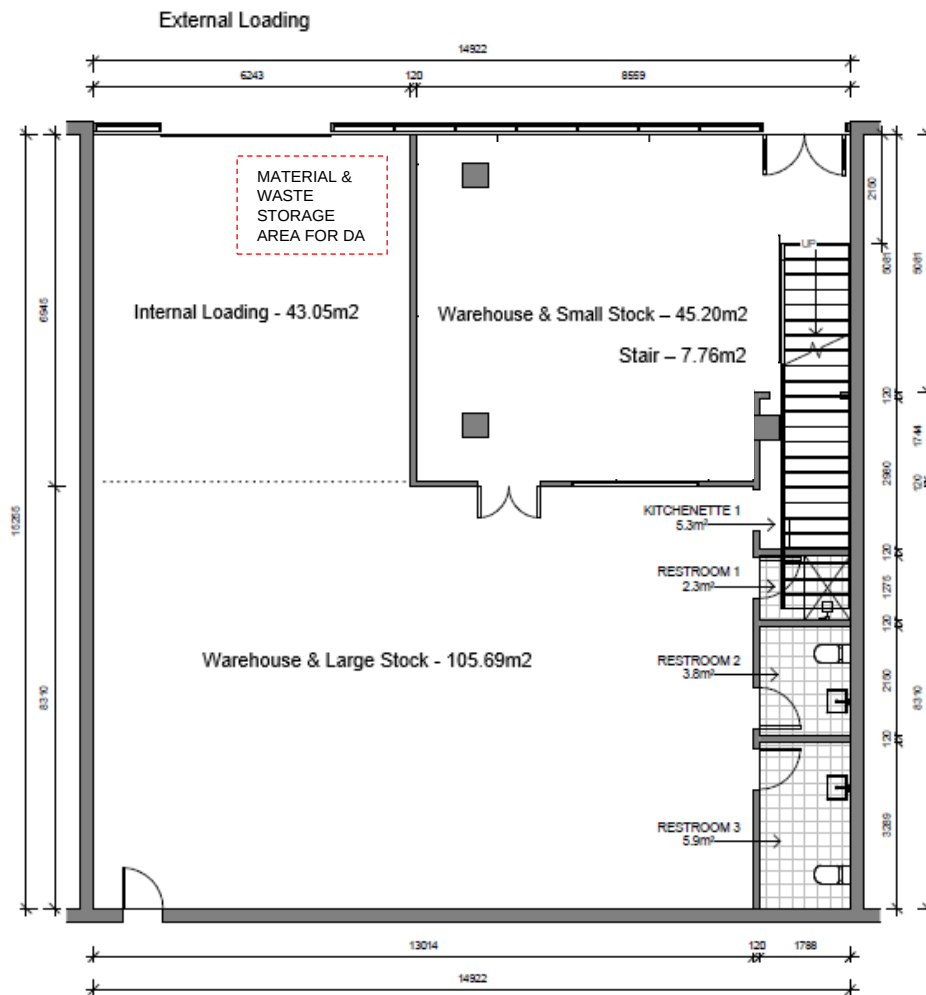


GROUND FLOOR 1:100

M. 0437 275 275
P. 02 9905 5502
E. tony@styleness.com.au
W. www.styleness.com.au
S. www.linkedin.com/in/tony-johnson-aus

Unit 25, 9 Powells Road
Brookvale NSW 2100 AUSTRALIA
Builders Licence No. 361260C
ABN 37 604 270 840

styleness®

PROPERTIES
PROPERTY STYLING
PROJECT MANAGEMENT

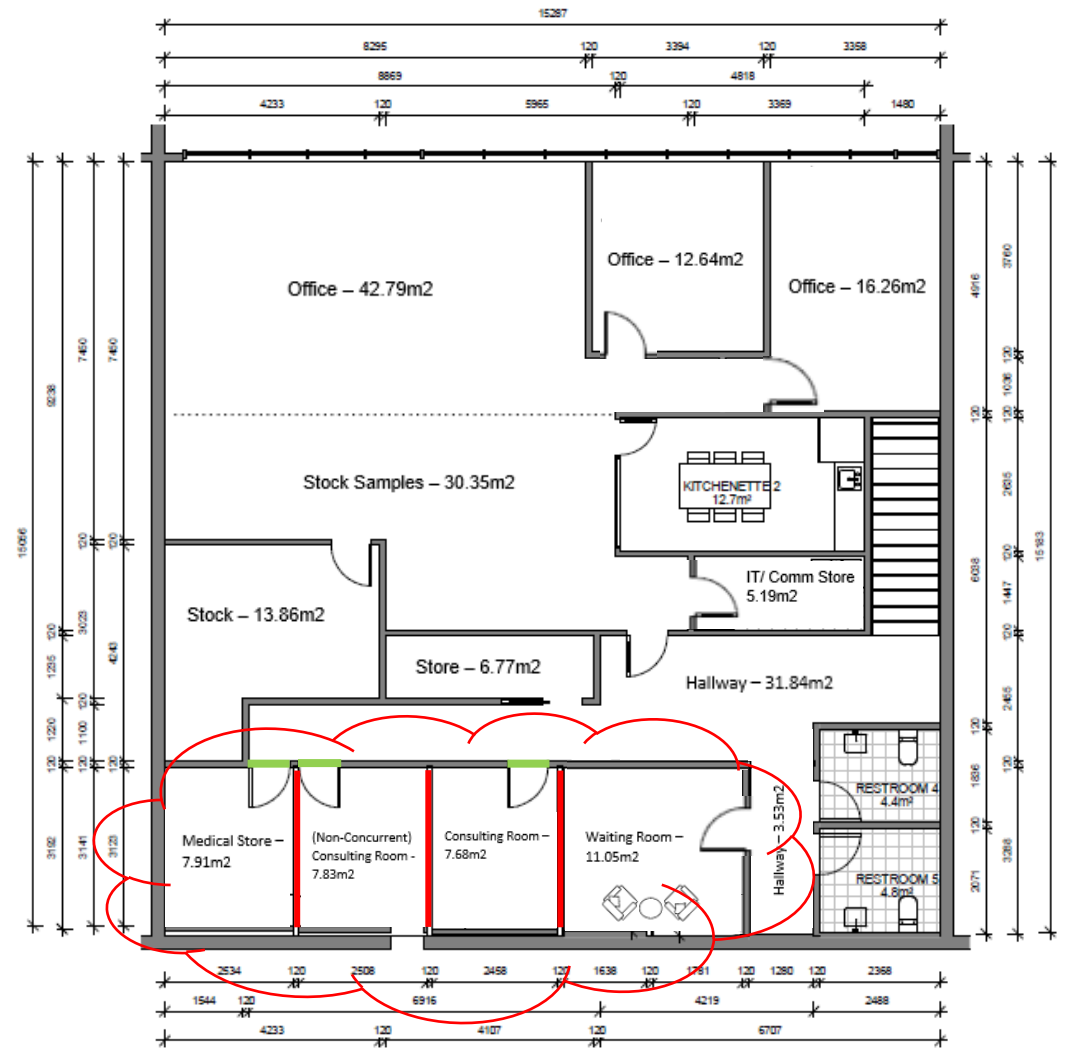

FIRST FLOOR 1:100 DO NOT SCALE FROM PLANS

NOTE: WALL SECTION TO BE DEMOLISHED SHOWN IN GREEN
NOTE: NEW WALLS SHOWN RED WITHIN CLOUDED SECTION

PROJECT TITLE:
PROJECT No.
AT:
FOR:
DRAWING TITLE
DRAWING No.
SCALE:

PROPOSED CHANGE OF USE
001
8/252 ALLAMBIE ROAD ALLAMBIE HEIGHTS
I LOVE IT ENTERPRISES PTY LTD
FLOOR PLANS
DA02-02
AS INDICATED

ISSUE
2
DATE
29.3.21

DESCRIPTION
DA-02 ISSUE

DRAWN
TJ

APPROVED
DP





SIGNAGE 1:20

DO NOT SCALE FROM PLANS

M. 0437 275 275
P. 02 9905 5502
E. tony@styleness.com.au
W. www.styleness.com.au
S. www.linkedin.com/in/tony-johnson-aus

Unit 25, 9 Powells Road
Brookvale NSW 2100 AUSTRALIA
Builders Licence No. 361260C
ABN 37 604 270 840

styleness®

PROPERTIES
PROPERTY STYLING
PROJECT MANAGEMENT

PROJECT TITLE:
PROJECT No.
AT:
FOR:
DRAWING TITLE
DRAWING No.
SCALE:

ISSUE DATE
2 29.3.21

PROPOSED CHANGE OF USE
001
8/252 ALLAMBIE ROAD ALLAMBIE HEIGHTS
I LOVE IT ENTERPRISES PTY LTD
BUSINESS IDENTIFICATION SIGNAGE
DA02-03
AS INDICATED

DESCRIPTION	DRAWN	APPROVED
DA-02 ISSUE	TJ	DP



LOCALITY PLAN



SITE PLAN


DO NOT SCALE FROM PLANS

M. 0437 275 275
P. 02 9905 5502
E. tony@styleness.com.au
W. www.styleness.com.au
S. www.linkedin.com/in/tony-johnson-aus

Unit 25, 9 Powells Road
Brookvale NSW 2100 AUSTRALIA
Builders Licence No. 361260C
ABN 37 604 270 840

styleness®

PROPERTIES
PROPERTY STYLING
PROJECT MANAGEMENT

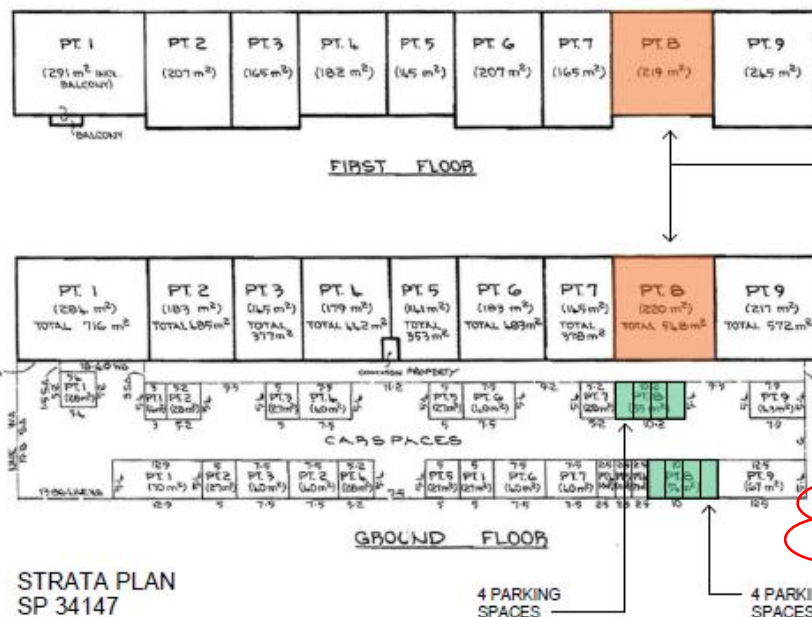

UNIT 8
I LOVE IT ENTERPRISES PTY LTD
ALLAMBIE HEIGHTS

OPERATING HOURS:
MONDAY-FRIDAY 7AM – 7PM
SATURDAY 8AM – 4PM

NUMBER OF EMPLOYEES: 8

SUMMARY OF USES:
Warehouse, Storage, Picking and Packing
of Skincare products

Commercial office component for the support
of online retail operations, such as marketing,
inventory management and customer service.

Health services facility used to provide other
services relating to the maintenance and
improvement of the health, restoration to health,
of persons and includes a health consulting room.

FRONT ELEVATION



FRONT ELEVATION



SIGNAGE

PROJECT TITLE:
PROJECT No.
AT:
FOR:
DRAWING TITLE
DRAWING No.
SCALE:

PROPOSED CHANGE OF USE
001
8/252 ALLAMBIE ROAD ALLAMBIE HEIGHTS
I LOVE IT ENTERPRISES PTY LTD
NOTIFICATION PLAN
DA02-04
AS INDICATED

ISSUE
2
DATE
29.3.21

DESCRIPTION
DA-02 ISSUE

DRAWN
TJ

APPROVED
DP

