

LEGEND:

SEWER MAIN AND DIRECTION OF FLOW

SYDNEY WATER SEWER MAN-HOLE

MAINTENANCE SHAFT

RODDING POINT

VENTSHAFT (INDUCT OR EDUCT)

VERTICAL RISER

P.C.P. OR JUNCTION

POTABLE WATER MAIN

HYDRANT

STOP VALVE

DUCTILE IRON CEMENT LINED

EARTHENWARE

REINFORCED CONCRETE

SALT GLAZED WARE

VITRIFIED CLAY

S.O.

TIE

PEG

NAIL

BDY

EX.

DN

PEG

SQUARE OFF

TIE MEASUREMENT FROM CORNER

PEG IN GROUND

NAIL IN GROUND OR ON WALL

BOUNDARY

EXISTING

DIAMETER

PEG

PEG-OUT / SERVICE PROTECTION REPORT

A3 - SIZE SHEET

ELECTRONIC DETECTION USED TO LOCATE COUNCIL STORM WATER ON SITE.

NOTES:

1. CONTRACTOR TO CONFIRM LINE, LEVEL AND SIZE OF ALL THE EXISTING SERVICES (AS PER NOTE ON PLAN) WITHIN THE VICINITY OF ANY NEW WORKS AND REPORT ANY CONFLICT TO SITE SUPERINTENDENT PRIOR TO ANY CONSTRUCTION COMMENCING

2. Ausflow PTY LTD (ABN: 86 097 766 428)  
Ph: (02) 9555 7979  
12.1, 160 Bourke Road, Alexandria NSW 2015  
Email: info@ausflowsydney.com.au  
Web: www.ausflowsydney.com.au  
ACCREDITED AS SERVICE PROTECTION REPORTER BY SYDNEY WATER

 




 


 


 










3. THE LOCATION OF THE ASSETS SPECIFIED ON THIS REPORT HAVE BEEN TAKEN FROM EXISTING FENCE LINES AND/OR SURVEYORS MARKINGS OR PEGS. FENCE LINES MAY NOT BE TRUE BOUNDARY LINES AND MAY NEED TO BE CONFIRMED BY SURVEYOR.

4. THIS PLAN IS NOT TO SCALE, DO NOT SCALE FROM THIS PLAN REFER DIMENSIONS SHOWN

PLAN TO BE READ IN CONJUNCTION WITH CURRENT SURVEY PLAN	UTILITIES LOCATED:				SITE STRATA (CIRCLE APPLICABLE)								PROPERTY ADDRESS:		PLAN SUPPLIED BY:	
	SERVICE	DATE	SIZE (mm)	TYPE	CLAY	ROCK	ROCK TRENCH	SAND	SHALE	TUNNEL	RUBBISH FILL	OTHER (SPECIFY)	LOT: CP No. 149 Street name: Condamine Street, Suburb: Balgowlah			
	EXISTING SEWER:	-	-	-								-				
	COUNCIL STORM WATER ASSET:	8/04/25	600	CONC												
	STORMWATER: SWD	-	-	-												
POTABLE WATER:	-	-	-										SHEET 1 OF 1		REVISION No. 1	
PRIOR TO COMMENCEMENT OF EXCAVATION FOR PROPOSED AND / OR EXISTING SERVICES CONTACT: DIAL BEFORE YOU DIG Ph. 1100 ELECTRICITY AUSGRID Ph. 4951 4555 GAS AGILITY Ph. 132 909 TELECOMM. TELSTRA Ph. 9204 0880 GIVE AT LEAST 48 HOURS NOTICE					I Gabriel Austin, of Ausflow Pty Ltd, being accredited to carry out a Service Protection Report, certify that the information shown on the report is accurate and has been prepared in accordance with the relevant instructions.  LOCATOR: Gabriel Austin LOCATOR SIGNATURE:											

DRAFTED BY: PG/CO

LEGEND:

	SEWER MAIN AND DIRECTION OF FLOW		POTABLE WATER MAIN		S.O. SQUARE OFF
	SYDNEY WATER SEWER MAN-HOLE		HYDRANT		TIE TIE MEASUREMENT FROM CORNER
	MAINTENANCE SHAFT		STOP VALVE		PEG PEG IN GROUND
	RODDING POINT		DICL DUCTILE IRON CEMENT LINED		NAIL NAIL IN GROUND OR ON WALL
	VENTSHAFT (INDUCT OR EDUCT)		EW EARTHENWARE		BDY BOUNDARY
	VERTICAL RISER		RC REINFORCED CONCRETE		EX. EXISTING
	P.C.P. OR JUNCTION		SGW SALT GLAZED WARE		DN DIAMETER PEG
			VC VITRIFIED CLAY		


PEG-OUT / SERVICE PROTECTION REPORT



A3 - SIZE SHEET

SEWER SHALLOW ON SITE  
GROUND LEVEL  
FLUCTUATES ON SITE AS  
A RESULT DEPTH OF  
SEWER Varies  
ELECTRONIC DETECTION USED TO LOCATE  
SEWER MAIN ON SITE.

NOTES:

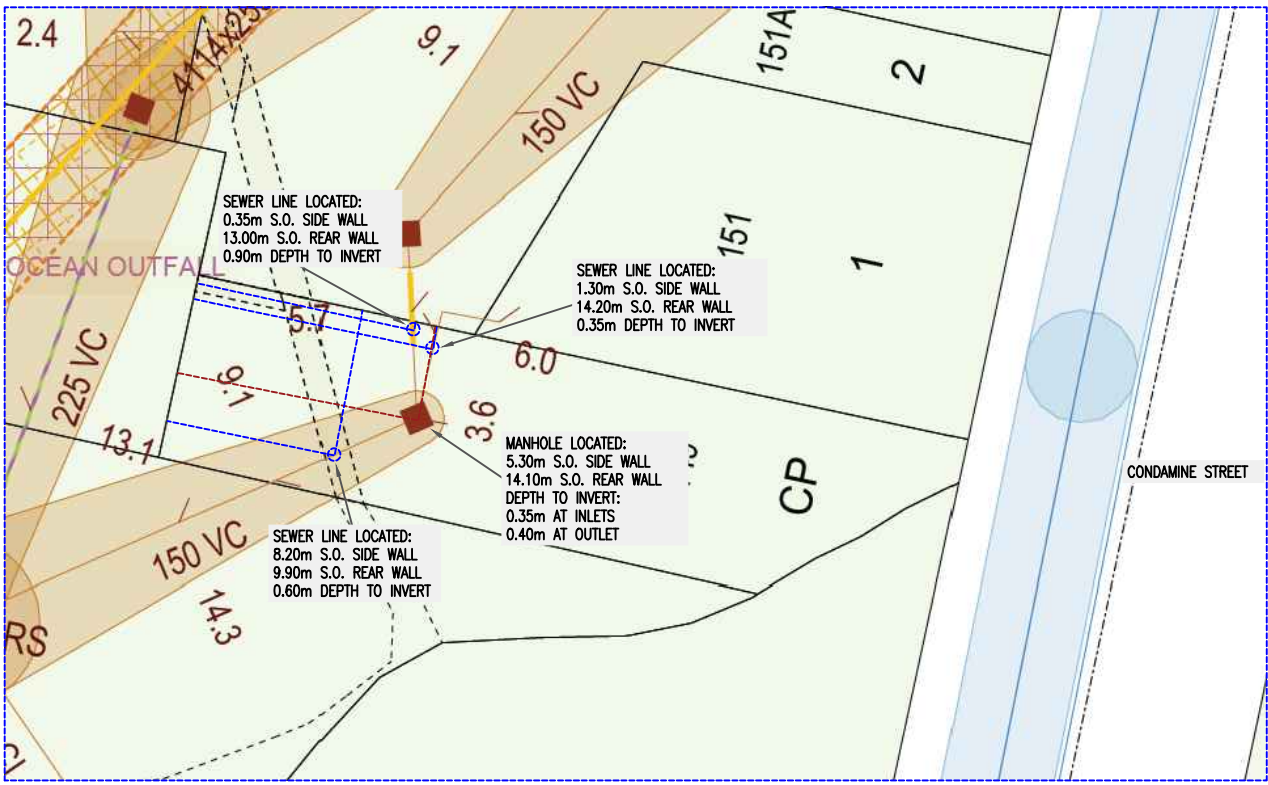1. CONTRACTOR TO CONFIRM LINE, LEVEL AND SIZE OF ALL THE EXISTING SERVICES (AS PER NOTE ON PLAN) WITHIN THE VICINITY OF ANY NEW WORKS AND REPORT ANY CONFLICT TO SITE SUPERINTENDENT PRIOR TO ANY CONSTRUCTION COMMENCING
2. Ausflow PTY LTD (ABN: 86 097 766 428)  
Ph: (02) 9555 7979  
Level 1, 323a Darling Street, Balmain NSW 2041  
Email: info@ausflowsydney.com.au  
Web: www.ausflowsydney.com.au  
ACCREDITED AS SERVICE PROTECTION REPORTER BY SYDNEY WATER
3. THE LOCATION OF THE ASSETS SPECIFIED ON THIS REPORT HAVE BEEN TAKEN FROM EXISTING FENCE LINES AND/OR SURVEYORS MARKINGS OR PEGS. FENCE LINES MAY NOT BE TRUE BOUNDARY LINES AND MAY NEED TO BE CONFIRMED BY SURVEYOR.
4. THIS PLAN IS NOT TO SCALE. DO NOT SCALE FROM THIS PLAN REFER DIMENSIONS SHOWN



PLAN TO BE READ IN CONJUNCTION WITH CURRENT SURVEY PLAN	UTILITIES LOCATED:				SITE STRATA (CIRCLE APPLICABLE)							PROPERTY ADDRESS:	PLAN SUPPLIED BY:	
	SERVICE	DATE	SIZE (mm)	TYPE	CLAY	ROCK	ROCK TRENCH	SAND	SHALE	TUNNEL	RUBBISH FILL	OTHER (SPECIFY)	LOT: CP No. 149 Street name: Condamine Street, Suburb: Balgowlah	
PRIOR TO COMMENCEMENT OF EXCAVATION FOR PROPOSED AND / OR EXISTING SERVICES CONTACT: DIAL BEFORE YOU DIG Ph. 1100 ELECTRICITY AUSGRID Ph. 4951 4555 GAS AGILITY Ph. 132 909 TELECOMM TELSTRA Ph. 9204 0880 GIVE AT LEAST 48 HOURS NOTICE	EXISTING SEWER:	10/10/24	150	VC										
	COUNCIL STORM WATER ASSET:	-	-	-										
	STORMWATER: SWD	-	-	-										
	POTABLE WATER:	-	-	-										
		-	-	-										
					I Gabriel Austin, of Ausflow Pty Ltd, being accredited to carry out a Service Protection Report, certify that the information shown on the report is accurate and has been prepared in accordance with the relevant instructions.  LOCATOR: Gabriel Austin LOCATOR SIGNATURE: 							SHEET 1 OF 1 REVISION No. 1		

DRAFTED BY: PG/LT