


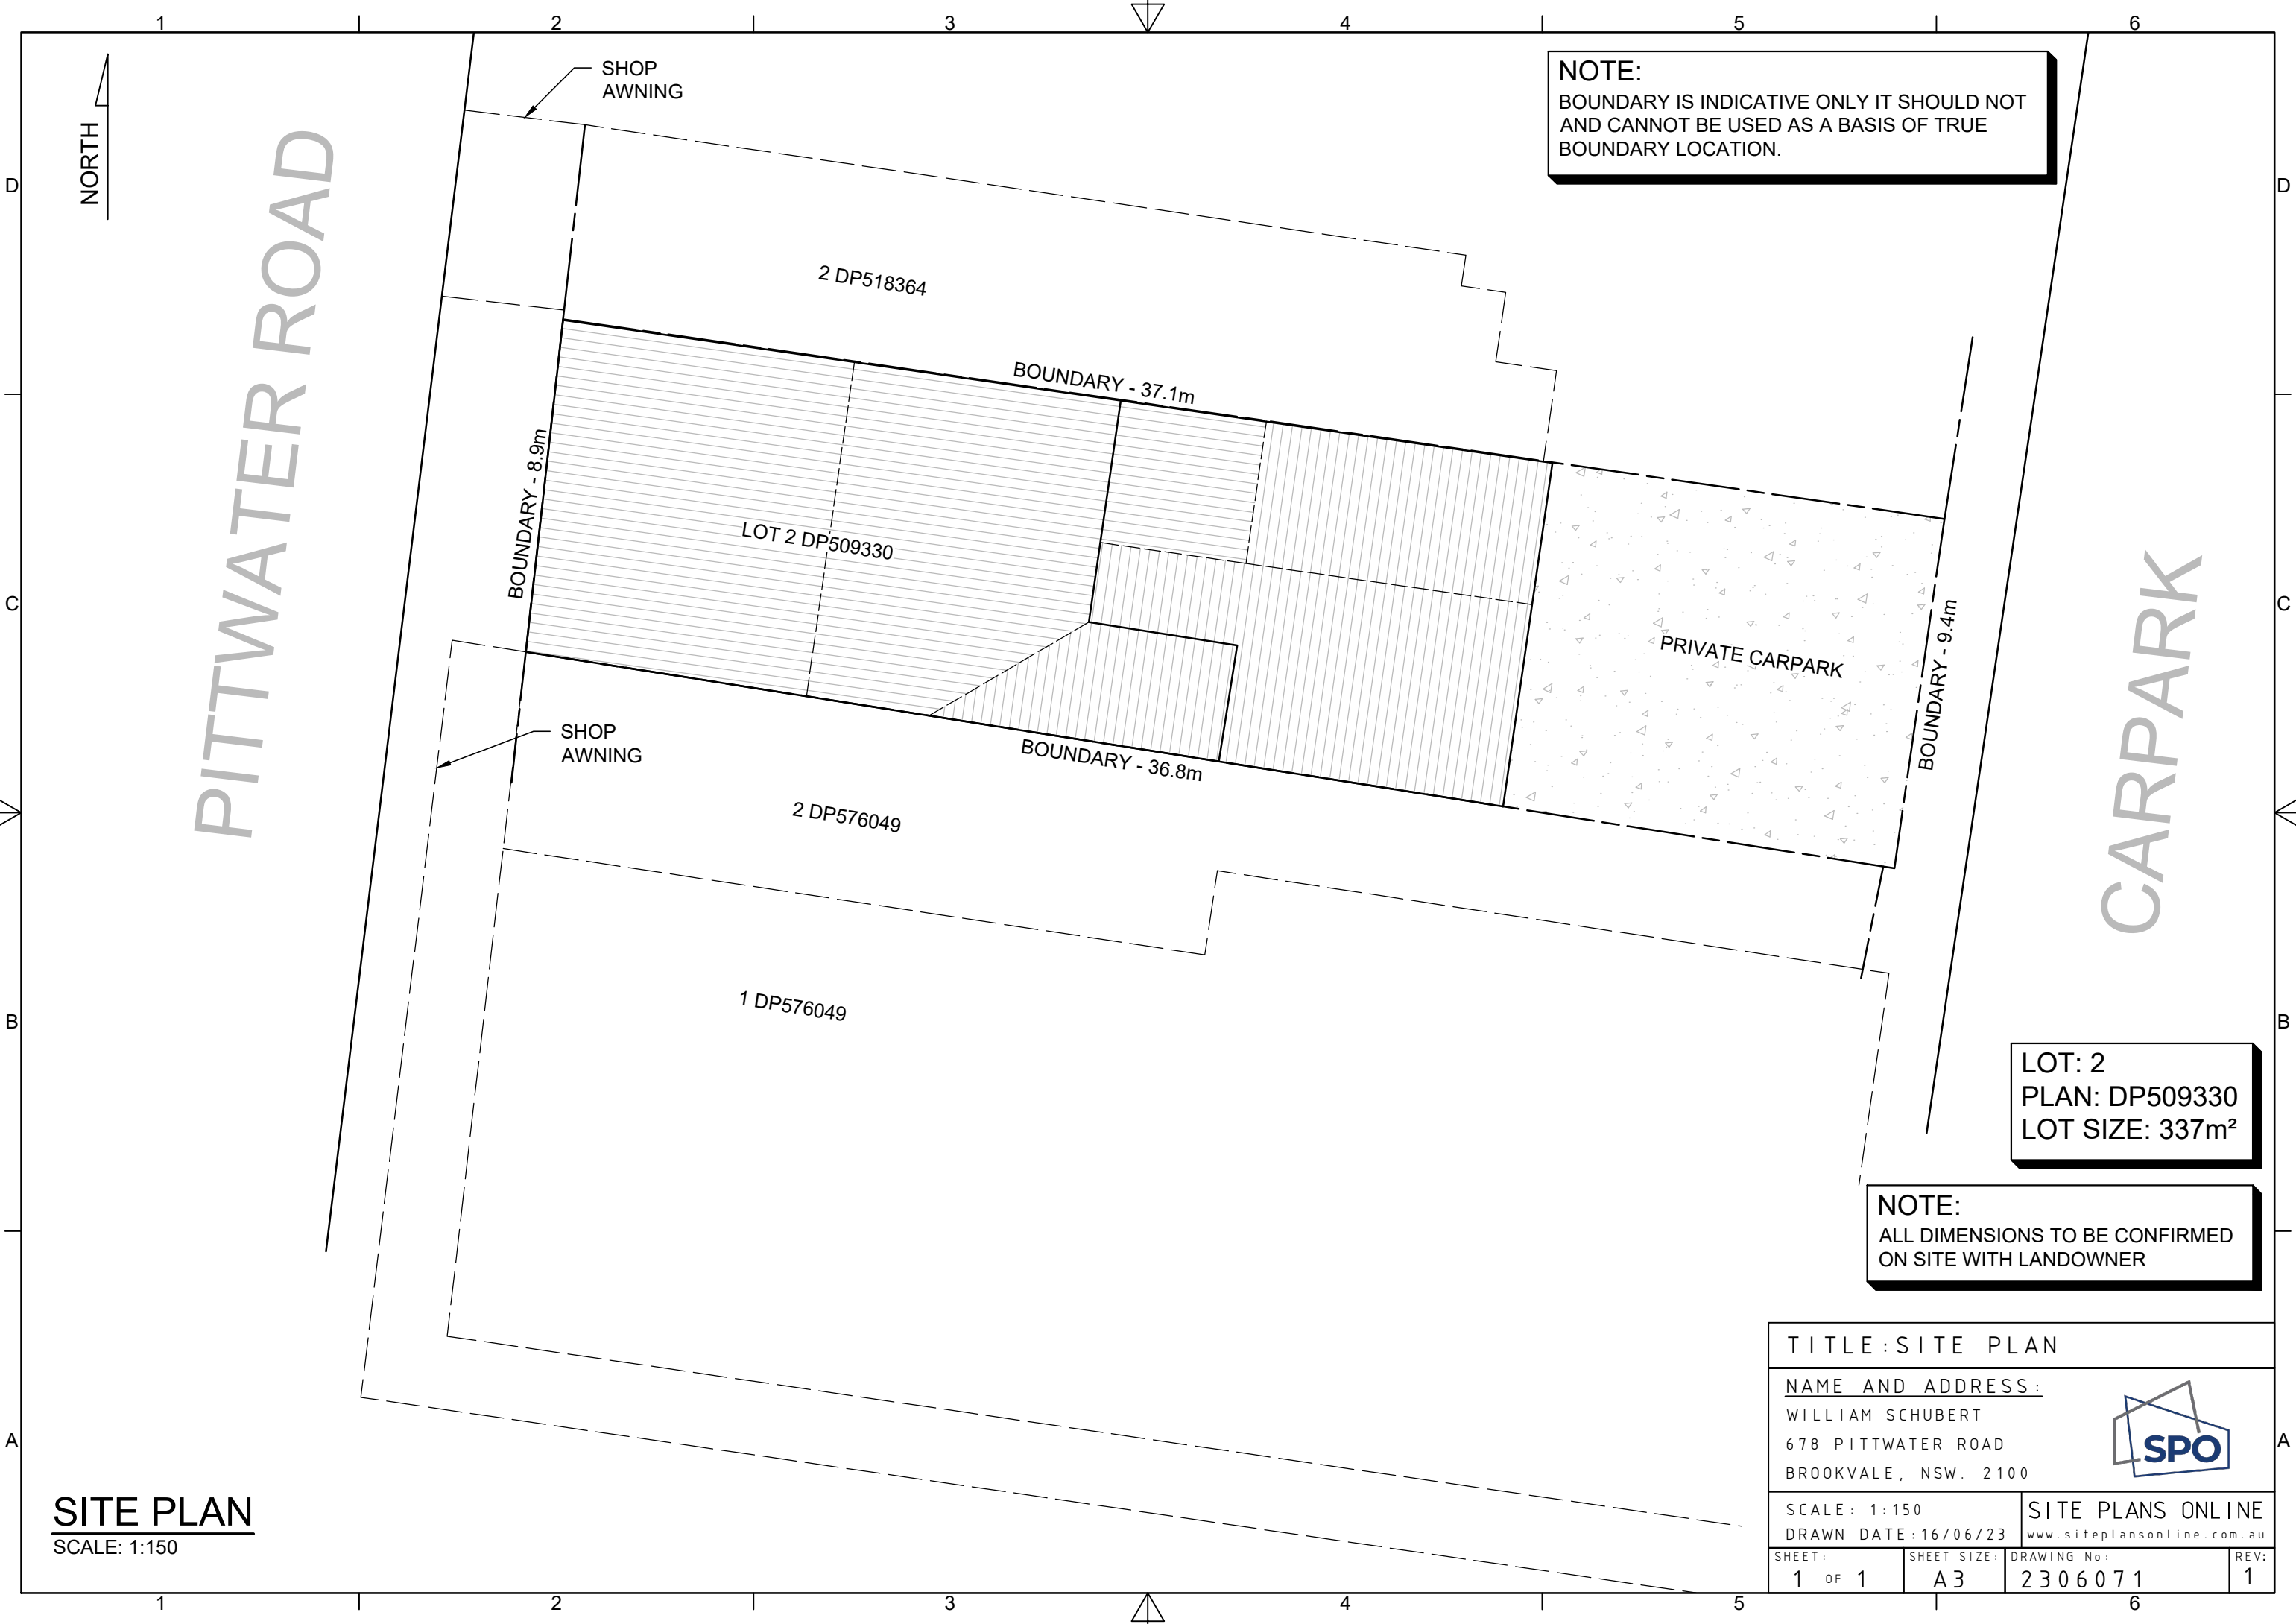

NOTE:
BOUNDARY IS INDICATIVE ONLY IT SHOULD NOT
AND CANNOT BE USED AS A BASIS OF TRUE
BOUNDARY LOCATION.


LOT: 2
PLAN: DP509330
LOT SIZE: 337m²

NOTE:
ALL DIMENSIONS TO BE CONFIRMED
ON SITE WITH LANDOWNER

SITE PLAN
SCALE: 1:150

TITLE: SITE PLAN			
NAME AND ADDRESS:			
WILLIAM SCHUBERT			
678 PITTWATER ROAD			
BROOKVALE, NSW. 2100			
SCALE: 1:150		SITE PLANS ONLINE	
DRAWN DATE: 16/06/23		www.siteplansonline.com.au	
SHEET:	SHEET SIZE:	DRAWING No:	REV:
1 OF 1	A3	2306071	1



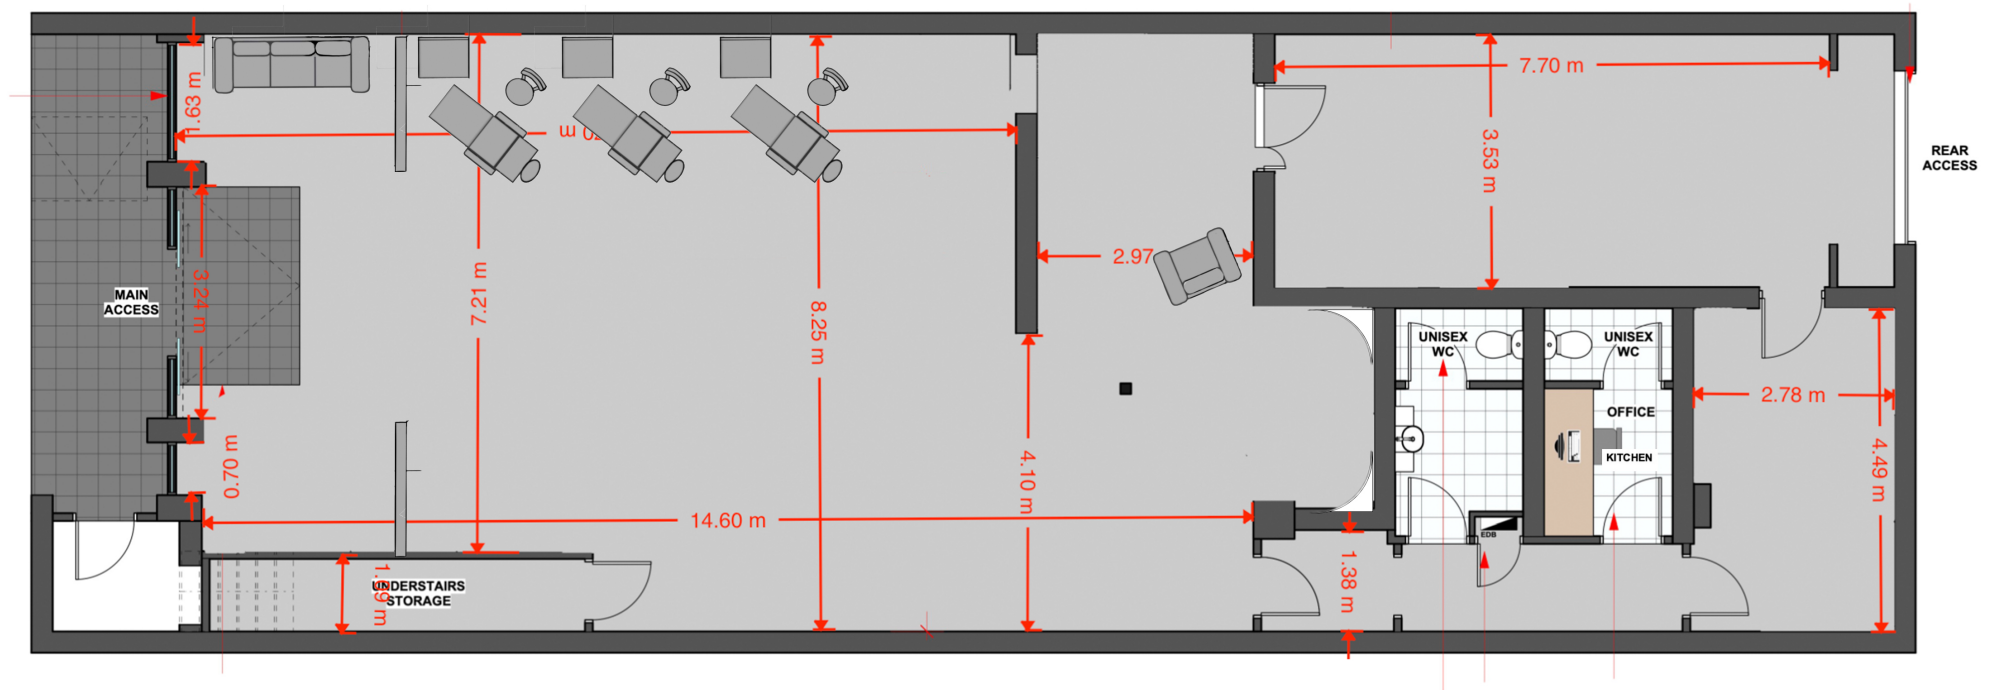

NOTES

Total Area	202m ²
Main floor area	188m ²
Toilets & Office	14m ²


EQUIPMENT

PLEASE NOTE: This plan is a reference to the internal warm shell of Pittwater Road only. The external walls shown in red are strictly indicative and are for visual effect only. These walls do not represent what is built on site and should not be used for any remedial works. Any works required to be undertaken regarding the external walls must be completed using separate site measurements not provided in this plan.

Brand	AQUATICA TATTOO
Project	Brookvale
Location	678 Pittwater Road, Brookvale, NSW 2100

Revision	SURVEYED BY: SS SURVEYED ON: 10/6/23
	DRAWN BY: SS DRAWN ON: 10/6/23
	HOR DATUM: SITE VERT DATUM: N/A
This plan has been produced to establish the base measurements of the warm shell. The document may only be used for the purpose that it was commissioned & in accordance with the terms of engagement for the commission. Unauthorised use of this document in anyway is prohibited.	

Issue

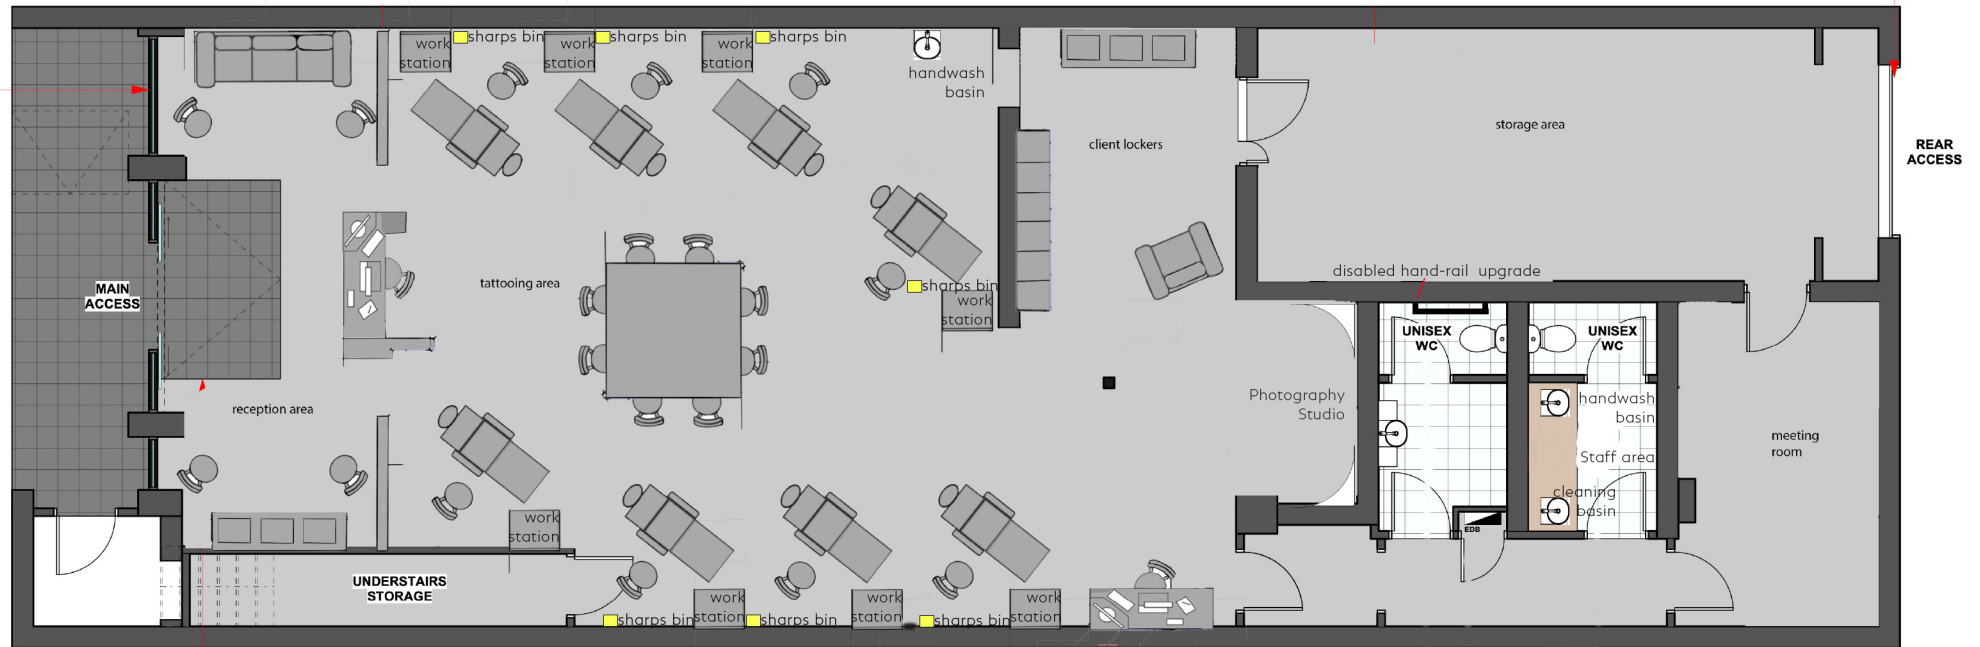

NOTES

Total Area	202m ²
Main floor area	188m ²
Toilets & Office	14m ²

PLEASE NOTE: This plan is a reference to the internal warm shell of 678 Pittwater Road only. The external walls shown in red are strictly indicative and are for visual effect only. These walls do not represent what is built on site and should not be used for any remedial works. Any works required to be undertaken regarding the external walls must be completed using separate site measurements not provided in this plan.

Brand	AQUATICA TATTOO
Project	Brookvale
Location	678 Pittwater Road, Brookvale, NSW 2100

Revision	SURVEYED BY: SS SURVEYED ON: 10/6/23
	DRAWN BY: SS DRAWN ON: 10/6/23
	HOR DATUM: SITE VERT DATUM: N/A

This plan has been produced to establish the base measurements of the warm shell. The document may only be used for the purpose that it was commissioned & in accordance with the terms of engagement for the commission. Unauthorised use of this document in anyway is prohibited.