DRAWING LIST

| | DRAWING No. | DRAWING NAME | REVISION |
|----|-------------|---|-------------|
| DA | 1001 | COVER SHEET | (°C |
| DA | 1002 | COMPLIANCE TABLE | } c. |
| DA | 1003 | UNIT SCHEDULE | C. |
| DA | 1005 | SITE PLAN | C |
| DA | 1007 | DEMOLITION PLAN | C |
| DA | 1011 | SITE ANALYSIS - TRANSPORT, AMENITY & NETWORK ANALYSIS | A |
| DA | 1012 | SITE ANALYSIS PLAN | A |
| DA | 1013 | SITE ANALYSIS - BUILT FORM | A |
| DA | 1014 | SITE ANALYSIS - EXISTING STREETSCAPE | A |
| DA | 1015 | SITE ANALYSIS - OPPORTUNITIES & CONSTRAINTS | A |
| DA | 1101 | GROUND FLOOR PLAN | В |
| DA | 1102 | LEVEL 1 FLOOR PLAN | (C) |
| DA | 1103 | LEVEL 2 FLOOR PLAN | ₽C- |
| DA | 1104 | LEVEL 3 FLOOR PLAN | C. |
| DA | 1105 | ROOF PLAN | C |
| DA | 2001 | NORTH & SOUTH ELEVATION | C |
| DA | 2002 | EAST & WEST ELEVATION | } c. |
| | 3001 | LONG SECTION | C. |
| DA | 3002 | CROSS SECTION | C |
| DA | 3003 | CROSS SECTION | (B |
| DA | 6001 | SHADOW DIAGRAMS | <u></u> |
| DA | 6021 | SUN ANGLE VIEWS 9AM - 21 JUNE | <u>}</u> C. |
| DA | 6022 | SUN ANGLE VIEWS 10AM - 21 JUNE | € C |
| | 6023 | SUN ANGLE VIEWS 11AM - 21 JUNE | (C |
| | 6024 | SUN ANGLE VIEWS 12PM - 21 JUNE | } c- |
| DA | 6025 | SUN ANGLE VIEWS 1PM - 21 JUNE | <u>C</u> . |
| | 6026 | SUN ANGLE VIEWS 2PM - 21 JUNE | C |
| DA | 6027 | SUN ANGLE VIEWS 3PM - 21 JUNE | (C |
| | 6028 | SOLAR SCHEDULE | } c. |
| DA | 7001 | GFA CALCULATION |) C. |
| | 7011 | SOLAR ACCESS PLAN | В |
| | 7021 | VENTILATION DIAGRAMS | (C |
| | 7035 | 3D VIEW - LANDSCAPE SHEET 1 | B · |
| | 7036 | 3D VIEW - LANDSCAPE SHEET 2 | \B_ |
| | 7041 | FINISHES SCHEDULE | A |
| | 7051 | LEP HEIGHT BLANKET | (C |
| | 7061 | 45 DEGREE BLANKET - 1 | B |
| | 7062 | 45 DEGREE BLANKET - 2 | <u>} B</u> |
| | 7063 | 45 DEGREE BLANKET - 3 | В |
| | 7080 | BUS LOCATION DIAGRAM & BUS 273 TIMETABLE | A |
| DA | 7081 | BUS ROUTE 278 TIMETABLE | A |

REFERENCES

DRAWINGS TO BE READ IN CONJUNCTION WITH BUT NOT LIMITED TO ALL STRUCTURAL ENGINEERS, STORMWATER ENGINEERS, LANDSCAPE ARCHITECTS, AND OTHER ASSOCIATED PLANS & REPORTS

REFER TO THE BASIX REPORT FOR ADDITIONAL REQUIREMENTS.

NOTES

ALL DIMENSIONS AND SETOUTS ARE TO BE VERIFIED ON SITE AND ALL OMISSIONS OR ANY DISCREPANCIES TO BE NOTIFIED TO THE ARCHITECT.

LIST OF CHANGES: 13.07.2023

C 13/07/2023 DA AMENDMENTS
B 21/03/2023 DA AMENDMENTS
A 5/12/2022 DA SUBMISSION

Rev. Date Description

Project Archi



LEVEL 2, 60 PARK STREET SYDNEY NSW 2000 P: 02 9267 2000

W: www.cdarchitects.com.au

© Copyright

The copyright of this drawing together with any other documents prepared by CD Architects (CDA) remains the property of CDA. CDA grants licence for the use of this document for the purpose for which it is intended. The licence is not transferable without permission from CDA.

Nominated Architect: Liljana Ermilova 7887, ABN. 24 243 205 327



Drawing Title
COVER SHEET

COVER SHEET

DA SUBMISSION

J22558D DA 1001 C

 Drawn by
 Checked by
 Approved by
 Date

 HF
 RJ
 ZC
 SEP. 2022

PROPOSED SENIOR HOUSING DEVELOPMENT

69 MELWOOD AVENUE, FORESTVILLE

WARRINGAH LOCAL ENVIRONMENTAL PLAN 2011

| SITE AREA | 1421m² |
|---------------------|------------------------------|
| ZONING | R2 - LOW DENSITY RESIDENTIAL |
| COUNCIL | NORTHERN BEACHES COUNCIL |
| FLOOR SPACE RATIO | 0:5:1 |
| HEIGHT OF BUILDING | 8.5m |
| MINIMUM LOT SIZE | 600m² |
| HERITAGE | NA |
| ACID SULPHATE SOILS | NA |
| KEY SITE | NA |
| FLOOD PLANNING AREA | NA |

AREA CALCULATIONS - FLOOR SPACE RATIO

| ZONE | R2 |
|---|--------------------|
| SITE AREA | 1421m² |
| PERMISSIBLE FLOOR SPACE RATIO PERMISSIBLE GFA | 0.5 : 1 710.5m² |
| PROPOSED FLOOR SPACE RATIO PROPOSED GFA | 0.591 841m² |

CAR PARKING SCHEDULE FOR WARRINGAH DCP 2011

| UNITS (7) | RATE | REQUIRED | PROPOSED |
|----------------|-----------------------|----------|----------|
| RESIDENTIAL NO | N-ADAPTABLE (5 UNITS) | | |
| 3 BED (5) | 1.5 SPACE / 1 UNIT | 6 | 8 |
| 2 BED (2) | 1.2 SPACE / 1 UNITS | 3.6 | 4 |
| VISITORS | 1 SPACE / 5 UNITS | 1.4 | 1 |
| TOTAL | | 10.6 | 13 |

| UNIT MIX | COUNT |
|-----------|-------|
| 2 BED | 3 |
| 3 BED | 4 |
| ΤΟΤΔΙ · 7 | • |

VENTILATION LEGEND

| TOTAL NUMBER OF UNITS | TARGET COMPLIANCE REQUI | PROPOSED UNITS RECEIVING REDNATURAL CROSS VENTILATION |
|--------------------------|----------------------------|--|
| 7 UNITS | 4.2 UNITS (60%) | 7 UNITS (100%) |
| \longleftrightarrow | NATURAL CROSS VENTIL | ATED APARTMENTS |
| | NATURAL CROSS VENTIL | ATED APARTMENTS |
| | NATURAL CROSS VENTIL | ATED CORRIDOR |

SOLAR ACCESS LEGEND

GLASS BIN

| TOTAL NUMBER | TARGET | PROPOSED UNITS RECEIVING |
|--------------|---|--------------------------------|
| OF UNITS | COMPLIANCE REQUIRED | |
| | | ON JUNE 21st BETWEEN 9am - 3pm |
| 7 UNITS | 4.9 UNITS (70%) | 5 UNITS (71.4%) |
| | APARTMENTS / BALCONIES RE SOLAR ACCESS ON JUNE 21St | |
| | APARTMENTS / BALCONIES RE SOLAR ACCESS ON JUNE 21St | |
| | APARTMENTS / BALCONIES RE ON JUNE 21St BETWEEN 9am - | |

WASTE CALCULATION

| | DATE OF MACE | | DIM OIZE | NO OF DINO | NO OF DING |
|----------------|---------------|---------------|----------|------------|-------------------|
| | RATE OF WAST | E TOTAL WASTE | BIN SIZE | | NO. OF BINS |
| | | | | COMPLIANCE | REQUIRED PROPOSED |
| RESIDENTIAL (7 | UNITS) | | | | |
| WASTE | 1 | 1 | 240L | 3 | 3 |
| RECYCLE | 1 | 1 | 240L | 2 | 2 |
| GLASS | 1 | 1 | 240L | 2 | 2 |
| VEGETATION | 1 | 1 | 240L | 2 | 2 |
| PROPOSED TO | ΓAL | | | | 9 |
| | | | | | |
| GENER | RAL WASTE BIN | RECYC | LE BIN | VEG | ETATION BIN |

Apartment Design Guide (ADG) Compliance Table

| ADG DESIGN CRITERIA | % | DESCRIPTION | | | TARGET | PROPOSED | COMPL |
|---|-------|---|--|--|---------------------------------------|---|--------------|
| Overall Sunlight Access to Living Rooms & Private Open Space | 70% | | ect sunlight between 9 am ar Area and in the Newcastle a | nd 3 pm at mid-winter Sydney and Wollongong LGA | 5 apartments out of 7 | 5 out of 7 units (71.4%) receiving 2 hours of solar | Yes √ |
| riosino di Finale opon opuso | 15% | Maximum 15% no direct sunlight between 9 am | | m and 3 pm at mid-winter | 1 apartments out of 7 | 0 out of 7 units (0%) | Yes √ |
| N . 10 N | 000/ | 60% o | f units should be naturally co | ross ventilated | out or r | | |
| Natural Cross Ventilation | 60% | Units at 10 storeys and allows adequate n | | Deemed to be cross ventilated | 4 apartments out of 7 | 7 out of 7 units (100%) | Yes √ |
| | | Cross-Over & Cross | s-Through units: | Maximum 18m depth | | | |
| Accessibility | 20% | Min. 20% of units requi | re incorporating the Livable universal design featur | Housing Guideline's silver level | 2 apartments out of 7 | 7 out of 7 units (100%) | Yes √ |
| Minimum Apartment Sizes | 100% | Studio | 35m² | | | Studio ≥ 35 m² | |
| | | 1 Bed | 50m² | | To Comply | 1 Bed ≥ 50 m ² | Yes √ |
| | | 2 Bed | 70m² + 5m² per extra ba | | Comply | 2 Bed ≥ 75 m² | |
| | | 3 Bed Maximum 2.5 x the ceilin | 90m² + 5m² per extra ba | th | | 3 Bed ≥ 95 m² | |
| Habitable room depths | - | Open plan layouts: 8m fr | | | Max. 8m | Max. 8m | Yes √ |
| Living rooms internal width | 100% | Studio and 1 Bed units | | 3.6m | | | |
| Living rooms internal width | 10070 | 2 Bed and 3 Bed units | | 4.0m | То | All living rooms internal | Yes √ |
| | | Cross-Over/Through unit | S | 4.0m | Comply | width comply | |
| Bedroom | 100% | Min. Dimension | | 3.0m | _ | | |
| Dimension/Area | 10070 | Master Bed Minimum Are | ea | 10m² | To Comply | All bedrooms dimension/ Area comply | Yes √ |
| (excluding wardrobe) | | Other Bed(s) Minimum A | rea | 9.0m² |] | | |
| Minimum Ceiling Heights | 100% | Habitable rooms: | | 2.7m | min. 2.7m | Comply | |
| | | Non-habitable rooms | | 2.4m | min. 2.4m | Comply | Yes 🗸 |
| | | Mixed use Ground Floor | | 3.3m | min. 3.3m | N/A | |
| Primary Balcony/Private | 100% | Studio | | 4.0m² | | | |
| Open Space Minimum Area & Dimension | | 1 Bed | | 8.0m² (min. 2m Dimension) | All balconies and P.O.S. to | | |
| & DIIIIelision | | 2 Bed 10.0m² (min. 2m Dimension) | | be provided | All the balconies and P.O.S. | Yes √ | |
| | | 3+ Bed | Name of Planta and a second second | 12.0m² (min. 2.4m Dimension) | with min requirements | provided with min requirements | |
| | | Min. Balcony depth as co area | Ground Floor or on a podium intributing to the balcony | 15.0m² (min. 3.0m Dimension) 1m | requirements | | |
| Minimum Storage Requirements | | Studio | 4.0m³ | | min. 4.0m³ | All contant and sold of contant and sold of the second of | |
| Timiniani Otorago Moquiromonto | | 1 Bed | 6.0m³ | Min. 50% inside of Unit | min. 6.0m³ | All units provided with required storage area | Yes √ |
| | | 2 Bed | 8.0m³ | 1 | min. 8.0m³ | (refer to the storage schedule) | 100 0 |
| | | 3 Bed | 10.0m³ | 1 | min.10.0m³ | | |
| Common circulation | - | Max. units off a circulation of | ore on a single level | 8 Units /Core Proffered 12 Units/Core Max. | 8 Units. | Max 3 Units. / Core | Yes √ |
| | | Min. units sharing a single lift and over | ft for building 10 storeys | 40 Units per Lift | 40 units | | 165 V |
| Building Depth | - | Max. 18m Building Depth GI | ass line to Glass Line | | 12-18m Pref. | N/A | Yes • |
| Building Separation | - | Up to 4 storeys (approx. 12m): | 12m hab. and hab. (6m to 9m hab. and non-hab. 6m non-hab rooms. (3m | , | | | |
| | | 5 to 8 storeys (approx. 25m): | 18m hab. and hab. (9m to 12m hab. and non-hab. 9m non-hab rooms. (4.5r | o side & rear boundary) n to side & rear boundary) | To Comply | COMPLY | Yes • |
| | | 9 storeys and above (over 25m): | 24m hab. and hab. (12m 18m hab. and non-hab. 12m non-hab rooms. (6m | | | | |
| | | Lower density at next door | Additional 3m setback fro | m the next door boundary | | | |
| Deep Soil Zone | 7% | 7% of site area on site | I | _ | Recommended | 413.3m²(29%) has been | |
| | | Minimum dimensions | Site area 650m - 1500m²; 3m Site area > 1500m; 6m | | DSZ =213.2m ² (15%) | proposed as deep soil zone with more than 3m depth | Yes √ |
| Communal Open Space (C.O.S.) | 25% | 25% of site area on site | | | N/A | N/A | Yes √ |
| | | (50% of C.O.S. should receive | e sunlight access for a 2 ho | urs between 9 am and 3 pm on 21 June) | N/A | N/A | Yes √ |
| RMS Car parking rates are applied for development on sites: | - | Within 800m of a railway station or light rail stop in the Sydney Metropolitan Area | | | Within 800m radius of railway station | Refer to traffic report | Yes √ |
| | | 0-1111 | 100 (1 1 1 100 | , B4 or equivalent in a nominated | 1 | | |

REFERENCES

DRAWINGS TO BE READ IN CONJUNCTION WITH BUT NOT LIMITED TO ALL STRUCTURAL ENGINEERS, STORMWATER ENGINEERS, LANDSCAPE ARCHITECTS, AND OTHER ASSOCIATED PLANS & REPORTS

REFER TO THE BASIX REPORT FOR ADDITIONAL REQUIREMENTS.

NOTES

ALL DIMENSIONS AND SETOUTS ARE TO BE VERIFIED ON SITE AND ALL OMISSIONS OR ANY DISCREPANCIES TO BE NOTIFIED TO THE ARCHITECT.
FIGURED DIMENSIONS TO BE USED AT ALL TIME.
DO NOT SCALE MEASUREMENTS OFF DRAWINGS.

LIST OF CHANGES: 13.07.2023

• GFA REVISED

• SOLAR TABLE REVISED

• COMPLIANCE TABLE REVISED

 C
 13/07/2023
 DA AMENDMENTS

 B
 21/03/2023
 DA AMENDMENTS

 A
 5/12/2022
 DA SUBMISSION

 Rev.
 Date
 Description

Project Architect



LEVEL 2, 60 PARK STREET SYDNEY NSW 2000 P: 02 9267 2000

W: www.cdarchitects.com.au © Copyright

The copyright of this drawing together with any other documents prepared by CD Architects (CDA) remains the property of CDA. CDA grants licence for the use of this document for the purpose for which it is intended. The licence is not transferable without permission from CDA.

Nominated Architect: Lijana Ermilova 7887, ABN 24 243 205 327



Project
SENIOR HOUSING DEVELOPMENT

69 Melwood Avenue, Forestville

Drawing Title

COMPLIANCE TABLE

DA SUBMISSION

Job no. Drav

ving no. F

J22558D DA 1002 C

Drawn by Checked by Approved by Date
HF RJ ZC SEP. 2022

LIST OF CHANGES: 13.07.2023 • UNIT 202 & 203 REVISED

REFERENCES

DRAWINGS TO BE READ IN CONJUNCTION WITH BUT NOT LIMITED TO ALL STRUCTURAL ENGINEERS, STORMWATER ENGINEERS, LANDSCAPE ARCHITECTS, AND OTHER ASSOCIATED PLANS & REPORTS

REFER TO THE BASIX REPORT FOR ADDITIONAL REQUIREMENTS.

NOTES

TO THE ARCHITECT.
FIGURED DIMENSIONS TO BE USED AT ALL TIME.
DO NOT SCALE MEASUREMENTS OFF DRAWINGS.

| ALL OMISSIONS OR ANY DISCREPANCIES TO | BE |
|---------------------------------------|----|
| TO THE ARCHITECT | |

| | | Roon | n Schedule | | | | | | | N N |
|----------------|--------------------|-------------------|--------------------|--------------------------------|--------------|-------------|-------------|---------------------|----------------------|---------------|
| CD_Room Number | UNIT AREA | BALCONY AREA | TOTAL AREA | DESCRIPTION | SOLAR ACCESS | VENTILATION | ROOM NUMBER | UNIT STORAGE | BASEMENT STORAGE | TOTAL STORAGE |
| G01 | 111 m² | 47 m² | 158 m² | THREE BEDROOM RESIDENTIAL UNIT | Under 2Hrs | Yes | G01 | 7.70 m³ | 70.00 m³ | 77.71 m³ |
| G02 | 112 m² | 41 m² | 152 m ² | THREE BEDROOM RESIDENTIAL UNIT | Over 2Hrs | Yes | G02 | 5.29 m³ | 40.00 m ³ | 45.30 m³ |
| U101 | 114 m² | 35 m² | 149 m² | THREE BEDROOM RESIDENTIAL UNIT | Over 2Hrs | Yes | U101 | 6.64 m³ | 40.00 m ³ | 46.64 m³ |
| U201 | 95 m² | 15 m² | 109 m² | TWO BEDROOM RESIDENTIAL UNIT | Over 2Hrs | Yes | U201 | 6.08 m³ | 40.00 m ³ | 46.08 m³ |
| U202 | 109 m² | 27 m ² | 136 m² | TWO BEDROOM RESIDENTIAL UNIT | Over 2Hrs | Yes | U202 | 8.24 m³ | 40.00 m³ | 48.24 m³ |
| U203 | 96 m² | 23 m ² | 119 m² | TWO BEDROOM RESIDENTIAL UNIT | Under 2Hrs | Yes | U203 | 8.52 m ³ | 40.00 m ³ | 48.52 m³ |
| U301 | 115 m ² | 65 m ² | 181 m ² | THREE BEDROOM RESIDENTIAL UNIT | Over 2Hrs | Yes | U301 | 5.32 m³ | 66.00 m³ | 71.31 m³ |

| С | 13/07/2023 | DA AMENDMENTS |
|---|------------|---------------|
| В | 21/03/2023 | DA AMENDMENTS |
| Α | 5/12/2022 | DA SUBMISSION |

Rev. Date Description



LEVEL 2, 60 PARK STREET SYDNEY NSW 2000 P: 02 9267 2000

W: www.cdarchitects.com.au

© Copyright

The copyright of this drawing logether with any other documents prepared by CD Architects (CDA) remains the property of CDA. CDA grants licence for the use of this document for the purpose for which it is riterated. The licence is not transferable without permission from CDA.

Nominated Architect. Lijana Ermilova 7887, ABN 24 243 205 327



SENIOR HOUSING DEVELOPMENT

69 Melwood Avenue,

Forestville

Drawing Title
UNIT SCHEDULE


DA SUBMISSION

Job no.

Drawing no.

 J22558D
 DA 1003
 C

 Drawn by
 Checked by Approved by BF
 Date SEP. 2022

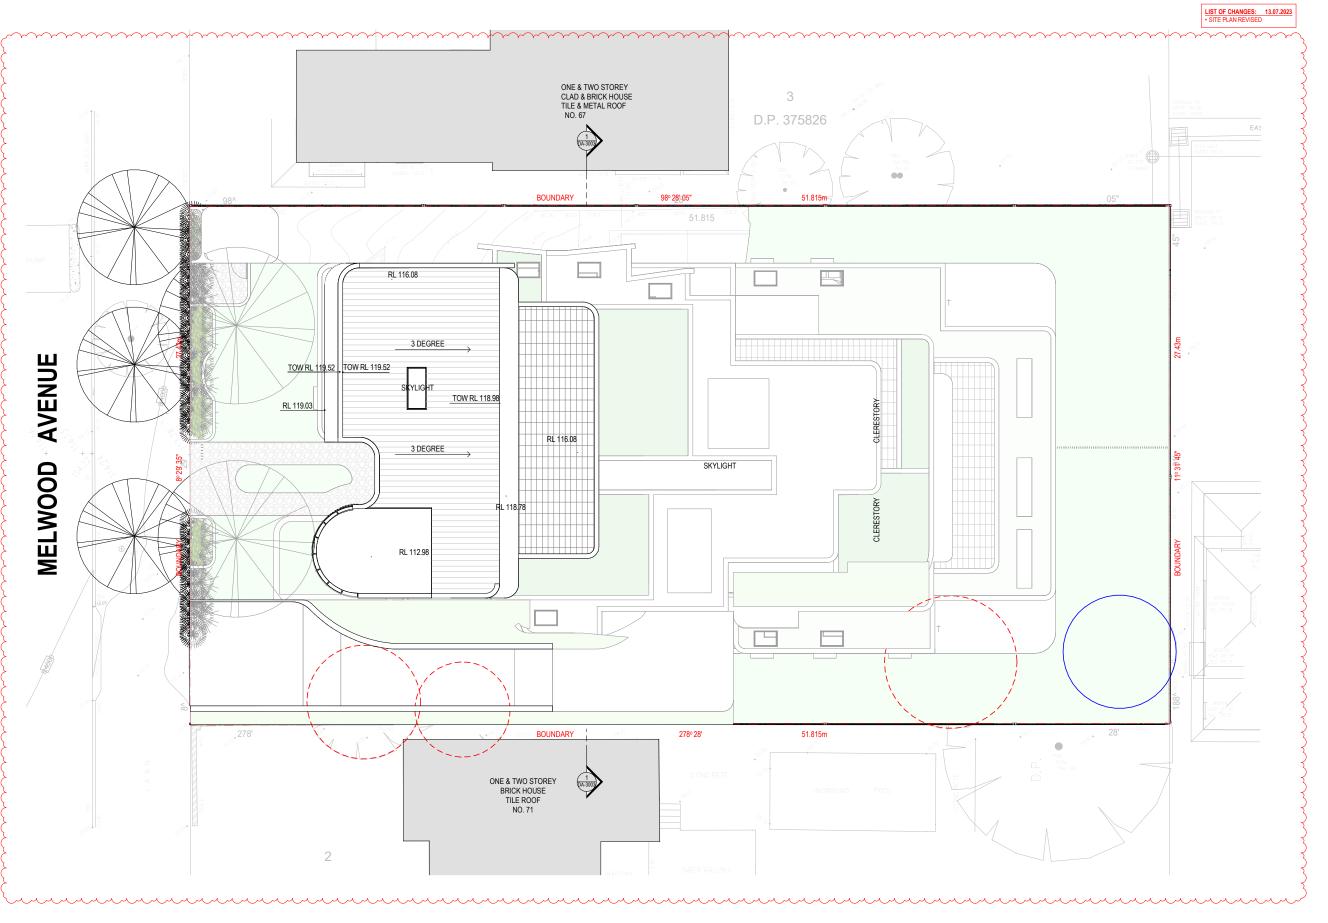

REFER TO THE BASIX REPORT FOR ADDITIONAL REQUIREMENTS.

ALL DIMENSIONS AND SETOUTS ARE TO BE VERIFIED ON SITE AND ALL OMISSIONS OR ANY DISCREPANCIES TO BE NOTIFIED TO THE ARCHITECT. FIGURED DIMENSIONS TO BE USED AT ALL TIME. DO NOT SCALE MEASUREMENTS OFF DRAWINGS.



LEGEND





| С | 13/07/2023 | DA AMENDME | ENTS | |
|------------|-------------------------|--------------|----------|---|
| В | 21/03/2023 | DA AMENDME | ENTS | |
| Α | 5/12/2022 DA SUBMISSION | | | |
| Rev. | Date | Description | | |
| Scale m | 1 2 | 4 | 6 | 8 |
| Ó | 1.1 | 00 at Δ1 1·2 | nn at Δ3 | |

Project Architect



LEVEL 2, 60 PARK STREET SYDNEY NSW 2000 P: 02 9267 2000

W: www.cdarchitects.com.au © Copyright

The copyright of this drawing together with any other documents prepared by CD Architects (CDA) remains the property of CDA. CDA grants licence for the use of this document for the purpose for which it is inherinded. The licence is not transferable without permission from CDA. Normitated Architect Lilipian Ermitavo 7867. ABN 24 243 205 327



SENIOR HOUSING DEVELOPMENT

69 Melwood Avenue, Forestville

Drawing Title SITE PLAN


DA SUBMISSION Job no.

J22558D DA 1005 C

Checked by Approved by Date
RJ ZC SEP. 2022

1 SITE PLAN

1:100 at A1 1:200 at A3

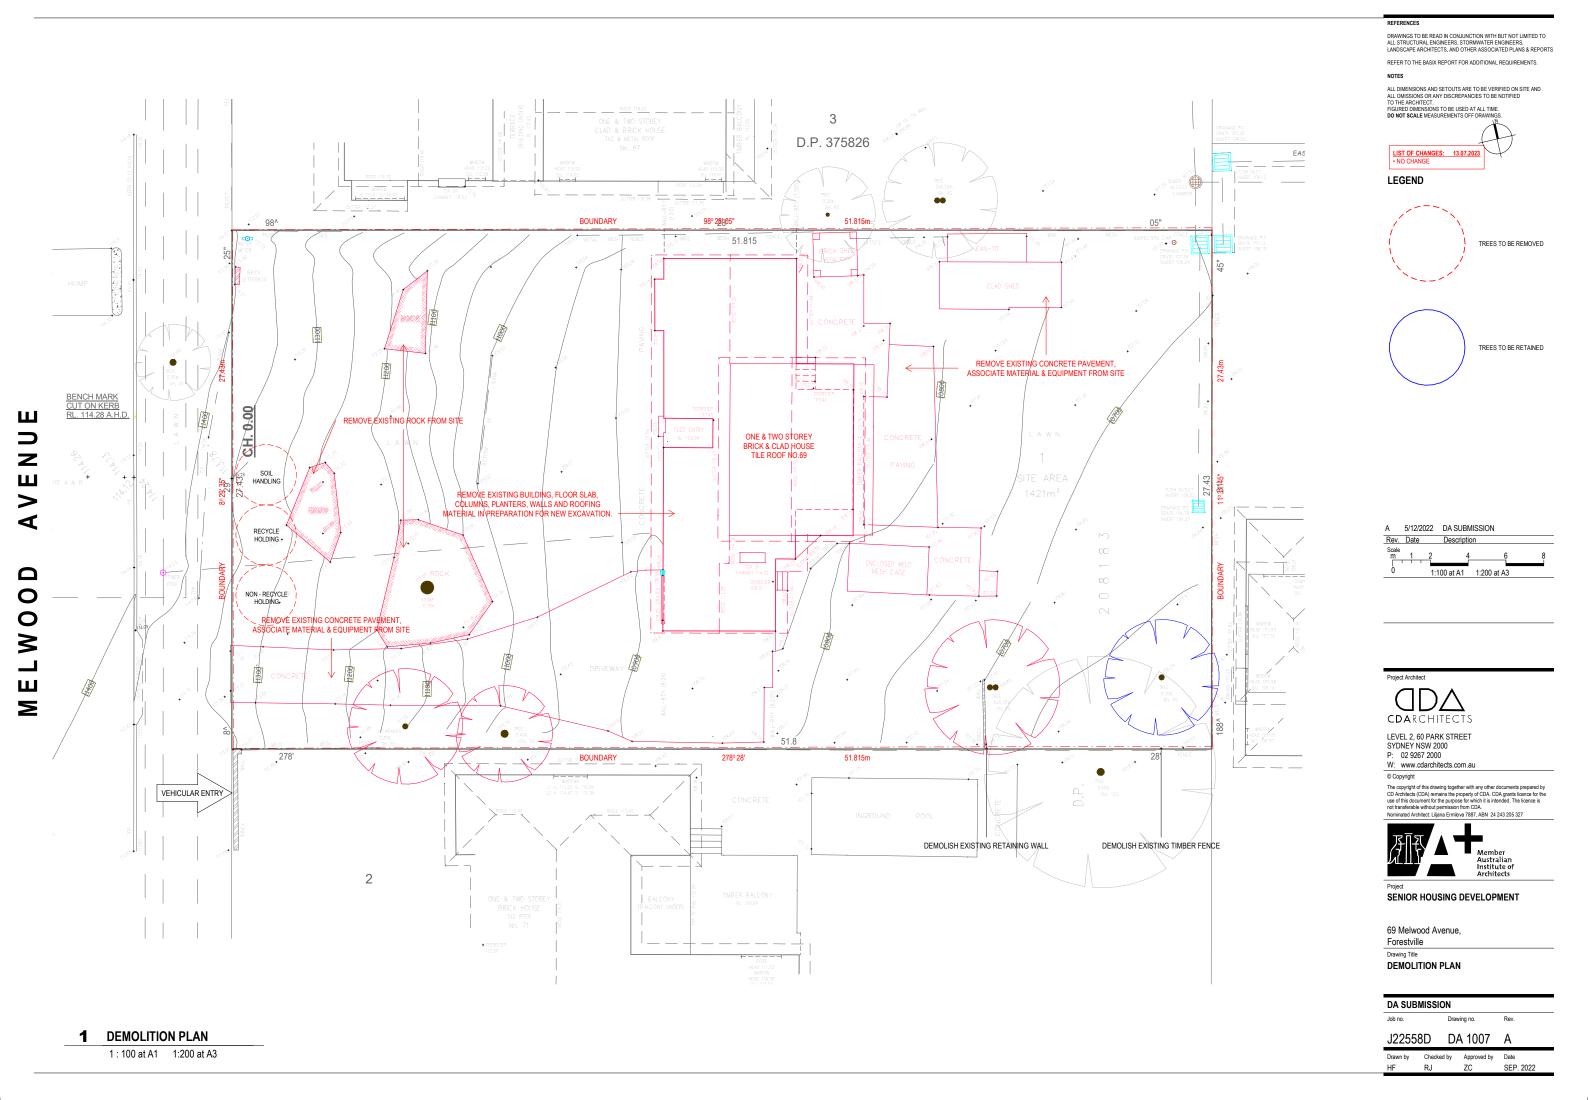






The copyright of this drawing together with any other documents prepared by chanine deelgn (CD) remains the property of CD. CD grants licence for the use of this document for the purpose for which it is intended. The licence is not transferable without permission from CD. Nominated Architect: Liljana Ermillova 7887, ABN 24 243 205 327


SENIOR HOUSING DEVELOPMENT

69 Melwood Avenue, Forestville, NSW 2087

SITE ANALYSIS - TRANSPORT, AMENITY & NETWORK ANALYSIS

J22558D DA 1011

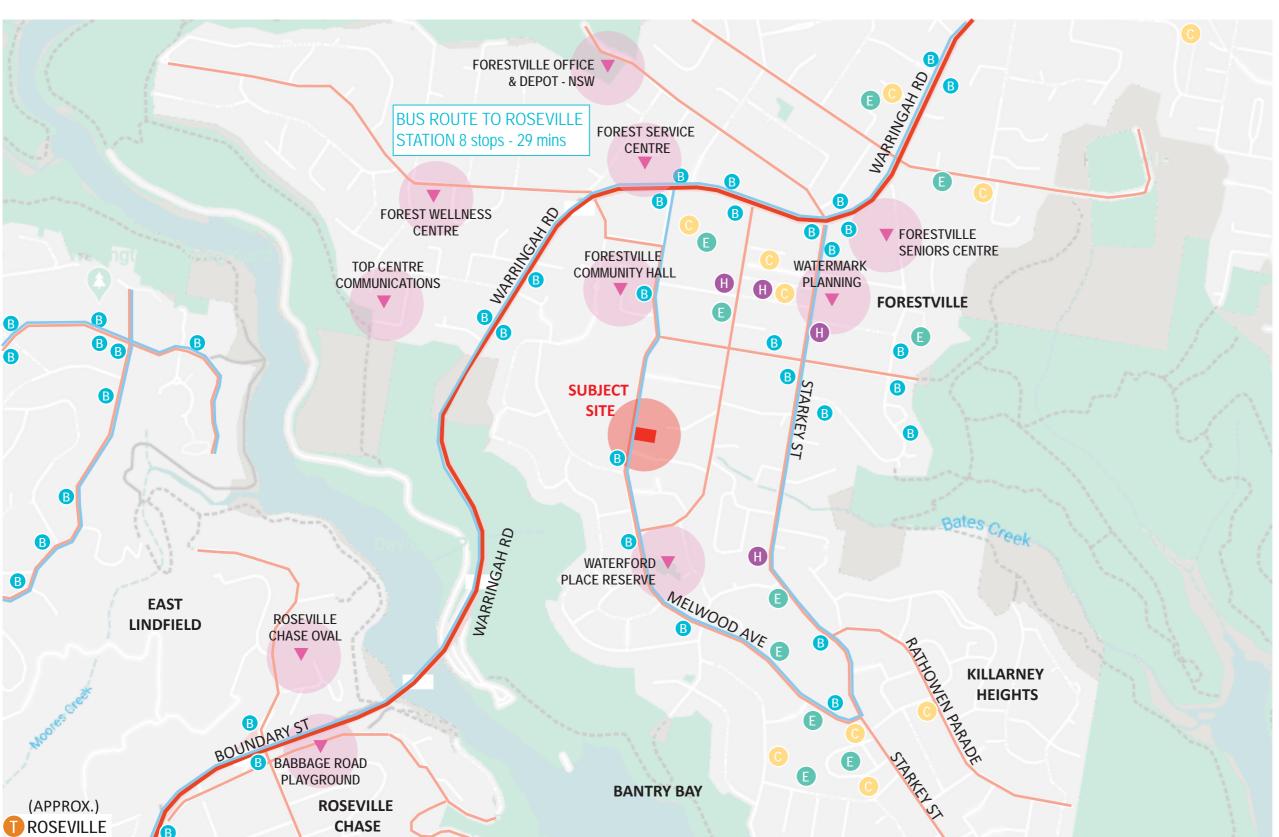

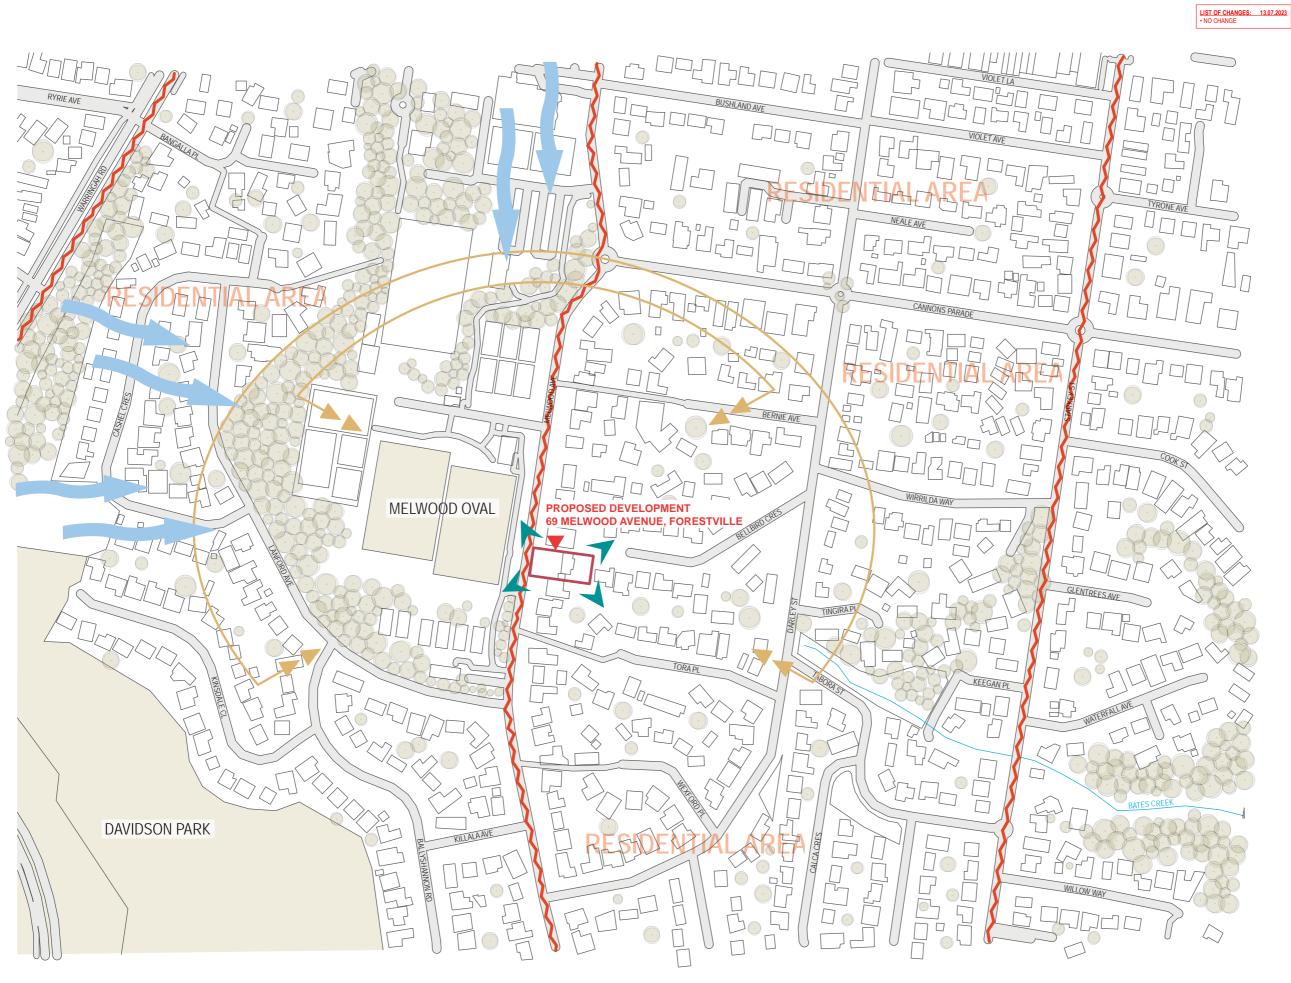

REFER TO THE BASIX REPORT FOR ADDITIONAL REQUIREMENT

ALL DIMENSIONS AND SETOUTS ARE TO BE VERIFIED ON SITE AND ALL OMISSIONS OR ANY DISCREPANCIES TO BE NOTIFIED TO THE ARCHITECT. FIGURED DIMENSIONS TO BE USED AT ALL TIME. DO NOT SCALE MEASUREMENTS OFF DRAWINGS.



LEGEND

WIND PATHS



SOLAR PATHS



VEHICULAR NOISE



GREEN SPACE



VIEW CORRIDORS

A 5/12/2022 DA SUBMISSION

NOT TO SCALE

Project Architect



LEVEL 2, 60 PARK STREET SYDNEY NSW 2000 P: 02 9267 2000


The copyright of this drawing together with any other documents prepared by chanine design (CD) remains the property of CD. CD grants licence for the use of this document for the purpose for which it is intended. The licence is not transferable without permission from CD Nominated Architect. Liljana Ermilova 7887, ABN 24 243 205 327

SENIOR HOUSING DEVELOPMENT

69 Melwood Avenue, Forestville, NSW 2087

SITE ANALYSIS PLAN

J22558D DA 1012 A

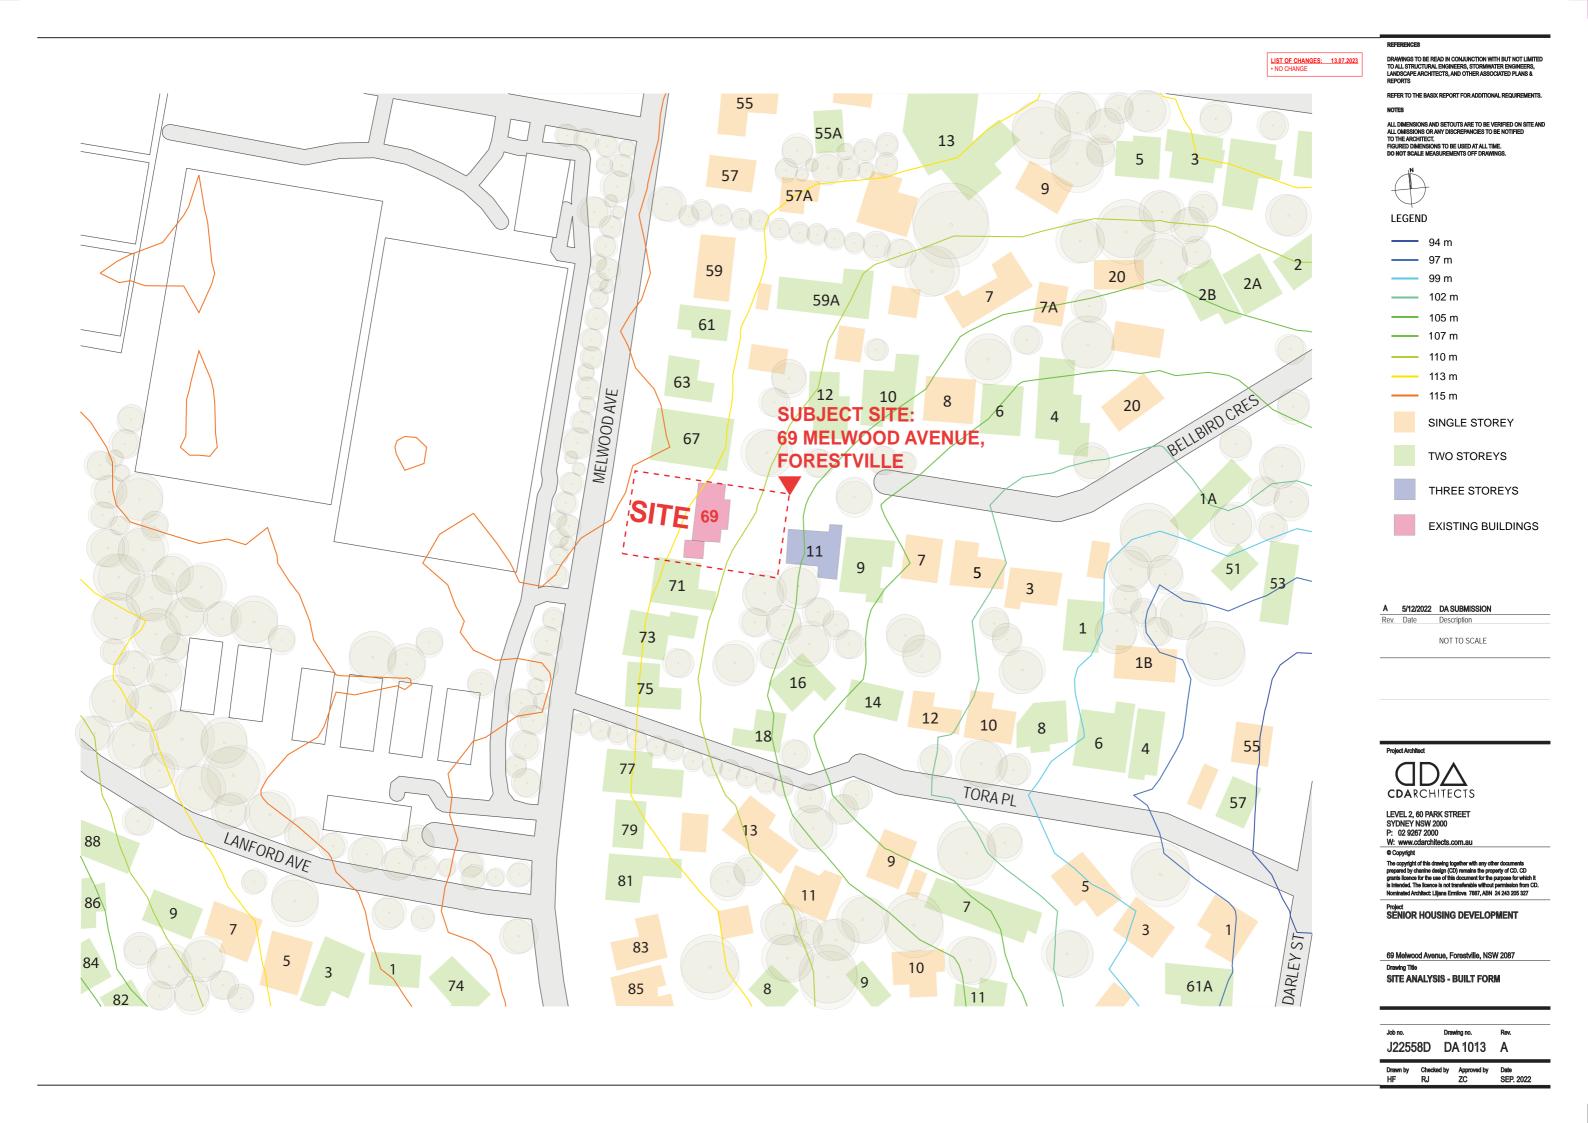

LIST OF CHANGES: 13.07.2023
• NO CHANGE

THIS IMAGE IS INDICATIVE OF THE EXISTING STREETSCAPE ENVELOPE WITH THE INCLUSION OF DEVELOPMENTS THAT ARE EITHER APPROVED OR CURRENTLY UNDER ASSESSMENT BY COUNCIL.



57 MELWOOD AVENUE

59 MELWOOD AVENUE

61 MELWOOD AVENUE

63 MELWOOD AVENUE

67 MELWOOD AVENUE



71 MELWOOD AVENUE

73 MELWOOD AVENUE

75 MELWOOD AVENUE

77 MELWOOD AVENUE

79 MELWOOD AVENUE

VIEWS ALONG MELWOOD AVENUE



FORESTVILLE TENNIS CENTRE

FORESTVILLE KILLARNEY FOOTBALL CLUB

FORESTVILLE RSL CLUB

FORESTVILLE LIBRARY



LEVEL 2, 60 PARK STREET SYDNEY NSW 2000 P: 02 9267 2000

The copyright of this drawing together with any other documents prepared by chanine deeign (CD) remains the property of CD. CD grants licence for the use of this document for the purpose for which it is intended. The licence is not transferable without permission from CD. Nominated Architect: Liljana Ermilova 7887, ABN 24 243 205 327

5/12/2022 SITE ANALYSIS UPDATED

NOT TO SCALE

Project SENIOR HOUSING DEVELOPMENT

69 Melwood Avenue, Forestville, NSW 2205

SITE ANALYSIS - EXISTING STREETSCAPE

J22558D DA 1014 A

KEY FEATURES

LIST OF CHANGES: 13.07.2023
• NO CHANGE

DRAWINGS TO BE READ IN CONJUNCTION WITH BUT NOT LIMITED TO ALL STRUCTURAL ENGINEERS, STORMWATER ENGINEERS, LANDSCAPE ARCHITECTS, AND OTHER ASSOCIATED PLANS &

REFER TO THE BASIX REPORT FOR ADDITIONAL REQUIREMENTS

ALL DIMENSIONS AND SETOUTS ARE TO BE VERIFIED ON SITE AND ALL OMISSIONS OR ANY DISCREPANCIES TO BE NOTIFIED TO THE ARCHITECT. FIGURED DIMENSIONS TO BE USED AT ALL TIME. DO NOT SCALE MEASUREMENTS OFF DRAWINGS.

NOTES

THIS IMAGE IS INDICATIVE OF THE EXISTING STREETSCAPE ENVELOPE WITH THE INCLUSION OF DEVELOPMENTS THAT ARE EITHER APPROVED OR CURRENTLY UNDER ASSESSMENT BY COUNCIL.

BELLBIRD MELWOOD AVE

BELLBIRD CRES 2 STOREY SUBJECT SITE: FORESTVILLE 69 VIEW TO VIEW TO MELWOOD OVA MELWOOD OVAL MELWOOD AVE


VIEWS


TRAFFIC NOISE

ACCESS

PEDESTRIAN VEHICLE <

LANDSCAPE

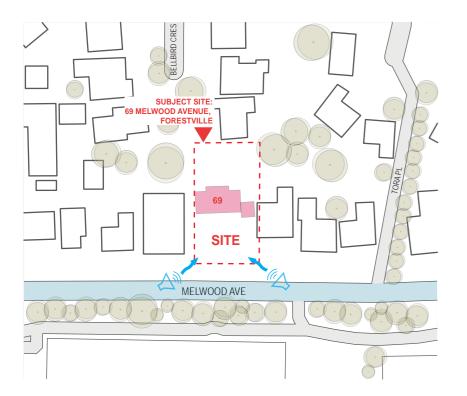

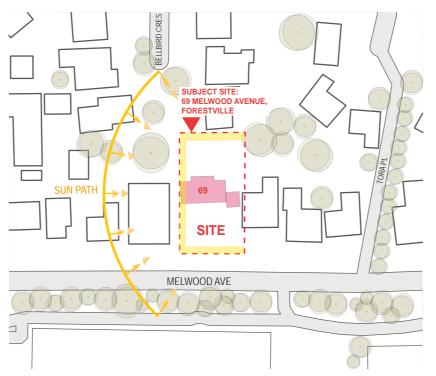

MELWOOD AVE

69 MELWOOD AVENUE. FORESTVILLE SITE

PUBLIC ACCESS SOLAR

Project Architect

CDARCHITECTS

5/12/2022 DA SUBMISSION

NOT TO SCALE

LEVEL 2, 60 PARK STREET SYDNEY NSW 2000 P: 02 9267 2000


The copyright of this drawing together with any other documents prepared by chanine deeign (CD) remains the property of CD. Or grants licence for the use of this document for the purpose for which it is intended. The licence is not transferable without permission from CD. Nominated Architect: Liljana Ermilova 7887, ABN 24 243 205 327


Project SENIOR HOUSING DEVELOPMENT

69 Melwood Avenue, Forestville, NSW 2205


SITE ANALYSIS - OPPORTUNITIES & CONSTRAINTS

J22558D DA 1015 A

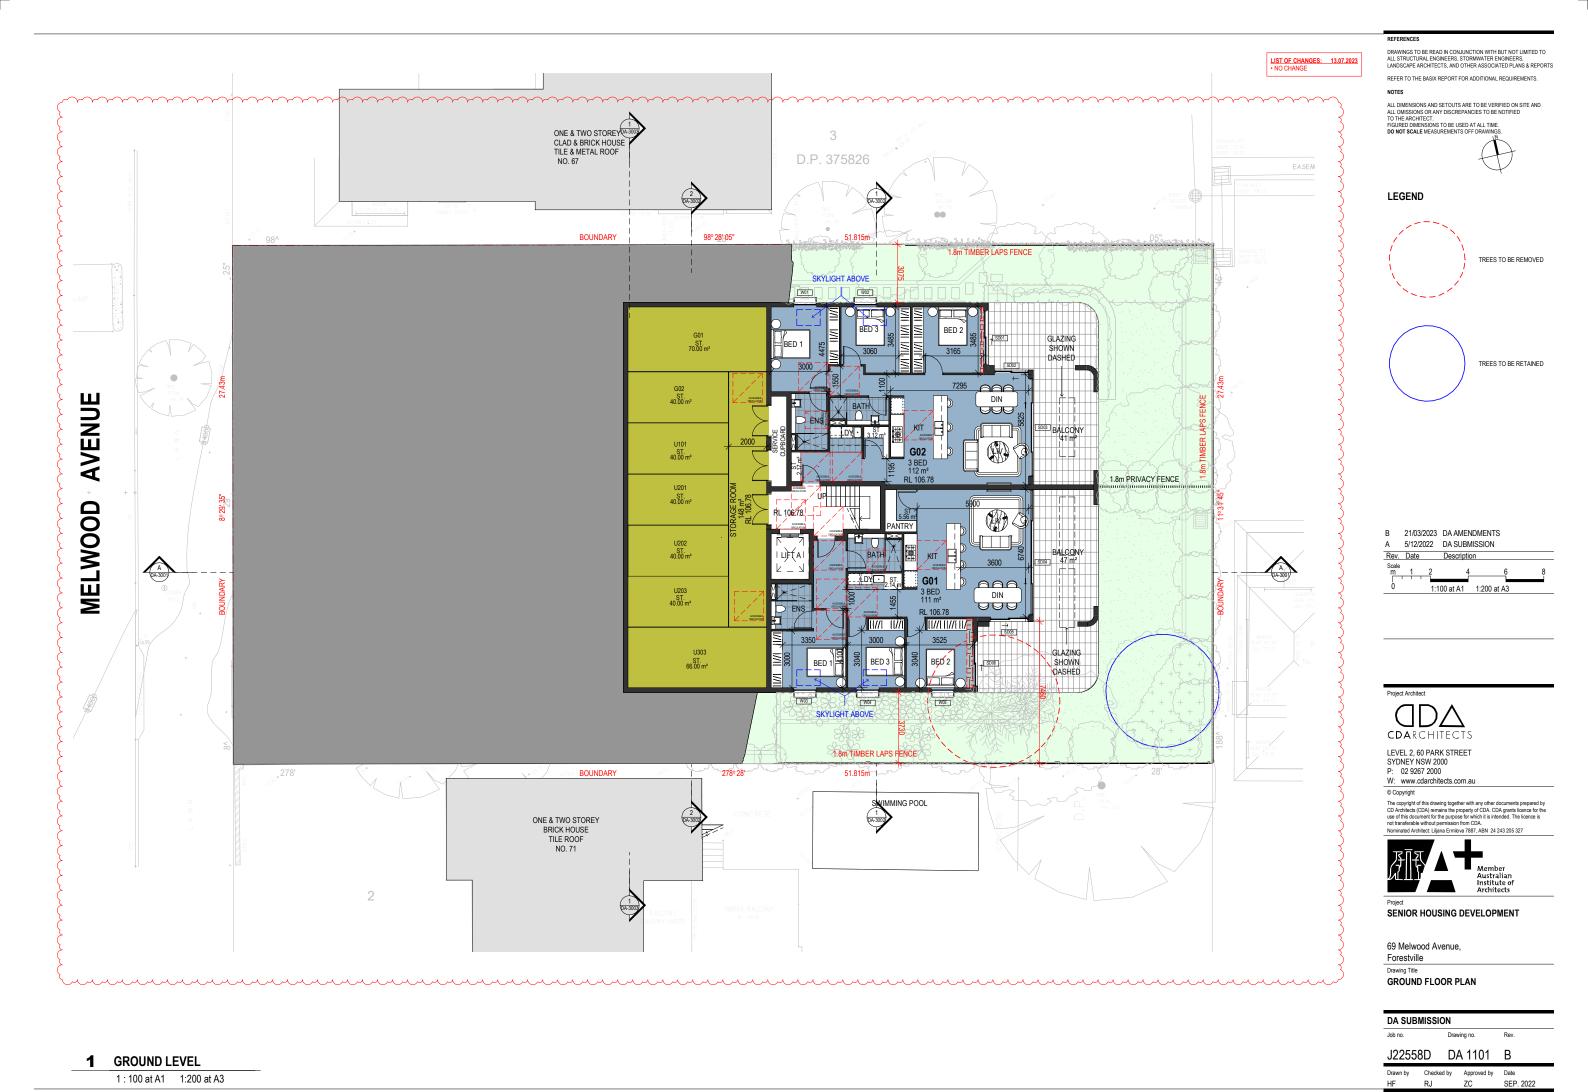

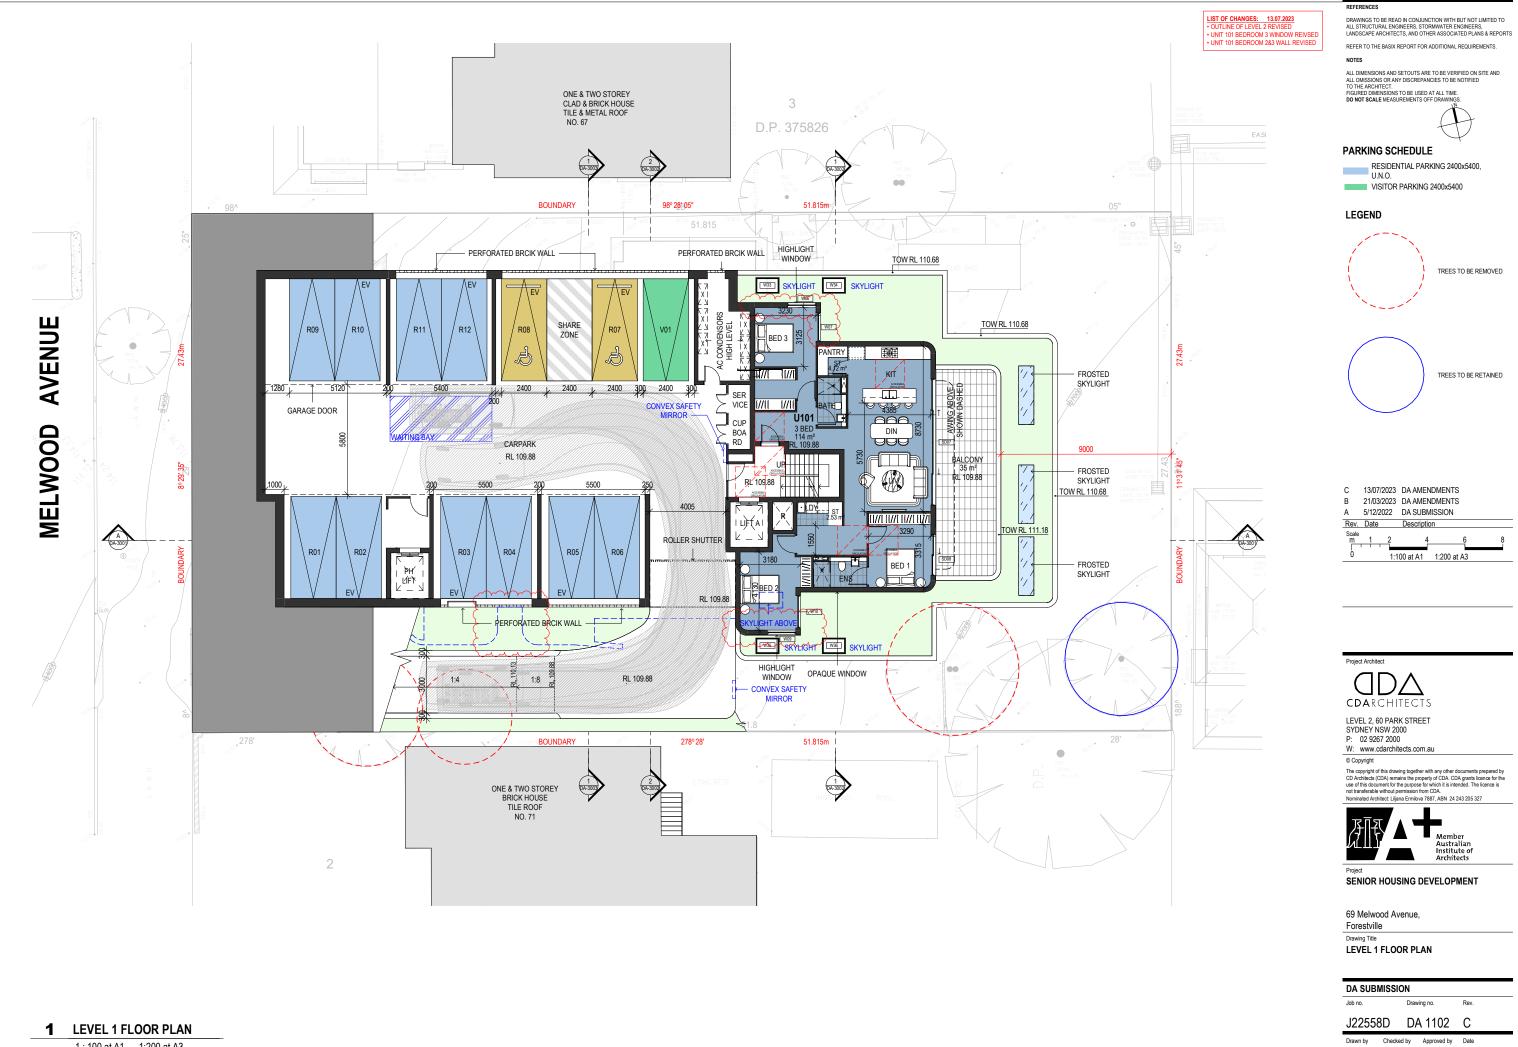


SEP. 2022

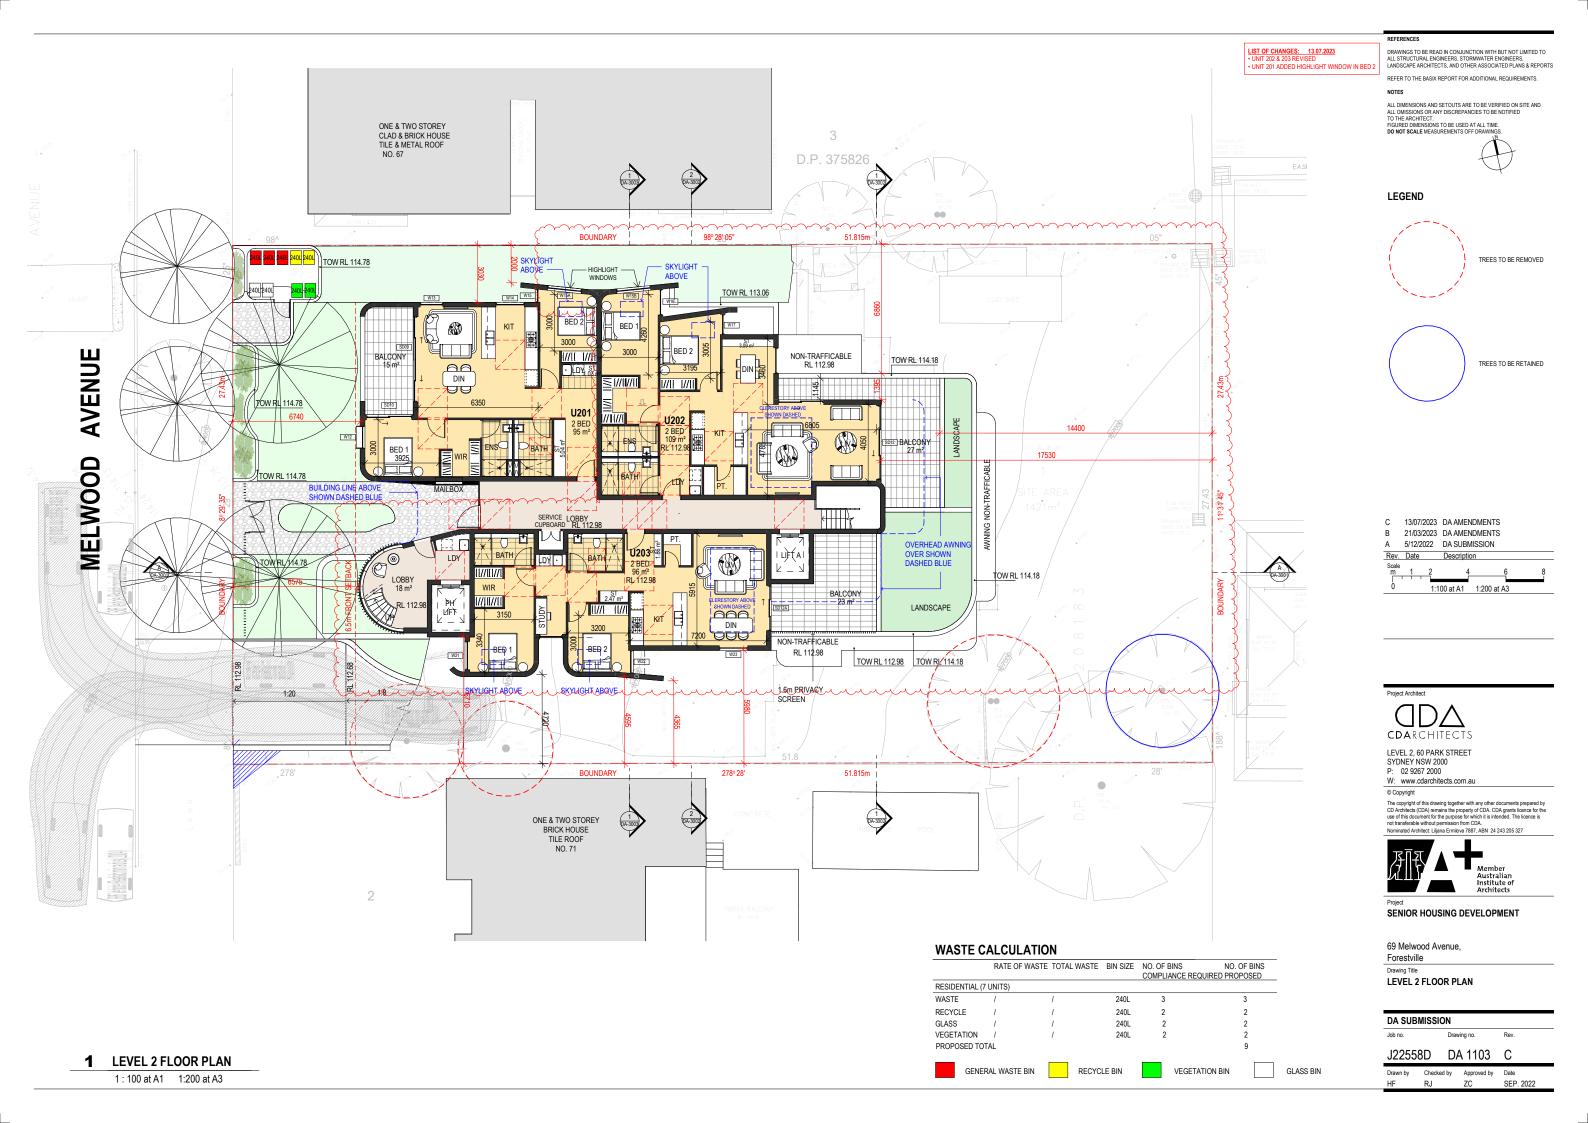

REFER TO THE BASIX REPORT FOR ADDITIONAL REQUIREMENTS.

ALL DIMENSIONS AND SETOUTS ARE TO BE VERIFIED ON SITE AND ALL OMISSIONS OR ANY DISCREPANCIES TO BE NOTIFIED TO THE ARCHITECT. FIGURED DIMENSIONS TO BE USED AT ALL TIME. DO NOT SCALE MEASUREMENTS OFF DRAWINGS.



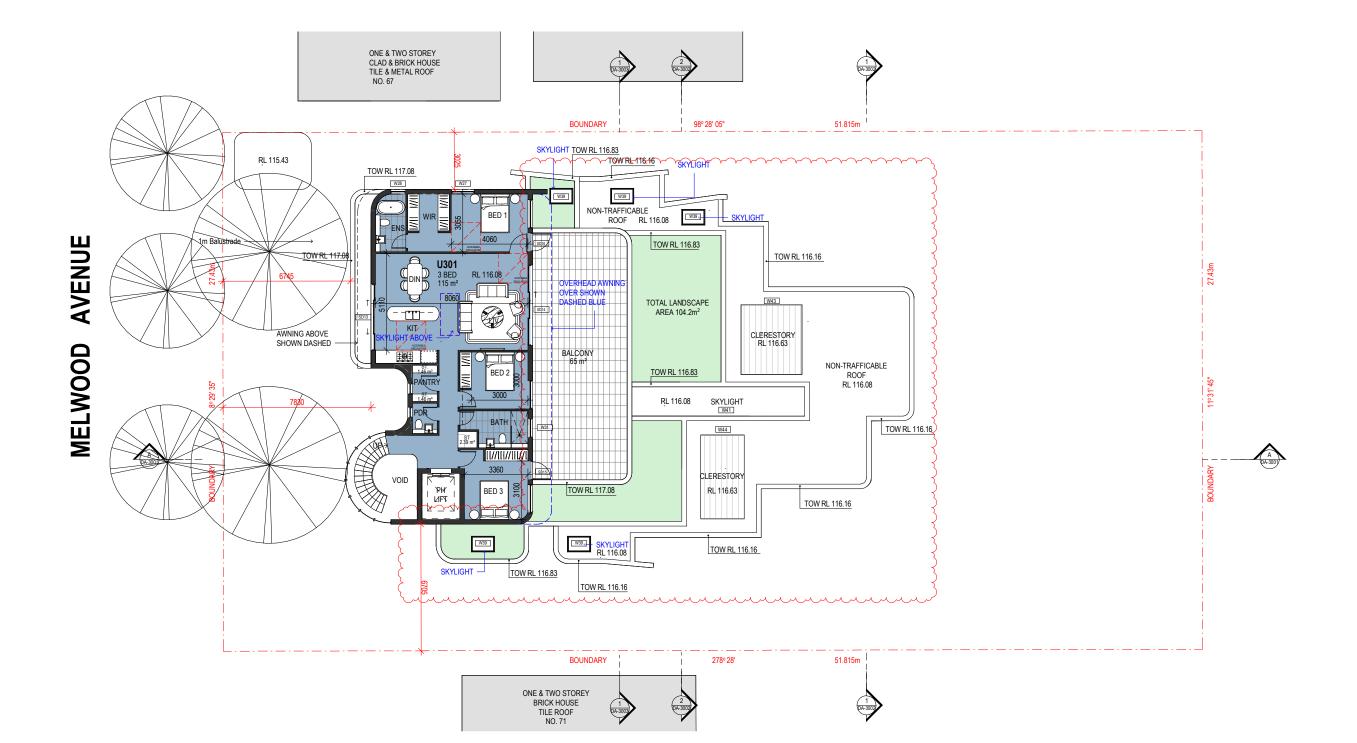

C 13/07/2023 DA AMENDMENTS 21/03/2023 DA AMENDMENTS 5/12/2022 DA SUBMISSION Rev. Date Description 1:100 at A1 1:200 at A3



LEVEL 2, 60 PARK STREET SYDNEY NSW 2000 P: 02 9267 2000

W: www.cdarchitects.com.au

© Copyright

The copyright of this drawing together with any other documents prepared by CD Architects (CDA) remains the property of CDA. CDA grants licence for the use of this document for the purpose for which it is inherinded. The licence is not transferable without permission from CDA. Normitated Architect Lilipian Ermitavo 7867. ABN 24 243 205 327



SENIOR HOUSING DEVELOPMENT

69 Melwood Avenue,

Forestville Drawing Title

LEVEL 3 FLOOR PLAN

DA SUBMISSION Job no.

J22558D DA 1104 C




DRAWINGS TO BE READ IN CONJUNCTION WITH BUT NOT LIMITED TO ALL STRUCTURAL ENGINEERS, STORMWATER ENGINEERS, LANDSCAPE ARCHITECTS, AND OTHER ASSOCIATED PLANS & REPORTS

REFER TO THE BASIX REPORT FOR ADDITIONAL REQUIREMENTS.

NOTES

ALL DIMENSIONS AND SETOUTS ARE TO BE VERIFIED ON SITE AND ALL OMISSIONS OR ANY DISCREPANCIES TO BE NOTIFIED TO THE ARCHITECT. FIGURED DIMENSIONS TO BE USED AT ALL TIME. DO NOT SCALE MEASUREMENTS OFF DRAWINGS.



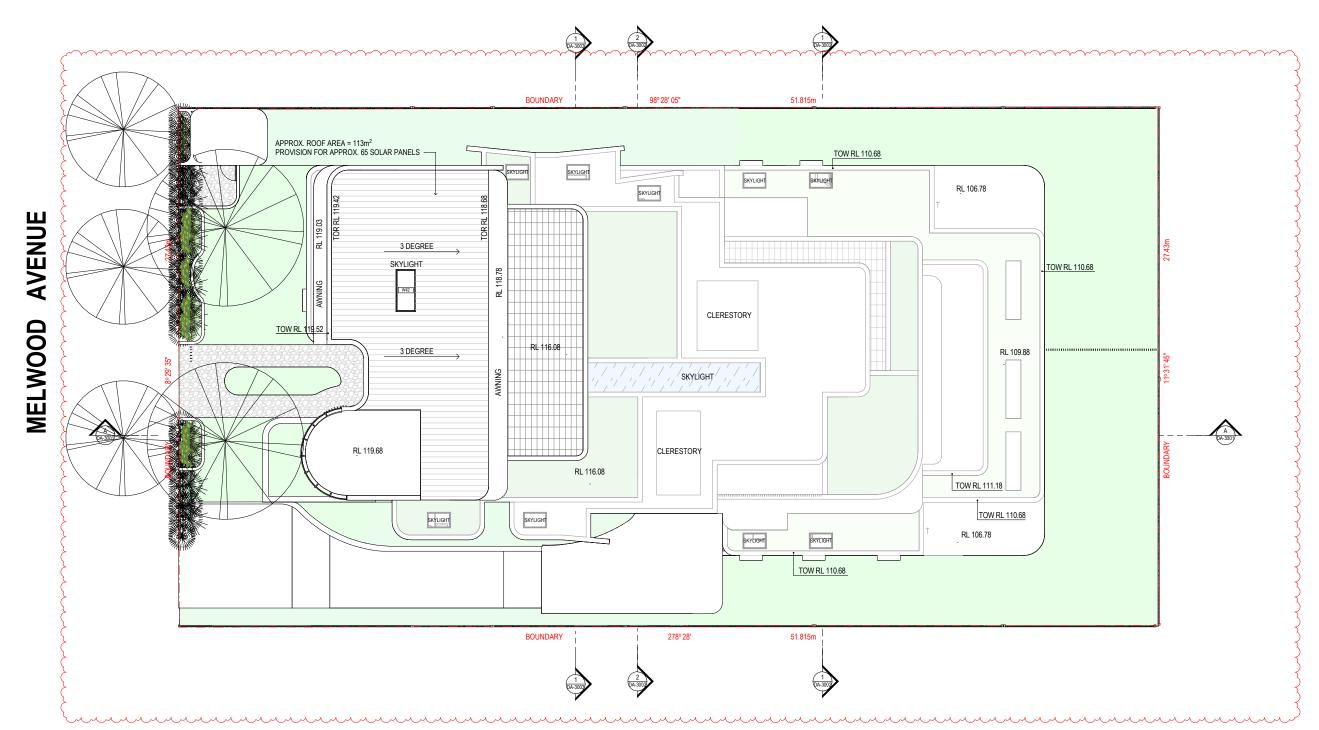

C 13/07/2023 DA AMENDMENTS B 21/03/2023 DA AMENDMENTS A 5/12/2022 DA SUBMISSION Rev. Date Description 1:100 at A1 1:200 at A3

Project Architect



LEVEL 2, 60 PARK STREET SYDNEY NSW 2000 P: 02 9267 2000

W: www.cdarchitects.com.au

© Copyright

G Copyright
The copyright of this drawing logether with any other documents prepared by
DD Architects (CDA) remains the property of CDA. CDA grants licence for the
use of this document for the purpose for which it is intended. The licence is
not transferable without permission from CDA.
Nominated Architect: Lijana Ermilova 7887, ABN 24 243 205 327



SENIOR HOUSING DEVELOPMENT

69 Melwood Avenue,

Forestville Drawing Title

ROOF PLAN

DA SUBMISSION Job no.

J22558D DA 1105 C

LIST OF CHANGES: 13.07.2023
• ELEVATIONS AMENDED TO

ROOF LEVEL TRL. 119.180

LEVEL 3

LEVEL 2 RL. 112.980

LEVEL 1

GROUND LEVEL

RL. 116.080

MELWOOD AVENUE

TOW RL 114.78

RL 115.43

BR1

DRAWINGS TO BE READ IN CONJUNCTION WITH BUT NOT LIMITED TO ALL STRUCTURAL ENGINEERS, STORMWATER ENGINEERS, LANDSCAPE ARCHITECTS, AND OTHER ASSOCIATED PLANS & REPORTS

REFER TO THE BASIX REPORT FOR ADDITIONAL REQUIREMENTS.

ALL DIMENSIONS AND SETOUTS ARE TO BE VERIFIED ON SITE AND ALL OMISSIONS OR ANY DISCREPANCIES TO BE NOTIFIED TO THE ARCHITECT. FIGURED DIMENSIONS TO BE USED AT ALL TIME. DO NOT SCALE MEASUREMENTS OFF DRAWINGS.



MATERIAL LEGEND

BR1 PGH MORADA BLANCO - STACK

RENDER PAINTED - DULUX WHISPER

STADNING SEAM SOLID ALUMINIUM

CLADDING - Duratec Zeus - Lunar Eclipse - Satin - Dulux Powder Coatings

TOW RL 116.16

RL 116.63

TOW RL 114.18

TOR RL 112.98

TOW RL 110.68

RP1

1 NORTH ELEVATION

1:100 at A1 1:200 at A3



TOR RL 119.68

RL 118.78

TOW RL 117.08

PERFORATED BRCIK WALL

TOW RL 119.52 RL 119.68

TOW RL 117.08

2 SOUTH ELEVATION

1:100 at A1 1:200 at A3

21/03/2023 DA AMENDMENTS A 5/12/2022 DA SUBMISSION Rev. Date Description 1:100 at A1 1:200 at A3

13/07/2023 DA AMENDMENTS

Project Architect

LEVEL 2, 60 PARK STREET SYDNEY NSW 2000 P: 02 9267 2000

CDARCHITECTS

W: www.cdarchitects.com.au

© Copyright

The copyright of this drawing together with any other documents prepared by CD Architects (CDA) remains the property of CDA. CDA grants licence for the use of this document for the purpose for which it is intended. The licence is not transferable without permission from CDA.

Nominated Architect Lilipan Emmiyer 7887, ABN 24 243 205 327



SENIOR HOUSING DEVELOPMENT

69 Melwood Avenue,


Forestville Drawing Title

NORTH & SOUTH ELEVATION

| DA | SUBMISSION | |
|----|------------|--|
| | | |

Drawing no.

J22558D DA 2001 C

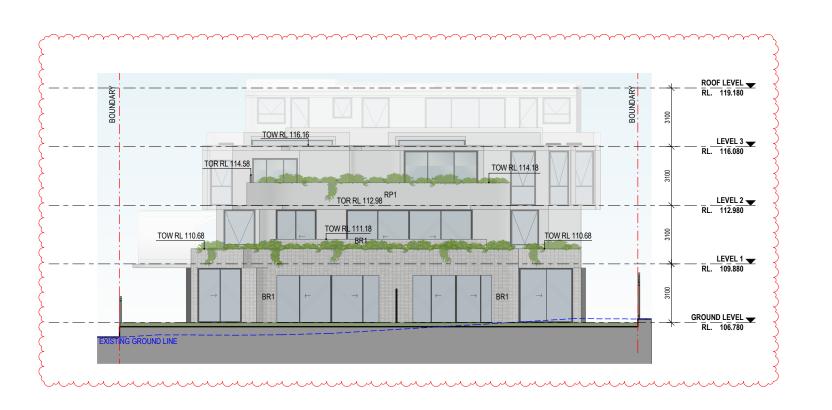

1 EAST ELEVATION

1: 100 at A1 1:200 at A3



2 WEST ELEVATION

1:100 at A1 1:200 at A3

LIST OF CHANGES: 13.07.2023
• ELEVATIONS AMENDED TO

DRAWINGS TO BE READ IN CONJUNCTION WITH BUT NOT LIMITED TO ALL STRUCTURAL ENGINEERS, STORMWATER ENGINEERS, LANDSCAPE ARCHITECTS, AND OTHER ASSOCIATED PLANS & REPORTS

REFER TO THE BASIX REPORT FOR ADDITIONAL REQUIREMENTS.

NOTES

ALL DIMENSIONS AND SETOUTS ARE TO BE VERIFIED ON SITE AND ALL OMISSIONS OR ANY DISCREPANCIES TO BE NOTIFIED TO THE ARCHITECT. FIGURED DIMENSIONS TO BE USED AT ALL TIME. DO NOT SCALE MEASUREMENTS OFF DRAWINGS.

MATERIAL LEGEND




BR1 PGH MORADA BLANCO - STACK BOND



RENDER PAINTED - DULUX WHISPER WHITE



STADNING SEAM SOLID ALUMINIUM CLADDING - Duratec Zeus - Lunar Eclipse - Satin - Dulux Powder Coatings

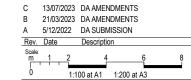



LEVEL 2, 60 PARK STREET SYDNEY NSW 2000 P: 02 9267 2000

W: www.cdarchitects.com.au

© Copyright

The copyright of this drawing together with any other documents prepared by CD Architects (CDA) remains the property of CDA. CDA grants licence for the use of this document for the purpose for which it is inherinded. The licence is not transferable without permission from CDA. Normitated Architect Lilipian Ermitavo 7867. ABN 24 243 205 327



SENIOR HOUSING DEVELOPMENT

69 Melwood Avenue, Forestville

Drawing Title

EAST & WEST ELEVATION


| DA SUBMISSION | | | | |
|---------------|------------|-------------|------------------|--|
| Job no. | Dra | awing no. | Rev. | |
| J2255 | 8D D | A 2002 | С | |
| Drawn by | Checked by | Approved by | Date SEP 2022 | |

DRAWINGS TO BE READ IN CONJUNCTION WITH BUT NOT LIMITED TO ALL STRUCTURAL ENGINEERS, STORMWATER ENGINEERS, LANDSCAPE ARCHITECTS, AND OTHER ASSOCIATED PLANS & REPORTS

REFER TO THE BASIX REPORT FOR ADDITIONAL REQUIREMENTS.

NOTES

ALL DIMENSIONS AND SETOUTS ARE TO BE VERIFIED ON SITE AND ALL OMISSIONS OR ANY DISCREPANCIES TO BE NOTIFIED TO THE ARCHITECT. FIGURED DIMENSIONS TO BE USED AT ALL TIME. DO NOT SCALE MEASUREMENTS OFF DRAWINGS.

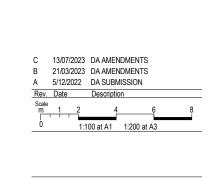

Project Architect



LEVEL 2, 60 PARK STREET SYDNEY NSW 2000 P: 02 9267 2000 W: www.cdarchitects.com.au

© Copyright

CODyright of this drawing together with any other documents prepared by CD Architects (CDA) remains the property of CDA. CDA grants licence for the use of this document for the purpose for which it is intended. The licence is not transferrable without permission from CDA. Nominated Architect: Uljana Ermilova 7887, ABN 24 243 205 327



SENIOR HOUSING DEVELOPMENT

69 Melwood Avenue, Forestville

Drawing Title


LONG SECTION

| DA SUBMISSION | | | |
|---------------|-------------|------|--|
| Job no. | Drawing no. | Rev. | |
| 122558D | DA 3001 | C | |


 J22558D
 DA 3001
 C

 Drawn by
 Checked by
 Approved by
 Date

 HF
 RJ
 ZC
 SEP. 2022

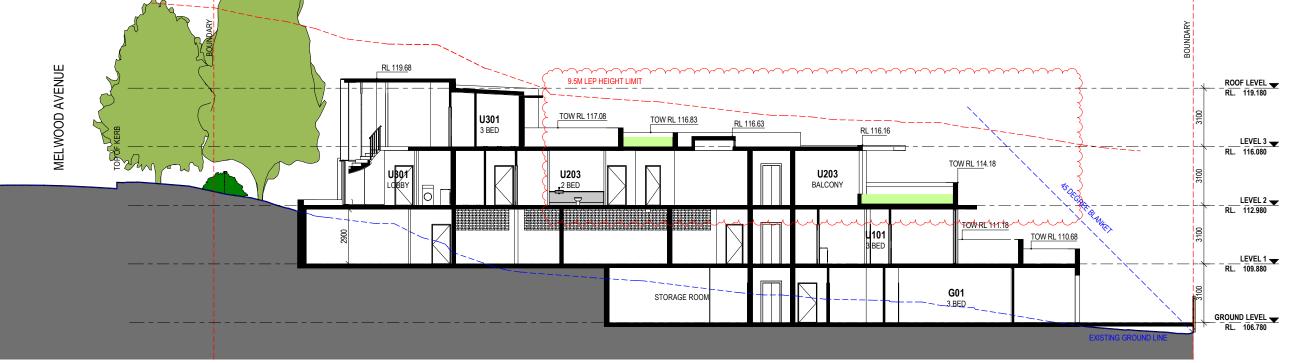


1 : 100 at A1 1:200 at A3

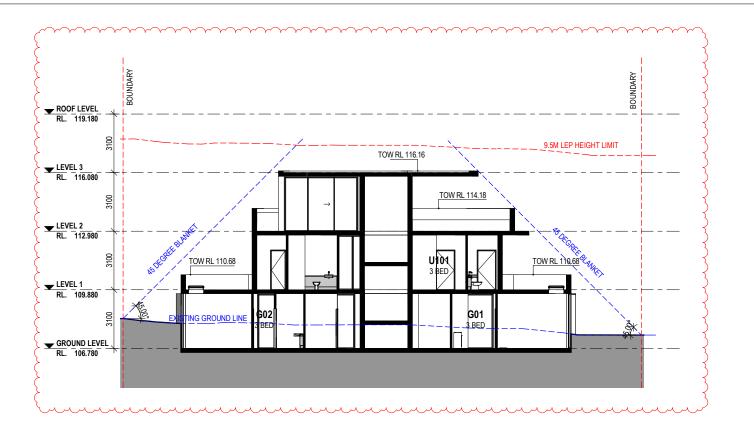

1 CROSS SECTION - 1

1:100 at A1 1:200 at A3

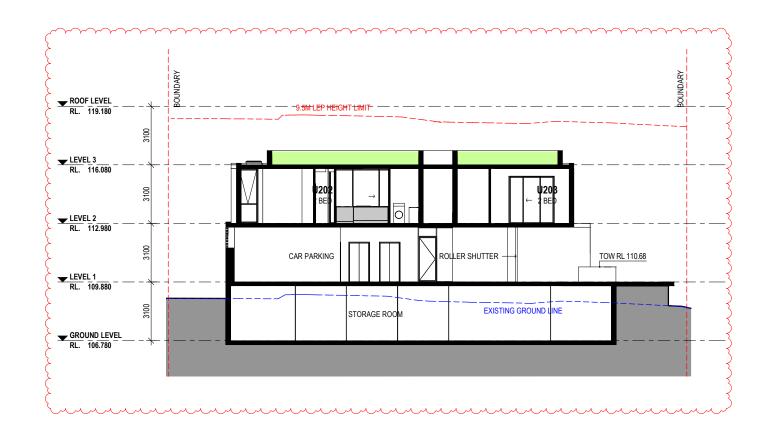

2 CROSS SECTION - 2

1:100 at A1 1:200 at A3

DRAWINGS TO BE READ IN CONJUNCTION WITH BUT NOT LIMITED TO ALL STRUCTURAL ENGINEERS, STORMWATER ENGINEERS, LANDSCAPE ARCHITECTS, AND OTHER ASSOCIATED PLANS & REPORTS

REFER TO THE BASIX REPORT FOR ADDITIONAL REQUIREMENTS.

ALL DIMENSIONS AND SETOUTS ARE TO BE VERIFIED ON SITE AND ALL OMISSIONS OR ANY DISCREPANCIES TO BE NOTIFIED TO THE ARCHITECT. FIGURED DIMENSIONS TO BE USED AT ALL TIME. DO NOT SCALE MEASUREMENTS OFF DRAWINGS.

C 13/07/2023 DA AMENDMENTS B 21/03/2023 DA AMENDMENTS A 5/12/2022 DA SUBMISSION Rev. Date Description 1:100 at A1 1:200 at A3

Project Architect CDARCHITECTS

LEVEL 2, 60 PARK STREET SYDNEY NSW 2000 P: 02 9267 2000

W: www.cdarchitects.com.au

© Copyright



SENIOR HOUSING DEVELOPMENT

69 Melwood Avenue,

Forestville Drawing Title

CROSS SECTION

DA SUBMISSION

Job no. J22558D DA 3002 C

Drawn by Checked by Approved by Date
R.I ZC SEP. 2022

LIST OF CHANGES: 13.07.2023

• SECTION AMENDED TO REFLECT CHANGES ON FLOOR PLANS

REFERENCES

DRAWINGS TO BE READ IN CONJUNCTION WITH BUT NOT LIMITED TO ALL STRUCTURAL ENGINEERS, STORMWATER ENGINEERS, LANDSCAPE ARCHITECTS, AND OTHER ASSOCIATED PLANS & REPORTS

REFER TO THE BASIX REPORT FOR ADDITIONAL REQUIREMENTS.

NOTES

ALL DIMENSIONS AND SETOUTS ARE TO BE VERIFIED ON SITE AND ALL OMISSIONS OR ANY DISCREPANCIES TO BE NOTIFIED TO THE ARCHITECT. FIGURED DIMENSIONS TO BE USED AT ALL TIME. DO NOT SCALE MEASUREMENTS OFF DRAWINGS.

B 13/07/2023 DA AMENDMENTS A 21/03/2023 DA AMENDMENTS Rev. Date Description 1:100 at A1 1:200 at A3

Project Architect

CDARCHITECTS LEVEL 2, 60 PARK STREET SYDNEY NSW 2000 P: 02 9267 2000

W: www.cdarchitects.com.au

© Copyright

CODyright of this drawing together with any other documents prepared by CD Architects (CDA) remains the property of CDA. CDA grants licence for the use of this document for the purpose for which it is intended. The licence is not transferrable without permission from CDA. Nominated Architect: Uljana Ermilova 7887, ABN 24 243 205 327




SENIOR HOUSING DEVELOPMENT

69 Melwood Avenue, Forestville

Drawing Title

CROSS SECTION

| DA SUBMISSION | | | | |
|---------------|------------|-------------|-----------|--|
| Job no. | | rawing no. | Rev. | |
| J22558D | | DA 3003 | В | |
| Drawn by | Checked by | Approved by | Date | |
| HF | ZC | ZC | SEP. 2022 | |

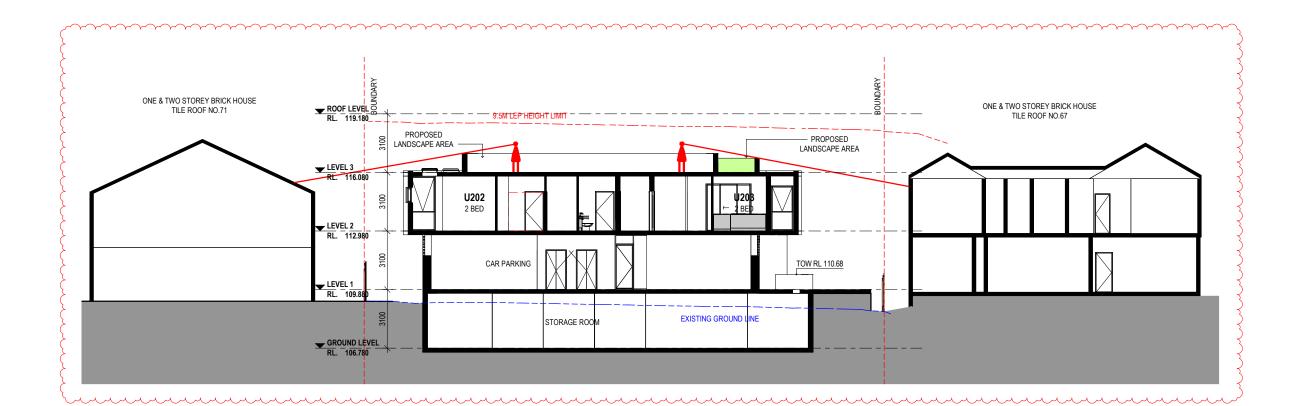

1 CROSS SECTION - 3

1 : 100 at A1 1:200 at A3



1 SHADOW DIAGRAM - 9AM, 21 JUNE



3 SHADOW DIAGRAM - 15PM, 21 JUNE



2 SHADOW DIAGRAM - 12PM, 21 JUNE

1:250



REFERENCES

DRAWINGS TO BE READ IN CONJUNCTION WITH BUT NOT LIMITED TO ALL STRUCTURAL ENGINEERS, STORMWATER ENGINEERS, LANDSCAPE ARCHITECTS, AND OTHER ASSOCIATED PLANS & REPORTS

REFER TO THE BASIX REPORT FOR ADDITIONAL REQUIREMENTS.

ALL DIMENSIONS AND SETOUTS ARE TO BE VERIFIED ON SITE AND ALL OMISSIONS OR ANY DISCREPANCIES TO BE NOTIFIED TO THE ARCHITECT. FIGURED DIMENSIONS TO BE USED AT ALL TIME. DO NOT SCALE MEASUREMENTS OFF DRAWINGS.



LIST OF CHANGES: 13.07.2023
• SHADOW DIAGRAMS REVISED

13/07/2023 DA AMENDMENTS 5/12/2022 DA SUBMISSION Rev. Date Description 1:250 at A1 1:500 at A3

Project Architect



LEVEL 2, 60 PARK STREET SYDNEY NSW 2000 P: 02 9267 2000

W: www.cdarchitects.com.au

© Copyright

The copyright of this drawing together with any other documents prepared by CD Architects (CDA) remains the property of CDA. CDA grants licence for the use of this document for the purpose for which it is inherinded. The licence is not transferable without permission from CDA. Normitated Architect Lilipian Ermitavo 7867. ABN 24 243 205 327



SENIOR HOUSING DEVELOPMENT

69 Melwood Avenue, Forestville

Drawing Title

SHADOW DIAGRAMS

| DA SUBMISSION | | |
|---------------|-------------|------|
| Job no. | Drawing no. | Rev. |
| J22558D | DA 6001 | В |



DRAWINGS TO BE READ IN CONJUNCTION WITH BUT NOT LIMITED TO ALL STRUCTURAL ENGINEERS, STORMWATER ENGINEERS, LANDSCAPE ARCHITECTS, AND OTHER ASSOCIATED PLANS & REPORTS

REFER TO THE BASIX REPORT FOR ADDITIONAL REQUIREMENTS.

NOTES

ALL DIMENSIONS AND SETOUTS ARE TO BE VERIFIED ON SITE AND ALL OMISSIONS OR ANY DISCREPANCIES TO BE NOTIFIED TO THE ARCHITECT. FIGURED DIMENSIONS TO BE USED AT ALL TIME. DO NOT SCALE MEASUREMENTS OFF DRAWINGS.





NOT TO SCALE

Project Architect



LEVEL 2, 60 PARK STREET SYDNEY NSW 2000 P: 02 9267 2000

W: www.cdarchitects.com.au

© Copyright

The copyright of this drawing together with any other documents prepared by CD Architects (CDA) remains the property of CDA. CDA grants licence for the use of this document for the purpose for which it is inherinded. The licence is not transferable without permission from CDA. Normitated Architect Lilipian Ermitavo 7867. ABN 24 243 205 327



SENIOR HOUSING DEVELOPMENT

69 Melwood Avenue, Forestville

Drawing Title

SUN ANGLE VIEWS 9AM - 21 JUNE

Drawing no.

J22558D DA 6021 C






DRAWINGS TO BE READ IN CONJUNCTION WITH BUT NOT LIMITED TO ALL STRUCTURAL ENGINEERS, STORMWATER ENGINEERS, LANDSCAPE ARCHITECTS, AND OTHER ASSOCIATED PLANS & REPORTS

REFER TO THE BASIX REPORT FOR ADDITIONAL REQUIREMENTS.

NOTES

ALL DIMENSIONS AND SETOUTS ARE TO BE VERIFIED ON SITE AND ALL OMISSIONS OR ANY DISCREPANCIES TO BE NOTIFIED TO THE ARCHITECT. FIGURED DIMENSIONS TO BE USED AT ALL TIME. DO NOT SCALE MEASUREMENTS OFF DRAWINGS.

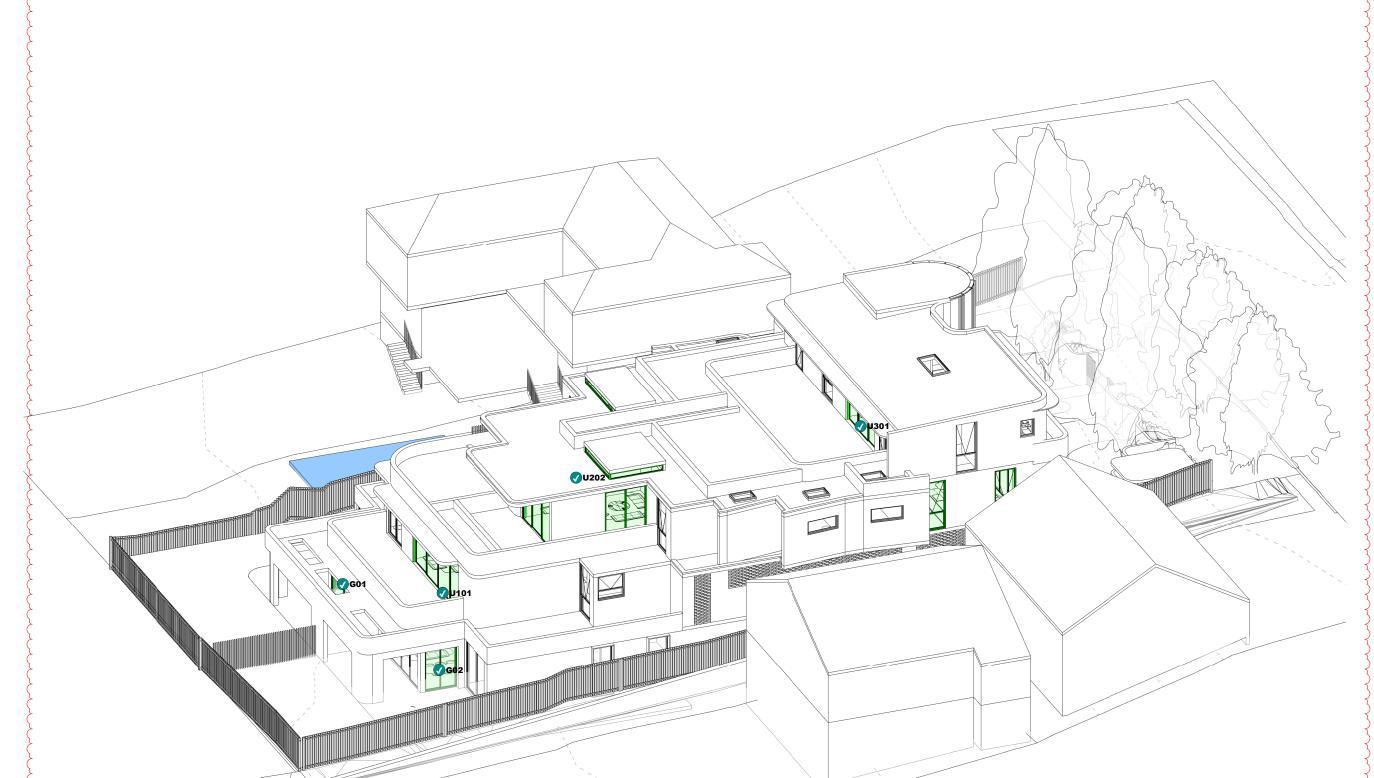

C 13/07/2023 DA AMENDMENTS B 21/03/2023 DA AMENDMENTS A 5/12/2022 DA SUBMISSION Rev. Date Description

NOT TO SCALE

CDARCHITECTS

LEVEL 2, 60 PARK STREET SYDNEY NSW 2000 P: 02 9267 2000

W: www.cdarchitects.com.au

© Copyright

The copyright of this drawing together with any other documents prepared by CD Architects (CDA) remains the property of CDA. CDA grants licence for the use of this document for the purpose for which it is intended. The licence is not transferable without permission from CDA.

Normitated Architect Lilpian Emmission 8787, ABN 24 243 205 327



SENIOR HOUSING DEVELOPMENT

69 Melwood Avenue, Forestville

Drawing Title

SUN ANGLE VIEWS 10AM - 21 JUNE

DA SUBMISSION

J22558D DA 6022 C



DRAWINGS TO BE READ IN CONJUNCTION WITH BUT NOT LIMITED TO ALL STRUCTURAL ENGINEERS, STORMWATER ENGINEERS, LANDSCAPE ARCHITECTS, AND OTHER ASSOCIATED PLANS & REPORTS

REFER TO THE BASIX REPORT FOR ADDITIONAL REQUIREMENTS.

NOTES

ALL DIMENSIONS AND SETOUTS ARE TO BE VERIFIED ON SITE AND ALL OMISSIONS OR ANY DISCREPANCIES TO BE NOTIFIED TO THE ARCHITECT. FIGURED DIMENSIONS TO BE USED AT ALL TIME. DO NOT SCALE MEASUREMENTS OFF DRAWINGS.



C 13/07/2023 DA AMENDMENTS B 21/03/2023 DA AMENDMENTS A 5/12/2022 DA SUBMISSION

Rev. Date Description

NOT TO SCALE

Project Architect

CDARCHITECTS

LEVEL 2, 60 PARK STREET SYDNEY NSW 2000 P: 02 9267 2000

W: www.cdarchitects.com.au © Copyright

The copyright of this drawing together with any other documents prepared by CD Architects (CDA) remains the property of CDA. CDA grants licence for the use of this document for the purpose for which it is intended. The licence is not transferable without permission from CDA.

Nominated Architect Lilipan Emmiyer 7887, ABN 24 243 205 327



SENIOR HOUSING DEVELOPMENT

69 Melwood Avenue, Forestville

Drawing Title

SUN ANGLE VIEWS 11AM - 21 JUNE

DA SUBMISSION

J22558D DA 6023 C



REFER TO THE BASIX REPORT FOR ADDITIONAL REQUIREMENTS.

ALL DIMENSIONS AND SETOUTS ARE TO BE VERIFIED ON SITE AND ALL OMISSIONS OR ANY DISCREPANCIES TO BE NOTIFIED TO THE ARCHITECT. FIGURED DIMENSIONS TO BE USED AT ALL TIME. DO NOT SCALE MEASUREMENTS OFF DRAWINGS.



C 13/07/2023 DA AMENDMENTS B 21/03/2023 DA AMENDMENTS A 5/12/2022 DA SUBMISSION Rev. Date Description

NOT TO SCALE

Project Architect

LEVEL 2, 60 PARK STREET SYDNEY NSW 2000 P: 02 9267 2000

W: www.cdarchitects.com.au

© Copyright

The copyright of this drawing together with any other documents prepared by CD Architects (CDA) remains the property of CDA. CDA grants license for the use of this document for the purpose of which it is triended. The license is not transferable without permission from CDA. Monitable Architect Lighers Emilyer 897, ABN 24 243 205 327



SENIOR HOUSING DEVELOPMENT

69 Melwood Avenue, Forestville

SUN ANGLE VIEWS 12PM - 21 JUNE


DA SUBMISSION

J22558D DA 6024 C Checked by Approved by Date
RJ ZC SEP. 2022



REFER TO THE BASIX REPORT FOR ADDITIONAL REQUIREMENTS.

ALL DIMENSIONS AND SETOUTS ARE TO BE VERIFIED ON SITE AND ALL OMISSIONS OR ANY DISCREPANCIES TO BE NOTIFIED TO THE ARCHITECT. FIGURED DIMENSIONS TO BE USED AT ALL TIME. DO NOT SCALE MEASUREMENTS OFF DRAWINGS.

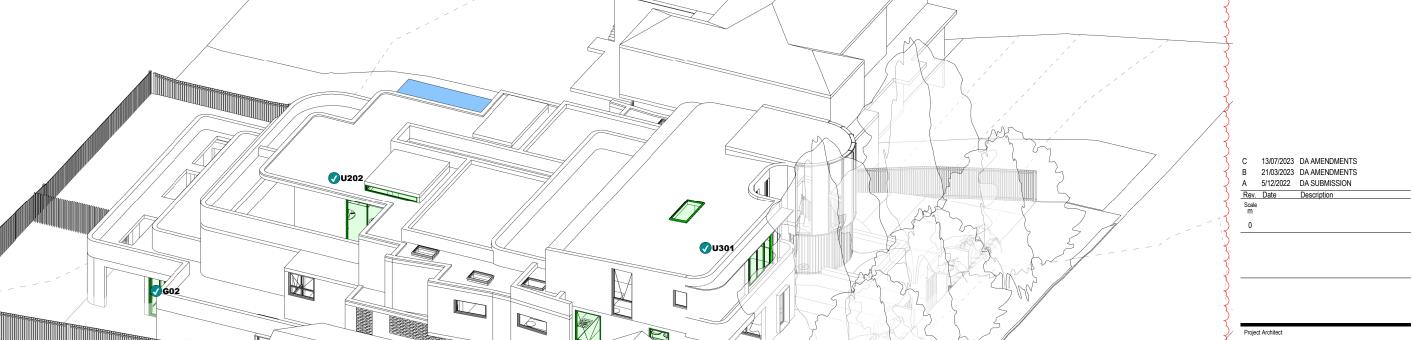



LEVEL 2, 60 PARK STREET SYDNEY NSW 2000 P: 02 9267 2000

W: www.cdarchitects.com.au

© Copyright

The copyright of this drawing together with any other documents prepared by CD Architects (CDA) remains the property of CDA. CDA grants license for the use of this document for the purpose of which it is triended. The license is not transferable without permission from CDA. Monitable Architect Lighers Emilyer 897, ABN 24 243 205 327



SENIOR HOUSING DEVELOPMENT

69 Melwood Avenue, Forestville

Drawing Title

SUN ANGLE VIEWS 1PM - 21 JUNE

| DA | SUBMISSION | |
|----|------------|--|

Drawing no.

J22558D DA 6025 C



REFER TO THE BASIX REPORT FOR ADDITIONAL REQUIREMENTS.

ALL DIMENSIONS AND SETOUTS ARE TO BE VERIFIED ON SITE AND ALL OMISSIONS OR ANY DISCREPANCIES TO BE NOTIFIED TO THE ARCHITECT. FIGURED DIMENSIONS TO BE USED AT ALL TIME. DO NOT SCALE MEASUREMENTS OFF DRAWINGS.

C 13/07/2023 DA AMENDMENTS B 21/03/2023 DA AMENDMENTS A 5/12/2022 DA SUBMISSION

NOT TO SCALE

Project Architect

LEVEL 2, 60 PARK STREET SYDNEY NSW 2000 P: 02 9267 2000

W: www.cdarchitects.com.au

© Copyright

The copyright of this drawing together with any other documents prepared by CD Architects (CDA) remains the property of CDA. CDA grants licence for the use of this document for the purpose for which it is inherinded. The licence is not transferable without permission from CDA. Normitated Architect Lilipian Ermitavo 7867. ABN 24 243 205 327



SENIOR HOUSING DEVELOPMENT


69 Melwood Avenue, Forestville

Drawing Title

SUN ANGLE VIEWS 2PM - 21 JUNE

DA SUBMISSION

J22558D DA 6026 C Checked by Approved by Date
RJ ZC SEP. 2022

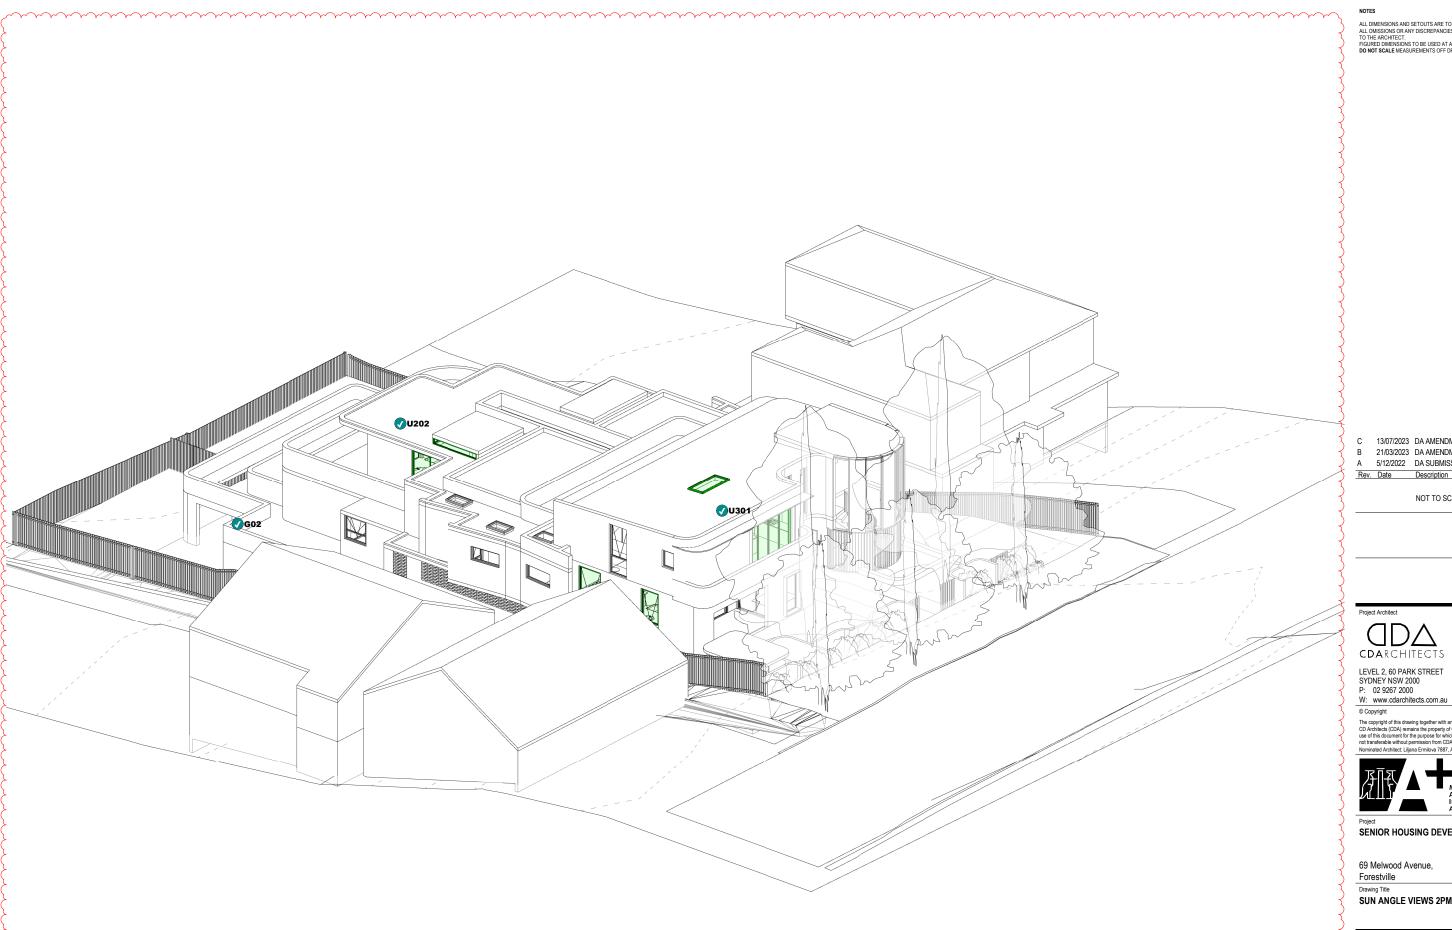

LIST OF CHANGES: 13.07.2023

• SOLAR VIEWS REVISED


REFERENCES

DRAWINGS TO BE READ IN CONJUNCTION WITH BUT NOT LIMITED TO ALL STRUCTURAL ENGINEERS, STORMWATER ENGINEERS, LANDSCAPE ARCHITECTS, AND OTHER ASSOCIATED PLANS & REPORTS

REFER TO THE BASIX REPORT FOR ADDITIONAL REQUIREMENTS.

NOTES

ALL DIMENSIONS AND SETOUTS ARE TO BE VERIFIED ON SITE AND ALL OMISSIONS OR ANY DISCREPANCIES TO BE NOTIFIED TO THE ARCHITECT. FIGURED DIMENSIONS TO BE USED AT ALL TIME. DO NOT SCALE MEASUREMENTS OFF DRAWINGS.

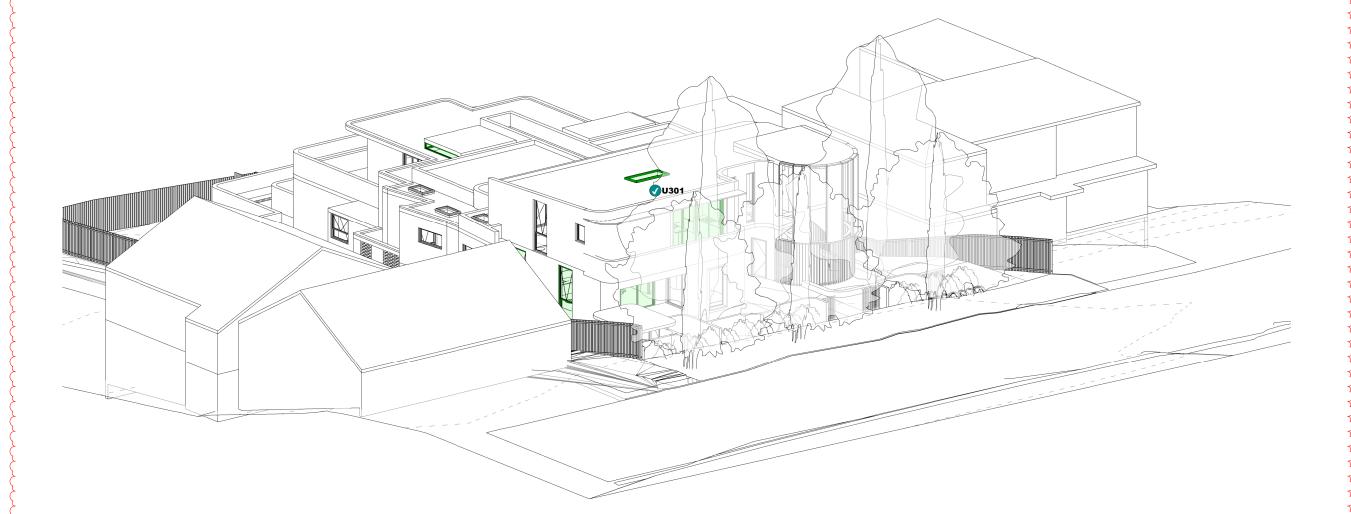

C 13/07/2023 DA AMENDMENTS B 21/03/2023 DA AMENDMENTS A 5/12/2022 DA SUBMISSION Rev. Date Description

NOT TO SCALE

Project Architect



LEVEL 2, 60 PARK STREET SYDNEY NSW 2000 P: 02 9267 2000

W: www.cdarchitects.com.au

© Copyright

CODyright of this drawing together with any other documents prepared by CD Architects (CDA) emains the property of CDA. CDA grants licence for the use of this document for the purpose for which it is intended. The licence is not transferrable without permission from CDA. Nominated Architect: Liljana Ermilova 7887, ABN 24 243 205 327



SENIOR HOUSING DEVELOPMENT

69 Melwood Avenue, Forestville

Drawing Title

SUN ANGLE VIEWS 3PM - 21 JUNE

DA SUBMISSION

J22558D DA 6027 C

| SOLAR SCHEDULE - RESIDENTIAL | | | | | | | |
|------------------------------|-------|-------|-------|-------|-------|-------|-------|
| UNIT Number | 09:00 | 10:00 | 11:00 | 12:00 | 13:00 | 14:00 | 15:00 |
| G01 | | | | | | | |
| G02 | | | | | | | |
| U101 | | | | | | | |
| U201 | | | | | | | |
| U202 | | | | | | | |
| U203 | | | | | | | |
| U301 | | | | | | | |

DIRECT SUN VIEW LEGEND

| TOTAL NUMBER OF UNITS | TARGET COMPLIANCE REQUIRED | PROPOSED UNITS RECEIVING OVER 2 HOURS SOLAR ACCESS ON JUNE 21st BETWEEN 9am-3pm | PROPOSED UNITS RECEIVING NO DIRECT SUNLIGHT ON JUNE 21st BETWEEN 9am-3pm |
|--------------------------|-------------------------------|---|--|
| 7 UNITS | 4.9 UNITS (70%) | 5 UNITS (71.4%) | 0 UNIT (0%) |
| ~~~~~~ | ~~~~~~ | ~~~~~~~~~ | . ~ ~ ~ ~ ~ ~ ~ ~ |

OUNIT NUMBER

PROPOSED UNIT NUMBER RECEIVING DIRECT SOLAR ACCESS AT THE SPECIFIC SUN ANGLE VIEWS

LIVING RECEIVING DIRECT SOLAR ACCESS ON JUNE 21St AT SPECIFIC TIME

LIVING RECEIVING NO DIRECT SOLAR ACCESS ON JUNE 21St AT SPECIFIC TIME

APARTMENT RECEIVING DIRECT SOLAR ACCESS ON JUNE 21St AT SPECIFIC TIME

DRAWINGS TO BE READ IN CONJUNCTION WITH BUT NOT LIMITED TO ALL STRUCTURAL ENGINEERS, STORMWATER ENGINEERS, LANDSCAPE ARCHITECTS, AND OTHER ASSOCIATED PLANS & REPORTS

REFER TO THE BASIX REPORT FOR ADDITIONAL REQUIREMENTS.

NOTES

ALL DIMENSIONS AND SETOUTS ARE TO BE VERIFIED ON SITE AND ALL OMISSIONS OR ANY DISCREPANCIES TO BE NOTIFIED TO THE ARCHITECT. FIGURED DIMENSIONS TO BE USED AT ALL TIME. DO NOT SCALE MEASUREMENTS OFF DRAWINGS.

C 13/07/2023 DA AMENDMENTS B 21/03/2023 DA AMENDMENTS A 5/12/2022 DA SUBMISSION

1:100 at A1 1:200 at A3



Rev. Date Description

LEVEL 2, 60 PARK STREET SYDNEY NSW 2000 P: 02 9267 2000 W: www.cdarchitects.com.au

© Copyright

The copyright of this drawing together with any other documents prepared by CD Architects (CDA) remains the property of CDA. CDA grants licence for the use of this document for the purpose for which it is intended. The licence is not transferable without permission from CDA.

Nominated Architect: Lijana Ermilova 7887, ABN 24 243 205 327




SENIOR HOUSING DEVELOPMENT

69 Melwood Avenue, Forestville

Drawing Title


SOLAR SCHEDULE

DA SUBMISSION Job no. J22558D DA 6028 C

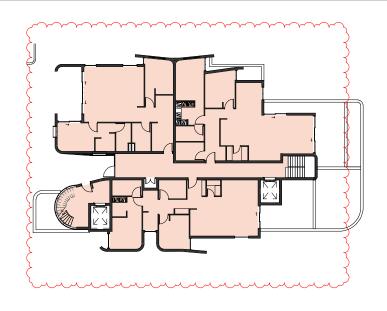

3 LEVEL 2

1:200

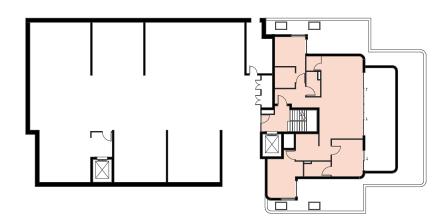



2 LEVEL 1

1:200

GROUND LEVEL

1:200

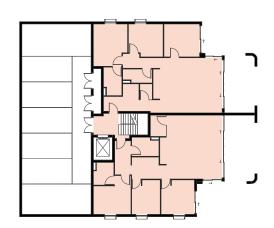

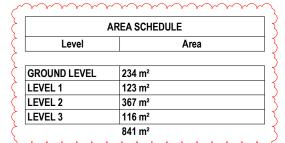


AREA CALCULATIONS - FLOOR SPACE RATIO

| ZONE | RZ. |
|---|--------------------|
| SITE AREA | 1421m² |
| PERMISSIBLE FLOOR SPACE RATIO PERMISSIBLE GFA | 0.5 : 1 710.5m² |
| PROPOSED FLOOR SPACE RATIO PROPOSED GFA | 0.591 841m² |
| mmmm | Jun |
| | |

WARRINGAH LOCAL ENVIRONMENTAL PLAN 2011

| SITE AREA | 1421m² |
|---------------------|------------------------------|
| ZONING | R2 - LOW DENSITY RESIDENTIAL |
| COUNCIL | NORTHERN BEACHES COUNCIL |
| FLOOR SPACE RATIO | 0:5 : 1 |
| HEIGHT OF BUILDING | 8.5m |
| MINIMUM LOT SIZE | 600m² |
| HERITAGE | NA |
| ACID SULPHATE SOILS | NA |
| KEY SITE | NA |
| FLOOD PLANNING AREA | NA |
| | |

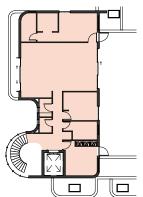

4 LEVEL 3


1:200



DEEP SOIL ZONE AREA REQUIRED: 213.2sqm (15% of SITE AREA) DEEP SOIL ZONE AREA PROVIDED: 413.3sqm (29% of SITE AREA)

As per State Environmental Planning Policy (Housing) 2021

Deep Soil Zones: a deep soil zone on at least 15% of the site area, where each deep soil zone has minimum dimensions of 3m and, if practicable, at least 65% of the deep soil zone is located at the rear of the site.

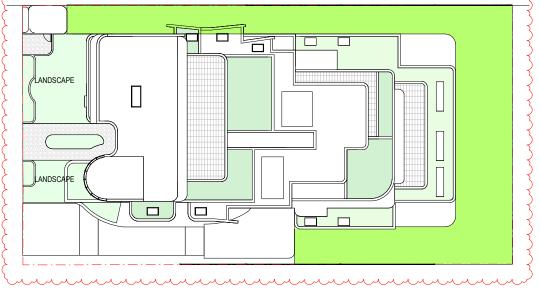

LANDSCAPE AREA REQUIRED:

495,6sgm (35% of SITE AREA) TOTAL LANDSCAPE AREA PROVIDED: 723.25sqm (50.9% of SITE AREA)

As per State Environmental Planning Policy (Housing) 2021

Landscaped Area means that part of the site area that is not occupied by any building

- (a) for a development application made by a social housing provider -- at least 35m² of landscaped area per dwelling.
- (b) if paragraph (d) does not apply -- at least 30% of the site area is landscaped.

| ΞГ | EK | EN | UE | 3 | |
|----|----|----|----|---|--|
| | | | | | |
| | | | | | |

DRAWINGS TO BE READ IN CONJUNCTION WITH BUT NOT LIMITED TO ALL STRUCTURAL ENGINEERS, STORMWATER ENGINEERS, LANDSCAPE ARCHITECTS, AND OTHER ASSOCIATED PLANS & REPORTS

REFER TO THE BASIX REPORT FOR ADDITIONAL REQUIREMENTS.

LIST OF CHANGES: 13.07.2023
• GFA DIAGRAMS / CALCULATONS &

ALL DIMENSIONS AND SETOUTS ARE TO BE VERIFIED ON SITE AND ALL OMISSIONS OR ANY DISCREPANCIES TO BE NOTIFIED TO THE ARCHITECT. FIGURED DIMENSIONS TO BE USED AT ALL TIME. DO NOT SCALE MEASUREMENTS OFF DRAWINGS.



C 13/07/2023 DA AMENDMENTS 21/03/2023 DA AMENDMENTS 5/12/2022 DA SUBMISSION Rev. Date Description 1:200 at A1 1:400 at A3

LEVEL 2, 60 PARK STREET SYDNEY NSW 2000

P: 02 9267 2000 W: www.cdarchitects.com.au

© Copyright

The copyright of this drawing together with any other documents prepared by CD Architects (CDA) remains the property of CDA. CDA grants licence for the use of this document for the purpose for which it is intended. The licence is not transferable without permission from CDA.



SENIOR HOUSING DEVELOPMENT

69 Melwood Avenue, Forestville

Drawing Title

GFA CALCULATION


| DA SUBMISSI | ON | | |
|-------------|-------------|------|--|
| Job no. | Drawing no. | Rev. | |
| J22558D | DA 7001 | С | |


REFER TO THE BASIX REPORT FOR ADDITIONAL REQUIREMENTS.

NOTES

ALL DIMENSIONS AND SETOUTS ARE TO BE VERIFIED ON SITE AND ALL OMISSIONS OR ANY DISCREPANCIES TO BE NOTIFIED TO THE ARCHITECT. FIGURED DIMENSIONS TO BE USED AT ALL TIME. DO NOT SCALE MEASUREMENTS OFF DRAWINGS.



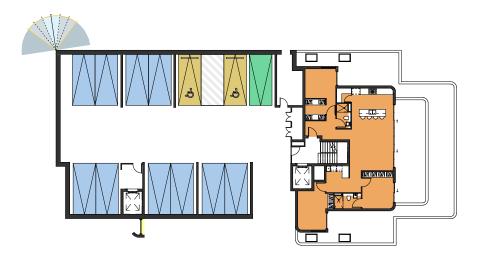

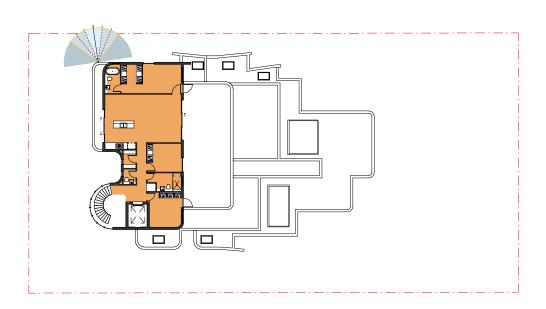


2 LEVEL 1 FLOOR PLAN

1:200

4 LEVEL 3 FLOOR PLAN

1:200



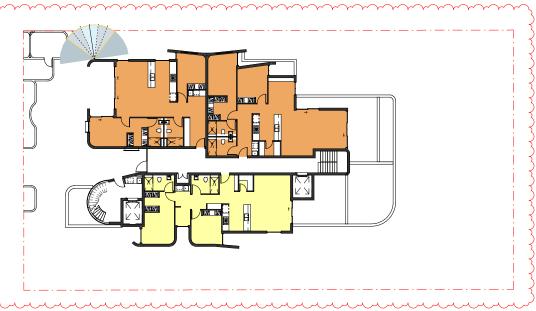

1 SOLAR ACCESS - GROUND LEVEL

1:200

3 LEVEL 2 FLOOR PLAN

1:200

| TOTAL NUMBER | TARGET | PROPOSED UNITS RECEIVING |
|--------------|---|--|
| OF UNITS | COMPLIANCE REQUIRED | OVER 2 HOURS SOLAR ACCES ON JUNE 21st BETWEEN 9am - |
| 7UNITS | 4.9 UNITS (70%) | .5 UNITS (71,4%) |
| | APARTMENTS / BALCONIES RE SOLAR ACCESS ON JUNE 21St | |
| | APARTMENTS / BALCONIES RE SOLAR ACCESS ON JUNE 21St | |
| | APARTMENTS / BALCONIES RE ON JUNE 21St BETWEEN 9am - | |

| В | 13/07/2 | 2023 | DA AMEN | NDMEN | NTS | |
|-----------------|---------|------|-----------|--------|---------------|----|
| Α | 5/12/20 | 22 | DA SUBN | /ISSIO | N | |
| Rev. | Date | | Descripti | on | | |
| Scale m 0 | 2 | 4 | 00 at A1 | 1:40 | 12 D at A3 | 16 |
| | | 1.2 | 00 41711 | 1.40 | 0 41710 | |



LEVEL 2, 60 PARK STREET SYDNEY NSW 2000 P: 02 9267 2000

W: www.cdarchitects.com.au

© Copyright

The copyright of this drawing together with any other documents prepared by CD Architects (CDA) remains the property of CDA. CDA grants licence for the use of this document for the purpose for which it is intended. The Icence is not transferable without permission from CDA.

Nominated Architect Lijiana Ermilway 7887, ABN 24 243 205 327



SENIOR HOUSING DEVELOPMENT

69 Melwood Avenue,

Forestville Drawing Title

SOLAR ACCESS PLAN

| DA SUBMISSI | ON | | |
|-------------|-------------|------|--|
| Job no. | Drawing no. | Rev. | |
| J22558D | DA 7011 | В | |

Drawn by Checked by Approved by Date HF RJ ZC SEP. 2022

LIST OF CHANGES: 13.07.2023
CROSS VENTILATION DIAGRAMS / CALCULATION REVISED

REFERENCES


DRAWINGS TO BE READ IN CONJUNCTION WITH BUT NOT LIMITED TO ALL STRUCTURAL ENGINEERS, STORMWATER ENGINEERS, LANDSCAPE ARCHITECTS, AND OTHER ASSOCIATED PLANS & REPORTS

REFER TO THE BASIX REPORT FOR ADDITIONAL REQUIREMENTS.

NOTES

ALL DIMENSIONS AND SETOUTS ARE TO BE VERIFIED ON SITE AND ALL OMISSIONS OR ANY DISCREPANCIES TO BE NOTIFIED TO THE ARCHITECT. FIGURED DIMENSIONS TO BE USED AT ALL TIME. DO NOT SCALE MEASUREMENTS OFF DRAWINGS.




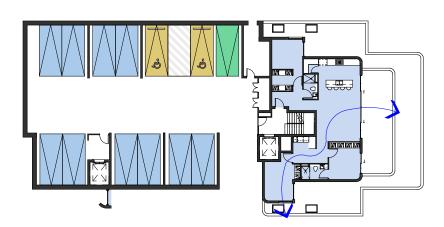


4 LEVEL 3 FLOOR PLAN

1:200

 \Box

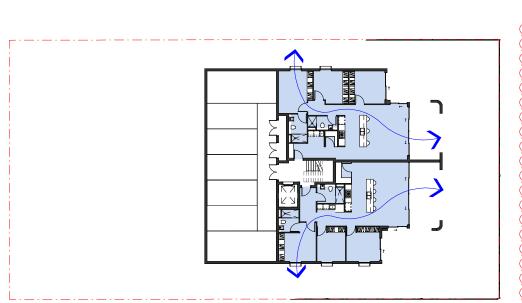

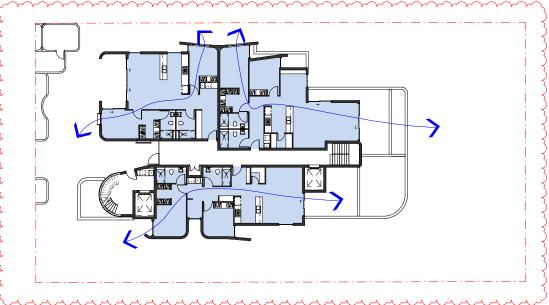

1 VENTILATION DIAGRAM - GROUND FLOOR

1:200

2 LEVEL 1 FLOOR PLAN

1:200

3 LEVEL 2 FLOOR PLAN

1:200

VENTILATION LEGEND

TOTAL NUMBER PROPOSED UNITS RECEIVING TARGET COMPLIANCE REQUIREDNATURAL CROSS VENTILATION 7 UNITS 4.2 UNITS (60%) 7 UNITS (100%) NATURAL CROSS VENTILATED APARTMENTS NATURAL CROSS VENTILATED APARTMENTS NATURAL CROSS VENTILATED CORRIDOR

| | | | DMENTS | |
|--------|-----------|-------------|------------|------|
| A 5 | 5/12/2022 | DA SUBMI | SSION | |
| Rev. D | Date | Description | n | |
| Scale | 2 4 | 8_ | 1: | 2 16 |
| 0 | 1:20 | 00 at A1 | 1:400 at A | 3 |



LEVEL 2, 60 PARK STREET SYDNEY NSW 2000 P: 02 9267 2000

W: www.cdarchitects.com.au

© Copyright

The copyright of this drawing together with any other documents prepared by CD Architects (CDA) remains the property of CDA. CDA grants licence for the use of this document for the purpose for which it is intended. The licence is not transferable without permission from CDA.

Normicrated Architect. 18 licens Employa. 7887. ASIN. 24, 243.305.372



SENIOR HOUSING DEVELOPMENT

69 Melwood Avenue,

Forestville

Drawing Title **VENTILATION DIAGRAMS**

DA SUBMISSION Job no. Drawing no. J22558D DA 7021 C



REFER TO THE BASIX REPORT FOR ADDITIONAL REQUIREMENTS.

NOTES

ALL DIMENSIONS AND SETOUTS ARE TO BE VERIFIED ON SITE AND ALL OMISSIONS OR ANY DISCREPANCIES TO BE NOTIFIED TO THE ARCHITECT. FIGURED DIMENSIONS TO BE USED AT ALL TIME. DO NOT SCALE MEASUREMENTS OFF DRAWINGS.

B 13/07/2023 DA AMENDMENTS A 5/12/2022 DA SUBMISSION

Rev. Date Description

NOT TO SCALE







LEVEL 2, 60 PARK STREET SYDNEY NSW 2000 P: 02 9267 2000

W: www.cdarchitects.com.au

© Copyright

The copyright of this drawing together with any other documents prepared by CD Architects (CDA) remains the property of CDA. CDA grants licence for the use of this document for the purpose for which it is intended. The licence is not transferable without permission from CDA.

Nominated Architect: Lijana Ermilova 7887, ABN 24 243 205 327



SENIOR HOUSING DEVELOPMENT

69 Melwood Avenue, Forestville

Drawing Title

3D VIEW - LANDSCAPE SHEET 1

| DA SUBMISSION | l |
|---------------|---|
|---------------|---|

Drawing no.

J22558D DA 7035 B

 Drawn by
 Checked by
 Approved by
 Date

 HF
 RJ
 ZC
 SEP. 2022

LIST OF CHANGES: 13.07.2023

• 3D VIEW REVISED AS PER
CHANGES TO ELEVATIONS

REFERENCES

DRAWINGS TO BE READ IN CONJUNCTION WITH BUT NOT LIMITED TO ALL STRUCTURAL ENGINEERS, STORMWATER ENGINEERS, LANDSCAPE ARCHITECTS, AND OTHER ASSOCIATED PLANS & REPORTS

REFER TO THE BASIX REPORT FOR ADDITIONAL REQUIREMENTS.

NOTES

ALL DIMENSIONS AND SETOUTS ARE TO BE VERIFIED ON SITE AND ALL OMISSIONS OR ANY DISCREPANCIES TO BE NOTIFIED TO THE ARCHITECT. FIGURED DIMENSIONS TO BE USED AT ALL TIME. DO NOT SCALE MEASUREMENTS OFF DRAWINGS.



B 13/07/2023 DA AMENDMENTS A 5/12/2022 DA SUBMISSION

Rev. Date Description

NOT TO SCALE

Project Architect



LEVEL 2, 60 PARK STREET SYDNEY NSW 2000 P: 02 9267 2000 W: www.cdarchitects.com.au

© Copyright

The copyright of this drawing together with any other documents prepared by CD Architects (CDA) remains the property of CDA. CDA grants licence for the use of this document for the purpose for which it is intended. The licence is not transferable without permission from CDA.

Nominated Architect: Lijana Ermilova 7887, ABN 24 243 205 327



SENIOR HOUSING DEVELOPMENT

69 Melwood Avenue,

Forestville

Drawing Title
3D VIEW - LANDSCAPE SHEET 2

DA SUBMISSION Job no.

Drawing no.

 J22558D
 DA 7036
 B

 Drawn by
 Checked by Approved by BF
 Date SEP. 2022

LIST OF CHANGES: 13.07.2023 • NO CHANGE

MATERIAL LEGEND_SHEET

BR1 PGH MORADA BLANCO - STACK BOND

> RENDER PAINTED - DULUX WHISPER RP1 WHITE

STADNING SEAM SOLID ALUMINIUM SS1 CLADDING - Duratec Zeus - Lunar Eclipse -

Satin - Dulux Powder Coatings



DRAWINGS TO BE READ IN CONJUNCTION WITH BUT NOT LIMITED TO ALL STRUCTURAL ENGINEERS, STORMWATER ENGINEERS, LANDSCAPE ARCHITECTS, AND OTHER ASSOCIATED PLANS & REPORTS

REFER TO THE BASIX REPORT FOR ADDITIONAL REQUIREMENTS.

ALL DIMENSIONS AND SETOUTS ARE TO BE VERIFIED ON SITE AND ALL OMISSIONS OR ANY DISCREPANCIES TO BE NOTIFIED TO THE ARCHITECT. FIGURED DIMENSIONS TO BE USED AT ALL TIME. DO NOT SCALE MEASUREMENTS OFF DRAWINGS.

A 5/12/2022 DA SUBMISSION

Rev. Date Description



LEVEL 2, 60 PARK STREET SYDNEY NSW 2000 P: 02 9267 2000

W: www.cdarchitects.com.au

© Copyright

The copyright of this drawing together with any other documents prepared by CD Architects (CDA) remains the property of CDA. CDA grants licence for the use of this document for the purpose for which it is intended. The licence is not transferable without permission from CDA.

Nominated Architect Lilipian Emiliowa 7887, ABN 24 243 205 327



SENIOR HOUSING DEVELOPMENT

69 Melwood Avenue, Forestville

Drawing Title
FINISHES SCHEDULE


DA SUBMISSION

J22558D DA 7041 A



REFER TO THE BASIX REPORT FOR ADDITIONAL REQUIREMENTS.

ALL DIMENSIONS AND SETOUTS ARE TO BE VERIFIED ON SITE AND ALL OMISSIONS OR ANY DISCREPANCIES TO BE NOTIFIED TO THE ARCHITECT. FIGURED DIMENSIONS TO BE USED AT ALL TIME. DO NOT SCALE MEASUREMENTS OFF DRAWINGS.

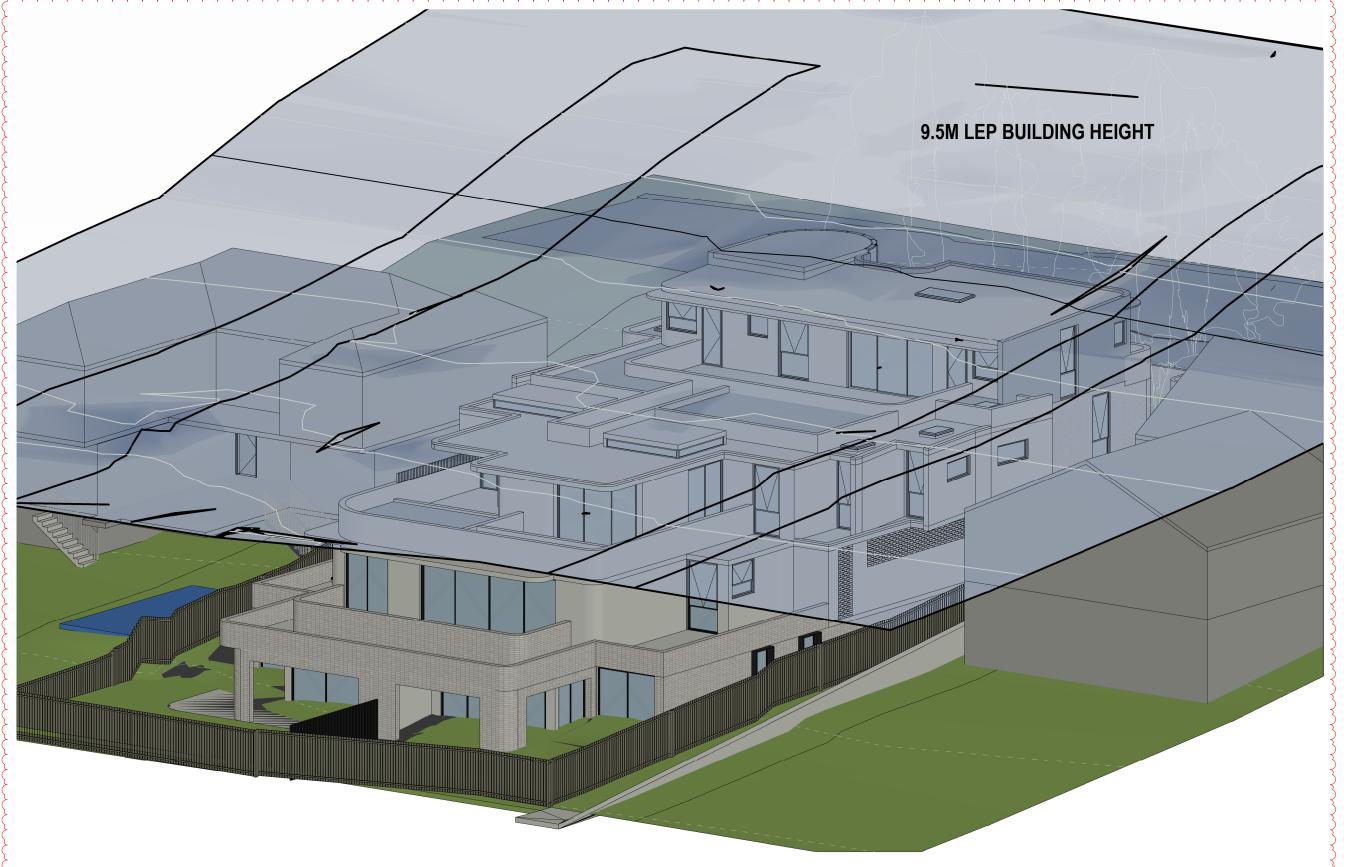

C 13/07/2023 DA AMENDMENTS B 21/03/2023 DA AMENDMENTS A 5/12/2022 DA SUBMISSION

Rev. Date Description

LEVEL 2, 60 PARK STREET SYDNEY NSW 2000 P: 02 9267 2000

W: www.cdarchitects.com.au

© Copyright

© Copyright
The copyright of this drawing together with any other documents prepared by
OD Architects (CDA) remains the property of CDA. CDA grants licence for the
use of this document for the purpose for which it is intended. The licence is
not transferable without permission from CDA.
Nominated Architect. Liljana Ermilova 7887, ABN 24 243 205 327



SENIOR HOUSING DEVELOPMENT

69 Melwood Avenue, Forestville


Drawing Title

LEP HEIGHT BLANKET

DA SUBMISSION

J22558D DA 7051 C

Checked by Approved by Date
Checker ZC SEP. 2022

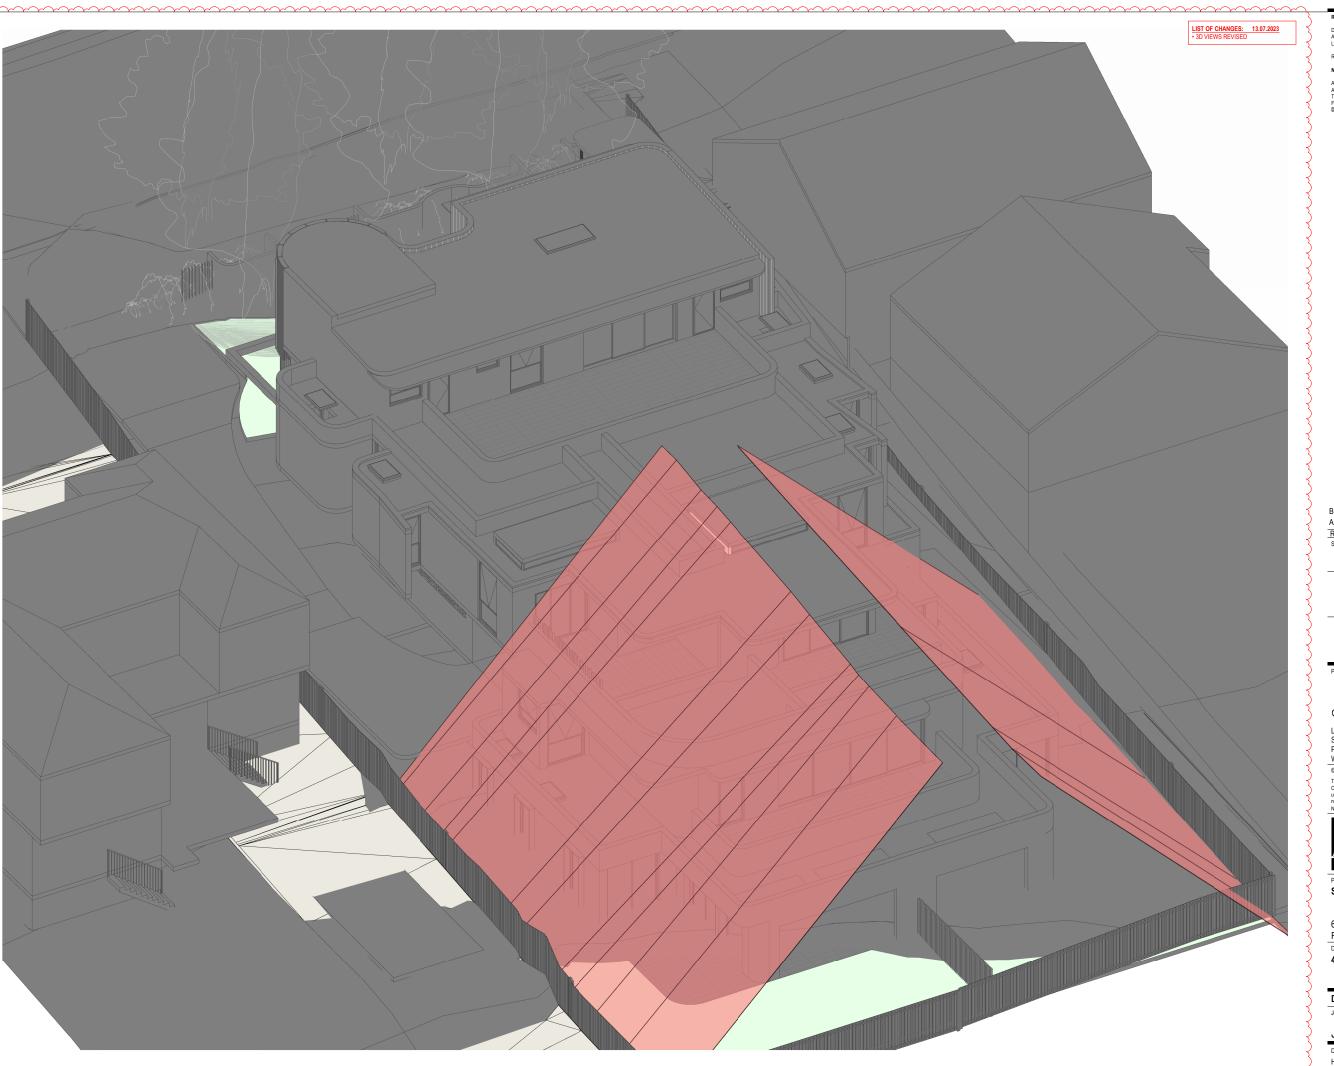

REFER TO THE BASIX REPORT FOR ADDITIONAL REQUIREMENTS.

ALL DIMENSIONS AND SETOUTS ARE TO BE VERIFIED ON SITE AND ALL OMISSIONS OR ANY DISCREPANCIES TO BE NOTIFIED TO THE ARCHITECT. FIGURED DIMENSIONS TO BE USED AT ALL TIME. DO NOT SCALE MEASUREMENTS OFF DRAWINGS.

13/07/2023 DA AMENDMENTS A 21/03/2023 DA AMENDMENTS

Rev. Date Description 1:100 at A1 1:200 at A3



LEVEL 2, 60 PARK STREET SYDNEY NSW 2000 P: 02 9267 2000

W: www.cdarchitects.com.au

© Copyright

The copyright of this drawing together with any other documents prepared by CD Architects (CDA) remains the property of CDA. CDA grants licence for the use of this document for the purpose for which it is intended. The Icence is not transferable without permission from CDA.

Nominated Architect Lijiana Ermilway 7887, ABN 24 243 205 327



SENIOR HOUSING DEVELOPMENT


69 Melwood Avenue,

Forestville

Drawing Title
45 DEGREE BLANKET - 1

DA SUBMISSION

J22558D DA 7061 B

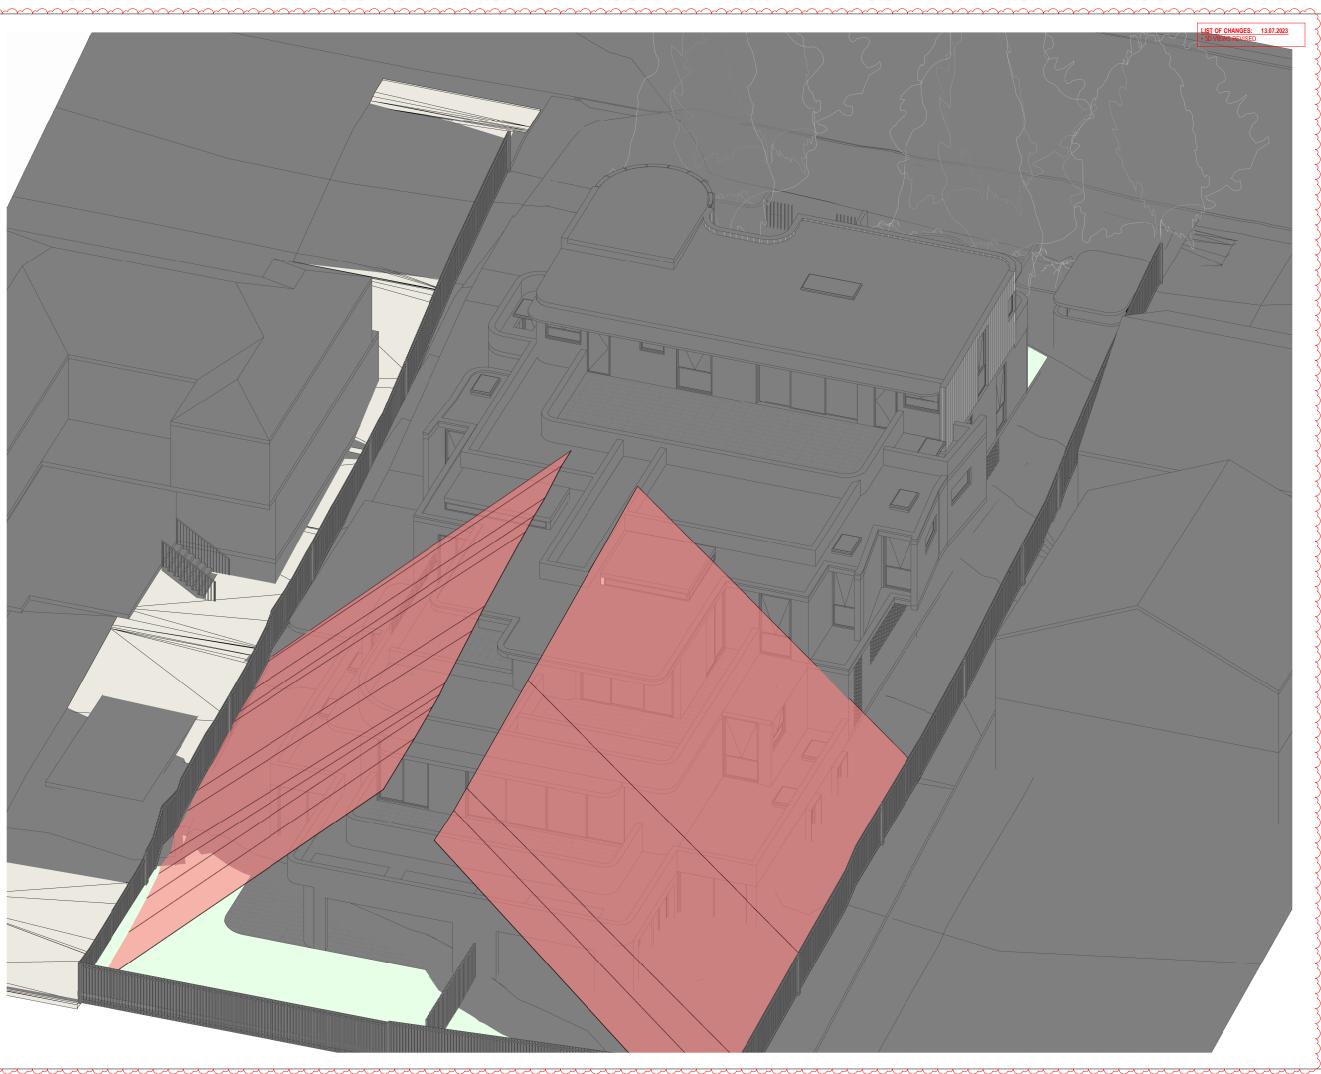

REFER TO THE BASIX REPORT FOR ADDITIONAL REQUIREMENTS.

ALL DIMENSIONS AND SETOUTS ARE TO BE VERIFIED ON SITE AND ALL OMISSIONS OR ANY DISCREPANCIES TO BE NOTIFIED TO THE ARCHITECT. FIGURED DIMENSIONS TO BE USED AT ALL TIME. DO NOT SCALE MEASUREMENTS OFF DRAWINGS.

13/07/2023 DA AMENDMENTS A 21/03/2023 DA AMENDMENTS

Rev. Date Description 1:100 at A1 1:200 at A3

LEVEL 2, 60 PARK STREET SYDNEY NSW 2000 P: 02 9267 2000

W: www.cdarchitects.com.au

© Copyright

The copyright of this drawing together with any other documents prepared by CD Architects (CDA) remains the property of CDA. CDA grants licence for the use of this document for the purpose for which it is intended. The licence is not transferable without permission from CDA.

Nominated Architect: Lijana Ermilova 7887, ABN 24 243 205 327



SENIOR HOUSING DEVELOPMENT


69 Melwood Avenue, Forestville

Drawing Title

45 DEGREE BLANKET - 2

DA SUBMISSION

J22558D DA 7062 B

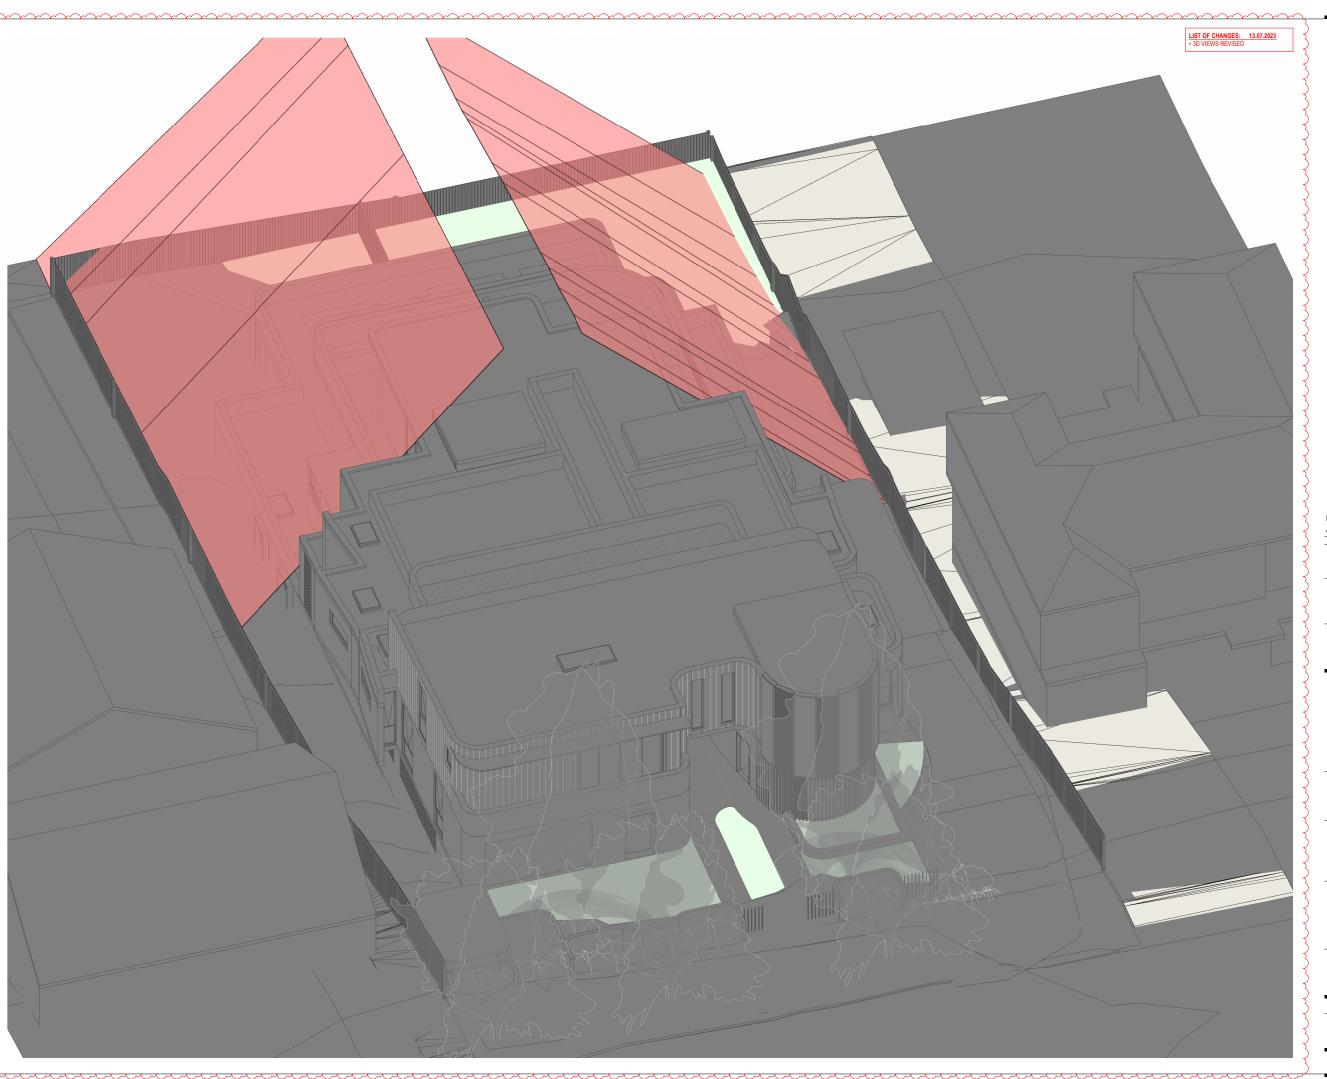

REFER TO THE BASIX REPORT FOR ADDITIONAL REQUIREMENTS.

ALL DIMENSIONS AND SETOUTS ARE TO BE VERIFIED ON SITE AND ALL OMISSIONS OR ANY DISCREPANCIES TO BE NOTIFIED TO THE ARCHITECT. FIGURED DIMENSIONS TO BE USED AT ALL TIME. DO NOT SCALE MEASUREMENTS OFF DRAWINGS.

13/07/2023 DA AMENDMENTS A 21/03/2023 DA AMENDMENTS

Rev. Date Description 1:100 at A1 1:200 at A3

LEVEL 2, 60 PARK STREET SYDNEY NSW 2000 P: 02 9267 2000

W: www.cdarchitects.com.au

© Copyright

The copyright of this drawing together with any other documents prepared by CD Architects (CDA) emains the property of CDA. CDA grants licence for the use of this document for the purpose for which it is intended. The Icence is not transferable without permission from CDA. Nominated Architect Lilgian Emilior #887, ABN 24 243 205 327



SENIOR HOUSING DEVELOPMENT

69 Melwood Avenue, Forestville

Drawing Title
45 DEGREE BLANKET - 3

DA SUBMISSION

J22558D DA 7063 B

LIST OF CHANGES: 13.07.2023



REFERENCES

DRAWINGS TO BE READ IN CONJUNCTION WITH BUT NOT LIMITED TO ALL STRUCTURAL ENGINEERS, STORMWATER ENGINEERS, LANDSCAPE ARCHITECTS, AND OTHER ASSOCIATED PLANS & REPORTS

REFER TO THE BASIX REPORT FOR ADDITIONAL REQUIREMENTS.

NOTES

ALL DIMENSIONS AND SETOUTS ARE TO BE VERIFIED ON SITE AND ALL OMISSIONS OR ANY DISCREPANCIES TO BE NOTIFIED TO THE ARCHITECT. FIGURED DIMENSIONS TO BE USED AT ALL TIME. DO NOT SCALE MEASUREMENTS OFF DRAWINGS.

CALE MEASUREMENTS OFF DRAWII

A 5/12/2022 DA SUBMISSION

Rev. Date Description

CDARCHITECTS

LEVEL 2, 60 PARK STREET SYDNEY NSW 2000 P: 02 9267 2000

W: www.cdarchitects.com.au

© Copyright

The copyright of this drawing together with any other documents prepared by CD Architects (CDA) remains the property of CDA. CDA grants licence for the use of this document for the purpose for which it is intended. The licence is not transferable without permission from CDA.

Norminated Architect Lilians Enrollman 7887. ARM 24 24 30 5 327



SENIOR HOUSING DEVELOPMENT

69 Melwood Avenue,

Forestville

BUS LOCATION DIAGRAM & BUS 273 TIMETABLE

DA SUBMISSION

_ ___

 J22558D
 DA 7080
 A

 Drawn by
 Checked by
 Approved by
 Date

REFER TO THE BASIX REPORT FOR ADDITIONAL REQUIREMENTS.

ALL DIMENSIONS AND SETOUTS ARE TO BE VERIFIED ON SITE AND ALL OMISSIONS OR ANY DISCREPANCIES TO BE NOTIFIED TO THE ARCHITECT. FIGURED DIMENSIONS TO BE USED AT ALL TIME. DO NOT SCALE MEASUREMENTS OFF DRAWINGS.

Monday to Friday map ref Route Number
G Cook Street Retirement Villages 16:20 16:45
 06:12
 06:52
 07:09
 07:29
 07:58
 08:24
 08:34
 Por off-peak times,

 06:16
 06:56
 07:13
 07:34
 08:02
 08:28
 08:38
 see Forestville to

 06:19
 06:59
 07:16
 07:37
 08:07
 08:31
 08:41
 Killarney Heights

 06:23
 07:03
 07:20
 07:42
 08:17
 08:37
 08:47
 Shuttle Loop timetable
 H Cook Street & Starkey Street 16:21 16:46 Westmeath Avenue & Rathowen Parade 16:25 16:50 Melwood Avenue & Starkey Street
 Melwood Avenue & Cannons Parade
 Forestville Jamieson Square 16:28 16:53 16:32 16:57 16:35 17:00 E East Roseville Babbage Road 06:31 07:11 07:28 07:50 08:24 -16:39 17:04

06:41 07:21 07:40 08:03 08:37

Chatswood to Killarney Heights (Loop Service)

16:51 17:16

| | Monday to Friday | 6. | Ġ. | Ġ. | 6. | Ġ | 6. | 6. | 6 | 6. | |
|----------|------------------------------------|-------|-------|-------|-------|-------|-------|-------|---------------------|----------------|-------|
| ap ef | Route Number | 278 | 278 | 278 | 278 | 278 | 278 | 278 | | 278 | 278 |
| Α | Chatswood Station Interchange | - | - | - | - | 07:40 | 08:05 | 08:15 | | S 15:40 | 16:00 |
| Ε | East Roseville Babbage Road | - | - | - | - | 07:50 | 08:15 | 08:25 | | S 15:50 | 16:10 |
| F | Forestville Jamieson Square | 06:11 | 06:51 | 07:08 | 07:28 | 07:57 | 08:23 | 08:33 | For off-peak times, | 16:05 | 16:18 |
| G | Cook Street Retirement Villages | - | - | - | - | - | - | - | see Forestville to | 16:07 | 16:20 |
| | Cook Street & Starkey Street | 06:12 | 06:52 | 07:09 | 07:29 | 07:58 | 08:24 | 08:34 | Killarney Heights | 16:08 | 16:21 |
| | Westmeath Avenue & Rathowen Parade | 06:16 | 06:56 | 07:13 | 07:34 | 08:02 | 08:28 | 08:38 | Shuttle Loop | 16:11 | 16:25 |
| J | Melwood Avenue & Starkey Street | 06:19 | 06:59 | 07:16 | 07:37 | 08:07 | 08:31 | 08:41 | timetable | 16:15 | 16:28 |
| K | Melwood Avenue & Cannons Parade | 06:23 | 07:03 | 07:20 | 07:42 | 08:11 | 08:35 | 08:45 | | - | 16:32 |
| L | Forestville RSL | - | - | - | - | - | - | - | | 16:19 | - |
| E | Forestville Jamieson Square | 06:25 | 07:05 | 07:22 | 07:44 | 08:17 | 08:37 | 08:47 | | 16:20 | 16:35 |
| | | | | | | | | | | | |

Forestville to Killarney Heights Shuttle Loop

| | Monday to Friday | 6. | Ġ. | Ġ. | 6. | è | 6. | Ġ. | 6. | Ġ. | Ġ | 6. | 6 |
|------------|------------------------------------|-------|-------|-------|-------|-------|-------|-------|-------|-------|-------|-------|-------|
| map ref | Route Number | 278 | 278 | 278 | 278 | 278 | 278 | 278 | 278 | 278 | 278 | 278 | 278 |
| F | Forestville Jamieson Square | 08:40 | 08:55 | 09:15 | 09:35 | 09:55 | 10:15 | 10:35 | 10:55 | 11:15 | 11:35 | 11:55 | 12:15 |
| G | Cook Street Retirement Villages | 08:42 | 08:57 | 09:17 | 09:37 | 09:57 | 10:17 | 10:37 | 10:57 | 11:17 | 11:37 | 11:57 | 12:17 |
| Н | Cook Street & Starkey Street | 08:43 | 08:58 | 09:18 | 09:38 | 09:58 | 10:18 | 10:38 | 10:58 | 11:18 | 11:38 | 11:58 | 12:18 |
| П | Westmeath Avenue & Rathowen Parade | 08:46 | 09:01 | 09:21 | 09:41 | 10:01 | 10:21 | 10:41 | 11:01 | 11:21 | 11:41 | 12:01 | 12:21 |
| J | Melwood Avenue & Starkey Street | 08:50 | 09:05 | 09:25 | 09:45 | 10:05 | 10:25 | 10:45 | 11:05 | 11:25 | 11:45 | 12:05 | 12:25 |
| L | Forestville RSL | 08:54 | 09:09 | 09:29 | 09:49 | 10:09 | 10:29 | 10:49 | 11:09 | 11:29 | 11:49 | 12:09 | 12:29 |
| F | Forestville Jamieson Square | 08:55 | 09:10 | 09:30 | 09:50 | 10:10 | 10:30 | 10:50 | 11:10 | 11:30 | 11:50 | 12:10 | 12:30 |

| Monday to Friday (continued) | 6. | | ė. | ė. | P | ė. | ė. | ė. |
|------------------------------------|-------|-------|-------|-------|-------|-------|-------|--------|
| nap ref Route Number | 278 | 278 | 278 | 278 | 278 | 278 | 278 | 278 |
| G Cook Street Retirement Villages | - | - | - | - | - | - | - | - |
| H Cook Street & Starkey Street | 17:14 | 17:44 | 18:09 | 18:29 | 18:54 | 19:38 | 20:33 | 21:28 |
| Westmeath Avenue & Rathowen Parade | 17:19 | 17:49 | 18:14 | 18:34 | 18:59 | 19:43 | 20:38 | 21:33 |
| Melwood Avenue & Starkey Street | 17:22 | 17:52 | 18:17 | 18:36 | 19:01 | 19:45 | 20:40 | 21:35 |
| K Melwood Avenue & Cannons Parade | 17:26 | 17:56 | 18:21 | 18:39 | 19:04 | 19:49 | 20:44 | 21:38 |
| F Forestville Jamieson Square | 17:32 | 17:59 | 18:24 | 18:42 | 19:07 | 19:51 | 20:46 | A21:40 |
| E East Roseville Babbage Road | 17:36 | 18:03 | 18:28 | - | - | 19:55 | 20:50 | - |
| A Chatswood Station Interchange | 17:48 | 18:15 | 18:40 | - | - | 20:04 | 20:59 | - |

| | Monday to Friday (continued) | | 6. | | 6 | & | 6 | Ġ. | 6. | 6 |
|------------|------------------------------------|-------|-------|-------|-------|-------|-------|-------|-------|-------|
| map ref | Route Number | 278 | 278 | 278 | 278 | 278 | 278 | 278 | 278 | 278 |
| Α | Chatswood Station Interchange | 16:25 | 16:55 | 17:25 | 17:50 | 18:10 | 18:35 | 19:25 | 20:20 | 21:15 |
| Ε | East Roseville Babbage Road | 16:35 | 17:05 | 17:35 | 18:00 | 18:20 | 18:45 | 19:30 | 20:25 | 21:20 |
| F | Forestville Jamieson Square | 16:43 | 17:13 | 17:43 | 18:08 | 18:28 | 18:53 | 19:37 | 20:32 | 21:27 |
| G | Cook Street Retirement Villages | 16:45 | - | - | - | - | - | - | - | - |
| Н | Cook Street & Starkey Street | 16:46 | 17:14 | 17:44 | 18:09 | 18:29 | 18:54 | 19:38 | 20:33 | 21:28 |
| П | Westmeath Avenue & Rathowen Parade | 16:50 | 17:19 | 17:49 | 18:14 | 18:34 | 18:59 | 19:43 | 20:38 | 21:33 |
| J | Melwood Avenue & Starkey Street | 16:53 | 17:22 | 17:52 | 18:17 | 18:36 | 19:01 | 19:45 | 20:40 | 21:35 |
| K | Melwood Avenue & Cannons Parade | 16:57 | 17:26 | 17:56 | 18:21 | 18:39 | 19:04 | 19:49 | 20:44 | 21:38 |
| L | Forestville RSL | - | - | - | - | - | - | - | - | - |
| F | Forestville Jamieson Square | 17:00 | 17:32 | 17:59 | 18:24 | 18:42 | 19:07 | 19:51 | 20:46 | A21:4 |

| | Monday to Friday (continued) | 6. | 6 | 6. | 6 | Ġ | 6. | Ġ. | 6. | 6 | خ |
|------------|------------------------------------|-------|-------|-------|-------|-------|-------|-------|-------|-------|-------|
| map ref | Route Number | 278 | 278 | 278 | 278 | 278 | 278 | 278 | 278 | 278 | 278 |
| F | Forestville Jamieson Square | 12:35 | 12:55 | 13:15 | 13:35 | 13:55 | 14:15 | 14:35 | 14:55 | 15:40 | 16:05 |
| G | Cook Street Retirement Villages | 12:37 | 12:57 | 13:17 | 13:37 | 13:57 | 14:17 | 14:37 | 14:57 | 15:42 | 16:07 |
| H | Cook Street & Starkey Street | 12:38 | 12:58 | 13:18 | 13:38 | 13:58 | 14:18 | 14:38 | 14:58 | 15:43 | 16:08 |
| | Westmeath Avenue & Rathowen Parade | 12:41 | 13:01 | 13:21 | 13:41 | 14:01 | 14:21 | 14:41 | 15:01 | 15:46 | 16:11 |
| J | Melwood Avenue & Starkey Street | 12:45 | 13:05 | 13:25 | 13:45 | 14:05 | 14:25 | 14:45 | 15:05 | 15:50 | 16:15 |
| L | Forestville RSL | 12:49 | 13:09 | 13:29 | 13:49 | 14:09 | 14:29 | 14:49 | 15:09 | 15:54 | 16:19 |
| F | Forestville Jamieson Square | 12:50 | 13:10 | 13:30 | 13:50 | 14:10 | 14:30 | 14:50 | 15:10 | 15:55 | 16:20 |
| | | | | | | | | | | | |

| | 5/12/2022 | DA SUBMISSION | |
|------|-----------|---------------|--|
| lev. | Date | Description | |

Killarney Heights to Chatswood

Killarney Heights to Chatswood

A Chatswood Station Interchange

Forestville to Killarney Heights Shuttle Loop

Forestville to Killarney Heights Shuttle Loop

| | Saturday | ė. | కు | ė. | é. | ė. | క | ė. | 6. | ė. | 6. | ė. |
|------------|------------------------------------|-------|-------|-------|-------|-------|-------|-------|-------|-------|-------|-------|
| map ref | Route Number | 278 | 278 | 278 | 278 | 278 | 278 | 278 | 278 | 278 | 278 | 278 |
| F | Forestville Jamieson Square | 07:55 | 08:15 | 08:35 | 08:55 | 09:15 | 09:35 | 09:55 | 10:15 | 10:35 | 10:55 | 11:15 |
| G | Cook Street Retirement Villages | 07:57 | 08:17 | 08:37 | 08:57 | 09:17 | 09:37 | 09:57 | 10:17 | 10:37 | 10:57 | 11:17 |
| Н | Cook Street & Starkey Street | 07:58 | 08:18 | 08:38 | 08:58 | 09:18 | 09:38 | 09:58 | 10:18 | 10:38 | 10:58 | 11:18 |
| П | Westmeath Avenue & Rathowen Parade | 08:01 | 08:21 | 08:41 | 09:01 | 09:21 | 09:41 | 10:01 | 10:21 | 10:41 | 11:01 | 11:21 |
| J | Melwood Avenue & Starkey Street | 08:05 | 08:25 | 08:45 | 09:05 | 09:25 | 09:45 | 10:05 | 10:25 | 10:45 | 11:05 | 11:25 |
| L | Forestville RSL | 08:09 | 08:29 | 08:49 | 09:09 | 09:29 | 09:49 | 10:09 | 10:29 | 10:49 | 11:09 | 11:29 |
| F | Forestville Jamieson Square | 08:10 | 08:30 | 08:50 | 09:10 | 09:30 | 09:50 | 10:10 | 10:30 | 10:50 | 11:10 | 11:30 |

Forestville to Killarney Heights Shuttle Loop

| | Saturday (continued) | ė. | 6. | ė | 6. | ė. | Ġ. | ė. | కు | Ġ. |
|------------|------------------------------------|-------|-------|-------|-------|-------|-------|-------|-------|-------|
| map ref | Route Number | 278 | 278 | 278 | 278 | 278 | 278 | 278 | 278 | 278 |
| F | Forestville Jamieson Square | 15:15 | 15:35 | 15:55 | 16:15 | 16:35 | 16:55 | 17:15 | 17:35 | 17:55 |
| G | Cook Street Retirement Villages | 15:17 | 15:37 | 15:57 | 16:17 | 16:37 | 16:57 | 17:17 | 17:37 | 17:57 |
| Н | Cook Street & Starkey Street | 15:18 | 15:38 | 15:58 | 16:18 | 16:38 | 16:58 | 17:18 | 17:38 | 17:58 |
| П | Westmeath Avenue & Rathowen Parade | 15:21 | 15:41 | 16:01 | 16:21 | 16:41 | 17:01 | 17:21 | 17:41 | 18:01 |
| J | Melwood Avenue & Starkey Street | 15:25 | 15:45 | 16:05 | 16:25 | 16:45 | 17:05 | 17:25 | 17:45 | 18:05 |
| L | Forestville RSL | 15:29 | 15:49 | 16:09 | 16:29 | 16:49 | 17:09 | 17:29 | 17:49 | 18:09 |
| F | Forestville Jamieson Square | 15:30 | 15:50 | 16:10 | 16:30 | 16:50 | 17:10 | 17:30 | 17:50 | 18:10 |

Forestville to Killarney Heights Shuttle Loop

| | Sunday & Public Holidays (continued) | 6 | 6. | Ġ. | 6. | Ġ. | 6. | 6 | 6. | 8 | 6. | Ġ. |
|------------|--------------------------------------|-------|-------|-------|-------|-------|-------|-------|-------|-------|-------|-------|
| map ref | Route Number | 278 | 278 | 278 | 278 | 278 | 278 | 278 | 278 | 278 | 278 | 278 |
| F | Forestville Jamieson Square | 11:35 | 11:55 | 12:15 | 12:35 | 12:55 | 13:15 | 13:35 | 13:55 | 14:15 | 14:35 | 14:55 |
| G | Cook Street Retirement Villages | 11:37 | 11:57 | 12:17 | 12:37 | 12:57 | 13:17 | 13:37 | 13:57 | 14:17 | 14:37 | 14:57 |
| Н | Cook Street & Starkey Street | 11:38 | 11:58 | 12:18 | 12:38 | 12:58 | 13:18 | 13:38 | 13:58 | 14:18 | 14:38 | 14:58 |
| | Westmeath Avenue & Rathowen Parade | 11:41 | 12:01 | 12:21 | 12:41 | 13:01 | 13:21 | 13:41 | 14:01 | 14:21 | 14:41 | 15:01 |
| J | Melwood Avenue & Starkey Street | 11:45 | 12:05 | 12:25 | 12:45 | 13:05 | 13:25 | 13:45 | 14:05 | 14:25 | 14:45 | 15:05 |
| L | Forestville RSL | 11:49 | 12:09 | 12:29 | 12:49 | 13:09 | 13:29 | 13:49 | 14:09 | 14:29 | 14:49 | 15:09 |
| F | Forestville Jamieson Square | 11:50 | 12:10 | 12:30 | 12:50 | 13:10 | 13:30 | 13:50 | 14:10 | 14:30 | 14:50 | 15:10 |

CDARCHITECTS

LEVEL 2, 60 PARK STREET SYDNEY NSW 2000

P: 02 9267 2000 W: www.cdarchitects.com.au

© Copyright

The copyright of this drawing together with any other documents prepared by CD Architects (CDA) remains the property of CDA. CDA grants licence for the use of this document for the purpose for which it is inherinded. The licence is not transferable without permission from CDA. Normitated Architect Lilipian Ermitavo 7867. ABN 24 243 205 327



SENIOR HOUSING DEVELOPMENT

69 Melwood Avenue,

Forestville

Drawing Title **BUS ROUTE 278 TIMETABLE**

DA SUBMISSION Job no.

J22558D DA 7081 A

Checked by Approved by Date SEP. 2022

| | Saturday (continued) | ė. | 6. | 6 | 6. | 6. | 6. | Ġ. | 6. | 6. | 6. | 6. |
|------------|------------------------------------|-------|-------|-------|-------|-------|-------|-------|-------|-------|-------|-------|
| map ref | Route Number | 278 | 278 | 278 | 278 | 278 | 278 | 278 | 278 | 278 | 278 | 278 |
| F | Forestville Jamieson Square | 11:35 | 11:55 | 12:15 | 12:35 | 12:55 | 13:15 | 13:35 | 13:55 | 14:15 | 14:35 | 14:55 |
| G | Cook Street Retirement Villages | 11:37 | 11:57 | 12:17 | 12:37 | 12:57 | 13:17 | 13:37 | 13:57 | 14:17 | 14:37 | 14:57 |
| H | Cook Street & Starkey Street | 11:38 | 11:58 | 12:18 | 12:38 | 12:58 | 13:18 | 13:38 | 13:58 | 14:18 | 14:38 | 14:58 |
| | Westmeath Avenue & Rathowen Parade | 11:41 | 12:01 | 12:21 | 12:41 | 13:01 | 13:21 | 13:41 | 14:01 | 14:21 | 14:41 | 15:01 |
| J | Melwood Avenue & Starkey Street | 11:45 | 12:05 | 12:25 | 12:45 | 13:05 | 13:25 | 13:45 | 14:05 | 14:25 | 14:45 | 15:05 |
| L | Forestville RSL | 11:49 | 12:09 | 12:29 | 12:49 | 13:09 | 13:29 | 13:49 | 14:09 | 14:29 | 14:49 | 15:09 |
| E | Forestville Jamieson Square | 11:50 | 12:10 | 12:30 | 12:50 | 13:10 | 13:30 | 13:50 | 14:10 | 14:30 | 14:50 | 15:10 |

| | Sunday & Public Holidays | Ġ | 6. | Ġ | 6. | Ġ | 6. | Ġ | 6. | Ġ. | 6. | Ġ |
|------------|------------------------------------|-------|-------|-------|-------|-------|-------|-------|-------|-------|-------|-------|
| map ref | Route Number | 278 | 278 | 278 | 278 | 278 | 278 | 278 | 278 | 278 | 278 | 278 |
| F | Forestville Jamieson Square | 07:55 | 08:15 | 08:35 | 08:55 | 09:15 | 09:35 | 09:55 | 10:15 | 10:35 | 10:55 | 11:15 |
| G | Cook Street Retirement Villages | 07:57 | 08:17 | 08:37 | 08:57 | 09:17 | 09:37 | 09:57 | 10:17 | 10:37 | 10:57 | 11:17 |
| H | Cook Street & Starkey Street | 07:58 | 08:18 | 08:38 | 08:58 | 09:18 | 09:38 | 09:58 | 10:18 | 10:38 | 10:58 | 11:18 |
| | Westmeath Avenue & Rathowen Parade | 08:01 | 08:21 | 08:41 | 09:01 | 09:21 | 09:41 | 10:01 | 10:21 | 10:41 | 11:01 | 11:21 |
| J | Melwood Avenue & Starkey Street | 08:05 | 08:25 | 08:45 | 09:05 | 09:25 | 09:45 | 10:05 | 10:25 | 10:45 | 11:05 | 11:25 |
| L | Forestville RSL | 08:09 | 08:29 | 08:49 | 09:09 | 09:29 | 09:49 | 10:09 | 10:29 | 10:49 | 11:09 | 11:29 |
| F | Forestville Jamieson Square | 08:10 | 08:30 | 08:50 | 09:10 | 09:30 | 09:50 | 10:10 | 10:30 | 10:50 | 11:10 | 11:30 |

| | Sunday & Public Holidays (continued) | Ġ | 6. | Ġ | 6. | Ġ | 6. | ė. | 6. | ė. |
|----|--------------------------------------|-------|-------|-------|-------|-------|-------|-------|-------|-------|
| ma | Route Number | 278 | 278 | 278 | 278 | 278 | 278 | 278 | 278 | 278 |
| F | Forestville Jamieson Square | 15:15 | 15:35 | 15:55 | 16:15 | 16:35 | 16:55 | 17:15 | 17:35 | 17:55 |
| G | Cook Street Retirement Villages | 15:17 | 15:37 | 15:57 | 16:17 | 16:37 | 16:57 | 17:17 | 17:37 | 17:57 |
| Н | Cook Street & Starkey Street | 15:18 | 15:38 | 15:58 | 16:18 | 16:38 | 16:58 | 17:18 | 17:38 | 17:58 |
| 0 | Westmeath Avenue & Rathowen Parade | 15:21 | 15:41 | 16:01 | 16:21 | 16:41 | 17:01 | 17:21 | 17:41 | 18:01 |
| J | Melwood Avenue & Starkey Street | 15:25 | 15:45 | 16:05 | 16:25 | 16:45 | 17:05 | 17:25 | 17:45 | 18:05 |
| L | Forestville RSL | 15:29 | 15:49 | 16:09 | 16:29 | 16:49 | 17:09 | 17:29 | 17:49 | 18:09 |
| F | Forestville Jamieson Square | 15:30 | 15:50 | 16:10 | 16:30 | 16:50 | 17:10 | 17:30 | 17:50 | 18:10 |

Forestville to Killarney Heights Shuttle Loop Forestville to Killarney Heights Shuttle Loop Forestville to Killarney Heights Shuttle Loop