- 1. ALL LINES ARE TO BE MIN. 100Ø UPVC @ MIN 1.0% GRADE UNLESS NOTED OTHERWISE.
- 2. IT IS THE CONTRACTORS RESPONSIBILITY TO LOCATE & LEVEL ALL EXISTING SERVICES PRIOR TO THE COMMENCEMENT OF ANY EARTHWORKS. ALL DESIGN LEVELS SHOWN ON PLAN SHALL BE VERIFIED ON SITE PRIOR TO THE COMMENCEMENT OF ANY WORK.
- 3. ALL PIPES TO HAVE MIN 200mm COVER IF LOCATED WITHIN PROPERTY.
- 4. ALL PITS IN DRIVEWAYS BE HEAVY DUTY GRATES. DIRECT SURFACE FLOW TO ALL GRATED SURFACE INLET PITS.
- 5. ALL WORK DO BE DONE IN ACCORDANCE WITH AS/NZ 3500.3.2:1998 AND COUNCIL SPECIFICATIONS.
- 6. LOCATION OF DOWNPIPES & FLOOR WASTES ARE INDICATIVE ONLY. DOWNPIPE & FLOOR WASTE SIZE, LOCATION & QUANTITY TO BE DETERMINED BY BUILDER & IN ACCORDANCE WITH RELEVANT AUSTRALIAN STANDARDS.
- 7. THIS PLAN IS TO BE READ IN CONJUNCTION WITH THE ARCHITECTURAL, LANDSCAPE AND STRUCTURAL PLANS.
- 8. ANY DISCREPANCIES OR OMISSIONS SHALL BE REFERRED TO THE DESIGN ENGINEER FOR RESOLUTION.
- 9. ALL PITS OR GRATES IN TRAFFICABLE AREAS TO BE HEAVY
- 10. ALL GUTTERS WILL BE FITTED WITH LEAF GUARDS AND SHOULD BE INSPECTED AND CLEANED TO ENSURE LEAF LITTER CANNOT ENTER THE DOWNPIPES
- 11. EXISTING STORMWATER DRAINAGE TO BE UTILISED WHERE CONTRACTOR SEE FIT.

#### **LEGEND**

PIT SURFACE LEVEL INVERT LEVEL ΤK TOP OF KERB STORMWATER DRAINAGE PIPE DOWNPIPE TO RAINWATER TANK Ø100 SUBSOIL PIPE RAINWATER TANK OVER FLOW PIPE \_\_\_ OF \_\_\_\_ OF \_\_\_ PROPOSED RISING MAIN Ø80mm CAST IN-SITU **EXISTING STORMWATER PIPE** PROPOSED Ø100 DOWN PIPE O DP O<sub>DP1</sub> PROPOSED Ø150 DOWN PIPE EX-DP **EXISTING DOWN PIPE CLEAN OUT** CO DOWN PIPE SPREADERS DPS VERTICAL DROP VD VERTICAL RISER VR FLOOR WASTE 65Ø ∅ FW **GRATED INLET PIT** 200mm WIDE GRATED DRAIN 🔀 BD **BALCONY DRAIN** ⊗ PD PLANTER DRAIN RWO **ROOF RAINWATER OUTLET** RAINWATER HEAD RWH PROPOSED DOWN PIPE SPREADER ⊢ SP

SWIVEL JOINT

FLEXIBLE CONNECTOR


PUMP WELL DETAILS

AREA DRAINING TO SUMP= 39.88 m<sup>2</sup>

SUMP SIZE BASED ON 100 YEAR 2 HR STORM, I = 46.5 mm/hr, Q = CIA/3600 = 1 X 46.5 X 39.88/3600 = 0.515 L/sec VOLUME REQUIRED = 0.515 X (2X60X60) = 3708.8 L = 3.71 m<sup>3</sup> STORAGE PROVIDED 2.0 X 1.855 X 1.0 = 3.71 m<sup>3</sup>

PUMP OUT RATE BASED ON 100YR 5MIN STORM, I = 263 mm/hr Q = CIA/3600 = 1X 263 X 39.88/3600 = 2.91 L/sec Q = 5.0 L/sec (AS 3500 MIN.)

DUAL KS-08 PUMP OR EQUIVALENT TO BE INSTALLED IN SUMP AND CONNECTED TO CONTROL PANEL WHICH WILL ALLOW FOR THE PUMPS TO OPERATE SIMULTANEOUSLY ON HIGH LEVEL ALARMS AT 5.0 I/sec (PER PUMP) AT 3.07m HEAD

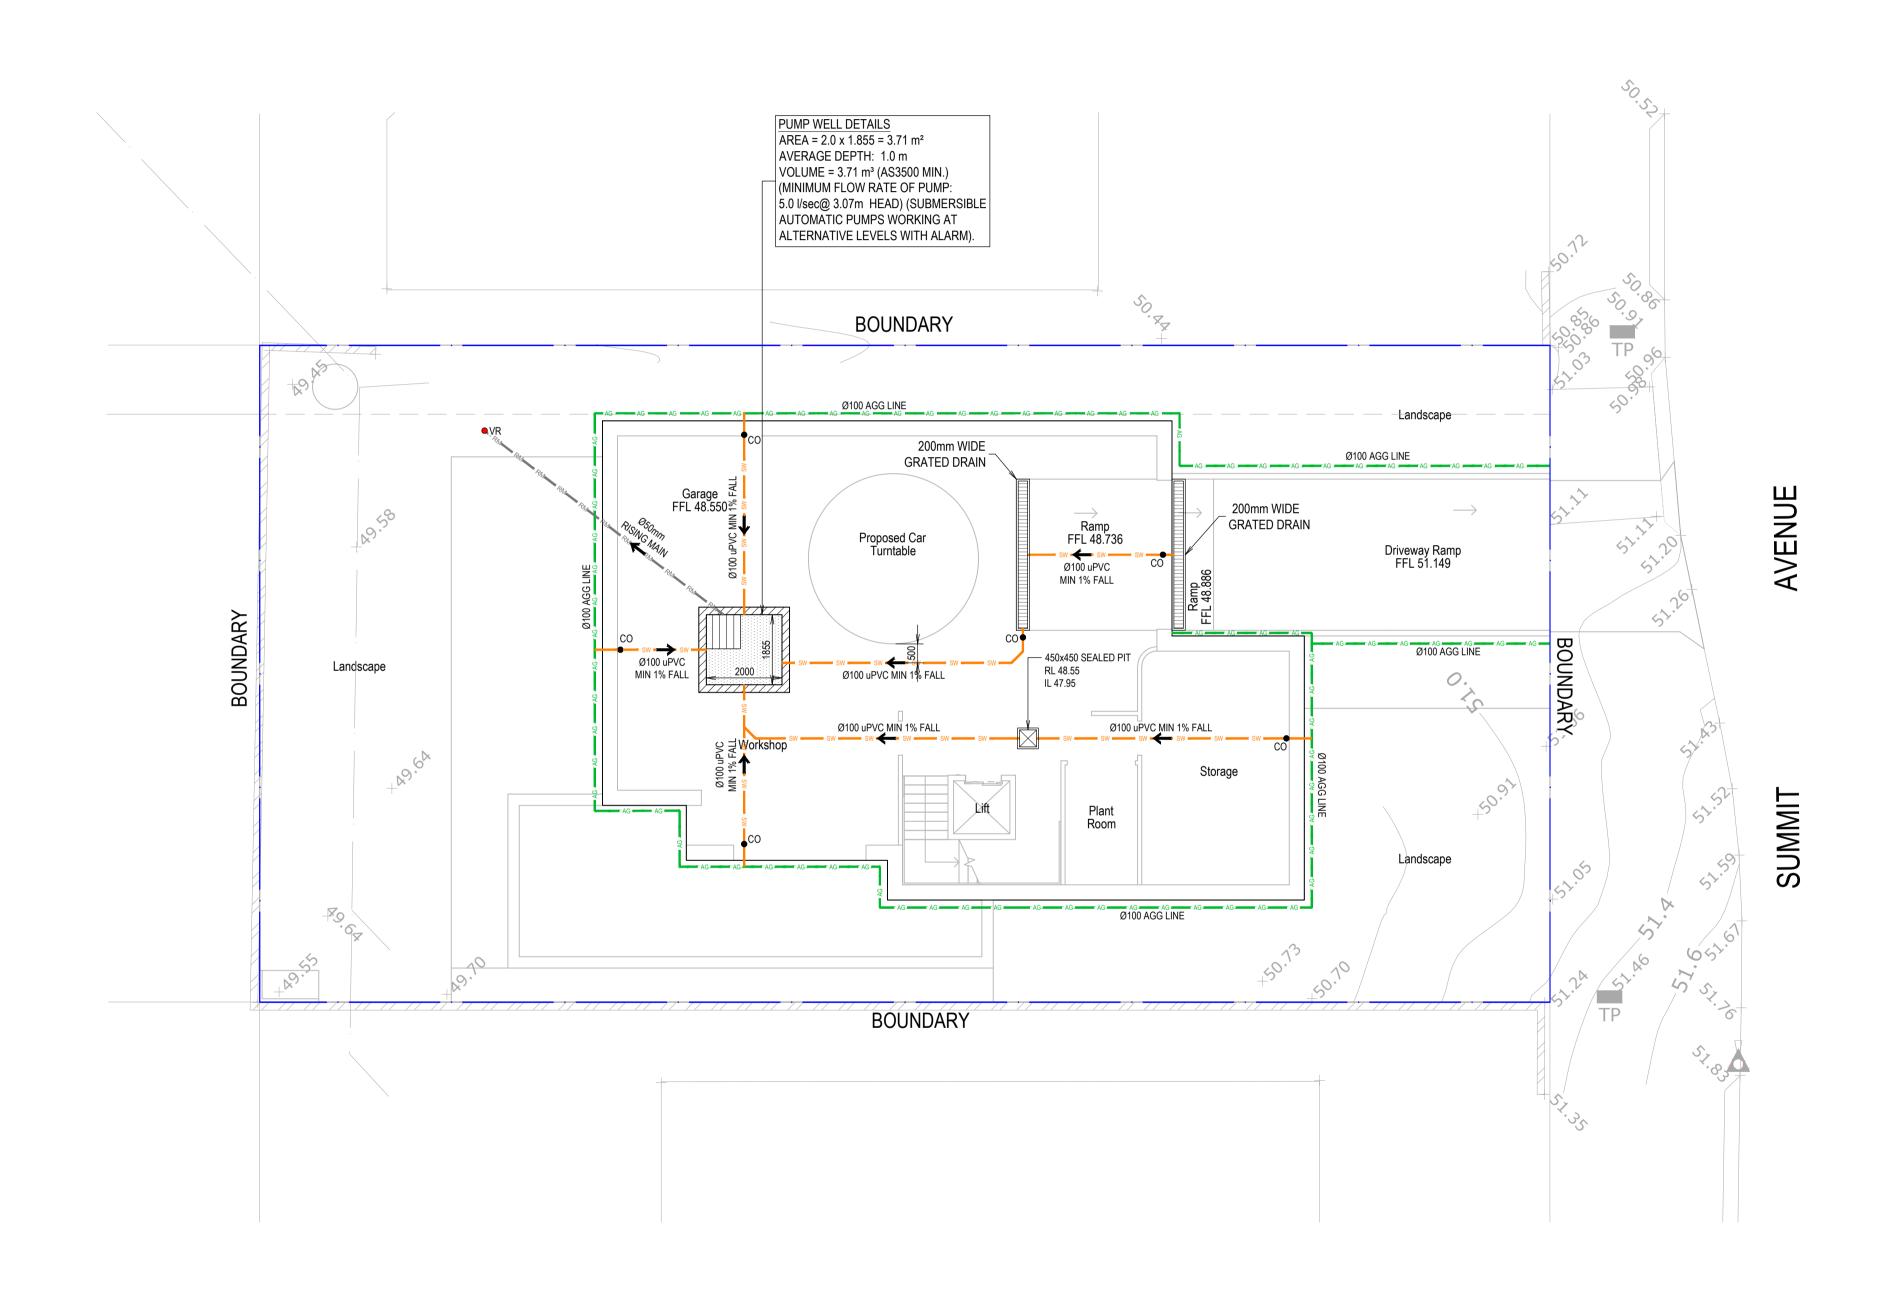

Н	ISSUED FOR APPROVAL	A.E.	A.E.	11.08.25
G	ISSUED FOR APPROVAL	A.E.	A.E.	04.06.25
F	ISSUED FOR APPROVAL	A.E.	A.E.	08.04.25
Ε	ISSUED FOR APPROVAL	A.E.	R.G.	19.03.25
D	ISSUED FOR APPROVAL	A.E.	R.G.	07.11.24
С	ISSUED FOR APPROVAL	A.E.	R.G.	01.11.24
No	AMENDMENT	ENG	DRAFT	DATE



P: 9037 0731

CONSULTING

E: info@aeconsulting.com.au

W: www.aeconsulting.com.au



MH ARCHITECTS Pty Ltd
maggie@mharchitects.net.au

www.mharchitects.net.au

+61 416113221

MICHAEL HRONOPOULOS & VANESSA ROWED STORMWATER DRAINAGE PLAN BASEMENT FLOOR LEVEL

	PROJECT: 6 SUMM	IIT AVENUE, DEE	WHY, NSW 2099						
	06.02.2024	A.E.	DESIGNED A.E.	CHECKED A.E.		ISSUED FOR APPROVAL			
	SCALE @ A1 1:100 AUTHORISED		JOB No						
			D24014			DO NOT SCALE DRAWING, USE FIGURED DIMENSIONS ONLY			
			RISED DWG No			This drawing remains the preparty of A E CONCLILITING ENCINEEDS and			
	A.E.		SW10	SW10		This drawing remains the property of A.E CONSULTING ENGINEERS and must not be reproduced or used without written consent.			

- 1. ALL LINES ARE TO BE MIN. 100Ø UPVC @ MIN 1.0% GRADE UNLESS NOTED OTHERWISE.
- 2. IT IS THE CONTRACTORS RESPONSIBILITY TO LOCATE & LEVEL ALL EXISTING SERVICES PRIOR TO THE COMMENCEMENT OF ANY EARTHWORKS. ALL DESIGN LEVELS SHOWN ON PLAN SHALL BE VERIFIED ON SITE PRIOR TO THE COMMENCEMENT OF ANY WORK.
- 3. ALL PIPES TO HAVE MIN 200mm COVER IF LOCATED WITHIN PROPERTY.
- 4. ALL PITS IN DRIVEWAYS BE HEAVY DUTY GRATES. DIRECT SURFACE FLOW TO ALL GRATED SURFACE INLET PITS.
- 5. ALL WORK DO BE DONE IN ACCORDANCE WITH AS/NZ 3500.3.2:1998 AND COUNCIL SPECIFICATIONS.
- 6. LOCATION OF DOWNPIPES & FLOOR WASTES ARE INDICATIVE ONLY. DOWNPIPE & FLOOR WASTE SIZE, LOCATION & QUANTITY TO BE DETERMINED BY BUILDER & IN ACCORDANCE WITH RELEVANT AUSTRALIAN STANDARDS.
- 7. THIS PLAN IS TO BE READ IN CONJUNCTION WITH THE ARCHITECTURAL, LANDSCAPE AND STRUCTURAL PLANS.
- 8. ANY DISCREPANCIES OR OMISSIONS SHALL BE REFERRED TO THE DESIGN ENGINEER FOR RESOLUTION.
- 9. ALL PITS OR GRATES IN TRAFFICABLE AREAS TO BE HEAVY
- 10. ALL GUTTERS WILL BE FITTED WITH LEAF GUARDS AND SHOULD BE INSPECTED AND CLEANED TO ENSURE LEAF LITTER CANNOT ENTER THE DOWNPIPES
- 11. EXISTING STORMWATER DRAINAGE TO BE UTILISED WHERE CONTRACTOR SEE FIT.

#### 

LEGEND	
RL	PIT SURFACE LEVEL
IL	INVERT LEVEL
TK	TOP OF KERB
sw sw	STORMWATER DRAINAGE PIPE
RWT RWT	DOWNPIPE TO RAINWATER TANK
AG AG	Ø100 SUBSOIL PIPE
— OF —— OF ——	RAINWATER TANK OVER FLOW PIPE
RM RM	PROPOSED RISING MAIN
-CIS-CIS-	Ø80mm CAST IN-SITU
	EXISTING STORMWATER PIPE
O DP	PROPOSED Ø100 DOWN PIPE
O DP1	PROPOSED Ø150 DOWN PIPE
© EX-DP	EXISTING DOWN PIPE
<ul><li>■ co</li></ul>	CLEAN OUT
<ul><li>DPS</li></ul>	DOWN PIPE SPREADERS
<ul><li>VD</li></ul>	VERTICAL DROP
<ul><li>VR</li></ul>	VERTICAL RISER
Ø FW	FLOOR WASTE 65Ø
	GRATED INLET PIT
	200mm WIDE GRATED DRAIN
<b>™</b> BD	BALCONY DRAIN
⊗ PD	PLANTER DRAIN
	ROOF RAINWATER OUTLET
RWH	RAINWATER HEAD
⊢● SP	PROPOSED DOWN PIPE SPREADER
<del></del>	SWIVEL JOINT

FLEXIBLE CONNECTOR

#### **DESIGN NOTES**


EFORE YOU DI

- LGA = NORTHERN BEACHES COUNCIL
- SITE CLASSIFIED IN REGION 2.
- PROPOSED NEW SINGLE DWELLING
- LOT SITE AREA = 593.08 m<sup>2</sup>
- IN ACCORDANCE WITH COUNCIL GUIDELINE OSD IS REQUIRED FOR SUBJECT DEVELOPMENT. (WATER MANAGEMENT POLICY 9.3.2) a) SITE AREA =  $593.08 \text{ m}^2 \text{ x } 40\% = 237.23 \text{ m}^2$ b) POST DEVELOPMENT IMPERVIOUS AREA = 374.40 m<sup>2</sup>
- a < b THEREFORE OSD REQUIRED

% IMPERVIOUS = 374.40/593.08 x100 = 63.1 %. (WATER MANAGEMENT POLICY, TABLE A8-2): AREA TAKEN AS 600m<sup>2</sup> FOR DESIGN PURPOSES  $SSR_{MIN} = 19.0 \text{ m}^3$ 

PSD<sub>Q5</sub> = 18 L/s

PROPOSED 4000L (MIN) RAINWATER TANK TO BE INSTALLED AS PER BASIX SPECIFICATIONS (TANK USED IN DESIGN: KINGSPAN 4000 LITRE SLIMLINE TANK. DIM: 2700 L x 880 W x 2020 H).

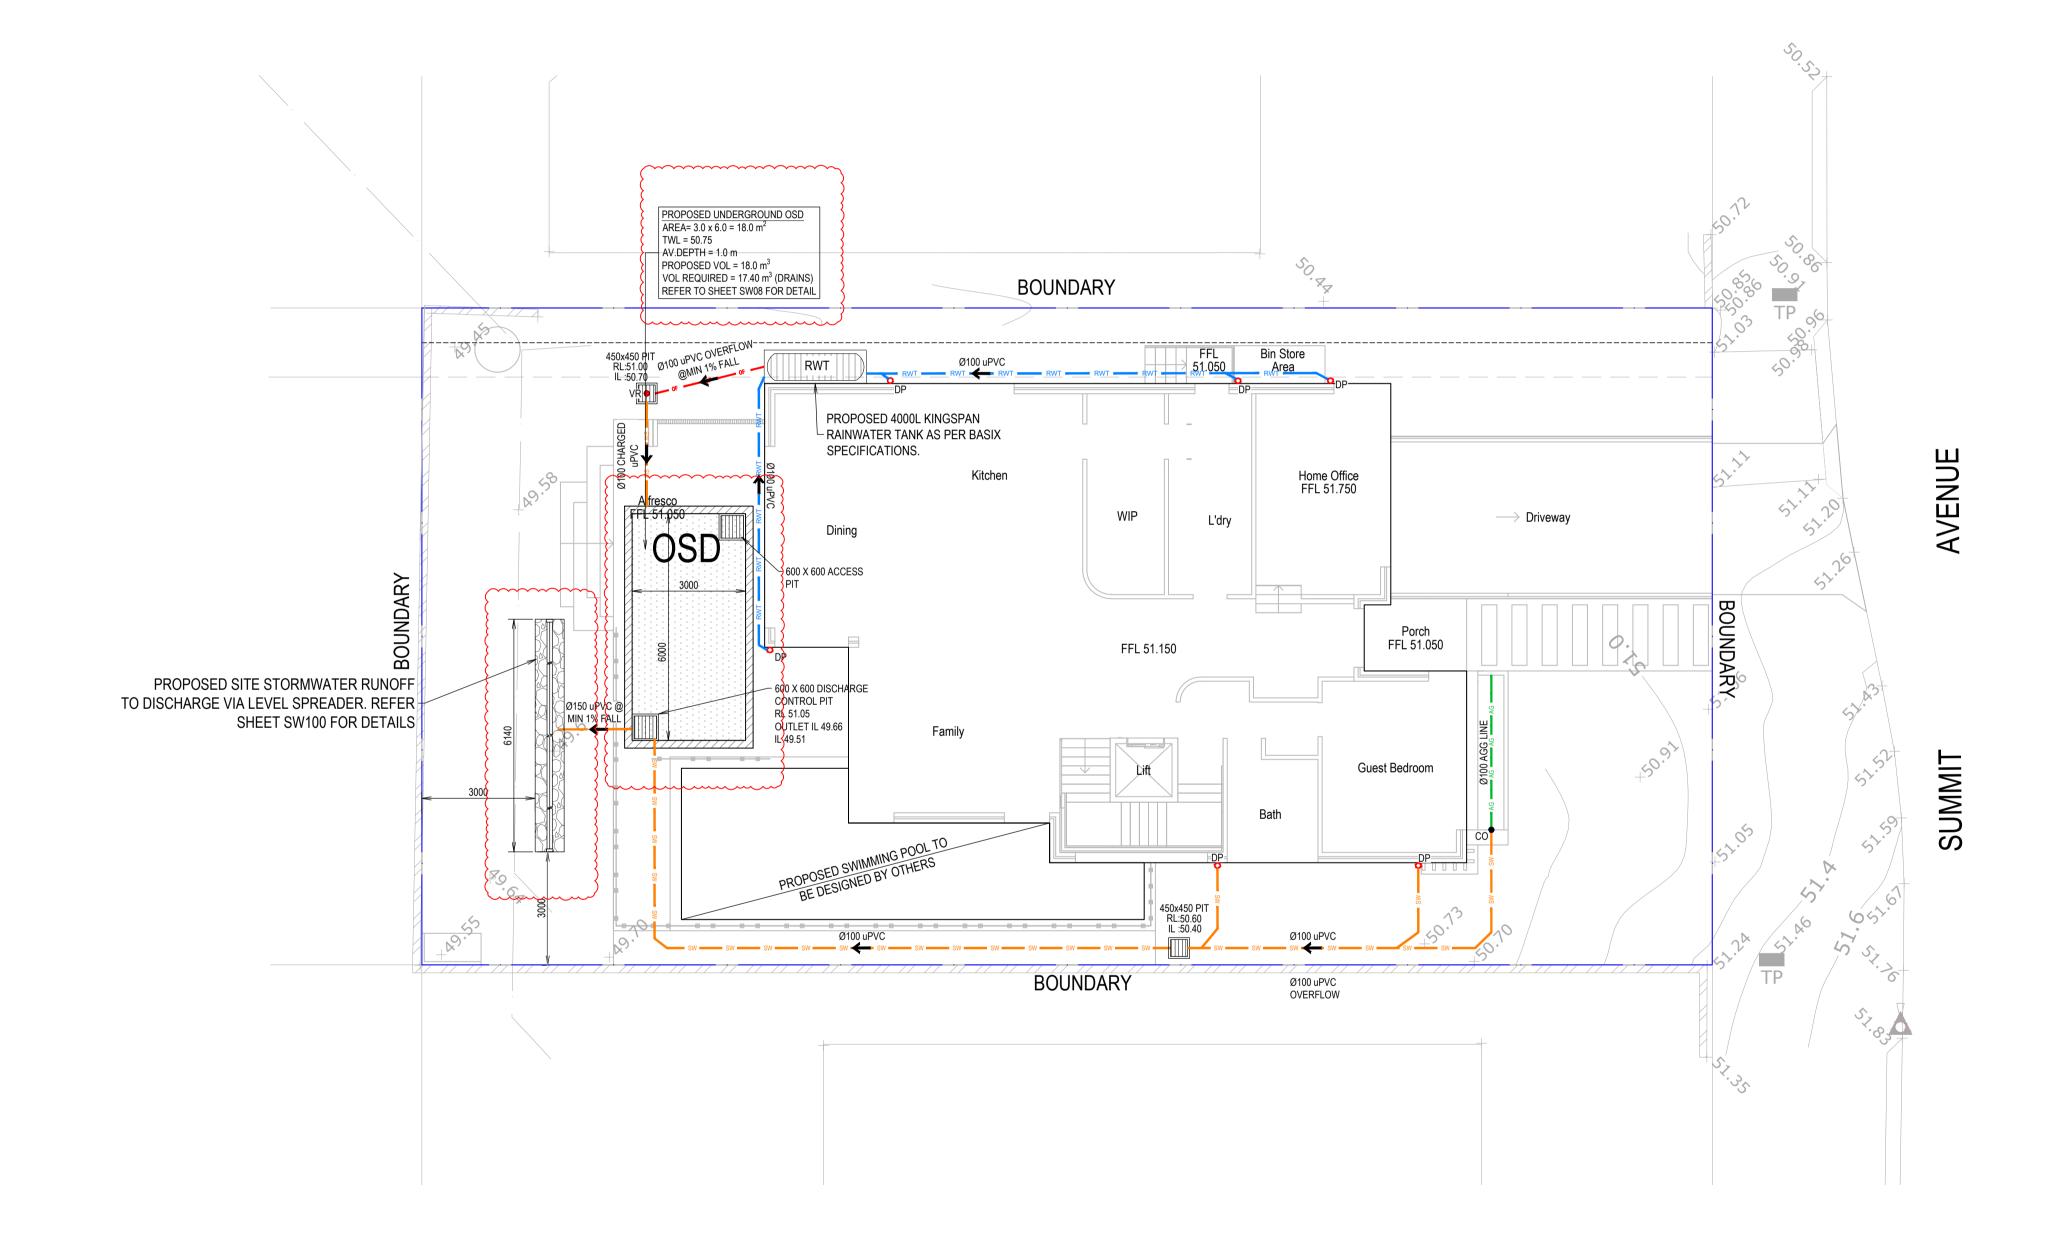

Н	ISSUED FOR APPROVAL	A.E.	A.E.	11.08.25
G	ISSUED FOR APPROVAL	A.E.	A.E.	04.06.25
F	ISSUED FOR APPROVAL	A.E.	A.E.	08.04.25
Ε	ISSUED FOR APPROVAL	A.E.	R.G.	19.03.25
D	ISSUED FOR APPROVAL	A.E.	R.G.	07.11.24
C	ISSUED FOR APPROVAL	A.E.	R.G.	01.11.24
No	AMENDMENT	FNG	DRAFT	DATE



E: info@aeconsulting.com.au

**P:** 9037 0731



MH ARCHITECTS Pty Ltd maggie@mharchitects.net.au www.mharchitects.net.au

+61 416113221

MICHAEL HRONOPOULOS & VANESSA ROWED

SHEET SUBJECT STORMWATER DRAINAGE PLAN GROUND FLOOR LEVEL

ROJECT: 6 SUMM	T AVENUE, DEE WHY	, NSW 2099						
6.02.2024	A.E.	A.E.	A.E.	ED	ISSUED FOR APPROVAL			
CALE @ A1		JOB No						
:100		D24014			DO NOT SCALE DRAWING, USE FIGURED DIMENSIONS ONLY			
UTHORISED		DWG No		REV	This drawing remains the property of A.E CONSULTING ENGINEERS and must			
A.E.		SW20		Н	not be reproduced or used without written consent.			

- 1. ALL LINES ARE TO BE MIN. 100Ø UPVC @ MIN 1.0% GRADE UNLESS NOTED OTHERWISE.
- 2. IT IS THE CONTRACTORS RESPONSIBILITY TO LOCATE & LEVEL ALL EXISTING SERVICES PRIOR TO THE COMMENCEMENT OF ANY EARTHWORKS. ALL DESIGN LEVELS SHOWN ON PLAN SHALL BE VERIFIED ON SITE PRIOR TO THE COMMENCEMENT OF ANY WORK.
- 3. ALL PIPES TO HAVE MIN 200mm COVER IF LOCATED WITHIN PROPERTY.
- 4. ALL PITS IN DRIVEWAYS BE HEAVY DUTY GRATES. DIRECT SURFACE FLOW TO ALL GRATED SURFACE INLET PITS.
- 5. ALL WORK DO BE DONE IN ACCORDANCE WITH AS/NZ 3500.3.2:1998 AND COUNCIL SPECIFICATIONS.
- 6. LOCATION OF DOWNPIPES & FLOOR WASTES ARE INDICATIVE ONLY. DOWNPIPE & FLOOR WASTE SIZE, LOCATION & QUANTITY TO BE DETERMINED BY BUILDER & IN ACCORDANCE WITH RELEVANT AUSTRALIAN STANDARDS.
- THIS PLAN IS TO BE READ IN CONJUNCTION WITH THE ARCHITECTURAL, LANDSCAPE AND STRUCTURAL PLANS.
- 8. ANY DISCREPANCIES OR OMISSIONS SHALL BE REFERRED TO THE DESIGN ENGINEER FOR RESOLUTION.
- 9. ALL PITS OR GRATES IN TRAFFICABLE AREAS TO BE HEAVY DUTY.
- 10. ALL GUTTERS WILL BE FITTED WITH LEAF GUARDS AND SHOULD BE INSPECTED AND CLEANED TO ENSURE LEAF LITTER CANNOT ENTER THE DOWNPIPES
- 11. EXISTING STORMWATER DRAINAGE TO BE UTILISED WHERE CONTRACTOR SEE FIT.

**LEGEND** RLPIT SURFACE LEVEL INVERT LEVEL ΤK TOP OF KERB STORMWATER DRAINAGE PIPE DOWNPIPE TO RAINWATER TANK Ø100 SUBSOIL PIPE RAINWATER TANK OVER FLOW PIPE \_\_\_ OF \_\_\_\_ OF \_\_\_ PROPOSED RISING MAIN Ø80mm CAST IN-SITU EXISTING STORMWATER PIPE PROPOSED Ø100 DOWN PIPE O DP O<sub>DP1</sub> PROPOSED Ø150 DOWN PIPE EX-DP **EXISTING DOWN PIPE CLEAN OUT** CO DOWN PIPE SPREADERS DPS VERTICAL DROP VD VERTICAL RISER VR FLOOR WASTE 65Ø  $\oslash$  FW **GRATED INLET PIT** 200mm WIDE GRATED DRAIN

**BALCONY DRAIN** 

PLANTER DRAIN

RAINWATER HEAD


SWIVEL JOINT

ROOF RAINWATER OUTLET

FLEXIBLE CONNECTOR

PROPOSED DOWN PIPE SPREADER



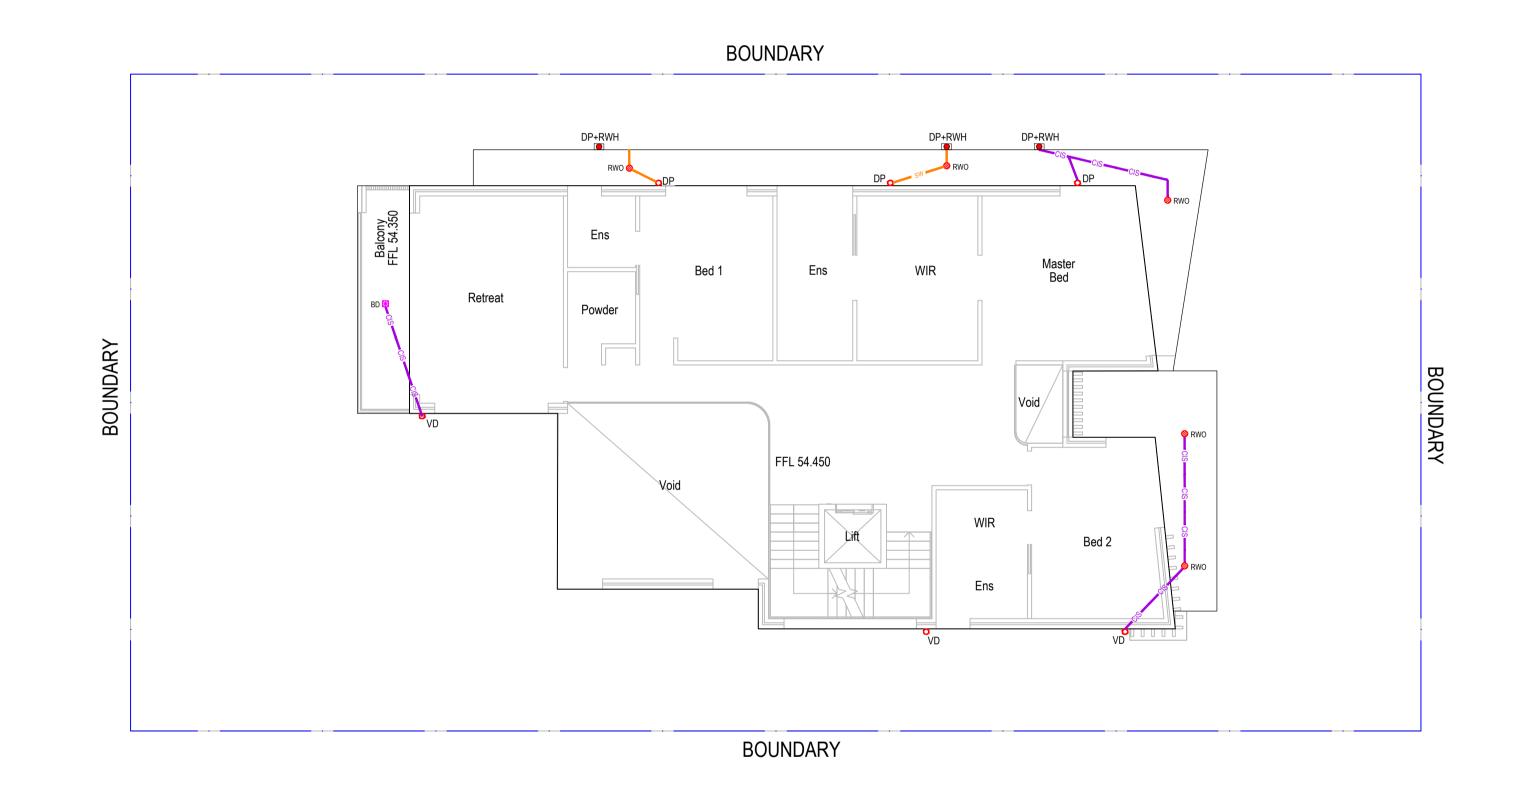

AVENUE

SUMMIT

A.E. A.E. 11.08.25 H $\mid$ ISSUED FOR APPROVAL A.E. A.E. 04.06.25  $\mathsf{S} \mid \mathsf{ISSUED}$  FOR APPROVAL A.E. A.E. 08.04.25 ISSUED FOR APPROVAL A.E. R.G. 19.03.25 ISSUED FOR APPROVAL A.E. R.G. 07.11.24 D ISSUED FOR APPROVAL A.E. R.G. 01.11.24 ISSUED FOR APPROVAL ENG DRAFT DATE AMENDMENT

**™** BD

⊗ PD

RWO

RWH

⊢● SP

<del>----</del>

ENGINEERS

P: 9037 0731 E: info@aeconsulting.com.au CONSULTING w: www.aeconsulting.com.au

ARCHITECT MH ARCHITECTS Pty Ltd maggie@mharchitects.net.au www.mharchitects.net.au

+61 416113221

MICHAEL HRONOPOULOS & VANESSA ROWED

SHEET SUBJECT STORMWATER DRAINAGE PLAN FIRST FLOOR LEVEL

PROJECT: 6 SUMM	IT AVENUE, DEE WHY,	NSW 2099					
06.02.2024	A.E.	DESIGNED A.E.	A.E.				ISSUED FOR APPROVAL
SCALE @ A1 1:100		JOB No D24014			DO NOT SCALE DRAWING, USE FIGURED DIMENSIONS ONLY		
A.E.				REV H	his drawing remains the property of A.E CONSULTING ENGINEERS and must not be reproduced or used without written consent.		


- 1. ALL LINES ARE TO BE MIN. 100Ø UPVC @ MIN 1.0% GRADE UNLESS NOTED OTHERWISE.
- 2. IT IS THE CONTRACTORS RESPONSIBILITY TO LOCATE & LEVEL ALL EXISTING SERVICES PRIOR TO THE COMMENCEMENT OF ANY EARTHWORKS. ALL DESIGN LEVELS SHOWN ON PLAN SHALL BE VERIFIED ON SITE PRIOR TO THE COMMENCEMENT OF ANY WORK.
- 3. ALL PIPES TO HAVE MIN 200mm COVER IF LOCATED WITHIN PROPERTY.
- 4. ALL PITS IN DRIVEWAYS BE HEAVY DUTY GRATES. DIRECT SURFACE FLOW TO ALL GRATED SURFACE INLET PITS.
- 5. ALL WORK DO BE DONE IN ACCORDANCE WITH AS/NZ 3500.3.2:1998 AND COUNCIL SPECIFICATIONS.
- 6. LOCATION OF DOWNPIPES & FLOOR WASTES ARE INDICATIVE ONLY. DOWNPIPE & FLOOR WASTE SIZE, LOCATION & QUANTITY TO BE DETERMINED BY BUILDER & IN ACCORDANCE WITH RELEVANT AUSTRALIAN STANDARDS.
- 7. THIS PLAN IS TO BE READ IN CONJUNCTION WITH THE
- ARCHITECTURAL, LANDSCAPE AND STRUCTURAL PLANS.

  8. ANY DISCREPANCIES OR OMISSIONS SHALL BE REFERRED TO THE DESIGN ENGINEER FOR RESOLUTION.
- 9. ALL PITS OR GRATES IN TRAFFICABLE AREAS TO BE HEAVY DUTY.
- 10. ALL GUTTERS WILL BE FITTED WITH LEAF GUARDS AND SHOULD BE INSPECTED AND CLEANED TO ENSURE LEAF LITTER CANNOT ENTER THE DOWNPIPES
- 11. EXISTING STORMWATER DRAINAGE TO BE UTILISED WHERE CONTRACTOR SEE FIT.



LEGEND	
RL	PIT SURFACE LEVEL
IL	INVERT LEVEL
TK	TOP OF KERB
sw sw	STORMWATER DRAINAGE PIPE
RWT RWT	DOWNPIPE TO RAINWATER TANK
AG ————————————————————————————————————	Ø100 SUBSOIL PIPE
OF OF	RAINWATER TANK OVER FLOW PIPE
RN RN	PROPOSED RISING MAIN
CISCIS	Ø80mm CAST IN-SITU
	EXISTING STORMWATER PIPE
O DP	PROPOSED Ø100 DOWN PIPE
O DP1	PROPOSED Ø150 DOWN PIPE
○ EX-DP	EXISTING DOWN PIPE
<ul><li>CO</li></ul>	CLEAN OUT
<ul><li>DPS</li></ul>	DOWN PIPE SPREADERS
<ul><li>VD</li></ul>	VERTICAL DROP
<ul><li>VR</li></ul>	VERTICAL RISER
Ø FW	FLOOR WASTE 65Ø
	GRATED INLET PIT
	200mm WIDE GRATED DRAIN
<b>⊠</b> BD	BALCONY DRAIN
⊗ PD	PLANTER DRAIN
⊗ RWO	ROOF RAINWATER OUTLET
RWH	RAINWATER HEAD
⊢● SP	PROPOSED DOWN PIPE SPREADER
	SWIVEL JOINT
	FLEXIBLE CONNECTOR



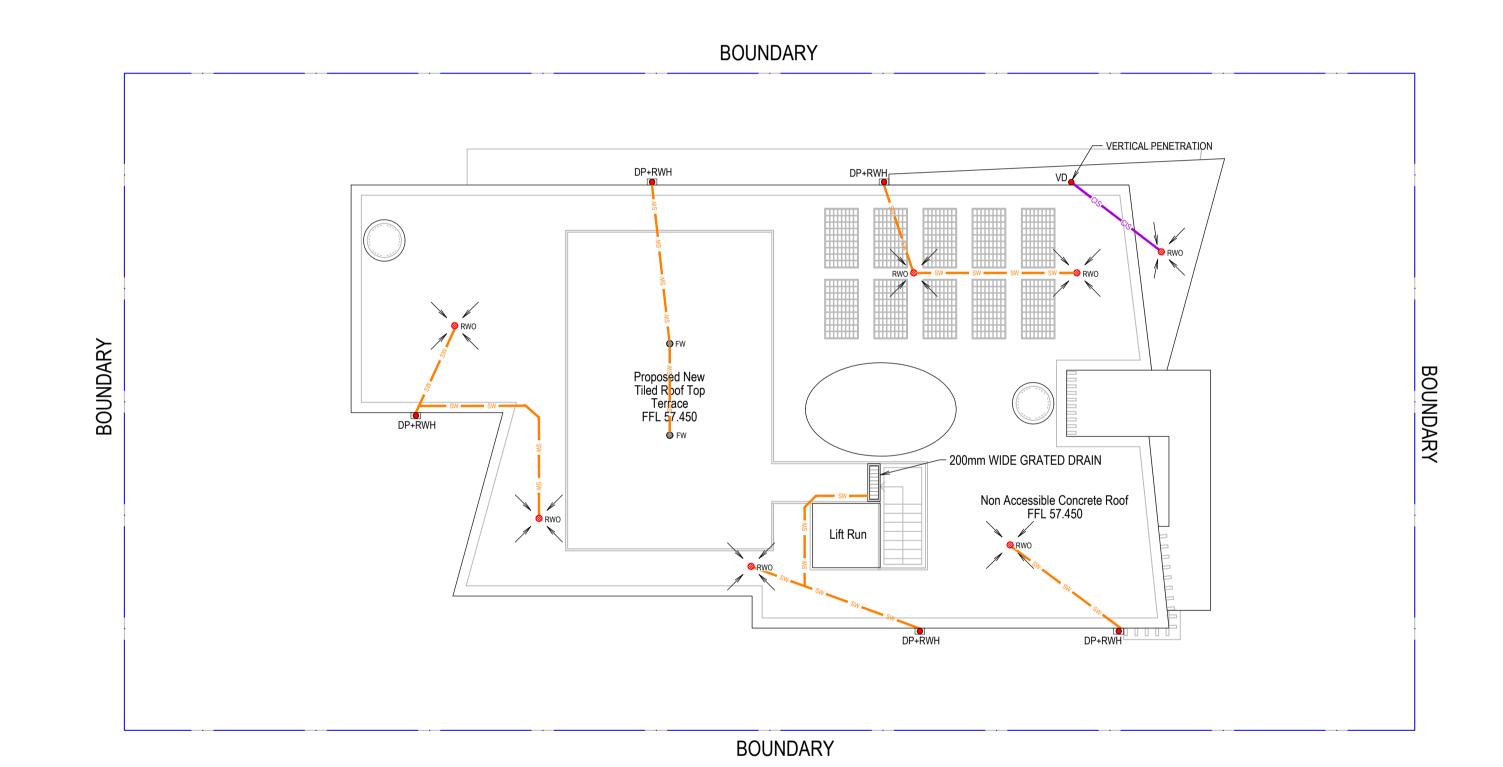

AVENUE

SUMMIT


H ISSUED FOR APPROVAL A.E. A.E. 11.08.25 PROJECT: 6 SUMMIT AVENUE, DEE WHY, NSW 2099 ARCHITECT SHEET SUBJECT ISSUED FOR APPROVAL CHECKED A.E. MICHAEL HRONOPOULOS A.E. A.E. 04.06.25 STORMWATER DRAINAGE PLAN ISSUED FOR APPROVAL 06.02.2024 A.E. MH ARCHITECTS Pty Ltd A.E. P: 9037 0731 & VANESSA ROWED A.E. A.E. 08.04.25 ISSUED FOR APPROVAL ROOF LEVEL SCALE @ A1 A.E. R.G. 19.03.25 ISSUED FOR APPROVAL DO NOT SCALE DRAWING, USE FIGURED DIMENSIONS ONLY E: info@aeconsulting.com.au D24014 1:100 maggie@mharchitects.net.au A.E. R.G. 07.11.24 D ISSUED FOR APPROVAL CONSULTING w: www.aeconsulting.com.au www.mharchitects.net.au AUTHORISED A.E. R.G. 01.11.24 ISSUED FOR APPROVAL This drawing remains the property of A.E CONSULTING ENGINEERS and must +61 416113221 ENGINEERS not be reproduced or used without written consent. A.E. SW40 ENG DRAFT DATE AMENDMENT


A1


#### **EROSION & SEDIMENT CONTROL PLAN**

SCALE: 1:100 NOTES:

- THIS PLAN IS TO BE READ IN CONJUNCTION WITH THE ENGINEERING PLANS AND ANY OTHER PLANS OR WRITTEN INSTRUCTIONS THAT MAY BE ISSUED AND RELATING TO THE DEVELOPMENT AT THE SUBJECT SITE
- THE CONTRACTOR MUST ENSURE THAT ALL SOIL AND WATER MANAGEMENT WORKS ARE LOCATED AS INSTRUCTED IN THIS SPECIFICATION
- ALL BUILDERS AND SUB-CONTRACTORS SHALL BE INFORMED OF THEIR RESPONSIBILITIES IN MINIMIZING THE POTENTIAL FOR SOIL EROSION AND POLLUTION TO DOWN SLOPE LANDS AND WATERWAYS
- DURING WINDY CONDITIONS, LARGE, UNPROTECTED AREAS SHALL BE KEPT MOIST (NOT WET) BY SPRINKLING WITH WATER TO KEEP DUST UNDER CONTROL
- FINAL SITE LANDSCAPING SHALL BE UNDERTAKEN AS SOON AS POSSIBLE AND WITHIN 20 WORKING DAYS FROM COMPLETION OF CONSTRUCTION ACTIVITIES
- WATER WILL BE PREVENTED FROM ENTERING THE PERMANENT DRAINAGE SYSTEM UNLESS IT IS RELATIVELY SEDIMENT FREE BY FILTERING THROUGH AN APPROVED STRUCTURE
- TEMPORARY SOIL AND WATER MANAGEMENT STRUCTURES SHALL BE REMOVED ONLY AFTER THE LANDS THEY ARE PROTECTING HAVE BEEN REHABILITATED
- EROSION AND SEDIMENT CONTROL MEASURES SHALL BE INSPECTED AFTER RAINFALL EVENTS TO ENSURE THEY HAVE OPERATED EFFECTIVELY AND REMAIN IN WORKING CONDITION
- THE ENTRANCE SHALL BE MAINTAINED IN A CONDITION WHICH PREVENTS TACKING OR FLOWING OF SEDIMENT ONTO PUBLIC RIGHTS OF WAY. THIS MAY REQUIRE PERIODIC TOP DRESSING WITHIN ADDITIONAL GRAVEL AS CONDITIONS DEMAND AND REPAIR AND/OR CLEANOUT OF ANY MEASURES USED TO TRAP SEDIMENT. ALL SEDIMENT SPILLED, DROPPED, WASHED OR TRACKED ONTO PUBLIC RIGHTS OF WAY MUST BE REMOVED IMMEDIATELY
- PROVIDE SILT FENCE/HAY BALE BARRIERS TO THE LOW SIDE OF ALL EXPOSED EARTH EXCAVATIONS (TYPICAL)
- 11. ISOLATE EXISTING STORMWATER PITS WITH HAY BALES TO FILTER ALL INCOMING FLOWS
- DO NOT STOCK PILE EXCAVATED MATERIAL ON THE ROAD WAY

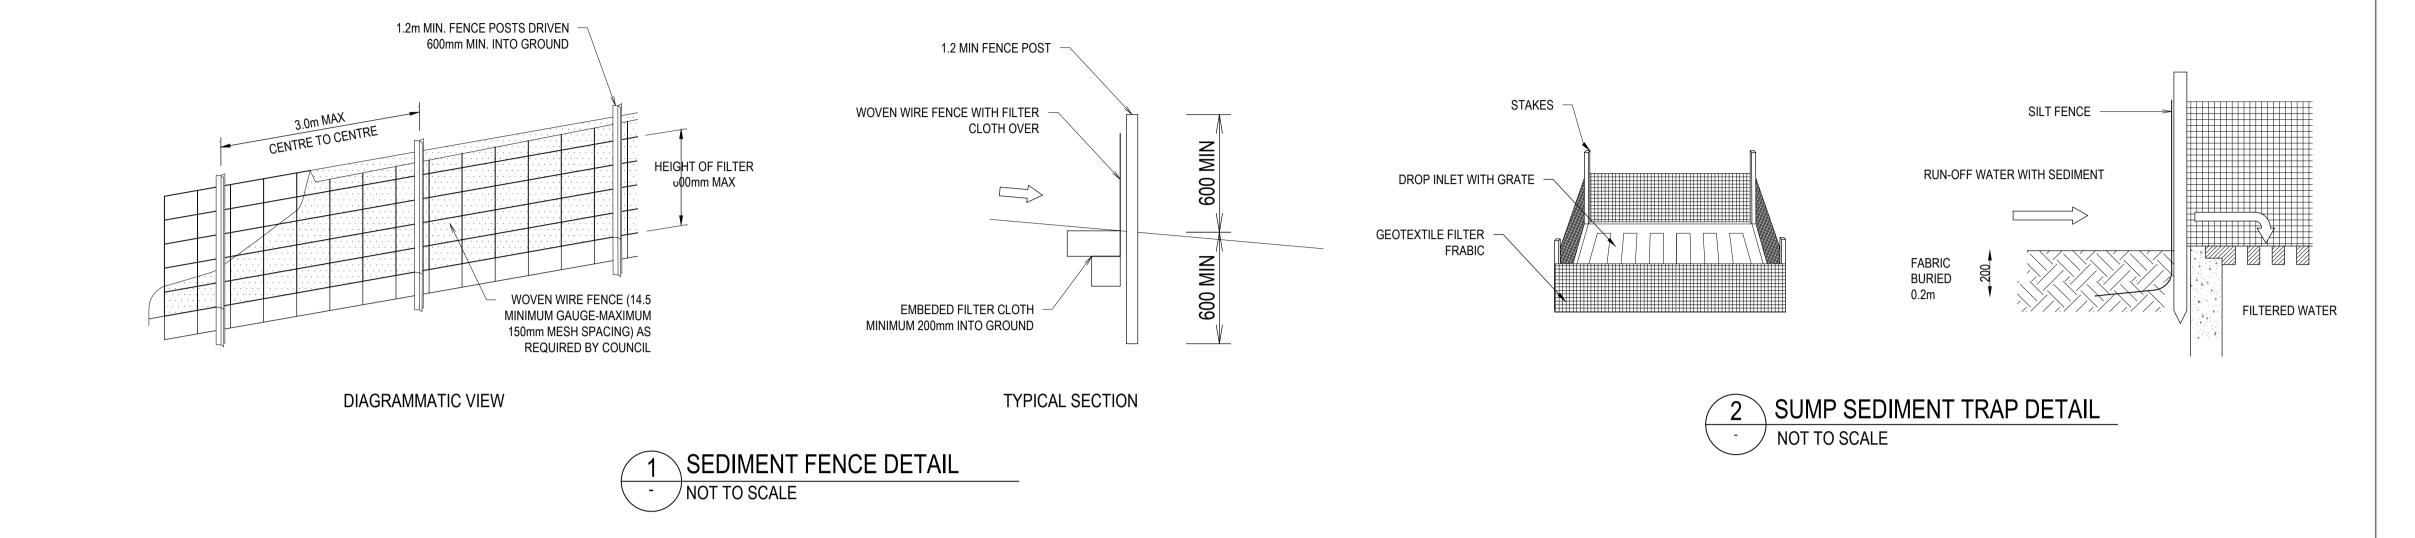

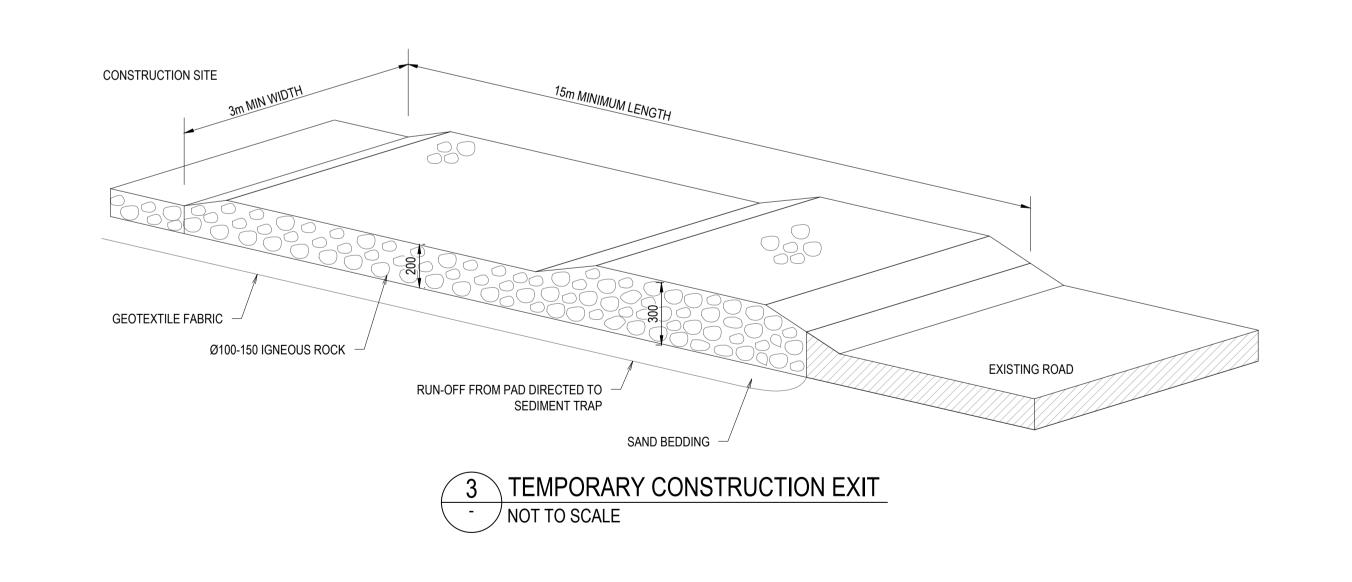

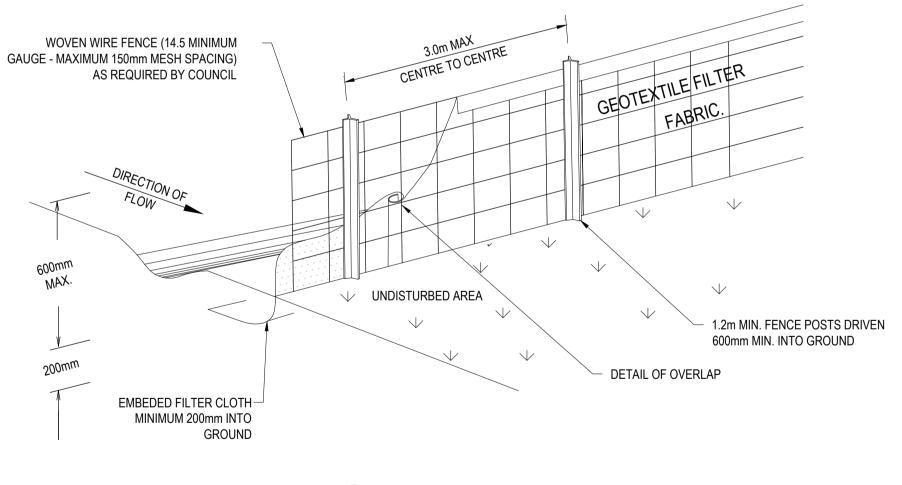

**SEDIMENT FENCE** NOT TO SCALE

Н	ISSUED FOR APPROVAL	A.E.	A.E.	11.08.2
G	ISSUED FOR APPROVAL	A.E.	A.E.	04.06.2
F	ISSUED FOR APPROVAL	A.E.	A.E.	08.04.25
Ε	ISSUED FOR APPROVAL	A.E.	R.G.	19.03.25
D	ISSUED FOR APPROVAL	A.E.	R.G.	07.11.24
С	ISSUED FOR APPROVAL	A.E.	R.G.	01.11.24
No	AMENDMENT	ENG	DRAFT	DATE



P: 9037 0731 E: info@aeconsulting.com.au CONSULTING W: www.aeconsulting.com.au



MICHAEL HRONOPOULOS & VANESSA ROWED

SHEET SUBJECT **EROSION & SEDIMENT** CONTROL DETAILS

ISSUED FOR APPROVAL			ROJECT: 6 SUMMIT AVENUE, DEE WHY, NSW 2099					
			DESIGNED A.E.	A.E.	ATE 6.02.2024			
DO NOT SCALE DRAWING, USE FIGURED DIMENSIONS ONLY			JOB No		CALE @ A1			
			D24014		S SHOWN			
			DWG No		JTHORISED			
This drawing remains the property of A.E CONSULTING ENGINEERS an not be reproduced or used without written consent.		SW50			λ.Ε.			



COLOURS:

WARNING - RED **BORDER AND OTHER** - BLACK

### NOTES:

SIGN SHALL BE PLACED IN A CLEAR AND VISIBLE LOCATION WHERE VEHICLES ENTER THE BASEMENT.

A SUITABLE ALARM SYSTEM POSITIONED AT ENTRANCE OF BASEMENT CARPARK TO PROVIDE A FLOOD WARNING IN CASE OF PUMP FAILURE (TO COUNCILS SPEC).

# PUMP SPECIFICATIONS: STANDARD PUMP-OUT NOTES

THE PUMP-OUT SYSTEM IS DESIGNED TO WORK IN THE FOLLOWING MANNER -1. THE PUMPS SHALL BE PROGRAMMED TO WORK ALTERNATELY SO AS TO ALLOW BOTH PUMPS TO HAVE EQUAL OPERATION LOAD & PUMP LIFE.


- 2. A LOW LEVEL FLOAT SHALL BE PROVIDED TO ENSURE THAT THE MINIMUM REQUIRED WATER LEVEL IS MAINTAINED WITHIN THE SUMP AREA OF THE BELOW GROUND TANK. IN THIS REGARD THIS FLOAT WILL FUNCTION AS AN OFF SWITCH FOR THE PUMPS.
- 3. A SECOND FLOAT SHALL BE PROVIDED AT A HIGHER LEVEL APPROXIMATELY 300mm ABOVE THE MINIMUM WATER LEVEL. WHEREBY ONE OF THE PUMPS WILL OPERATE & DRAIN THE TANK TO THE LEVEL OF THE LOW LEVEL FLOAT.
- 4. A THIRD FLOAT SHALL BE PROVIDED AT A HIGH LEVEL. WHICH IS APPROXIMATELY THE ROOF LEVEL OF THE BELOW GROUND TANK. THIS FLOAT SHOULD START THE OTHER PUMP THAT IS NOT OPERATING & ACTIVATE THE ALARM.
- 5. AN ALARM SYSTEM SHALL BE PROVIDED WITH A FLASHING STROBE LIGHT & A PUMP FAILURE WARNING SIGN WHICH ARE TO BE LOCATED AT THE DRIVEWAY ENTRANCE TO THE BASEMENT LEVEL. THE ALARM SYSTEM SHALL BE PROVIDED WITH A BATTERY BACK-UP IN CASE OF POWER FAILURE.




COLOURS: "DANGER" AND BACKGROUND ELLIPTICAL AREA RECTANGLE CONTAINING ELIPSE OTHER LETTERING AND BORDER


WHITE **BLACK BLACK** 

MATERIALS: POLYPROPYLENE

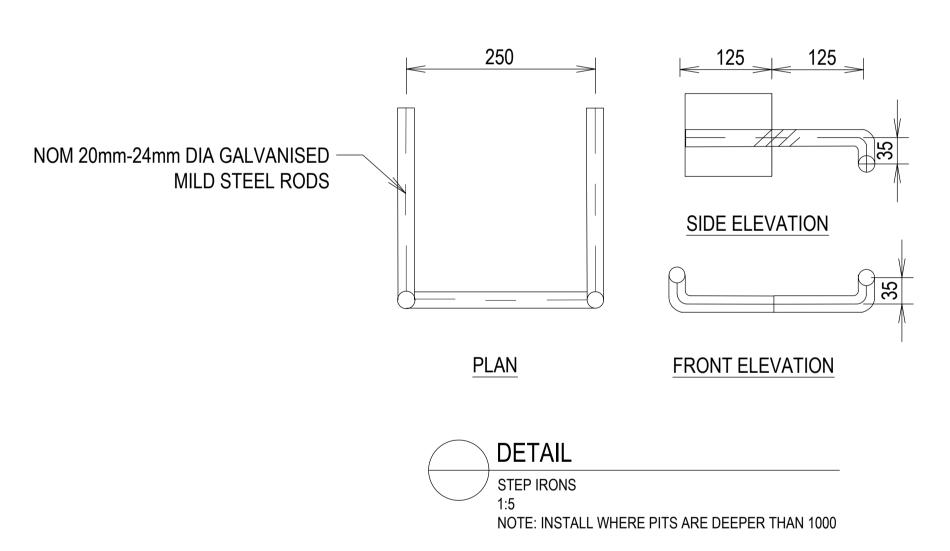

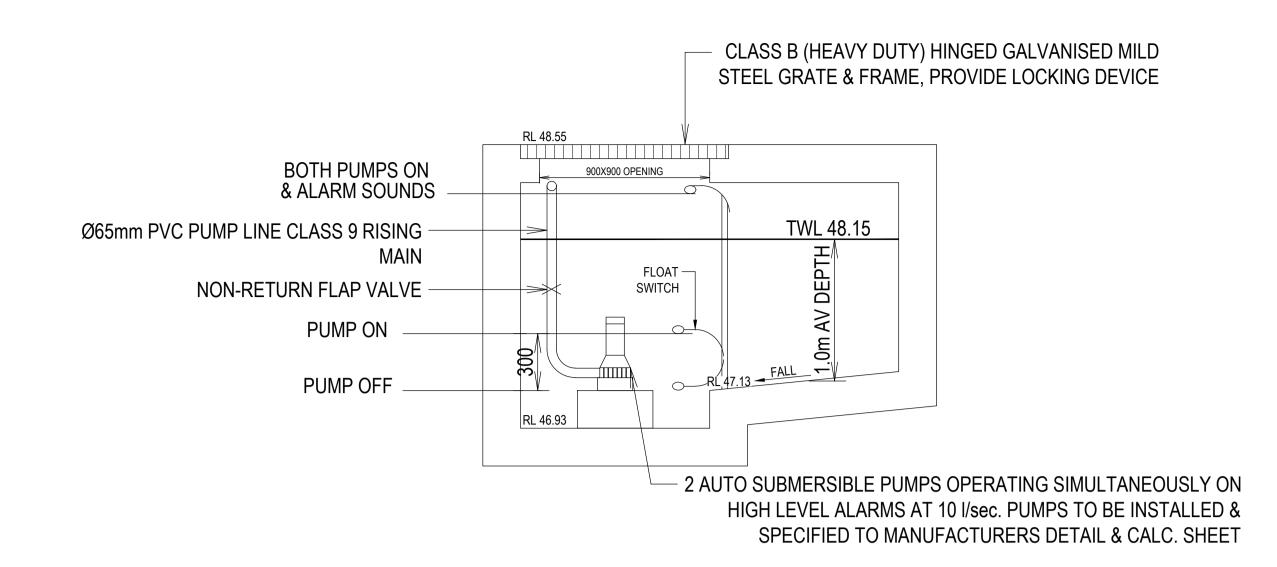

TYPICAL SECTION THROUGH PUMP PIT SCALE 1:20 PUMP WELL VOLUME 3.71 m<sup>3</sup>

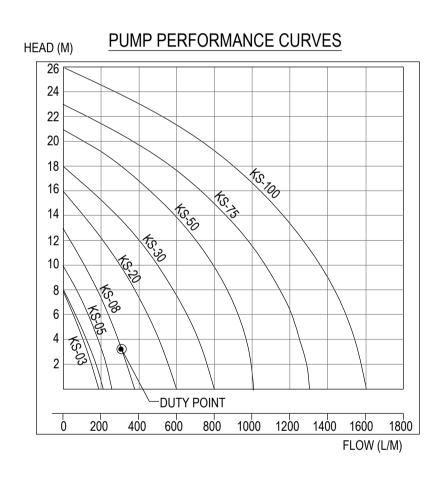

	Output		Output Outlet		Rat	ted	Maximum		Weigh	Dimension		
Type					Head Capacity		Head Capacity		weigh	Dimension		
	HP	kW	mm	Inch	М	LPM	Μ	LPM	Kg	L(mm)	W(mm)	H(mm)
KS-03	1/3	0.25	40	1 1/2"	3	130	8	180	9	188	141	305
KS-04	1/2	0.4	50	2"	5	150	8	220	11	208	140	359
KS-05	1/2	0.4	50	2"	5	160	10	260	14	230	156	375
KS-08	1	0.75	50	2"	6	240	13	380	21	290	180	425
KS-20	2	1.5	80	3"	10	300	16	600	31	278	182	475
KS-30	3	2.2	80	3"	10	500	18	800	42	390	250	450
KS-50	5	3.7	100	4"	10	800	21	1100	48	450	240	530
KS-75	7 1/2	5.6	100	4"	15	800	23	1300	60	550	310	590
KS-100	10	7.5	150	6"	18	900	25	1600	70	550	310	610

Н	ISSUED FOR APPROVAL	A.E.	A.E.	11.08
G	ISSUED FOR APPROVAL	A.E.	A.E.	04.06
F	ISSUED FOR APPROVAL	A.E.	A.E.	08.04
Ε	ISSUED FOR APPROVAL	A.E.	R.G.	19.03
D	ISSUED FOR APPROVAL	A.E.	R.G.	07.11
С	ISSUED FOR APPROVAL	A.E.	R.G.	01.11
No	AMENDMENT	ENG	DRAFT	DAT



P: 9037 0731 E: info@aeconsulting.com.au




MH ARCHITECTS Pty Ltd maggie@mharchitects.net.au www.mharchitects.net.au

+61 416113221


MICHAEL HRONOPOULOS & VANESSA ROWED

SHEET SUBJECT STORMWATER SECTIONS & DETAILS 06.0 SHEET 1 AS S


	PROJECT: 6 SUMMI	T AVENUE, DEE WHY,	NSW 2099			
3	06.02.2024	A.E.	DESIGNED A.E.	A.E.		ISSUED FOR APPROVAL
	SCALE @ A1		JOB No			
	AS SHOWN	N D24014		4		DO NOT SCALE DRAWING, USE FIGURED DIMENSIONS ONLY
	AUTHORISED		DWG No		REV	This drawing remains the property of A E CONSULTING ENCINEEDS and mus
	A.E.		SW60		Н	This drawing remains the property of A.E CONSULTING ENGINEERS and mus not be reproduced or used without written consent.

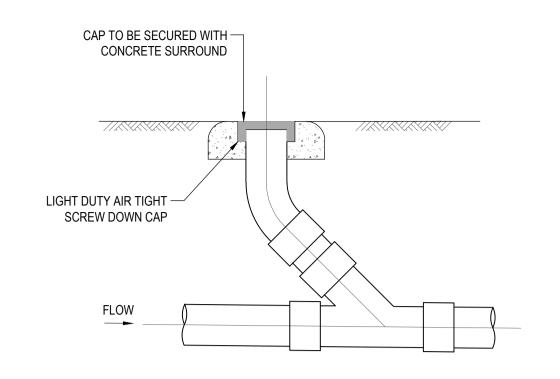




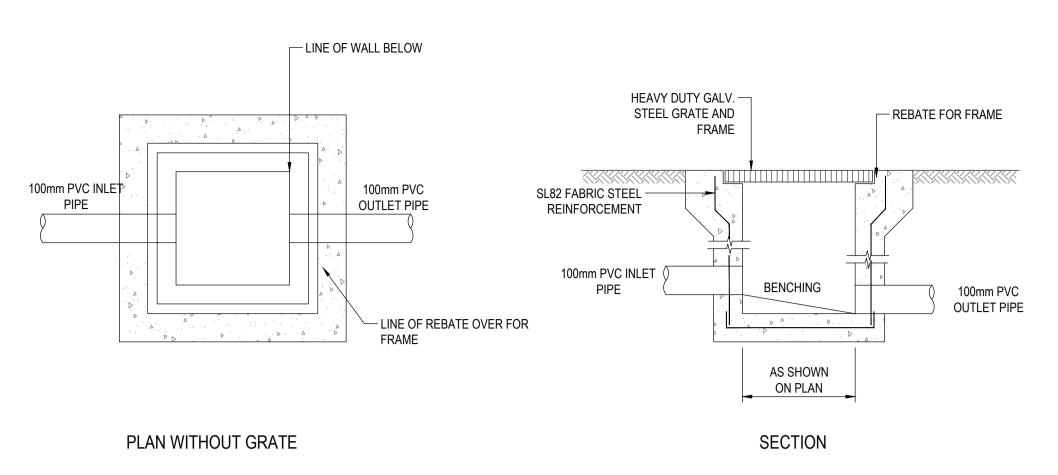




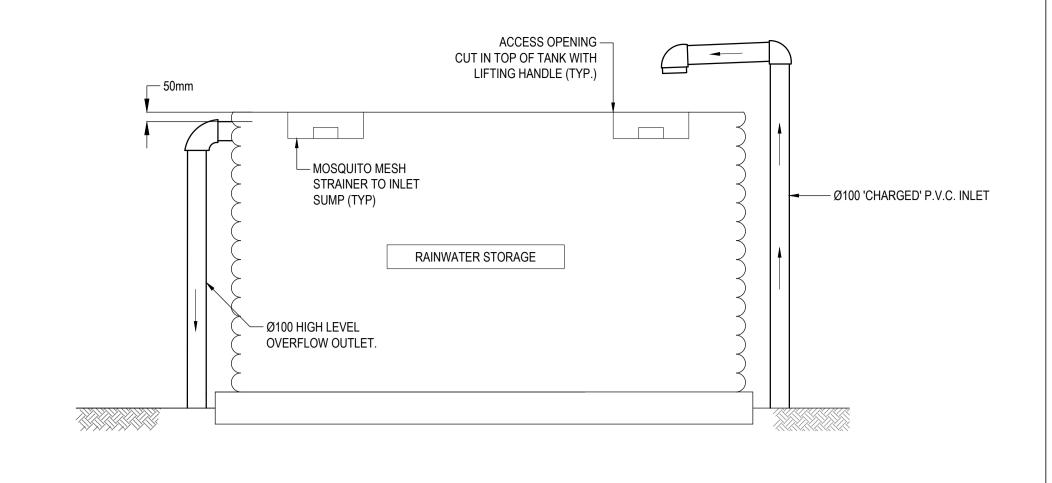




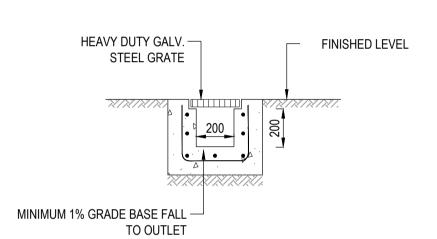




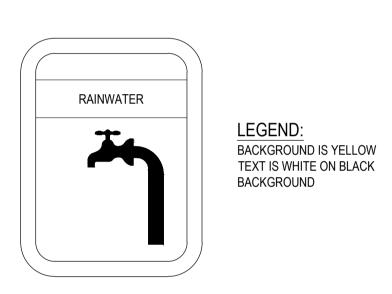




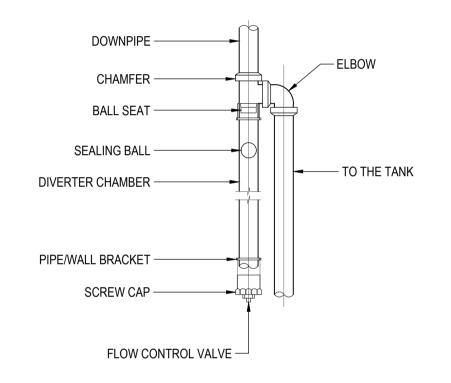




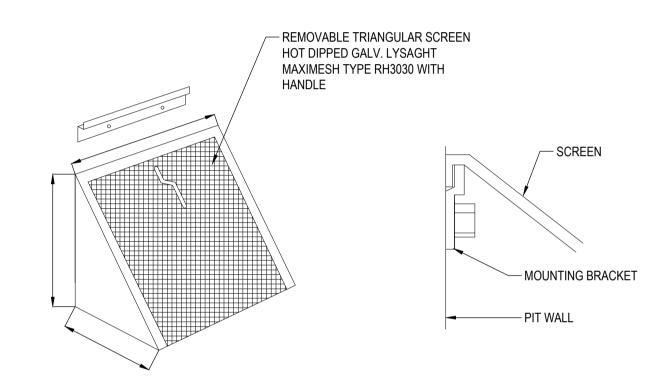



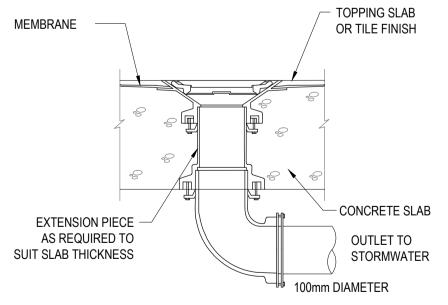



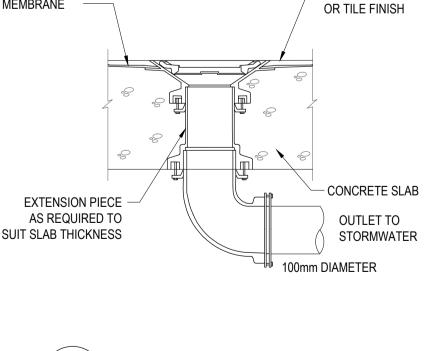

Н	ISSUED FOR APPROVAL	A.E.	A.E.	11.08.25
G	ISSUED FOR APPROVAL	A.E.	A.E.	04.06.25
F	ISSUED FOR APPROVAL	A.E.	A.E.	08.04.25
Ε	ISSUED FOR APPROVAL	A.E.	R.G.	19.03.25
D	ISSUED FOR APPROVAL	A.E.	R.G.	07.11.24
С	ISSUED FOR APPROVAL	A.E.	R.G.	01.11.24
No	AMENDMENT	ENG	DRAFT	DATE









	CLIENT
d	MICHAEL HRONOPOULOS & VANESSA ROWED

SHEET SUBJECT	PROJECT
STORMWATER SECTIONS & DETAILS	DATE
3 TORIVIVIATER SECTIONS & DETAILS	06.02.
SHEET 2	SCALE @
• · · – - · –	N.T.S
	14.1.0
	AUTHORI

ROJECT: 6 SUMM	T AVENUE, DEE WHY,	NSW 2099								
6.02.2024	A.E.	A.E.	A.E.	ED .	ISSUED FOR APPROVAL					
CALE @ A1		JOB No								
I.T.S.		D24014			DO NOT SCALE DRAWING, USE FIGURED DIMENSIONS ONLY					
UTHORISED		DWG No		REV	This drawing remains the property of A.E CONSULTING ENGINEERS and must					
Ŋ.E.		SW70		Н	not be reproduced or used without written consent.					

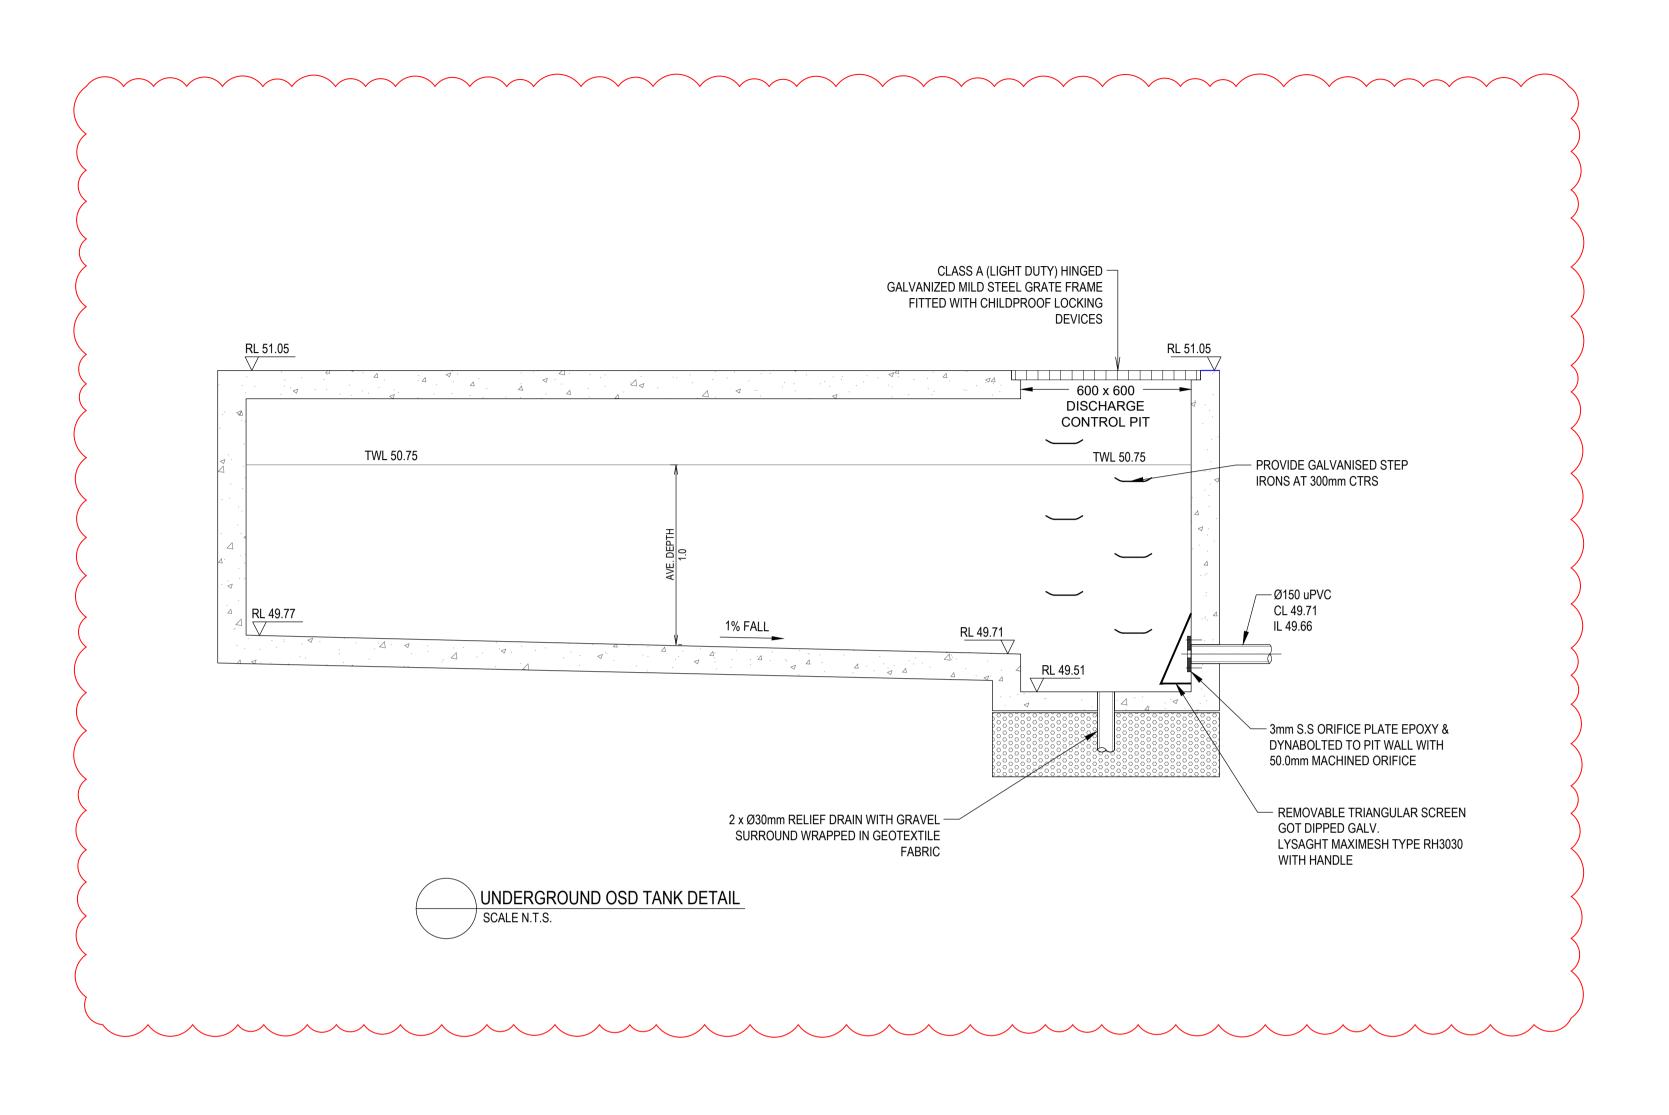

CALCULATING ORIFICE DIAMETER									
Q (I/s)=	5								
Q (m^3/s)=	0.005								
Cd=	0.61								
g=	9.81								
h=	1.04								
A (m^2)=	0.001814571								
D (m)=	0.048066451								
D(mm)=	48.1	(min 50mm)							

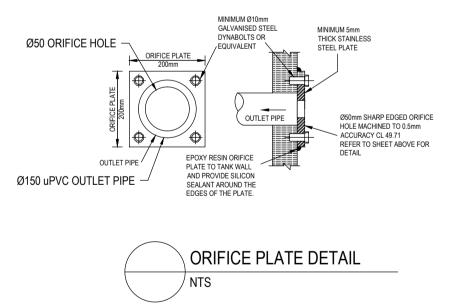

DRAINS SUMMARY TABLE												
STORM DURATION	PRE-DEVELOPMENT 0% IMPERVIOUS	POST DEVELOPMENT	POST DEVELOPMENT - BYPASS	POST DEVELOPMENT - TOTAL								
20% AEP	12 L/S	4 L/S	3 L/S	7 L/S								
10% AEP	16 L/S	4 L/S	4 L/S	8 L/S								
5% AEP	23 L/S	5 L/S	4 L/S	9 L/S								
1% AEP	29L/S	5 L/S	7 L/S	12 L/S								


H ISSUED FOR APPROVAL	A.E. A.E. 11.08.25			ARCHITECT	CLIENT	SHEET SUBJECT	PROJECT: 6 SUMN	MIT AVENUE, DEE WHY	, NSW 2099		
G ISSUED FOR APPROVAL	A.E. A.E. 04.06.25			/	MICHAEL HRONOPOULOS	OSD DETAILS SHEET	DATE 06.02.2024	DRAWN A F	DESIGNED A F	CHECKED A F	ISSUED FOR APPROVAL
F ISSUED FOR APPROVAL	A.E. A.E. 08.04.25		P: 9037 0731		MH ARCHITECTS Pty Ltd & VANESSA ROWED		SCALE @ A1	A.L.	JOB No	71.2.	
E ISSUED FOR APPROVAL	A.E. R.G. 19.03.25		E: info@aeconsulting.com.au		maggie@mharchitects.net.au		AS SHOWN		D24014		DO NOT SCALE DRAWING, USE FIGURED DIMENSIONS ONLY
D ISSUED FOR APPROVAL	A.E. R.G. 07.11.24						710 01101111		52.01.		
C ISSUED FOR APPROVAL	A.E. R.G. 01.11.24	ONSULTING	W: www.aeconsulting.com.au	- /	www.mharchitects.net.au		AUTHORISED		DWG No	REV	This drawing remains the property of A.E CONSULTING ENGINEERS and must
No AMENDMENT	ENG DRAFT DATE	ENGINEERS		*	+61 416113221		A.E.		SW80	Н	not be reproduced or used without written consent.

# Appendix 9 – Orifice Plate Table (Table 3)

SD							Ţ	Depth of t	ank abov	ve centre	eline of o	rifice									l .
l/s	0.1	0.2	0.3	0.4	0.5	0.6	0.7	8.0	0.9	1.0	1.1	1.2	1.3	1.4	1.5	1.6	1.7	1.8	1.9	2.0	
2	55	46	42	39	37	35	34	33	32	31	30	30	29	28	28	28	27	27	26	26	
3	67	57	51	48	45	43	41	40	39	38	37	36	36	35	34	34	33	33	32	32	Min.
4	78	65	59	55	52	50	48	46	45	44	43	42	41	40	40	39	38	38	37	37	100 mi
5	87	73	66	62	58	56	54	52	50	49	48	47	46	45	44	44	43	42	42	41	diame
6	95	80	72	67	64	61	59	57	55	54	52	51	50	49	48	48	47	46	46	45	outle
7	103	87	78	73	69	66	63	61	59	58	57	55	54	53	52	51	51	50	49	49	pipe
8	110	93	84	78	74	70	68	65	64	62	60	59	58	57	56	55	54	53	53	52	
9	117	98	89	83	78	75	72	69	67	66	64	63	61	60	59	58	58	57	56	55	
10	123	104	94	87	82	79	76	73	71	69	68	66	65	64	63	62	61	60	59	58	
11	129	109	98	91	86	82	79	77	75	73	71	69	68	67	66	65	64	63	62	61	
12	135	113	102	95	90	86	83	80	78	76	74	72	71	70	69	67	66	65	65	64	
13	140	118	107	99	94	90	86	83	81	79	77	75	74	73	71	70	69	68	67	66	
14	146	122	111	103	97	93	90	87	84	82	80	78	77	75	74	73	72	71	70	69	Min
15	151	127	115	107	101	96	93	90	87	85	83	81	79	78	77	75	74	73	72	71	150 n
16	156	131	118	110	104	99	96	93	90	88	85	84	82	80	79	78	77	76	75	74	diame
17	160	135	122	113	107	103	99	95	93	90	88	86	85	83	82	80	79	78	77	76	outle
18	165	139	125	117	110	106	102	98	95	93	91	89	87	85	84	83	81	80	79	78	100000
19	170	143	129	120	113	108	104	101	98	95	93	91	89	88	86	85	84	82	81	80	pipe
	174	146	132									94			88	87	86				
20	178			123	116	111	107	104	100	98	96	9	92	90				85	83 85	82	-
21		150	136	126	119	114	110	106	103	100	98	96	94	92	91	89	88	87		84	
22	183	154	139	129	122	117	112	109	105	103	100	98	96	94	93	91	90	89	87	86	
23 24	187 191	157 160	142 145	132 135	125 128	119 122	115 117	111 113	108 110	105 107	102 105	100 102	98 100	97 99	95 97	93 95	92 94	91 93	89 91	88 90	
25	195	164	148	138	130	124	120	116	112	109	107	105	102	101	99	97	96	94	93	92	
26	198	167	151	140	133	127	122	118	115	112	109	107	105	103	101	99	98	96	95	94	ł
27		170	154	143	135	129	124	120	117	114	111	109	107	105	103	101	100	98	97	96	
28		173	156	146	138	132	127	122	119	116	113	111	108	106	105	103	101	100	99	97	
29		176	159	148	140	134	129	125	121	118	115	113	110	108	107	105	103	102	100	99	
30		179	162	151	143	136	131	127	123	120	117	115	112	110	108	107	105	104	102	101	
31		182	165	153	145	138	133	129	125	122	119	116	114	112	110	108	107	105	104	102	1
32		185	167	156	147	141	135	131	127	124	121	118	116	114	112	110	108	107	105	104	
33		188	170	158	150	143	137	133	129	126	123	120	118	116	114	112	110	109	107	106	
34		191	172	160	152	145	140	135	131	128	125	122	120	117	115	113	112	110	109	107	Min
35		194	175	163	154	147	142	137	133	129	126	124	121	119	117	115	113	112	110	109	225 n
36	4	196	177	165	156	149	144	139	135	131	128	125	123	121	119	117	115	113	112	110	diame
37		199	180	167	158	151	146	141	137	133	130	127	125	122	120	118	117	115	113	112	outle
38		202	182	170	160	153	148	143	139	135	132	129	126	124	122	120	118	116	115	113	pipe
39		204	185	172	163	155	149	145	140	137	133	131	128	126	124	122	120	118	116	115	
40	g.	207	187	174	165	157	151	146	142	138	135	132	130	127	125	123	121	120	118	116	

H ISSUED FOR APPROVAL	A.E. A.E. 11.08.25			ARCHITECT		CLIENT	SHEET SUBJECT	PROJECT: 6 SUMMIT AVENUE, DEE	,	OHEOKED	
G ISSUED FOR APPROVAL	A.E. A.E. 04.06.25		D. 0025 0521	. /		MICHAEL HRONOPOULOS	ORIFICE CALCULATION	06.02.2024 A.E.	A.E.	CHECKED A.E.	ISSUED FOR APPROVAL
F ISSUED FOR APPROVAL	A.E. A.E. 08.04.25		P: 9037 0731		WITT ARCHITECTS I ty Ltd	& VANESSA ROWED		SCALE @ A1	JOB No		
E ISSUED FOR APPROVAL	A.E. R.G. 19.03.25		E: info@aeconsulting.com.au		maggie@mharchitects.net.au			AS SHOWN	D24014		DO NOT SCALE DRAWING, USE FIGURED DIMENSIONS ONLY
D ISSUED FOR APPROVAL	A.E. R.G. 07.11.24							7.6 6116 1111	B21011		
C ISSUED FOR APPROVAL	A.E. R.G. 01.11.24	ONSULTING	W: www.aeconsulting.com.au	1	www.mharchitects.net.au			AUTHORISED	DWG No	REV	This drawing remains the property of A.E CONSULTING ENGINEERS and must
No AMENDMENT	ENG DRAFT DATE	ENGINEERS		/	+61 416113221			A.E.	SW90	Н	not be reproduced or used without written consent.

Λ 1

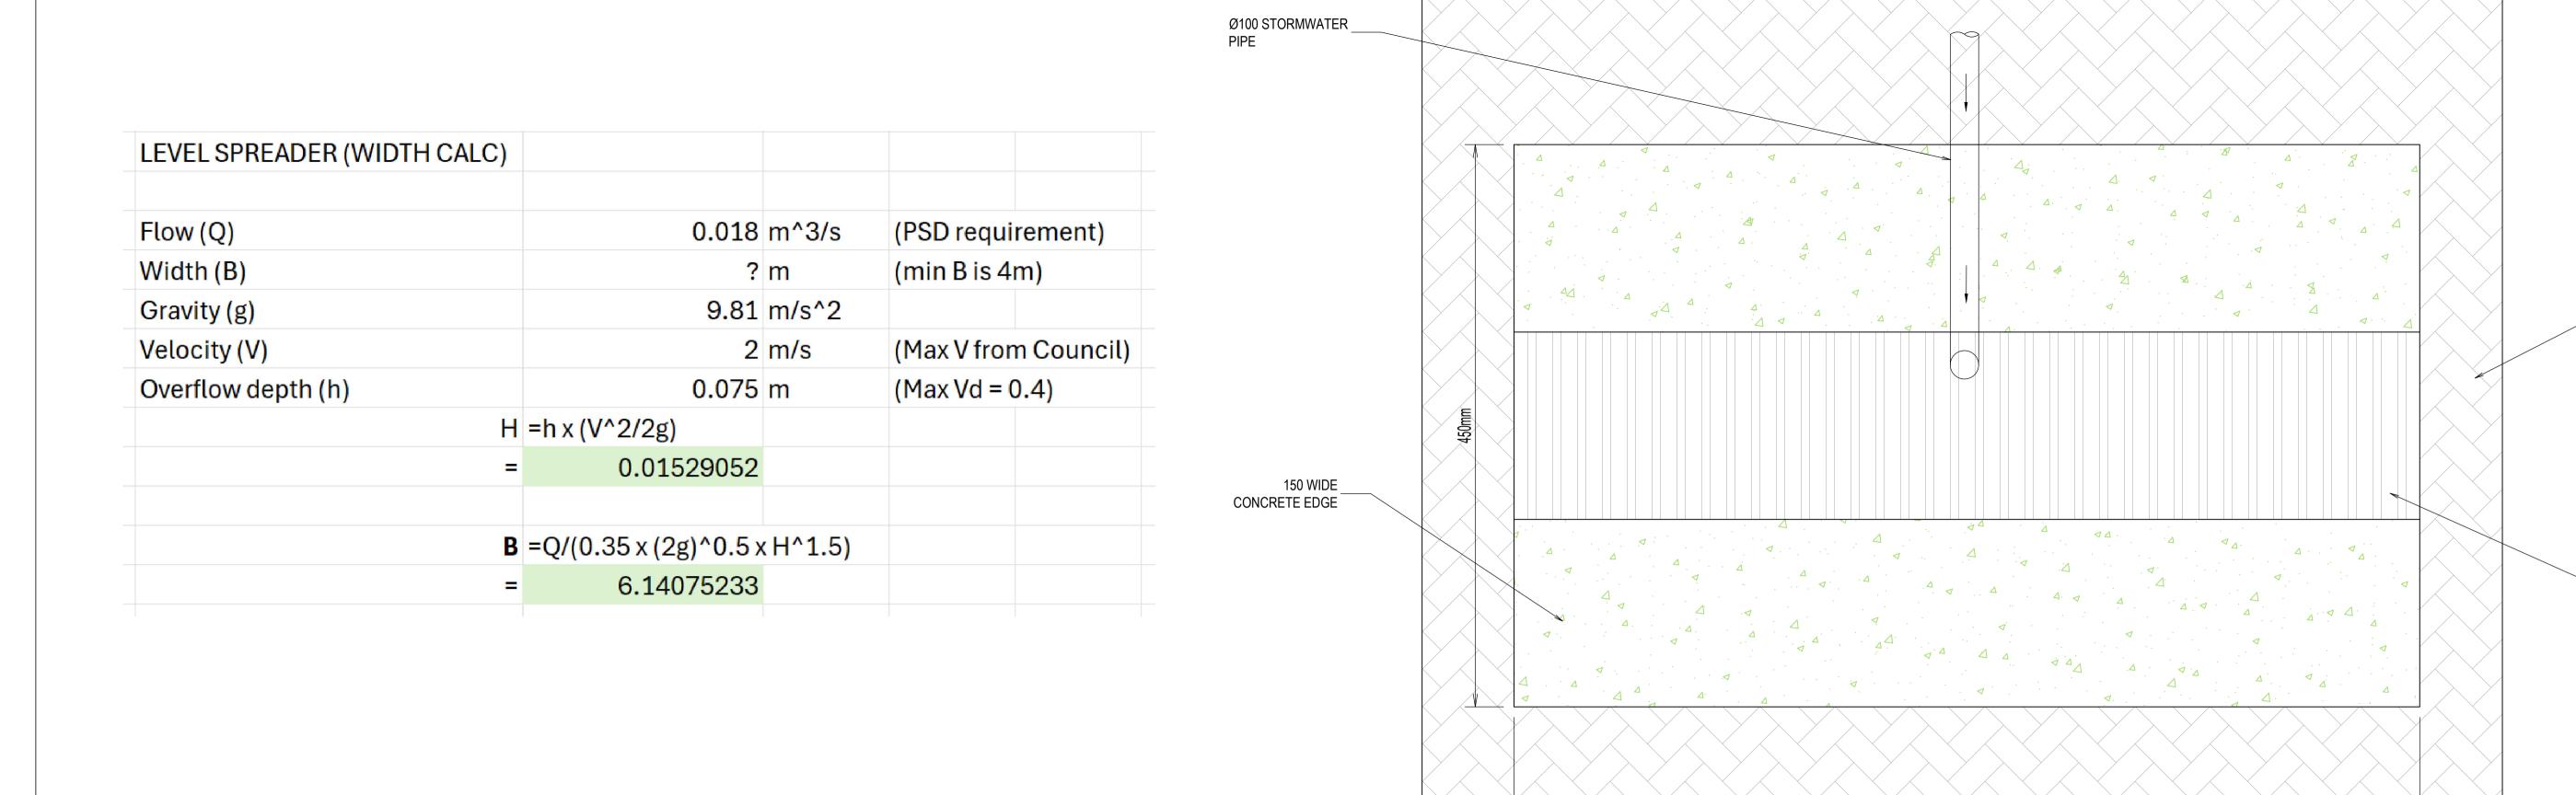


**GRASSED AREA** 

SURROUNDING
THE SPREADER

150 WIDE

GALVANISED

STEEL GRATE AND

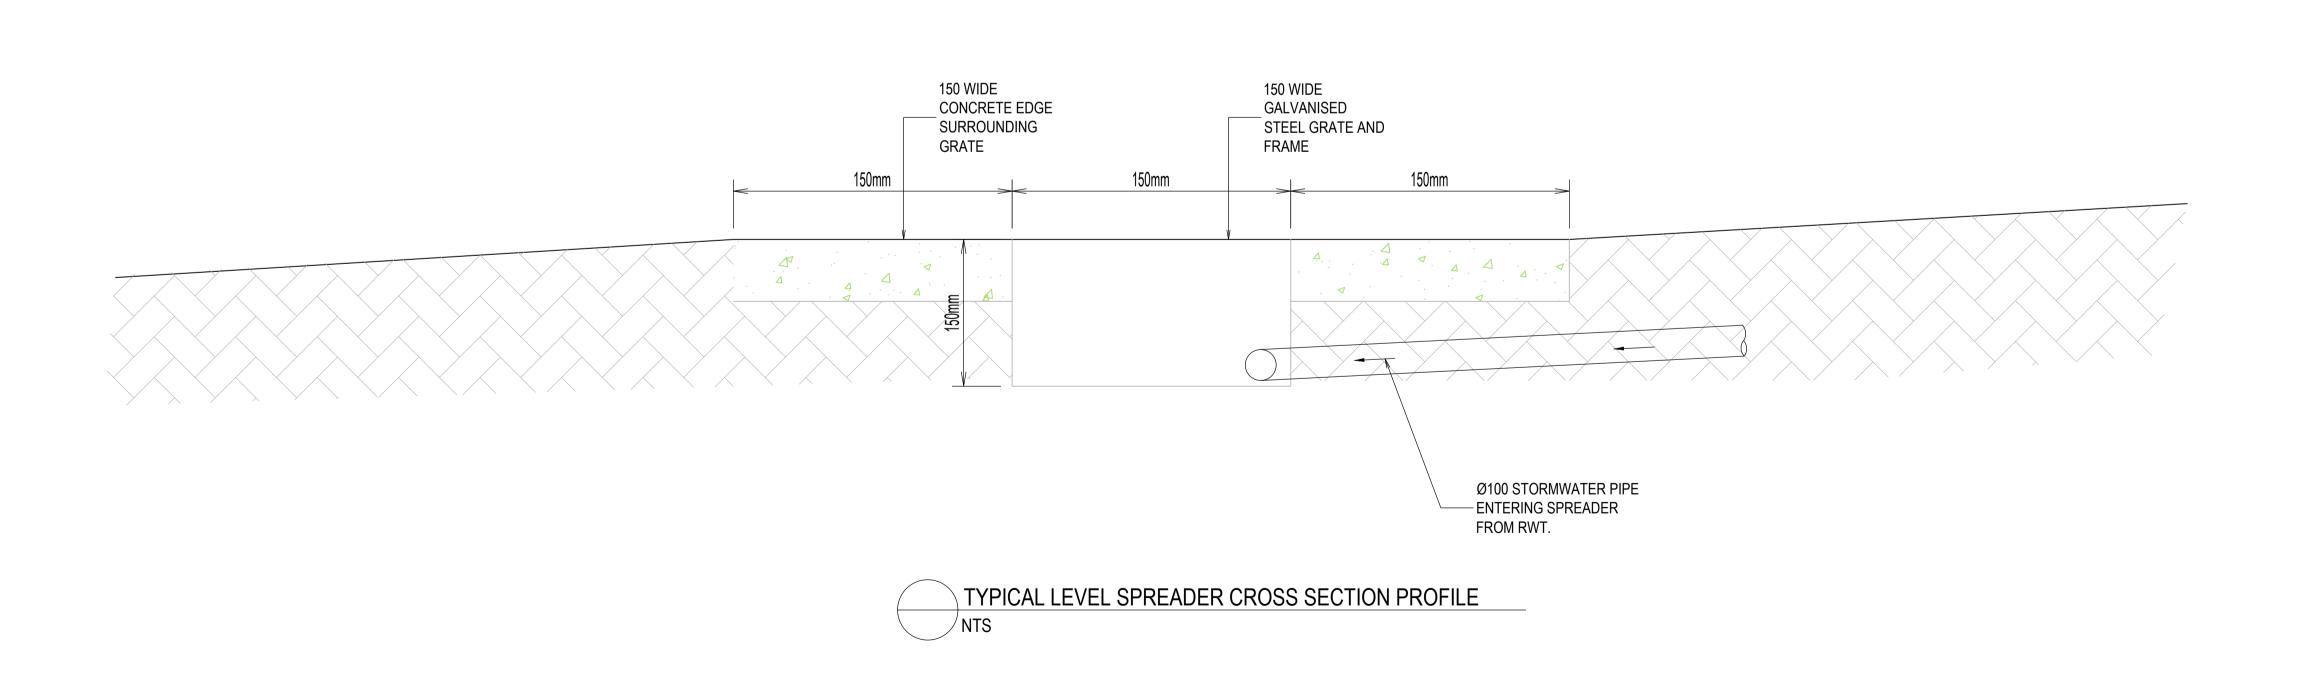

6140mm

TYPICAL LEVEL SPREADER AERIAL PROFILE

H ISSUED FOR APPROVAL A.E. A.E. 11.08.25 PROJECT: 6 SUMMIT AVENUE, DEE WHY, NSW 2099 ARCHITECT ISSUED FOR APPROVAL CHECKED A.E. A.E. A.E. 04.06.25 MICHAEL HRONOPOULOS G ISSUED FOR APPROVAL LEVEL SPREADER DETAILS SHEET MH ARCHITECTS Pty Ltd 06.02.2024 A.E. A.E. **P:** 9037 0731 A.E. A.E. 08.04.25 & VANESSA ROWED ISSUED FOR APPROVAL SCALE @ A1 A.E. R.G. 19.03.25 E ISSUED FOR APPROVAL DO NOT SCALE DRAWING, USE FIGURED DIMENSIONS ONLY E: info@aeconsulting.com.au N.T.S. D24014 maggie@mharchitects.net.au A.E. R.G. 07.11.24 D ISSUED FOR APPROVAL www.mharchitects.net.au CONSULTING w: www.aeconsulting.com.au AUTHORISED ISSUED FOR APPROVAL A.E. R.G. 01.11.24 This drawing remains the property of A.E CONSULTING ENGINEERS and must +61 416113221 SW100 not be reproduced or used without written consent. ENG DRAFT DATE AMENDMENT

Δ1