




AC	ARC	ARC	METAL DENSITY FIBERBOARD
AD	ARC CONFORMAL	MB	METAL ROOF
AE	ALUMINUM	MC	METAL SHEET
BL	ALUMINUM SHALEY	MCB	MCB
BL1	ALUMINUM TYPE 1	MCB	MCB
BL2	ALUMINUM TYPE 2	MCB	MCB
BL3	ALUMINUM TYPE 3	MCB	MCB
BL102	ALUMINUM TYPE 102	MCB	MCB



1 NORTH
1 : 50

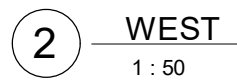

61 2 9999 0668
+61 0433 775 490
se 8 11 level 1 bungan st
mona vale nsw 2106
po. box 26 newport nsw 2106
info@hothousestudio.com
www.hothousestudio.com
Nominated Architect:
Wade Stewart Cogle
NSW ARB Registration:
10971

NO.
A
B


DATE _____

CLIENT:
PHILLIP TORRANCE & TINA WILD

PROJECT:
ALTERATIONS AND ADDITIONS

ADDRESS:
113 GONDOLA RD, NORTH NARRABEEN

PROJECT NO.	DRAWN	CHECKED
18164	MS	WC
DATE	DRAWING NO	REVISION NO
31 January 2025		
SIZE	SCALE	
A1	As indicated	
	MOD_200	B

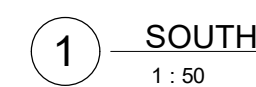[illegible]

61 2 9999 0668
+61 0433 775 490
se 8 11 level 1 bungan st
mona vale nsw 2106
po.box 26 newport nsw 2106
info@hothousestudio.com
www.hothousestudio.com
Nominated Architect:
Wade Stewart Cogle
NSW ARB Registration:
10971

PRINT DATE: 7/02/2025 2:38:22 PM PRINT SIZE: A1

NOTES:

It is to examine the site and verify conditions and dimensions.
Any discrepancies must be brought to the architect's attention.
Use figured dimensions only. Do not scale drawings.
All work shall comply with the Building Code of Australia and
relevant Australian standards.

© COPYRIGHT: Hot House Projects Pty Ltd
Information contained on this drawing is the copyright
of Hot House Projects Pty Ltd. Copying, or part of, without
written permission infringes Copyright.
Hot House Projects Pty Ltd T/A Hot House Architects

NO.	REVISION	DATE
A	CC Issue	24/09/20
R	As Built Drawings	31/01/25


CONSULTANTS:
Architect:
HOT HOUSE ARCHITECTS
PO Box 26, NEWPORT NSW 2106
m: 0433 775 490
info@hothousestudio.com

CUSTOMER:
PHILLIP TORRANCE & TINA WILD

PROJECT:
ALTERATIONS AND ADDITIONS

ADDRESS:
113 GONDOLA RD, NORTH NARRABEEN

DRAWING TITLE:	
South & East Elevations	
PROJECT NO.	CHECKED
18164	WC
DRAWN	
MS	
DATE	REVISION NO
31 January 2025	
SIZE	
A1	
SCALE	
As indicated	
MOD_201	
B	

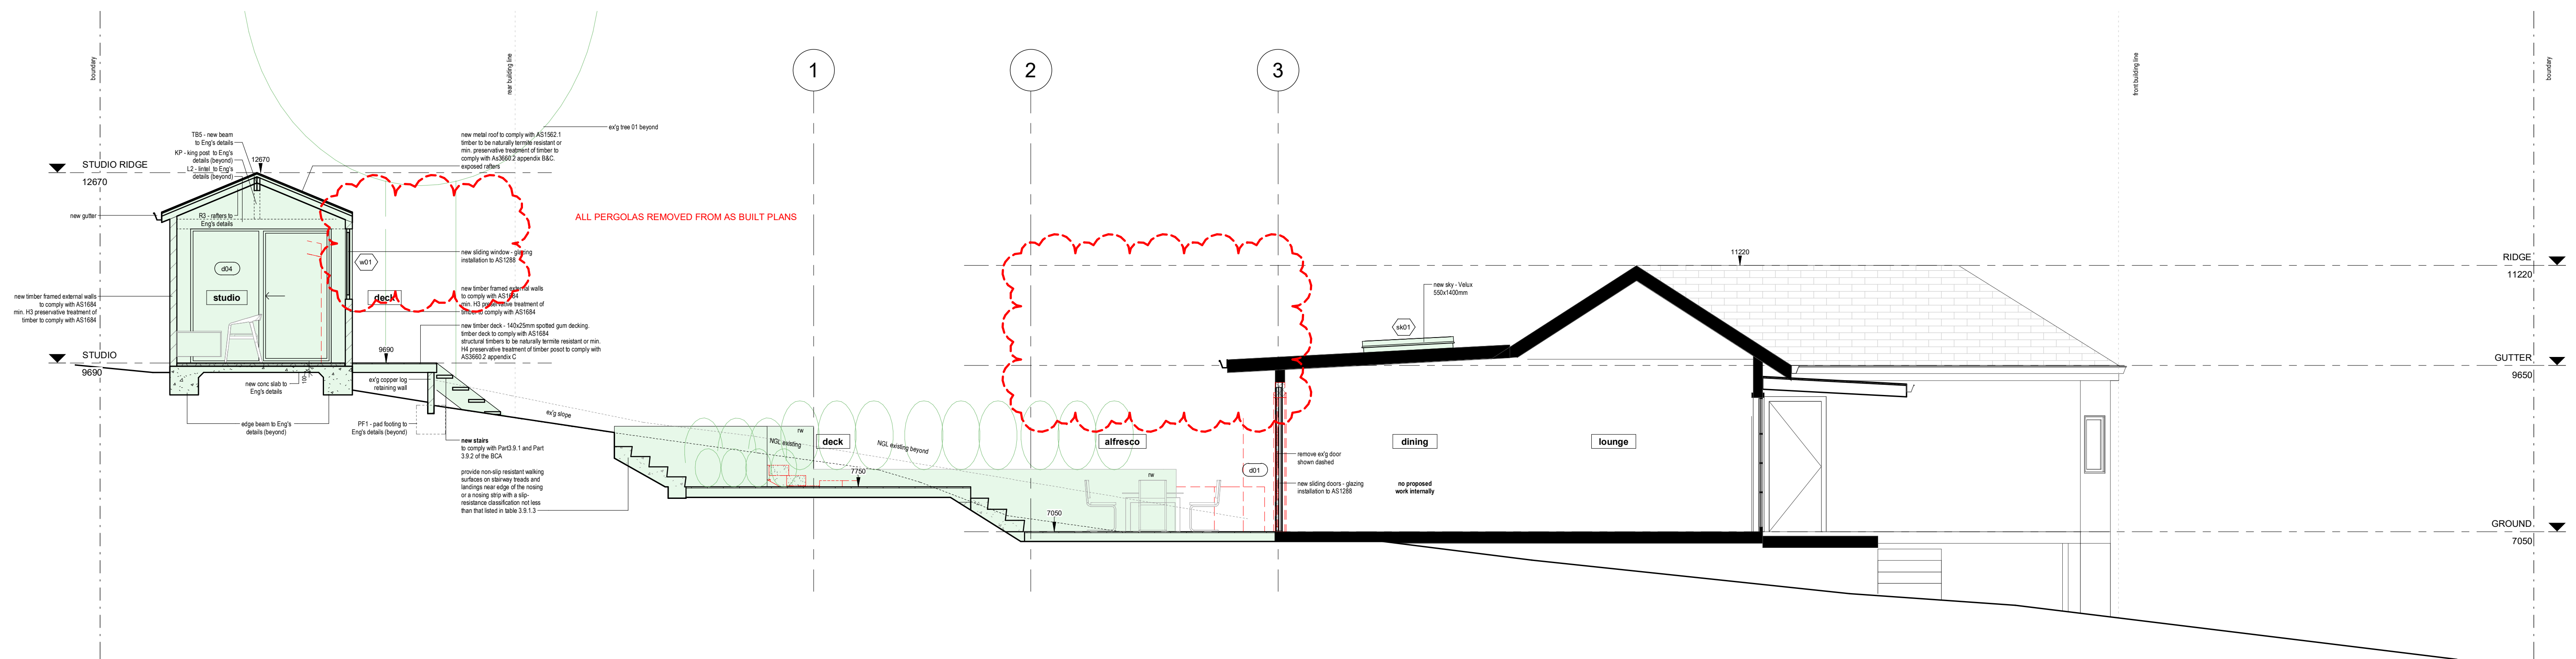

1 SECTION - LONG
1 : 50

The logo for HOT HOUSE ARCHITECTS features a stylized graphic on the left consisting of a series of nested, offset squares that create a sense of depth and architectural structure. To the right of this graphic, the words "HOT HOUSE" are written in a large, clean, sans-serif font, with "HOT" and "HOUSE" on the same line. Below "HOT HOUSE", the word "ARCHITECTS" is written in a smaller, all-caps, sans-serif font, centered under the line above. The entire logo is rendered in black on a white background.

61 2 9999 0668
+61 0433 775 490
se 8 11 level 1 bungan st
mona vale nsw 2108
po. box 26 newport nsw 2106
info@hothousestudio.com
www.hothousestudio.com
Nominated Architect:
Wade Stewart Cogle
NSW ARB Registration:
10971

PRINT DATE: 7/02/2025 2:38:23 PM PRINT SIZE: A1

NOTES:

Builder is to examine the site and verify conditions and dimensions.
Any discrepancies must be brought to the architect's attention.
Use figured dimensions only. Do not scale drawings.
All work shall comply with the Building Code of Australia and
relevant Australian standards.

© COPYRIGHT: Hot House Projects Pty Ltd
Information contained on this drawing is the copyright of
Hot House Projects Pty Ltd. Copying, or part of, without
written permission infringes Copyright.
Hot House Projects Pty Ltd T/A Hot House Architects

NO.	REVISION	DATE
A	CC Issue	24/09/20
B	As Built Drawings	31/01/25

CONSULTANTS:
Architect:
HOT HOUSE ARCHITECTS
PO Box 26, NEWPORT NSW 2106
m: 0433 775 490
info@hthousestudio.com

CLIENT:
PHILLIP TORRANCE & TINA WILD

PROJECT:
ALTERATIONS AND ADDITIONS

ADDRESS:
113 GONDOLA RD, NORTH NARRABEEN

DRAWING TITLE:
Section - Long

PROJECT NO.	DRAWN	CHECKED
-------------	-------	---------

DATE	DRAWING NO	REVISION NO
------	------------	-------------

SIZE	A1	SCALE	As indicated	MOD_300	B
------	----	-------	--------------	---------	---

AB	AB	AB	AB
ACC	ACC	ACC	ACC
AC	AC	AC	AC
AD	AD	AD	AD
AE	AE	AE	AE
AF	AF	AF	AF
AG	AG	AG	AG
AH	AH	AH	AH
AI	AI	AI	AI
AL	AL	AL	AL
AM	AM	AM	AM
AN	AN	AN	AN
AO	AO	AO	AO
AP	AP	AP	AP
AQ	AQ	AQ	AQ
AR	AR	AR	AR
AS	AS	AS	AS
AT	AT	AT	AT
AV	AV	AV	AV
AW	AW	AW	AW
AX	AX	AX	AX
AY	AY	AY	AY
AZ	AZ	AZ	AZ
BA	BA	BA	BA
BB	BB	BB	BB
BC	BC	BC	BC
BD	BD	BD	BD
BE	BE	BE	BE
BF	BF	BF	BF
BG	BG	BG	BG
BH	BH	BH	BH
BI	BI	BI	BI
BJ	BJ	BJ	BJ
BK	BK	BK	BK
BL	BL	BL	BL
BM	BM	BM	BM
BN	BN	BN	BN
BO	BO	BO	BO
BP	BP	BP	BP
BQ	BQ	BQ	BQ
BR	BR	BR	BR
BS	BS	BS	BS
BT	BT	BT	BT
BU	BU	BU	BU
BV	BV	BV	BV
BW	BW	BW	BW
BX	BX	BX	BX
BY	BY	BY	BY
BZ	BZ	BZ	BZ
CA	CA	CA	CA
CB	CB	CB	CB
CC	CC	CC	CC
CD	CD	CD	CD
CE	CE	CE	CE
CF	CF	CF	CF
CG	CG	CG	CG
CH	CH	CH	CH
CI	CI	CI	CI
CJ	CJ	CJ	CJ
CK	CK	CK	CK
CL	CL	CL	CL
CM	CM	CM	CM
CN	CN	CN	CN
CO	CO	CO	CO
CP	CP	CP	CP
CQ	CQ	CQ	CQ
CR	CR	CR	CR
CS	CS	CS	CS
CT	CT	CT	CT
CU	CU	CU	CU
CV	CV	CV	CV
CW	CW	CW	CW
CX	CX	CX	CX
CY	CY	CY	CY
CZ	CZ	CZ	CZ
DA	DA	DA	DA
DB	DB	DB	DB
DC	DC	DC	DC
DD	DD	DD	DD
DE	DE	DE	DE
DF	DF	DF	DF
DG	DG	DG	DG
DH	DH	DH	DH
DI	DI	DI	DI
DJ	DJ	DJ	DJ
DK	DK	DK	DK
DL	DL	DL	DL
DM	DM	DM	DM
DN	DN	DN	DN
DO	DO	DO	DO
DP	DP	DP	DP
DQ	DQ	DQ	DQ
DR	DR	DR	DR
DS	DS	DS	DS
DT	DT	DT	DT
DU	DU	DU	DU
DV	DV	DV	DV
DW	DW	DW	DW
DX	DX	DX	DX
DY	DY	DY	DY
DZ	DZ	DZ	DZ
EA	EA	EA	EA
EB	EB	EB	EB
EC	EC	EC	EC
ED	ED	ED	ED
EE	EE	EE	EE
EF	EF	EF	EF
EG	EG	EG	EG
EH	EH	EH	EH
EI	EI	EI	EI
EJ	EJ	EJ	EJ
EK	EK	EK	EK
EL	EL	EL	EL
EM	EM	EM	EM
EN	EN	EN	EN
EO	EO	EO	EO
EP	EP	EP	EP
EQ	EQ	EQ	EQ
ER	ER	ER	ER
ES	ES	ES	ES
ET	ET	ET	ET
EU	EU	EU	EU
EV	EV	EV	EV
EW	EW	EW	EW
EX	EX	EX	EX
EY	EY	EY	EY
EZ	EZ	EZ	EZ
FA	FA	FA	FA
FB	FB	FB	FB
FC	FC	FC	FC
FD	FD	FD	FD
FE	FE	FE	FE
FF	FF	FF	FF
FG	FG	FG	FG
FH	FH	FH	FH
FI	FI	FI	FI
FJ</			

for construction certificate

DEMOLISH
NEW WORK
BOUNDARY
HIDDEN
OVERHEAD
OVERLAND FLOW
SILTATION BARRIER
SITE FENCE
RE-CLAD