



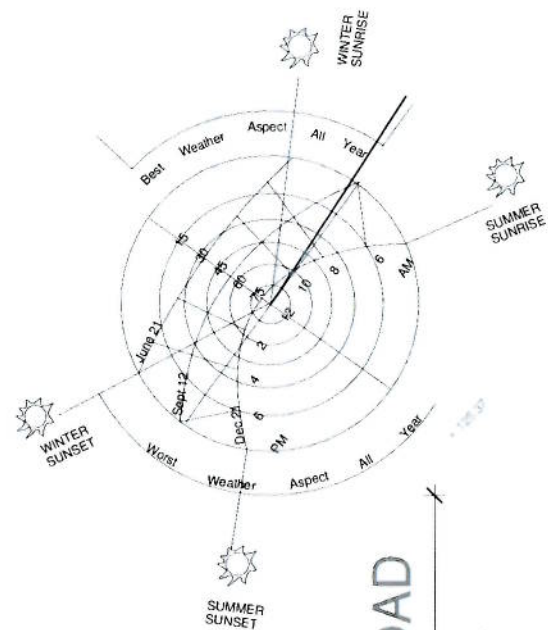

ALLAMBIE ROAD

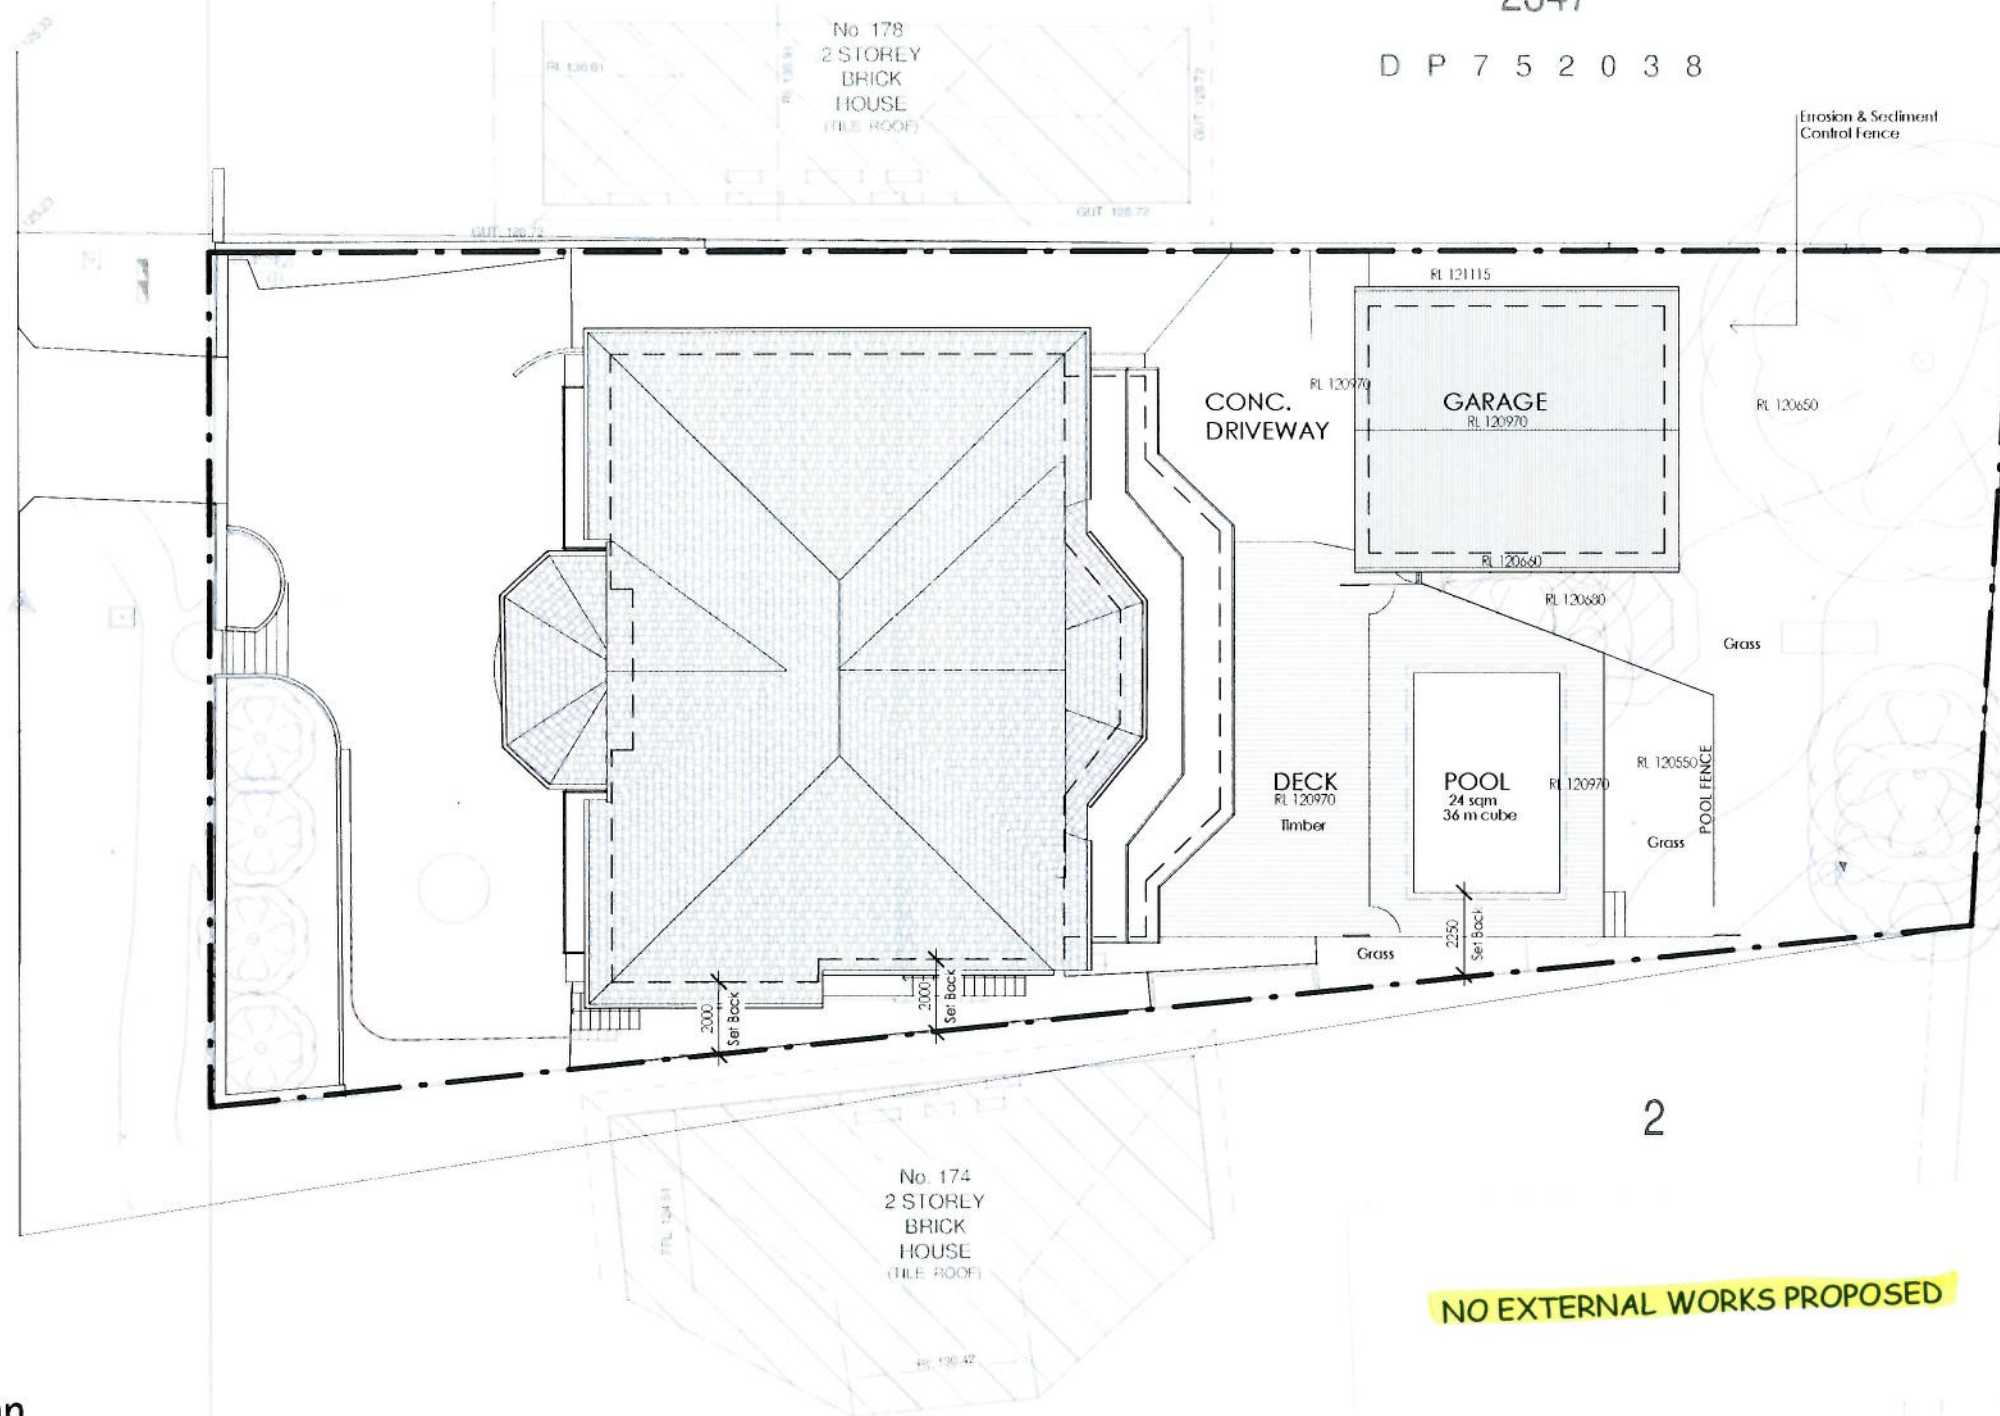

1 Pro Site and Roof Plan

A04-A A00-A 1:200

NO EXTERNAL WORKS PROPOSED

ARCHITECT

THW
ARCHITECTS


t. 0419 210 480
f. 02 8915 1723
e. tim@thw.net.au
m. 46 Elaine Ave AVALON NSW 2107
reg# NSW 7417

PROJECT
Second Kitchen Application
176 Allambie Rd
Allambie Heights NSW
Lot 1, DP 575244

CLIENT
Mike McLean
176 Allambie
Allambie Heights NSW 2100
e. mcleanmh@bigpond.net.au
p. 02 9452 6901

B	29-03-17	REVISED AS BUILT
A	03-03-17	AS BUILT
IS	DATE	COMMENTS


SCALE 1:200	DRAWN BY L.J.	CHK. BY T.W.	PAGE SIZE A3
PROJECT NAME Allambie Heights			JOB NUMBER 049
DRAWING NAME Site, Analysis & Landscape Plan			DRAWING NUMBER A00-A

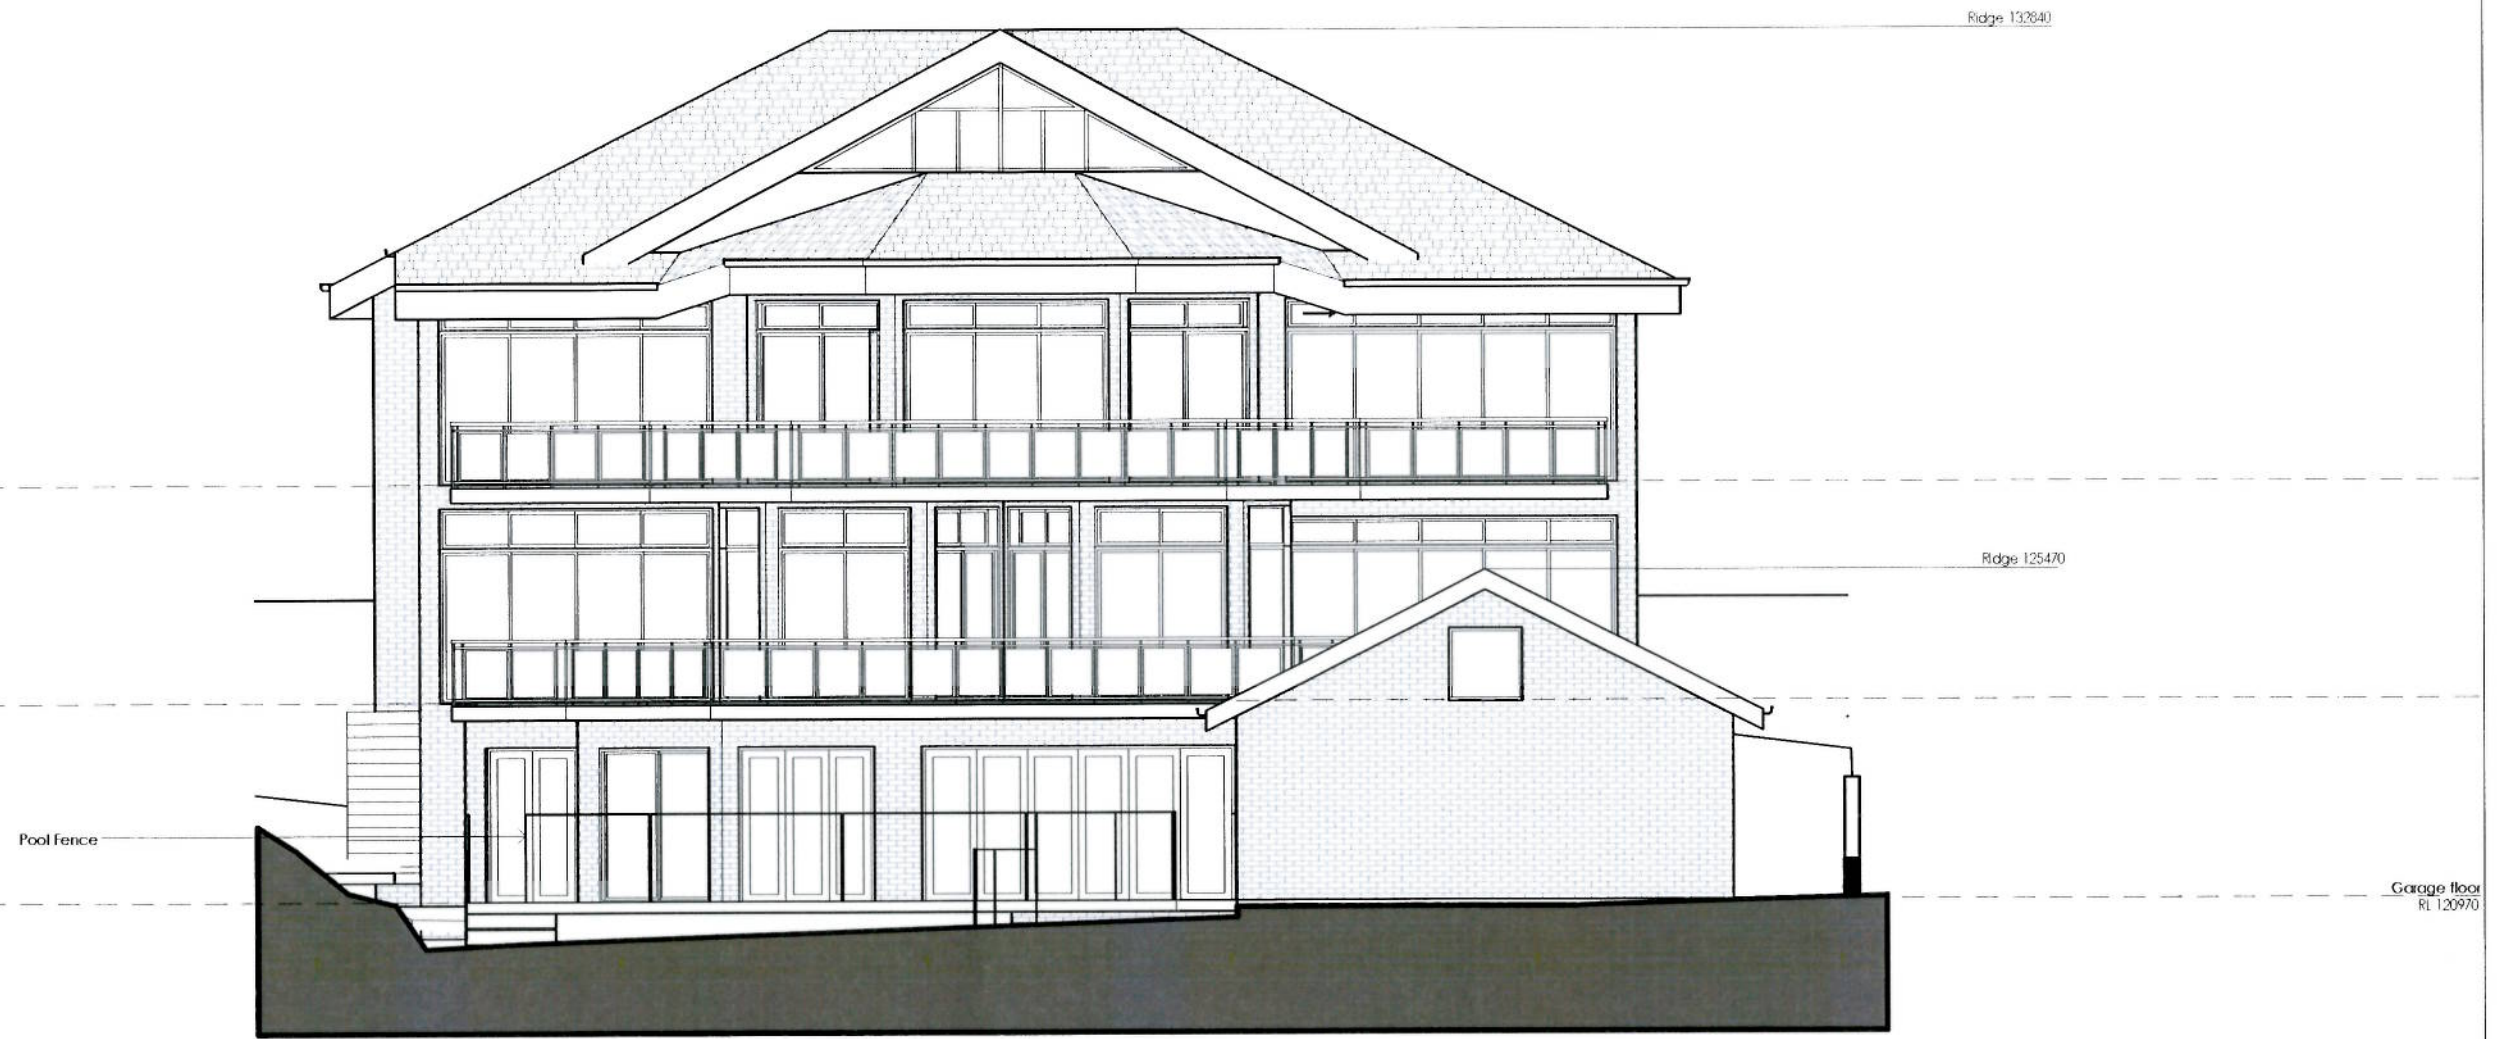

2 Pro North East
A04-A 1:100



ARCHITECT  t. 0419 210 480 f. 02 8915 1723 e. tim@thw.net.au m. 46 Elaine Ave AVALON NSW 2107 reg# NSW 7417				PROJECT Second Kitchen Application 176 Allambie Rd Allambie Heights NSW Lot 1, DP 575244	B A IS	29-03-17 03-03-17 DATE	REVISED AS BUILT AS BUILT COMMENTS	SCALE 1 : 100	DRAWN BY L.J	CHK. BY T.W	PAGE SIZE A3
								PROJECT NAME Allambie Heights	JOB NUMBER 049		
				CLIENT Mike McLean 176 Allambie Allambie Heights NSW 2100 e. mcleanmh@bigpond.net.au p. 02 9452 6901				DRAWING NAME North East Elevation	DRAWING NUMBER A04-A		

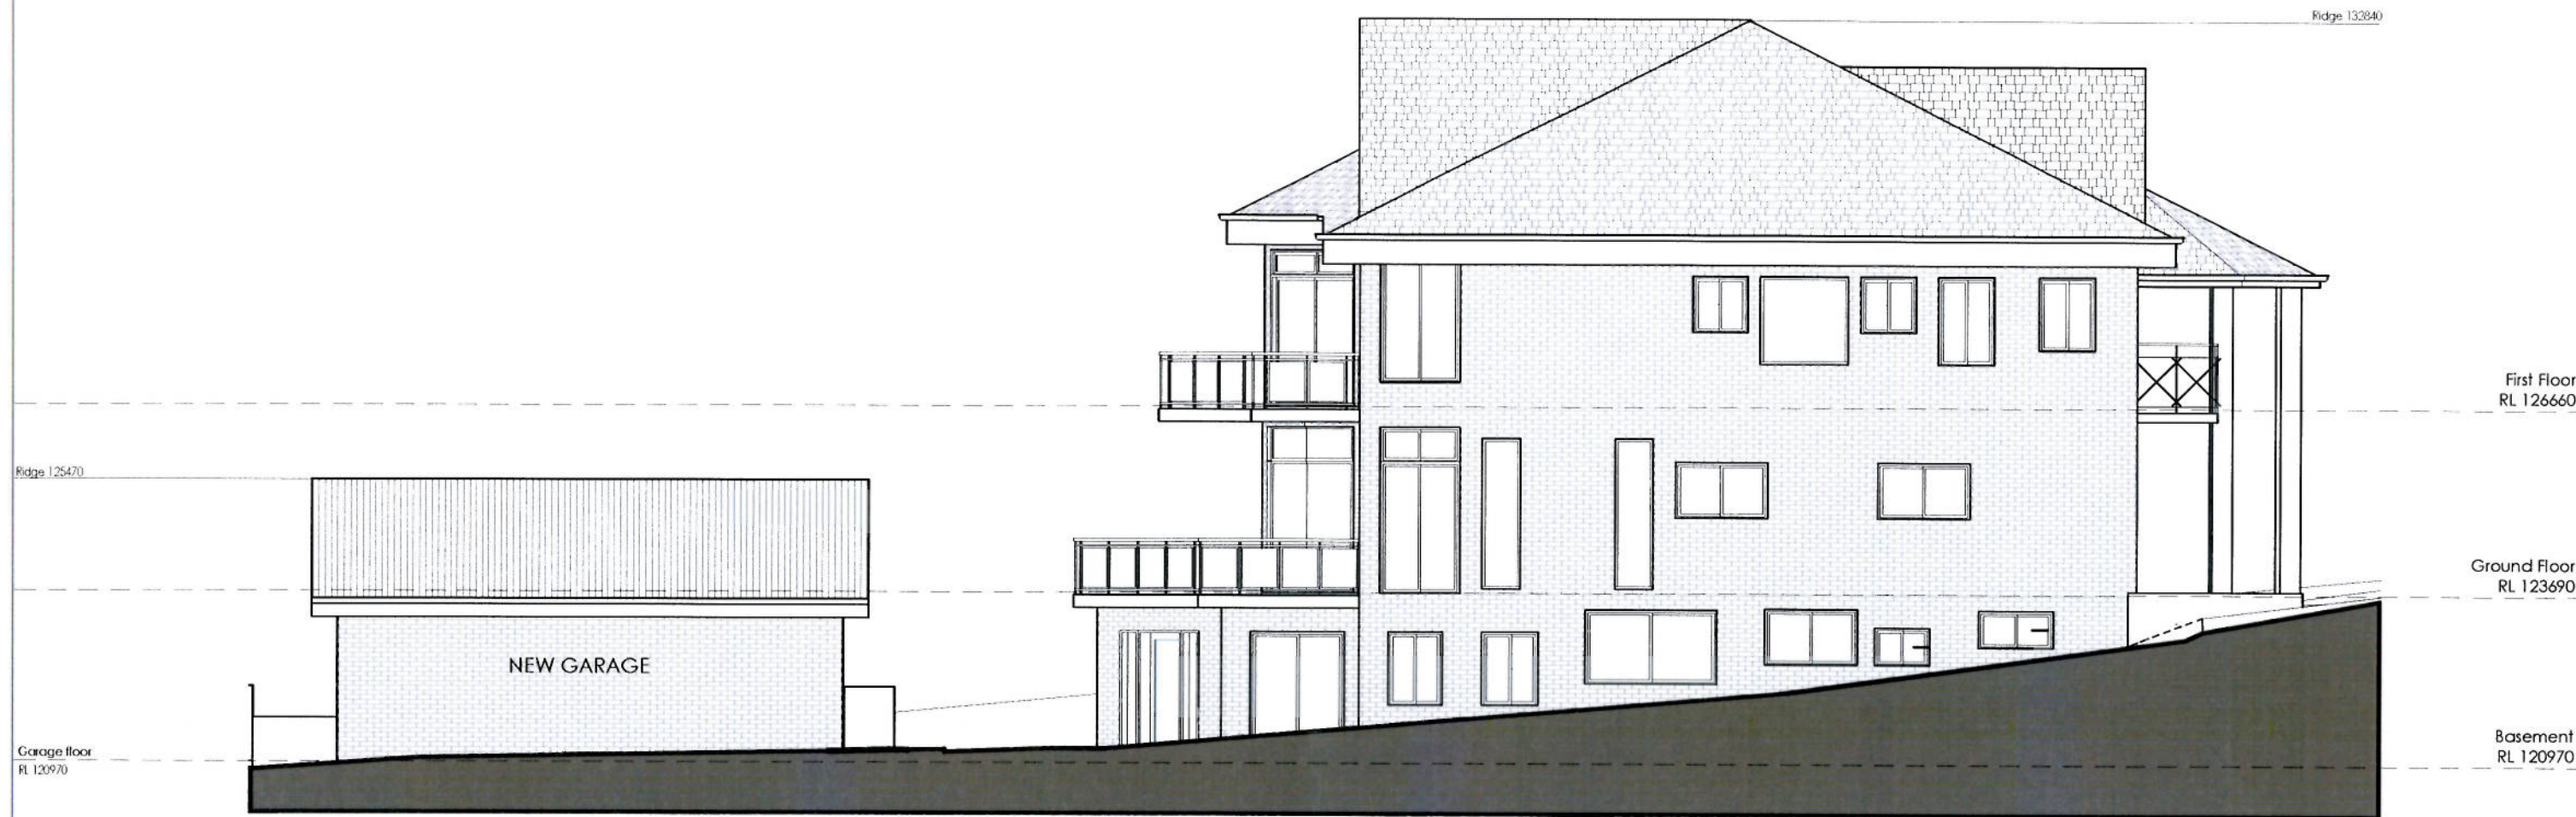

1 Pro North West
A05-A 1:100

ARCHITECT




t. 0419 210 480
f. 02 8915 1723
e. tim@thw.net.au
m. 46 Elaine Ave AVALON NSW 2107
reg# NSW 7417

PROJECT
Second Kitchen Application
176 Allambie Rd
Allambie Heights NSW
lot 1, DP 575244

CLIENT
Mike McLean
176 Allambie
Allambie Heights NSW 2100
e. mcleanmh@bigpond.net.au
p. 02 9452 6901

B 29-03-17
A 03-03-17
IS DATE COMMENTS
REVISED AS BUILT
AS BUILT

SCALE	DRAWN BY	CHK. BY	PAGE SIZE
1:100	L.J	T.W	A3
PROJECT NAME			JOB NUMBER
Allambie Heights			049
DRAWING NAME			DRAWING NUMBER
North West Elevation			A05-A

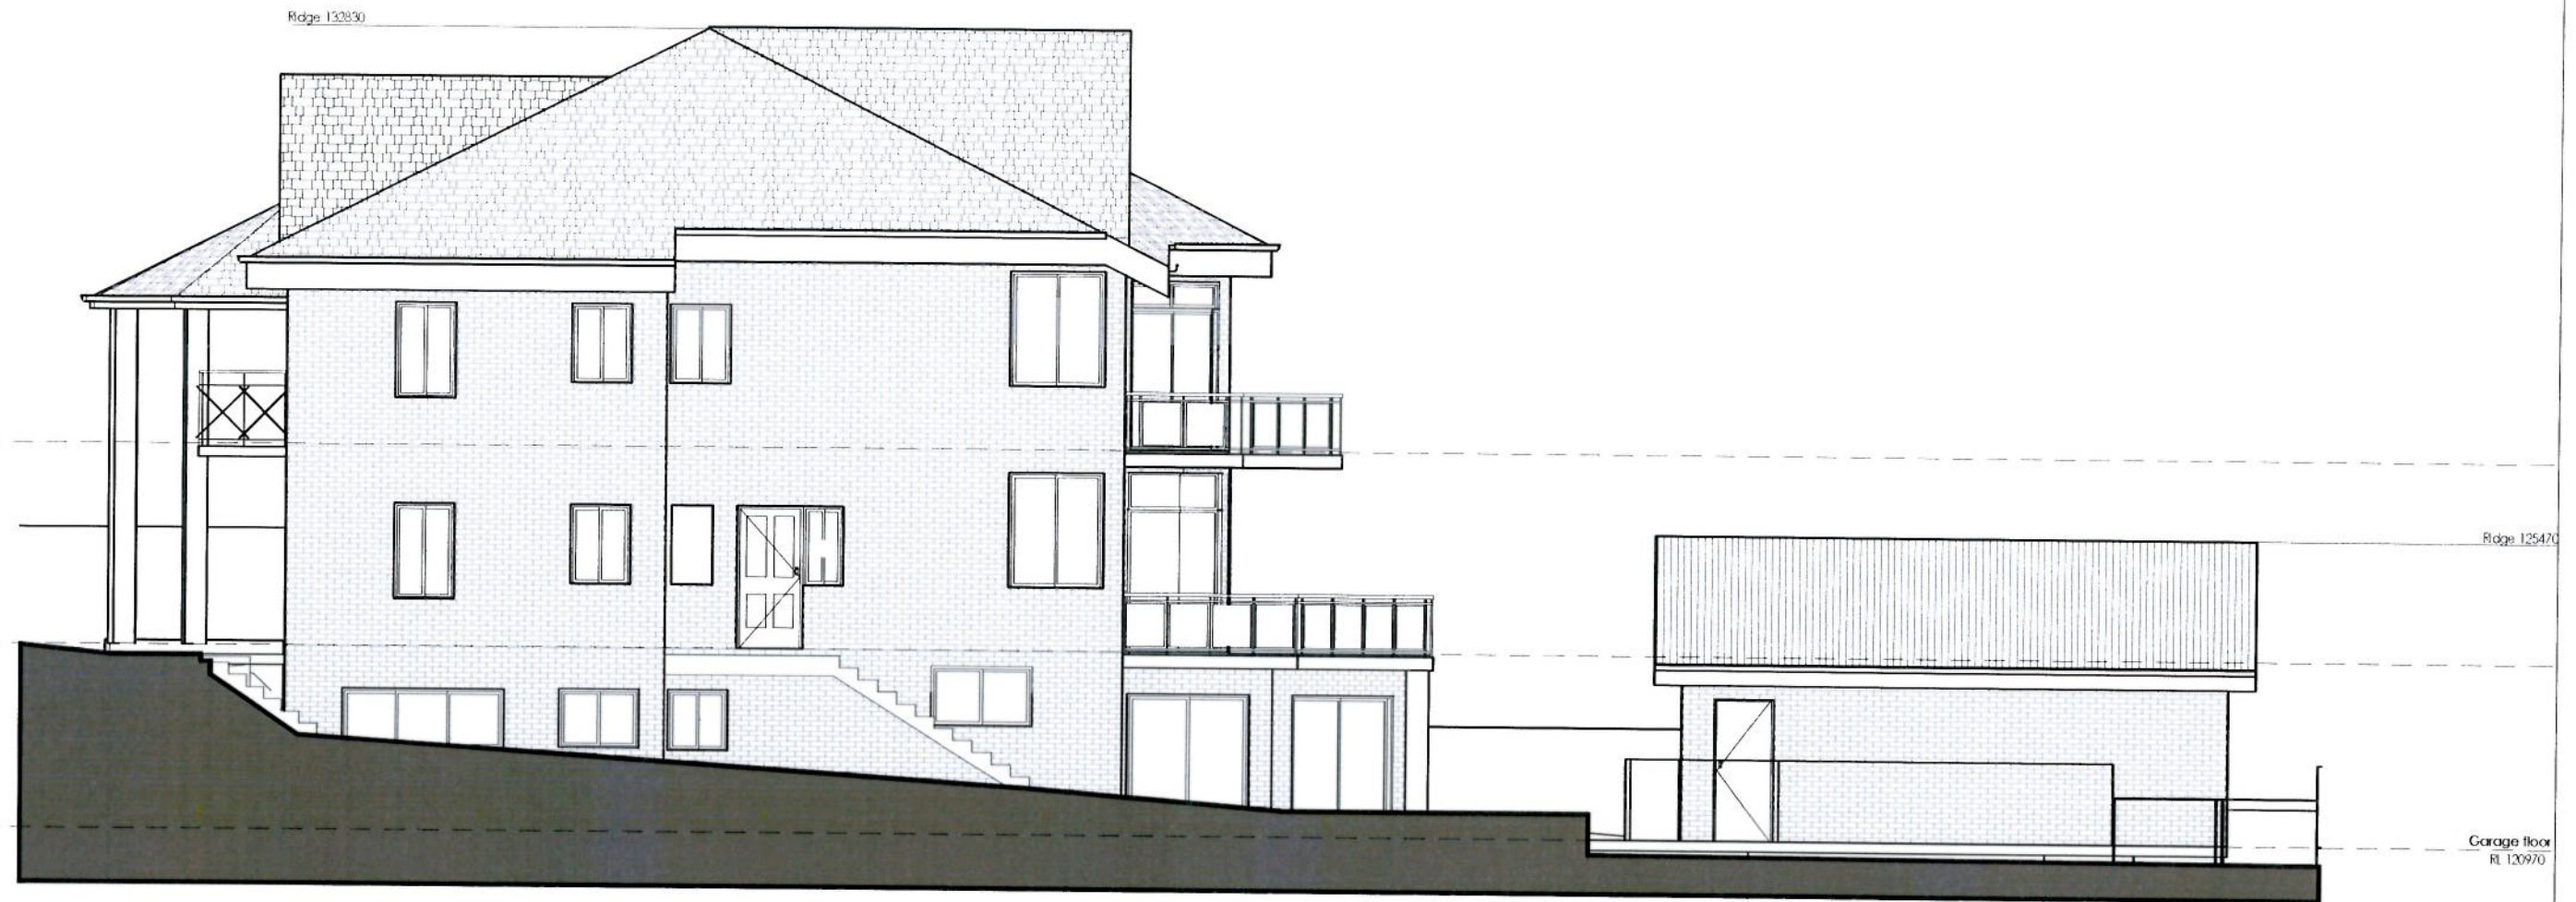

1 Pro South East
A06-A 1:100

ARCHITECT



t. 0419 210 480
f. 02 8915 1723
e. tim@thw.net.au
m. 46 Elaine Ave AVALON NSW 2107
reg# NSW 7417

PROJECT
Second Kitchen Application
176 Allambie Rd
Allambie Heights NSW
Lot 1, DP 575244

CLIENT
Mike McLean
176 Allambie
Allambie Heights NSW 2100
e. mcleanmh@bigpond.net.au
p. 02 9452 6901

B	29-03-17	REVISED AS BUILT
A	03-03-17	AS BUILT
IS	DATE	COMMENTS

SCALE 1:100	DRAWN BY L.J	CHK. BY T.W	PAGE SIZE A3
PROJECT NAME Allambie Heights			JOB NUMBER 049
DRAWING NAME South East Elevation			DRAWING NUMBER A06-A

DRAWINGS NOT TO BE SCALED. USE FIGURED DIMENSIONS ONLY. CHECK ALL DIMENSIONS ON SITE. ELECTRONIC COPIES OF DRAWINGS SHOULD BE VERIFIED AGAINST PRINTED COPIES TO ENSURE NO LOSS OF INFORMATION.

ARCHITECTS WORK IS COPYRIGHT AND COVERED BY COPYRIGHT ACT 1968



First Floor
RL 126660

Ground Floor
RL 123690

2 South West
A07-A 1:100



ARCHITECT



t. 0419 210 480
f. 02 8915 1723
e. tim@thw.net.au
m. 46 Elaine Ave AVALON NSW 2107
reg# NSW 7417

PROJECT
Second Kitchen Application
176 Allambie Rd
Allambie Heights NSW
lot 1, DP 575244

CLIENT
Mike McLean
176 Allambie
Allambie Heights NSW 2100
e. mcleanmh@bigpond.net.au
p. 02 9452 6901

B 29-03-17
A 03-03-17
IS DATE COMMENTS

SCALE 1:100	DRAWN BY L.J.	CHK. BY T.W.	PAGE SIZE A3
PROJECT NAME Allambie Heights			JOB NUMBER 049
DRAWING NAME South West Elevation			DRAWING NUMBER A07-A